

Department of Licensing and Regulatory Affairs

1st Floor Ottawa Building
611 W. Ottawa Street
Lansing, MI 48933



Final Report - Approved

Application Number: PR2023BCC-002591

Report Date: 03/29/2024

Description : New one-story with a penthouse addition to existing structure for commercial kitchen and dining space. Addition totals 11,124 square feet and includes plumbing, HVAC, electrical, food service equipment, communications and IT, and associated site work for new construction.

Address : 8303 PLATT RD, SALINE, MI, 48176

Record Type : Bureau of Construction Codes Plan Review Application

Document Filename : 491.20167.SDW CFP - Create Kitchen - Bid and Construction Set_Sealed.pdf

Reviewer Contact Information:

Reviewer Name	Reviewer Email	Reviewer Phone
Allon Robbins	RobbinsA@michigan.gov	517-243-6560
Neil Pline	PlineN@michigan.gov	517-280-9516
Brian Hamilton	HamiltonB7@michigan.gov	517-914-7874
Daniel Morris	MorrisD9@michigan.gov	517-927-9734

General Comments

Markups for this Approved Document or Plan

Comment ID	Page Ref	Reviewer : Department	Review Comments
20	1	Brian Hamilton : Building	<p>PLEASE NOTE: This is a CONDITIONAL AND PARTIAL approval. Final approval is subject to your State of Michigan assigned Building Inspectors determination pending final inspection. Any issue found to be non-compliant may be written as a violation.</p> <p>Provide a Temporary Egress Exit Plan to be approved by your State Building Inspector PRIOR to commencement of work. This plan shall include the alternate egress exit travel path's and their distances for use WHILE THE BUILDING IS UNDER CONSTRUCTION.</p> <p>-CONTACT YOUR ASSIGNED BUILDING INSPECTOR FOR A WALK THROUGH TO OBTAIN HIS APPROVAL.</p> <p>- MBC2015, 1001.2 - Minimum requirements. It shall be unlawful to alter a building or structure in a manner that will reduce the number of exits or the minimum width or required capacity of the means of egress to less than required by this code.</p> <p>- MBC2015, 3310.2 - Maintenance of means of egress. Required means of egress shall be MAINTAINED AT ALL TIMES during construction, demolition, remodeling or alterations and additions to any building.</p>



Comment ID	Page Ref	Reviewer : Department	Review Comments
21	1	Brian Hamilton : Building	- The applicant of this submittal is responsible for the submission of F.P.S. Shop Drawings. Certificates of Occupancy shall not be issued without approved F.P.S. drawings unless otherwise determined by your assigned Building Inspector. - MBC2015, 107.2.2 - Fire protection system shop drawings. Shop drawings for the fire protection system(s) shall be submitted to indicate conformance to this code and the construction documents and shall be approved prior to the start of system installation. - MBC2015, 3312.1 - Completion before occupancy. In buildings where an automatic sprinkler system is required by this code, it shall be unlawful to occupy any portion of a building or structure until the automatic sprinkler system installation has been tested and approved, except as provided in Section 111.3.
22	1	Brian Hamilton : Building	- MBC2015, - 714.1.1 Ducts and air transfer openings. Penetrations of fire-resistance-rated walls by ducts that are not protected with dampers shall comply with Sections 714.2 through 714.3.3. Penetrations of horizontal assemblies not protected with a shaft as permitted by Section 717.6, and not required to be protected with fire dampers by other sections of this code, shall comply with Sections 714.4 through 714.5.2. Ducts and air transfer openings that are protected with dampers shall comply with Section 717.
5	70	Neil Pline : Electrical	NEC, Section 250.52(A)(3) - The foundation reinforcing steel, a concrete-encased electrode, is required to be connected to the building grounding electrode system for all new construction. This requirement also applies to building additions unless it can be shown that there is an existing electrode of this type currently installed and connected in a proper manner.
3	71	Neil Pline : Electrical	NEC, Sections 220.16(B), 220.12, and 220.14 - All additions and changes shall not overload existing circuits, panels, or the total service.
4	72	Neil Pline : Electrical	NEC, Section 210.8(B) - Other than dwelling units Ground-fault circuit-interrupter protection is required at all single-phase receptacles rated 150 volts to ground or less, 50 amperes or less and three-phase receptacles rated 150 volts to ground or less, 100 amperes or less installed in kitchens.
24	40	Daniel Morris : Mechanical	IFGC, 404.20 - Before any system of piping is put in service or concealed; it shall be tested to ensure that it is gas tight. Testing, inspection and purging of piping systems shall comply with Section 406.
25	42	Daniel Morris : Mechanical	MMC, Section 1204.2 - Required thickness. Hydronic piping shall be insulated to the thickness required by the International Energy Conservation Code.
26	42	Daniel Morris : Mechanical	MMC, Section 1208.1 - General. Hydronic piping systems shall be tested hydrostatically at one and one-half times the maximum system design pressure, but not less than 100 psi (689 kPa). The duration of each test shall be not less than 15 minutes.
17	54	Daniel Morris : Mechanical	MMC, Section 508.1.1 - Makeup air temperature. The temperature differential between makeup air and the air in the conditioned space shall not exceed 10°F (6°C) except where the added heating and cooling loads of the makeup air do not exceed the capacity of the HVAC system.
18	54	Daniel Morris : Mechanical	MMC, Section 508.1.2 - Air balance. Design plans for a facility with a commercial kitchen ventilation system shall include a schedule or diagram indicating the design outdoor air balance.
19	54	Daniel Morris : Mechanical	MMC, Section 106.3.1 - Provide detailed drawings of kitchen hood showing setback, clearances, duct design with offsets and roof or sidewall penetration. Provide an air table and make up air design details. Fire suppression plan also to be submitted if required per hood type.
14	39	Allon Robbins : Plumbing	MPC, Section 308.6 - Where horizontal pipes 4 inches (102 mm) and larger convey drainage or waste, and where a pipe fitting in that piping changes the flow direction greater than 45 degrees (0.79 rad), rigid bracing or other rigid support arrangements shall be installed to resist movement of the upstream pipe in the direction of pipe flow. A change of flow direction into a vertical pipe shall not require the upstream pipe to be braced.
15	47	Allon Robbins : Plumbing	MPC, Section 701.8 - Direct connection of a steam exhaust, blow off, or drip pipe, shall not be made with the building drainage system. Wastewater where discharged into the building drainage system shall be at a temperature not greater than 140° F (60° C). Where higher temperatures exist, approved cooling methods shall be provided.

Comment ID	Page Ref	Reviewer : Department	Review Comments
16	47	Allon Robbins : Plumbing	<p>MPC, Section 607.1 - 1) In nonresidential occupancies, hot water or tempered water shall be supplied for bathing and washing purposes. Tempered water shall be supplied through a water temperature limiting device that conforms to ASSE 1070 and shall limit the tempered water to a maximum of 110°F (43°C). This provision does not supersede the requirement for protective shower valves in accordance with Section 412.3 of the code.</p> <p>2) Tempered water shall be supplied to bathing and hand washing facilities in the occupancies identified in the following by individual water temperature limiting devices to individual fixtures: a. Elementary Schools. b. Child Care Centers. c. Day Care Centers. d. Nurseries. e. Adult group homes. f. Adult congregate homes. g. Children's camps. h. At accessible plumbing fixtures.</p>

491/20167.SDW - PHASE 500:

CENTER FOR FORENSIC PSYCHIATRY - CREATE KITCHEN

SALINE, MICHIGAN

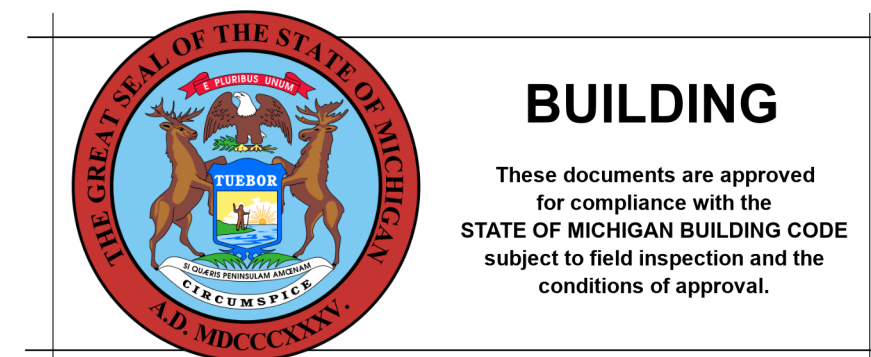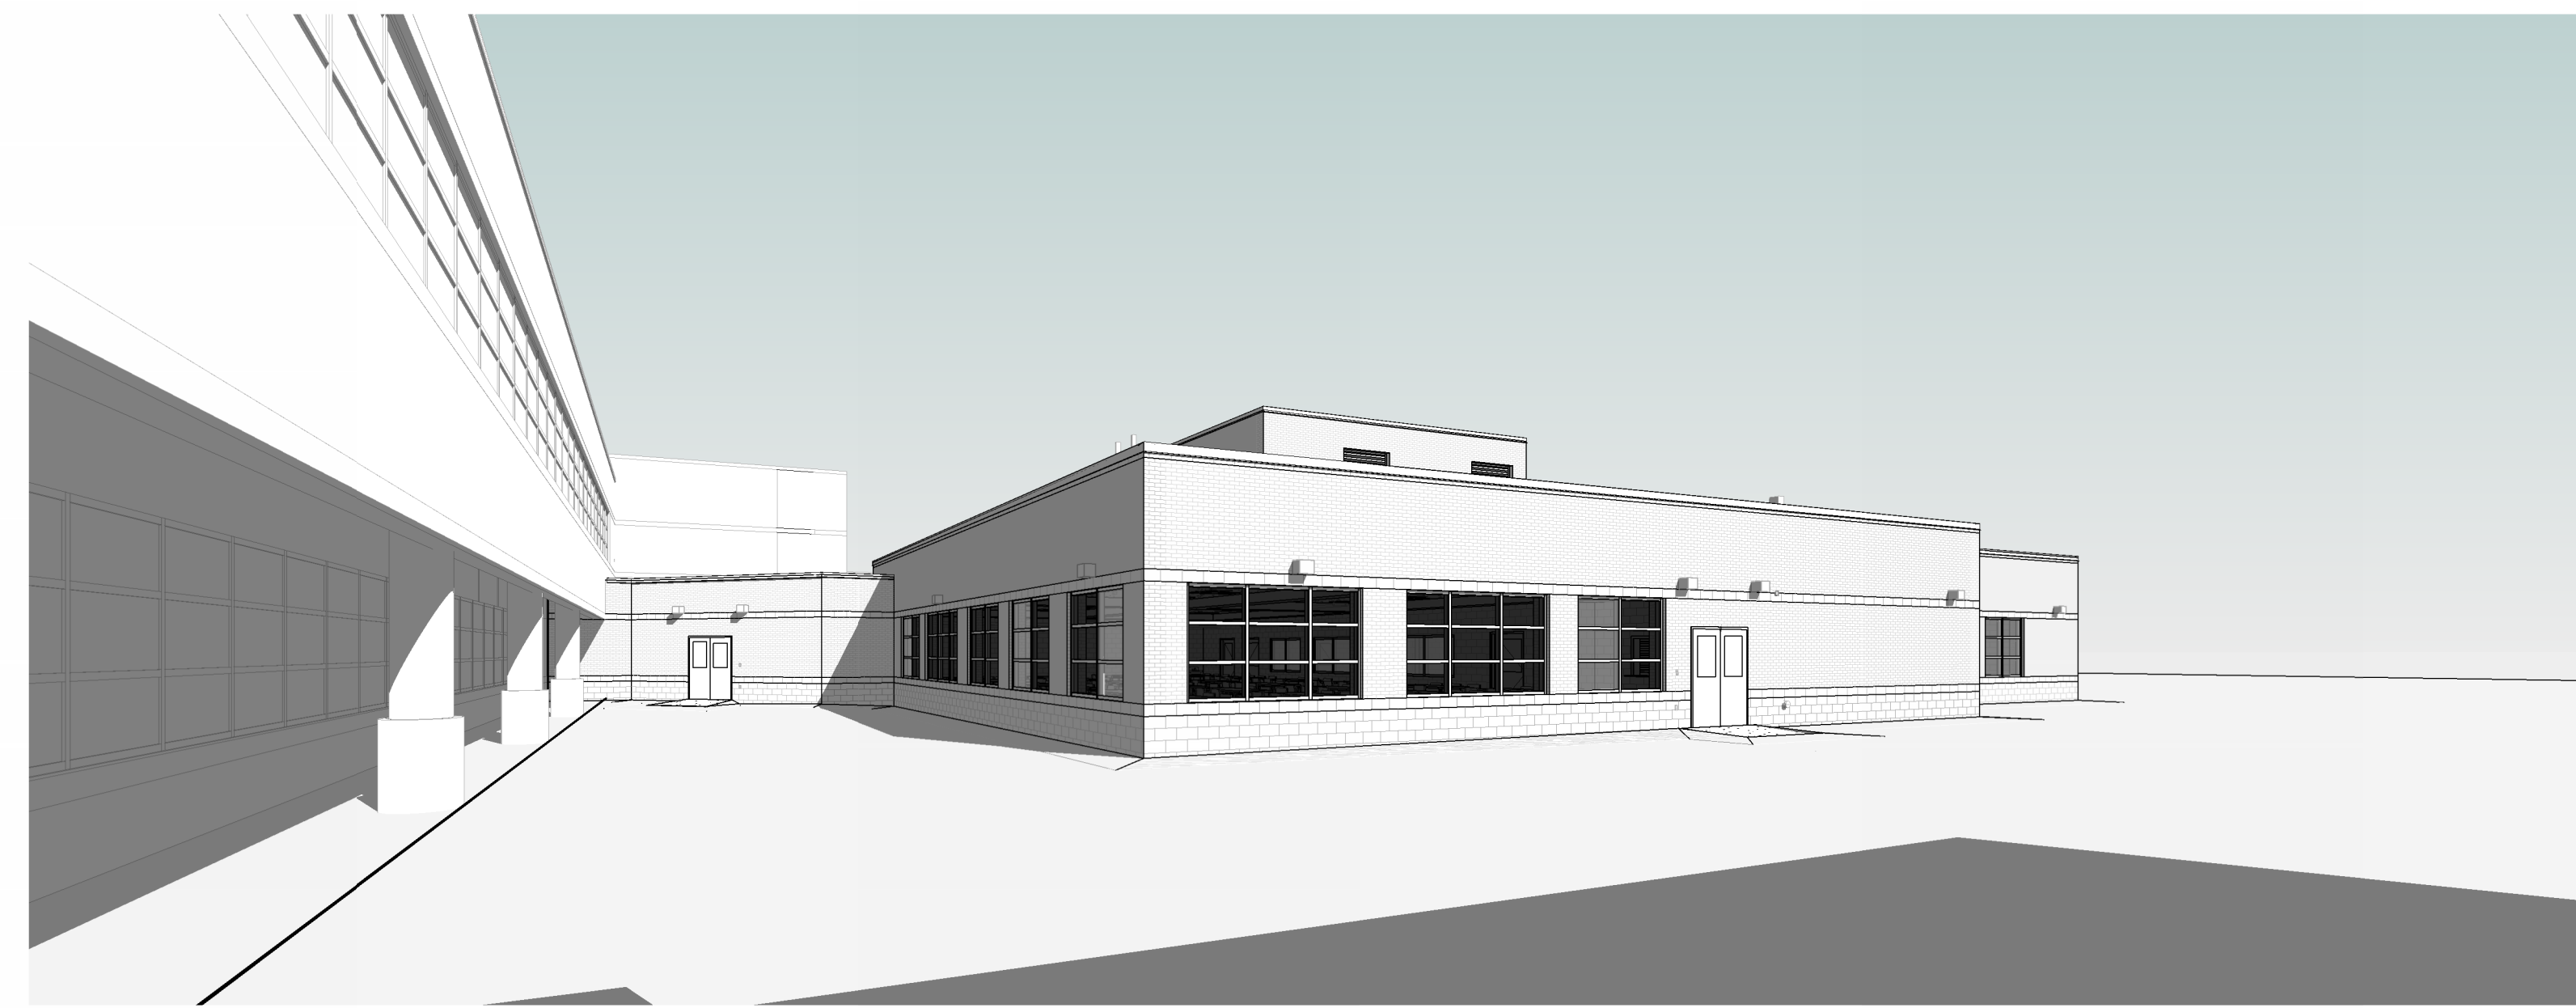

CONTACTS:

ARCHITECT:

WTA ARCHITECTS
100 S. JEFFERSON AVENUE, SUITE 601
SAGINAW, MICHIGAN 48607
PHONE: (989) 752-8107
EMAIL: DESIGN@WTAARCH.COM

STRUCTURAL ENGINEER:

MACMILLAN ASSOCIATES, INC.
714 E. MIDLAND STREET
BAY CITY, MICHIGAN 48706
PHONE: (989) 894-4300
FAX: (989) 864-9930

MECHANICAL & ELECTRICAL ENGINEER:

PETER BASSO ASSOCIATES, INC.
CONSULTING ENGINEERS
5145 LIVERNOIS ROAD, SUITE 100
TROY, MICHIGAN 48098
PHONE: (248) 879-5666
FAX: (248) 879-0007

CIVIL ENGINEER:

ROWE PROFESSIONAL SERVICES COMPANY
127 S. MAIN STREET
MT. PLEASANT, MICHIGAN 48858
PHONE: (989) 772-2138
FAX: (989) 773-7757

FOOD SERVICE:

STAFFORD SMITH, INC.
3414 SOUTH BURDICK STREET
KALAMAZOO, MICHIGAN 49001
PHONE: (800) 962-2442
PHONE: (269) 343-1240

COMMUNICATIONS & IT:

COMMTECH DESIGN
6581 BELDING RD NE SUITE. #101
ROCKFORD, MICHIGAN 49341
PHONE: (616) 446-4545
PHONE: (616) 863-8132

INDEX OF DRAWINGS:

TS TITLE SHEET

CIVIL DRAWINGS
C1.01 CIVIL LEGEND
C1.02 CIVIL NOTES
C1.03 CIVIL DETAILS
C1.04 FENCE DETAILS

C2.01 SITE DEMOLITION PLAN
C2.02 SITE PLAN
C2.03 UTILITY PLAN
C2.04 GRADING PLAN

ARCHITECTURAL DRAWINGS
A0.01 PROJECT INFORMATION

A2.01 FIRST FLOOR MASTER CODE PLAN
A2.02 FIRST FLOOR PARTIAL CODE PLAN

A2.11 FIRST FLOOR DEMOLITION PLAN

A2.21 FIRST FLOOR CONSTRUCTION PLAN
A2.22 SECOND FLOOR CONST. PLN, ENLARGED PLN,
& INTERIOR ELEVATION

A2.23 FIRST & SECOND FLOOR FLOORING PLANS

A2.31 PLAN DETAILS

A3.01 ROOM FINISH & DOOR SCHEDS, DOOR & WDW
TYPES, AND DOOR DTLS

A4.01 VERTICAL CIRCULATION

A5.01 EXTERIOR ELEVATIONS

A5.11 BUILDING SECTIONS

A6.01 ROOF PLAN

A7.01 WALL SECTIONS & DETAILS
A7.02 WALL SECTIONS & DETAILS

A9.01 FIRST & SECOND FLOOR REFLECTED CEILING
PLAN

FOOD SERVICE DRAWINGS
FS2.01 KITCHEN EQUIPMENT PLAN
FS2.02 KITCHEN ELECTRICAL PLAN
FS2.03 KITCHEN PLUMBING PLAN
FS2.04 KITCHEN VENTILATION PLAN
FS2.05 SPECIAL CONDITIONS PLAN

STRUCTURAL DRAWINGS
S2.01 FOUNDATION PLAN
S2.02 ROOF FRAMING PLAN

S3.01 NOTES AND SCHEDULES

S5.01 FOUNDATION DETAILS

S7.01 ROOF FRAMING DETAILS

MECHANICAL DRAWINGS
M0.01 MECHANICAL STANDARDS AND DRAWING
INDEX

M1.01 FIRE PROTECTION ZONING PLAN

M2.00 UNDERGROUND PLUMBING PLAN
M2.01 FIRST FLOOR PLUMBING AND FIRE
PROTECTION PLAN - UNIT H

M2.02 FIRST FLOOR PLUMBING AND FIRE
PROTECTION PLAN - UNIT J

M2.03 PENTHOUSE PLUMBING PLAN

M3.01 FIRST FLOOR HVAC PIPING PLAN - UNIT H

M3.03 PENTHOUSE HVAC PIPING PLAN

M4.01 FIRST FLOOR SHEET METAL PLAN - UNIT H

M4.03 PENTHOUSE SHEET METAL PLAN

M4.04 MECHANICAL ROOF PLAN

M5.01 PLUMBING ENLARGED PLAN

M6.01 MECHANICAL DETAILS

M6.02 MECHANICAL DETAILS

M6.03 MECHANICAL DETAILS

M6.04 MECHANICAL DETAILS

M7.01 MECHANICAL SCHEDULES

M7.02 MECHANICAL SCHEDULES

M7.03 MECHANICAL SCHEDULES

M7.04 MECHANICAL SCHEDULES

M8.01 TEMPERATURE CONTROL STANDARDS AND
GENERAL NOTES
M8.02 TEMPERATURE CONTROLS
M8.03 TEMPERATURE CONTROLS
M8.04 TEMPERATURE CONTROLS

ELECTRICAL DRAWINGS
E0.01 ELECTRICAL STANDARDS AND DRAWING
INDEX
E0.02 ELECTRICAL STANDARD SCHEDULES
E0.03 ELECTRICAL DEMOLITION SITE PLAN
E0.04 ELECTRICAL NEW WORK SITE PLAN

ED1.01 FIRST FLOOR ELECTRICAL DEMOLITION PLAN

E2.01 FIRST FLOOR LIGHTING PLAN - UNIT H

E3.00 BASEMENT FLOOR POWER PLAN - UNIT H

E3.01 FIRST FLOOR POWER PLAN - UNIT H

E4.01 FIRST FLOOR AUXILIARY SYSTEMS PLAN - UNIT
H

E4.04 ELECTRICAL ROOF PLAN

E5.01 ONE LINE DIAGRAM - NEW WORK

E5.02 PANEL SCHEDULES

E6.01 ELECTRICAL ENLARGED PLAN

E6.02 ELECTRICAL ENLARGED PLAN

E7.00 ELECTRICAL DETAILS AND DIAGRAMS

E7.01 ELECTRICAL DETAILS AND DIAGRAMS

COMMUNICATIONS & IT DRAWINGS

TC1.01 CABLING LEGENDS, SCHEDULES & DETAILS

TC1.02 CABLING CONNECTIVITY CODES

TC1.03 CABLING RACK LAYOUTS & DETAILS

TC1.04 FENCE DETECTION DETAILS

TC1.05 ACCESS CONTROL DEVICES

TC1.06 SECURITY ACCESS CONTROL DETAILS

TC1.07 VIDEO SECURITY SYSTEM DETAILS



TC2.00 TECHNOLOGY SITE PLAN

TC2.01 FIRST FLOOR TECHNOLOGY PLAN

TC2.01A BASEMENT TECHNOLOGY PLAN AREA 100



Structural
September 16, 2023
MAI #2021-1530

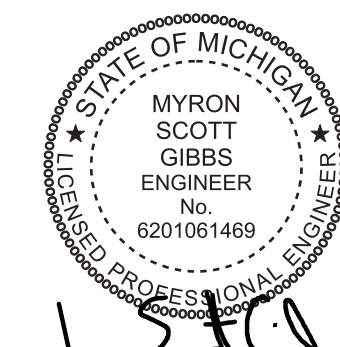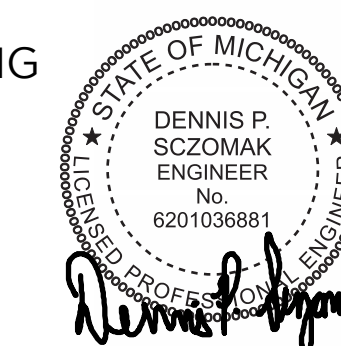

L.S.C.

NO.	REVISION	DATE

STATE OF MICHIGAN
DEPARTMENT OF TECHNOLOGY, MANAGEMENT AND BUDGET
FACILITIES AND BUSINESS SERVICES ADMINISTRATION
DESIGN AND CONSTRUCTION DIVISION
ADAM LACR, R.A. DIRECTOR

FILE NO.
491/20167.SDW
FUNDING CODE
171CODHHS7255
CONTRACT NO.
Y22003






WTAARCH.COM
WTA ARCHITECTS
100 S. Jefferson Ave, Suite 601
Saginaw, Michigan 48607
989 752 8107
COPYRIGHT © 2023

PROJECT TITLE
491/20167.SDW - PHASE 500:
CENTER FOR FORENSIC
PSYCHIATRY - CREATE
KITCHEN
SALINE, MICHIGAN

SHEET TITLE
TITLE SHEET

PROJECT NUMBER 2021094	SHEET NUMBER TS
PROJECT DATE SEPTEMBER 6, 2023	
CHECKED BY C.D.S.	

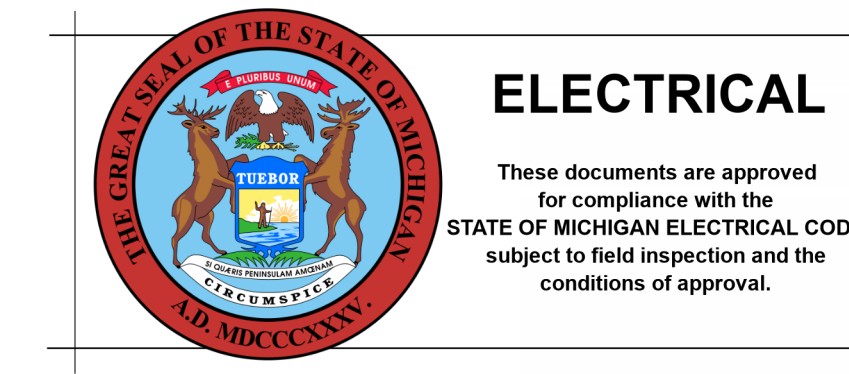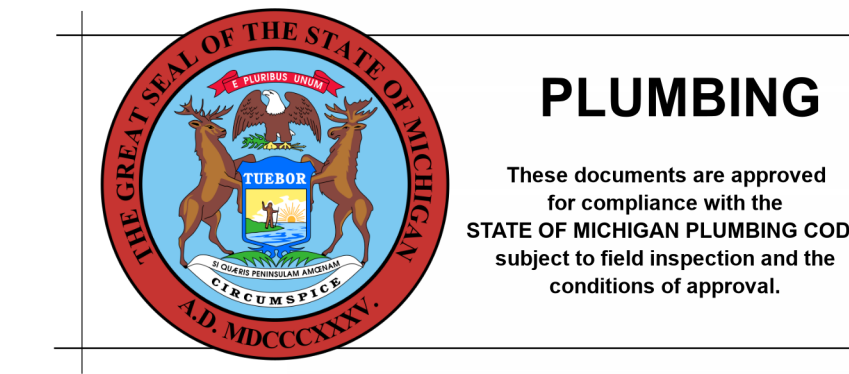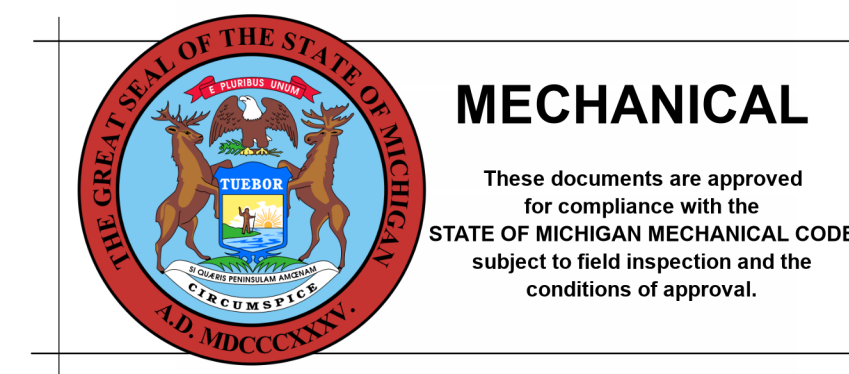

STRUCTURE SYMBOLS

- ◻ EXISTING CATCH BASIN IN CURB LINE
- PROPOSED CATCH BASIN IN CURB LINE
- ⊙ EXISTING CATCH BASIN IN GREEN SPACE
- PROPOSED CATCH BASIN IN GREEN SPACE
- EXISTING STORM MANHOLE
- PROPOSED STORM MANHOLE
- PROPOSED CULVERT END SECTION
-) EXISTING HEADWALL
-) PROPOSED HEADWALL
- EXISTING GATE VALVE AND BOX
- EXISTING WATER SHUT OFF (CURB BOX)
- PROPOSED GATE VALVE AND BOX
- EXISTING GATE VALVE AND WELL
- PROPOSED GATE VALVE AND WELL
- × EXISTING SPRINKLER HEAD
- EXISTING WATER WELL
- ⊕ EXISTING FIRE HYDRANT
- ⊕ PROPOSED FIRE HYDRANT
- ┌─┐ PROPOSED WATER MAIN FITTINGS
- EXISTING CLEAN OUT
- EXISTING SANITARY SEWER MANHOLE
- PROPOSED SANITARY SEWER MANHOLE
- ⊠ EXISTING MONITORING WELL

EXISTING TOPOGRAPHICAL SYMBOLS

- ≡ SIGN
- ↑ STREET SIGN
- END OF PIPE
- ▭ SWAMP OR WETLAND
- ⊙ DECIDUOUS TREE
- ☀ CONIFEROUS TREE
- ⊕ TREE STUMP
- ✉ MAIL BOX
- ⊠ SOIL BORING
- ROCK
- METAL POST
- BUMPER BLOCK

UTILITY SYMBOLS

- UTILITY POLE
- > GUY ANCHOR CABLE
- * LIGHT POLE / ORNAMENTAL LIGHT
- ⊕ POWER LIGHT POLE
- TELEPHONE MANHOLE
- UNDERGROUND GAS LINE MARKER
- GAS RISER
- GAS VENT
- GAS VALVE
- ⊕ RAILROAD SIGNAL
- * METAL LIGHT POLE
- OUTLET
- CIRCUIT BREAKER PANEL
- ⊠ ELECTRICAL TRANSFORMER PAD
- ⊠ ELECTRICAL TRANSFORMER RISER
- ⊖ ELECTRIC METER
- TELEPHONE PEDESTAL / RISER
- ⊠ TRAFFIC SIGNAL ON POLE
- PHONE BOOTH / PAY PHONE

SURVEY SYMBOLS

- MONUMENT
- ▲ BENCHMARK
- △ TRAVERSE POINT
- ⊕ SECTION CORNER
- FOUND SURVEY MONUMENTATION

MISCELLANEOUS SYMBOLS

- EX 1812 EXISTING STORM SEWER STRUCTURE NUMBER
- EX 5236 EXISTING SANITARY SEWER STRUCTURE NUMBER
- 1 PROPOSED STORM SEWER STRUCTURE NUMBER
- A PROPOSED SANITARY SEWER STRUCTURE NUMBER
- ~ FLOW DIRECTION
- ⊗ EXISTING RIP-RAP
- ⊗ PROPOSED RIP-RAP

CAUTION SYMBOLS

- CAUTION•• HAZARDOUS FLAMMABLE MATERIAL UNDERGROUND USED WITH UNDERGROUND GAS & ELECTRICAL LINES
- CAUTION•• FIBER OPTIC USED WITH FIBER OPTICS LINES

PLAN VIEW LINE TYPES

- 12" STM ----- EXISTING STORM SEWER
- 12" COMC ----- EXISTING CULVERT
- PROPOSED STORM SEWER LESS THAN 24"
- PROPOSED STORM SEWER 24" AND GREATER
- 12" SAN ----- EXISTING SANITARY SEWER
- PROPOSED SANITARY SEWER
- 12" WM ----- EXISTING WATER MAIN
- PROPOSED WATER MAIN
- SECTION LINE
- 60' ROW ----- EXISTING RIGHT OF WAY
- 60' ROW ----- PROPOSED RIGHT OF WAY
- PROPOSED EASEMENT
- EXISTING CENTER LINE DITCH
- PROPOSED DITCH CENTERLINE
- EXISTING CENTER LINE ROADWAY
- PARCEL LINE / LOT LINE
- 0/H ----- EXISTING OVERHEAD UTILITIES
- U/G ELEC ----- UNDERGROUND ELECTRICAL LINE
- 6" S-MP GAS ----- GAS LINE OR PETROLEUM PIPELINE
- U/G TEL ----- UNDERGROUND TELEPHONE LINE
- U/G CATV ----- UNDERGROUND CABLE TV LINE
- U/G FIBER OPTIC ----- UNDERGROUND FIBER OPTIC
- 11+00 ----- PROJECT CONTROL LINE
- ~~~~~ TREE LINE
- ~~~~~ BRUSH LINE
- X----- EXISTING FENCE
- X----- PROPOSED FENCE
- EXISTING GUARD RAIL
- PROPOSED SLOPE STAKE LINE
- PROPOSED SILT FENCE

TOPOGRAPHY

- 960 EXISTING CONTOURS MAJOR
- 958 EXISTING CONTOURS MINOR
- 960 PROPOSED CONTOUR MAJOR
- 958 PROPOSED CONTOURS MINOR

PARCEL INFORMATION

- 401-069 PARCEL/TAX IDENTIFICATION NUMBER
- #5324 ADDRESS/BUSINESS NAME

PAVEMENT IDENTIFICATION


- ===== EXISTING CURB AND GUTTER

HATCHING LEGEND

- REMOVE PAVEMENT
- REMOVE SIDEWALK
- PROPOSED CONCRETE SIDEWALK
- PROPOSED CONCRETE PAVEMENT
- PROPOSED HMA PAVEMENT
- SAND BACKFILL (PROFILE)

PROPOSED CALLOUTS

- | TOPO CALLOUTS | PLAN VIEW | |
|---------------|-----------|-------------------------------|
| ADJ | ADJ | ADJUST STRUCTURE |
| ADJ-X | ADJ-X | ADJUST STRUCTURE W/ NEW COVER |
| ADJ-B/D | ADJ-B/D | ADJUST STRUCTURE BY OTHERS |
| REC | REC | RECONSTRUCT STRUCTURE |
| REL | REL | RELOCATE |
| REL-B/D | REL-B/D | RELOCATE BY OTHERS |
| REM | R | REMOVE |
| R&R | R&R | REMOVE AND REPLACE |
| SALV | SALV | SALVAGE |
| SAVE | S | SAVE |
| ABN | A | ABANDON |
| CLR | C | CLEARING |
| | B | BULKHEAD |
| | SR-F | SIDEWALK RAMP TYPE |
| | 6 | SOIL EROSION CONTROL MEASURE |

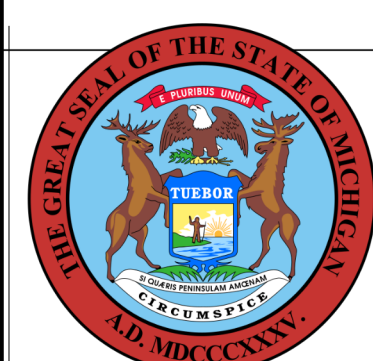

BUILDING
These documents are approved for compliance with the STATE OF MICHIGAN BUILDING CODE subject to field inspection and the conditions of approval.




NO.	REVISION	DATE

STATE OF MICHIGAN
DEPARTMENT OF TECHNOLOGY, MANAGEMENT AND BUDGET
FACILITIES AND BUSINESS SERVICE ADMINISTRATION
DESIGN AND CONSTRUCTION DIVISION
ADAM LACHE, DIRECTOR

FILE NO.
491/20167.SDW

FUNDING CODE 171CODHHS7255 CONTRACT NO. Y22003

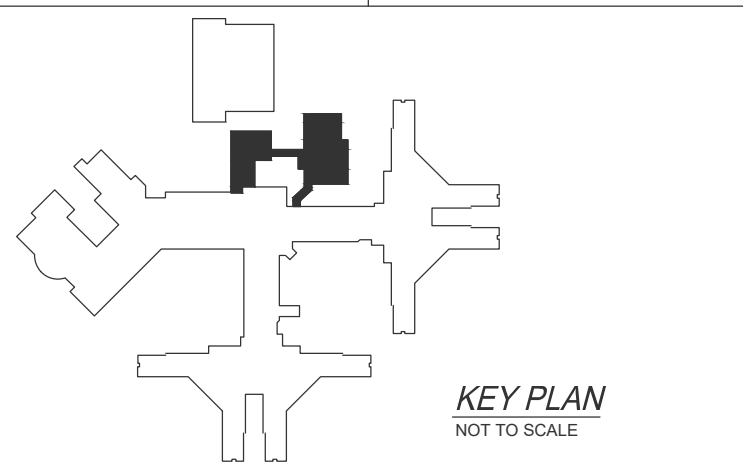

WTAARCH.COM
WTA ARCHITECTS

100 S Jefferson Ave, Suite 601
Saginaw, Michigan 48607
989 752 8107
COPYRIGHT © 2023

ROWE PROFESSIONAL SERVICES COMPANY

PROJECT TITLE
491/20167.SDW CFP - PHASE 500
CENTER FOR FORENSIC PSYCHIATRY - CREATE KITCHEN
SALINE, MICHIGAN

SHEET TITLE
CIVIL LEGEND

PROJECT NUMBER 2021094	SHEET NUMBER C1.01
PROJECT DATE SEPTEMBER 6, 2023	CHECKED BY A.J.T.

GENERAL CONSTRUCTION NOTES

EMERGENCY CONTACTS

BEFORE BEGINNING WORK ON THE PROJECT, THE CONTRACTOR SHALL PROVIDE THE OWNER AND ENGINEER WITH THE NAMES AND TELEPHONE NUMBERS OF EMERGENCY CONTACTS. AT LEAST ONE PERSON REPRESENTING THE CONTRACTOR SHALL BE AVAILABLE TO RESPOND TO EMERGENCIES THROUGHOUT THE LIFE OF THE PROJECT, 24 HOURS A DAY, 7 DAYS A WEEK.

UNDERGROUND UTILITY IDENTIFICATION AND LOCATION

CONTRACTOR TO COMPLETE GROUND PENETRATING RADAR WITHIN CONSTRUCTION LIMITS TO DETERMINE THE EXACT LOCATION OF UNDERGROUND UTILITIES PRIOR TO BEGINNING EXCAVATION.

PUBLIC UTILITIES

EXISTING UTILITIES ARE SHOWN BASED UPON RECORDS AND LOCATIONS PROVIDED BY UTILITY AGENCIES. THE INFORMATION SHOWN IS CONSIDERED APPROXIMATE AND SHALL BE VERIFIED BY THE CONTRACTOR. UNLESS THE PLANS SPECIFICALLY SHOW THAT EXISTING UTILITIES ARE TO BE MOVED, THE CONTRACTOR IS RESPONSIBLE TO PROTECT AND MAINTAIN EXISTING UTILITIES.

VERIFICATION OF UNDERGROUND UTILITIES

THE CONTRACTOR SHALL EXCAVATE AND LOCATE ALL EXISTING UTILITIES IN THE PROJECT AREA IN ADVANCE OF CONSTRUCTION TO VERIFY THEIR ACTUAL LOCATION. POTENTIAL CONFLICTS SHALL BE REPORTED TO THE ENGINEER. THE CONTRACTOR SHALL MAKE SUCH CHANGES TO GRADE AND ALIGNMENT OF PROPOSED WORK AS DIRECTED BY THE ENGINEER TO AVOID CONFLICTS, AT NO INCREASE IN COST TO THE OWNER.

UTILITY SERVICE

UNLESS SPECIFICALLY PROVIDED OTHERWISE IN THE CONTRACT DOCUMENTS, ALL EXISTING UTILITIES ARE TO REMAIN IN SERVICE DURING THE PROJECT.

PRIVATE IRRIGATION SYSTEMS

THE CONTRACTOR SHALL COORDINATE WITH THE FACILITY TO DETERMINE THE LOCATION OF THE IRRIGATION SYSTEM PRIOR TO THE START OF CONSTRUCTION. THE SYSTEM IS TO BE REVISED TO ACCOMMODATE PROPOSED SITE WORK.

SOIL BORINGS / PAVEMENT CORES

IF PROVIDED ON THE PLANS OR IN THE CONTRACT DOCUMENTS, LOGS OF SOIL BORINGS OR PAVEMENT CORES REPRESENT THE SUBSURFACE CONDITIONS ENCOUNTERED AT SPECIFIC POINTS. THE INFORMATION IS PROVIDED FOR THE CONTRACTOR'S INFORMATION ONLY.

MAINTAINING TRAFFIC

LOCAL AND EMERGENCY TRAFFIC SHALL BE MAINTAINED AT ALL TIMES WITHIN THE PROJECT AREA.

WHEN EXCAVATION, FRESH CONCRETE, OR OTHER CONSTRUCTION WORK WILL RESULT IN THE CLOSURE OF A STREET OR DRIVEWAY FOR A PERIOD OF TIME, THE CONTRACTOR IS RESPONSIBLE TO NOTIFY ALL AFFECTED RESIDENTS AND BUSINESSES IN ADVANCE.

THE CONTRACTOR SHALL NOTIFY EMERGENCY RESPONSE AGENCIES IN ADVANCE OF ROAD CLOSURES OR THE ESTABLISHMENT OF DETOURS.

SCHEDULE

THE CONTRACTOR SHALL COMPLETE ALL WORK IN AN EXPEDITIOUS MANNER AND SHALL NOT STOP WORK ON THE PROJECT ONCE BEGUN.

ALIGNMENT

ALIGNMENT AND GRADES FOR CURB AND GUTTER (INCLUDING THROUGH RAMPS AND DRIVEWAY OPENINGS) SHOWN ON THE PLANS ARE FOR THE TOP, BACK OF CURB, UNLESS SPECIFICALLY SHOWN OTHERWISE ON THE PLANS.

THE HORIZONTAL ALIGNMENT SHOWN ON THE DRAWINGS FOR DRAINAGE STRUCTURES LOCATED IN THE CURB LINE IS TO THE CENTER OF THE CASTING.

THE HORIZONTAL ALIGNMENT SHOWN ON THE DRAWINGS FOR DRAINAGE STRUCTURES WHICH ARE NOT IN THE CURB LINE AND FOR MANHOLES IS TO THE CENTER OF THE STRUCTURE.

WHERE RIM ELEVATIONS ARE PROVIDED ON THE PLANS FOR MANHOLE CASTINGS, THE ELEVATION PROVIDED IS FOR THE TOP OF THE CASTING.

WHERE RIM ELEVATIONS ARE PROVIDED FOR INLET TYPE CASTINGS, THE ELEVATIONS ARE PROVIDED AS FOLLOWS:

- CURB INLETS – THE ELEVATION OF THE TOP OF CURB
- ALL OTHER INLETS – THE ELEVATION OF THE FLOW LINE

WHERE RIM ELEVATIONS ARE PROVIDED ON THE PLANS FOR INLETS OR MANHOLE CASTINGS, THE ELEVATIONS PROVIDED ARE CONSIDERED PRELIMINARY. THE CONTRACTOR SHALL MAKE THE FINAL ADJUSTMENT FOLLOWING THE ESTABLISHMENT OF ACTUAL GRADING AND PAVEMENT ELEVATIONS.

CONSTRUCTION STAKING

WHEN CONSTRUCTION STAKING IS TO BE PROVIDED BY THE ENGINEER OR OWNER, THE CONTRACTOR SHALL REQUEST STAKING AT LEAST THREE WORKING DAYS IN ADVANCE.

WHEN CONSTRUCTION STAKING IS TO BE PROVIDED BY THE ENGINEER OR OWNER, STAKING WILL BE PROVIDED ONE TIME. THE CONTRACTOR SHALL PROTECT AND PRESERVE SURVEY CONTROL AND STAKING. RE-STAKING WILL BE AT THE CONTRACTOR'S EXPENSE.

SURVEY CORNERS, BENCHMARKS, AND CONTROL POINTS

THE CONTRACTOR SHALL PRESERVE ALL GOVERNMENT CORNERS, PROPERTY CORNERS, BENCHMARKS, SURVEY CONTROL POINTS AND OTHER SURVEY POINTS WITHIN THE PROJECT AREA. WHERE CORNERS, BENCHMARKS, OR SURVEY POINTS ARE ENCOUNTERED WHICH WILL BE DISTURBED BY THE CONTRACTOR'S ACTIVITIES, A LICENSED SURVEYOR SHALL WITNESS THE POINT BEFORE DISTURBANCE AND SHALL RE-SET THE POINT FOLLOWING THE COMPLETION OF CONSTRUCTION ACTIVITIES. THE CONTRACTOR SHALL PAY THE SURVEYOR TO WITNESS AND TO RE-SET THE POINTS.

PROTECTION OF TREES, SHRUBS, AND LANDSCAPING

ALL TREES, SHRUBS, AND LANDSCAPING WITHIN THE CONSTRUCTION AREA WHICH ARE NOT SPECIFICALLY DESIGNATED FOR REMOVAL SHALL BE PROTECTED FROM DAMAGE BY THE CONTRACTOR. DAMAGED TREES, SHRUBS, AND LANDSCAPING SHALL BE REPLACED AT THE CONTRACTOR'S EXPENSE.

CONSTRUCTION SIGNING AND BARRICADING

THE CONTRACTOR SHALL PROTECT HAZARDOUS AREAS WITH BARRICADES. BARRICADES LEFT IN PLACE AFTER SUNSET SHALL BE LIGHTED.

THE CONTRACTOR SHALL PROVIDE SUITABLE SANDBAGS OR OTHER SUITABLE MEASURES FOR ANCHORING OF TEMPORARY SIGNS AND BARRICADES, TO PREVENT THEIR TIPPING OR DISPLACEMENT BY WIND OR AIR FLOW FROM VEHICLES.

THE CONTRACTOR SHALL PROVIDE SIGNING, BARRICADES, TRAFFIC REGULATORS, CONES, AND OTHER TRAFFIC CONTROL DEVICES IN ACCORDANCE WITH THE REQUIREMENTS OF THE AGENCY HAVING JURISDICTION OVER STREETS OR ROADS IN THE PROJECT AREA, THE CURRENT MICHIGAN MANUAL OF UNIFORM TRAFFIC CONTROL DEVICES, AND THE PLANS AND SPECIFICATIONS.

THE CONTRACTOR SHALL COVER OR REMOVE TEMPORARY SIGNS DURING PERIODS WHEN THEY ARE NOT APPROPRIATE.

TURF ESTABLISHMENT

ALL DISTURBED AREAS WHICH ARE NOT TO BE SURFACED WITH PAVEMENT, AGGREGATE OR OTHER APPROVED SURFACES SHALL BE ESTABLISHED WITH TURF.

TURF AREAS SHALL BE GRADED TO PROVIDE POSITIVE DRAINAGE.

DISTURBED AREAS SHALL BE SURFACED WITH FOUR INCHES OF SCREENED TOPSOIL.

THE CONTRACTOR IS RESPONSIBLE TO ESTABLISH TURF WHICH IS SUBSTANTIALLY FREE OF BARE SPOTS AND FREE OF WEEDS. THE GROUND SURFACE IN TURF AREAS SHALL BE SMOOTH AND PROVIDE A NATURAL TRANSITION TO ADJACENT, UNDISTURBED AREAS.

THE CONTRACTOR IS RESPONSIBLE TO PROVIDE WATERING, WEEDING, RESEEDING, AND REWORKING AS NECESSARY TO ESTABLISH TURF AREAS TO THE REQUIRED STANDARD.

ADA COMPLIANCE

ALL PROPOSED CONSTRUCTION SHALL COMPLY WITH THE PROVISIONS OF THE AMERICANS WITH DISABILITIES ACT (ADA), AND APPLICABLE GUIDELINES OR STANDARDS. WHERE EXISTING CONDITIONS AND/OR THE REQUIREMENTS OF THE PLANS WILL RESULT IN FINISHED CONDITIONS THAT DO NOT MEET THE ADA REQUIREMENTS, GUIDELINES, OR STANDARDS; THE CONTRACTOR SHALL NOTIFY THE ENGINEER BEFORE PROCEEDING WITH CONSTRUCTION. THE CONTRACTOR IS RESPONSIBLE TO REMOVE AND REPLACE WORK DETERMINED TO BE NOT IN ACCORDANCE WITH APPLICABLE REQUIREMENTS, GUIDELINES, OR STANDARDS.

EARTHWORK

THE CONTRACTOR SHALL MAKE HIS OWN DETERMINATION OF THE EARTHWORK QUANTITIES, AND BASE HIS BID ON HIS DETERMINATION OF THE QUANTITIES OF WORK REQUIRED.

IF ADDITIONAL FILL MATERIAL MUST BE PROVIDED TO ATTAIN THE FINISH GRADES SHOWN ON THE PLANS, THE CONTRACTOR SHALL PROVIDE THE REQUIRED FILL MATERIAL, UNLESS A SPECIFIC BORROW AREA IS IDENTIFIED ON THE PLANS.

EXCESS SOILS RESULTING FROM EXCAVATION AND EARTHWORK SHALL BECOME THE CONTRACTOR'S PROPERTY AND DISPOSED OF PROPERLY, UNLESS AN AREA(S) HAS BEEN DESIGNATED FOR STOCKPILING OR "BLENDING IN" THE EXCESS MATERIAL WITHIN THE PROJECT LIMITS.

BACKFILL AND EMBANKMENT

BACKFILL OF AN EXCAVATION UNDER OR WITHIN THE ONE ON ONE INFLUENCE OF AN EXISTING OR PROPOSED ROAD, SIDEWALK, DRIVEWAY, PAVEMENT, OR AGGREGATE SURFACE, SHALL BE SAND, MEETING THE REQUIREMENTS OF GRANULAR MATERIAL CLASS II AS DESCRIBED IN THE CURRENT MICHIGAN DEPARTMENT OF TRANSPORTATION STANDARD SPECIFICATIONS FOR CONSTRUCTION. THE SAND BACKFILL SHALL BE COMPACTED TO AT LEAST 95% OF ITS MAXIMUM UNIT WEIGHT.

BACKFILL OF AN EXCAVATION WHICH IS NOT UNDER OR WITHIN THE ONE ON ONE INFLUENCE OF AN EXISTING OR PROPOSED ROAD, SIDEWALK, DRIVEWAY, PAVEMENT, OR AGGREGATE SURFACE MAY BE SUITABLE EXCAVATED MATERIAL OR OTHER SOIL, WHICH IS FREE OF ORGANIC MATTER, STONES AND ROCKS, ROOTS, BROKEN CONCRETE, FROZEN MATERIAL, OR DEBRIS. THE BACKFILL SHALL BE COMPACTED TO AT LEAST 90% OF ITS MAXIMUM UNIT WEIGHT.

THE CONTRACTOR SHALL INDICATE THE SOURCE OF SAND USED FOR BACKFILL TO THE ENGINEER, AND PROVIDE THE ENGINEER WITH THE RESULTS OF A GRADATION TEST PERFORMED ON A SAMPLE OF THE SAND. THE CONTRACTOR SHALL NOTIFY THE ENGINEER IN ADVANCE OF USING SAND FROM OTHER SOURCES.

EMBANKMENT USED TO BUILD THE SUBGRADE TO REQUIRED ELEVATION SHALL BE SUITABLE SOIL EXCAVATED FROM THE PROJECT SITE, OR FURNISHED BY THE CONTRACTOR FROM OTHER SOURCES. SUITABLE SOIL IS FREE FROM ORGANIC MATTER, ROCKS AND STONES, FROZEN MATERIAL, BROKEN CONCRETE, AND DEBRIS.

EMBANKMENT CONSTRUCTED OF GRANULAR SOILS SHALL BE COMPACTED IN LIFTS NOT EXCEEDING 10 INCHES TO AT LEAST 95% OF ITS MAXIMUM UNIT WEIGHT.

EMBANKMENT CONSTRUCTED OF COHESIVE SOILS SHALL BE COMPACTED IN LIFTS NOT EXCEEDING 10 INCHES TO AT LEAST 95% OF ITS MAXIMUM UNIT WEIGHT.

DENSITY TESTING

THE MAXIMUM UNIT WEIGHT OF SAND AND OTHER GRANULAR SOILS WILL BE DETERMINED BY THE ONE POINT CONE TEST, AS DESCRIBED IN THE MICHIGAN DEPARTMENT OF TRANSPORTATION'S DENSITY TESTING AND INSPECTION MANUAL, EXCEPT WHEN ANOTHER TEST METHOD IS SPECIFIED.

THE MAXIMUM UNIT WEIGHT OF COHESIVE SOILS WILL BE DETERMINED BY THE ONE POINT PROCTOR TEST, AS DESCRIBED IN THE MICHIGAN DEPARTMENT OF TRANSPORTATION'S DENSITY TESTING AND INSPECTION MANUAL, EXCEPT WHEN ANOTHER TEST METHOD IS SPECIFIED.

DRAINAGE

THE CONTRACTOR SHALL MAINTAIN DRAINAGE OF THE PROJECT AREA AND ADJACENT AREAS. WHERE EXISTING DRAINAGE FACILITIES ARE DISTURBED OR BLOCKED BY CONSTRUCTION, THE CONTRACTOR SHALL PROVIDE AND MAINTAIN TEMPORARY PROVISIONS FOR DRAINAGE.

WHERE CONSTRUCTION HAS DISTURBED EXISTING DITCHES, SWALES, OR OTHER DRAINAGE FACILITIES; THE CONTRACTOR SHALL RESTORE THEM TO THEIR GRADES AND DIMENSIONS WHICH EXISTED PRIOR TO THE BEGINNING OF CONSTRUCTION, UNLESS DIRECTED OTHERWISE.

DRAINAGE SHALL NOT BE REROUTED ONTO ADJACENT PROPERTIES NOR ALLOWED TO DRAIN ONTO ADJACENT PROPERTIES AT AN INCREASED RATE, AS A RESULT OF THE CONTRACTOR'S WORK.

SIDEWALK CONSTRUCTION

SIDEWALKS SHALL BE CONSTRUCTED TO PROVIDE POSITIVE DRAINAGE OF THE SIDEWALK AND ADJACENT SURFACES.

EXCEPT WHERE NECESSARY TO PROVIDE POSITIVE DRAINAGE OR MEET EXISTING SURFACES, SIDEWALK SHALL BE CONSTRUCTED WITH A CROSS SLOPE SLOPED TOWARD THE STREET.

SIDEWALK CROSS SLOPES SHALL NOT EXCEED 2%.

IN TURF AREAS, THE SURFACE OF THE SIDEWALK SHALL BE ABOUT 1/4 INCH HIGHER THAN THE ADJACENT GROUND SURFACES, EXCEPT WHERE NECESSARY TO PROVIDE POSITIVE DRAINAGE OR MEET EXISTING SIDEWALKS, CURBS, OR PAVEMENTS.

SIDEWALK SHALL BE CONSTRUCTED ON A SAND BASE, COMPACTED TO AT LEAST 95% OF ITS MAXIMUM UNIT WEIGHT.

THE CONTRACTOR SHALL NOTIFY THE ENGINEER WHEN SIDEWALK FORMS HAVE BEEN SET AND THE SAND BASE PREPARED. CONCRETE SHALL NOT BE PLACED UNTIL THE ENGINEER HAS OBSERVED THE FORMS. CONCRETE DELIVERY SHALL BE SCHEDULED TO ALLOW SUFFICIENT TIME FOR ADJUSTMENT OF THE FORMS, IN THE EVENT THAT ADJUSTMENT IS NECESSARY.

THE CONTRACTOR SHALL PROTECT FRESH CONCRETE FROM DAMAGE BY THE WEATHER, TRAFFIC, OR VANDALISM. DAMAGED CONCRETE SHALL BE REPLACED BY THE CONTRACTOR'S EXPENSE.

STORM SEWER CONSTRUCTION NOTES

DRAINAGE STRUCTURES SHALL BE CONSTRUCTED FROM PRECAST CONCRETE MANHOLE SECTIONS, MEETING ASTM C478.

SUMPS IN DRAINAGE STRUCTURES AND PIPELINES SHALL BE FREE OF SEDIMENT AND DEBRIS AT THE TIME OF ACCEPTANCE BY THE OWNER.

ROAD PROJECTS

ADJUSTING STRUCTURES

WHERE CASTINGS FOR MANHOLES, CATCH BASINS, INLETS, VALVE BOXES, AND MONUMENT BOXES ARE TO BE ADJUSTED TO MEET A NEW PAVEMENT SURFACE ELEVATION, THE FINAL ADJUSTMENT SHALL NOT BE COMPLETED UNTIL ALL PAVEMENT COURSES HAVE BEEN PLACED EXCEPT THE FINAL COURSE. THE FINAL ADJUSTMENT SHALL BE COMPLETED JUST PRIOR TO PLACEMENT OF THE FINAL COURSE OF PAVEMENT.

THE MATERIALS AND PROCEDURES FOR ADJUSTING STRUCTURES SHALL MEET THE REQUIREMENTS OF THE AGENCIES HAVING JURISDICTION OVER THE ROAD AND UTILITIES.

SUBGRADE PREPARATION

TOPSOIL, PEAT, AND ORGANIC MATERIAL SHALL BE EXCAVATED AND REMOVED.

SOFT AND YIELDING SOILS SHALL BE REMOVED OR DRIED IF THE RESULT OF EXCESSIVE MOISTURE CONTENT.

PRIOR TO CONSTRUCTING FILLS, SUBBASE, OR PAVEMENT ON A SUBGRADE, THE SUBGRADE SHALL BE PROOF-ROLLED TO DETERMINE THE SUITABILITY OF THE SUBGRADE. THE CONTRACTOR SHALL DRIVE A HEAVY PIECE OF WHEELED CONSTRUCTION EQUIPMENT OVER THE SUBGRADE WHILE THE ENGINEER IS OBSERVING. THE CONSTRUCTION OF FILLS, SUBBASE, OR PAVEMENTS SHALL NOT PROCEED UNTIL THE SUBGRADE HAS BEEN DEMONSTRATED TO BE FREE OF SOFT AREAS.

THE CONTRACTOR IS RESPONSIBLE TO MAINTAIN THE MOISTURE CONTENT OF SUBGRADE SOILS WITHIN A SUITABLE RANGE TO ALLOW FOR COMPACTION TO THE REQUIRED DENSITY. WHEN THE SOIL IS TOO DRY, THE CONTRACTOR SHALL ADD WATER. WHEN THE SOIL IS TOO WET, THE CONTRACTOR SHALL PROVIDE DRAINAGE OR AERATE THE SOIL.

THE SURFACE OF THE SUBGRADE SHALL BE COMPACTED TO AT LEAST 95% OF ITS MAXIMUM UNIT WEIGHT, PRIOR TO CONSTRUCTING FILLS, SUBBASE, OR PAVEMENTS.

HOT MIX ASPHALT (HMA) PAVING

PAVEMENTS WHICH ARE TO BE OVERLAID WITH A NEW PAVEMENT COURSE SHALL BE SWEEPED TO REMOVE ALL DIRT AND DEBRIS.

A BITUMINOUS BOND COAT SHALL BE APPLIED TO PAVEMENTS WHICH ARE TO BE OVERLAID WITH A NEW PAVEMENT COURSE AND ALLOWED TO CURE PRIOR TO CONSTRUCTING THE NEW PAVEMENT COURSE.

HMA PAVEMENT SHALL NOT BE PLACED WHEN THE SURFACE BEING OVERLAID IS WET, OR WHEN RAIN IS FORECAST OR THREATENING.

DRIVEWAY CONSTRUCTION

DRIVEWAY SLOPES SHALL NOT EXCEED 10%, EXCEPT WHERE SPECIFICALLY INDICATED OTHERWISE ON THE PLANS OR DIRECTED BY THE ENGINEER.

THE CONTRACTOR SHALL PROVIDE PROPERTY OWNERS WITH SUITABLE NOTICE BEFORE REMOVING AND REPLACING AN EXISTING DRIVEWAY.

WATER MAIN CONSTRUCTION NOTES

HYDRANTS, VALVES, AND OTHER MATERIALS SHALL MEET THE OWNER'S STANDARDS, WITH REGARD TO MANUFACTURER AND MODEL, AND DETAILS SUCH AS OPENING DIRECTION, HYDRANT COLOR, HYDRANT CONFIGURATION, AND HYDRANT THREAD PATTERN.

WATER MAIN MATERIALS:	
HYDRANT	5 1/4 INCH AMERICAN FLOW CONTROL PACER OR EAST JORDAN IRON WORKS, BR5; WITH 5 1/4 INCH AMERICAN FLOW CONTROL PACER OR EAST JORDAN IRON WORKS, BR5; WITH COLOR: RED
VALVES	RESILIENT WEDGE GATE VALVES (MUELLER OR EAST JORDAN), OPENS COUNTER CLOCKWISE

NEW WATER MAIN SHALL NOT BE CONNECTED TO THE EXISTING WATER MAIN WITHOUT THE APPROVAL OF THE OWNER.

AT LEAST TEN FEET OF HORIZONTAL AND EIGHTEEN INCHES OF VERTICAL SEPARATION SHALL BE MAINTAINED BETWEEN THE WATER MAIN AND SEWERS (STORM OR SANITARY).

THE DEPTH OF BURY SHOWN ON THE PLANS SHALL BE PROVIDED, AS A MINIMUM, OVER THE TOP OF THE WATER MAIN PIPE TO THE FINISHED GROUND OR PAVEMENT SURFACE. UNLESS SPECIFICALLY DIRECTED OTHERWISE ON THE DRAWINGS, THE DEPTH OF BURY SHOWN ON THE PLANS SHALL BE MAINTAINED BETWEEN THE BOTTOM OF DITCHES AND THE TOP OF THE PIPE.

ALL BENDS, TEES, PLUGS, HYDRANTS, VALVES, AND OTHER FITTINGS WHERE THRUST MAY OCCUR SHALL BE RESTRAINED APPROPRIATELY BY THRUST BLOCKS OR JOINT RESTRAINT.

EXISTING WATER VALVES SHALL BE OPERATED ONLY BY THE WATER DEPARTMENT'S PERSONNEL.

THE SHUTTING DOWN OF EXISTING WATER MAINS TO ALLOW FOR COMPLETING THE CONTRACTOR'S WORK SHALL BE SCHEDULED IN ADVANCE BY THE CONTRACTOR WITH THE OWNER. THE CONTRACTOR SHALL PROVIDE NOTIFICATION TO AFFECTED WATER CUSTOMERS IN AT LEAST A DAY IN ADVANCE OF ANY SCHEDULED SERVICE DISRUPTIONS.

THE CONTRACTOR SHALL EXPOSE EXISTING MAINS TO VERIFY THE SIZE, MATERIALS, AND ANY FITTINGS NECESSARY BEFORE SHUTTING DOWN EXISTING WATER MAINS FOR NEW CONNECTIONS. ALL FITTINGS, PARTS, AND EQUIPMENT NECESSARY TO COMPLETE THE PROPOSED CONNECTIONS TO THE EXISTING MAIN SHALL BE AVAILABLE AT THE SITE BEFORE THE EXISTING MAIN IS SHUT DOWN.

THE COMPLETED WATER MAIN SHALL BE SUBJECTED TO A HYDROSTATIC PRESSURE. THE TEST PRESSURE SHALL BE 150 PSI. THE TEST DURATION SHALL BE 2 HOURS. THE CONTRACTOR SHALL CONDUCT SUCH PRELIMINARY TESTING TO EXPEL AIR AND VERIFY THAT THERE ARE NO LEAKS IN THE PIPELINE. THE TEST SHALL BE WITNESSED BY THE ENGINEER OR OWNER. THE CONTRACTOR SHALL NOTIFY THE ENGINEER OR OWNER AT LEAST 24 HOURS IN ADVANCE OF THE TIME FOR TESTING.

IF THE CONTRACTOR ELECTS TO PRESSURE TEST AGAINST AN EXISTING VALVE, THE OWNER DOES NOT GUARANTEE THAT EXISTING VALVES CAN RESIST THE TEST PRESSURE. IF THE CONTRACTOR BELIEVES THAT AN EXISTING VALVE IS THE CAUSE OF A FAILED PRESSURE TEST, THE CONTRACTOR SHALL EITHER REPAIR THE VALVE AND RETEST OR TEST AGAINST A PLUG, AT THEIR EXPENSE.

UNLESS SPECIFICALLY PROVIDED OTHERWISE, THE CONTRACTOR IS RESPONSIBLE TO FURNISH WATER FOR TESTING AND DISINFECTION.

WATER FROM THE CONTRACTOR'S FLUSHING AND DISINFECTION ACTIVITIES SHALL BE DISPOSED OF TO PREVENT EROSION OR FLOODING.

THE CONTRACTOR SHALL FURNISH AND INSTALL CORPORATIONS, TAPS, PIPING, AND FITTINGS AS NECESSARY TO COMPLETE THE REQUIRED FLUSHING AND TESTING FOR ACCEPTANCE. AFTER ACCEPTANCE, THE CONTRACTOR SHALL REMOVE ALL CORPORATIONS, TAPS, PIPING, AND FITTINGS USED FOR FLUSHING AND TESTING. TAPS TO THE WATER MAIN SHALL BE PLUGGED WITH BRASS PLUGS.

TAPS FOR SERVICE CONNECTIONS SHALL BE COMPLETED UNDER PRESSURE. THE CORPORATION AND SERVICE LEAD SHALL BE VISUALLY CHECKED FOR LEAKAGE WHILE UNDER PRESSURE. ALL JOINTS SHALL REMAIN EXPOSED UNTIL THE ENGINEER HAS OBSERVED THEM.

CORPORATIONS SHALL BE LEFT IN THE "OPEN" POSITION. CURB STOPS FOR FUTURE CONNECTIONS SHALL BE LEFT "CLOSED". CURB STOPS FOR CURRENT WATER CUSTOMERS SHALL BE LEFT "OPEN" ONCE CONNECTED.

SANITARY SEWER CONSTRUCTION NOTES

THE NEW SANITARY SEWER SHALL NOT BE CONNECTED TO THE EXISTING SEWER UNTIL APPROVED BY THE OWNER.

AT LEAST TEN FEET OF HORIZONTAL AND EIGHTEEN INCHES OF VERTICAL SEPARATION SHALL BE MAINTAINED BETWEEN THE SEWER AND EXISTING WATER MAINS.

MANHOLES SHALL BE CONSTRUCTED FROM PRECAST CONCRETE MANHOLE SECTIONS, MEETING ASTM C443. MANHOLE JOINTS SHALL BE MADE WITH RUBBER O-RING GASKETS. THE SECTION BETWEEN THE TOP OF THE PRECAST CONE AND THE BOTTOM OF THE CASTING SHALL BE CONSTRUCTED OF PRECAST GRADE RINGS, OF TOTAL THICKNESS SO THAT THE MANHOLE CASTING IS PLACED AT THE PROPER FINAL ELEVATION, EXCEPT THAT THE TOTAL THICKNESS SHALL NOT EXCEED TEN INCHES.

MANHOLE STEPS SHALL BE EQUALLY SPACED AT 15 INCHES. THE DISTANCE FROM THE TOP STEP TO THE TOP OF THE MANHOLE CASTING SHALL NOT EXCEED 16 INCHES.


THE CONTRACTOR SHALL CONDUCT A LOW PRESSURE AIR TEST ON ALL SANITARY SEWERS LESS THAN 24 INCHES IN DIAMETER. THE AIR TEST SHALL MEET THE REQUIREMENTS OF ASTM C 924 FOR CONCRETE PIPE AND ASTM F1471 FOR PLASTIC PIPE. IN AREAS WHERE GROUNDWATER IS OVER THE PIPE, THE TEST PRESSURE SHALL BE INCREASED EQUAL TO THE HYDRAULIC PRESSURE EXERTED BY THE WATER OVER THE PIPE, AS DETERMINED BY THE ENGINEER.



NO.	REVISION	DATE



FILE NO. 491/20167.SDW	CONTRACT NO. Y22003
FUNDING CODE 171CODHHS7255	

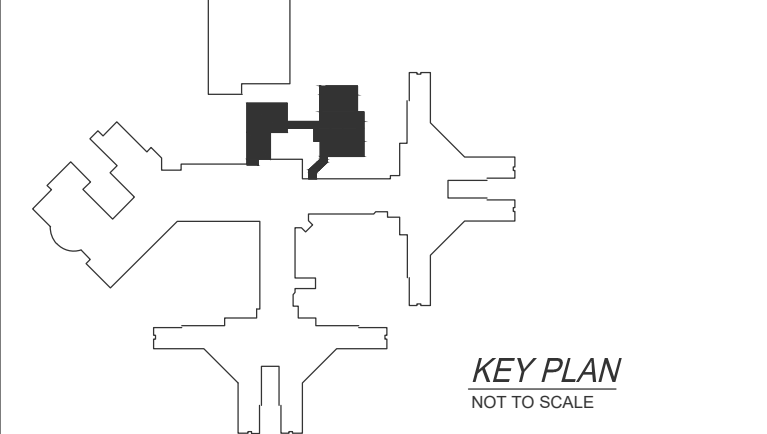

KEY PLAN
NOT TO SCALE

WTAARCHITECTS
100 S Jefferson Ave, Suite 601
Saginaw, Michigan 48607
989 752 8107
COPYRIGHT © 2023


ROWE PROFESSIONAL SERVICES COMPANY

PROJECT TITLE
491/20167.SDW CFP – PHASE 500
CENTER FOR FORENSIC PSYCHIATRY – CREATE KITCHEN
SALINE, MICHIGAN


SHEET TITLE
CIVIL NOTES

PROJECT NUMBER 2021094	SHEET NUMBER
PROJECT DATE SEPTEMBER 6, 2023	C1.02
CHECKED BY A.J.T.	


BUILDING
These documents are approved for compliance with the STATE OF MICHIGAN BUILDING CODE subject to field inspection and the conditions of approval.

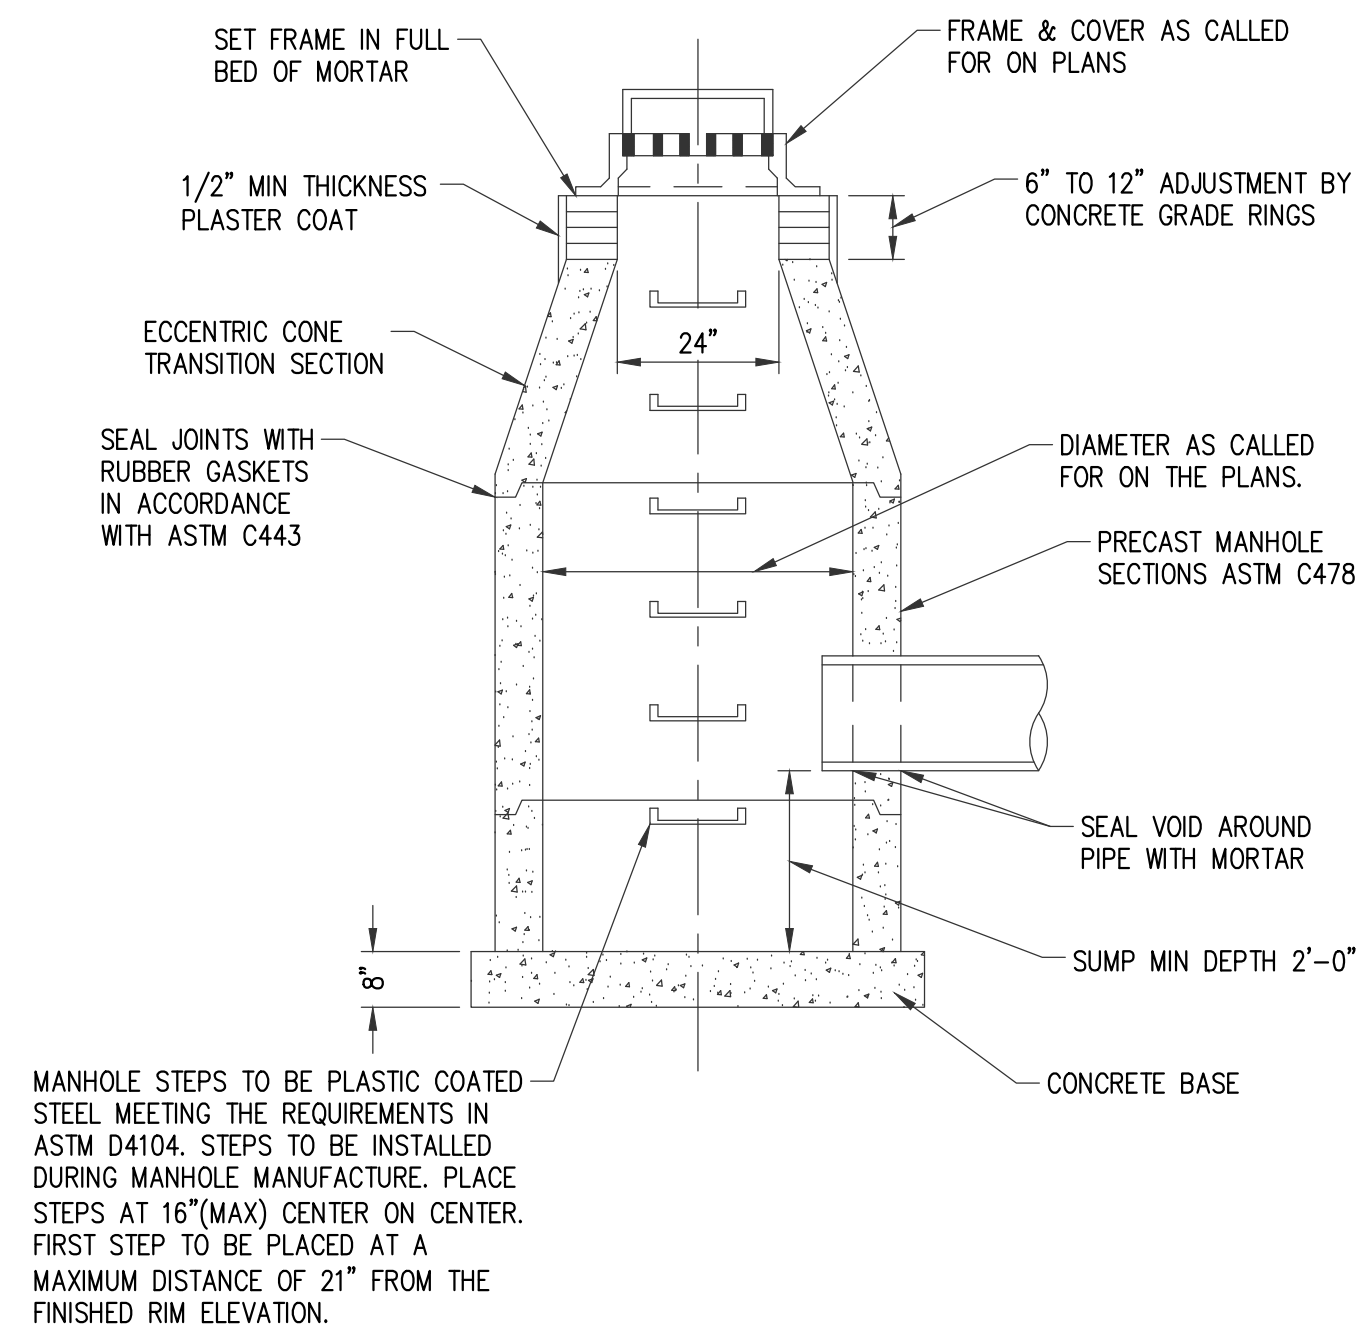


STANDARD DRAINAGE STRUCTURE WITH 2' SUMP
NOT TO SCALE

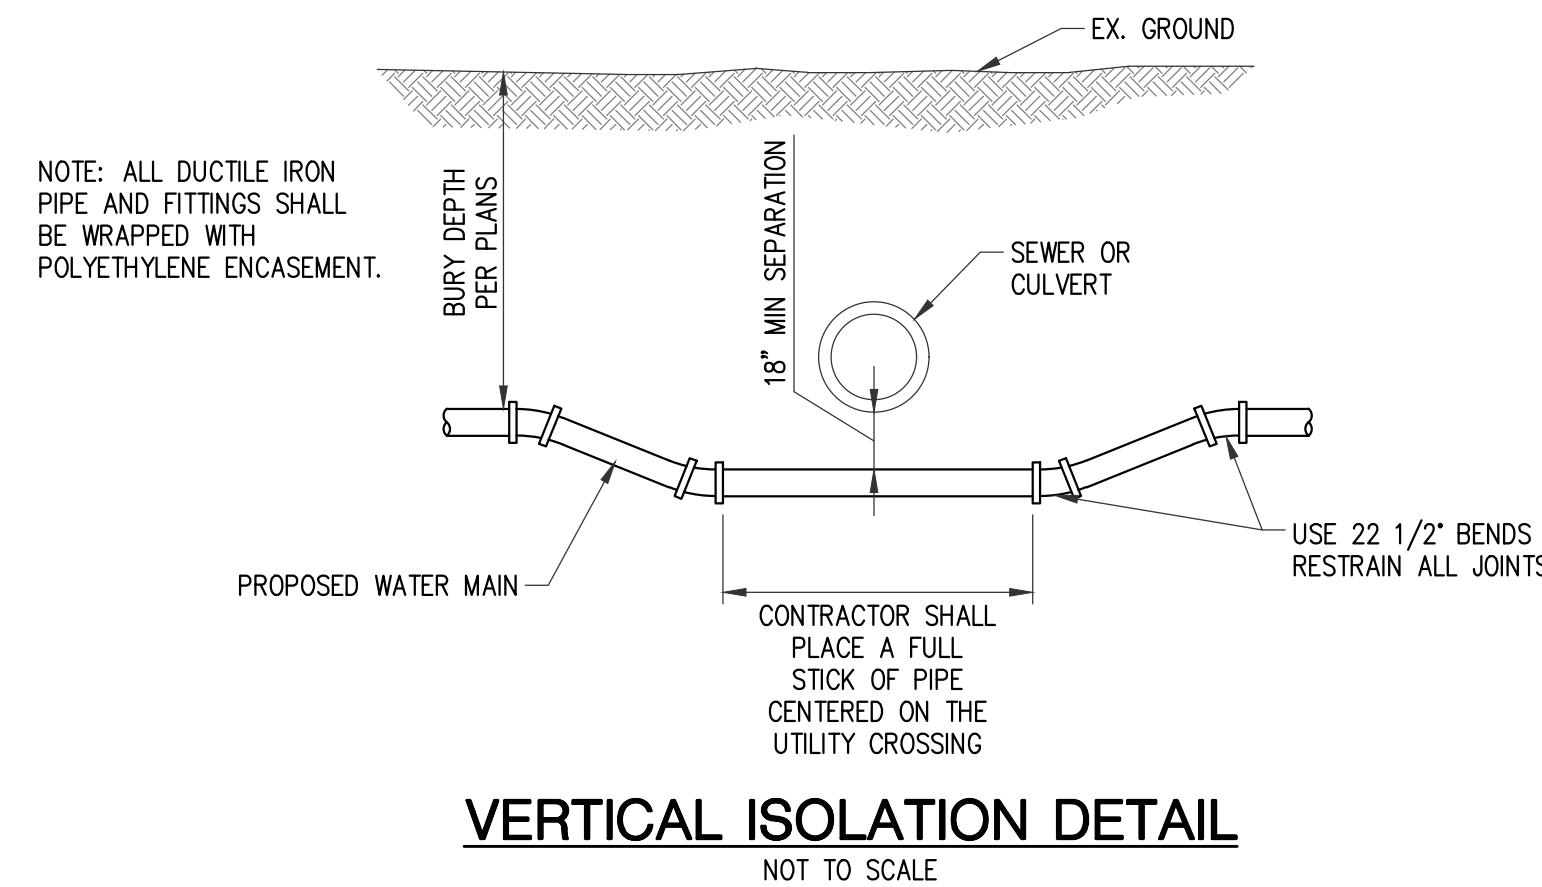


VERTICAL ISOLATION DETAIL
NOT TO SCALE

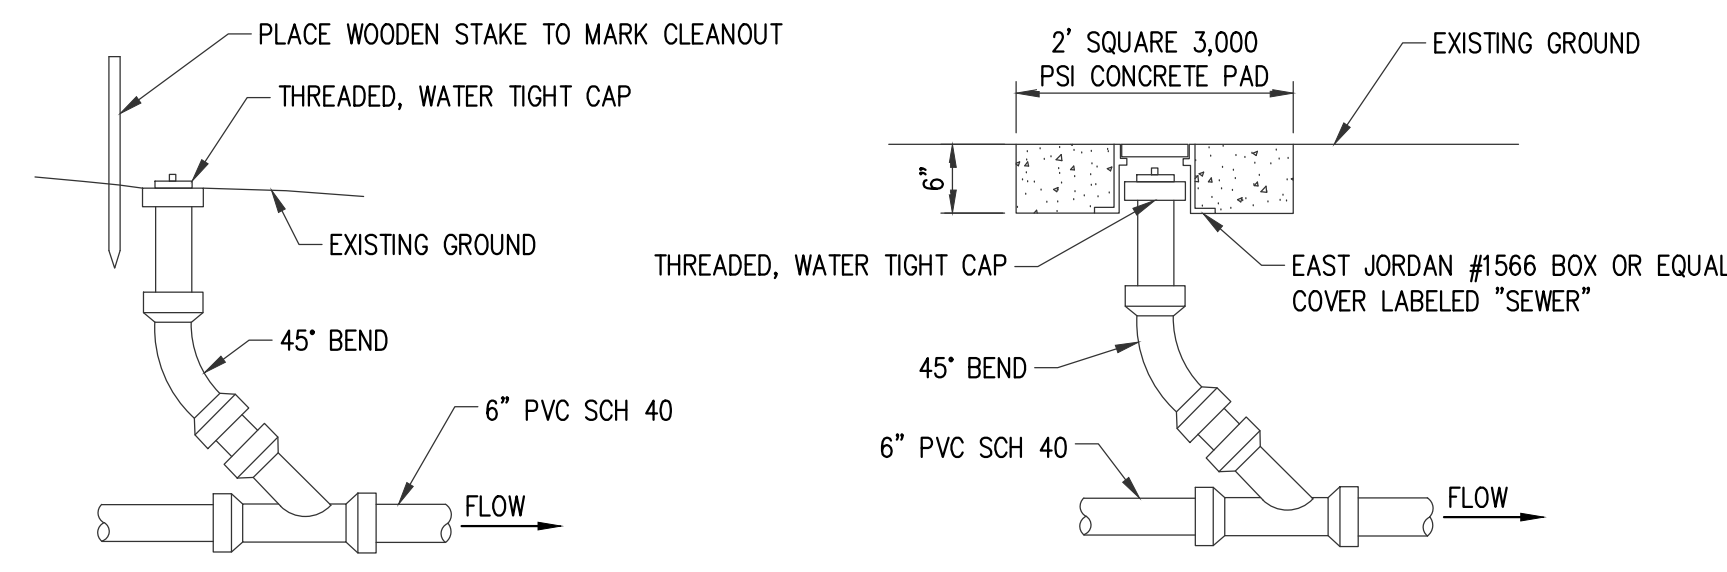

CLEANOUT RISER DETAIL
NOT TO SCALE

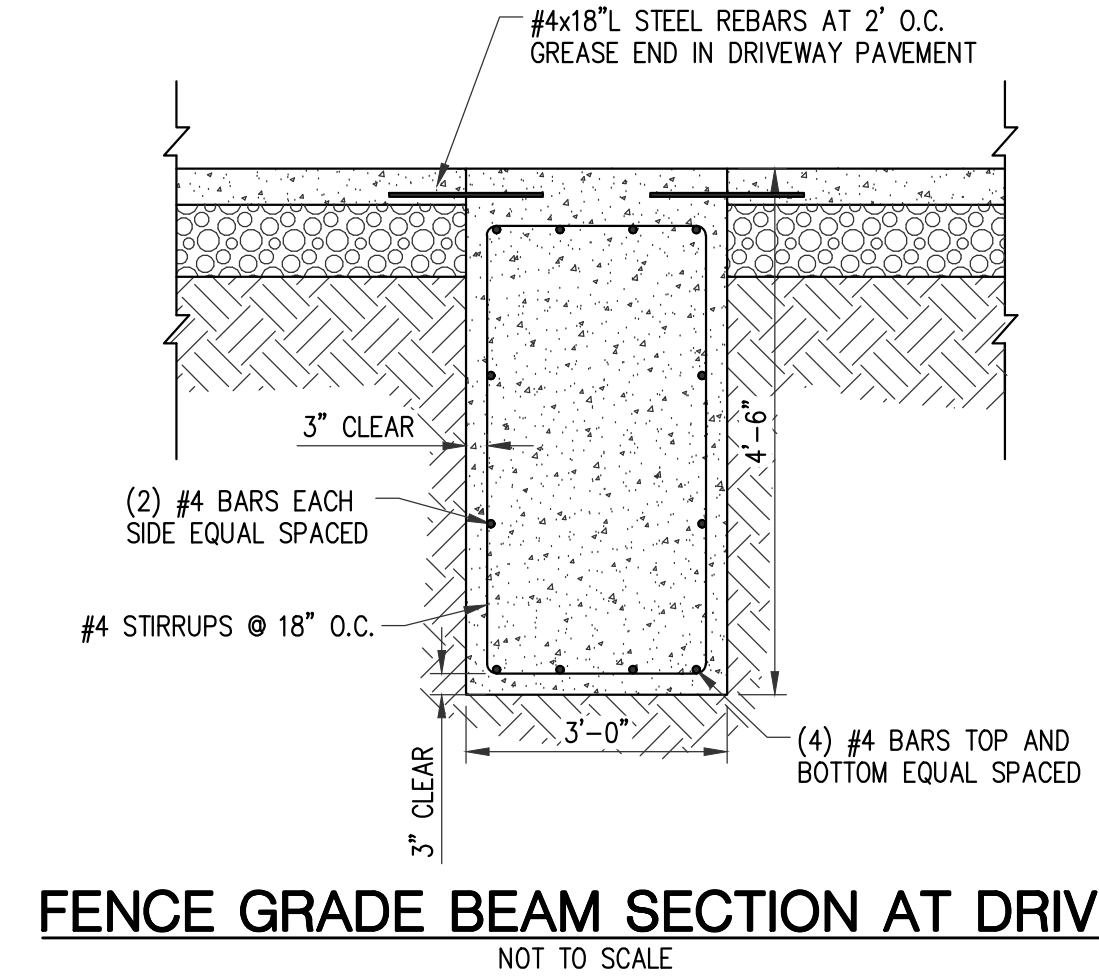

FENCE GRADE BEAM SECTION AT DRIVE
NOT TO SCALE

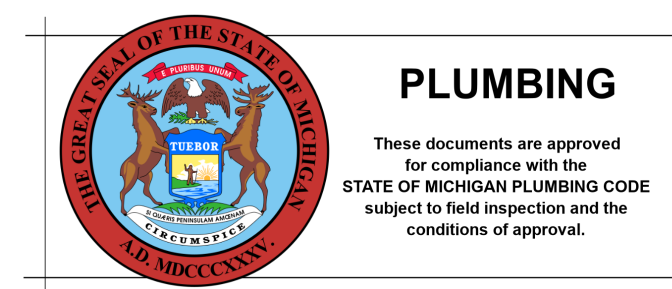


PLUMBING
These documents are approved for compliance with the STATE OF MICHIGAN PLUMBING CODE subject to field inspection and the conditions of approval.

DIA. OF PIPE OR BRANCH OF TEE	90° BEND			45° BEND			22 1/2° BEND 11 1/4° BEND			PLUGS, HYDRANTS AND TEE		
	A	B	C	A	B	C	A	B	C	A	B	C
6"	2'-0"	2'-0"	0'-9"	2'-0"	1'-0"	0'-9"	2'-0"	1'-0"	0'-9"	2'-0"	2'-0"	1'-0"
8"	3'-0"	2'-0"	1'-0"	2'-6"	2'-0"	1'-3"	2'-0"	1'-0"	1'-0"	3'-0"	2'-0"	1'-9"
12"	4'-0"	3'-0"	1'-6"	3'-0"	3'-0"	1'-6"	2'-0"	2'-0"	1'-6"	4'-0"	3'-0"	2'-0"
16"	6'-0"	4'-0"	1'-6"	4'-0"	4'-0"	1'-6"	3'-0"	3'-0"	1'-6"	5'-0"	4'-0"	2'-0"
24"	8'-0"	6'-0"	2'-0"	5'-0"	5'-0"	2'-0"	4'-0"	4'-0"	2'-0"	8'-0"	6'-0"	2'-6"


TABLE INDICATES MINIMUM BEARING

THRUST BLOCK DETAILS
NOT TO SCALE

NOTE:
1. USE 2,500 PSI CONCRETE FOR ALL THRUST BLOCKS.
2. POUR AGAINST UNDISTURBED SOIL.
3. KEEP BOLTS, FITTINGS AND JOINTS CLEAR OF CONCRETE.
4. BEARING AREA IS BASED ON 2,000 PSI SOIL CAPACITY.

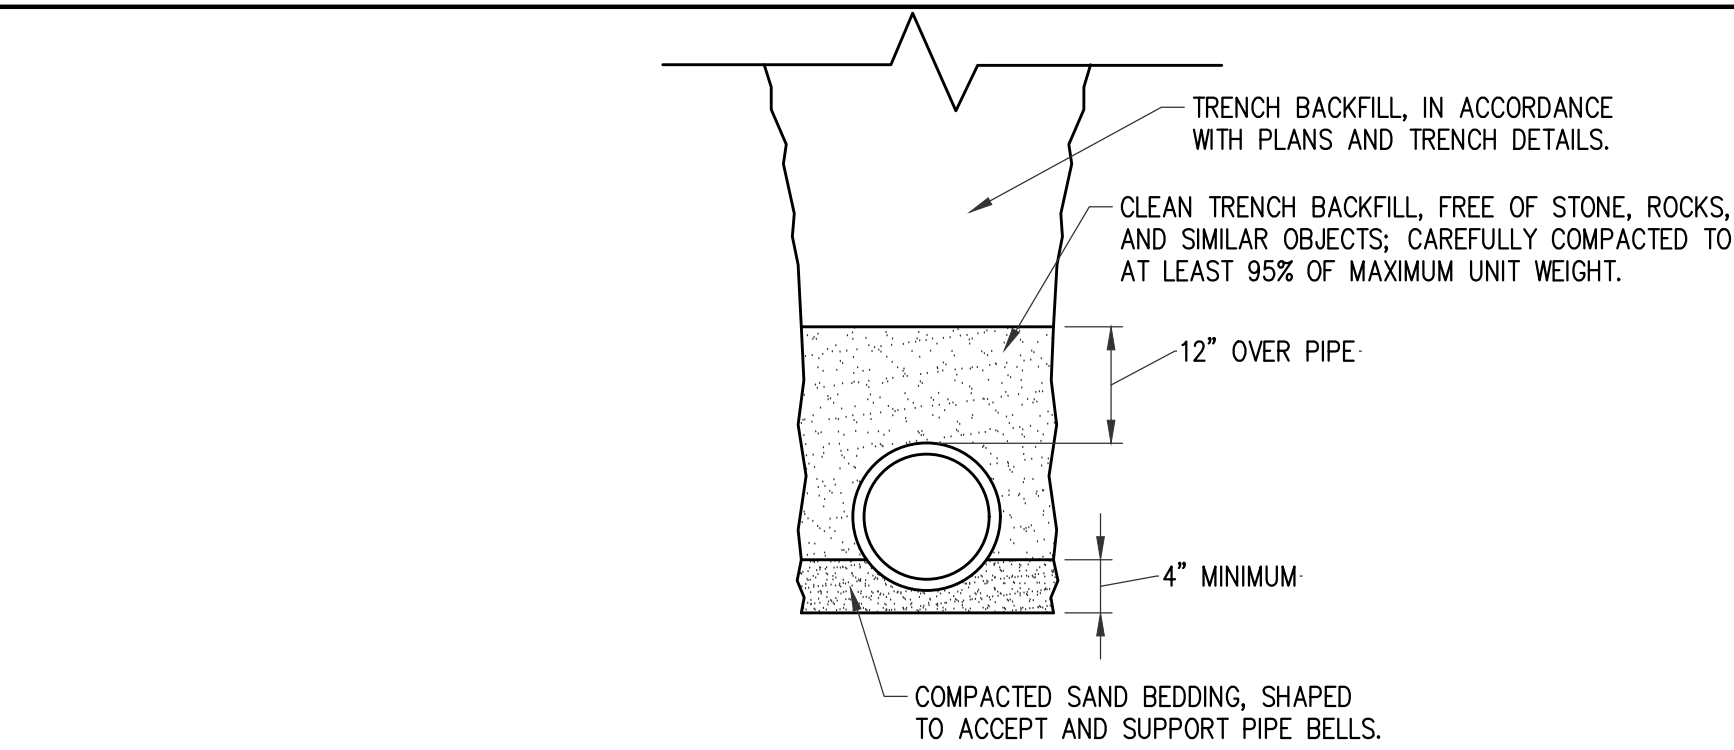


GRAVITY PIPE BEDDING DETAIL - SAND BEDDING

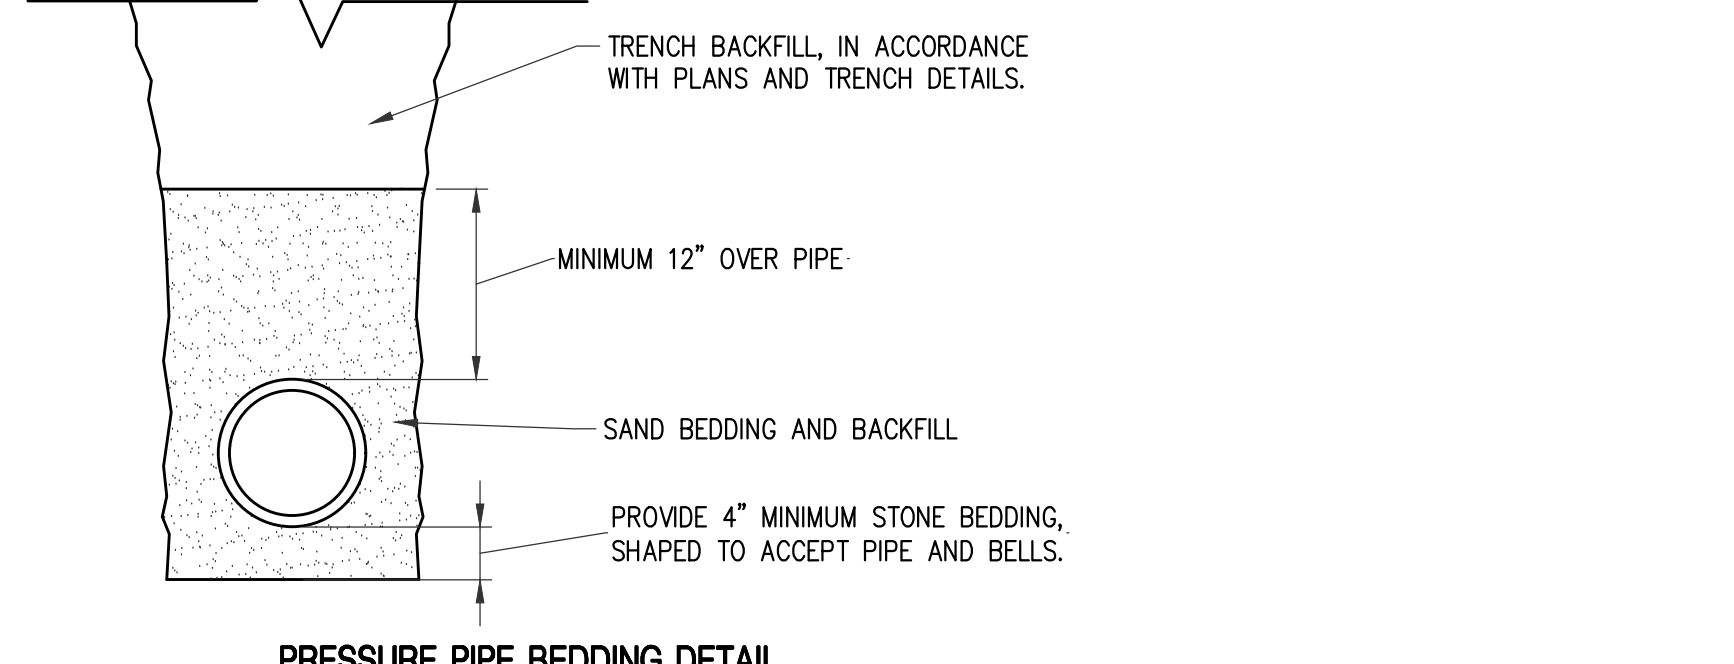

PRESSURE PIPE BEDDING DETAIL


- NOTES:
1. SAND SHALL BE M00T GRANULAR MATERIAL CLASS II.
2. SAND SHALL BE COMPACTED TO 95% OF ITS MAXIMUM UNIT WEIGHT.

PIPE BEDDING DETAIL
NOT TO SCALE

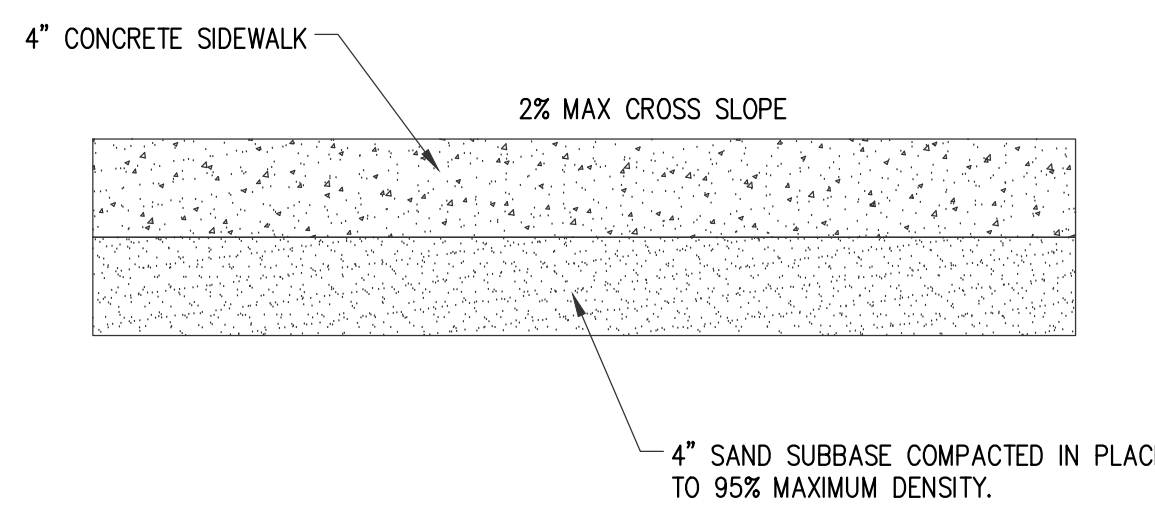

SIDEWALK DETAIL
NOT TO SCALE


- NOTES:
1. SEAL ALL EXPANSION JOINTS, BUILDING TO SIDEWALK JOINTS, SIDEWALK TO BRICK JOINTS, AND CURB TO BRICK JOINTS WITH SELF LEVELING POLYURETHANE JOINT SEALANT (GRAY) OR EQUAL.

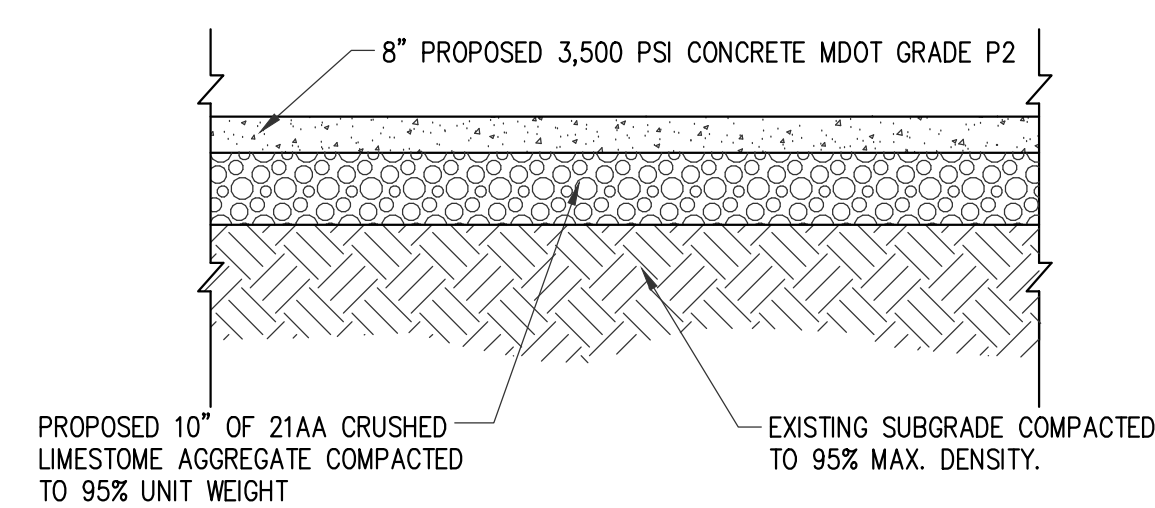


CONCRETE PAVEMENT CROSS SECTION
NOT TO SCALE

- NOTES:
1. SEAL ALL EXPANSION JOINTS WITH 1/2\"/>

- NOTES:
1. ALL PRESSURE TAPS MUST BE INSTALLED IN A CONCRETE VALVE MANHOLE.
2. CONTRACTOR SHALL LOCATE AND EXPOSE EXISTING WATER MAIN. THE CONTRACTOR WILL PROVIDE ANY FITTINGS NECESSARY TO COMPLETE TRANSITION(S) FROM EXISTING MAIN TO PROPOSED CONSTRUCTION.
3. THE VALVE SHALL HAVE ONE FLANGED END (CONNECTED TO THE SLEEVE) AND ONE MECHANICAL JOINT END (CONNECTED TO THE PIPELINE).
4. THE VALVE SHALL HAVE OVERSIZE SEAT RINGS TO PERMIT ENTRY OF THE TAPPING MACHINE CUTTERS.
5. THE VALVE SHALL MEET ALL REQUIREMENTS OF AWWA C500.
6. THE MINIMUM SIZE MANHOLE SHALL BE 6'-0\"/>

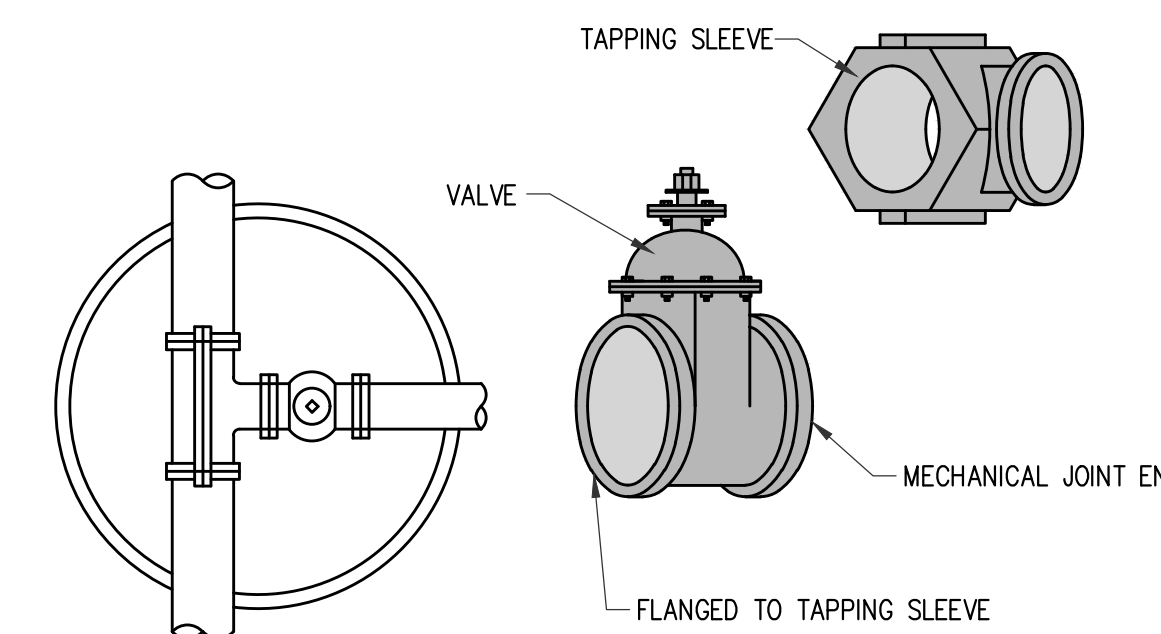


PRESSURE TAPPING SLEEVE & VALVE DETAIL
NOT TO SCALE

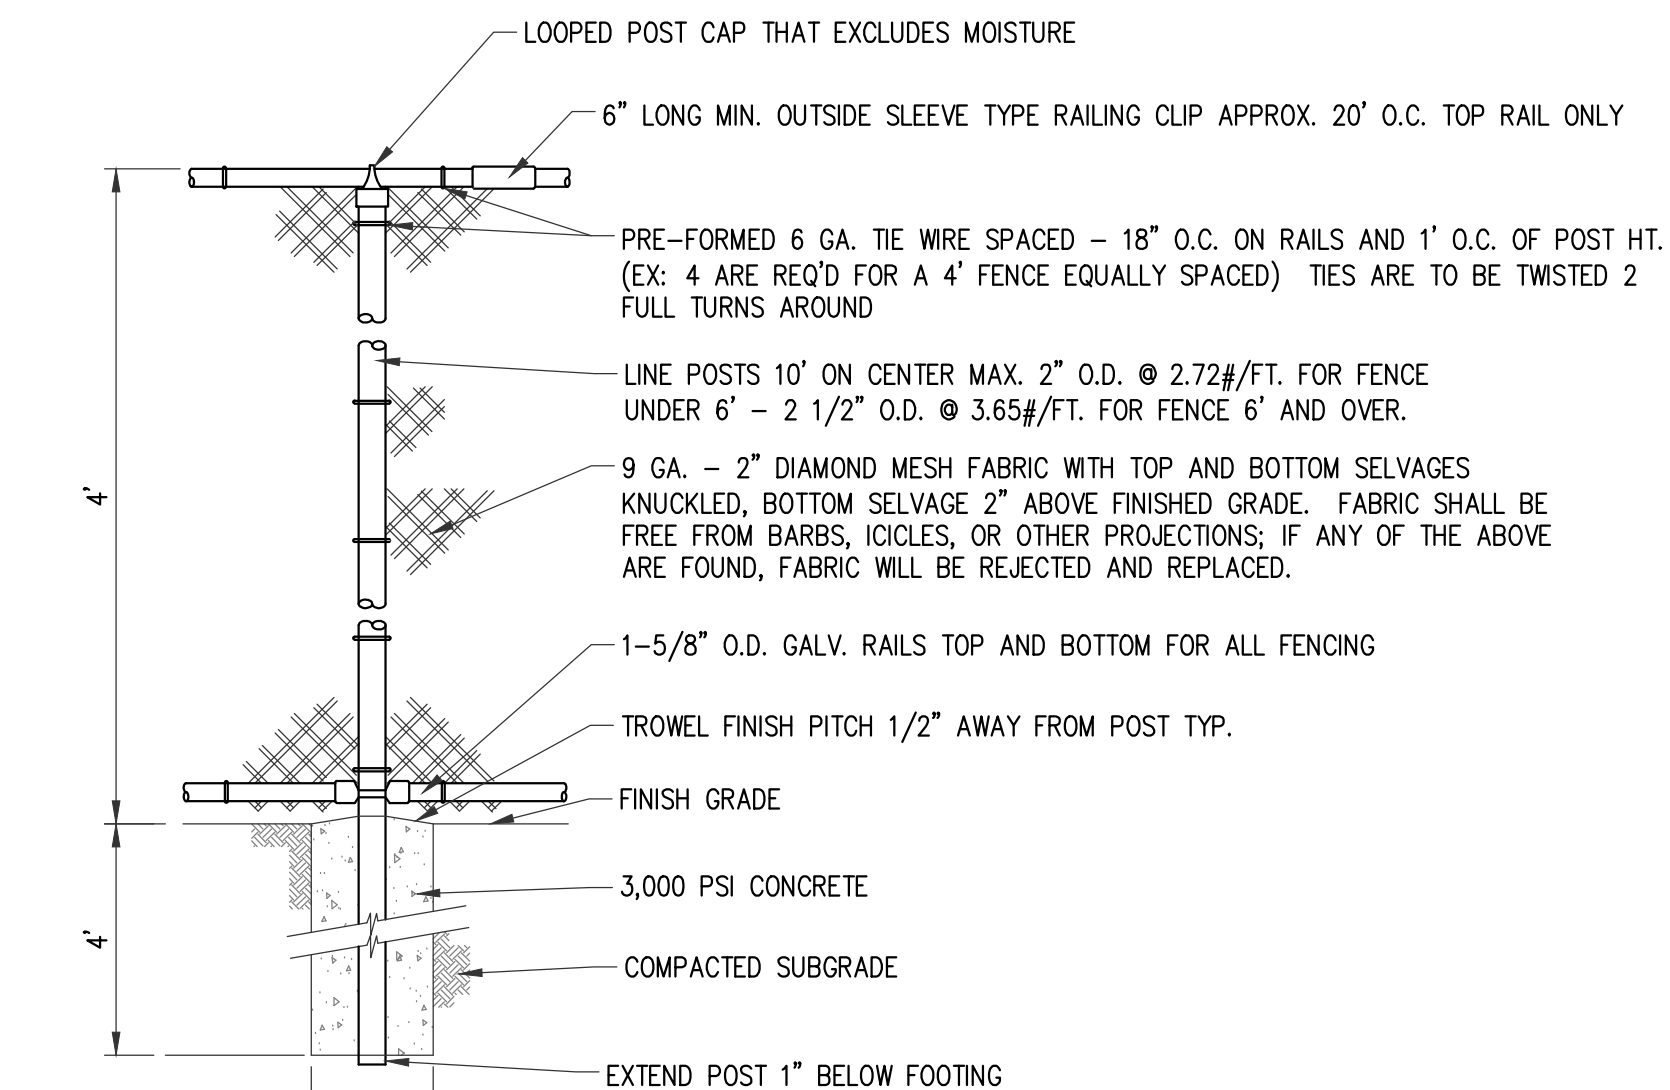


CHAIN LINK FENCE DETAIL
NOT TO SCALE

- NOTES:
1. ALL POSTS AND RAILS TO BE SCHEDULE 40 OR APPROVED EQUAL.
2. FENCE TO BE VINYL COATED.
3. COLOR TO BE AS SELECTED BY OWNER.

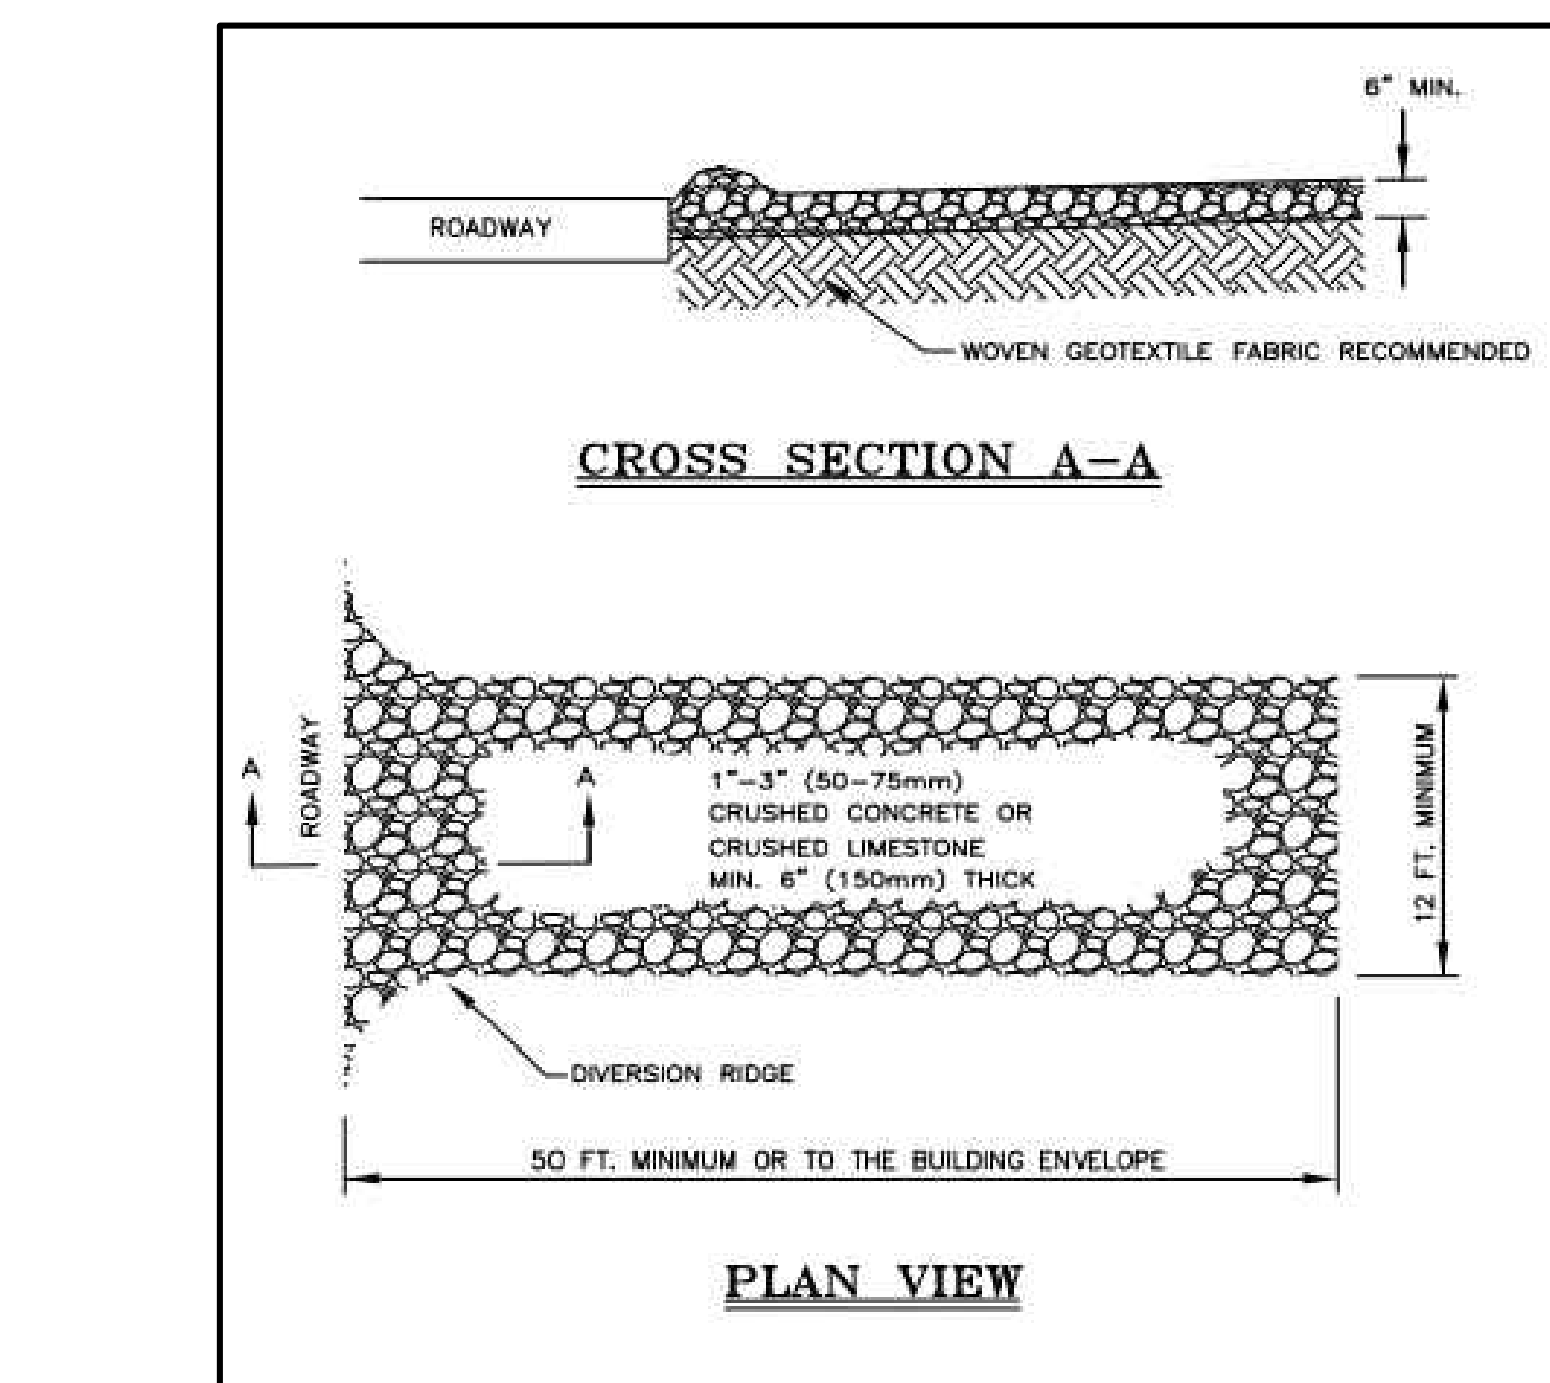


CONSTRUCTION ACCESS DRIVE DETAIL
NOT TO SCALE

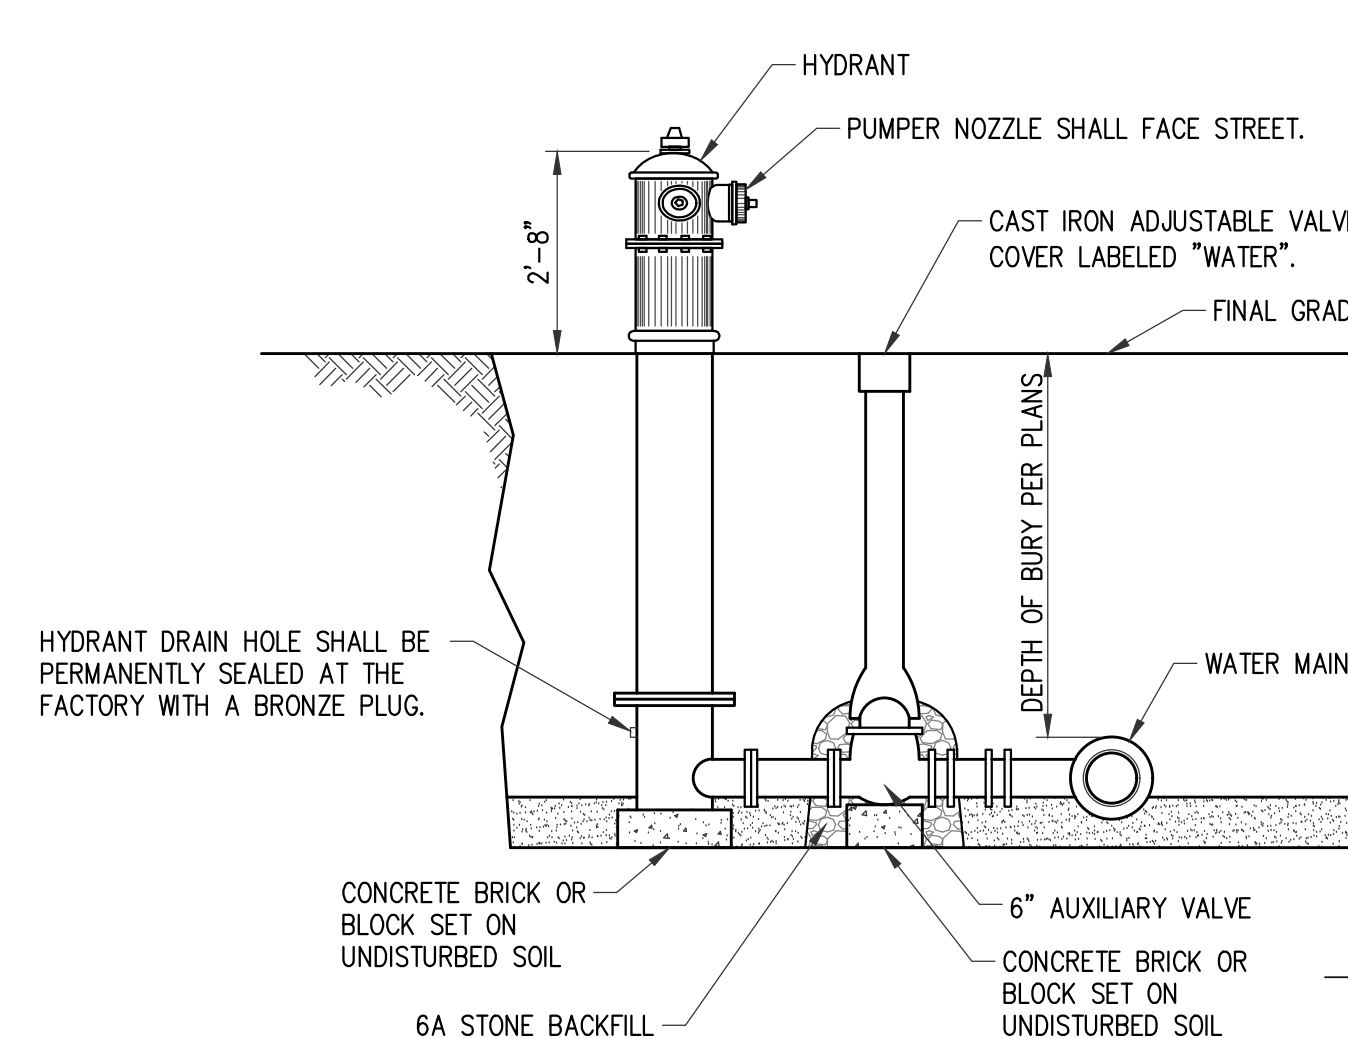

FIRE HYDRANT DETAIL
NOT TO SCALE

- NOTES:
1. ACCEPTABLE METHODS OF RESTRAINT ARE:
A. CONCRETE THRUST BLOCK
B. ANCHORING FITTINGS
C. APPROVED RESTRAINED JOINT

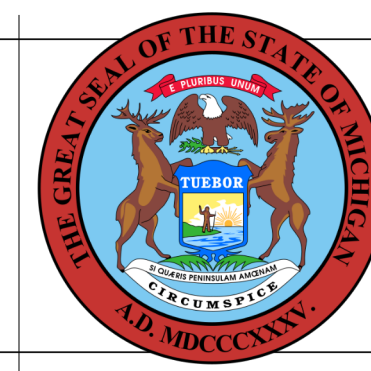

BUILDING


These documents are approved for compliance with the STATE OF MICHIGAN BUILDING CODE subject to field inspection and the conditions of approval.

- NOTES:
1. THIS TABLE IS BASED ON A TEST PRESSURE OF 180 PSI (OPERATING PRESSURE + WATER HAMMER.) FOR OTHER TEST PROCEDURES, ALL VALUES ARE TO BE INCREASED OR DECREASED PROPORTIONALLY.
2. IN EACH DIRECTION FROM POINT OF DEFLECTION OR TERMINATION EXCEPT FOR A TEE AT WHICH ONLY THE BRANCH IN THE DIRECTION OF THE TEE STEM.
3. IF THE RODS ARE USED, PLACE 2 RODS 5/8 INCH DIAMETER MINIMUM FOR WATER MAIN 6 INCH TO 10 INCH AND 4 RODS 5/8 INCH DIAMETER MINIMUM FOR 12 INCH AND LARGER.

PIPE RESTRAINT SCHEDULE
NOT TO SCALE


MINIMUM PIPE RESTRAINT SCHEDULE FOR GROUND BURIED PRESSURE PIPES (SEE NOTE 1)

PIPE DIAMETER	LENGTH (IN FEET) OF RESTRAINT REQUIRED (SEE NOTE 2)						
	22 1/2°	33 3/4°	45°	56 1/4°	67 1/2°	78 3/4°	90° TEE OR DEAD END
6"	3	6	11	16	23	29	37
8"	4	8	15	22	31	41	50
10"	5	11	18	28	38	49	61
12"	6	13	22	33	45	59	73
14"	7	14	25	37	52	68	84
16"	8	16	28	42	59	77	95
18"	8	18	31	47	66	86	107
20"	9	20	35	53	73	95	118
24"	11	23	40	61	85	111	138
30"	13	29	50	75	105	136	170
36"	15	34	59	88	123	160	199
42"	17	39	67	101	141	184	228
48"	19	43	75	113	157	206	255

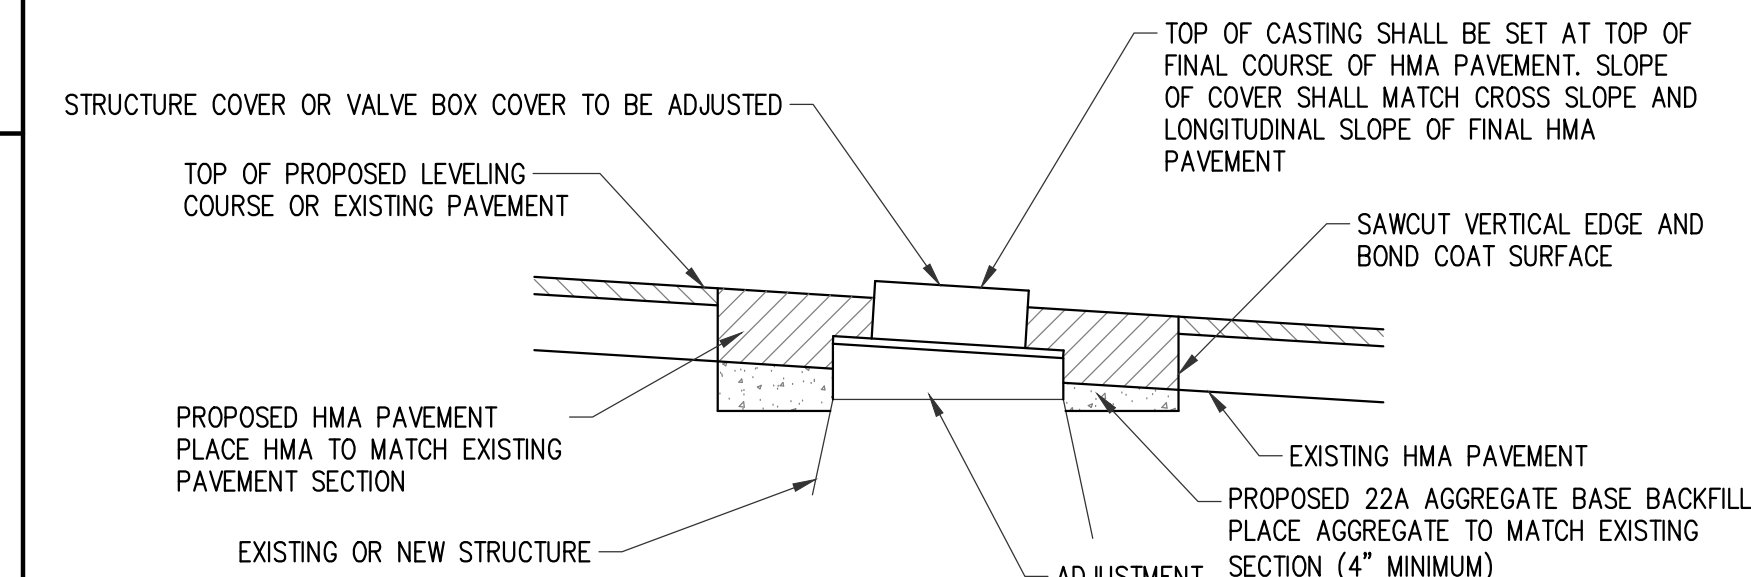

STRUCTURE COVER ADJUST DETAIL - HMA BASE
NOT TO SCALE

- NOTE:
1. STRUCTURE ADJUST SHALL BE CUT IN A DIAMOND WITH A MINIMUM 2' DISTANCE FROM THE CASTING.
2. CONCRETE BACKFILL WILL NOT BE PERMITTED. ALL COSTS OF BACKFILL (AGGREGATE AND HMA) INCLUDED IN COST OF ADJUSTMENT OR NEW STRUCTURE AND WILL NOT BE PAID FOR SEPARATELY.

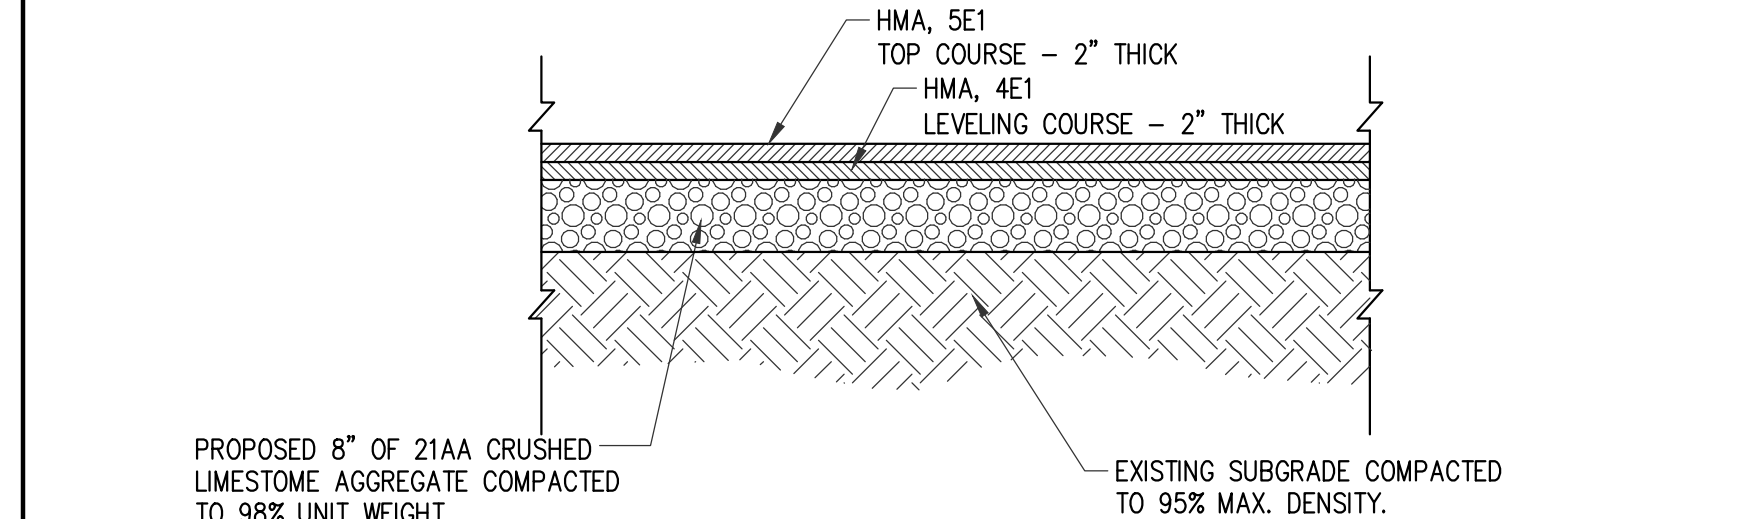

HMA APPLICATION CHART

HMA PAVEMENT	THICKNESS	PERFORMANCE GRADE	REMARKS
HMA, 5E1 (TOP)	2"	58-28	TOP COURSE (AW=220 MIN.)
HMA, 4E1 (LEVELING)	2"	58-28	LEVELING COURSE

HMA PAVEMENT CROSS SECTION
NOT TO SCALE




NO.	REVISION	DATE

STATE OF MICHIGAN
DEPARTMENT OF TECHNOLOGY, MANAGEMENT AND BUDGET
FACILITIES AND BUSINESS SERVICE ADMINISTRATION
DESIGN AND CONSTRUCTION DIVISION
ADAM LACHE DIRECTOR

FILE NO.
491/20167.SDW

FUNDING CODE
171CODHHS7255

CONTRACT NO.
Y22003

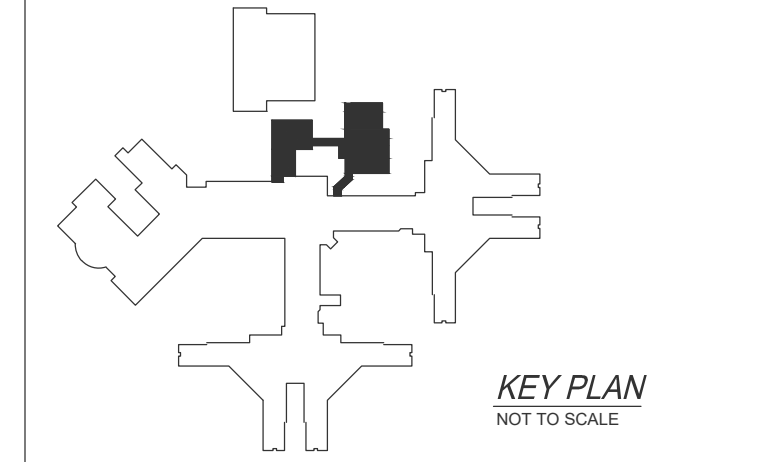

KEY PLAN
NOT TO SCALE

WTAARCH.COM
WTA ARCHITECTS
100 S Jefferson Ave, Suite 601
Saginaw, Michigan 48807
989 752 8107
COPYRIGHT © 2023

ROWE PROFESSIONAL SERVICES COMPANY

PROJECT TITLE
491/20167.SDW CFP - PHASE 500

CENTER FOR FORENSIC PSYCHIATRY - CREATE KITCHEN
SALINE, MICHIGAN

SHEET TITLE
CIVIL DETAILS














PROJECT NUMBER
2021094

SHEET NUMBER

PROJECT DATE
SEPTEMBER 6, 2023


C1.03

CHECKED BY
A.J.T.

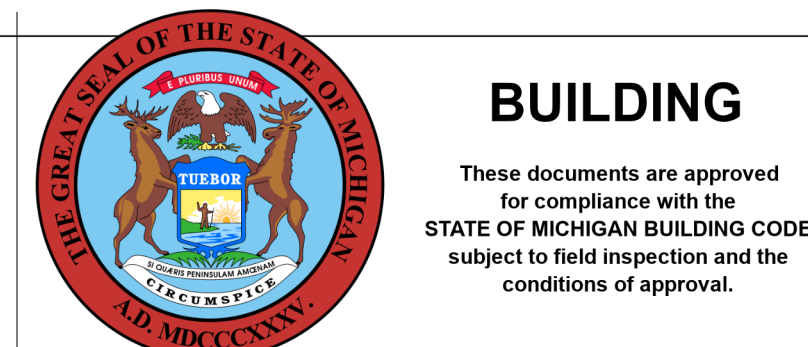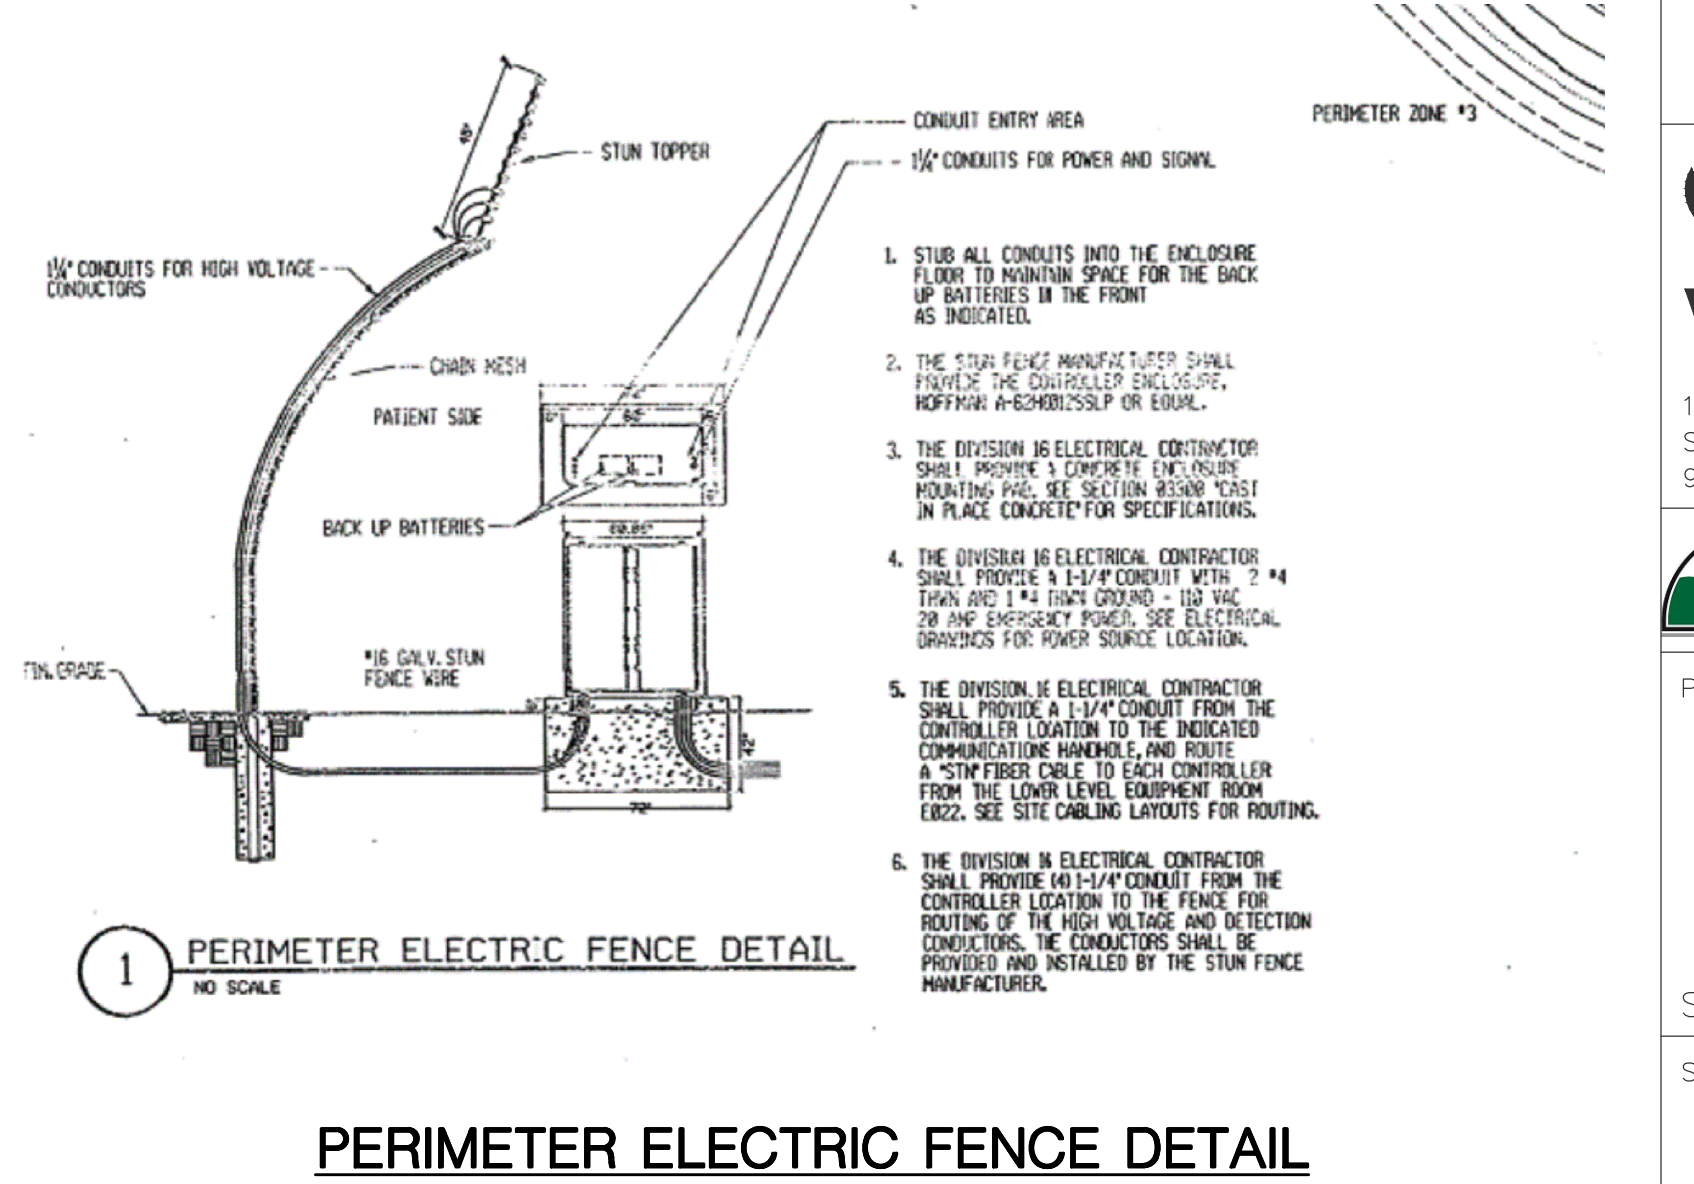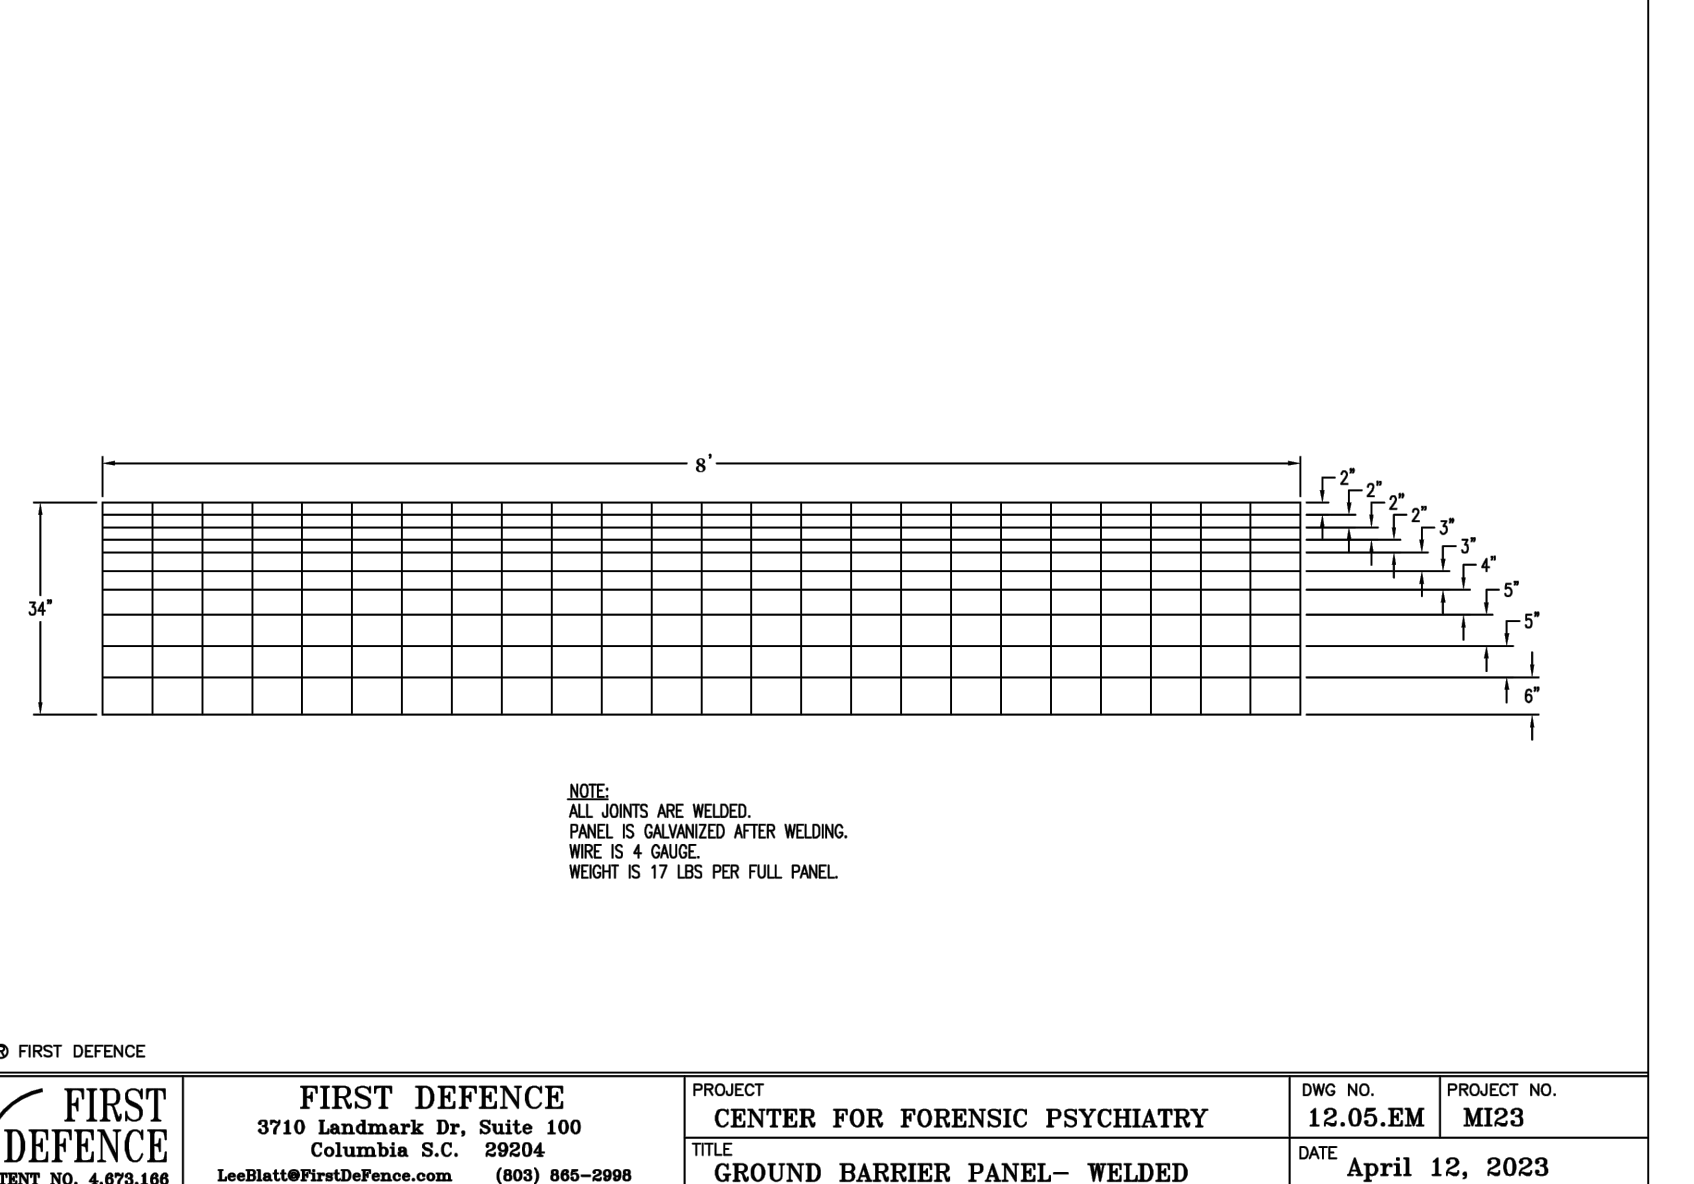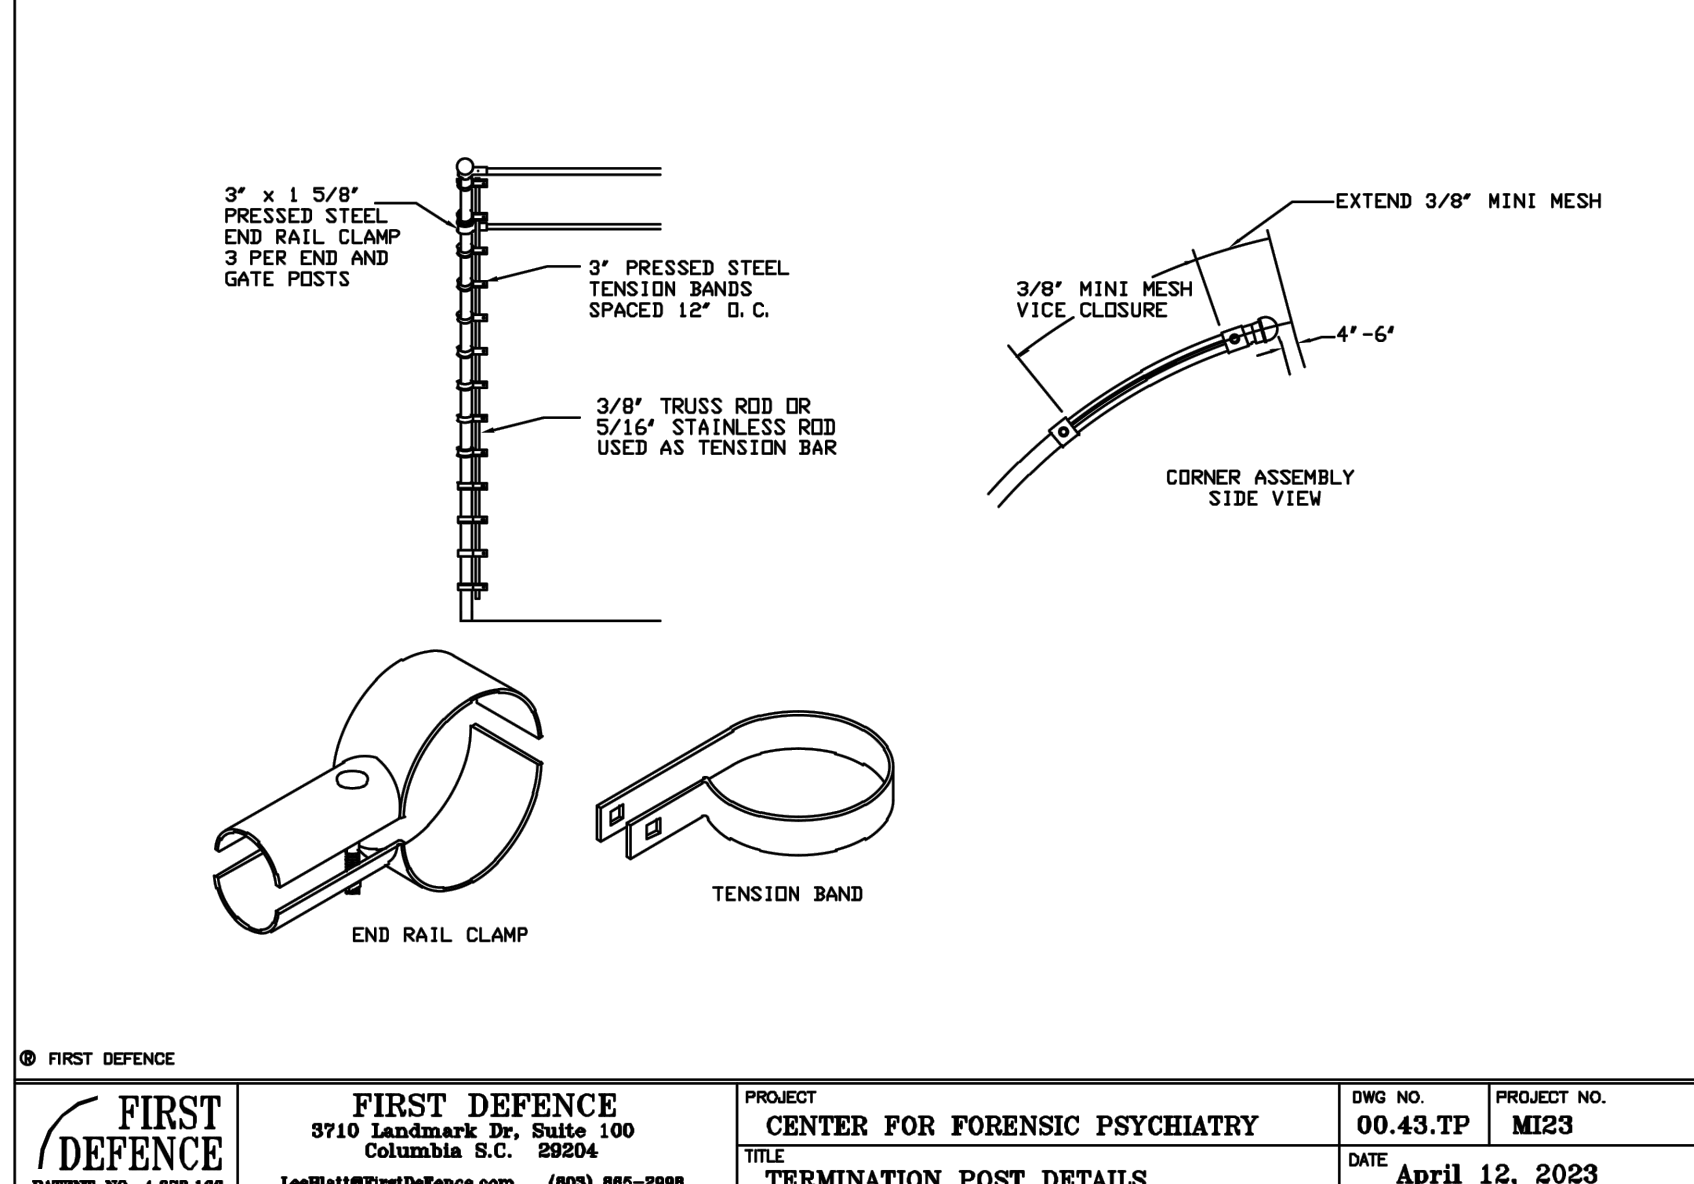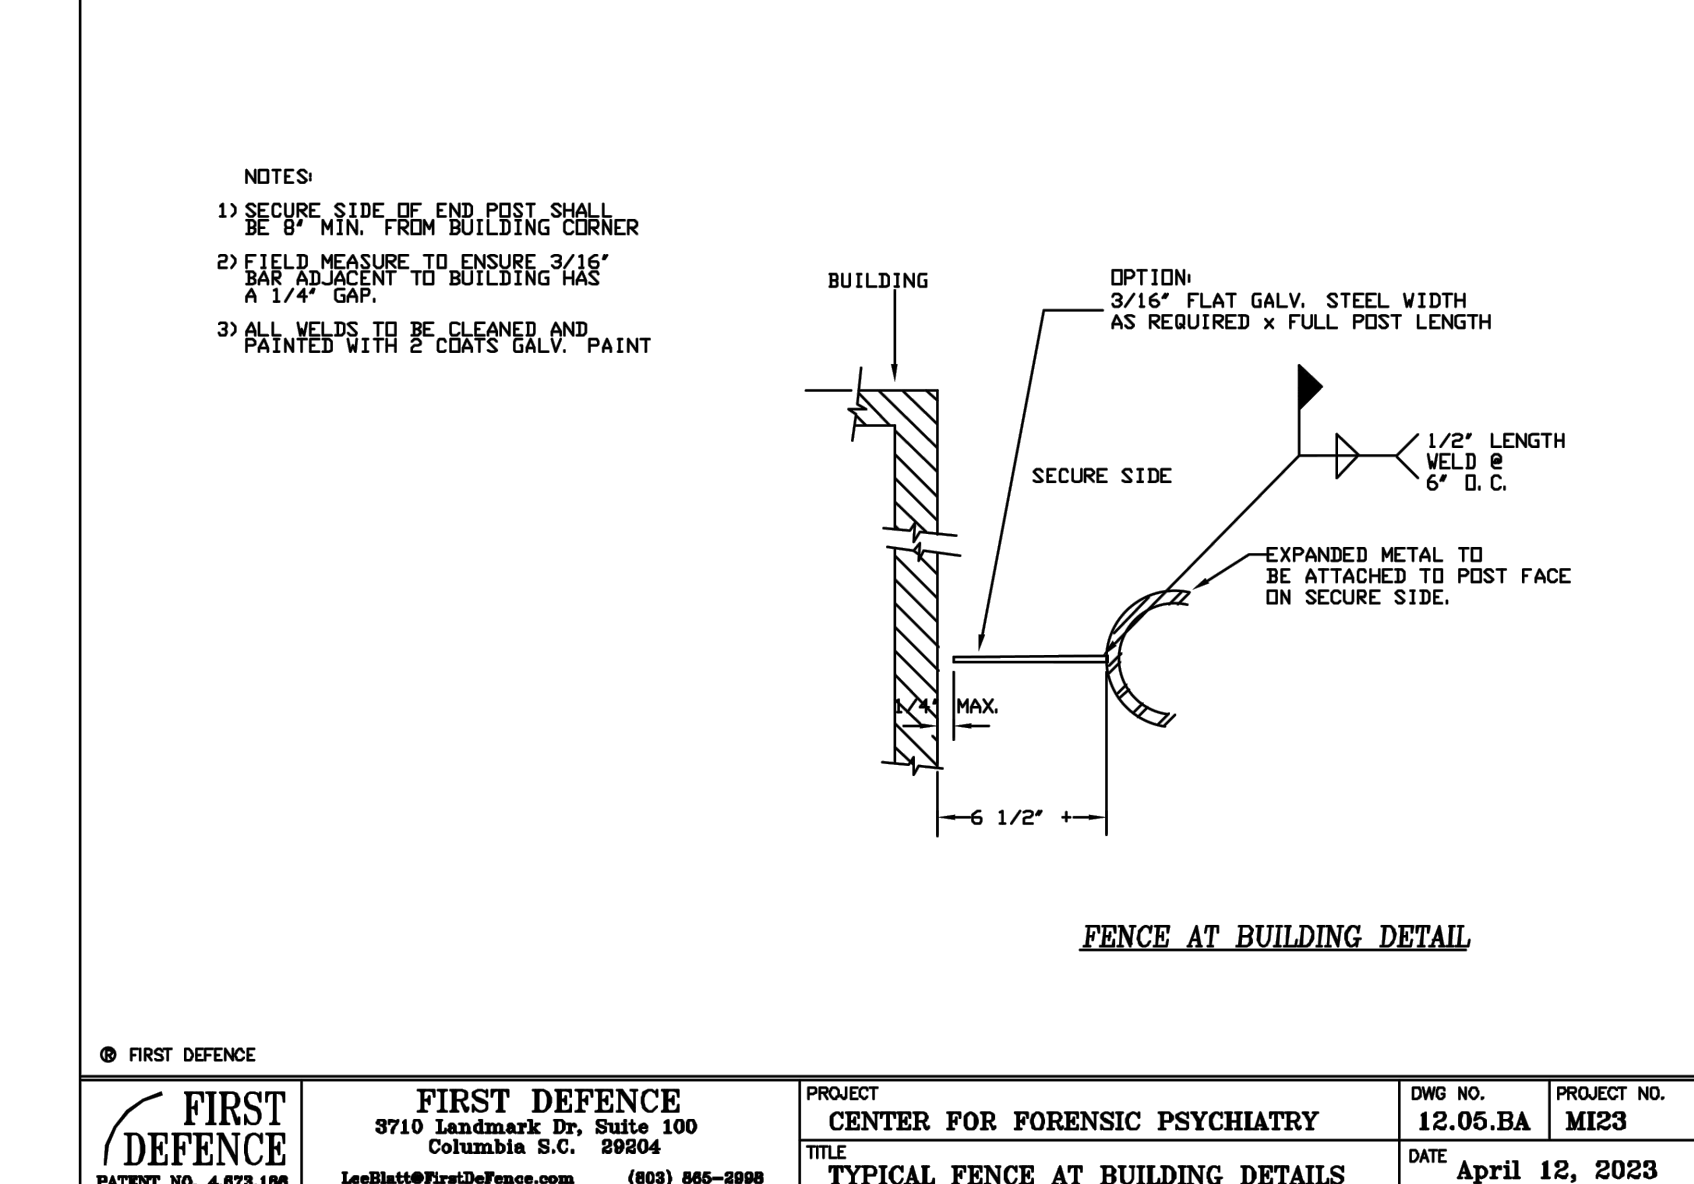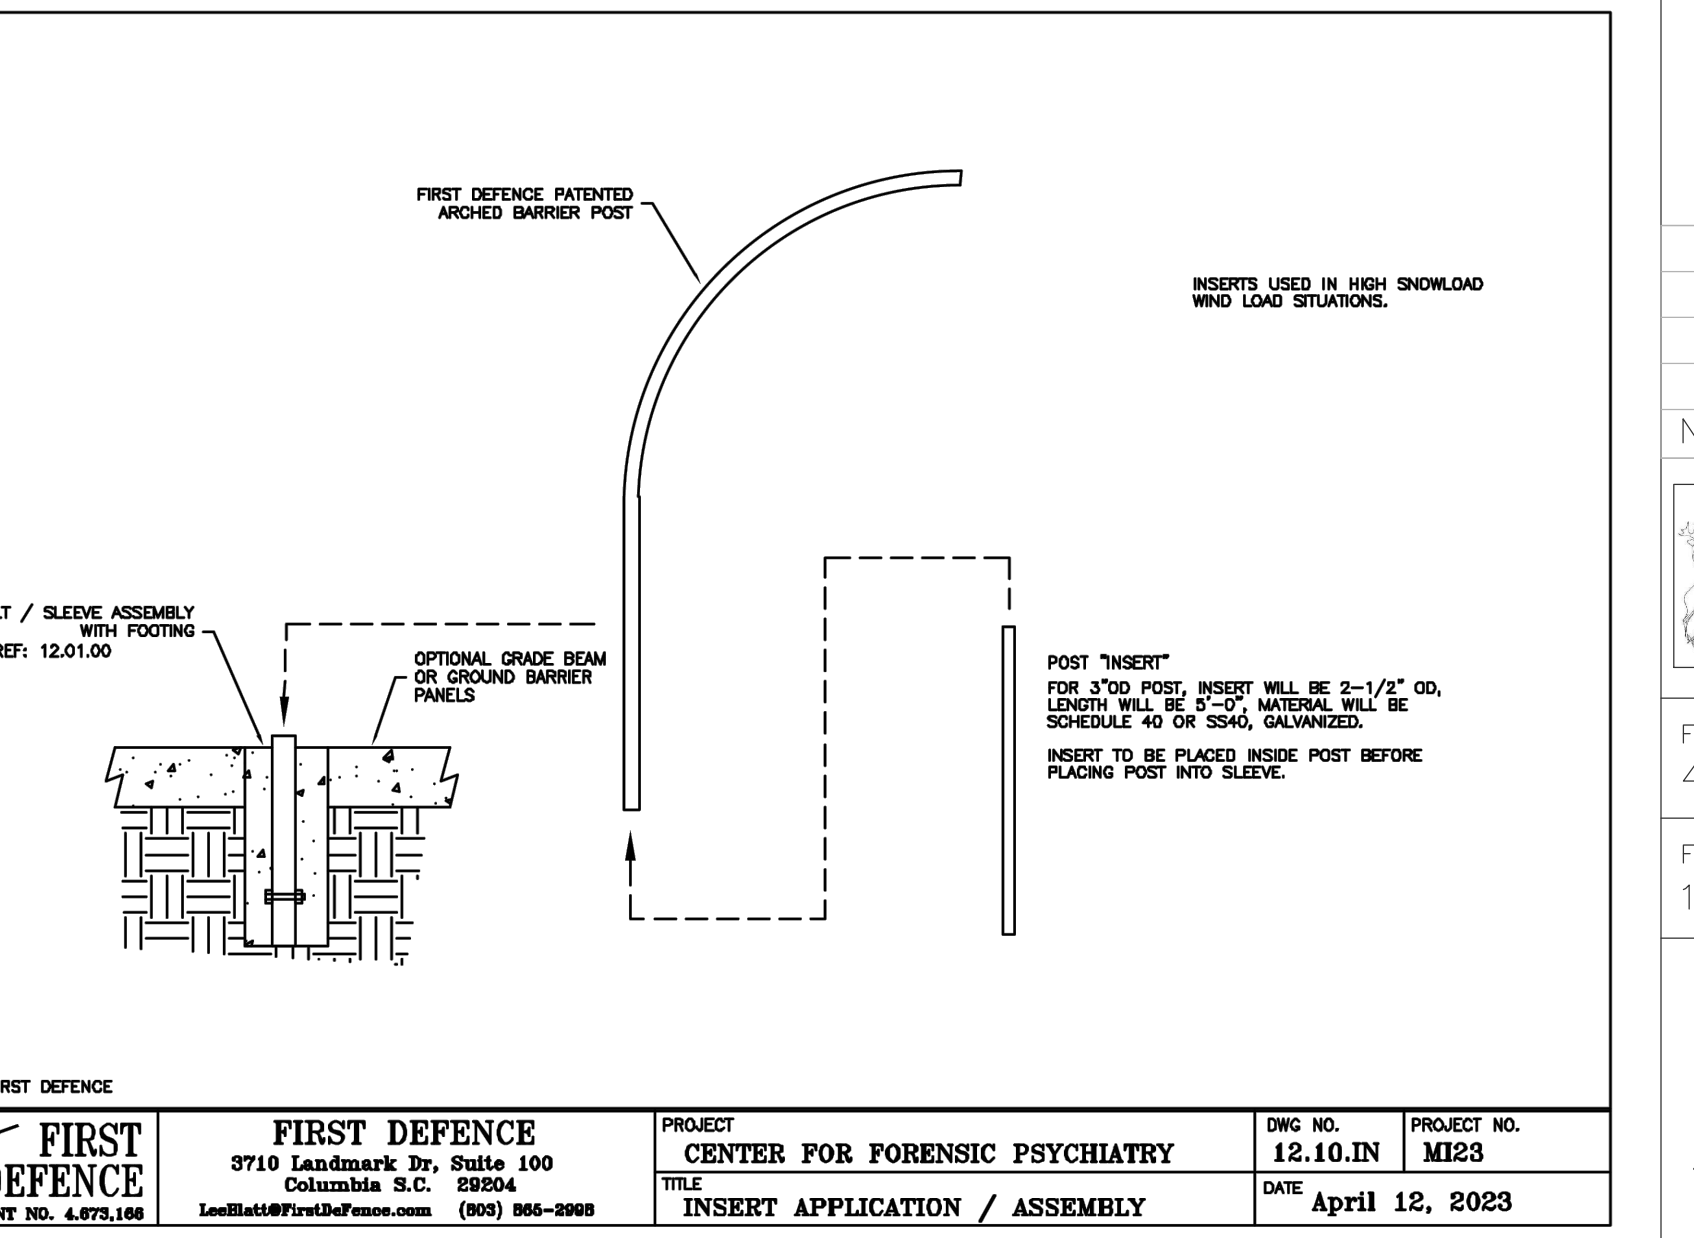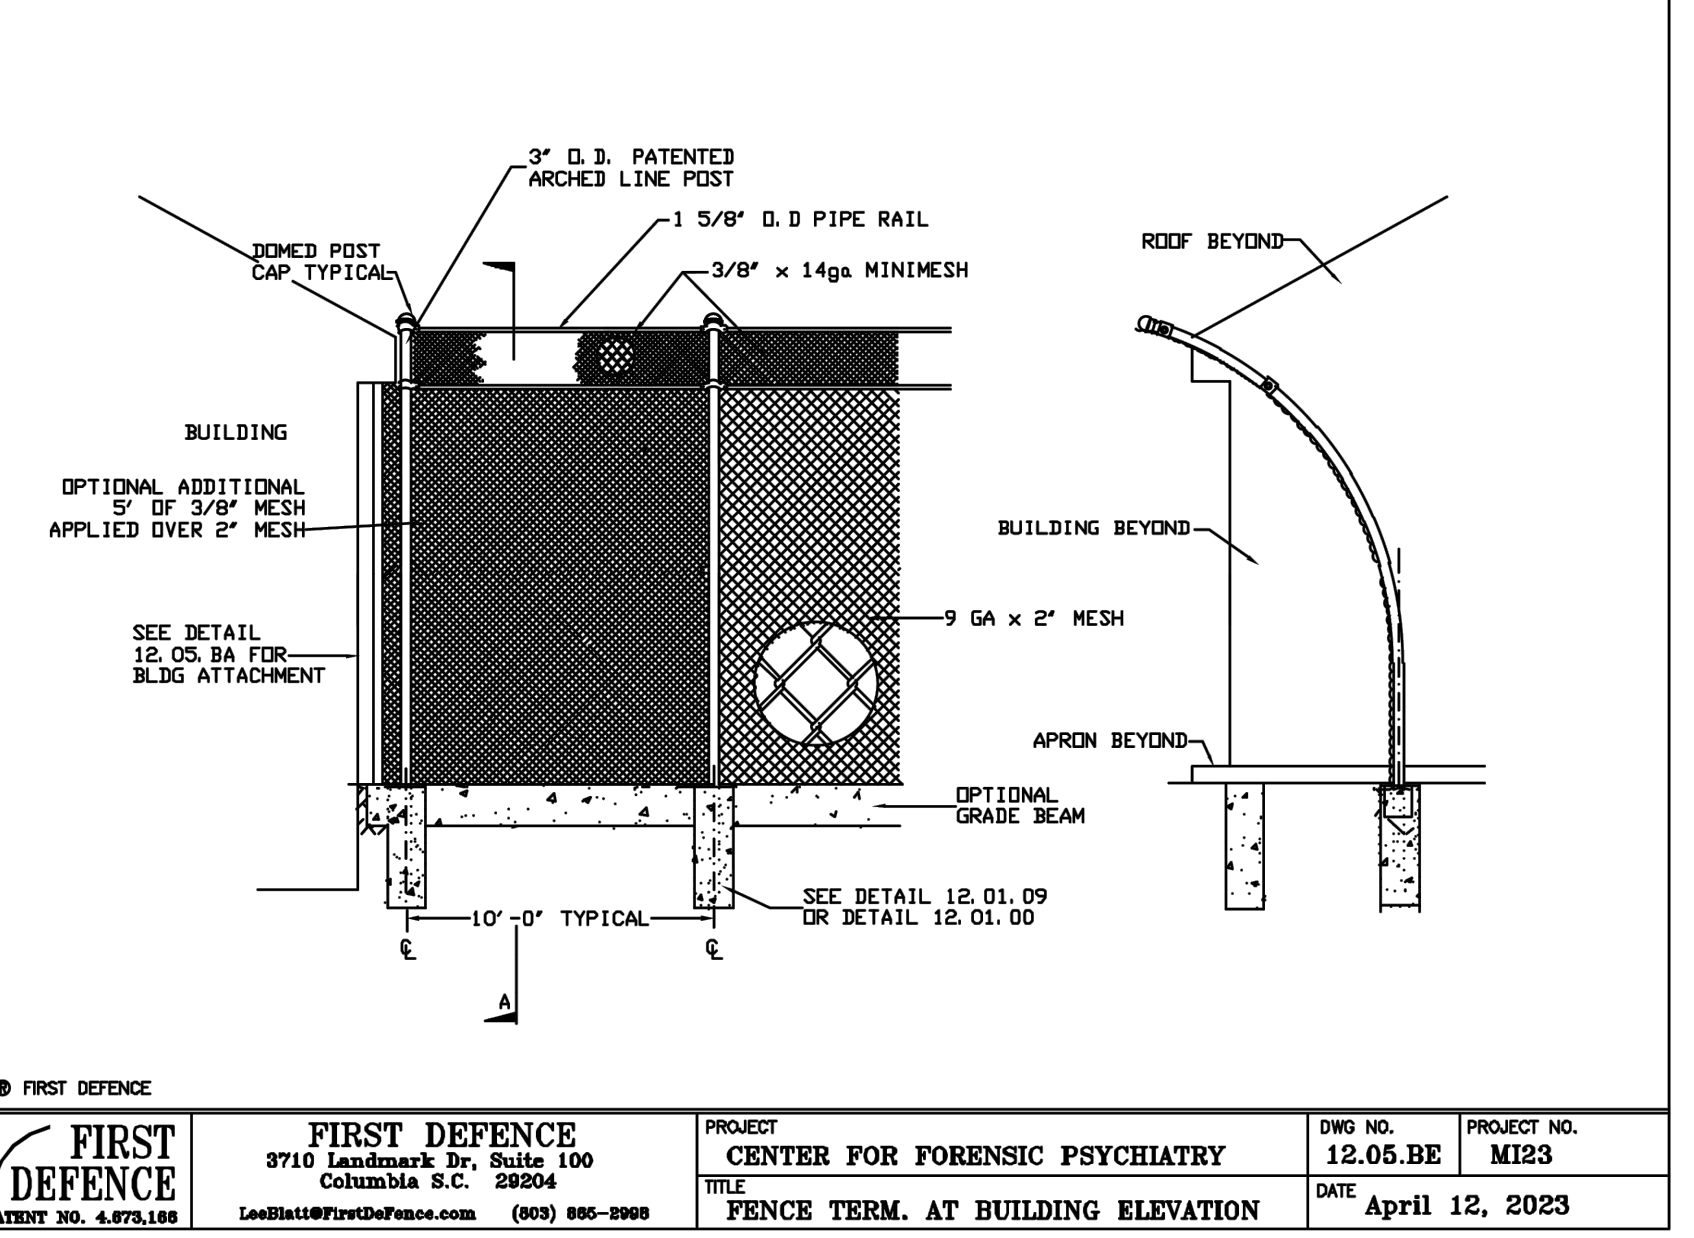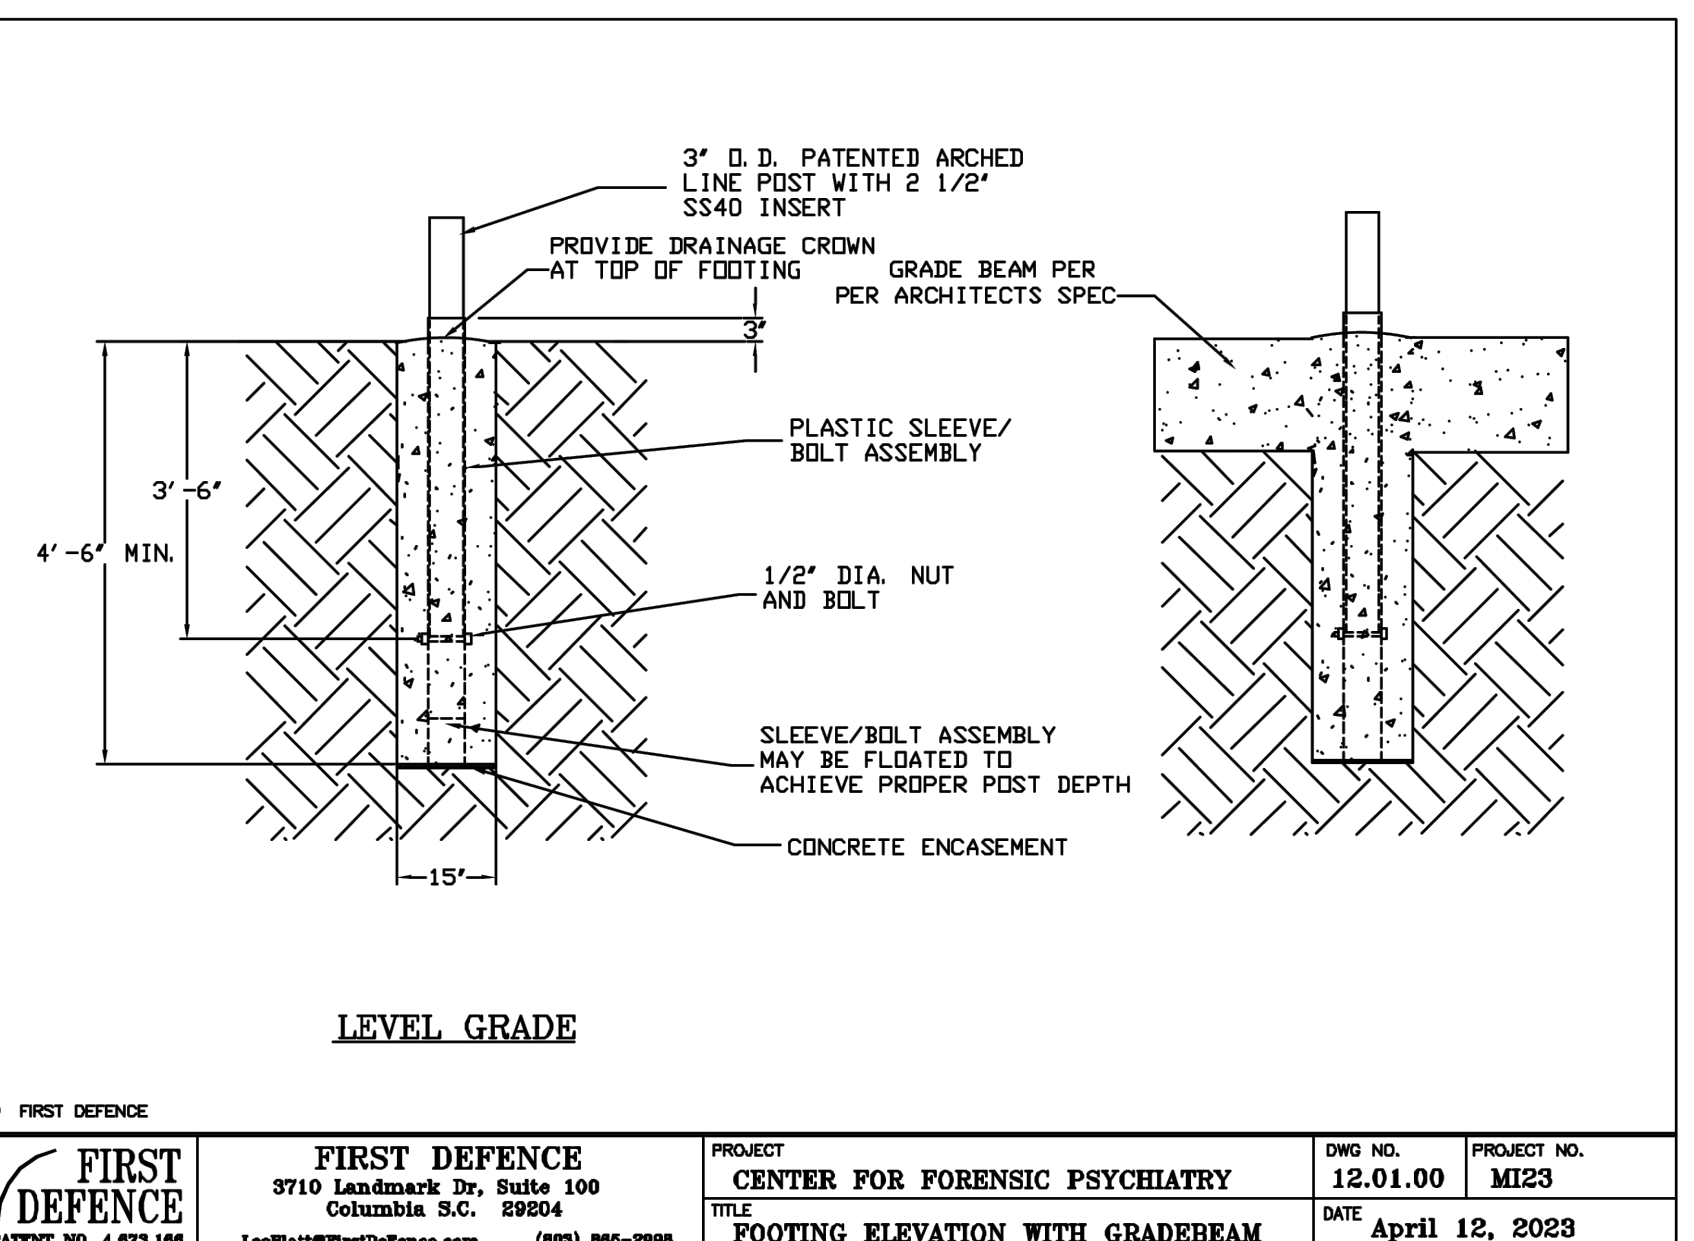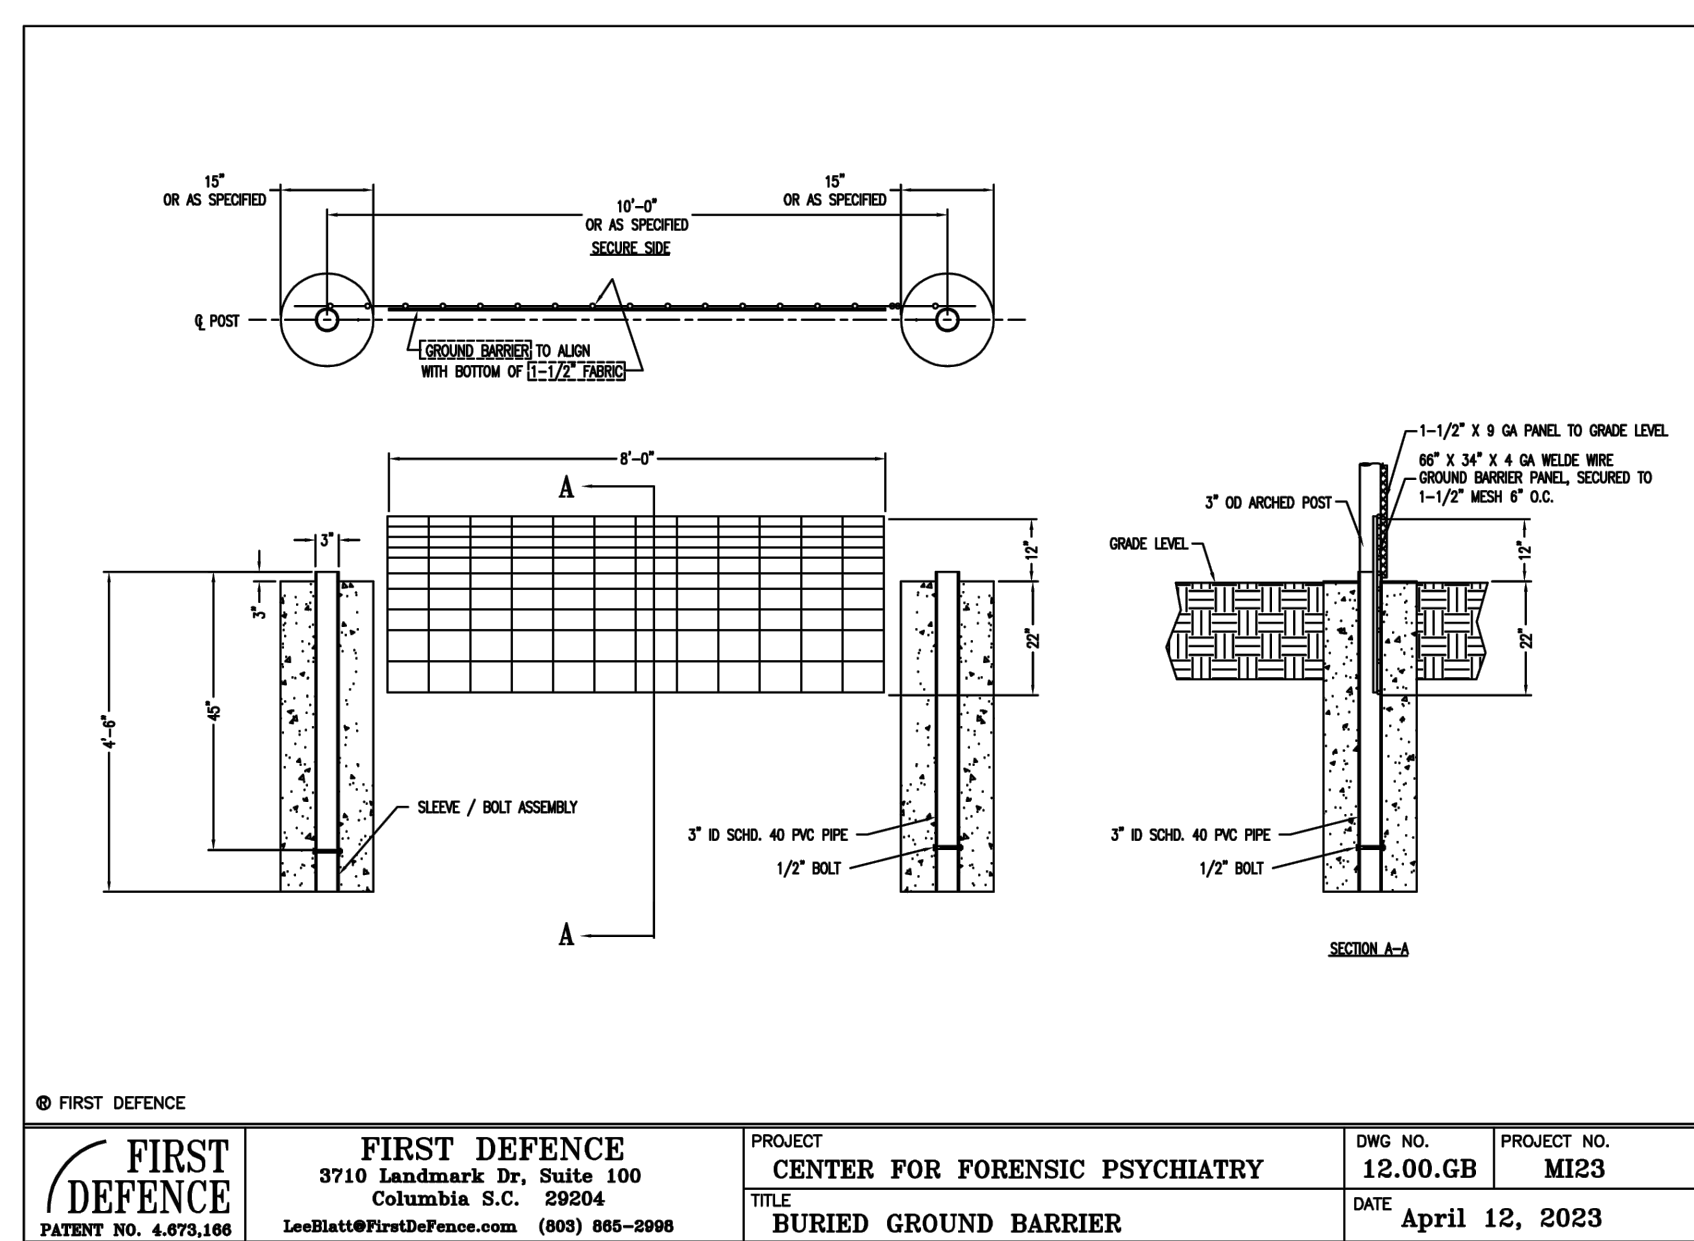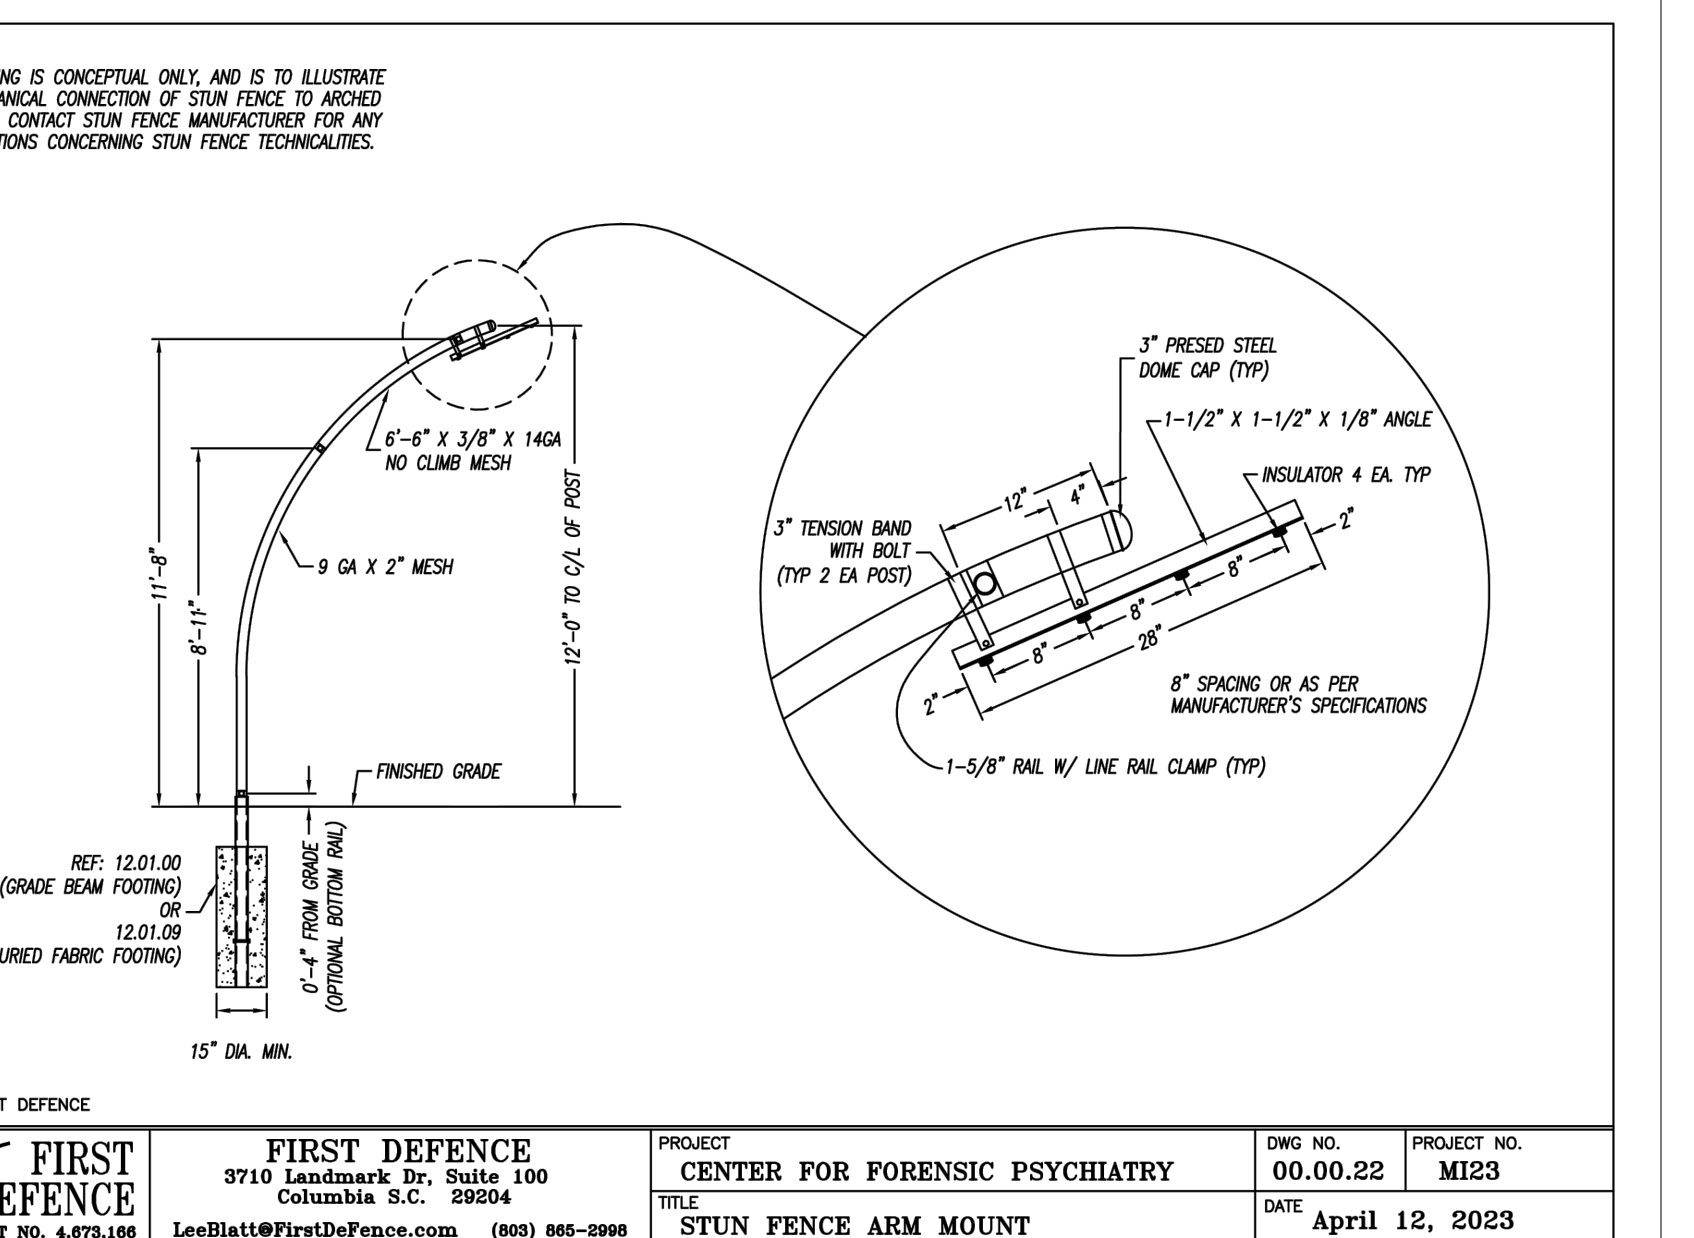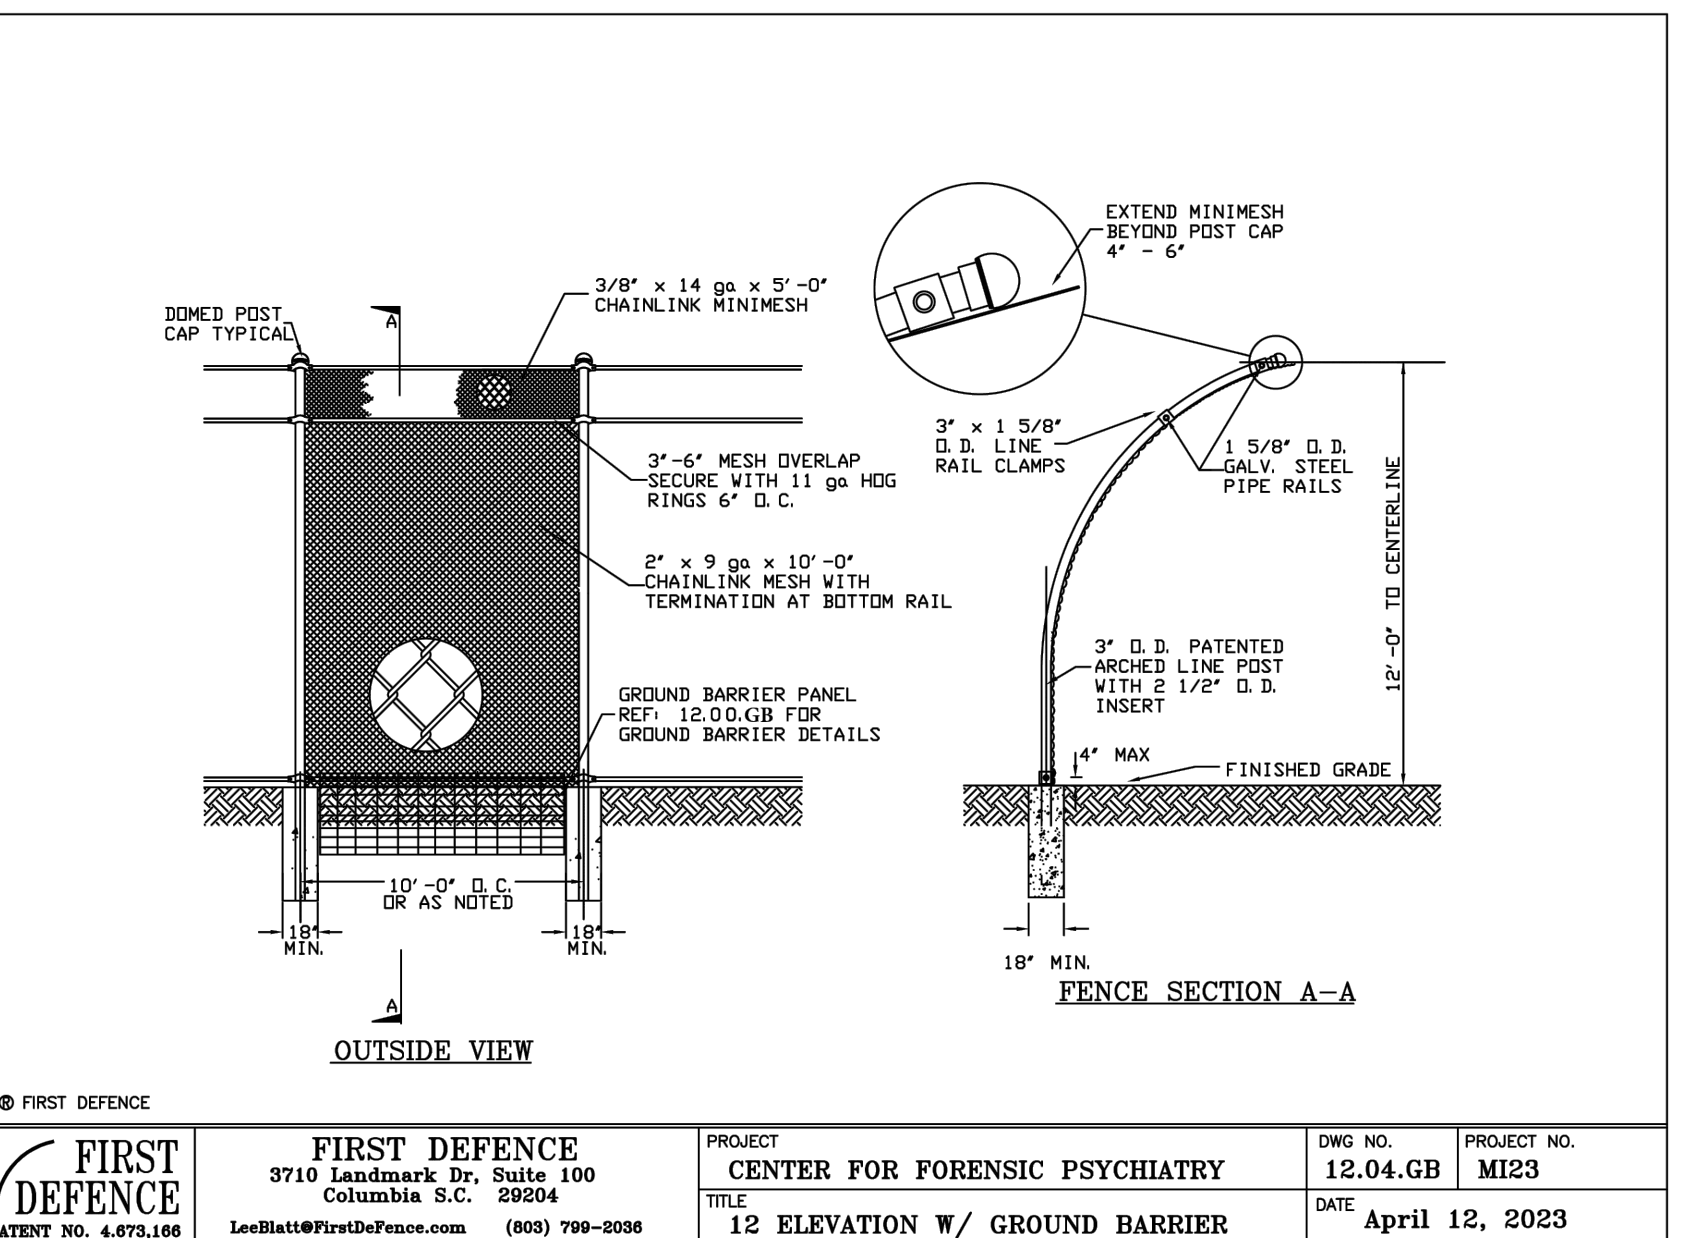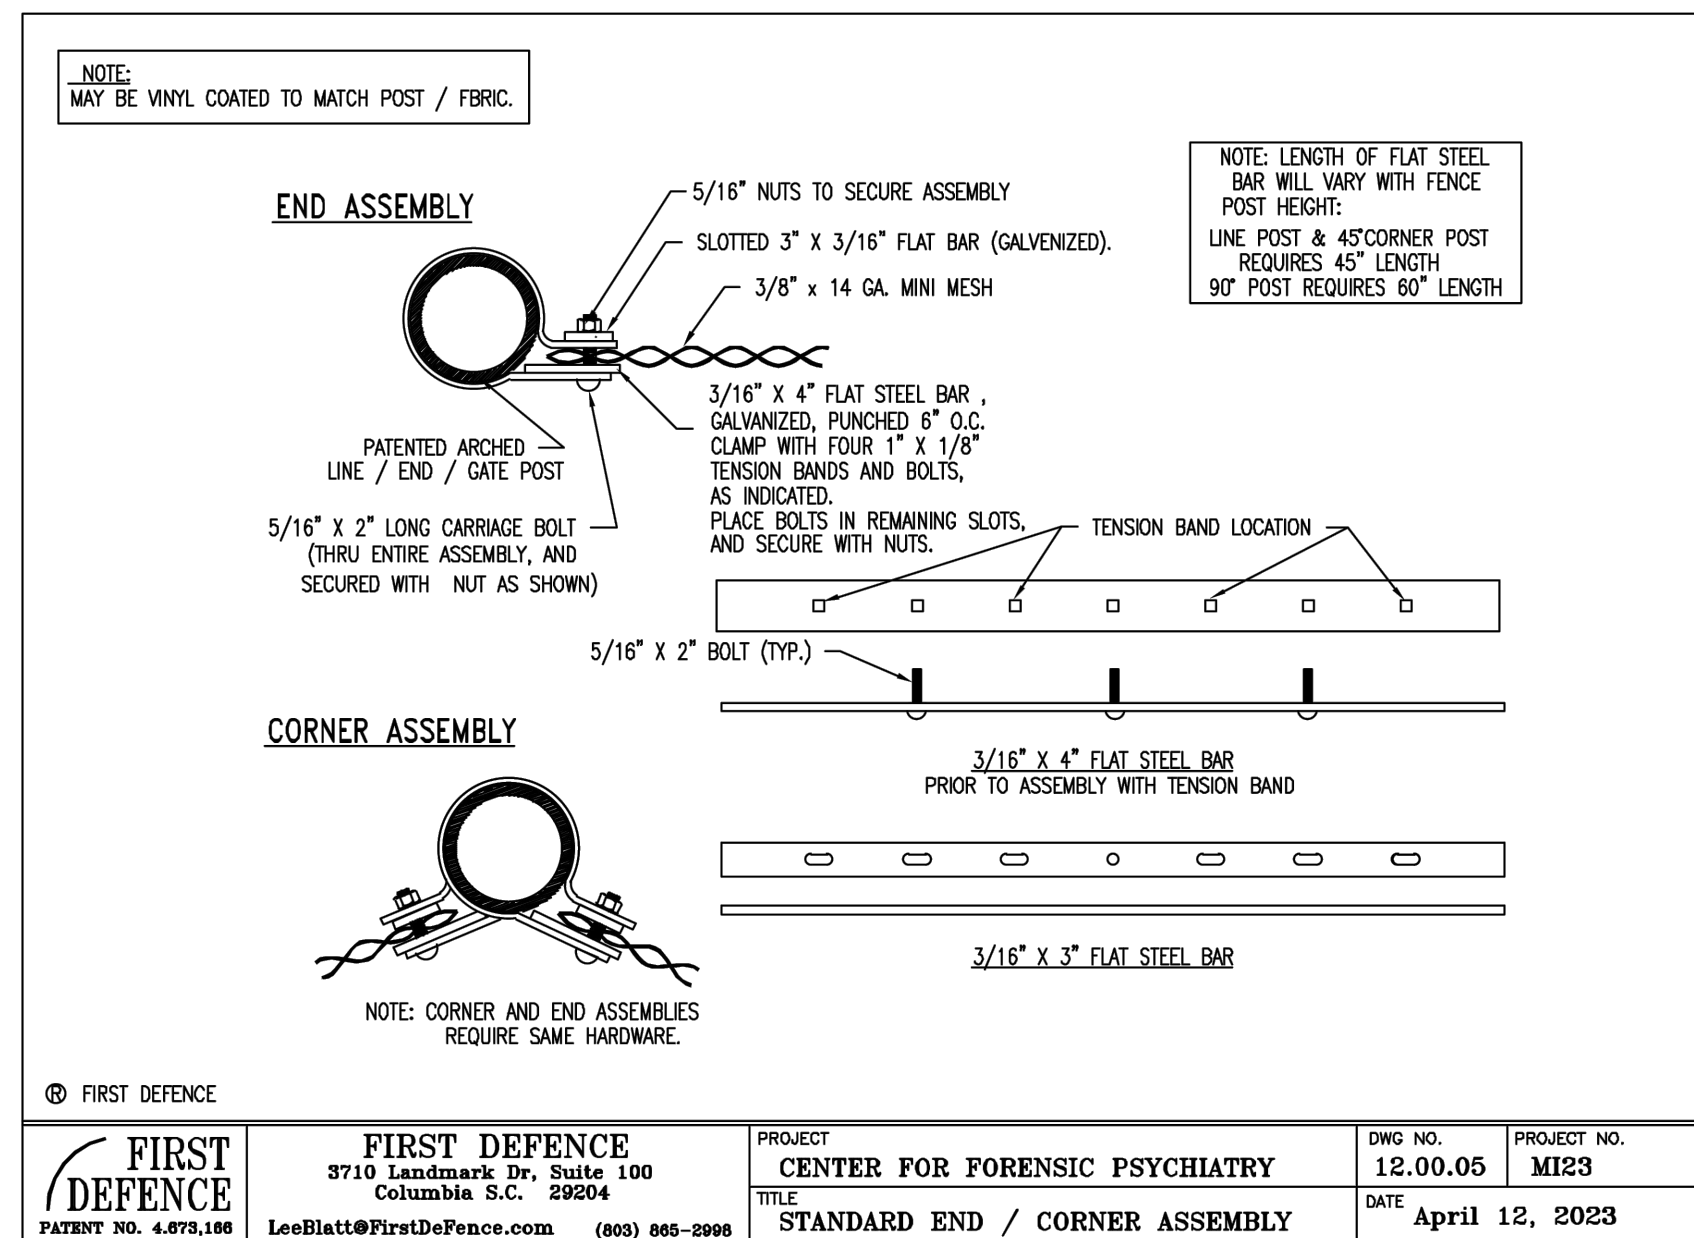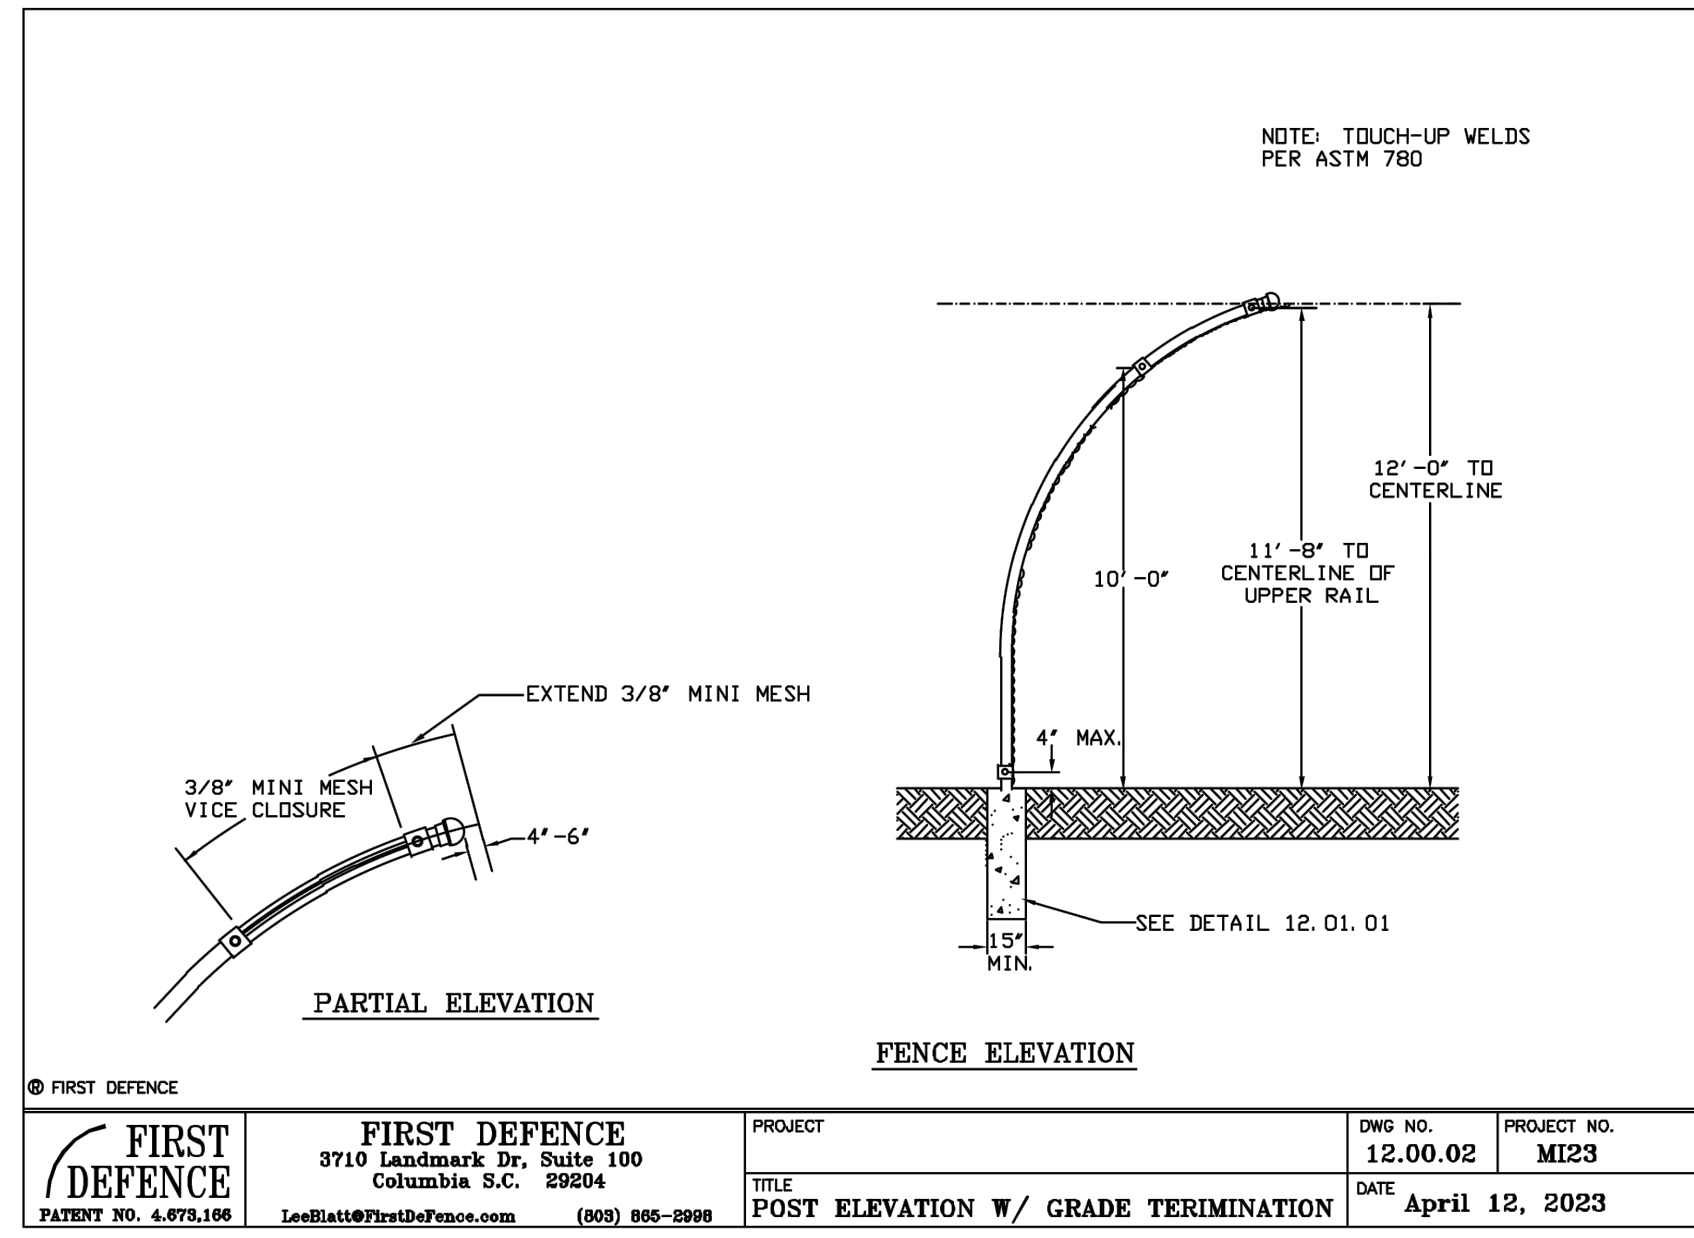

BUILDING

These documents are approved for compliance with the STATE OF MICHIGAN BUILDING CODE subject to field inspection and the conditions of approval.

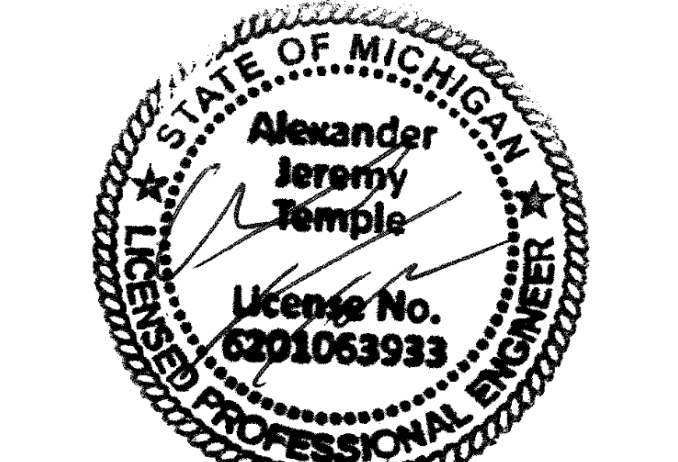


NO.	REVISION	DATE

STATE OF MICHIGAN
DEPARTMENT OF TECHNOLOGY, MANAGEMENT AND BUDGET
FACILITIES AND BUSINESS SERVICE ADMINISTRATION
DESIGN AND CONSTRUCTION DIVISION
ADAM LACHE, DIRECTOR

FILE NO.
491/20167.SDW

FUNDING CODE
171CODHHS7255

CONTRACT NO.
Y22003

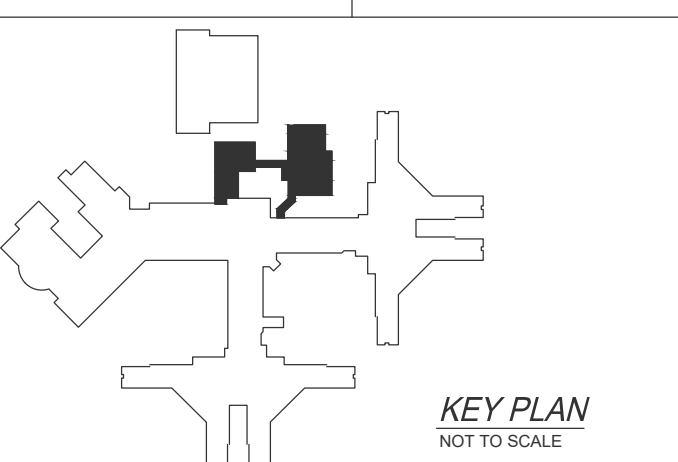

WTAARCH.COM

WTA ARCHITECTS

100 S Jefferson Ave, Suite 601
Saginaw, Michigan 48607
989 752 8107
COPYRIGHT © 2023

ROWE PROFESSIONAL SERVICES COMPANY

PROJECT TITLE
491/20167.SDW CFP - PHASE 500


CENTER FOR FORENSIC PSYCHIATRY - CREATE KITCHEN SALINE, MICHIGAN

SHEET TITLE
FENCE DETAILS

PROJECT NUMBER 2021094	SHEET NUMBER C1.04
PROJECT DATE SEPTEMBER 6, 2023	CHECKED BY A.J.T.

GENERAL CONSTRUCTION NOTES:


- 1) CONTRACTOR WILL COORDINATE WITH FACILITY STAFF TO DETERMINE THE IRRIGATION SYSTEM LOCATION FOR REMOVALS AND REPLACEMENT AROUND PROPOSED IMPROVEMENTS.
- 2) CONTRACTOR TO COMPLETE GROUND PENETRATING RADAR WITHIN CONSTRUCTION LIMITS TO DETERMINE THE EXACT LOCATION OF UNDERGROUND UTILITIES PRIOR TO BEGINNING EXCAVATION.
- 3) PRIOR TO CONSTRUCTION CONTRACTOR IS TO WORK WITH THE FACILITY TO DETERMINE AN ADEQUATE LAYDOWN AREA AND JOB TRAILER LOCATION.
- 4) ALL BENCHES ARE TO BE SALVAGED COORDINATE STORAGE LOCATION WITH OWNER.
- 5) EXISTING ABANDONED CONDUIT ALONG EXPOSED WALL SHALL BE REMOVED TO THE BUILDING FOUNDATION AND SHALL BE SEALED TO BE MADE WATER TIGHT.

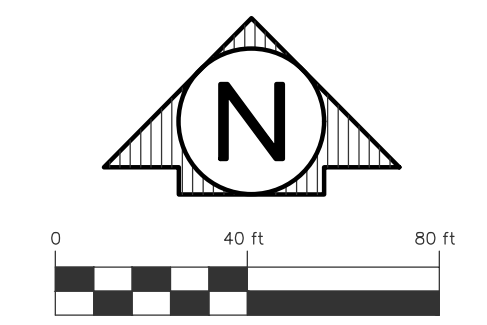

HAZARDOUS FLAMMABLE MATERIAL UNDERGROUND

HAZARDOUS FLAMMABLE MATERIAL UNDERGROUND

- TEMPORARY FENCING NOTES:**
- 1) FENCING SHALL BE REMOVED AS NEEDED TO FACILITATE PROPOSED CONSTRUCTION. TEMPORARY 12" FENCING SHALL BE INSTALLED AS SHOWN.
 - 2) CONTRACTOR IS TO INSTALL A NEW FENCE POST ADJACENT TO EXISTING BUILDING CORNER FOR TEMPORARY FENCING CONNECTION IN ACCORDANCE WITH THE FENCE AT BUILDING DETAIL ON SHEET C1.04.
 - 3) UPON COMPLETION OF PROPOSED FENCE AND DISMANTLING OF TEMPORARY FENCING, CONTRACTOR IS TO REMOVE TEMPORARY POST AT BUILDING AND RESTORE TO EXISTING CONDITIONS.
 - 4) ANY DAMAGE TO BUILDING OR SURROUNDING AREA AS PART OF THESE PROCEDURES SHALL BE RESTORED TO PRE CONSTRUCTION CONDITIONS AT THE CONTRACTORS EXPENSE.

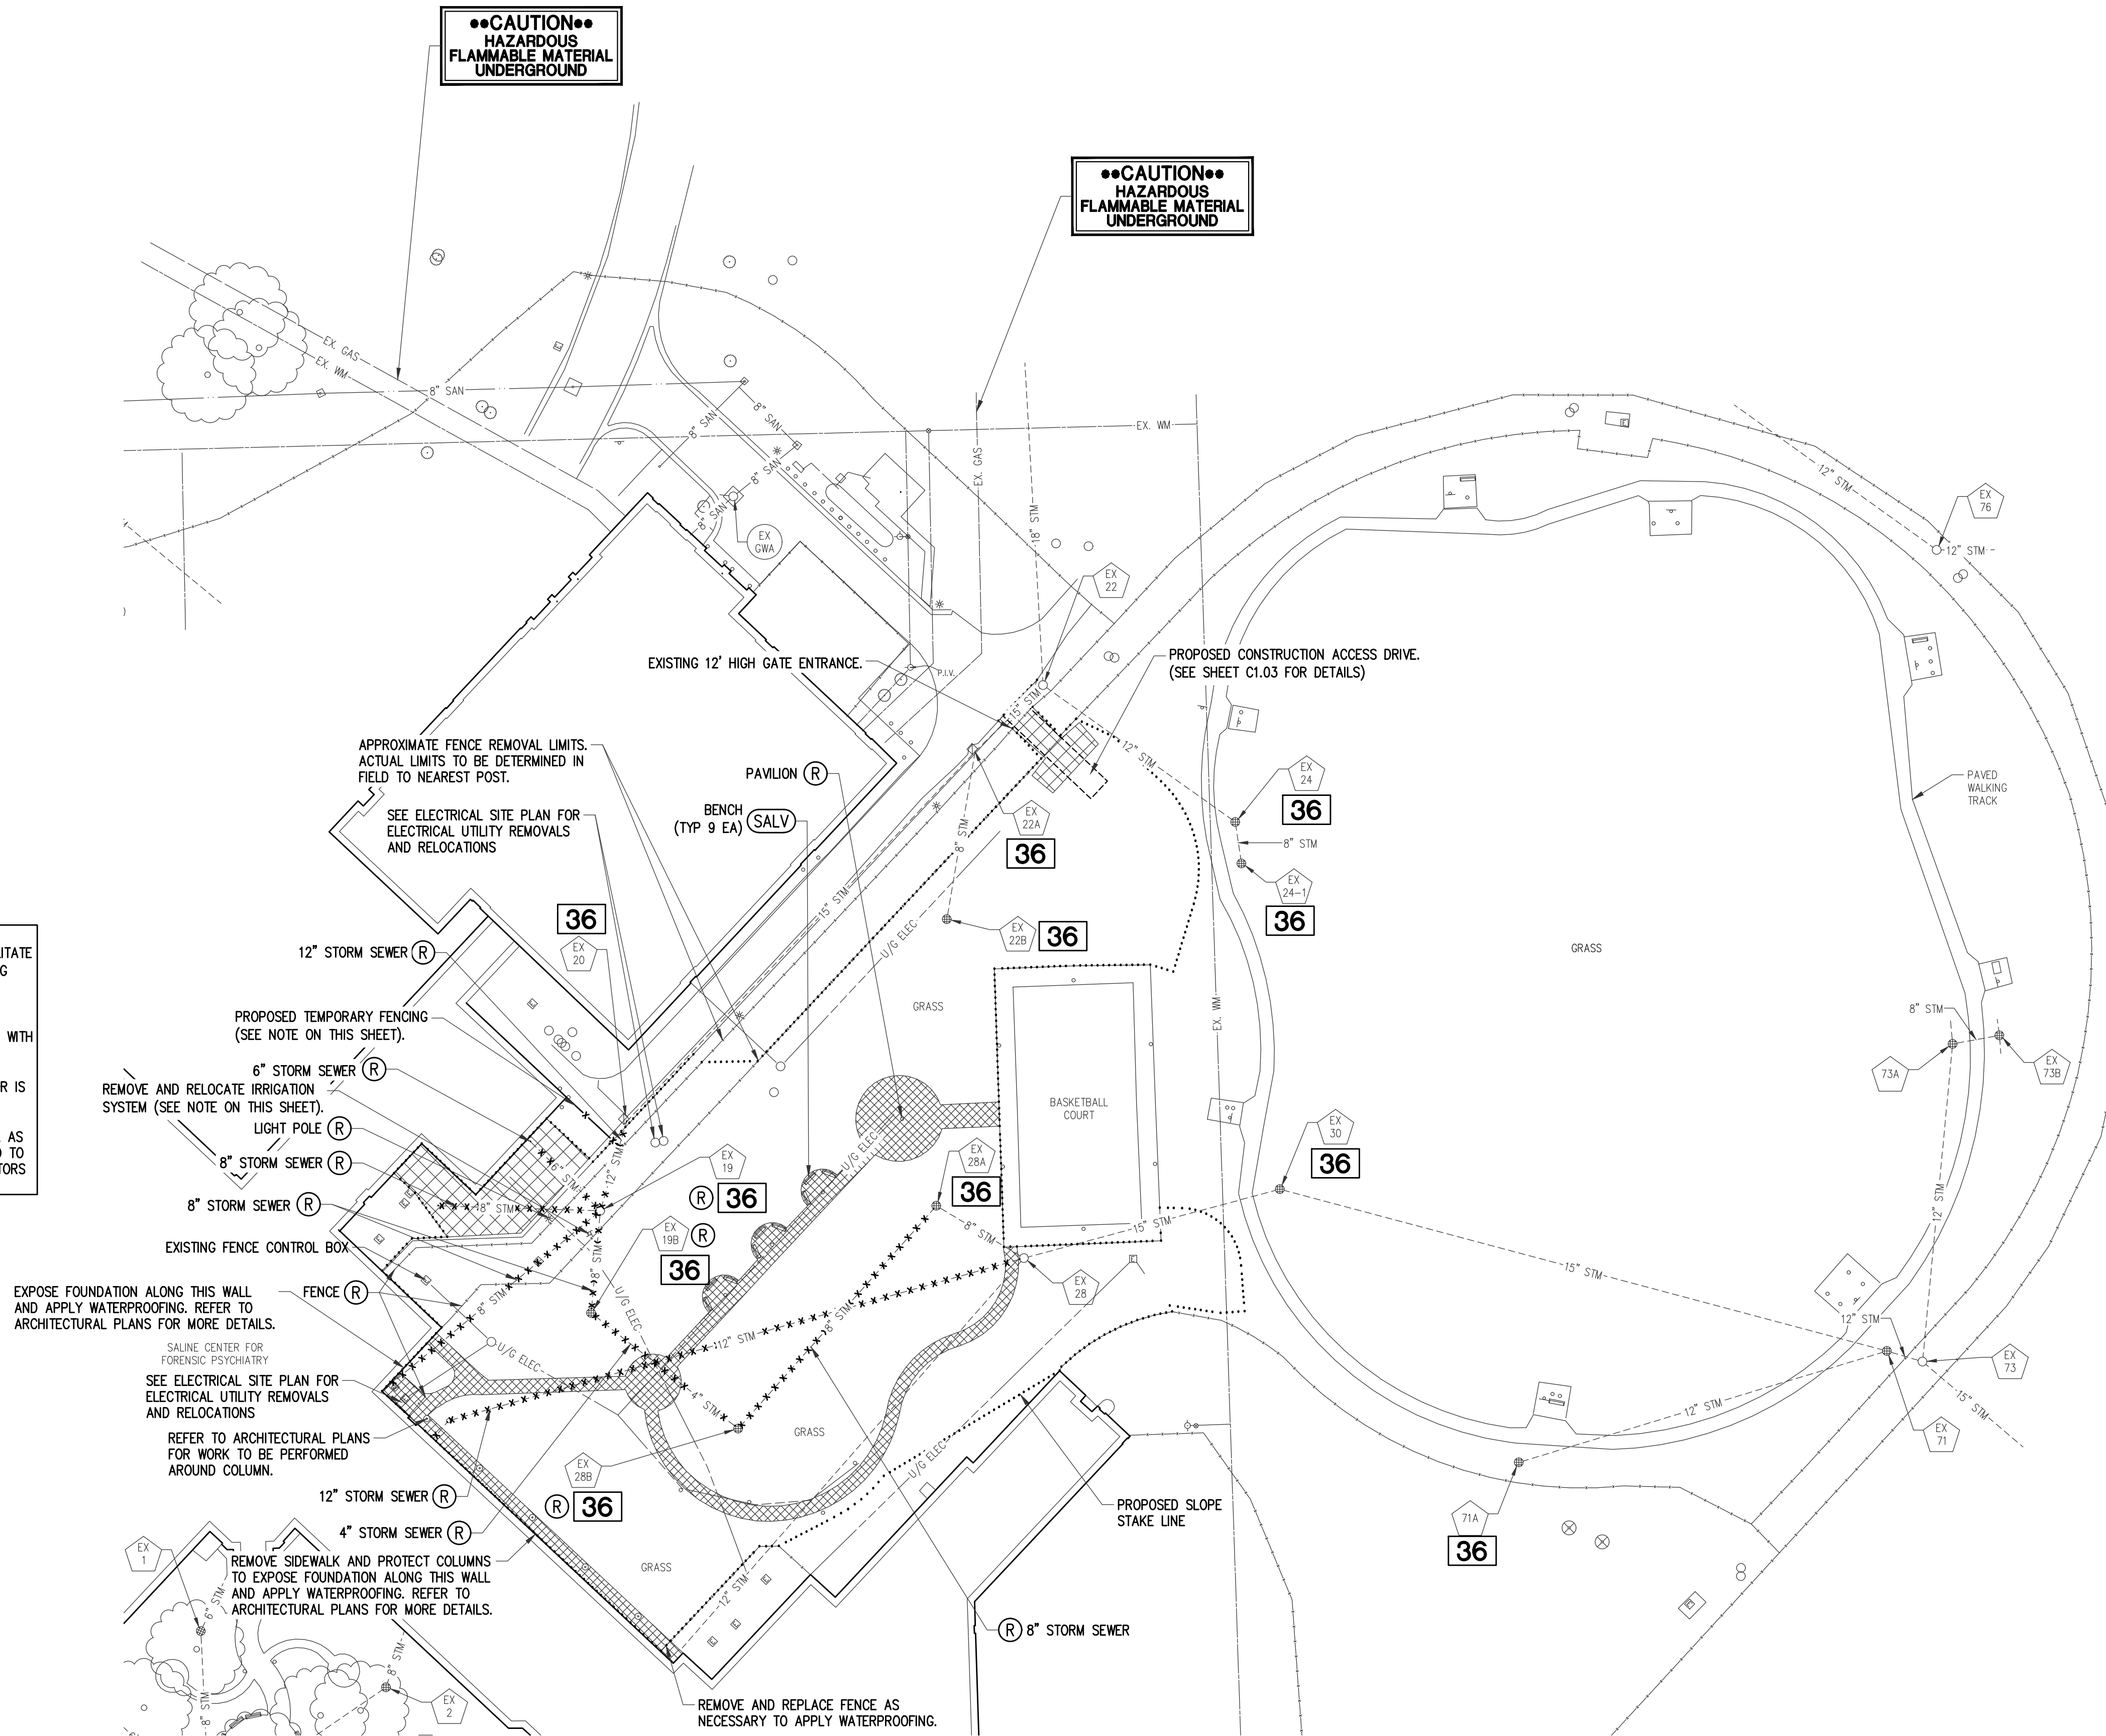


EXISTING STRUCTURE INVENTORY

MH# 19 TYPE: STORM COVER: FLAT GRATE RIM=839.64' 8.0" PVC S INV.=830.80' 8.0" PVC SW INV.=830.20' 8.0" PVC W INV.=830.48' 6.0" PVC NW INV.=830.80' 12.0" RCP N INV.=830.39'	MH# 28B TYPE: STORM COVER: RND INLET RIM=835.90' 4" PVC NW INV.=831.47' 8" NE INV.=830.62'
MH# 19B TYPE: STORM COVER: RND INLET RIM=833.80' 8.0" PVC N INV.=831.14'	MH# 28A TYPE: STORM COVER: RND INLET RIM= 834.18' 8" SE INV.=828.18' 8" SW INV.=828.28'
MH# 20 TYPE: STORM COVER: RND INLET RIM= 835.49' 12" RCP SW INV.=829.70' 15" RCP NE INV.=830.29'	MH# 30 TYPE: STORM COVER: RND INLET RIM=831.07' 15" SW INV.=819.10' 15" SE INV.=820.57'
MH# EX 22A TYPE: STORM COVER: CURB INLET RIM= 835.23' 8" S INV.=830.26' 15" SW INV.=829.26' 15" NE INV.=829.37'	MH# 71 TYPE: STORM COVER: RND INLET RIM=832.02' 15" NW INV.=820.45' 12" SW INV.=820.45' 12" SE INV.=820.91'
MH# 22B TYPE: STORM COVER: RND INLET RIM= 834.16' 8" N INV.=830.49'	MH# 71A TYPE: STORM COVER: RND INLET RIM= 831.36' 12" NE INV.=828.96'
MH# 22 TYPE: STORM COVER: FLATE GRATE RIM= 836.54' 15" SW INV.=829.16' 12" S INV.=827.89' 18" N INV.=828.81'	MH# 73 TYPE: STORM COVER: RND INLET RIM= 829.27 12" NW INV.=820.45' 12" N INV.=824.28' 15" SE INV.=820.91'
MH# 24 TYPE: STORM COVER: RND INLET RIM= 832.41' 12" N INV.=828.81' 8.0" S INV.=828.49'	MH# 73A TYPE: STORM COVER: RND INLET RIM= 829.58' 12" S INV.=827.33' 4" N INV.=828.73' 8" E INV.=827.33'
MH# 24-1 TYPE: STORM COVER: RND INLET RIM= 830.72' 8.0" N INV.=528.52'	MH# 73B TYPE: STORM COVER: RND INLET RIM= 831.22' 8" W INV.=827.48' 4" N INV.=828.68' 4" S INV.=828.48'
MH# 28 TYPE: STORM COVER: RND INLET RIM= 828.97' 12" SW INV.=819.10' 8" NW INV.=825.61' 15" NE INV.=820.57'	

**MICHIGAN UNIFIED KEYING SYSTEM
SOIL EROSION AND SEDIMENTATION CONTROL MEASURES**

KEY	DETAIL	CHARACTERISTICS
36	CATCH BASIN, GRASS INLET	COLLECTS HIGH VELOCITY CONCENTRATED RUNOFF AND USE FILTER FLOOR OVER PALE

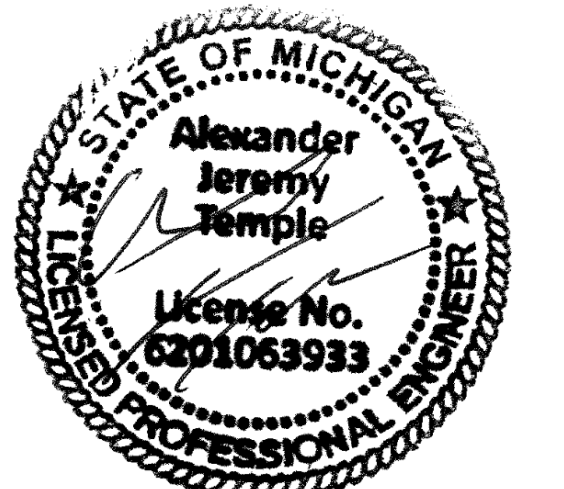


NO.	REVISION	DATE

STATE OF MICHIGAN
DEPARTMENT OF TECHNOLOGY, MANAGEMENT AND BUDGET
FACILITIES AND BUSINESS SERVICE ADMINISTRATION
DESIGN AND CONSTRUCTION DIVISION
ADAM LACHE, DIRECTOR

FILE NO.
491/20167.SDW

FUNDING CODE
171CODHHS7255

CONTRACT NO.
Y22003

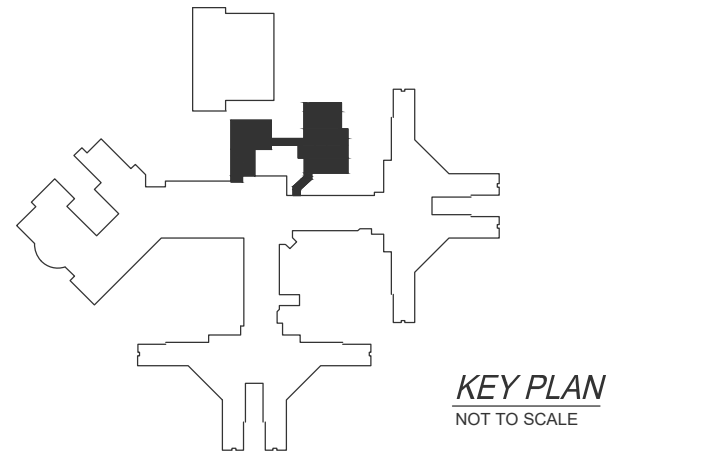

WTAARCH.COM

WTA ARCHITECTS

100 S Jefferson Ave, Suite 601
Saginaw, Michigan 48607
989 752 8107
COPYRIGHT © 2023

ROWE PROFESSIONAL SERVICES COMPANY

PROJECT TITLE
491/20167.SDW CFP - PHASE 500

CENTER FOR FORENSIC PSYCHIATRY - CREATE KITCHEN
SALINE, MICHIGAN


SHEET TITLE
SITE DEMOLITION PLAN

PROJECT NUMBER
2021094

SHEET NUMBER
C2.01


PROJECT DATE
SEPTEMBER 6, 2023

CHECKED BY
A.J.T.

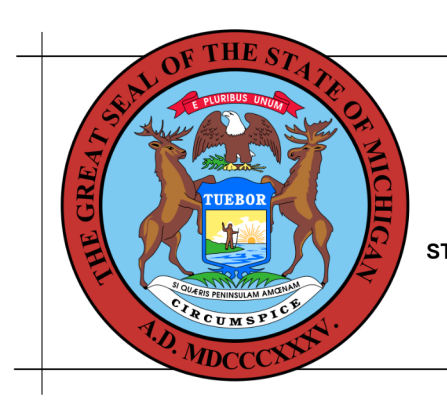


PLUMBING

These documents are approved for compliance with the STATE OF MICHIGAN PLUMBING CODE subject to field inspection and the conditions of approval.

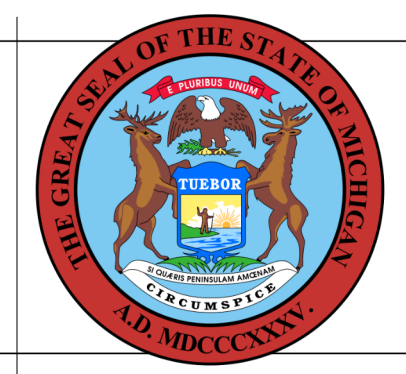

BUILDING

These documents are approved for compliance with the STATE OF MICHIGAN BUILDING CODE subject to field inspection and the conditions of approval.

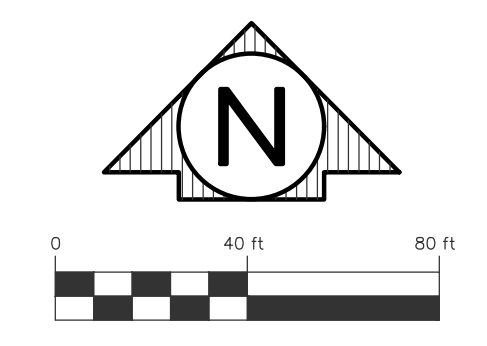

- NOTES:**
- 1) PROPOSED PERIMETER ELECTRIC AND CHAIN LINK FENCE IS TO MATCH THE EXISTING FENCE SIZE AND STYLE. ALL FENCING IS TO BE INSTALLED PER MANUFACTURERS REQUIREMENT. SEE SHEET C1.04 FOR MORE DETAILS.
 - 2) PERIMETER ELECTRIC FENCE IS TO BE INSTALLED AGAINST PROPOSED BUILDING CORNER AS SHOWN TO ALLOW FOR NO GAP OR MEANS OF PASSAGE. SEE SHEET C1.04 FOR MORE DETAILS.

SITE INFORMATION

PROPERTY ADDRESS: 8303 PLATT ROAD
SALINE, MI 48176

PROPERTY OWNER: CENTER FOR FORENSIC PSYCHIATRY


PROPERTY TAX ID: S-19-02-200-003

ZONING AND SETBACK REQUIREMENTS: A-2; INTERM AGRICULTURE
FRONT YARD SETBACK - 50 FT
SIDE YARD SETBACK - 30 FT
REAR YARD SETBACK - 50 FT

LEGAL DESCRIPTION: OWNER REQUEST YO 2-7A-1 BEG AT NW COR SEC 2, TH N 88-35-59 E 351.45 FT, TH S 01-24-01 W 388.00 FT, TH N 88-35-59 E 245.00 FT, TH N 01-24-01 E 388.00 FT, TH N 88-35-59 E 344.48 FT, TH S 01-30-15 E 1199.51 FT, TH S 88-33-41 W 3429.32 FT, TH N 01-34-54 W 1200.00 FT TO THE POB. PT OF N 1/2 SEC 2, T4S-R6E. 92.31 AC SPLIT ON 06/29/2005 FROM S-19-02-200-001;

TOTAL SITE AREA: 92.31 ACRES

ADJACENT PROPERTIES: S-19-02-200-002
S-19-02-200-004

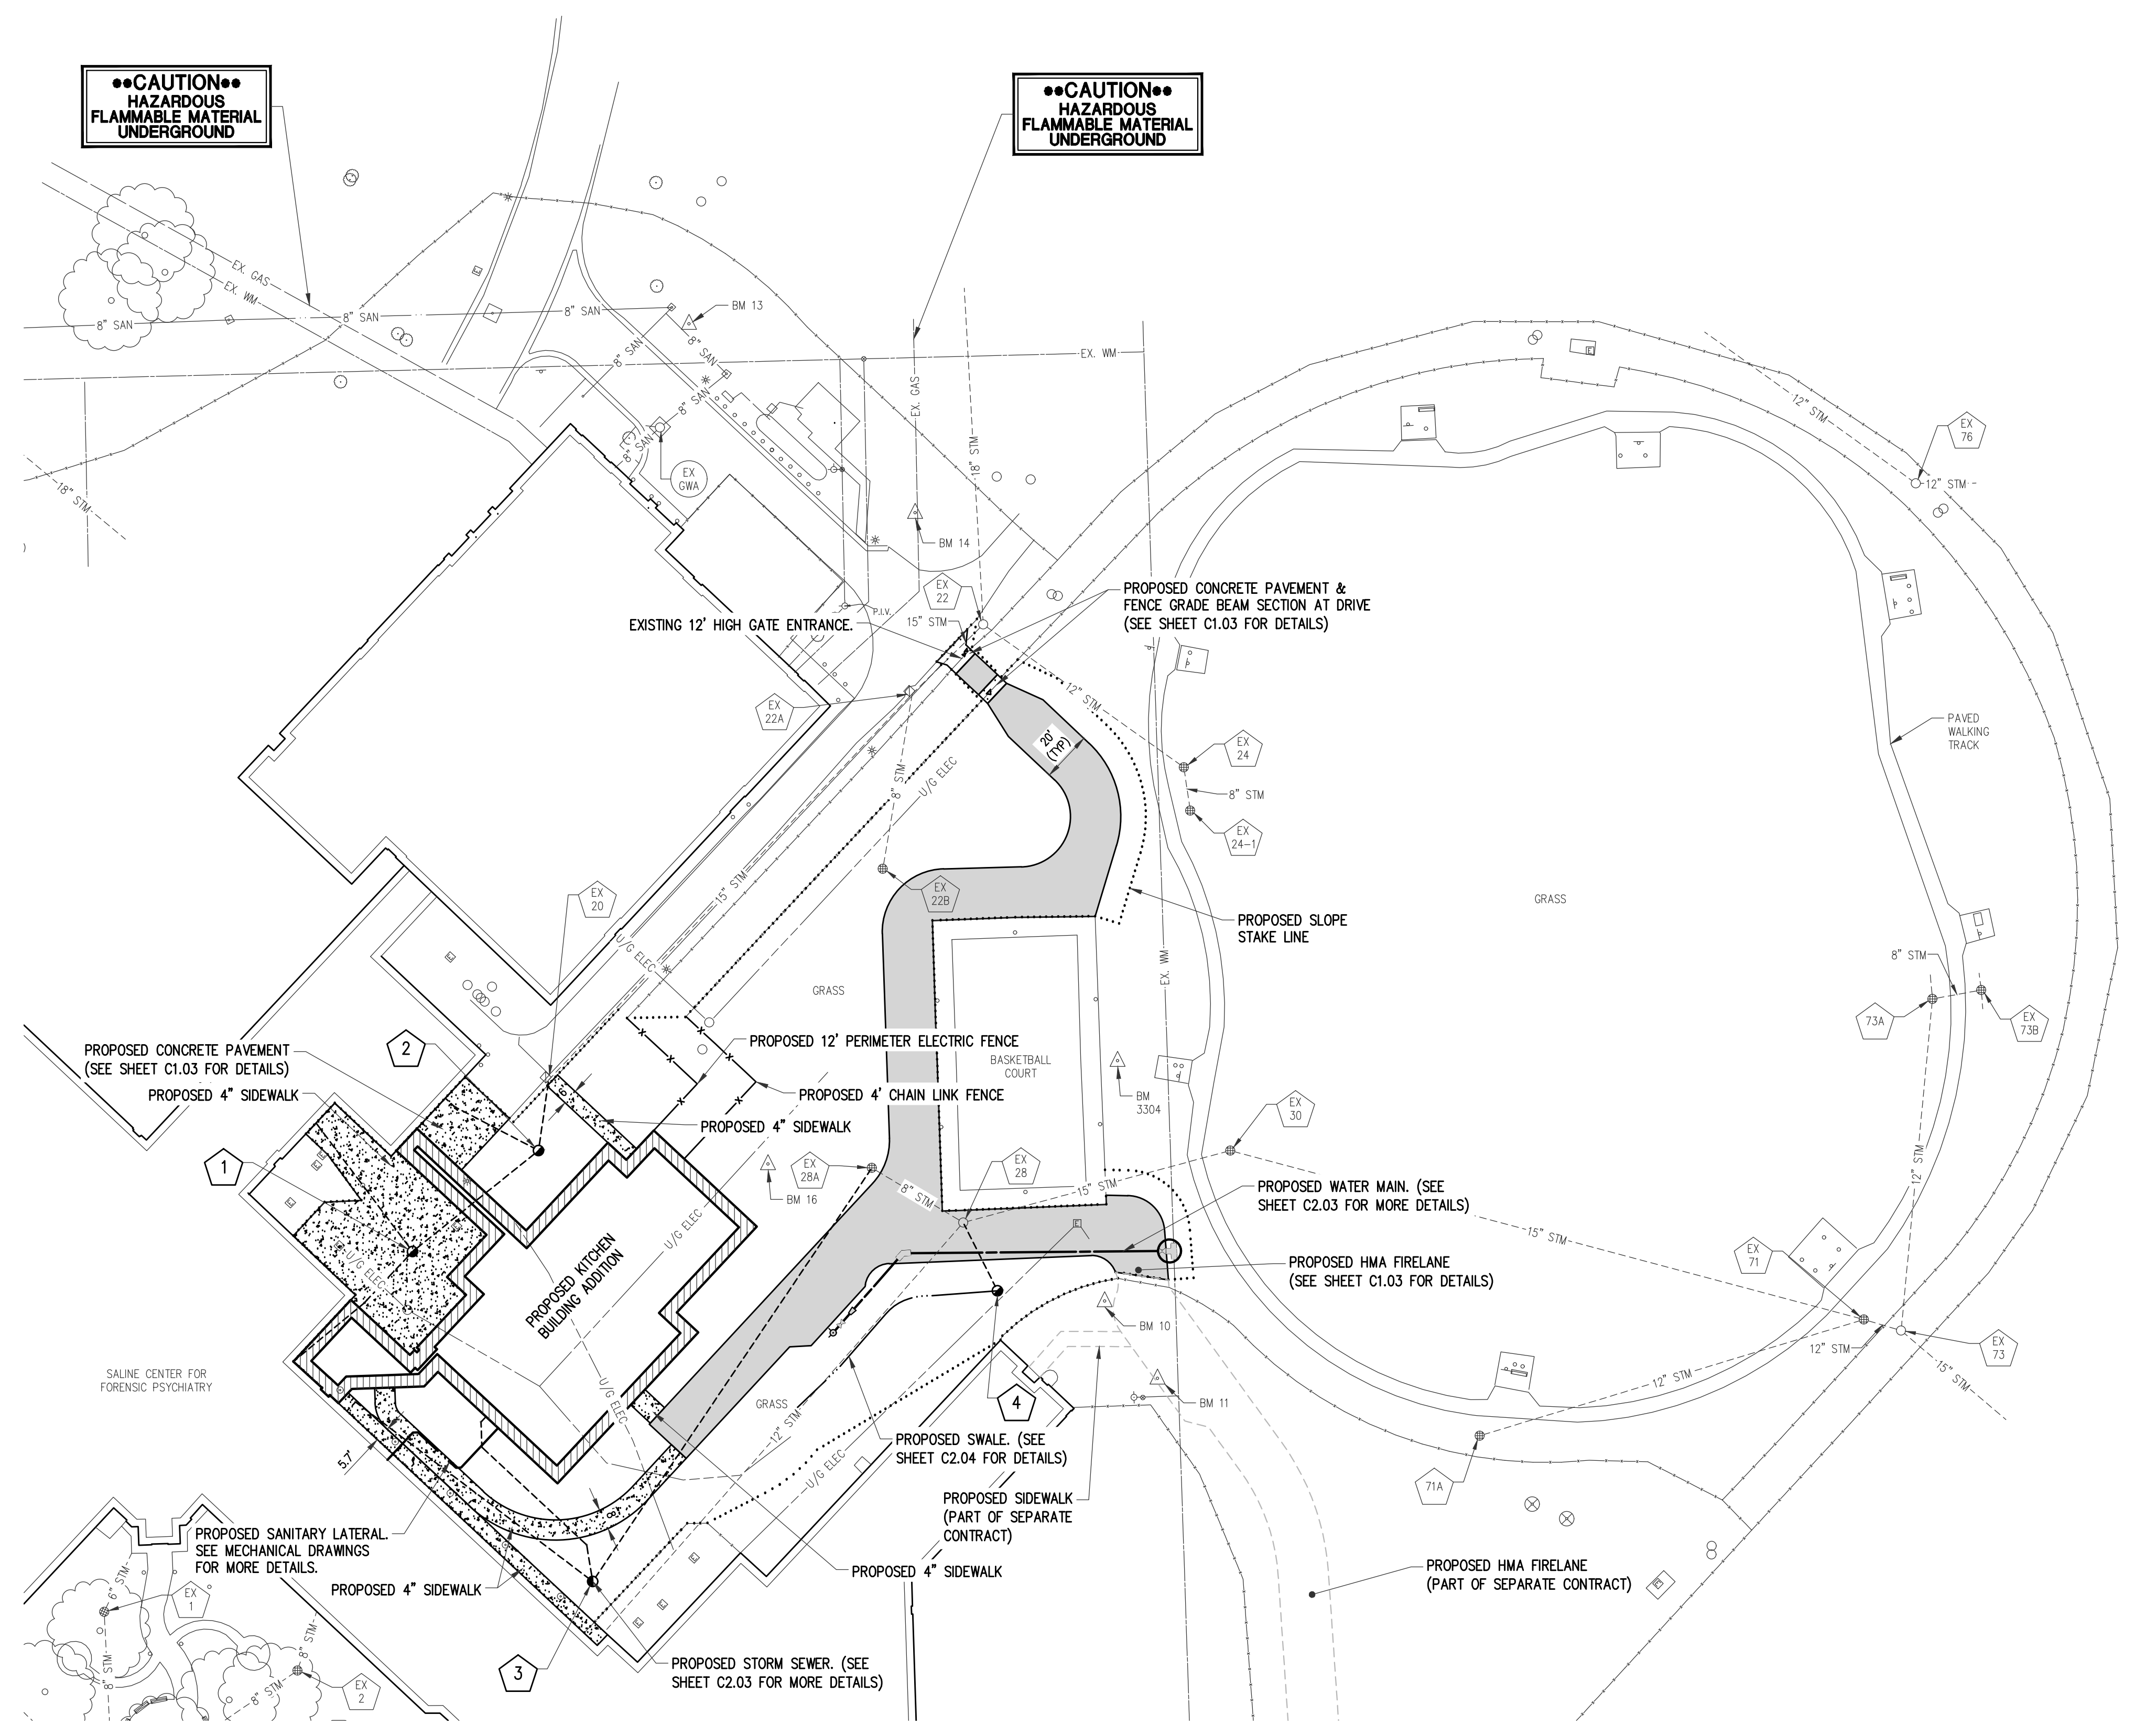


NO.	REVISION	DATE

STATE OF MICHIGAN
DEPARTMENT OF TECHNOLOGY, MANAGEMENT AND BUDGET
FACILITIES AND BUSINESS SERVICE ADMINISTRATION
DESIGN AND CONSTRUCTION DIVISION
ADAM LACHÉ, DIRECTOR

FILE NO.
491/20167.SDW

FUNDING CODE 171CDHHS7255 CONTRACT NO. Y22003

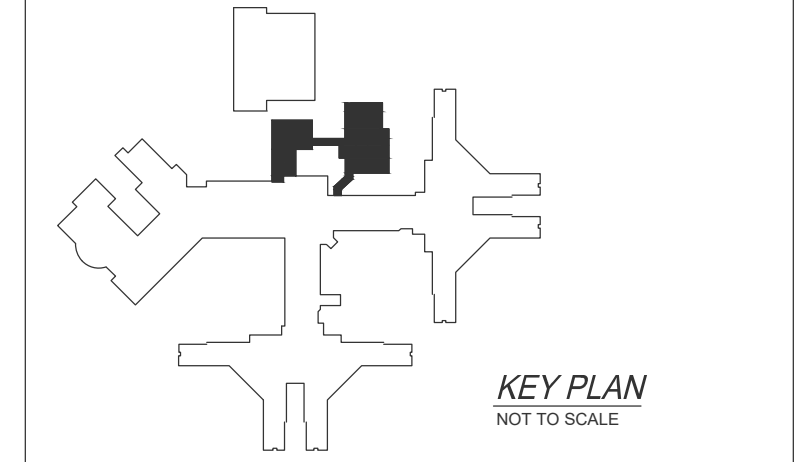

WTAARCH.COM

WTA ARCHITECTS
100 S Jefferson Ave, Suite 601
Saginaw, Michigan 48607
989 752 8107
COPYRIGHT © 2023

ROWE PROFESSIONAL SERVICES COMPANY

PROJECT TITLE
491/20167.SDW CFP - PHASE 500


CENTER FOR FORENSIC PSYCHIATRY - CREATE KITCHEN
SALINE, MICHIGAN




SHEET TITLE
SITE PLAN

PROJECT NUMBER 2021094 SHEET NUMBER

PROJECT DATE SEPTEMBER 6, 2023 C2.02

CHECKED BY A.J.T.

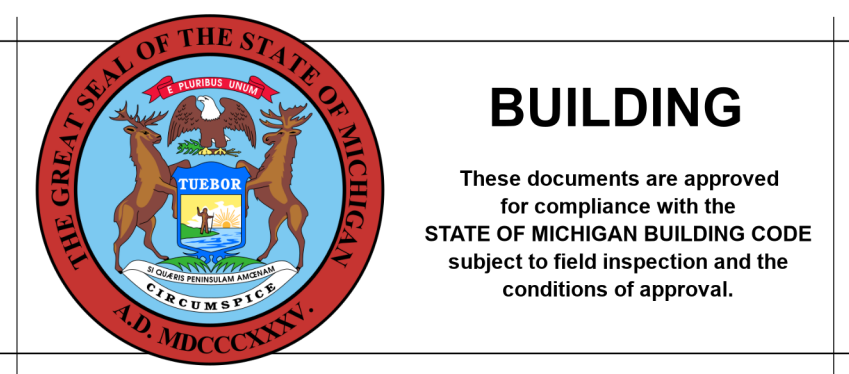

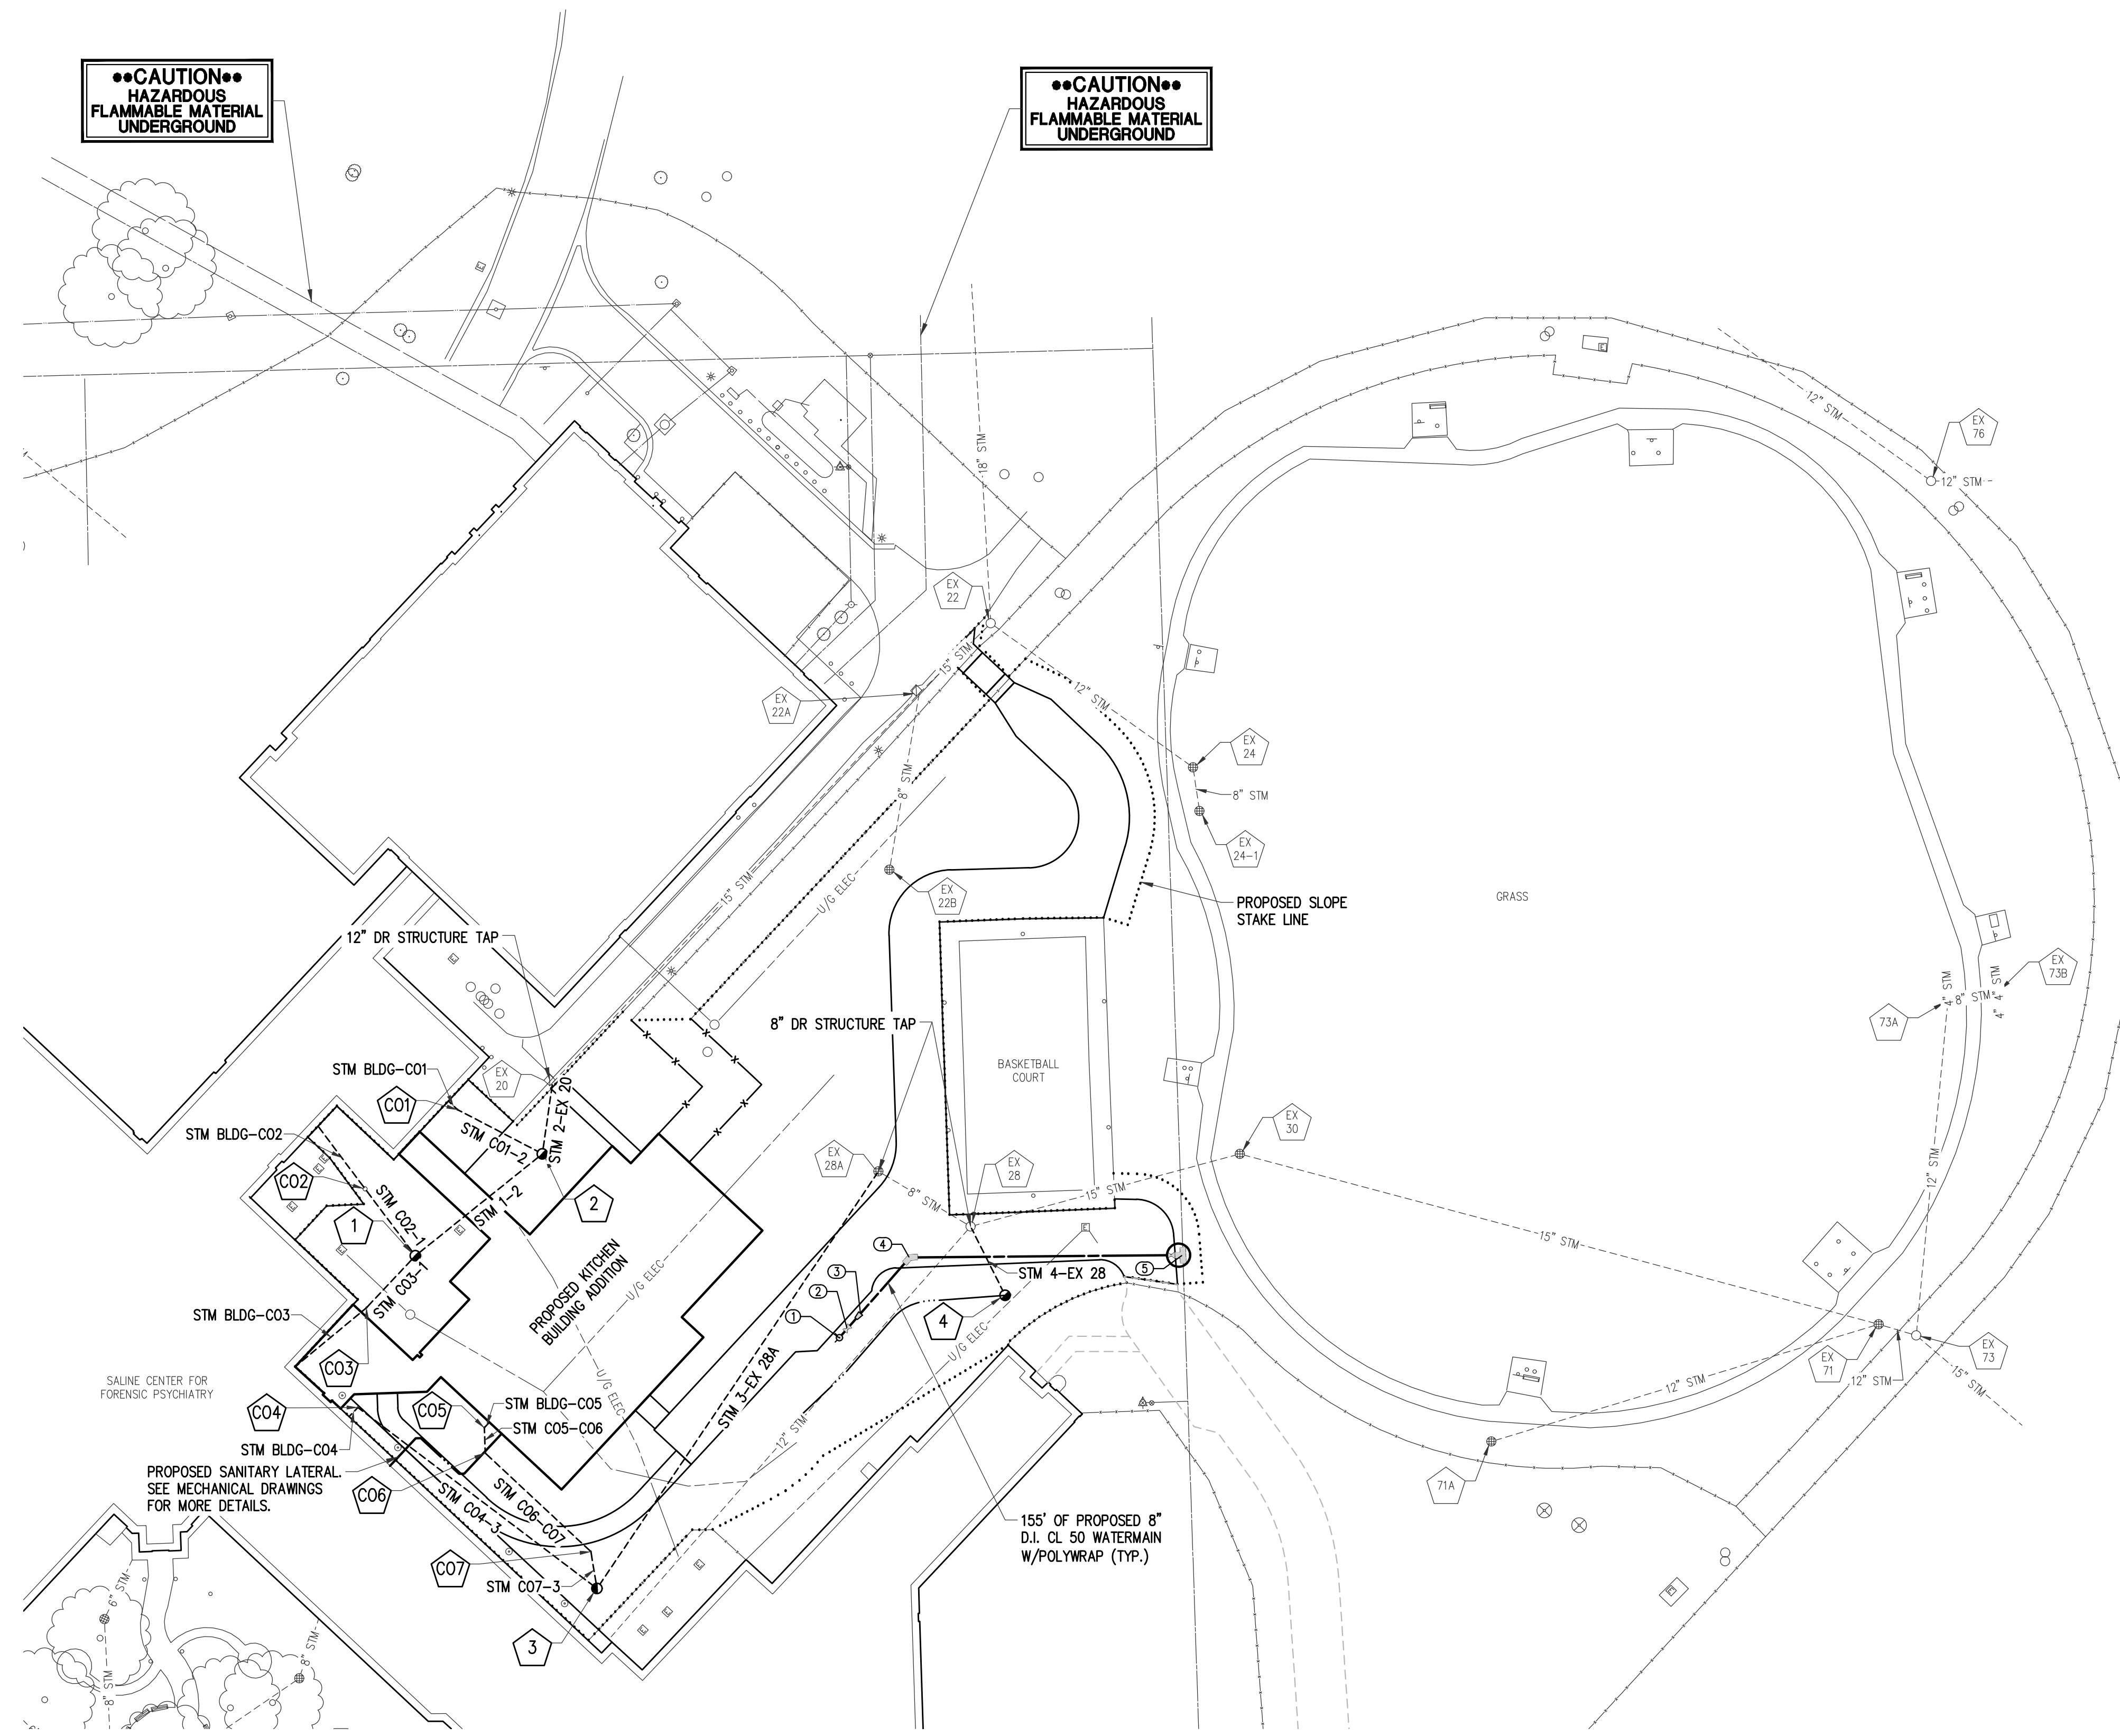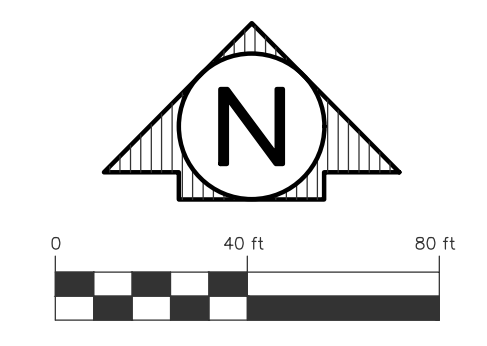
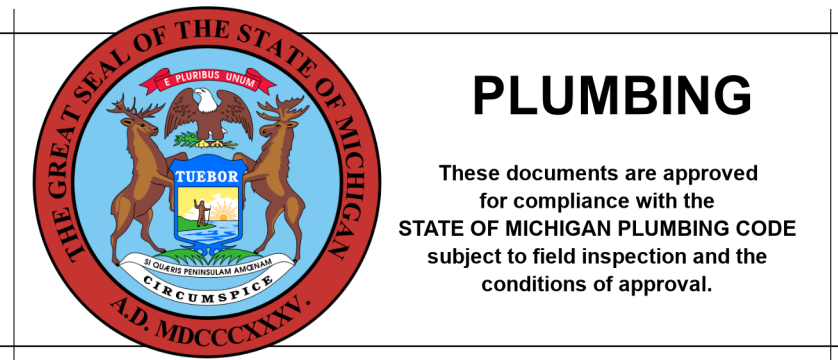


PROPOSED STORM SEWER STRUCTURE TABLE					
STRUCT NO.	DIA.	COVER TYPE	RIM ELEVATION	INVERT	EASTING
EX 28	N/A	N/A	RM=835.09	12" 827.27 SW (EX) 8" 829.27 SE (PR) 8" 825.61 NW (EX) 15" 819.10 E (EX)	244819.86
EX 20	N/A	N/A	T/C=834.37	12" 830.29 S (PR) 15" 830.29 NE (EX)	13306008.16
EX 28A	N/A	N/A	RM=833.60	8" 828.18 SW (PR) 8" 828.18 SE (EX)	13306136.61
1	48"	G	RM=835.60	12" 831.21 NE (PR) 6" 831.46 SW (PR) 6" 831.46 NW (PR)	13305954.08
2	48"	G	RM=835.63	12" 830.57 N (PR) 12" 830.57 SW (PR) 6" 830.82 NW (PR)	13306004.16
3	48"	G	RM=834.30	8" 830.16 NE (PR) 6" 830.84 NW (PR) 6" 830.65 N (PR)	13306025.68
4	24"	G	RM=833.04	8" 829.57 NW (PR)	13306186.54

PROPOSED STORM SEWER PIPE TABLE					
PIPE NUMBER	DIAMETER	TOTAL LENGTH	SLOPE	TRENCH DETAIL A (T.D. A)	TRENCH DETAIL B (T.D. B)
STM 1-2	12"	64'	1.00%	42'	22'
STM 2-EX 20	12"	28'	1.00%	20'	8'
STM 3-EX 28A	8"	198'	1.00%	8'	190'
STM 4-EX 28	8"	30'	1.00%	5'	25'
STM BLDG-C01	6"	5'	1.00%	0'	5'
STM BLDG-C02	12"	31'	1.00%	0'	31'
STM BLDG-C03	6"	37'	1.00%	0'	37'
STM BLDG-C04	6"	5'	1.00%	0'	5'
STM BLDG-C05	6"	3'	1.00%	0'	3'
STM C01-2	6"	38'	1.00%	10'	28'
STM C02-1	6"	33'	1.00%	8'	25'
STM C03-1	6"	28'	1.00%	5'	23'
STM C04-3	6"	118'	1.00%	0'	118'
STM C05-C06	6"	10'	1.00%	7'	3'
STM C06-C07	6"	57'	1.00%	15'	42'
STM C07-3	6"	15'	1.00%	12'	3'

WATER MAIN FITTING TABLE			
POINT	FITTING TYPE	NORTHING	EASTING
1	HYDRANT ASSEMBLY	244776.00	13306121.18
2	6" GATE VALVE	244779.62	13306124.36
3	8" x 6" REDUCER	244785.58	13306129.58
4	45° BEND	244807.65	13306148.92
5	8" x 12" TAPPING SLEEVE & VALVE IN WELL	244808.58	13306256.48


PROPOSED CLEANOUT TABLE		
CLEANOUT	NORTHING	EASTING
CO1	244865.88	13305970.76
CO2	244834.65	13305934.31
CO3	244787.91	13305934.89
CO4	244748.56	13305931.40
CO5	244740.57	13305981.26
CO6	244730.57	13305981.61
CO7	244691.72	13306023.27

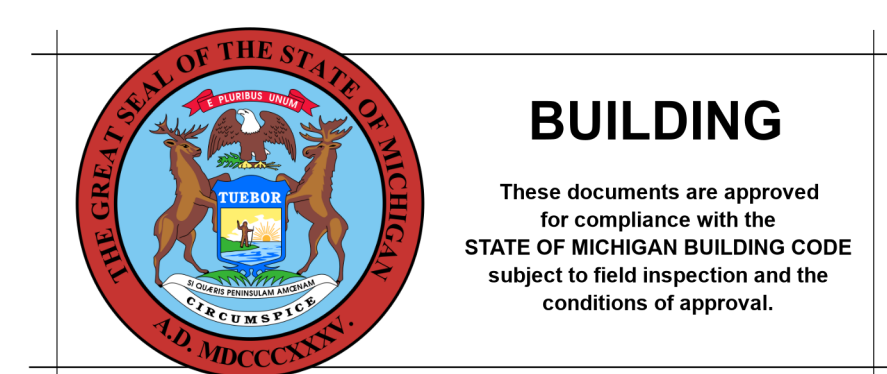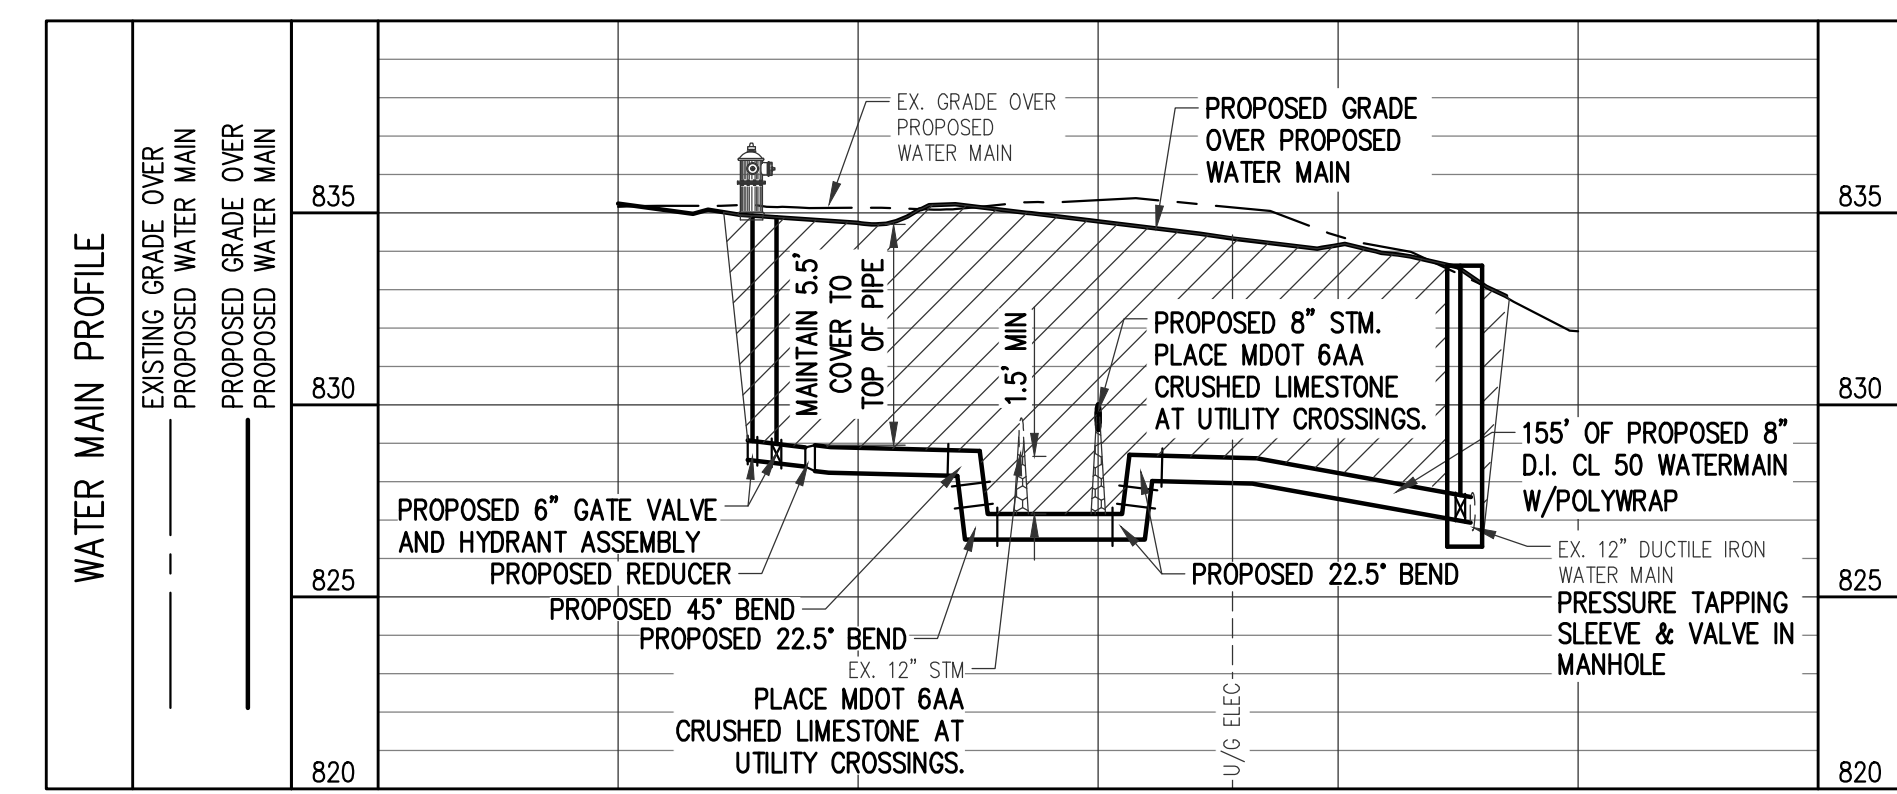

NO.	REVISION	DATE



FILE NO.
491/20167.SDW
FUNDING CODE
171CODHHS7255
CONTRACT NO.
Y22003

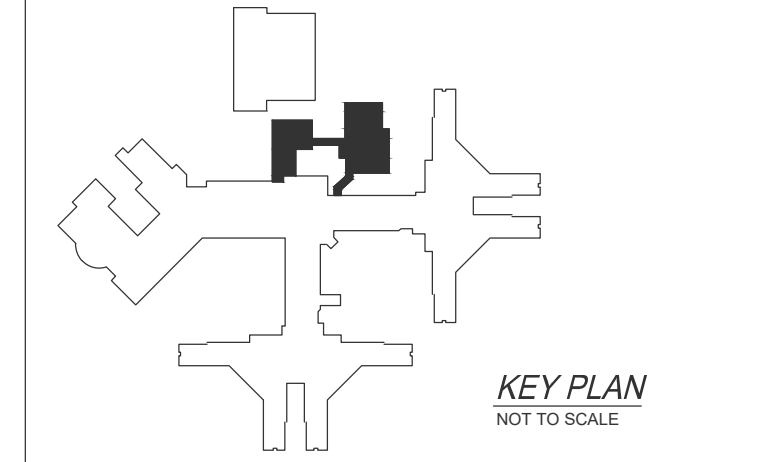

WTAARCH.COM

WTA ARCHITECTS
100 S Jefferson Ave, Suite 601
Saginaw, Michigan 48607
989 752 8107
COPYRIGHT © 2023

ROWE PROFESSIONAL SERVICES COMPANY

PROJECT TITLE
491/20167.SDW CFP - PHASE 500
CENTER FOR FORENSIC PSYCHIATRY - CREATE KITCHEN
SALINE, MICHIGAN

SHEET TITLE
UTILITY PLAN

PROJECT NUMBER 2021094	SHEET NUMBER C2.03
PROJECT DATE SEPTEMBER 6, 2023	CHECKED BY A.J.T.


GRADING TABLE				
POINT	ELEVATION	DESCRIPTION	NORTHING	EASTING
100	TW=835.88	PC	244707.13	13305976.81
101	TW=836.39	PC	244743.58	13305949.46
102	TW=836.94	PC	244712.98	13305982.26
103	TW=836.32	PC	244737.73	13305944.00
104	TW=836.44	PC	244748.17	13305939.24
105	TW=836.44	PC	244748.45	13305947.24
106	TW=836.50	ME	244846.22	13305945.58
107	TW=836.50	ME	244855.07	13305911.86
108	TW=836.50	ME	244848.42	13305947.63
109	TW=836.51	ME	244846.88	13305920.36
110	TW=836.33	ME	244823.43	13305957.90
111	TW=836.50	ME	244867.31	13305923.18
112	TW=836.50	ME	244831.69	13305965.57
113	TW=836.26	ME	244828.69	13305933.78
114	TW=836.27	ME	244829.58	13305951.26
115	TW=836.50	ME	244857.19	13305955.82
116	TW=836.00	ME	244877.73	13305974.97
117	TW=836.50	ME	244840.72	13305973.48
118	TW=835.73	ME	244861.26	13305992.63
119	TW=835.44	ME	244694.09	13306017.22
120	RM=834.30	ME	244677.20	13306025.68
121	TW=836.07	ME	244874.11	13306007.56
122	TW=836.05	ME	244878.49	13306011.66
123	TW=836.50	ME	244844.77	13306039.02

GRADING TABLE				
POINT	ELEVATION	DESCRIPTION	NORTHING	EASTING
124	TW=836.40	ME	244849.15	13306043.12
125	ME=836.05	ME	244901.07	13306039.28
126	ME=835.59	ME	244901.07	13306062.75
127	TW=836.50	ME	244814.66	13306096.74
128	TW=836.50	ME	244754.02	13306039.04
129	TW=836.50	ME	244754.30	13305947.03
130	TW=836.06	TP	244726.12	13306062.81
131	TW=836.17	TP	244731.57	13306056.95
132	TW=836.29	TP	244739.70	13306048.15
133	TW=836.50	ME	244747.42	13306040.76
134	TW=836.50	ME	244753.52	13306046.44
135	TW=836.29	TP	244746.15	13306045.18
136	TW=835.86	PC	244715.13	13306041.70
137	TW=835.78	PC	244709.69	13306047.56
138	RM=835.60	PC	244808.30	13305954.08
139	RM=835.52	PC	244848.48	13306004.16
140	TP=834.74	PC	244835.45	13306136.96
141	RM=833.60	PC	244848.51	13306136.61
142	TP=834.74	PC	244853.31	13306143.61
143	TP=834.98	PC	244934.55	13306165.14
144	TP=834.67	PC	244960.41	13306165.14
145	TP=834.37	PC	244961.22	13306196.03
146	TP=834.10	PC	244965.22	13306207.51
147	TP=834.46	PC	244995.77	13306209.21

GRADING TABLE				
POINT	ELEVATION	DESCRIPTION	NORTHING	EASTING
148	TP=834.72	PC	245013.07	13306190.85
149	TP=834.88	PC	245026.20	13306182.61
150	TP=834.93	PC	245029.63	13306178.98
151	TP=835.06	PC	245038.01	13306170.08
152	TP=835.11	ME	245042.73	13306162.31
153	TP=835.11	ME	245041.43	13306166.46
154	TP=834.97	ME	245055.73	13306174.61
155	TP=834.91	ME	245049.44	13306173.99
156	TP=834.86	ME	245046.02	13306177.62
157	TP=834.73	ME	245037.64	13306186.52
158	TP=834.68	ME	245034.21	13306190.16
159	TP=834.52	ME	245027.63	13306204.57
160	TP=834.26	PC	245010.33	13306223.83
161	TP=833.84	PC	244969.85	13306233.79
162	TP=833.51	ME	244941.53	13306225.30
163	TP=834.01	ME	244941.15	13306193.63
164	TP=834.54	ME	244939.83	13306160.64
165	TP=834.96	ME	244933.52	13306162.14
166	TP=835.04	ME	244884.64	13306162.54
167	TP=835.31	ME	244824.44	13306164.62
168	TP=835.23	ME	244824.56	13306169.98
169	TP=834.12	ME	244827.05	13306229.80
170	TP=834.14	ME	244830.70	13306229.65
171	TP=833.69	PC	244830.52	13306238.32


GRADING TABLE				
POINT	ELEVATION	DESCRIPTION	NORTHING	EASTING
172	TP=833.46	PC	244816.12	13306252.98
173	TP=833.76	ME	244797.03	13306254.47
174	TP=834.31	PC & ME	244800.00	13306233.36
175	TP=834.06	PC	244806.70	13306233.79
176	TP=833.23	PC	244803.49	13306143.51
177	TP=834.94	PC	244795.20	13306134.06
178	TP=834.92	PC	244794.45	13306133.93
179	TP=835.24	PC	244770.93	13306112.48
180	TP=835.35	PC	244770.45	13306103.94
181	SWALE=835.20	PC	244739.12	13306099.42
182	SWALE=834.54	PC	244761.94	13306123.34
183	SWALE=833.96	PC	244783.62	13306142.19
184	SWALE=833.65	PC	244795.20	13306155.81
185	RM=833.04	SWALE	244792.70	13306186.54
186	TW=835.57	PC	244702.01	13306016.20
187	TP=834.67	PC	244893.93	13306142.21
188	TW=836.50	ME	244656.05	13306031.57
189	TW=836.50	ME	244651.83	13306027.45
190	TW=836.50	ME	244702.93	13305972.87
191	TW=836.50	ME	244733.58	13305940.12
192	TW=836.50	ME	244748.04	13305924.64
193	TW=836.50	ME	244752.18	13305928.51
194	TW=836.50	ME	244851.59	13306031.71
195	TW=836.40	ME	244855.97	13306035.80

RADIUS POINTS				
POINT	DESCRIPTION	NORTHING	EASTING	
A	7' & 15' R	244748.70	13305954.23	
B	42' & 50' R	244743.69	13306010.91	
C	10' R	244793.49	13306143.91	
D	10' R	244796.70	13306223.97	
E	15' R	244815.52	13306238.00	
F	25' R	244935.42	13306165.79	
G	20' & 40' R	244981.21	13306195.50	
H	20' R	244770.50	13306157.28	
I	25' R	244852.45	13306118.63	

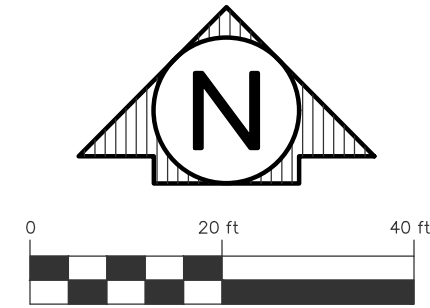


GRADING LEGEND

- TP - TOP OF PAVEMENT
- ME - TOP OF CONCRETE SIDEWALK
- PC - MATCH EXISTING ELEVATION
- RM - POINT OF CURVATURE
- SWALE - MANHOLE RIM

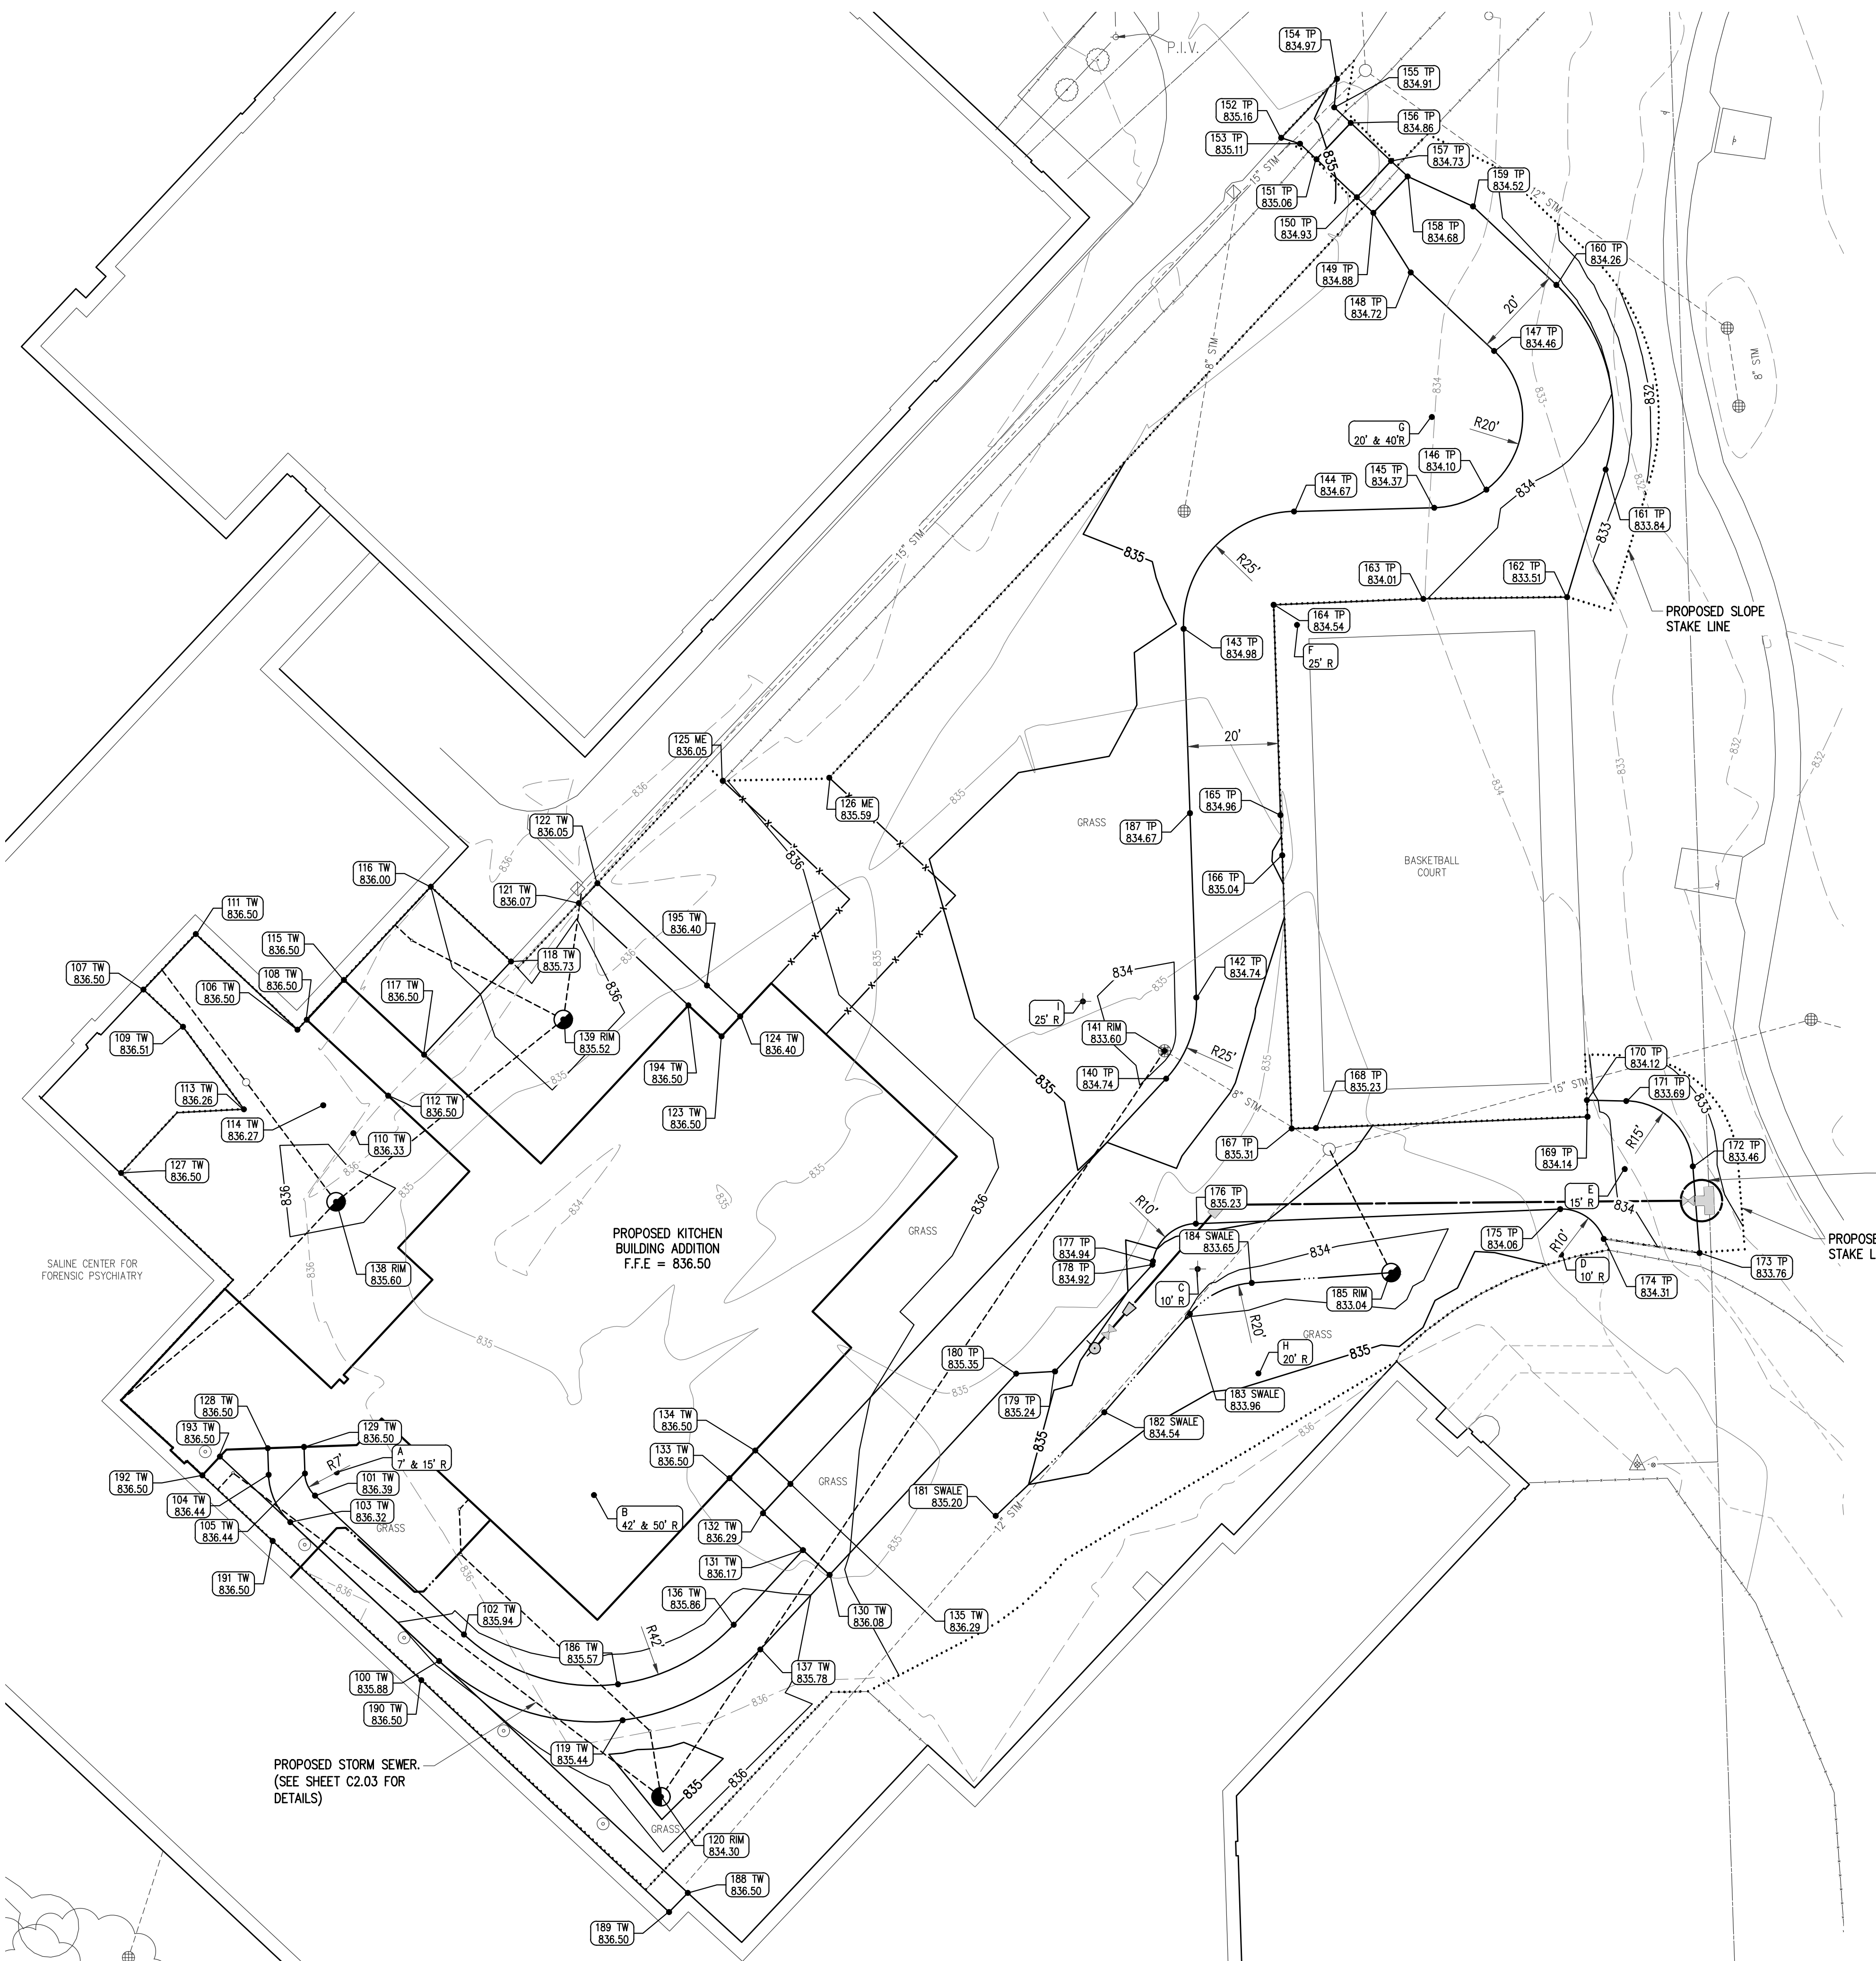

NOTES:
 1) CONTRACTOR TO COMPLETE GROUND PENETRATING RADAR WITHIN CONSTRUCTION LIMITS TO DETERMINE THE EXACT LOCATION OF UNDERGROUND UTILITIES PRIOR TO BEGINNING EXCAVATION.

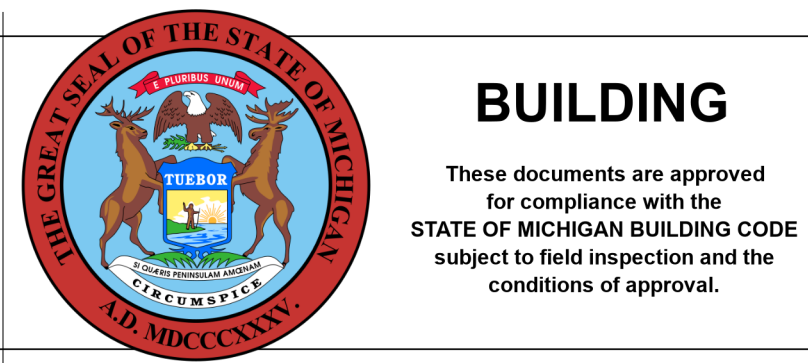

BUILDING
 These documents are approved for compliance with the STATE OF MICHIGAN BUILDING CODE subject to field inspection and the conditions of approval.




NO.	REVISION	DATE

STATE OF MICHIGAN
 DEPARTMENT OF TECHNOLOGY, MANAGEMENT AND BUDGET
 FACILITIES AND BUSINESS SERVICE ADMINISTRATION
 DESIGN AND CONSTRUCTION DIVISION
 ADAM LACER, DIRECTOR

FILE NO.
 491/20167.SDW

FUNDING CODE
 171CODHHS7255

CONTRACT NO.
 Y22003

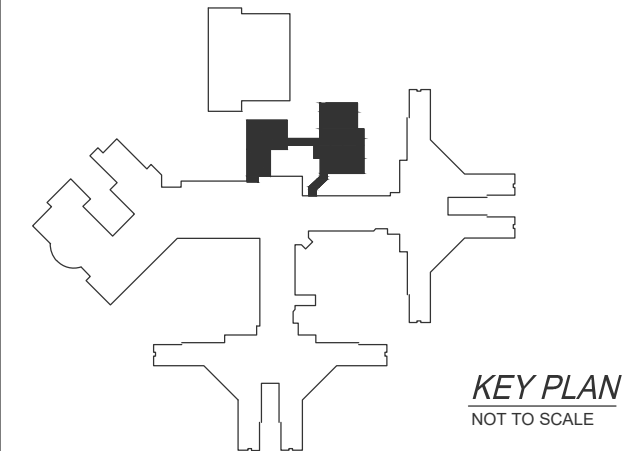

WTAARCH.COM

WTA ARCHITECTS

100 S Jefferson Ave, Suite 601
 Saginaw, Michigan 48607
 989 752 8107

ROWE PROFESSIONAL SERVICES COMPANY

PROJECT TITLE
 491/20167.SDW CFP - PHASE 500

CENTER FOR FORENSIC PSYCHIATRY - CREATE
 KITCHEN
 SALINE, MICHIGAN


SHEET TITLE
 GRADING PLAN

PROJECT NUMBER
 2021094

SHEET NUMBER
 C2.04

PROJECT DATE
 SEPTEMBER 6, 2023

CHECKED BY
 A.J.T.

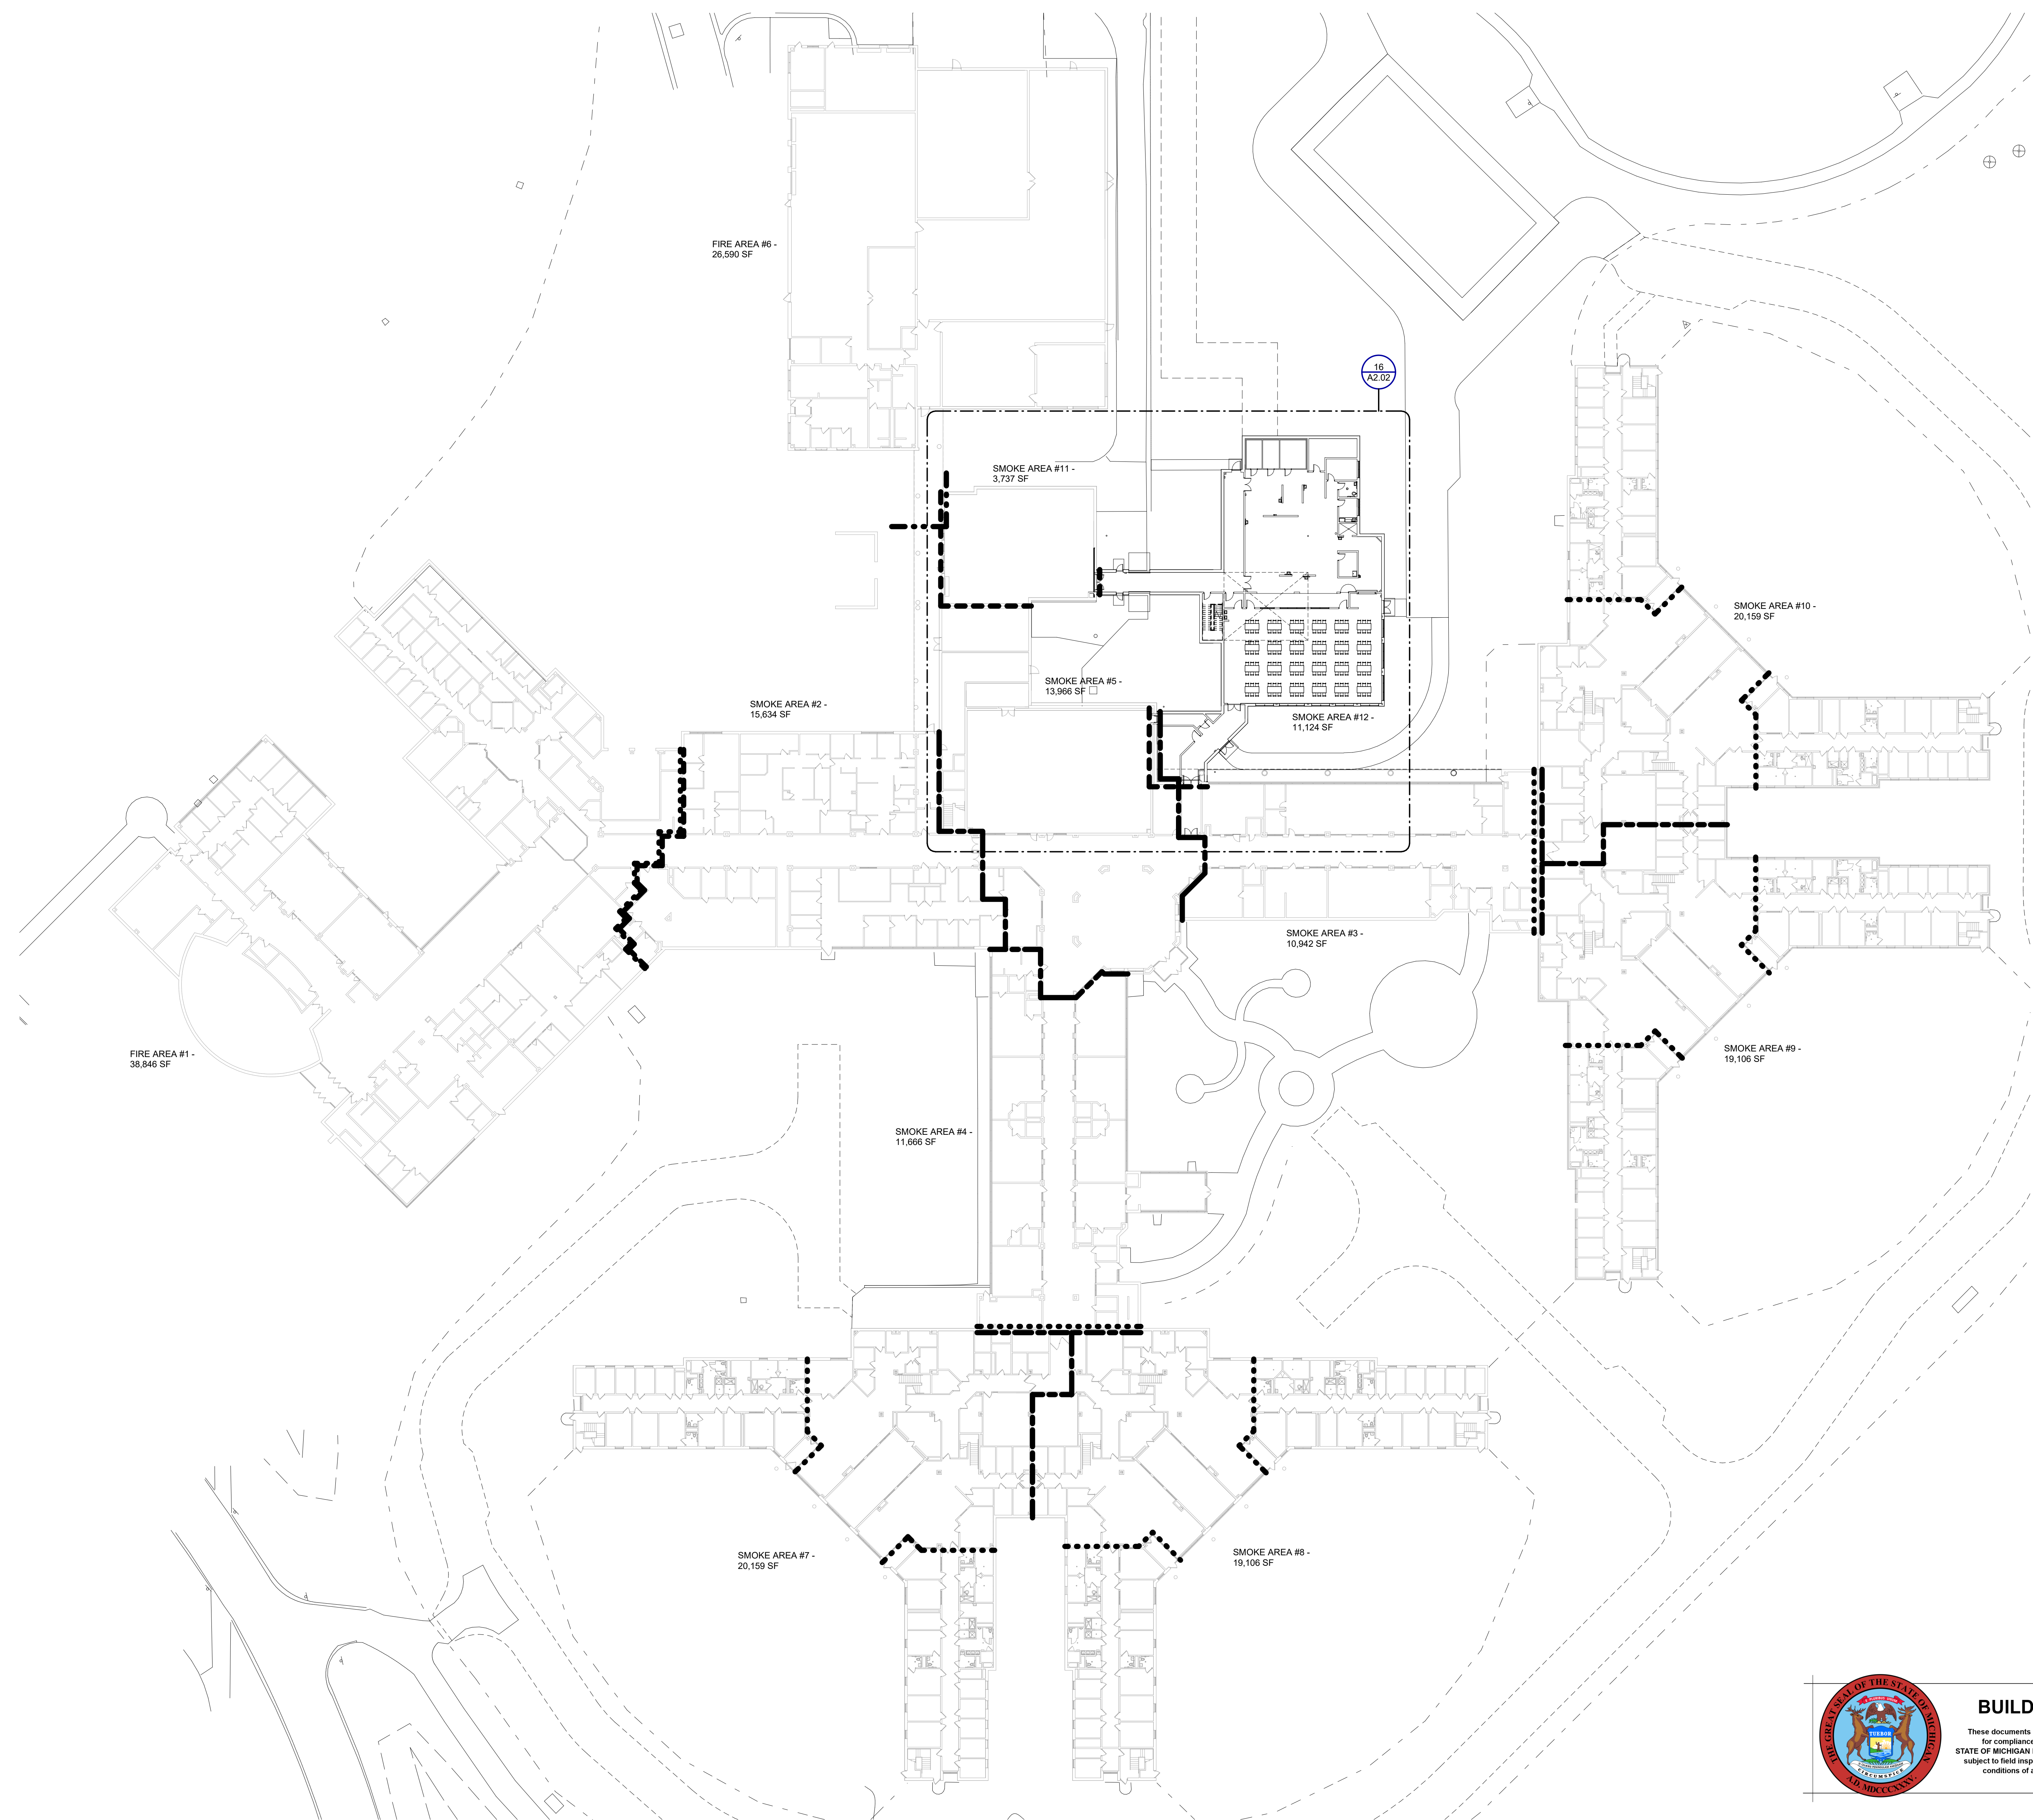

CODE LEGEND


- 3-HOUR BUILDING SEPARATION
- 2-HOUR BARRIER
- 1-HOUR ENCLOSURE
- 1-HOUR SMOKE BARRIER
- TRAVEL DISTANCE
- 100% SPRINKLED
- DF** DRINKING FOUNTAIN
- FE** FIRE EXTINGUISHER
- OCCUPANT LOAD
- EXIT CAPACITY

NO.	REVISION	DATE

STATE OF MICHIGAN
 DEPARTMENT OF TECHNOLOGY, MANAGEMENT AND BUDGET
 FACILITIES AND BUSINESS SERVICES ADMINISTRATION
 DESIGN AND CONSTRUCTION DIVISION
 ADAM LACEL, R.A., DIRECTOR

FILE NO.
 491/20167.SDW

FUNDING CODE 171CODHHS7255 CONTRACT NO. Y22003

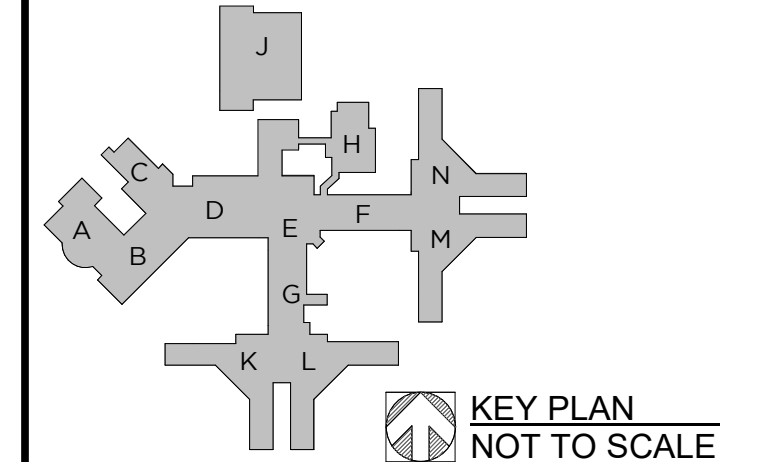


WTAARCH.COM

WTA ARCHITECTS
 100 S Jefferson Ave, Suite 601
 Saginaw, Michigan 48607
 989 752 8107 COPYRIGHT © 2023

PROJECT TITLE
 491/20167.SDW - PHASE 500:
 CENTER FOR FORENSIC
 PSYCHIATRY - CREATE
 KITCHEN
 SALINE, MICHIGAN


SHEET TITLE
 FIRST FLOOR MASTER
 CODE PLAN

PROJECT NUMBER 2021094	SHEET NUMBER A2.01
PROJECT DATE SEPTEMBER 6, 2023	
CHECKED BY C.D.S.	

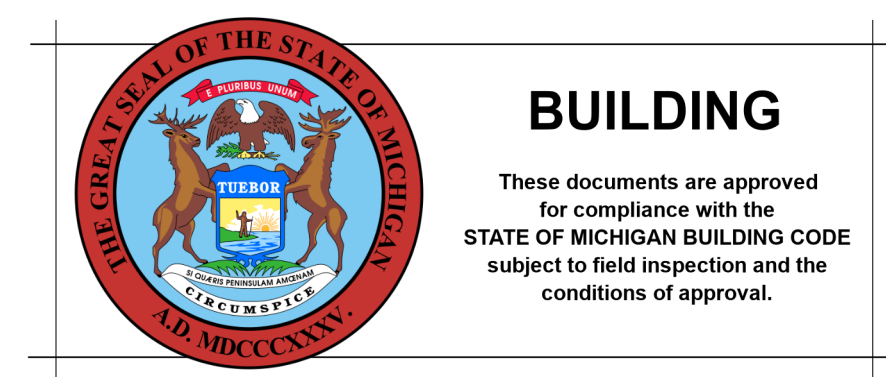


FIRST FLOOR MASTER PLAN
 TRUE NORTH SCALE: 1/32" = 1'-0"

CENTER FOR FORENSIC PSYCHIATRY - BUILDING CODE NOTES				
CODE REFERENCE	2012 NFPA 2015 MICHIGAN BUILDING CODE ANSI A117.1 2015 PLUMBING CODE 2015 ELECTRICAL CODE 2015 MECHANICAL CODE			
DESCRIPTION	REFERENCE	EXISTING	NEW ADDITION	REMARKS
OCCUPANCY CLASSIFICATION	MBC 303.3 / 308.4	I-2 CONDITION 1	A-2	ASSEMBLY - DINING FACILITY & ASSOCIATED KITCHEN / INSTITUTIONAL - PSYCHIATRIC HOSPITAL
CONSTRUCTION TYPE	MBC 601	IB	IIB	TYPE IIB: RATING FOR BLDG ELEMENTS = 0-HOUR TYPE IB: RATING FOR BLDG ELEMENTS = 2-HOUR EXCEPTION: NONBEAR INT WALLS = 0-HOUR ROOF = 1-HOUR
NONBEARING EXTERIOR WALL SEPARATION	MBC 602	IB.1 > 30 FT = 0-HOUR	IIB.A = 0-HOUR	
FEATURES OF FIRE PROTECTION		FULLY SPRINKLED		
BUILDING HEIGHT	MBC 504.4	ALLOWED - 5 STORIES - 180 FT.	ALLOWED - 3 STORIES - 75 FT.	A-2: ACTUAL - 1 STORY - 18 FT.
BUILDING AREA	MBC 506.2	UNLIMITED	ALLOWED - 38,000 S.F.	A-2: ACTUAL - 11,124 S.F.
SEPARATED OCCUPANCIES	MBC 508.4	I-2	A-2	2-HOUR FIRE BARRIER SEPARATION TO COMPLY WITH A-2 REQUIREMENTS
INCIDENTAL USE AREAS	MBC 509	FURNACE ROOM WITH >400,000 BTU PER HOUR INPUT = 1 HOUR OR SPR. BOILER ROOMS >15 PSI OR 10 HORSEPOWER = 1 HOUR OR SPR. LAUNDRY ROOM > 100 S.F. = 1-HOUR LABS = 1-HOUR & SPR. PHY PLANT MAINT SHOPS = 1-HOUR	LAUNDRY ROOM > 100 S.F. = 1-HOUR OR SPR.	BUILDING FULLY SPRINKLERED
FIRE BARRIERS	MBC 707	SEPARATED OCCUPANCIES		CONTINUITY: TOP OF FND OR FLR/CLG ASSEMBLY TO UNDERSIDE OF FLR OR ROOF ABOVE - CONT THRU OUT CONCEALED SPACES
INTERIOR WALL/CEILING FINISHES	MBC TABLE 803.11	INTERIOR EXIT STAIRWAYS - B CORRIDORS - B	ROOMS AND ENCLOSED SPACES - B ADMIN - C ≤ 4 OCC. - C	
OCCUPANT LOAD	MBC 1004.1.2	STOR/MECH 1,300 S.F. (GROSS) WAREHOUSE 1,500 S.F. (GROSS)	INPAT 1,240 S.F. (GROSS) SLEEPING 1/120 S.F. (GROSS)	KITCHEN 1,200 S.F. (GROSS) DINING ROOM/SERVING 15 S.F. (NET)
FIRE EXTINGUISHERS	NFPA 10	75' MAXIMUM DISTANCE APART		
COMMON PATH EGRESS TRAVEL	MBC 1006.2.1	75'		
NUMBER OF EXITS	MBC 1006.3.1		REQUIRED: (1) KITCHEN (2) DINING	PROVIDED: (2) DINING ROOM (2) KITCHEN
EXIT ACCESS TRAVEL DISTANCE	MBC 1017.2	200 FT.	250 FT.	
CORRIDOR FIRE RESISTANCE	MBC 1020.1	w/ SPRINKLER = 0 HOUR		FULLY SPRINKLERED
MINIMUM CORRIDOR WIDTH	MBC 1020.2	MIN. 44 INCHES		
DEAD END CORRIDORS	MBC 1020.4	20 FT.		
ACCESSIBILITY	MBC 1101.2		DESIGNED AND CONSTRUCTED TO BE ACCESSIBLE	
PLUMBING FIXTURES	MPC TABLE 403.1		NO ADDITIONAL STAFF OR PATIENTS ARE BEING ADDED TO THE FACILITY	
ENERGY EFFICIENCY	MEC		ROOF - INSULATION ENTIRELY ABOVE DECK = R-30 C.I. WALLS - MASS = R-11.4 C.I. SLAB ON GRADE = R-15 FOR 24IN.	

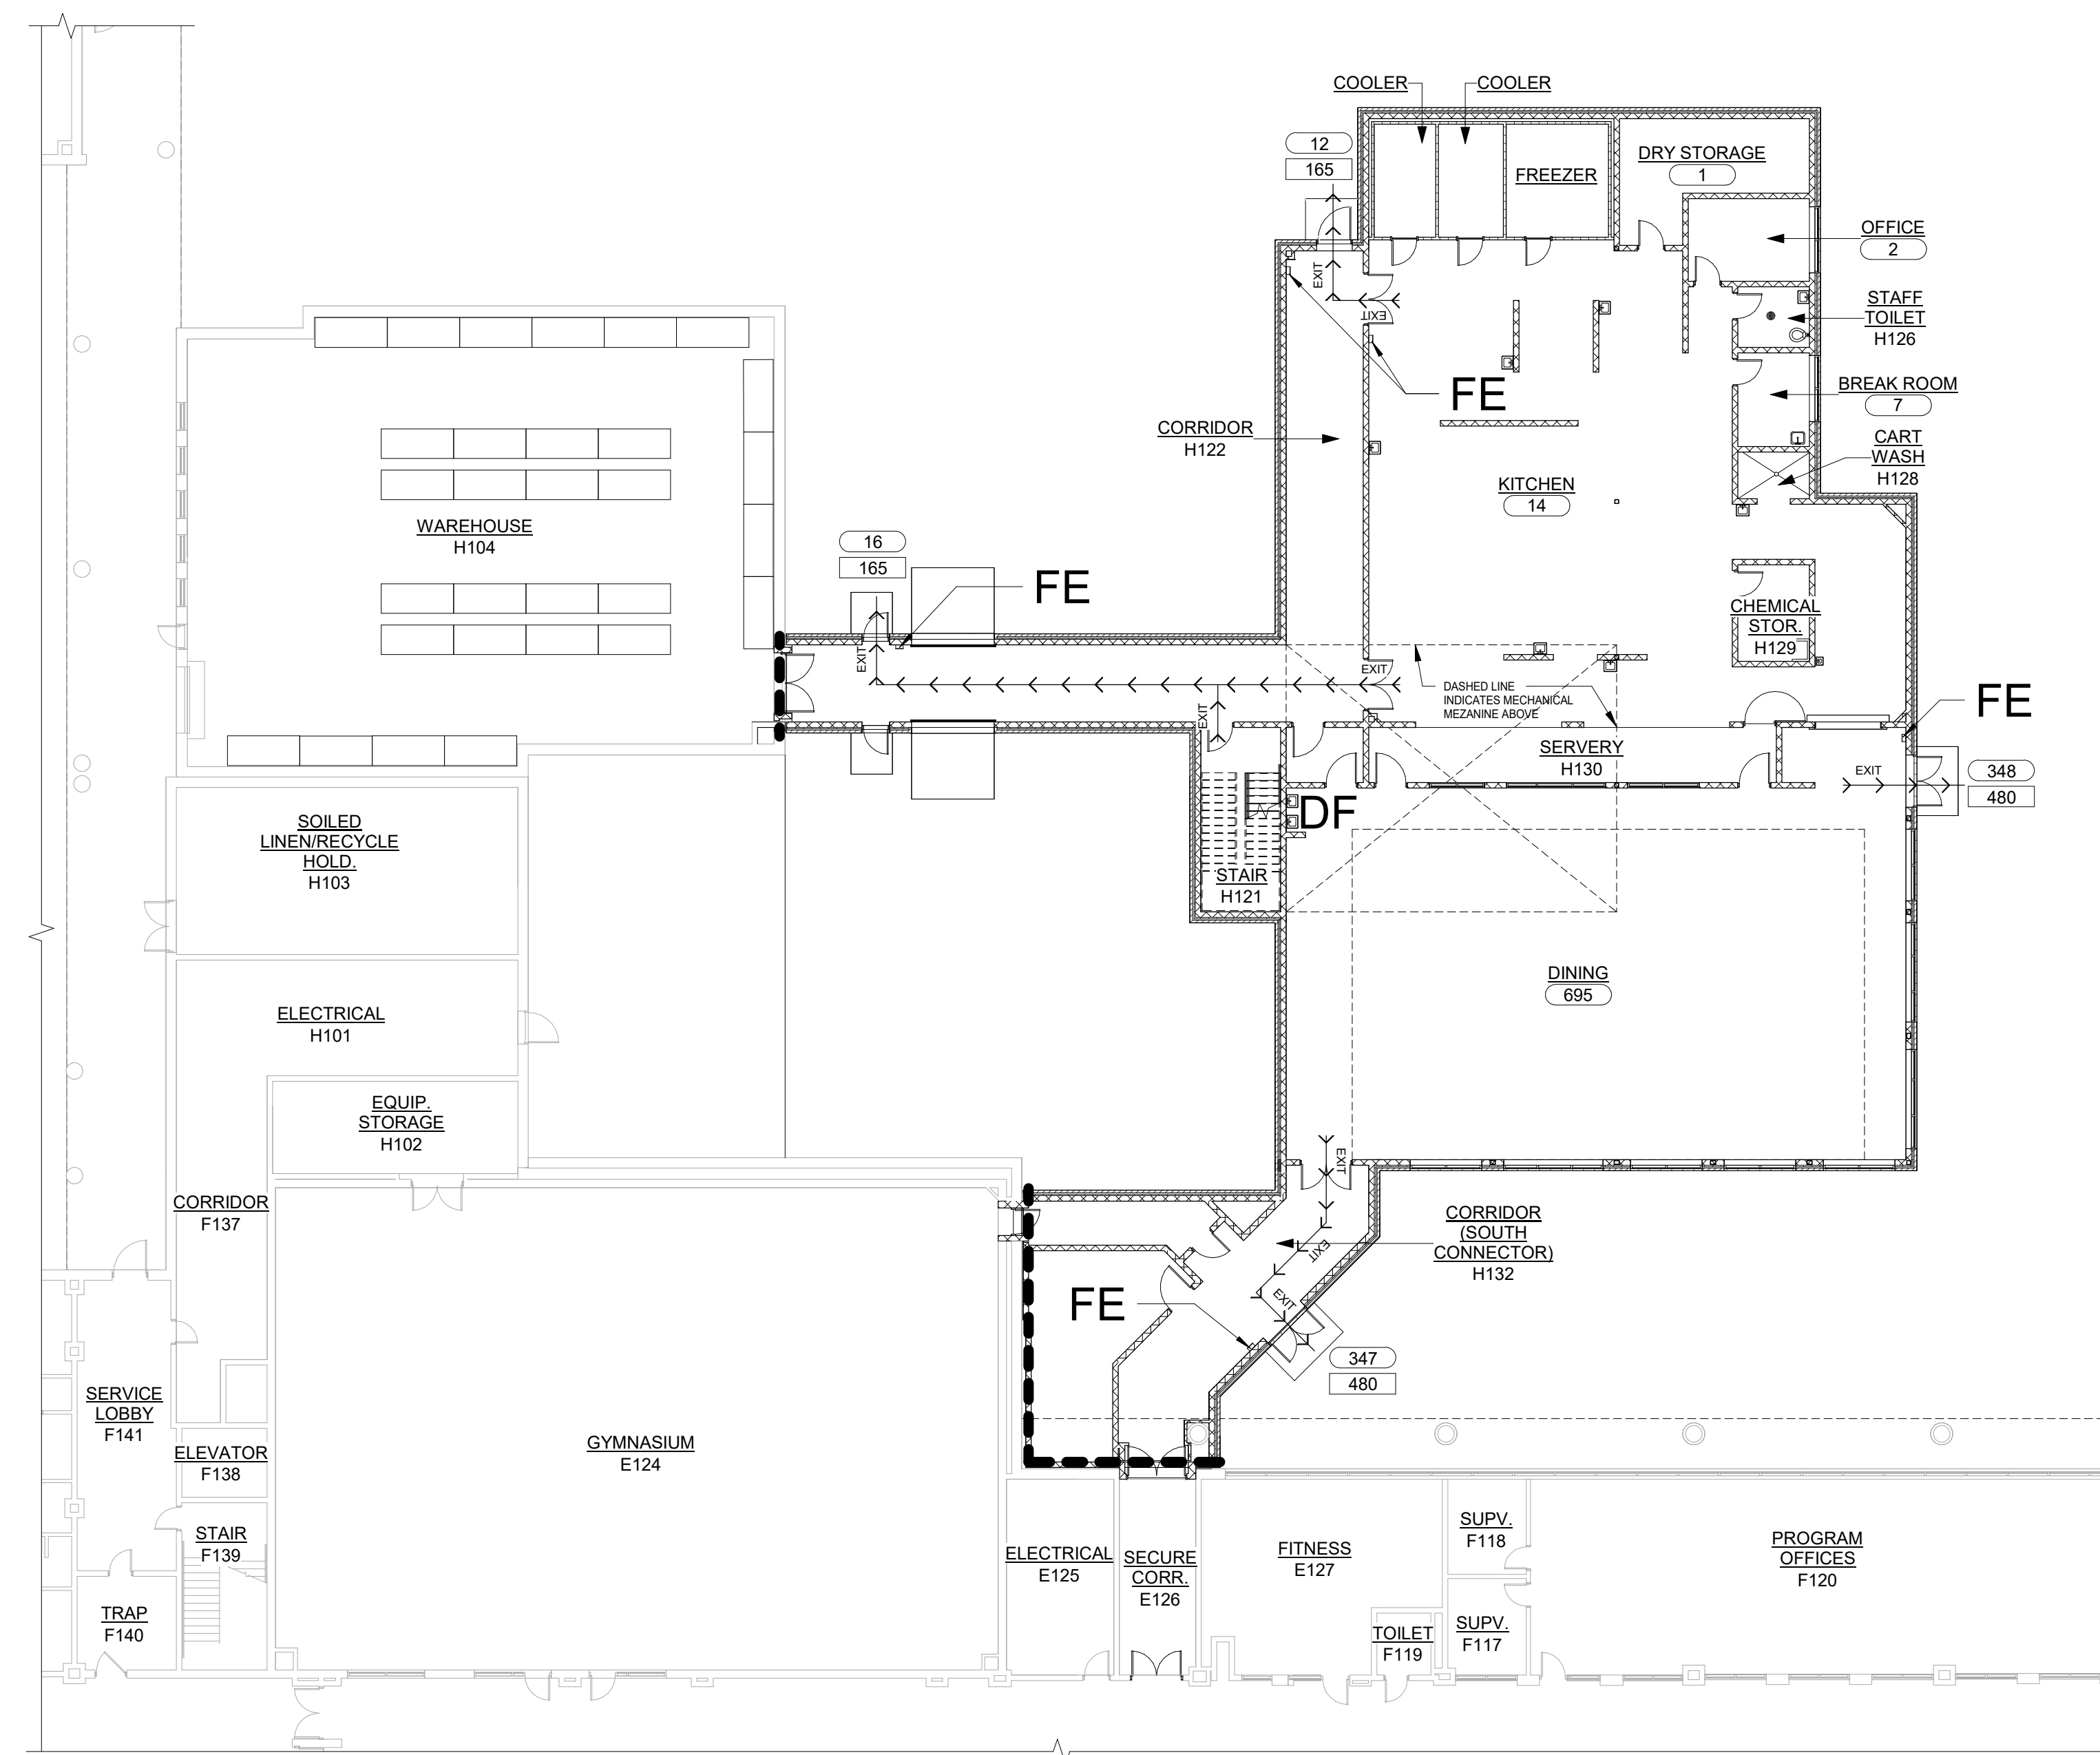

16
AZ.02
FIRST FLOOR CODE PLAN
SCALE: 1/16" = 1'-0"

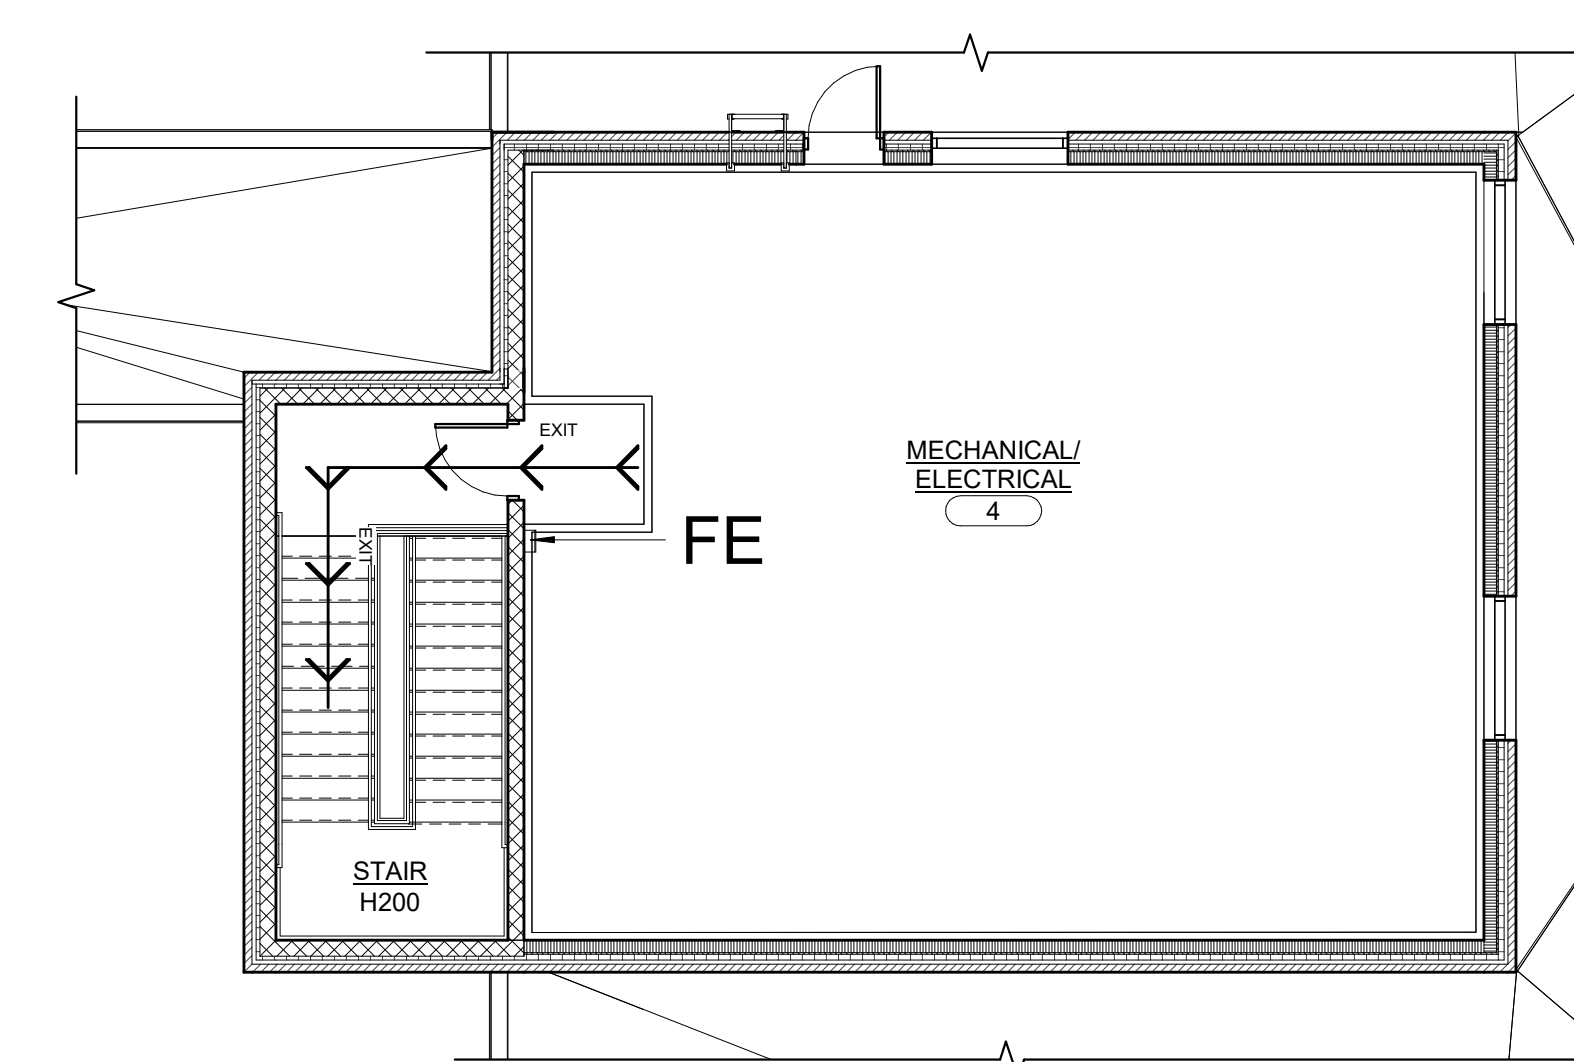

28
AZ.02
SECOND FLOOR CODE PLAN
SCALE: 1/8" = 1'-0"

CODE LEGEND	
	3-HOUR BUILDING SEPARATION
	2-HOUR BARRIER
	1-HOUR ENCLOSURE
	1-HOUR SMOKE BARRIER
	TRAVEL DISTANCE
	100% SPRINKLED
DF	DRINKING FOUNTAIN
FE	FIRE EXTINGUISHER
	OCCUPANT LOAD
	EXIT CAPACITY


NO.	REVISION	DATE

STATE OF MICHIGAN
DEPARTMENT OF TECHNOLOGY, MANAGEMENT AND BUDGET
FACILITIES AND BUSINESS SERVICES ADMINISTRATION
DESIGN AND CONSTRUCTION DIVISION
ADAM LACR, R.A. DIRECTOR

FILE NO.
491/20167.SDW

FUNDING CODE
171CODHHS7255

CONTRACT NO.
Y22003

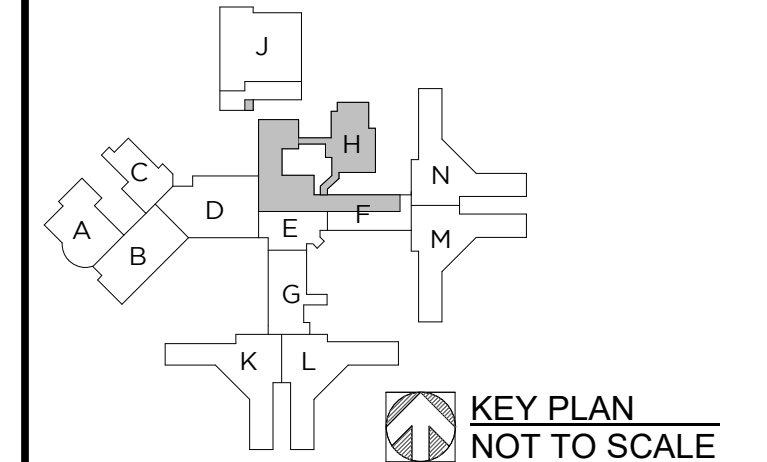

WTAARCH.COM

WTA ARCHITECTS
100 S Jefferson Ave, Suite 601
Saginaw, Michigan 48607
989 752 8107
COPYRIGHT © 2023

PROJECT TITLE
491/20167.SDW - PHASE 500:
CENTER FOR FORENSIC
PSYCHIATRY - CREATE
KITCHEN
SALINE, MICHIGAN

SHEET TITLE
FIRST FLOOR PARTIAL
CODE PLAN

PROJECT NUMBER 2021094	SHEET NUMBER A2.02
PROJECT DATE SEPTEMBER 6, 2023	
CHECKED BY C.D.S.	

BUILDING
These documents are approved for compliance with the STATE OF MICHIGAN BUILDING CODE subject to field inspection and the conditions of approval.

GENERAL DEMOLITION NOTES:

1. THE CONTRACTOR SHALL PROVIDE ALL SHORING, TEMPORARY SUPPORTS, AND BRACING REQUIRED FOR THE SAFE DEMOLITION AND ERECTION OF STRUCTURAL COMPONENTS.
2. ALL BUILDING MATERIAL BEING DEMOLISHED IS TO BE DISPOSED OF BY THE CONTRACTOR, UNLESS NOTED OTHERWISE AND EXCLUDING THOSE ITEMS SALVAGED BY THE OWNER.
3. PROTECT ADJACENT MEMBERS, FINISHES, AND SURFACES FROM DAMAGE DURING DEMOLITION WORK. CONDUCT DEMOLITION TO MINIMIZE INTERFERENCE W/ ADJACENT STRUCTURAL MEMBERS, BUILDING AREAS, AND PUBLIC AND PRIVATE THOROUGHFARES. MAINTAIN PROTECTED EGRESS AND ACCESS AT ALL TIMES.
4. PRIOR TO BEGINNING ANY DEMOLITION WORK PROVIDE TEMPORARY BARRIERS AS REQUIRED TO PREVENT MIGRATION OF DUST AND NOISE INTO ADJACENT AREAS, TO PREVENT UNAUTHORIZED ACCESS INTO THE WORK AREA, AND TO PROTECT THE GENERAL PUBLIC.
5. REFER TO MECHANICAL AND ELECTRICAL DRAWINGS FOR ADDITIONAL DEMOLITION WORK.

DEMOLITION KEYNOTES


- 1 REMOVE EXISTING DOOR, FRAME, AND ALL ASSOCIATED HARDWARE
- 2 REMOVE A PORTION OF EXISTING WALL CONSTRUCTION FOR NEW OPENING (REFER TO CONSTRUCTION PLAN)
- 3 REMOVE EXISTING CONCRETE ENTRY SLAB AND FOUNDATION
- 4 REMOVE EXISTING FENCE, REFER TO CIVIL FOR LOCATION OF TEMPORARY FENCING AND FOR FINAL FENCING LAYOUT - TEMPORARY FENCING MUST BE IN PLACE PRIOR TO DEMOLITION OF FENCING BEGINS
- 5 REMOVE EXISTING FENCE AND GATE
- 6 REMOVE AND SALVAGE EXISTING SHELVING - RETURN TO OWNER
- 7 REMOVE EXISTING WATER RESISTANT DAMPROOFING ALONG THE EXTENT OF THE FOUNDATION WALL - REFER TO CIVIL FOR COORDINATION OF SIDE WALK REMOVAL, ENTRY SLAB REMOVAL, AND FENCE MODIFICATIONS - PREP AREA FOR NEW DAMPROOFING (REFER TO CONSTRUCTION PLAN)
- 8 EXISTING CEILING TO REMAIN - MODIFY AS REQUIRED FOR NEW OPENINGS (REFER TO CONSTRUCTION PLAN)

NO.	REVISION	DATE

STATE OF MICHIGAN
DEPARTMENT OF TECHNOLOGY, MANAGEMENT AND BUDGET
FACILITIES AND BUSINESS SERVICES ADMINISTRATION
DESIGN AND CONSTRUCTION DIVISION
ADAM LACEL, R.A. DIRECTOR

FILE NO.
491/20167.SDW

FUNDING CODE 171CODHHS7255 CONTRACT NO. Y22003

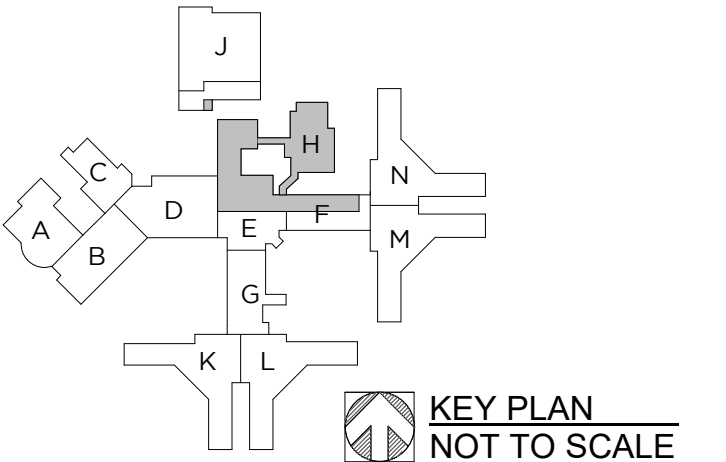



WTAARCH.COM

WTA ARCHITECTS
100 S Jefferson Ave, Suite 601
Saginaw, Michigan 48607
989 752 8107 COPYRIGHT © 2023

PROJECT TITLE
491/20167.SDW - PHASE 500:
CENTER FOR FORENSIC
PSYCHIATRY - CREATE
KITCHEN
SALINE, MICHIGAN

SHEET TITLE
**FIRST FLOOR
DEMOLITION PLAN**

PROJECT NUMBER 2021094	SHEET NUMBER A2.11
PROJECT DATE SEPTEMBER 6, 2023	CHECKED BY C.D.S.

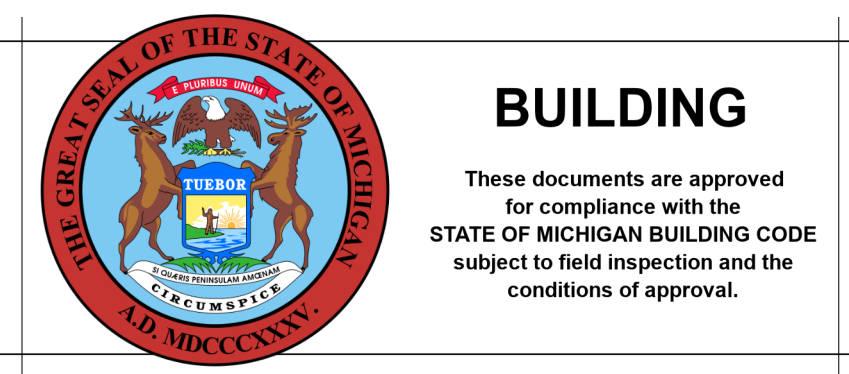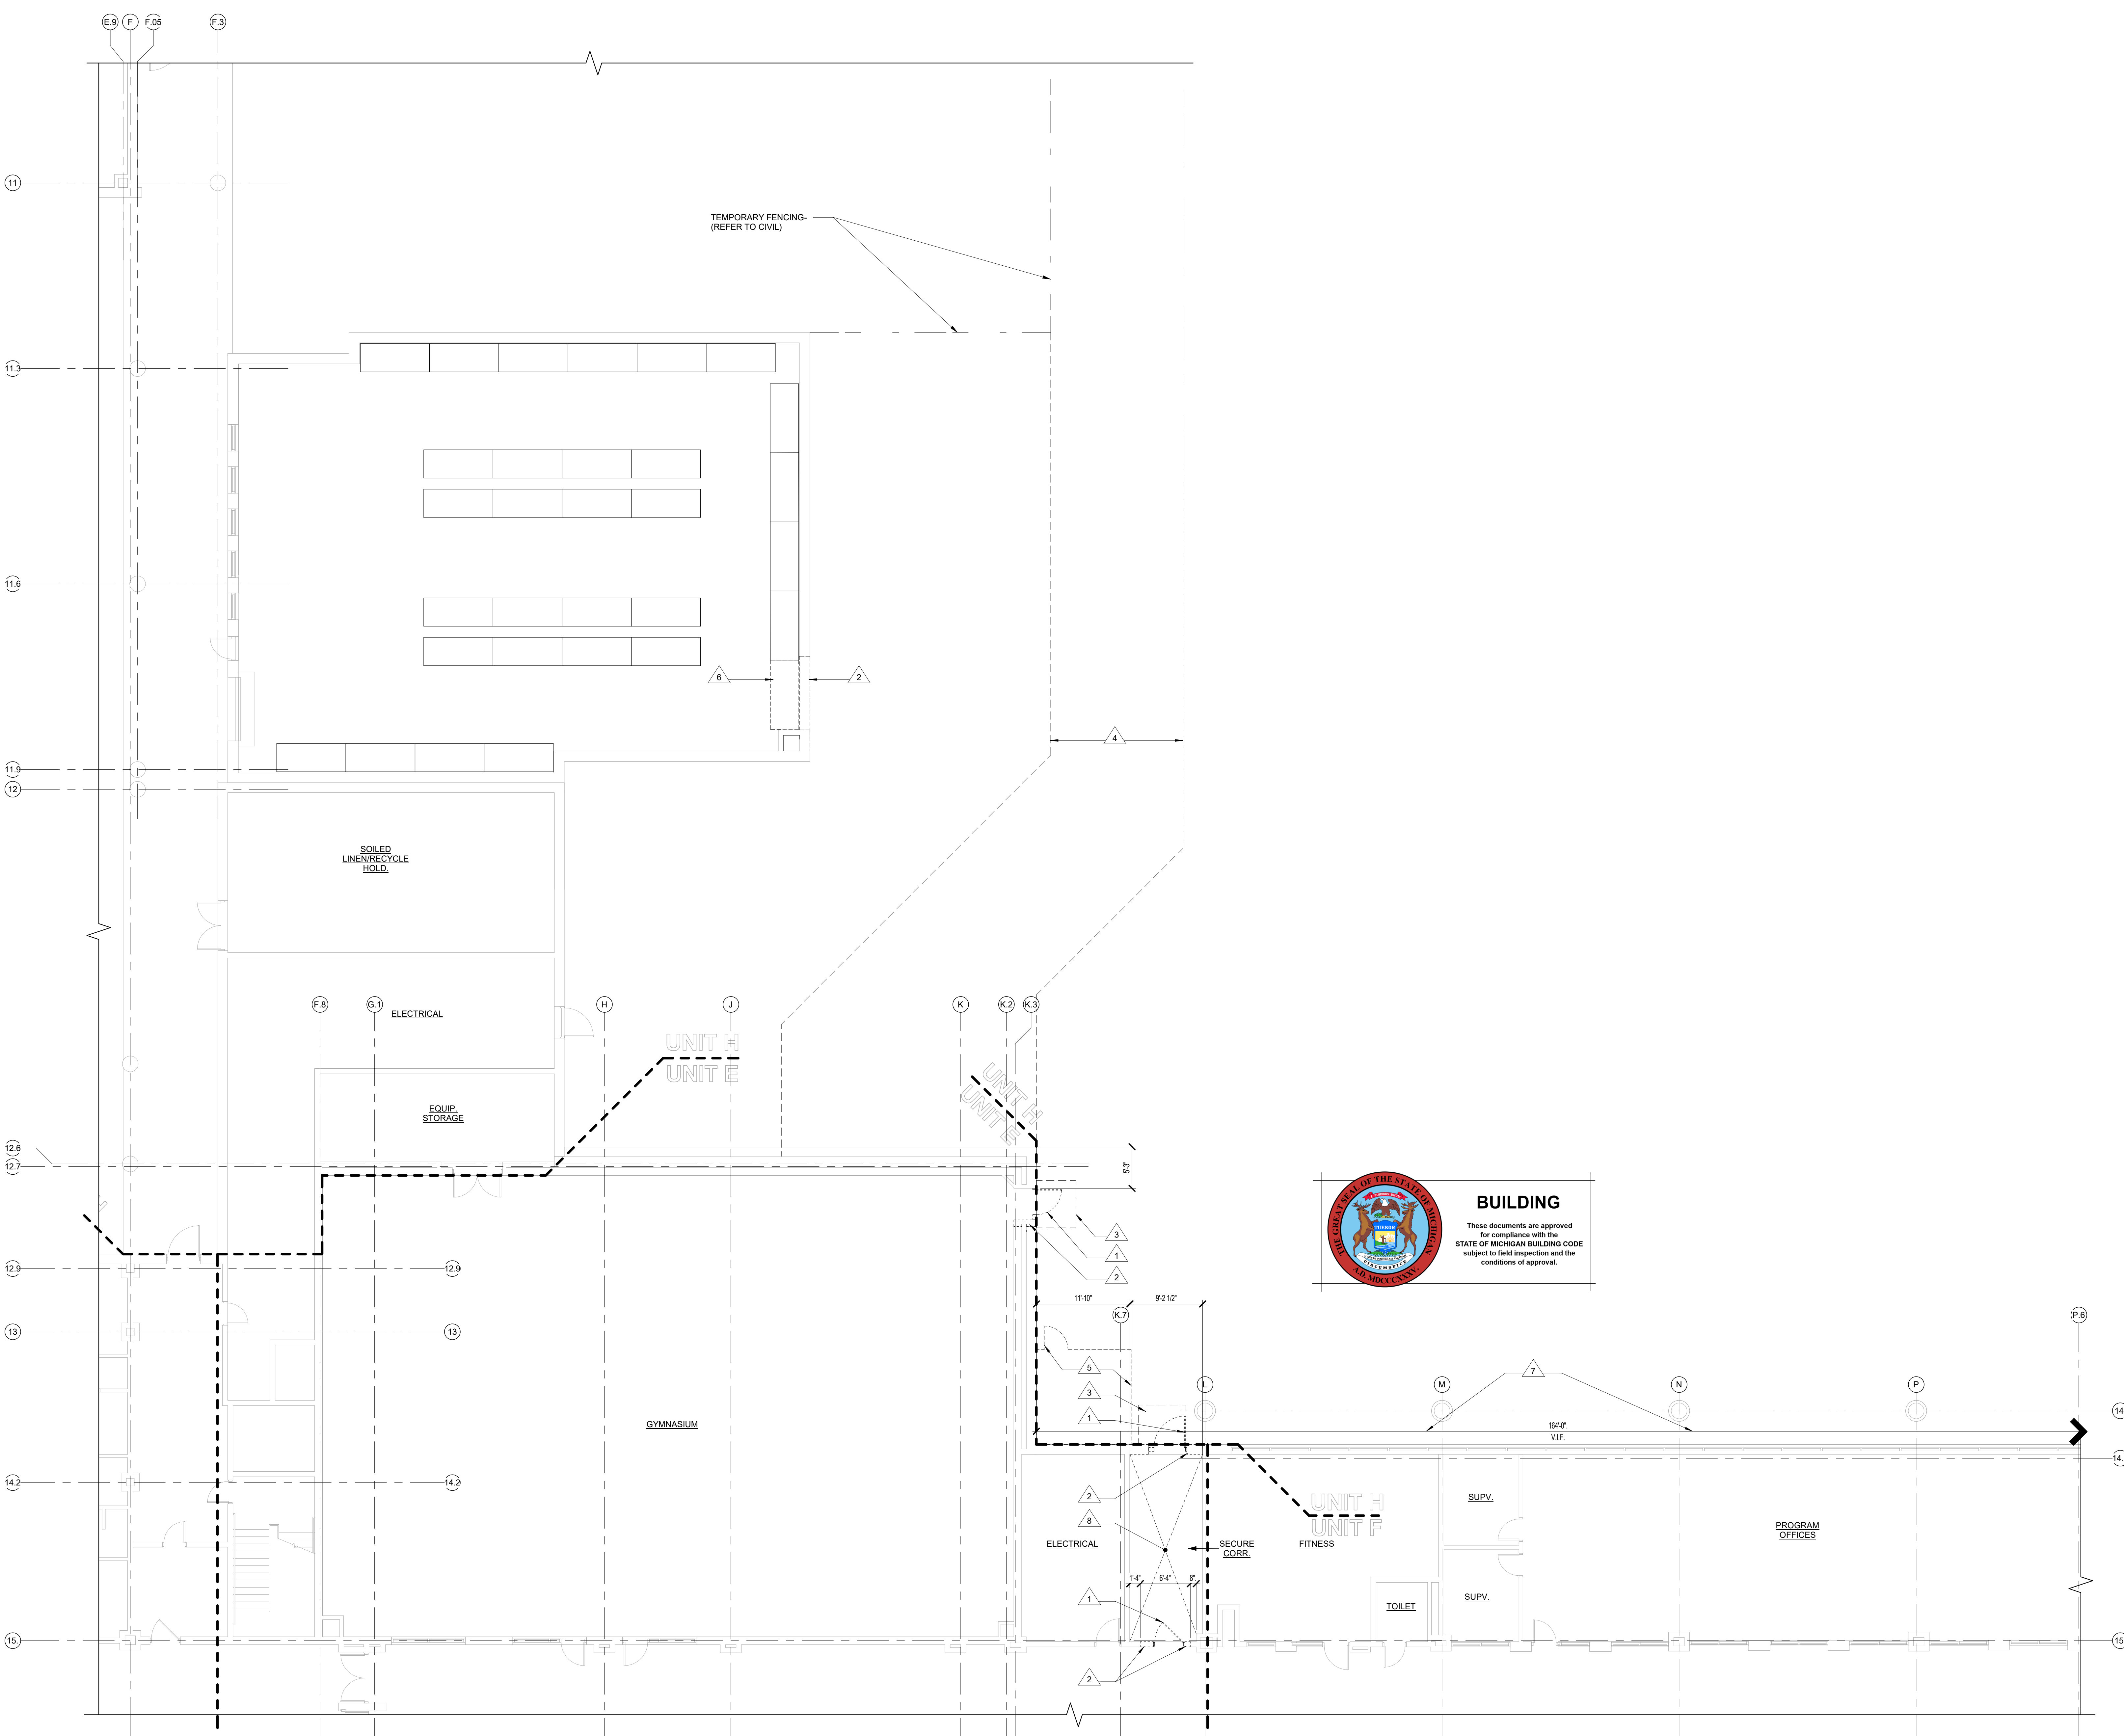

FIRST FLOOR DEMOLITION PLAN
NORTH SCALE: 1/8" = 1'-0"

CONSTRUCTION GENERAL NOTES:

1. WALL TYPES ARE INDICATED AS A DIAMOND WITH A NUMBER. REFER TO SHEET A0.01 FOR DESCRIPTION OF WALL TYPES.
2. PLAN DIMENSIONS DO NOT INCLUDE WALL THICKNESS (REFER TO WALL TYPES).
3. DOOR FRAMES ARE TO BE LOCATED 8" FROM THE PERPENDICULAR WALL ON THE HINGE SIDE OF THE DOOR AT MASONRY WALLS, UNLESS NOTED OTHERWISE.
4. PROVIDE BLOCKING AT ALL WALL MOUNTED ITEMS INCLUDING BUT NOT LIMITED TO: PLUMBING ACCESSORIES, KITCHEN EQUIPMENT, ETC.
5. ALL AREAS DAMAGED BY DEMOLITION WORK ARE TO BE PATCHED AND REPAIRED OR REPLACED TO MATCH ADJACENT SURFACES.
6. PATCH AND REPAIR REMAINING WALLS, AT ARCHITECTURAL, MECHANICAL, AND ELECTRICAL DEMOLITION POINTS WITH SIMILAR MATERIALS IN SIZE, COLOR AND TEXTURE.
7. PATCH AND REPAIR ALL EXISTING FLOORS AS REQUIRED WHERE EXISTING WALLS HAVE BEEN REMOVED.
8. FURNITURE OR EQUIPMENT TO BE BUILT AND/OR INSTALLED BY CONTRACTOR IS SPECIFICALLY NOTED, DIMENSIONED OR DETAILED. ALL OTHER FURNITURE OR EQUIPMENT WILL BE PROVIDED AND INSTALLED BY OWNER.
9. FOR CASEWORK DETAILS - REFER TO "NORTHERN AMERICA ARCHITECTURAL WOODWORK STANDARDS (A.W.S.)."
10. CASEWORK DESIGNATION REFERS TO THE WIDTH (W) AND DEPTH (D) OF THE CABINET. REFER TO DIMENSIONS FOR HEIGHT. REFER TO "A.W.S." FOR CABINET NUMBER LOCATED BELOW DIMENSION LINE.

CONSTRUCTION KEYNOTES


1. CONCRETE ENTRY SLAB (REFER TO STRUCTURAL)
2. PLUMBING FIXTURE (REFER TO MECHANICAL)
3. CASEWORK (REFER TO ELEVATIONS AND DETAILS)
4. CASEWORK (REFER TO ELEVATIONS AND DETAILS)
5. STAINLESS STEEL GRAB BARS
6. PAPER TOWEL DISPENSER
7. TOILET PAPER DISPENSER
8. SANITARY NAPKIN RECEPTACLE
9. MIRROR 18" x 36"
10. SOAP DISPENSER
11. RECESSED FIRE EXTINGUISHER CABINET
12. FURNITURE AND EQUIPMENT (BY OWNER)
13. SEMI-RECESSED DETENTION FIRE EXTINGUISHER CABINET
14. PATCH AND REPAIR WALL CONSTRUCTION, WALL BASE, AND FLOORING TO MATCH EXISTING.
15. COORDINATE LOCATION OF FLOOR TILE MOVEMENT JOINTS WITH ARCHITECT, TYPICAL OF TCNA E-171
16. FIN TUBE RADIATOR (REFER TO MECHANICAL)
17. PROVIDE NEW WATER COLD FLUID-APPLIED WATERPROOFING ALONG THE EXISTENCE OF THE EXISTING FOUNDATION WALL - REFER TO CIVIL FOR COORDINATION OF NEW SIDEWALK, NEW ENTRY SLAB, AND FENCE MODIFICATIONS - USE CAUTION AS UNDERGROUND LINES ARE LOCATED IN THIS AREA.
18. MECHANICAL CHASE VERIFY SIZE WITH KITCHEN EQUIPMENT MFR. AND MECHANICAL (REFER TO MECHANICAL)
19. MECHANICAL CHASE VERIFY CLEAR WIDTH REQUIRED WITH MECHANICAL (REFER TO MECHANICAL)
20. EYE WASH STATION (REFER TO FOOD SERVICE AND MECHANICAL)
21. SEMI-RECESSED WET CHEMICAL FIRE EXTINGUISHER CABINET

NO.	REVISION	DATE

STATE OF MICHIGAN
DEPARTMENT OF TECHNOLOGY, MANAGEMENT AND BUDGET
FACILITIES AND BUSINESS SERVICES ADMINISTRATION
DESIGN AND CONSTRUCTION DIVISION
ADAM LACEL, R.A. DIRECTOR

FILE NO.
491/20167.SDW

FUNDING CODE 171CODHHS7255 CONTRACT NO. Y22003

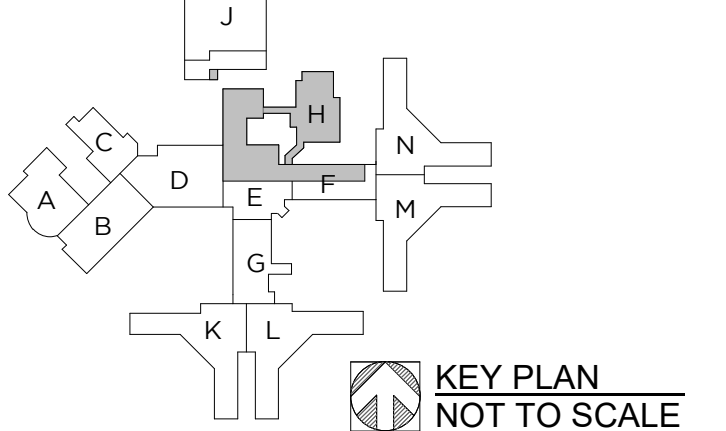

WTAARCH.COM

WTA ARCHITECTS

100 S Jefferson Ave, Suite 601
Saginaw, Michigan 48607
989 752 8107 COPYRIGHT © 2023

PROJECT TITLE

491/20167.SDW - PHASE 500:
CENTER FOR FORENSIC PSYCHIATRY - CREATE KITCHEN

SALINE, MICHIGAN



SHEET TITLE
FIRST FLOOR CONSTRUCTION PLAN

PROJECT NUMBER
2021094


PROJECT DATE
SEPTEMBER 6, 2023

CHECKED BY
C.D.S.


SHEET NUMBER
A2.21

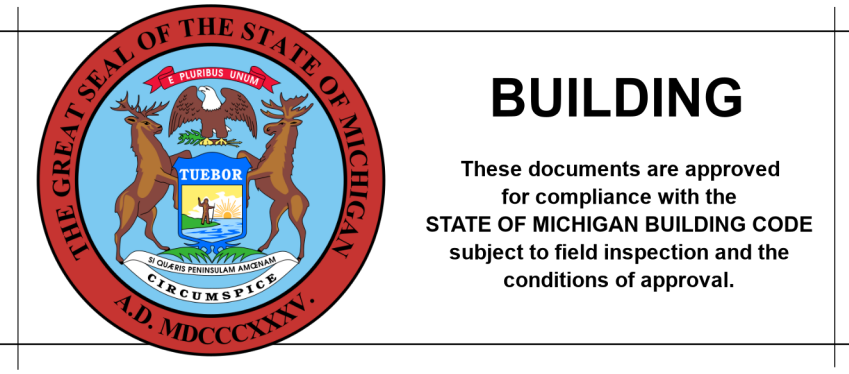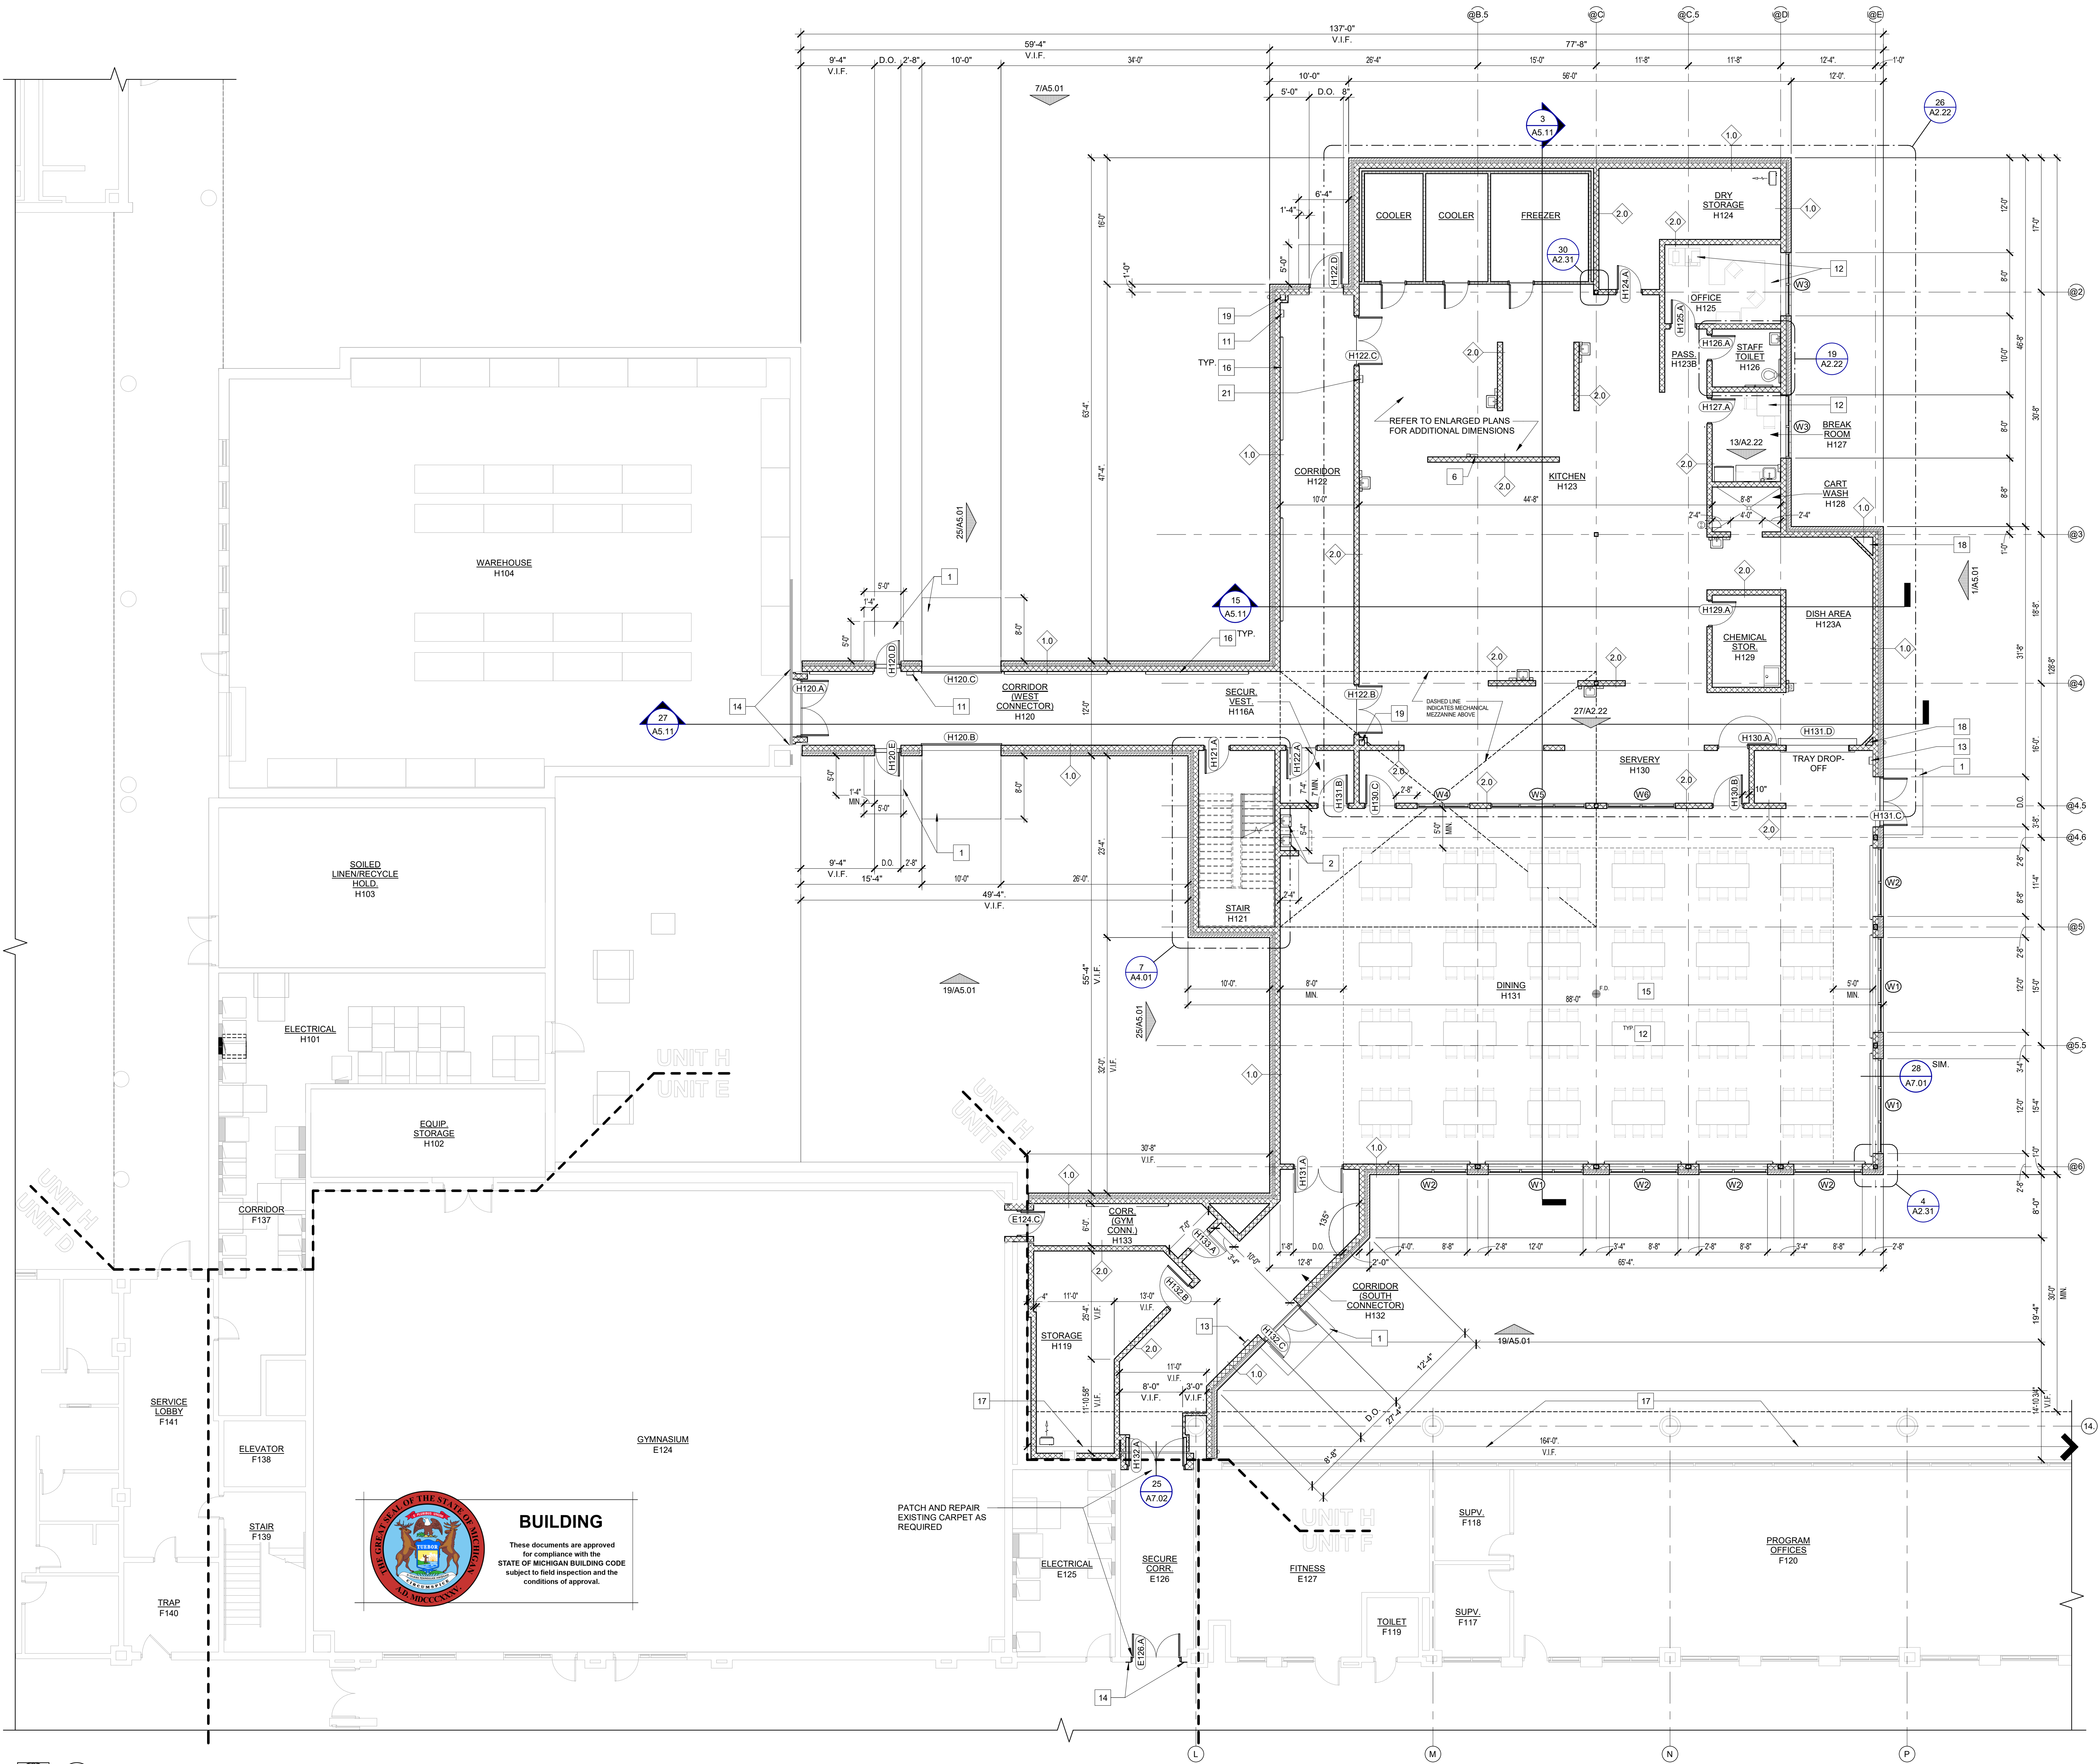


FIRST FLOOR CONSTRUCTION PLAN
SCALE: 1/8" = 1'-0"

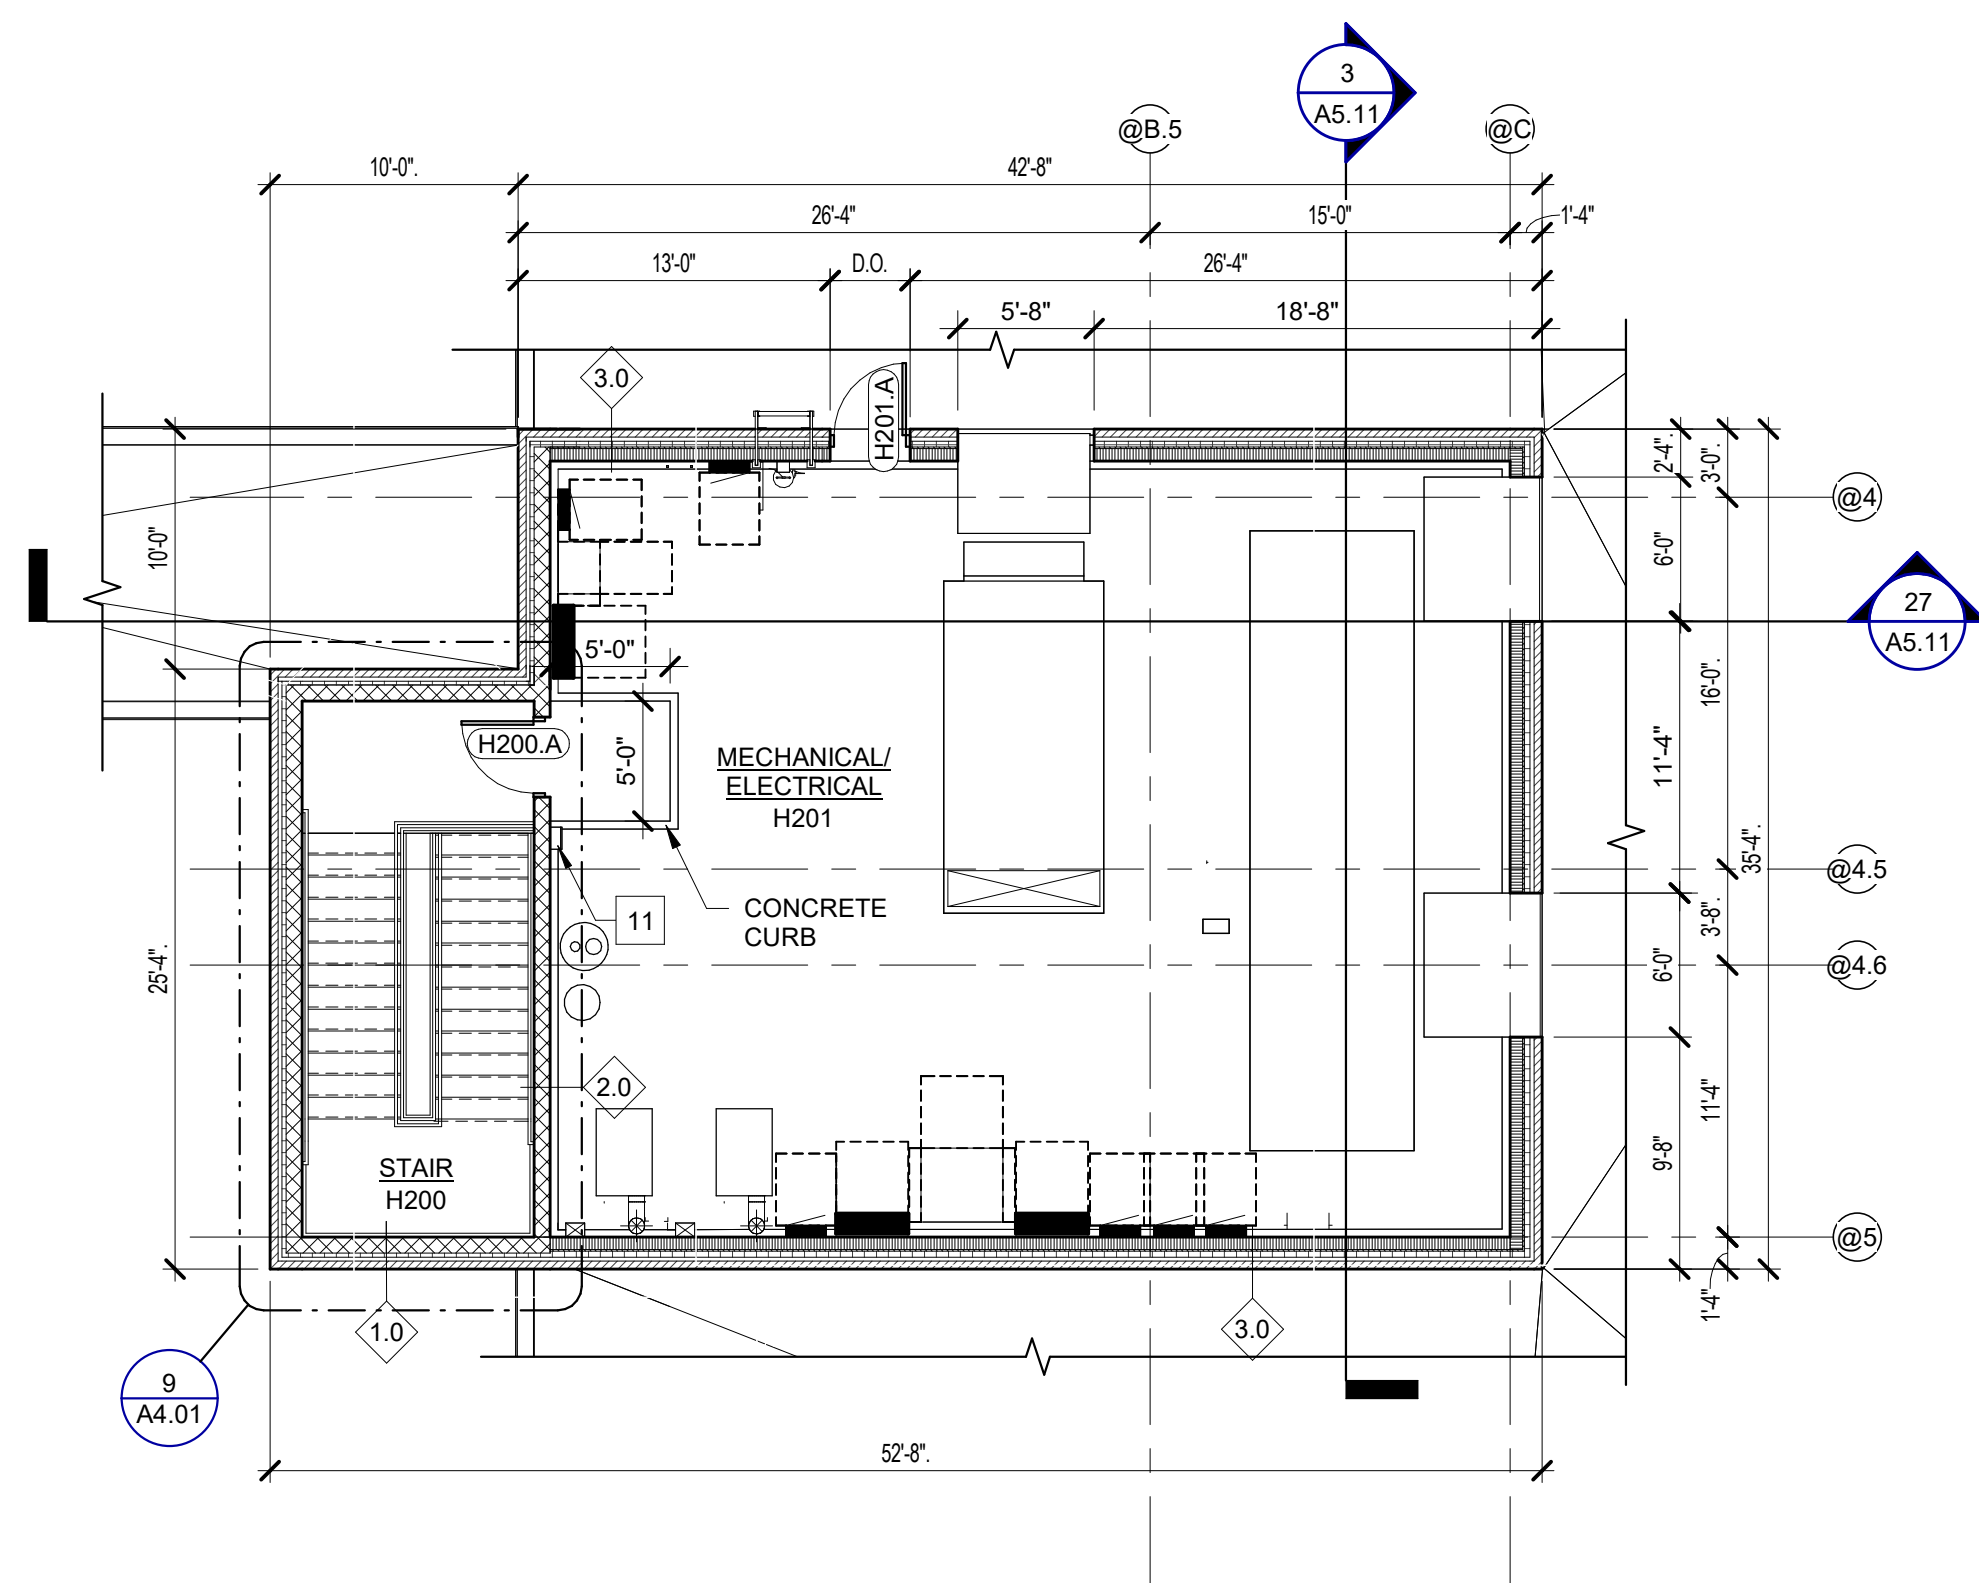


7 SECOND FLOOR CONSTRUCTION PLAN
SCALE: 1/8" = 1'-0"

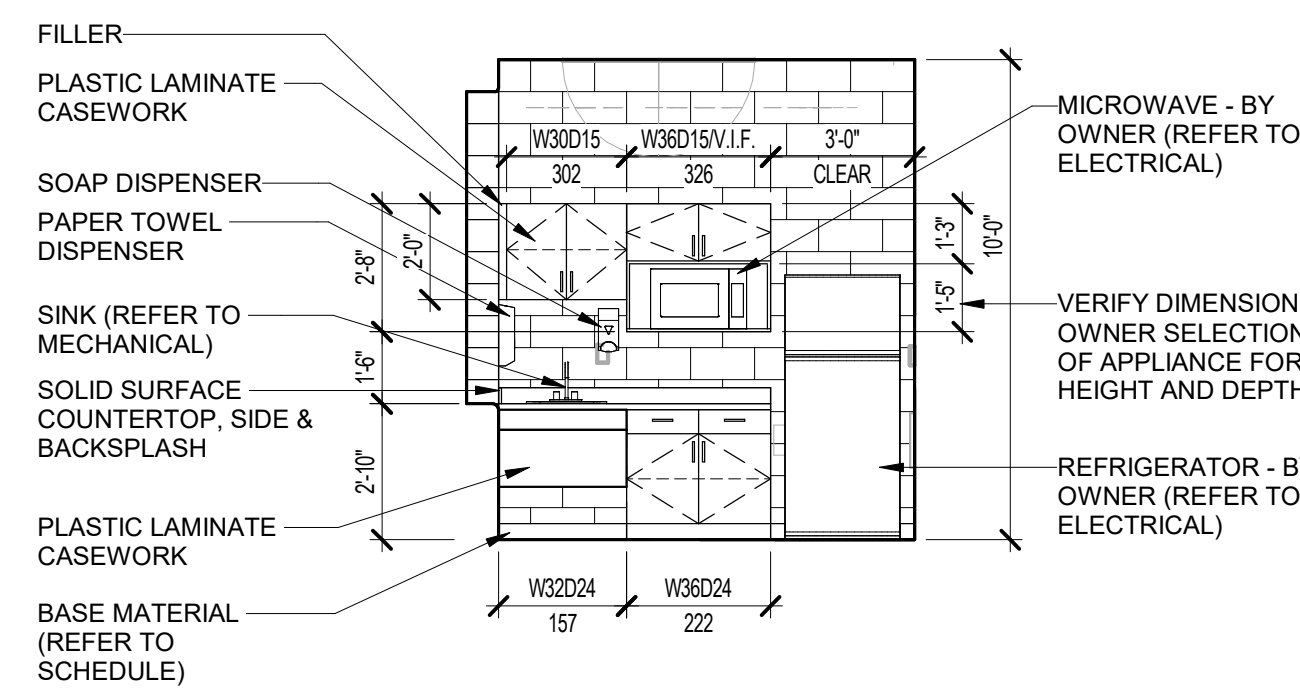


13/A2.22 BREAK ROOM ELEVATION
SCALE: 1/4" = 1'-0"

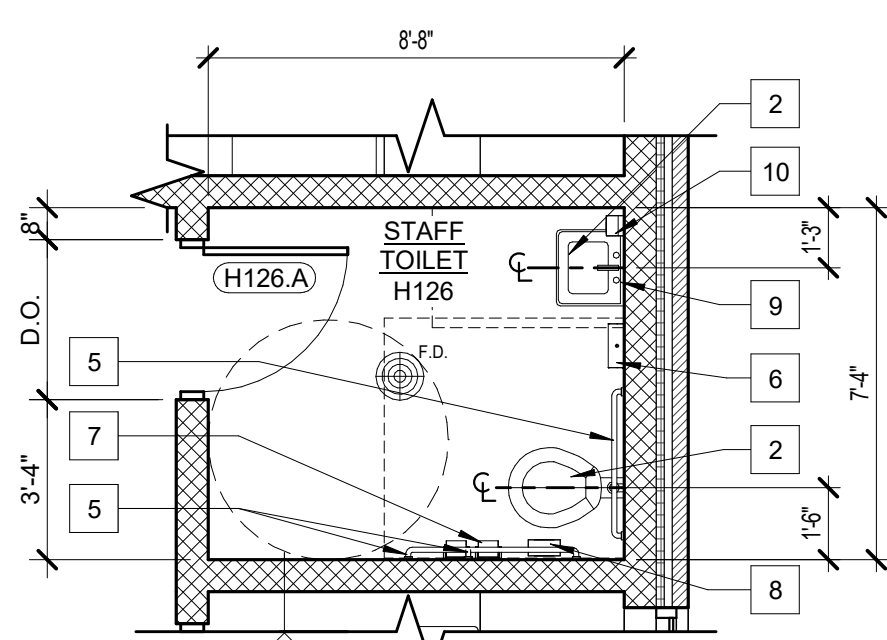

19 A2.22 ENLARGED FLOOR PLAN
SCALE: 1/4" = 1'-0"

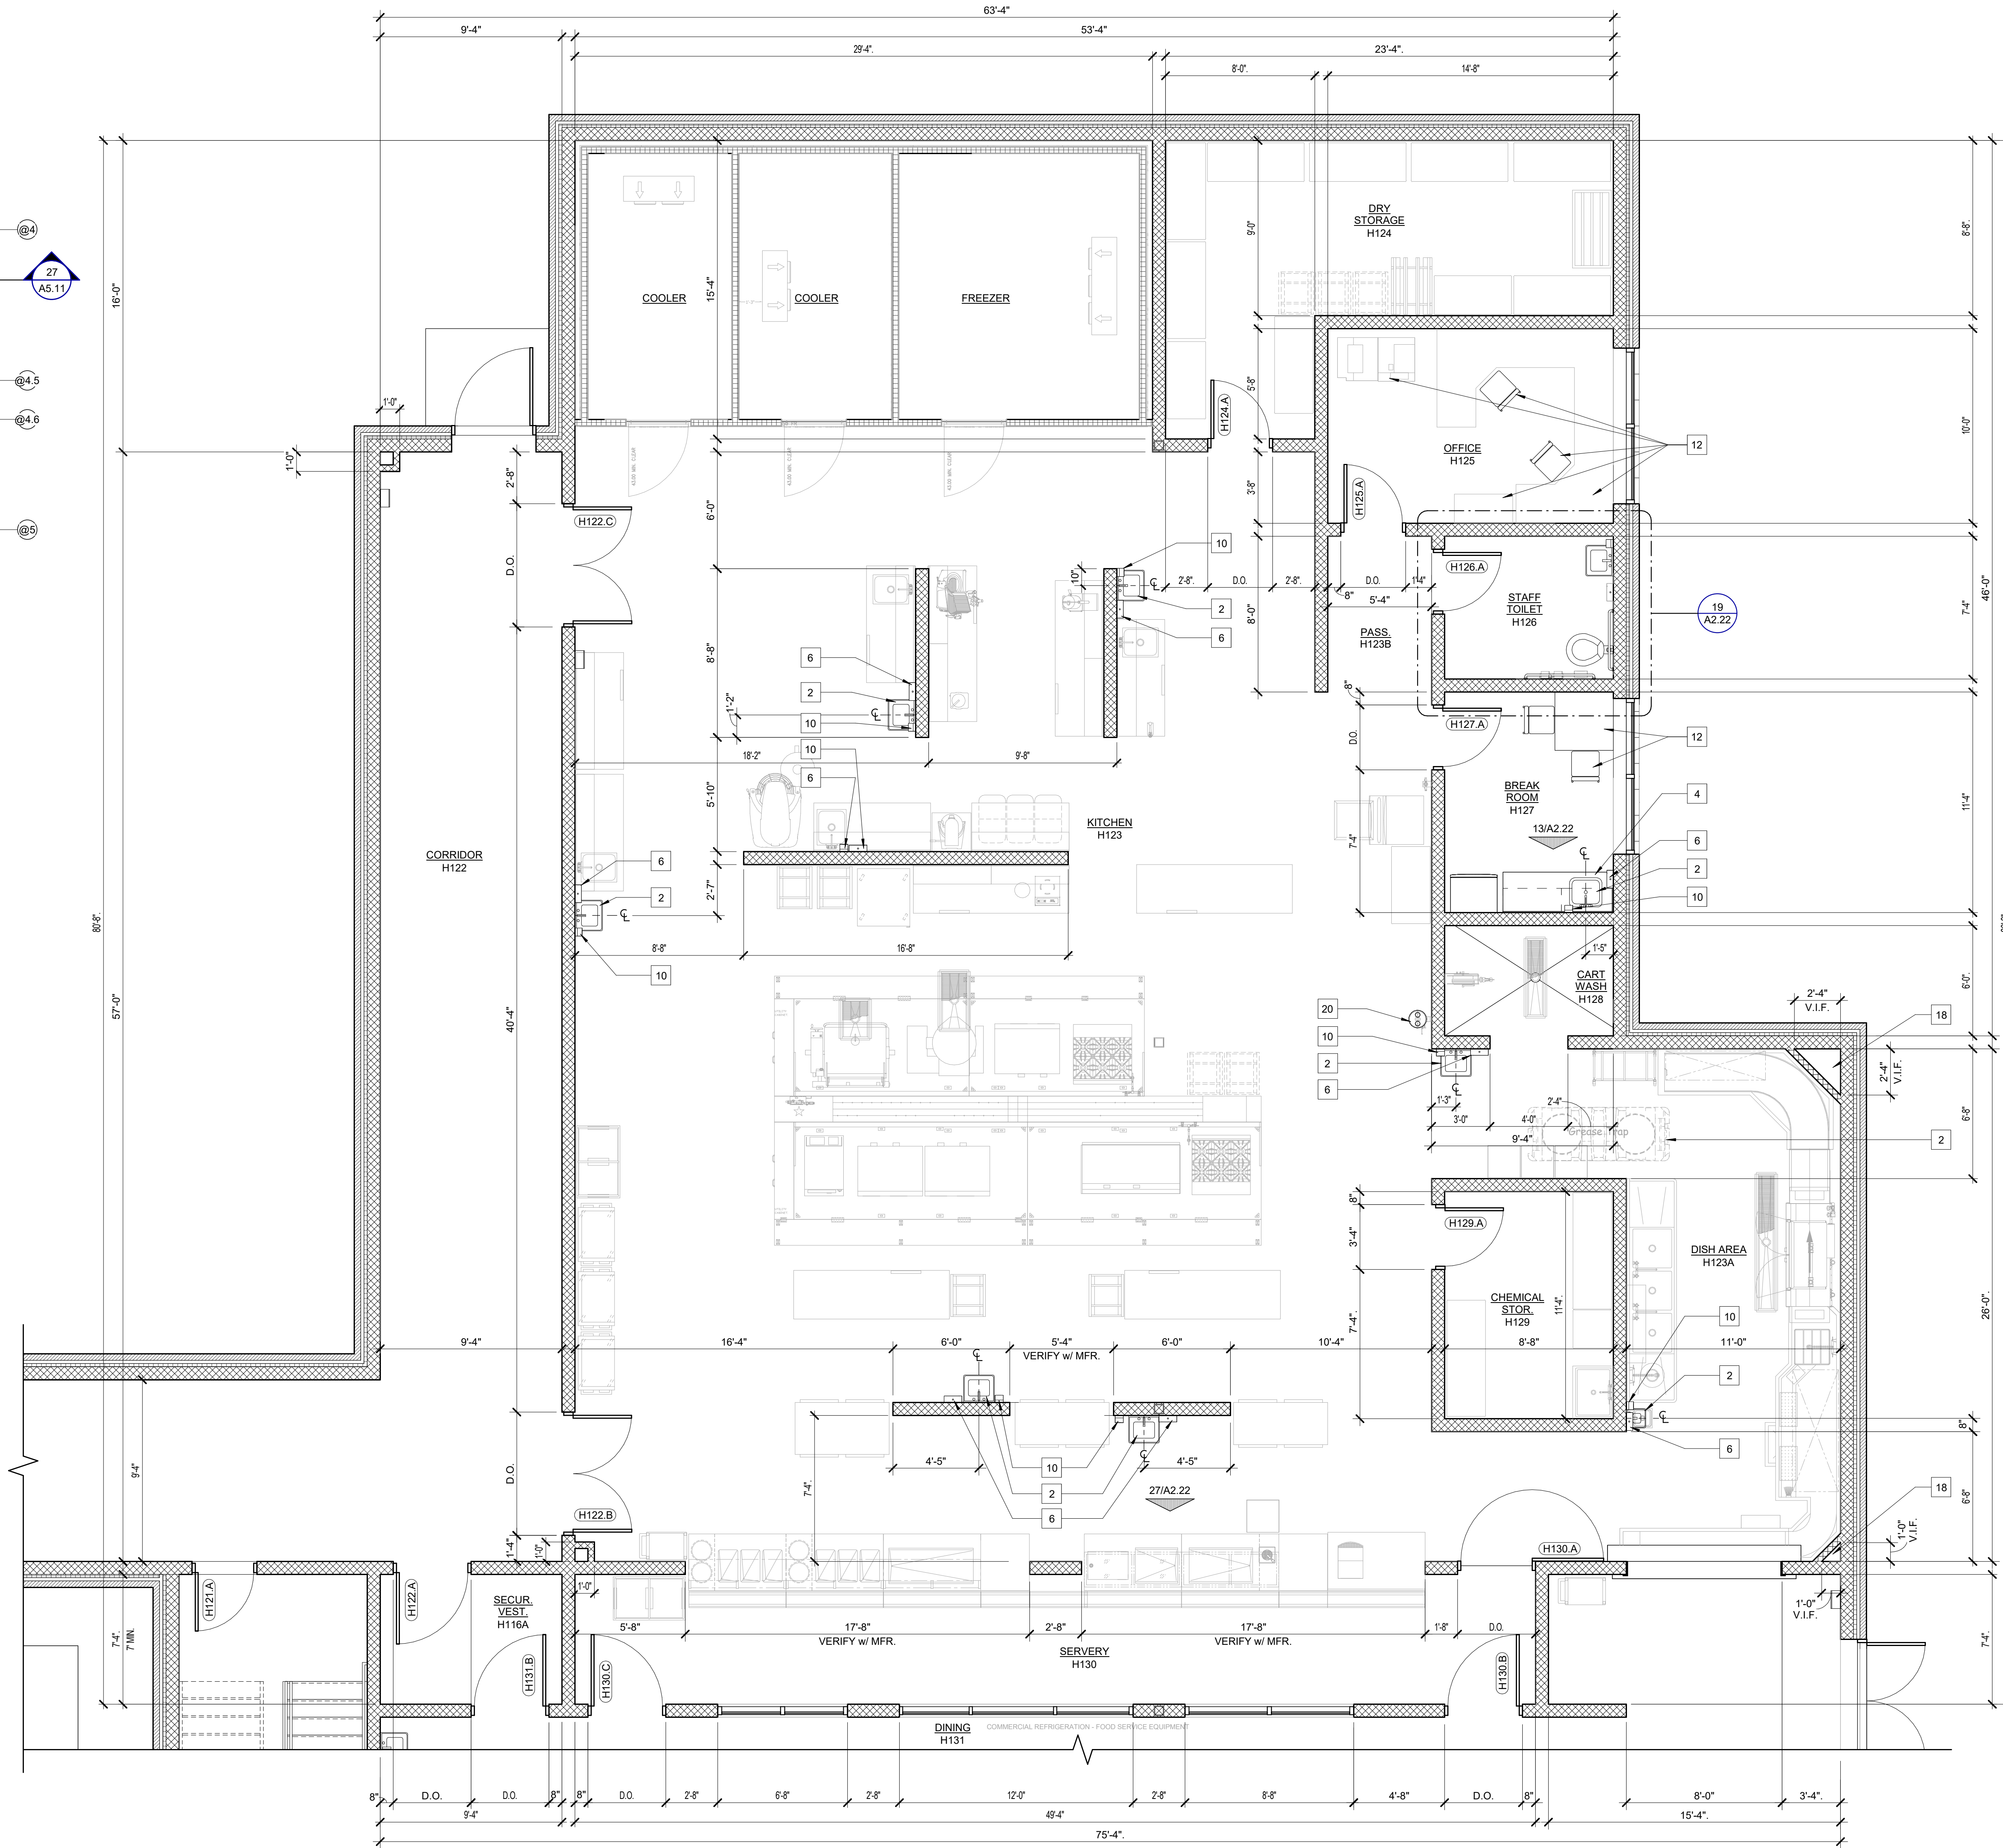

26 A2.22 ENLARGED KITCHEN FLOOR PLAN
SCALE: 1/4" = 1'-0"

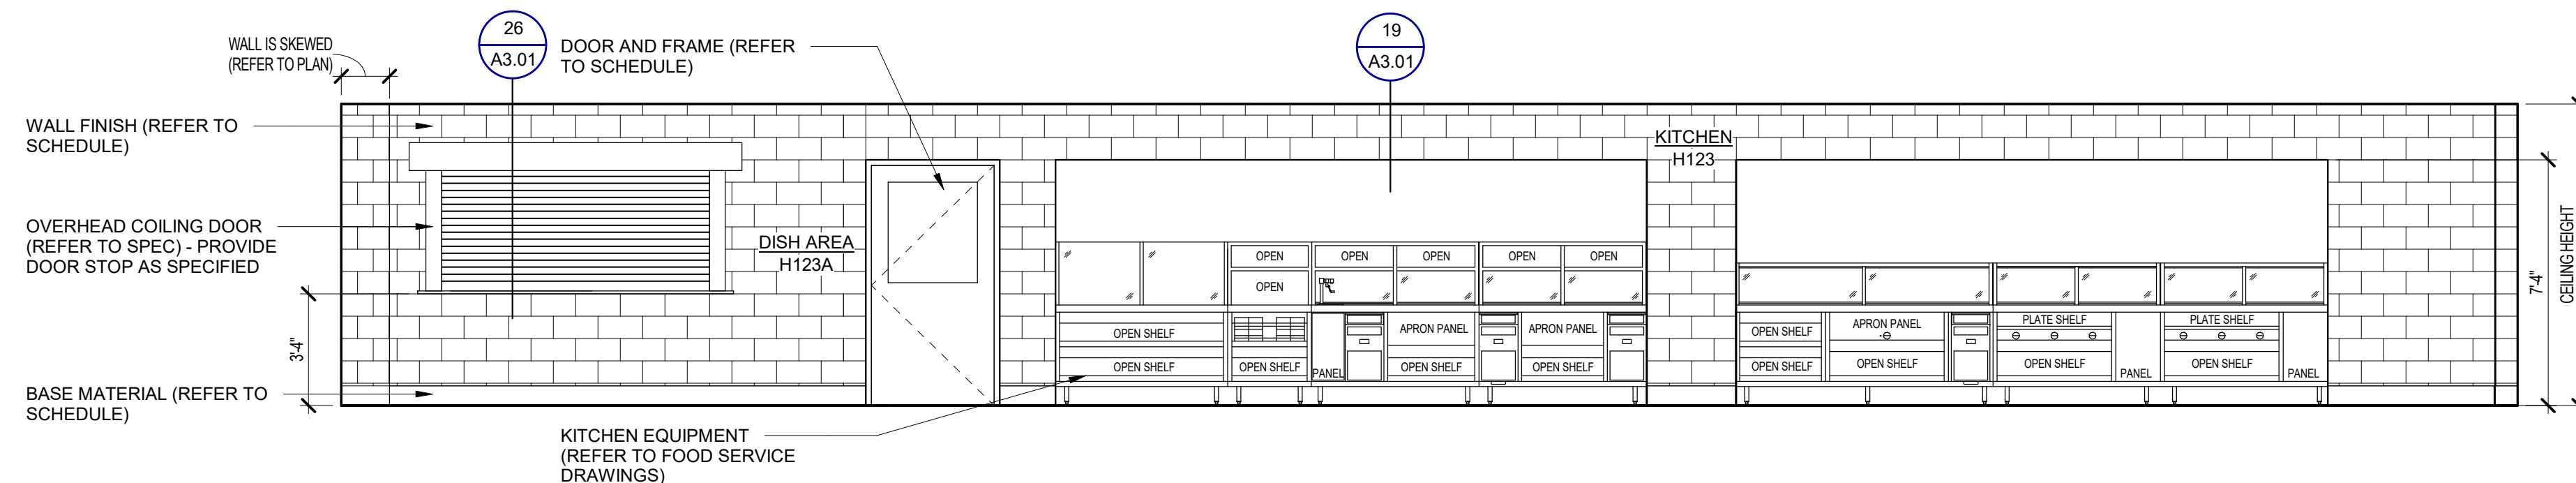

27/A2.22 SERVERY ELEVATION
SCALE: 1/4" = 1'-0"

CONSTRUCTION GENERAL NOTES:

- WALL TYPES ARE INDICATED AS A DIAMOND WITH A NUMBER. REFER TO SHEET A0.01 FOR DESCRIPTION OF WALL TYPES.
- PLAN DIMENSIONS DO NOT INCLUDE WALL THICKNESS (REFER TO WALL TYPES).
- DOOR FRAMES ARE TO BE LOCATED 8" FROM THE PERPENDICULAR WALL ON THE HINGE SIDE OF THE DOOR AT MASONRY WALLS, UNLESS NOTED OTHERWISE.
- PROVIDE BLOCKING AT ALL WALL MOUNTED ITEMS INCLUDING BUT NOT LIMITED TO: PLUMBING ACCESSORIES, KITCHEN EQUIPMENT, ETC.
- ALL AREAS DAMAGED BY DEMOLITION WORK ARE TO BE PATCHED AND REPAIRED OR REPLACED TO MATCH ADJACENT SURFACES.
- PATCH AND REPAIR REMAINING WALLS, AT ARCHITECTURAL, MECHANICAL, AND ELECTRICAL DEMOLITION POINTS WITH SIMILAR MATERIALS IN SIZE, COLOR AND TEXTURE.
- PATCH AND REPAIR ALL EXISTING FLOORS AS REQUIRED WHERE EXISTING WALLS HAVE BEEN REMOVED.
- FURNITURE OR EQUIPMENT TO BE BUILT AND/OR INSTALLED BY CONTRACTOR IS SPECIFICALLY NOTED, DIMENSIONED OR DETAILED. ALL OTHER FURNITURE OR EQUIPMENT WILL BE PROVIDED AND INSTALLED BY OWNER.
- FOR CASEWORK DETAILS - REFER TO "NORTHERN AMERICA ARCHITECTURAL WOODWORK STANDARDS (A.W.S.)."
- CASEWORK DESIGNATION REFERS TO THE WIDTH (W) AND DEPTH (D) OF THE CABINET. REFER TO DIMENSIONS FOR HEIGHT. REFER TO "A.W.S." FOR CABINET NUMBER LOCATED BELOW DIMENSION LINE.

CONSTRUCTION KEYNOTES

- CONCRETE ENTRY SLAB (REFER TO STRUCTURAL)
- PLUMBING FIXTURE (REFER TO MECHANICAL)
- CASEWORK (REFER TO ELEVATIONS AND DETAILS)
- STAINLESS STEEL GRAB BARS
- PAPER TOWEL DISPENSER
- TOILET PAPER DISPENSER
- SANITARY NAPKIN RECEPTACLE
- MIRROR 18" x 36"
- SOAP DISPENSER
- RECESSED FIRE EXTINGUISHER CABINET
- FURNITURE AND EQUIPMENT (BY OWNER)
- SEMI-RECESSED DETENTION FIRE EXTINGUISHER CABINET
- PATCH AND REPAIR WALL CONSTRUCTION, WALL BASE, AND FLOORING TO MATCH EXISTING.
- COORDINATE LOCATION OF FLOOR TILE MOVEMENT JOINTS WITH ARCHITECT, TYPICAL OF TONA EJ-171
- FIN TUBE RADIATOR (REFER TO MECHANICAL)
- PROVIDE NEW WATER COLD FLUID-APPLIED WATERPROOFING ALONG THE EXENT OF THE EXISTING FOUNDATION WALL - REFER TO CIVIL FOR COORDINATION OF NEW SIDEWALK, NEW ENTRY SLAB, AND FENCE MODIFICATIONS - USE CAUTION AS UNDERGROUND LINES ARE LOCATED IN THIS AREA.
- MECHANICAL CHASE VERIFY SIZE WITH KITCHEN EQUIPMENT MFR. AND MECHANICAL (REFER TO MECHANICAL)
- MECHANICAL CHASE VERIFY CLEAR WIDTH REQUIRED WITH MECHANICAL (REFER TO MECHANICAL)
- EYE WASH STATION (REFER TO FOOD SERVICE AND MECHANICAL)
- SEMI-RECESSED WET CHEMICAL FIRE EXTINGUISHER CABINET


NO.	REVISION	DATE



FILE NO. 491/20167.SDW

FUNDING CODE 171CODHHS7255

CONTRACT NO. Y22003

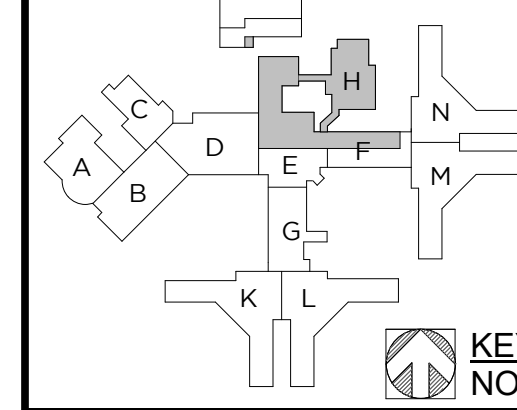

KEY PLAN NOT TO SCALE

WTAARCH.COM

WTA ARCHITECTS

100 S Jefferson Ave, Suite 601
Saginaw, Michigan 48607
989 752 8107 COPYRIGHT © 2023


PROJECT TITLE
491/20167.SDW - PHASE 500:
CENTER FOR FORENSIC PSYCHIATRY - CREATE KITCHEN
SALINE, MICHIGAN

SHEET TITLE
SECOND FLOOR CONST. PLN., ENLARGED PLN., & INTERIOR ELEVATION

PROJECT NUMBER 2021094 SHEET NUMBER

PROJECT DATE SEPTEMBER 6, 2023 **A2.22**



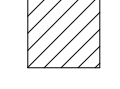
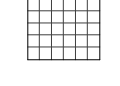
CHECKED BY C.D.S.

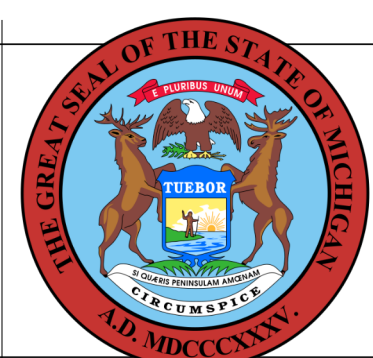


BUILDING


These documents are approved for compliance with the STATE OF MICHIGAN BUILDING CODE subject to field inspection and the conditions of approval.

FLOORING LEGEND

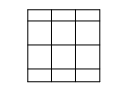-  CERAMIC TILE
-  SEALED CONCRETE
-  RESILIENT SHEET FLOORING
-  RESILIENT TILE FLOORING

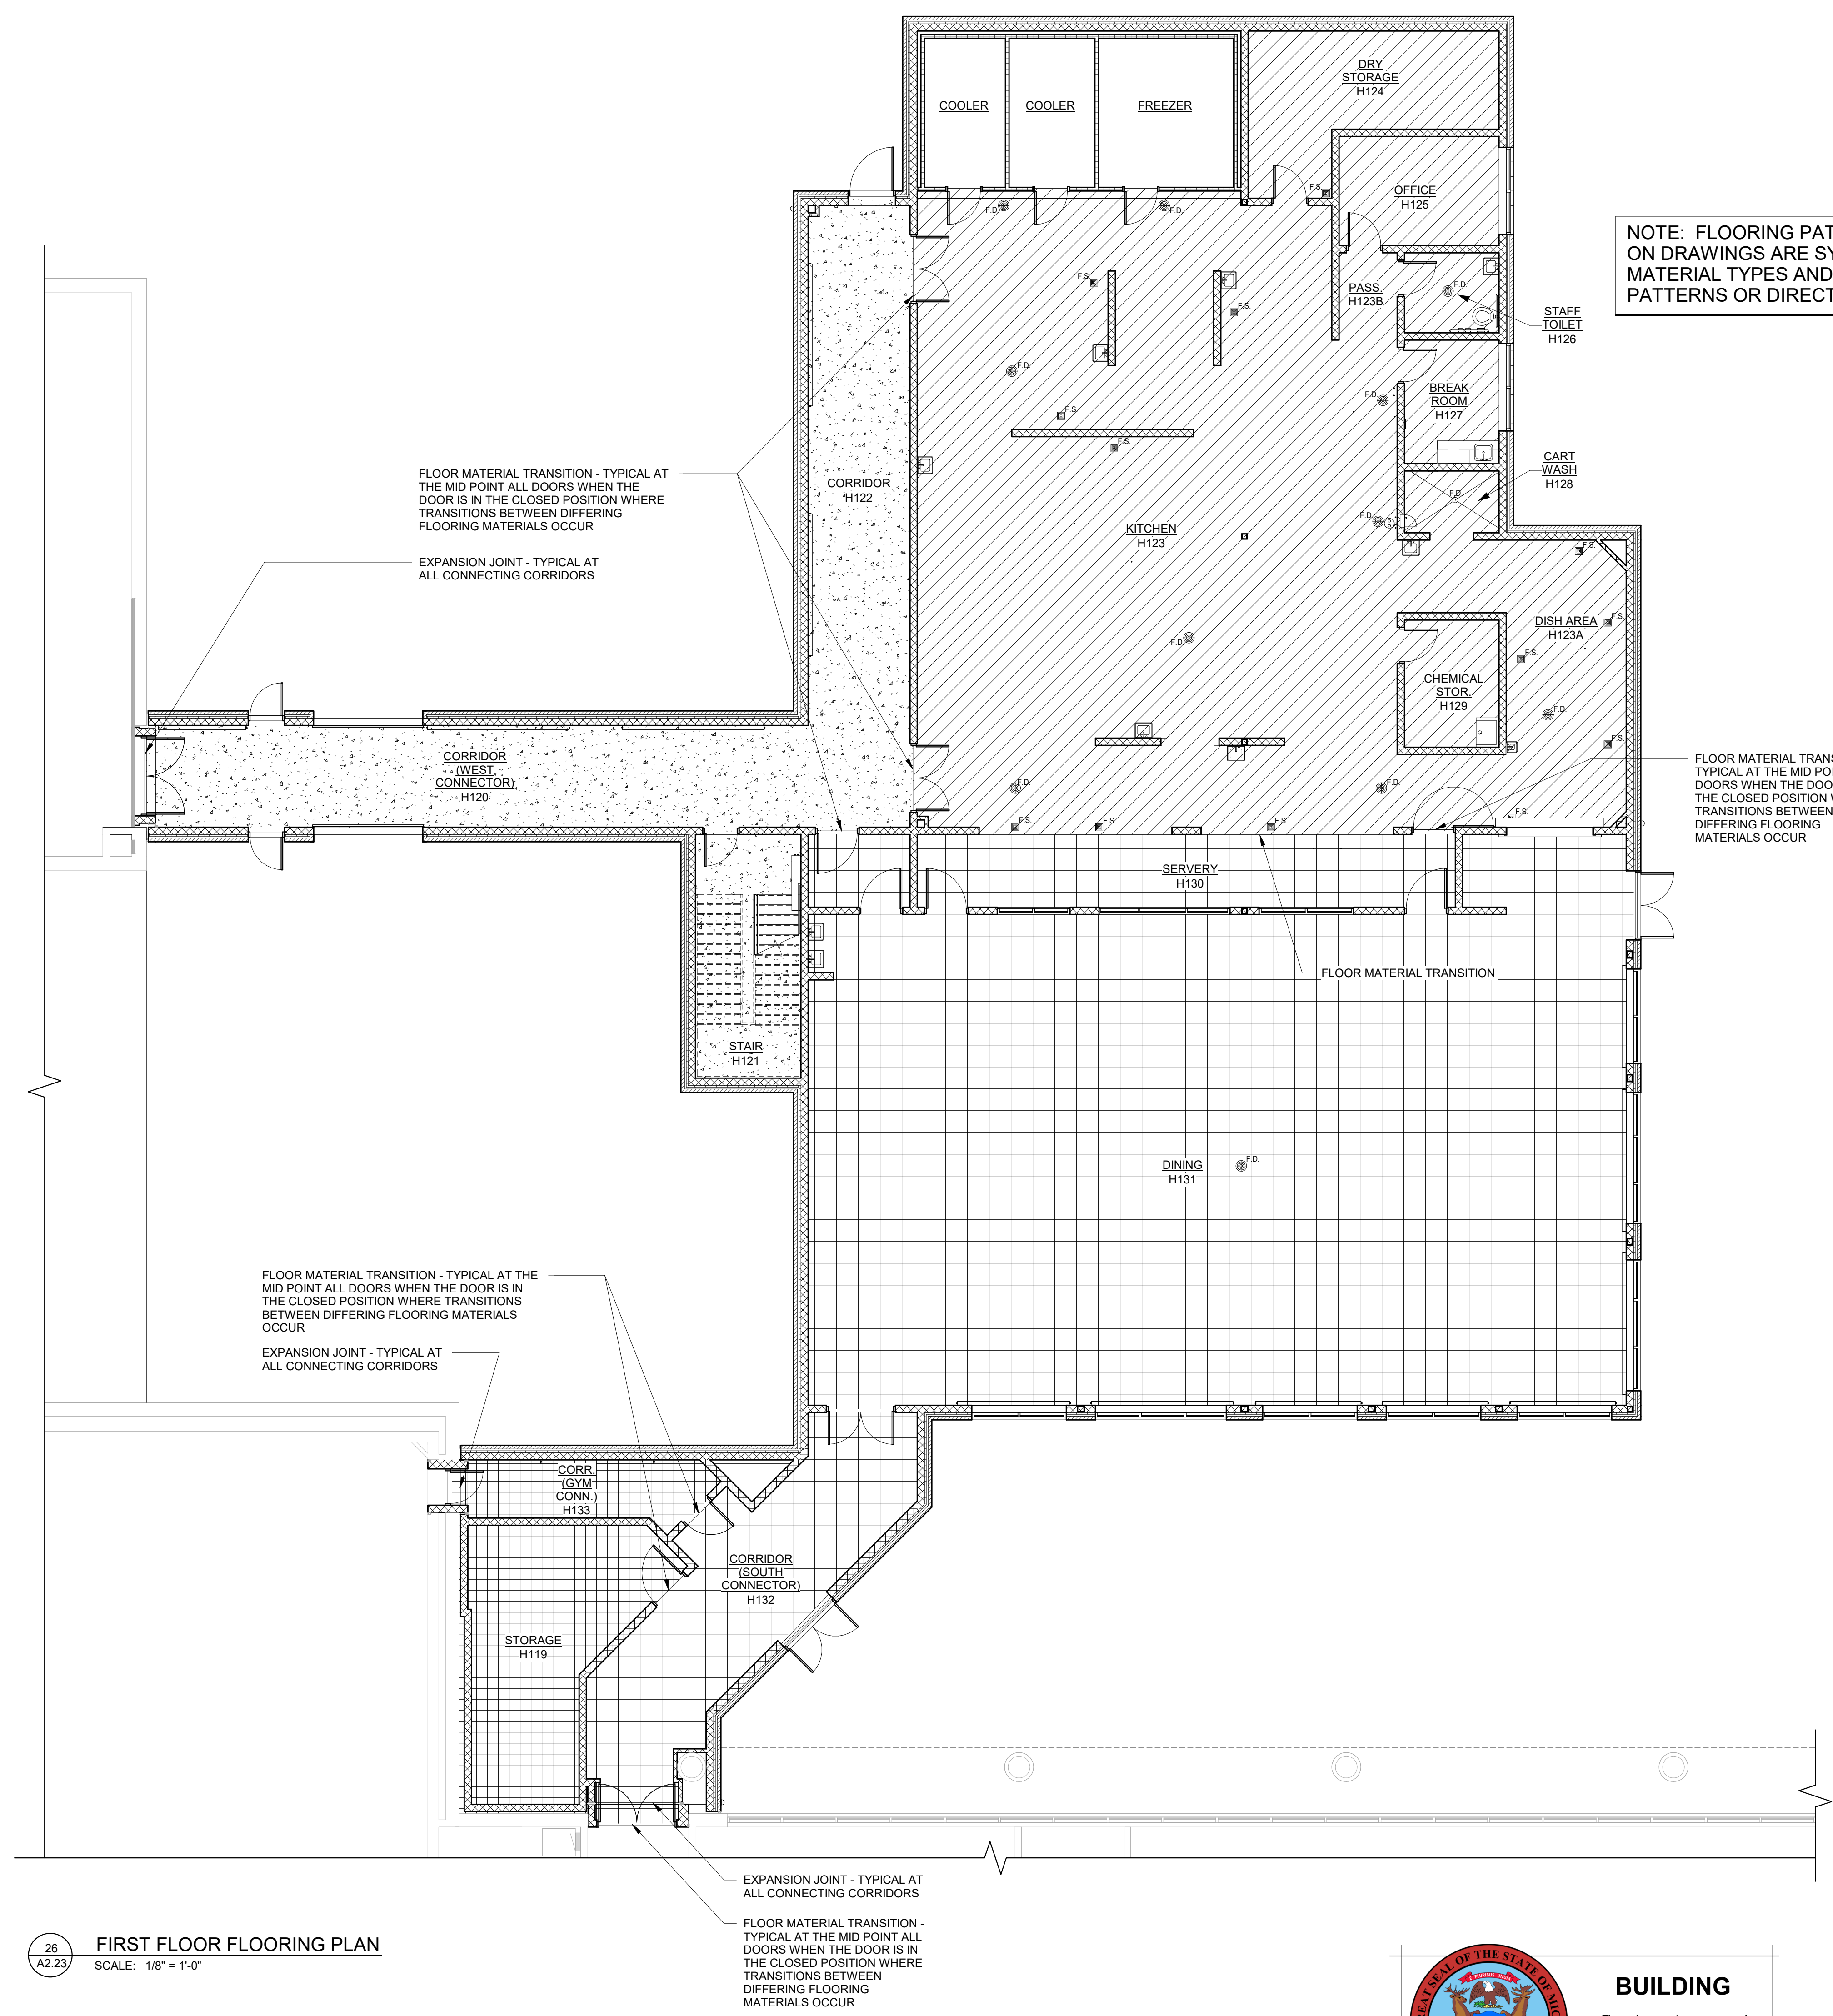

NOTE: FLOORING PATTERNS INDICATED ON DRAWINGS ARE SYMBOLIC OF MATERIAL TYPES AND NOT INSTALLATION PATTERNS OR DIRECTIONS.

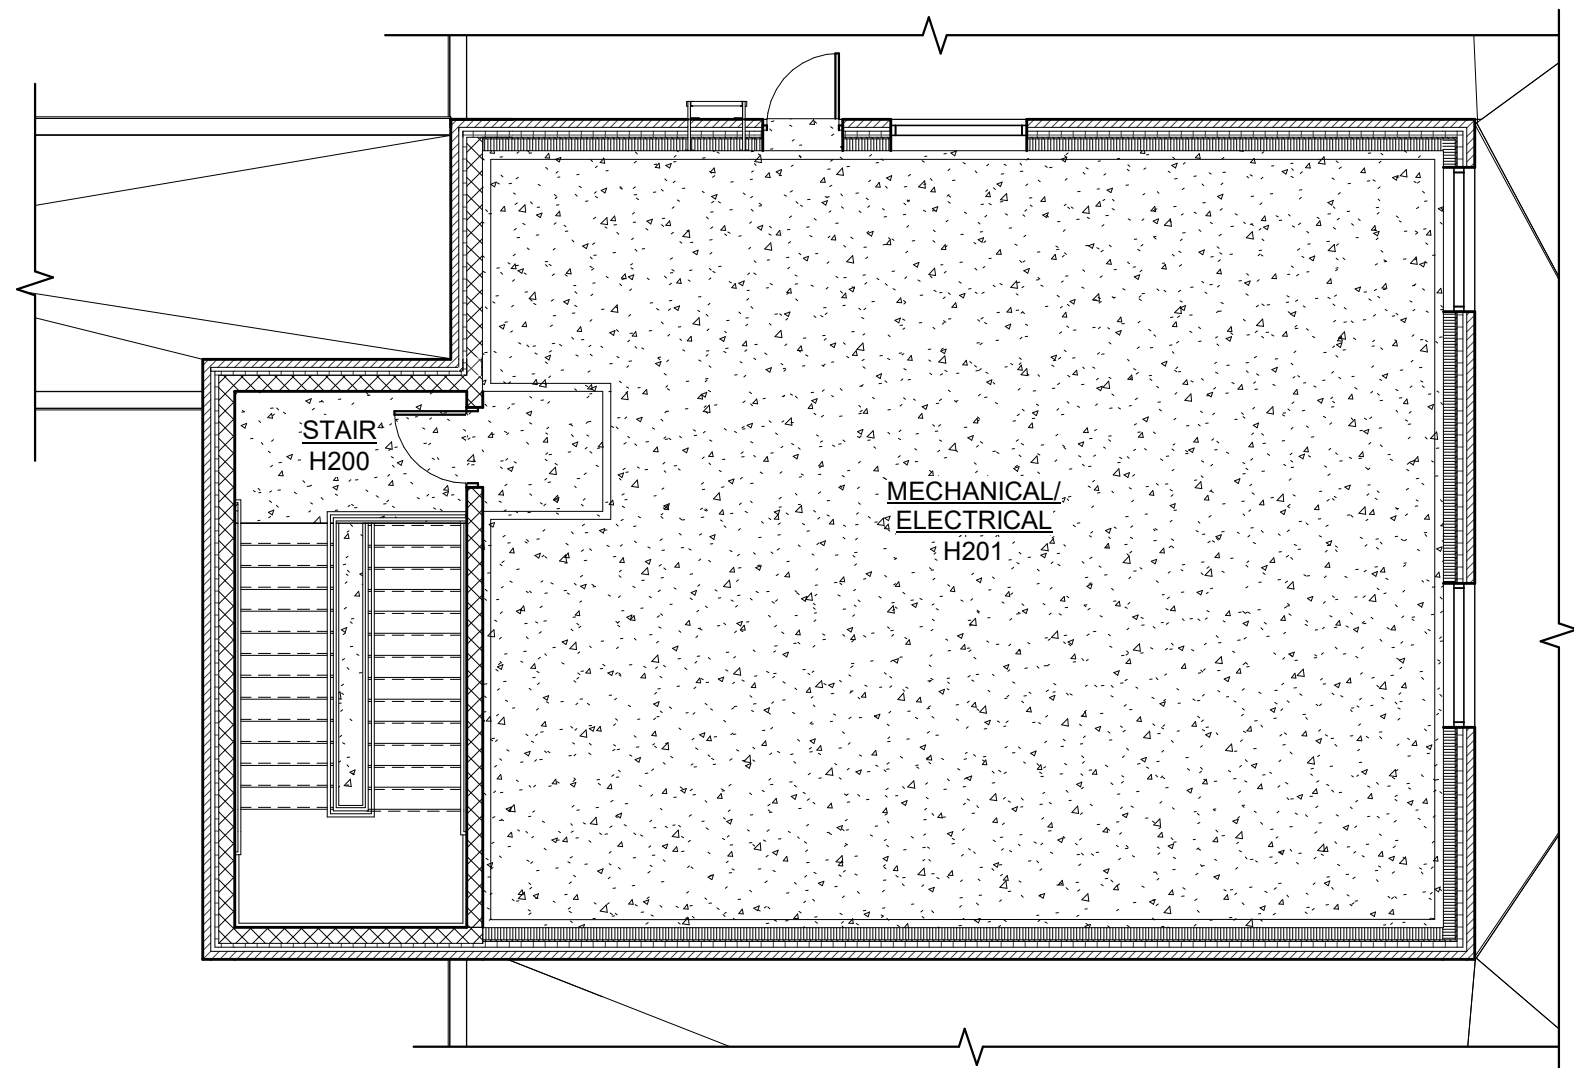

17 SECOND FLOOR FLOORING PLAN
SCALE: 1/8" = 1'-0"

26 FIRST FLOOR FLOORING PLAN
SCALE: 1/8" = 1'-0"


NO.	REVISION	DATE

STATE OF MICHIGAN
DEPARTMENT OF TECHNOLOGY, MANAGEMENT AND BUDGET
FACILITIES AND BUSINESS SERVICES ADMINISTRATION
DESIGN AND CONSTRUCTION DIVISION
ADAM LACH, R.A., DIRECTOR

FILE NO.
491/20167.SDW

FUNDING CODE
171CODHHS7255

CONTRACT NO.
Y22003

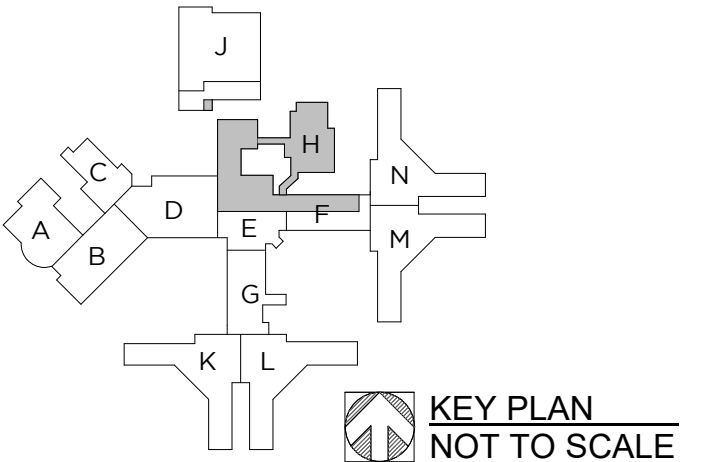

WTAARCH.COM

WTA ARCHITECTS

100 S. Jefferson Ave., Suite 601
Saginaw, Michigan 48607
989 752 8107

COPYRIGHT © 2023

PROJECT TITLE

491/20167.SDW - PHASE 500:
**CENTER FOR FORENSIC
PSYCHIATRY - CREATE
KITCHEN**

SALINE, MICHIGAN

SHEET TITLE
**FIRST & SECOND FLOOR
FLOORING PLANS**


PROJECT NUMBER
2021094

SHEET NUMBER

PROJECT DATE
SEPTEMBER 6, 2023


A2.23

CHECKED BY
C.D.S.

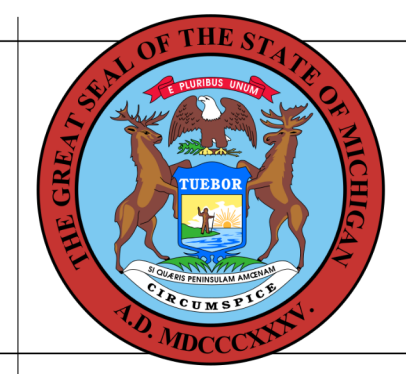


BUILDING


These documents are approved for compliance with the STATE OF MICHIGAN BUILDING CODE subject to field inspection and the conditions of approval.

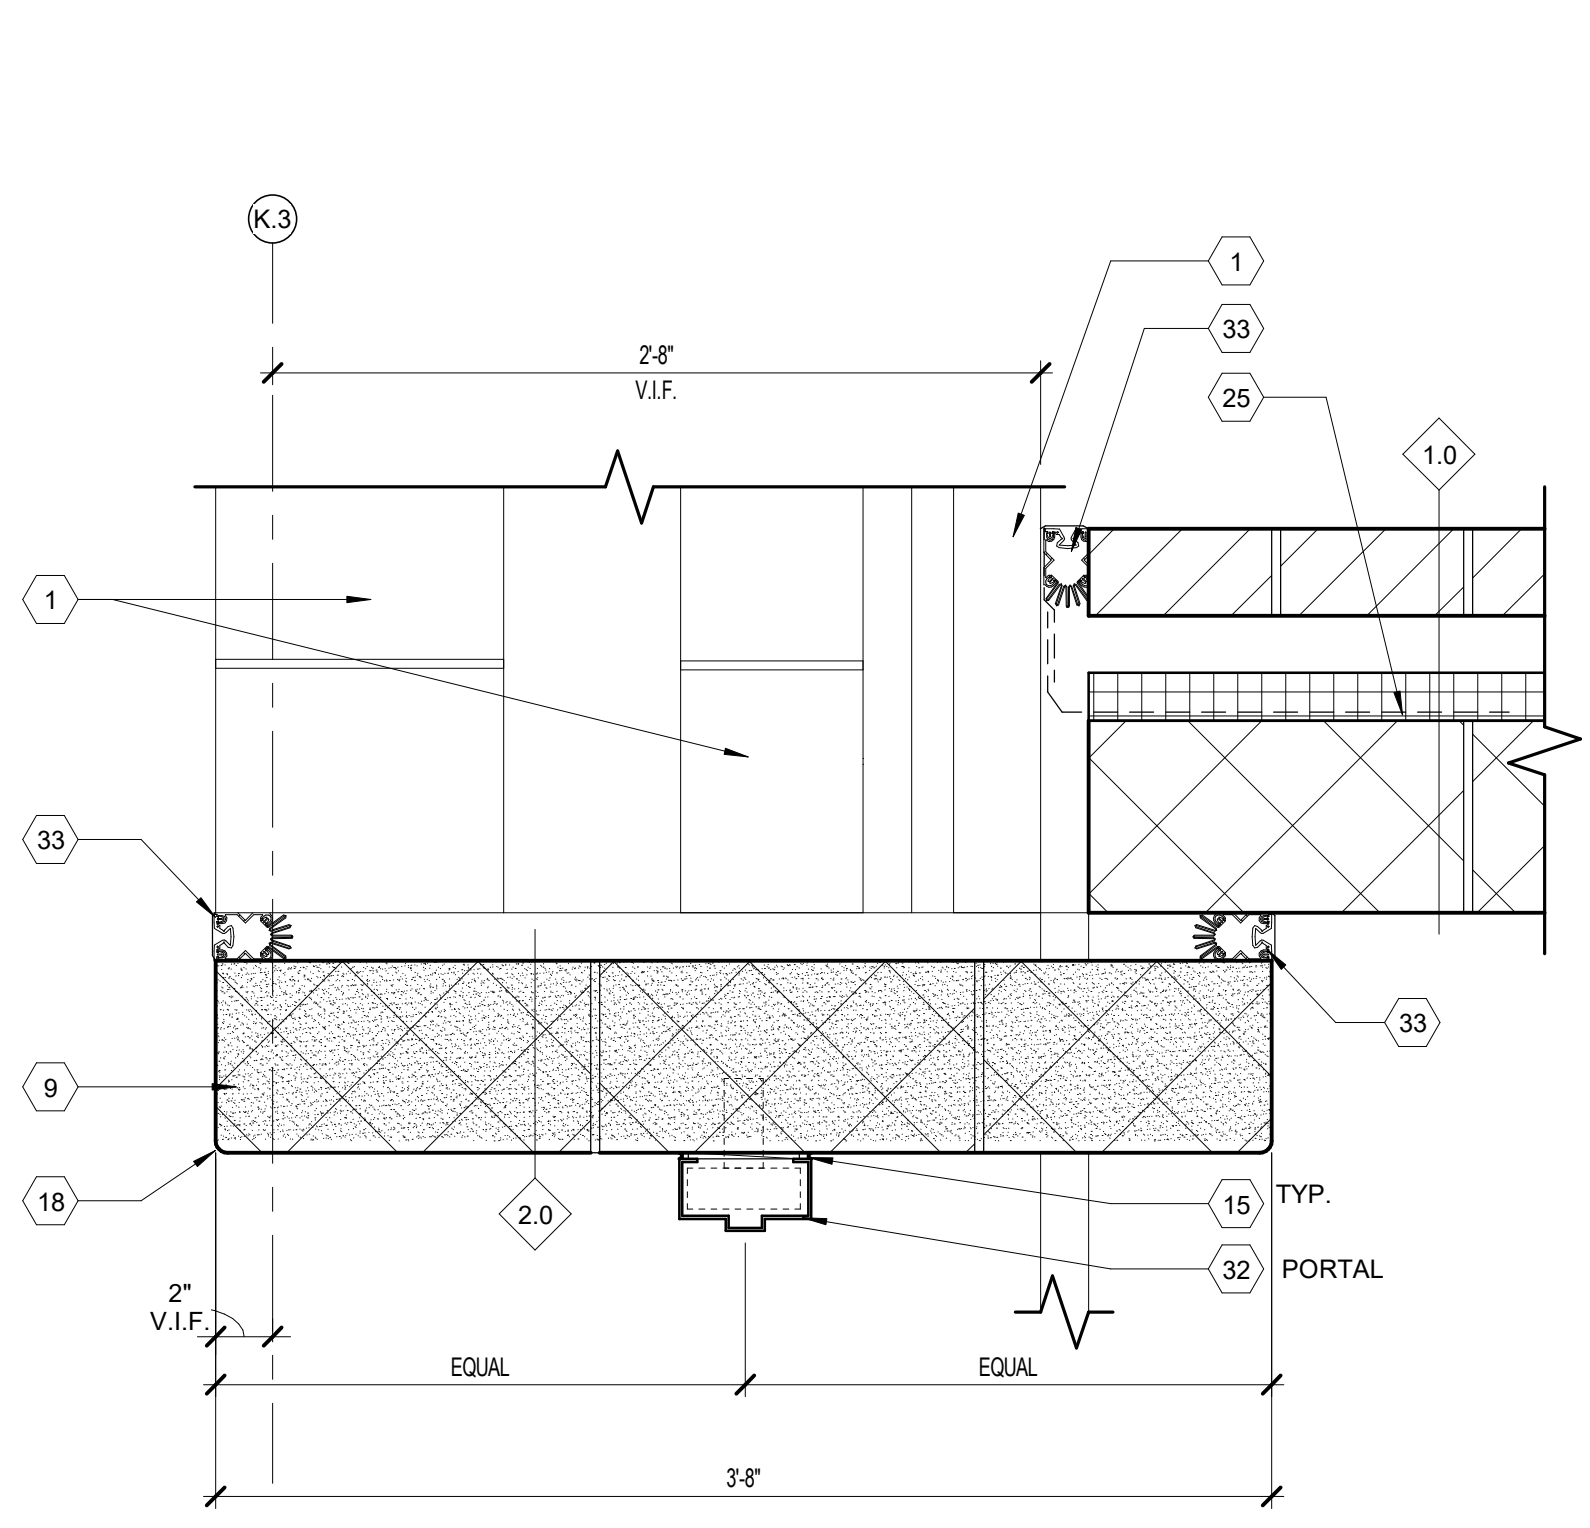


1 PORTAL FRAME @ WEST CONNECTOR
SCALE: 1 1/2" = 1'-0"

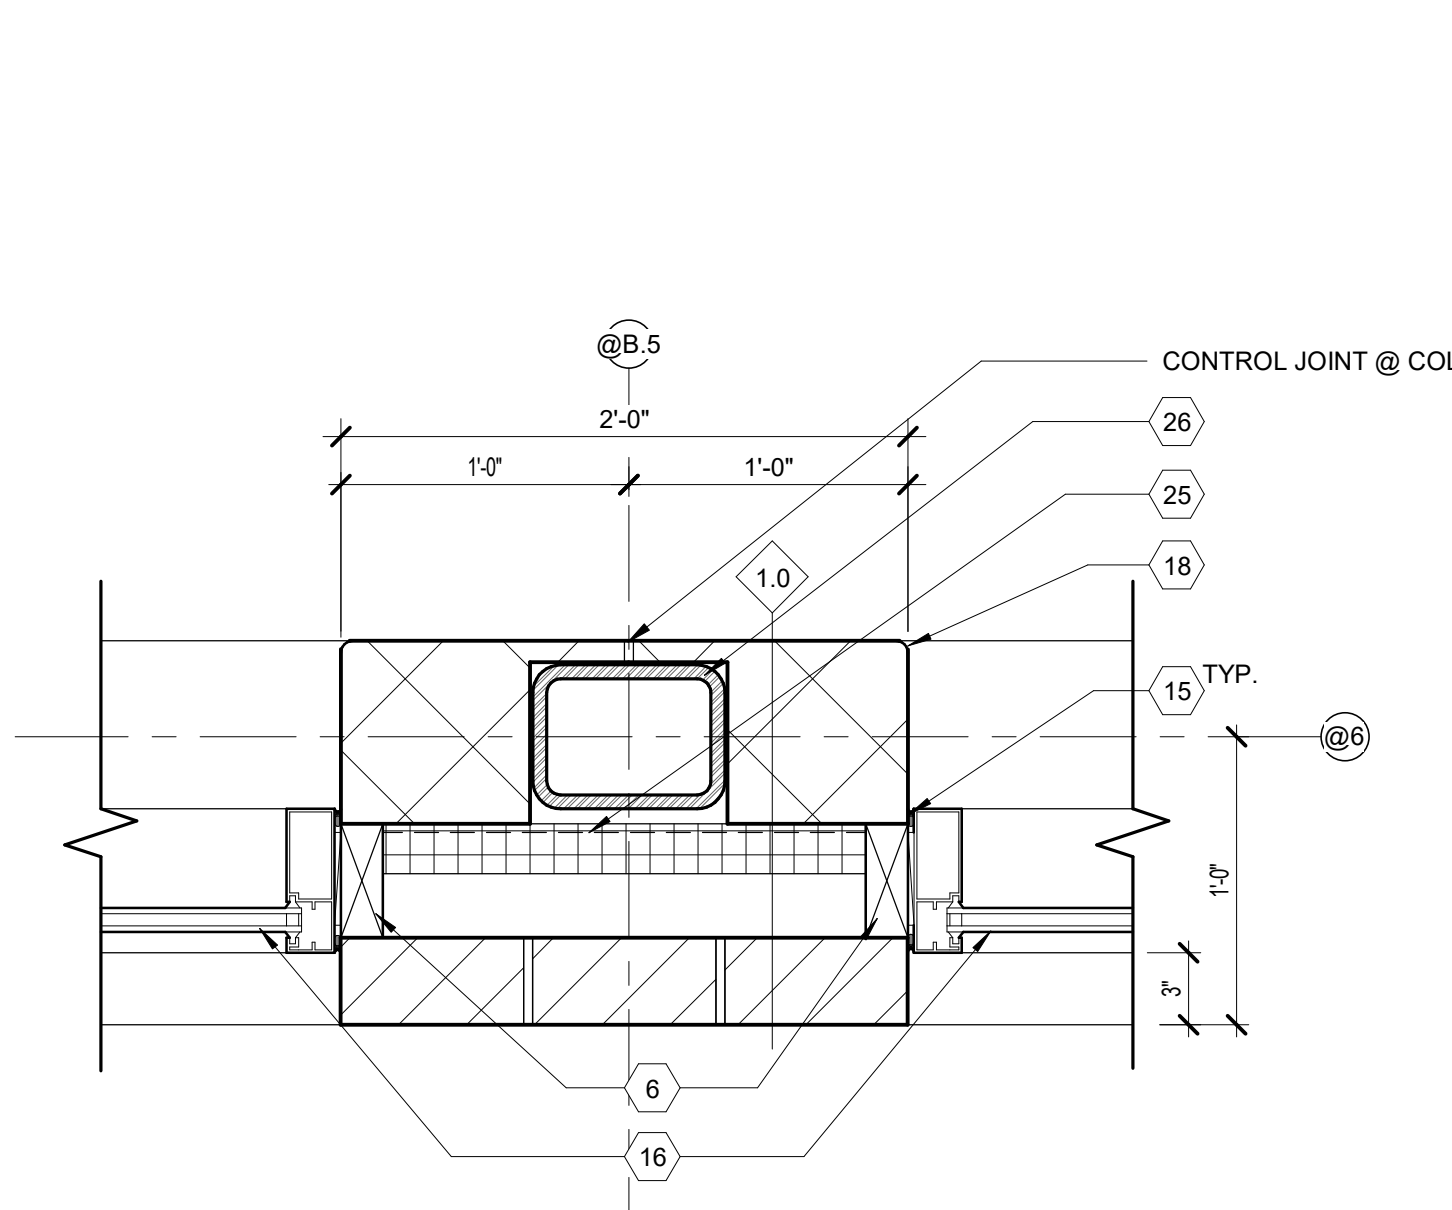


2 JAMB DETAIL @ DINING
SCALE: 1 1/2" = 1'-0"

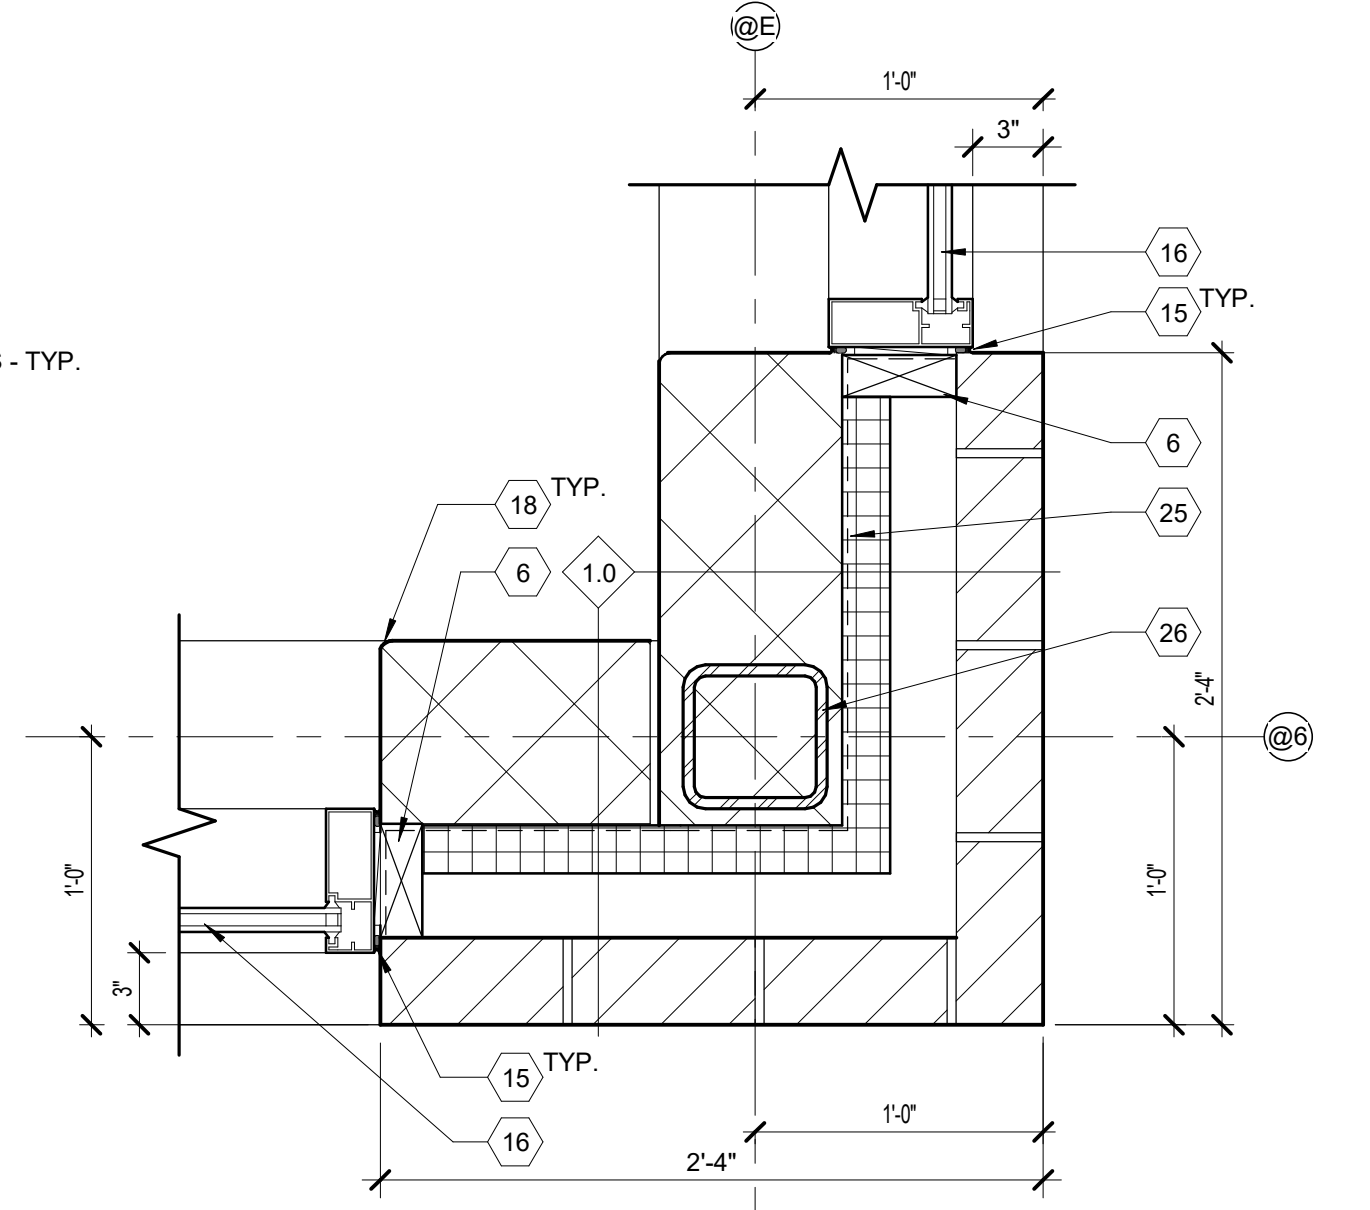


4 JAMB DETAIL @ DINING
SCALE: 1 1/2" = 1'-0"

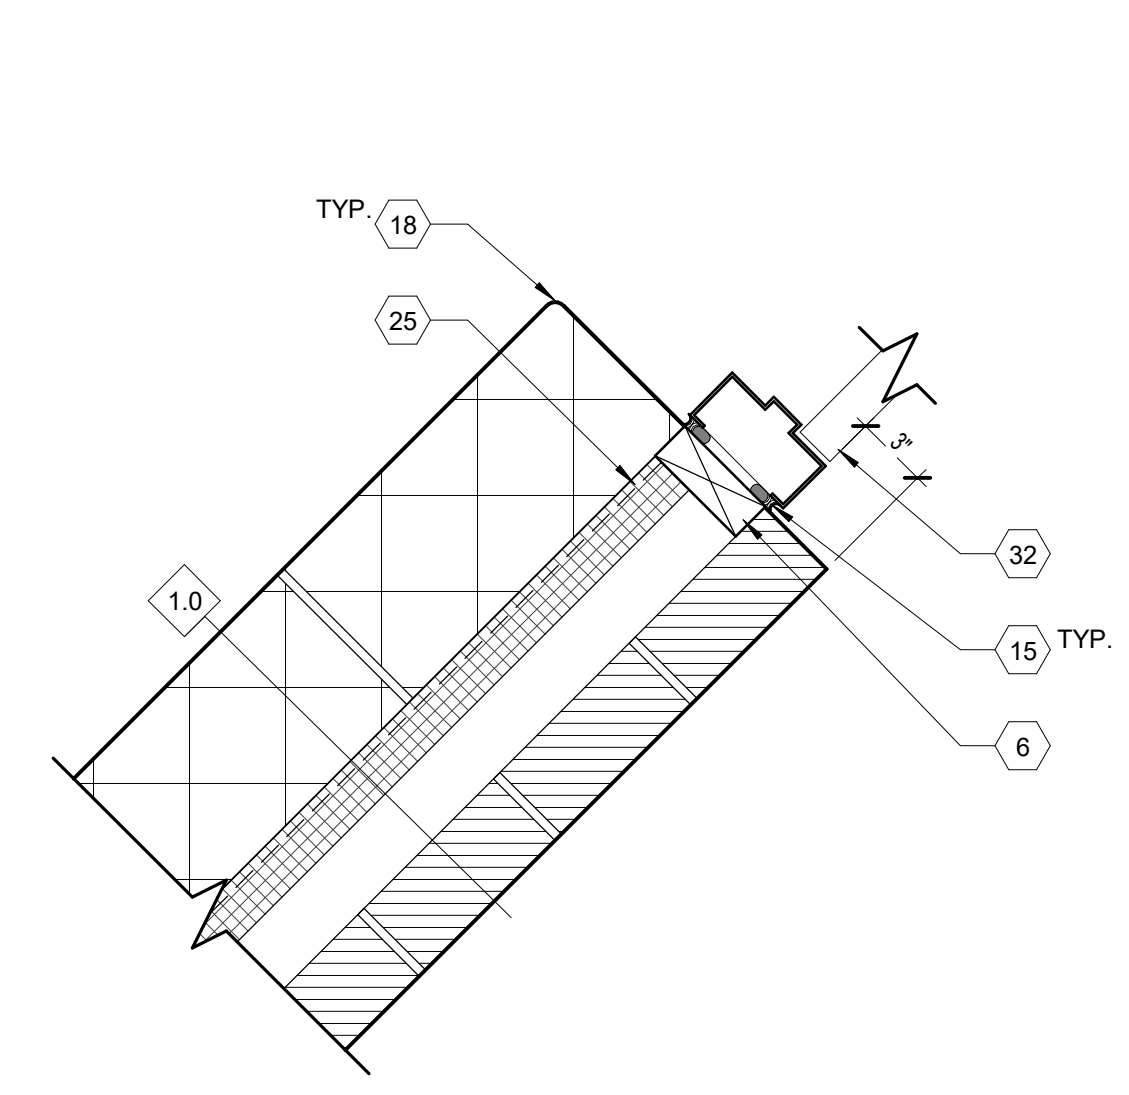


5 JAMB DETAIL @ CORRIDOR (SOUTH CONNECTOR)
SCALE: 1 1/2" = 1'-0"

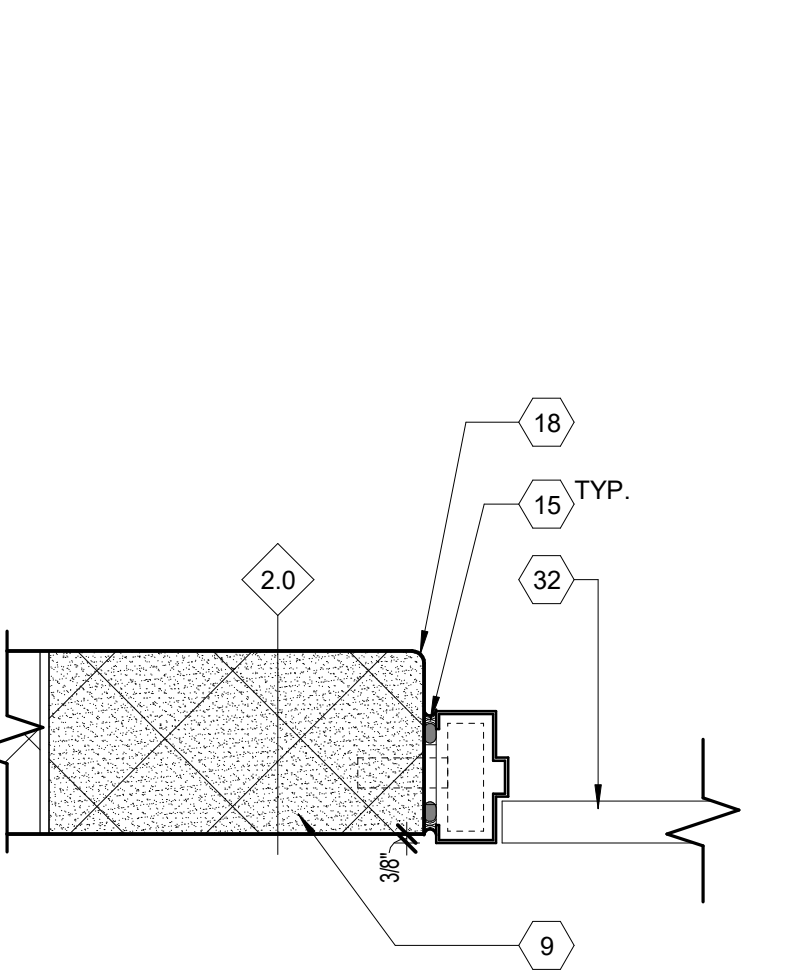


6 TYP. HM DR JAMB @ CMU
SCALE: 1 1/2" = 1'-0"

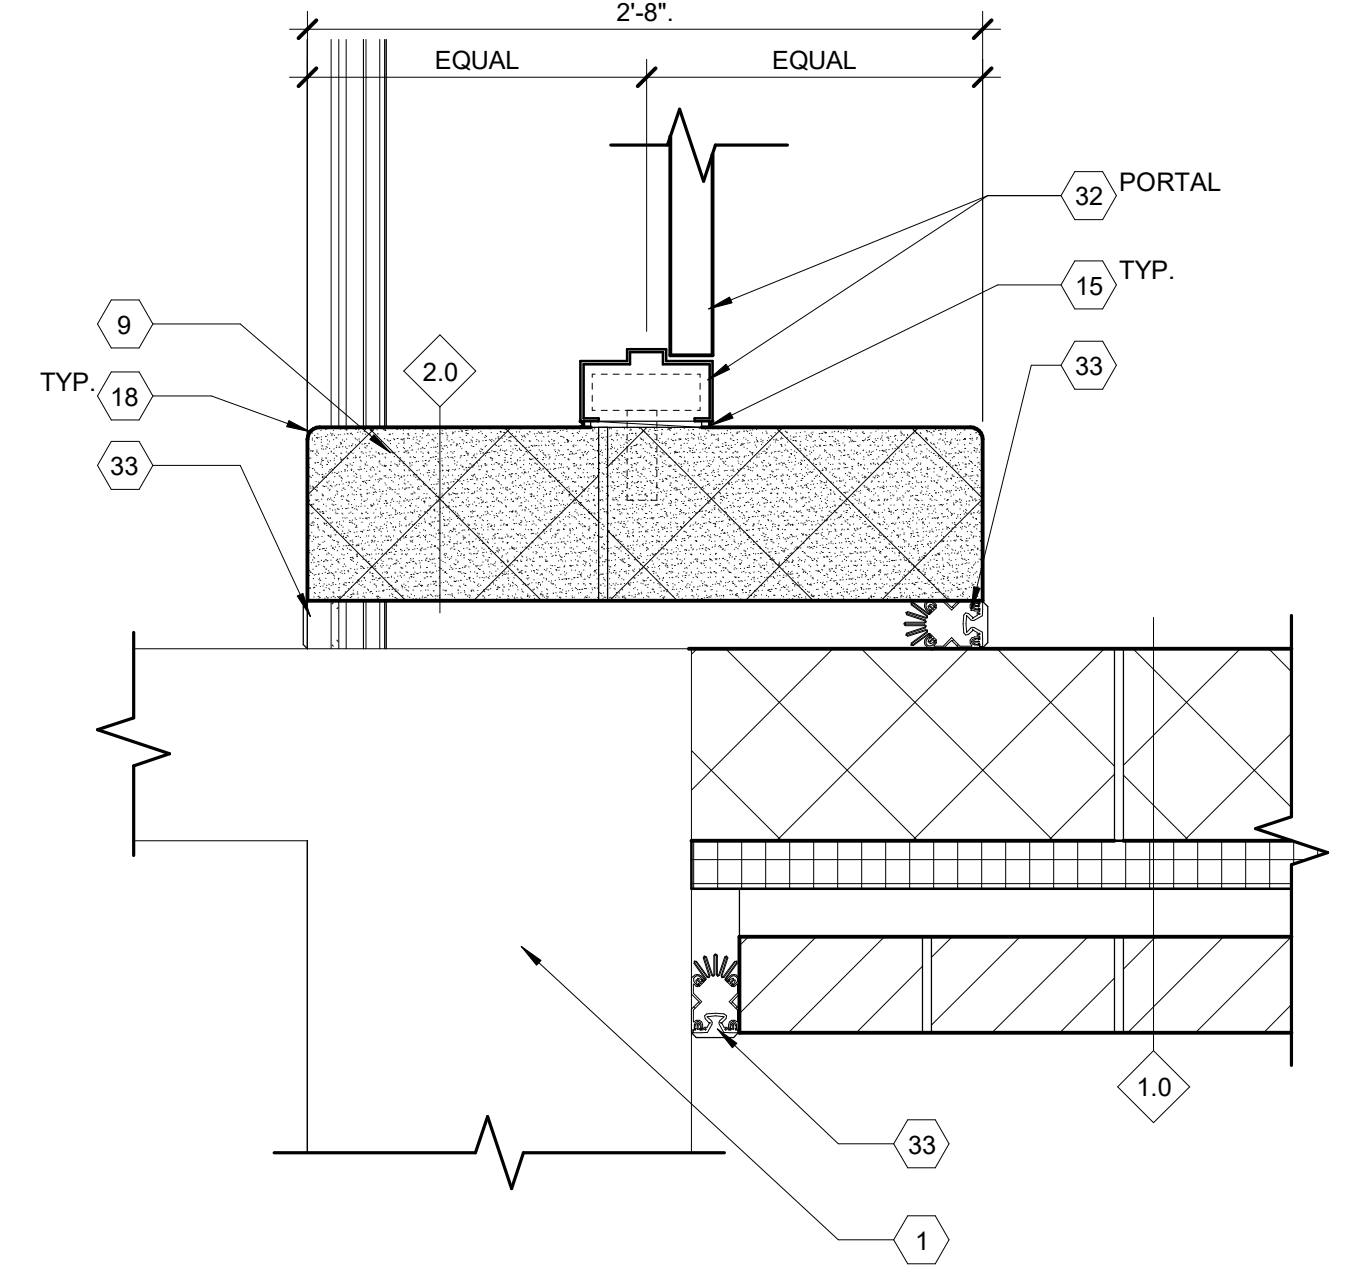


11 PORTAL FRAME @ GYM
SCALE: 1 1/2" = 1'-0"

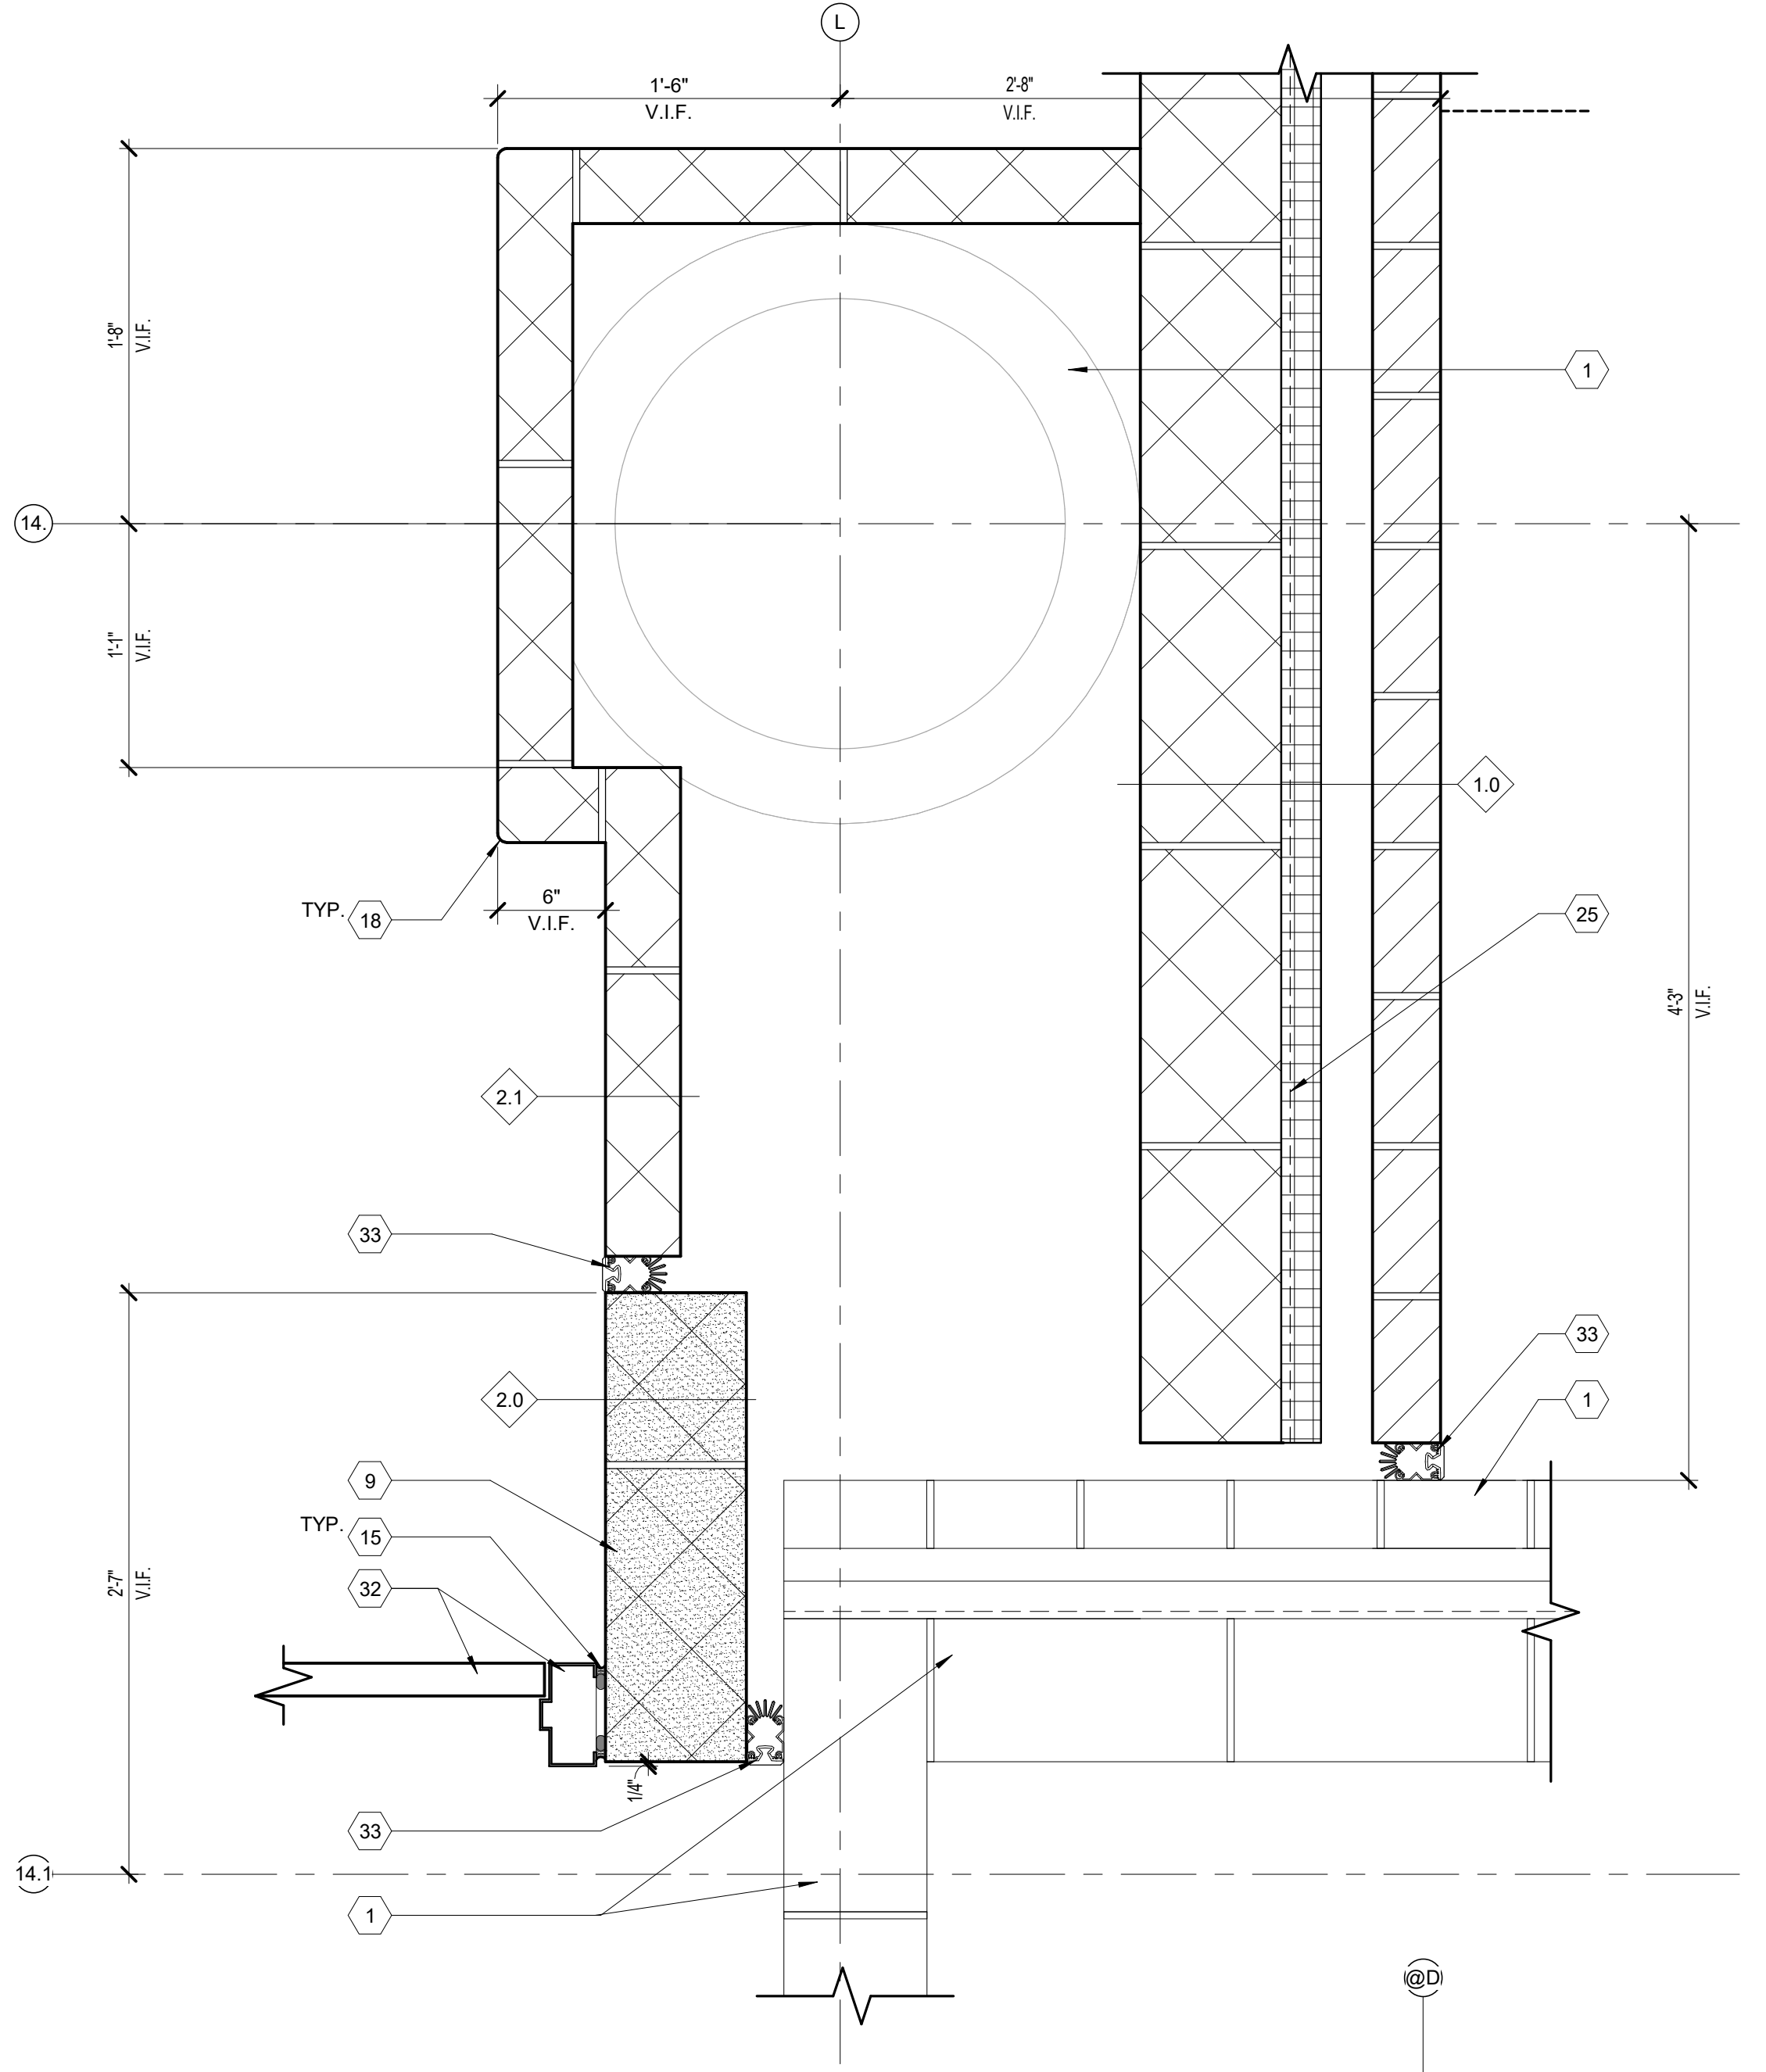


13 PORTAL FRAME @ SOUTH CONNECTOR
SCALE: 1 1/2" = 1'-0"

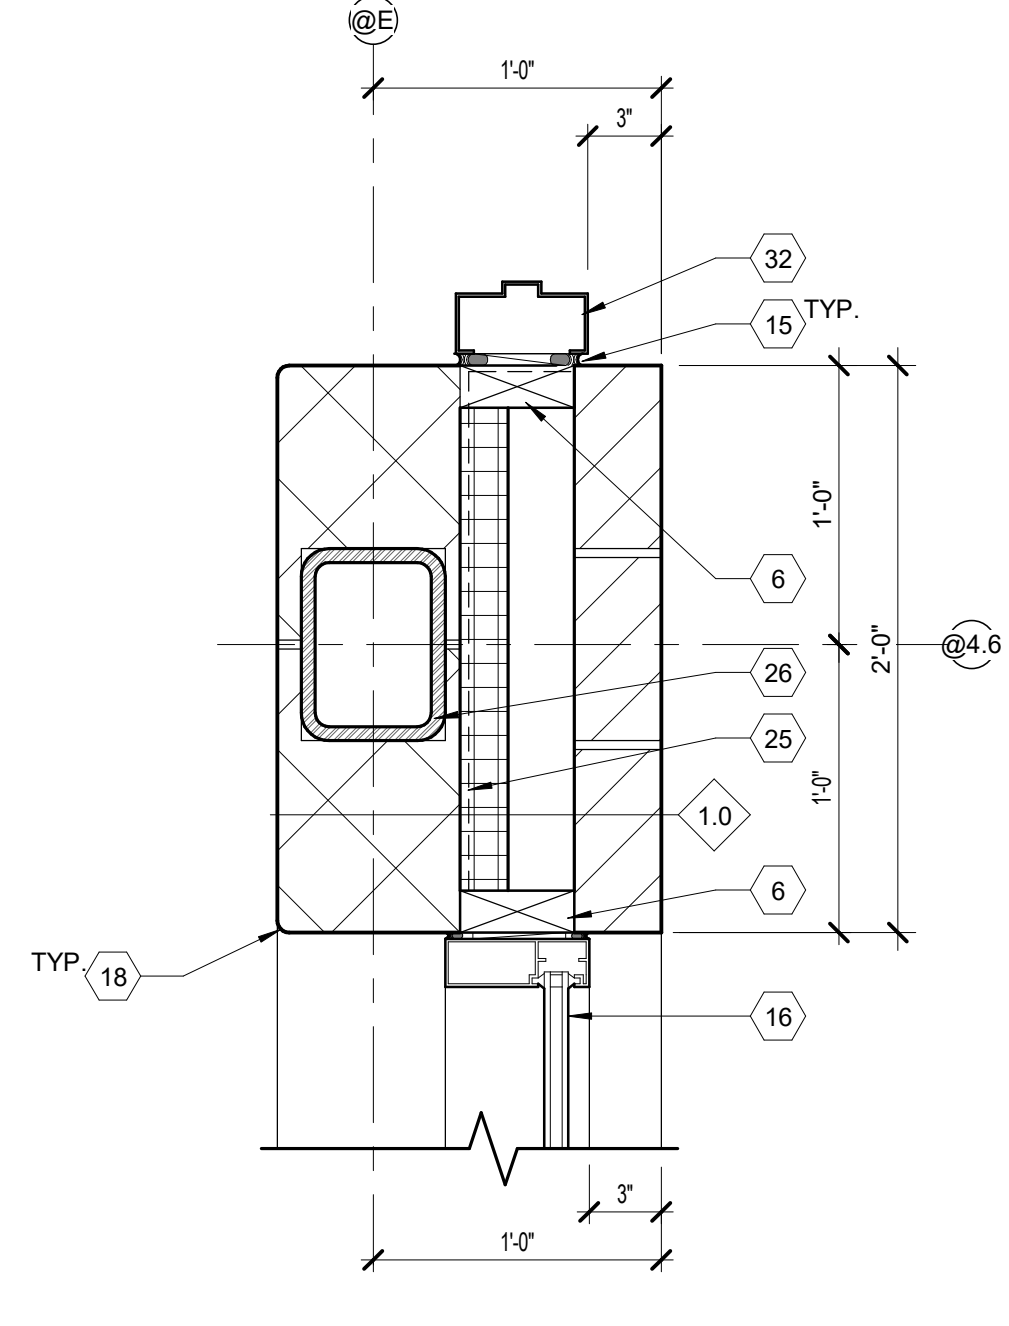


15 JAMB DETAIL @ DINING
SCALE: 1 1/2" = 1'-0"

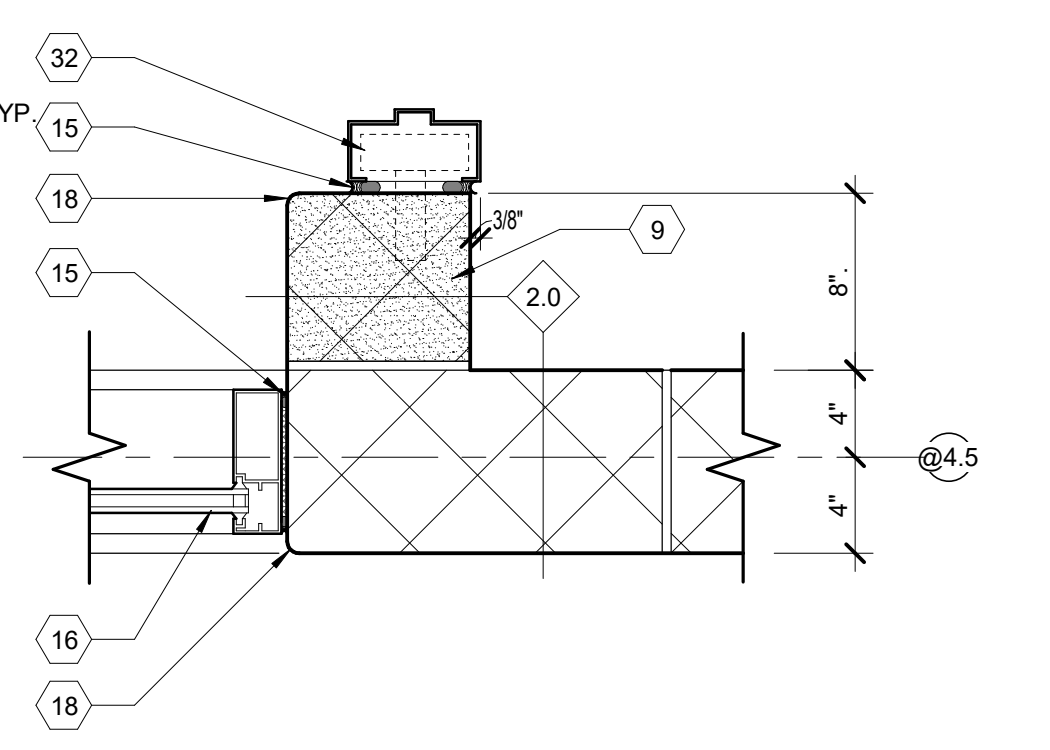


16 JAMB DETAIL @ SERVERY
SCALE: 1 1/2" = 1'-0"

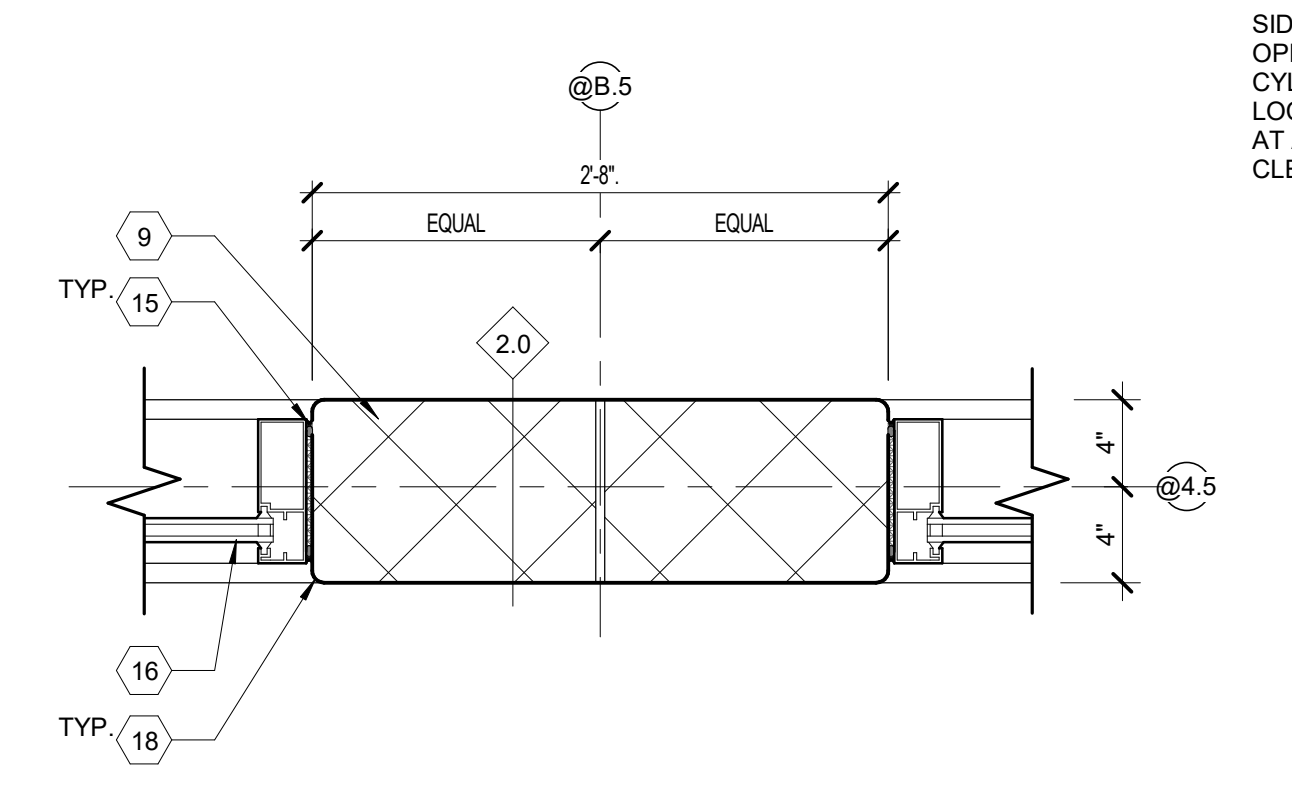


25 JAMB DETAIL @ SERVERY
SCALE: 1 1/2" = 1'-0"

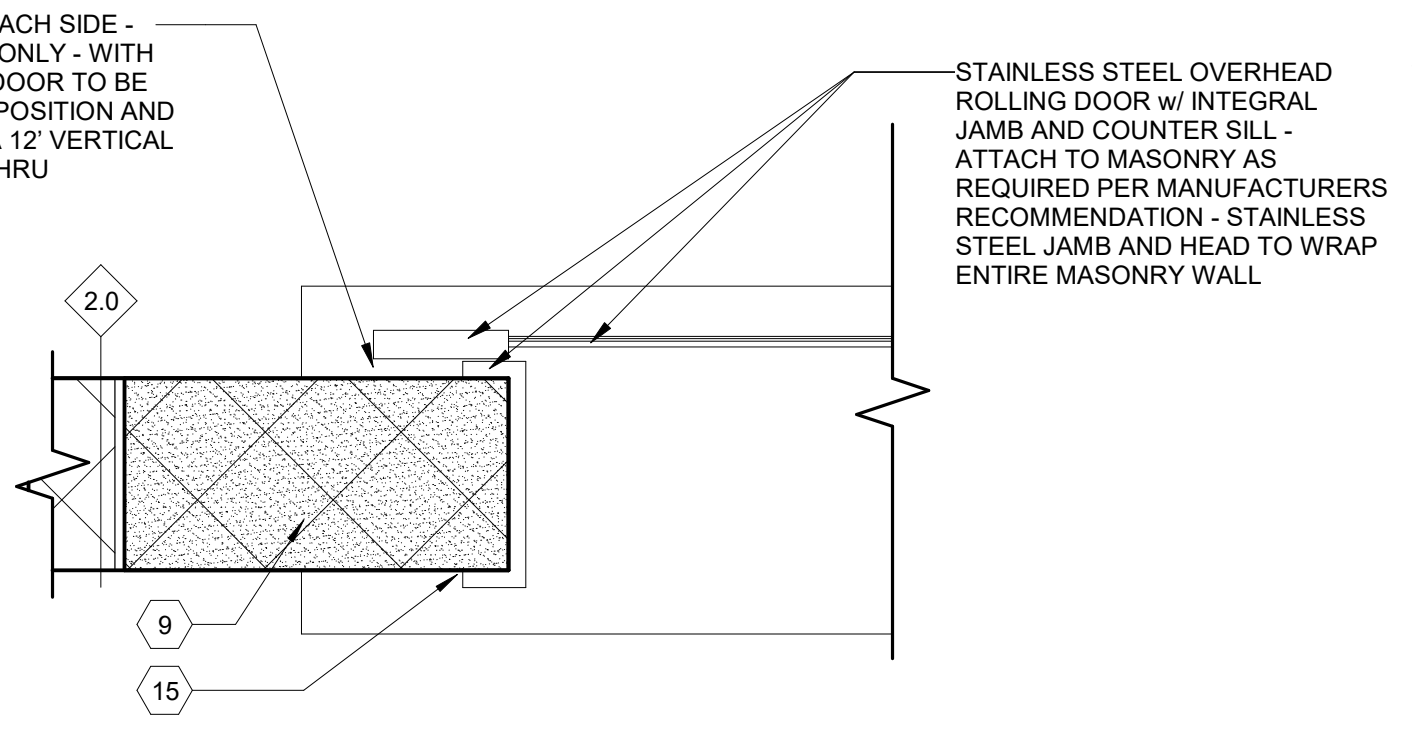


26 JAMB DETAIL @ TRAY DROP OFF
SCALE: 1 1/2" = 1'-0"

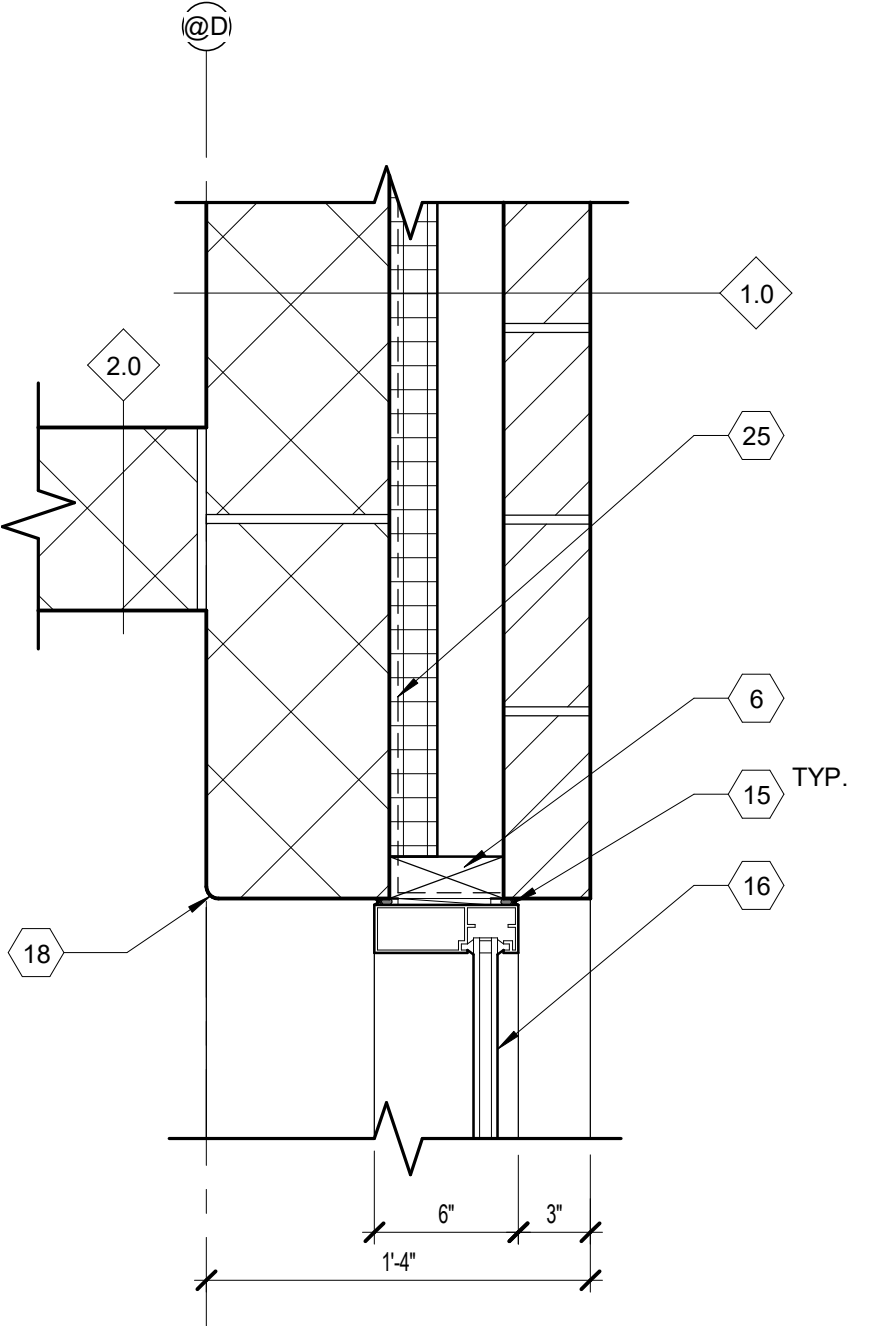

28 JAMB DETAIL @ DINING
SCALE: 1 1/2" = 1'-0"

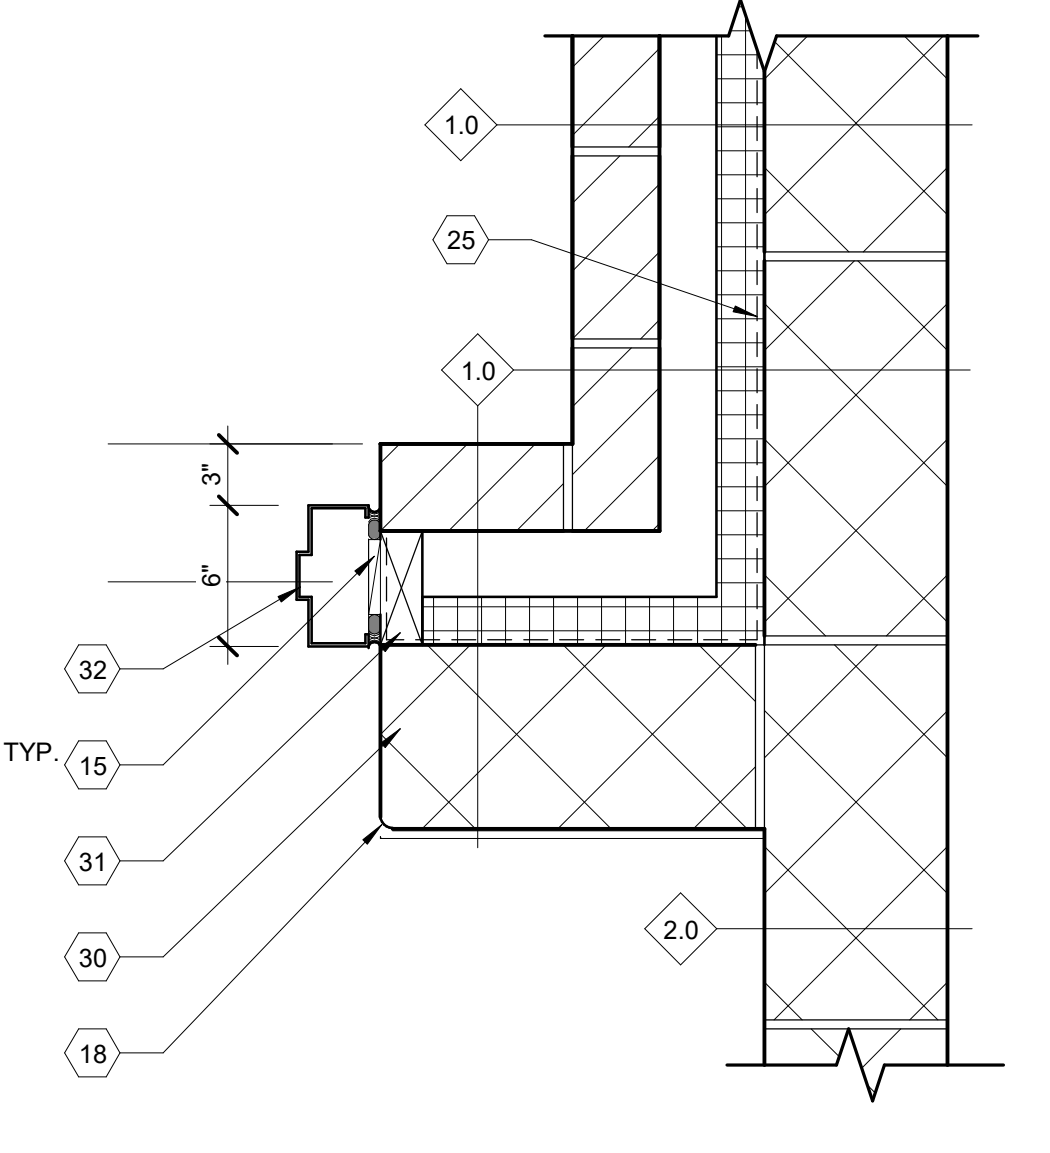

29 JAMB DETAIL @ CORRIDOR
SCALE: 1 1/2" = 1'-0"

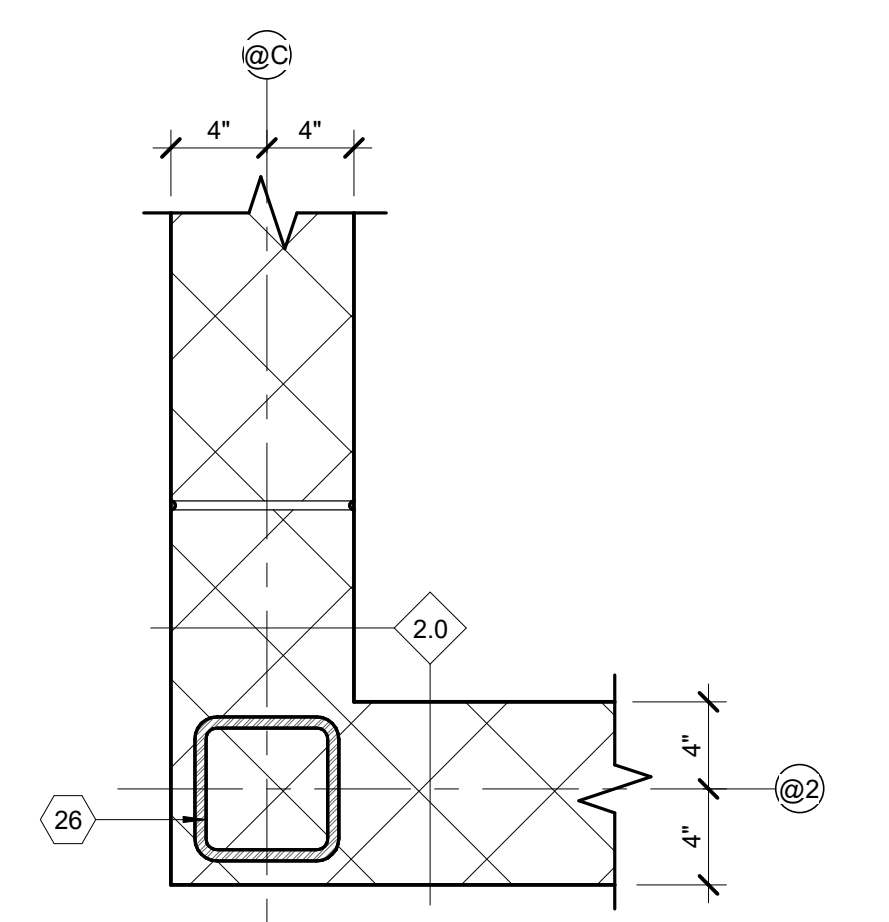

30 CORNER DETAIL @ DRY STORAGE
SCALE: 1 1/2" = 1'-0"

MATERIAL KEYNOTES


- 1 EXISTING TO REMAIN
- 2 FULLY ADHEARED SINGLE PLY MEMBRANE ROOFING
- 3 3/4" ROOFING BOARD
- 4 RIGID ROOF INSULATION R-30
- 5 METAL DECK (REFER TO STRUCTURAL)
- 6 2x PRESSURE TREATED WOOD BLOCKING
- 7 SPRAY INSULATION IN METAL DECK FLUTES TO ALLOW FOR CONTINUOUS INSULATION
- 8 STEEL LINTEL - EXTERIOR STEEL LINTELS TO BE GALVANIZED - PAINT (REFER TO STRUCTURAL)
- 9 GROUT SOLID
- 10 THRU WALL FLASHING
- 11 MORTAR NET
- 12 FACE BRICK - MATCH EXISTING
- 13 8x24 BURNISHED BLOCK ACCENT BAND - MATCH EXISTING
- 14 8x24 SPLIT FACE BLOCK WAINSCOT - MATCH EXISTING
- 15 SEALANT OVER BACKER ROD EXTERIOR / CAULK INTERIOR - TYPICAL AT ALL WINDOWS AND DOORS
- 16 ALUMINUM WINDOW SYSTEM WITH INSULATED GLAZING
- 17 BRICK VENT
- 18 BULLNOSE
- 19 BOND BREAK
- 20 4" CONCRETE SLAB ON VAPOR BARRIER (REFER TO STRUCTURAL)
- 21 PERIMETER INSULATION - EXTEND 2'-0" IN BOTH DIRECTIONS
- 22 COMPACTED GRANULAR FILL
- 23 GRADE (REFER TO CIVIL)
- 24 POURED CONCRETE FOUNDATION WALL (REFER TO STRUCTURAL)
- 25 BITUMINOUS DAMPPROOFING
- 26 STEEL COLUMN (REFER TO STRUCTURAL)
- 27 RIGID INSULATION
- 28 CONTINUOUS METAL ROOF EDGE - MATCH EXISTING PROFILE - AT CONNECTION POINTS ALSO MATCH EXISTING HEIGHT (V.I.F.)
- 29 NEW FENCE (REFER TO CIVIL AND ELECTRICAL)
- 30 CONCRETE MASONRY UNIT
- 31 COLD FORMED METAL FRAMING
- 32 DOOR AND FRAME (REFER TO SCHEDULE)
- 33 2" EXPANSION JOINT / CONTROL JOINT AS REQUIRED - FIRE RATE AS REQUIRED (REFER TO CODE PLAN)
- 34 LIGHT FIXTURE (REFER TO ELECTRICAL)
- 35 MECHANICAL ITEM (REFER TO MECHANICAL)
- 36 POURED CONCRETE FOOTING (REFER TO STRUCTURAL)
- 37 STEEL ANGLE (REFER TO STRUCTURAL)
- 38 STEEL TUBE (REFER TO STRUCTURAL)
- 39 STEEL JOIST (REFER TO STRUCTURAL)
- 40 STEEL BEAM (REFER TO STRUCTURAL)
- 41 SUSPENDED CEILING SYSTEM (REFER TO SCHEDULE)
- 42 LOUVER (REFER TO MECHANICAL)
- 43 BOND BEAM WITH (2) #6 CONT. GROUT SOLID (REFER TO STRUCTURAL)
- 44 CMU FOUNDATION WALL (REFER TO STRUCTURAL)
- 45 ROOF LADDER - ATTACH AND FLASH AS REQUIRED PER MANUFACTURER'S RECOMMENDATIONS (REFER TO REFERENCE ONLY DETAIL)
- 46 WALL MOUNTED ELECTRICAL ITEM (REFER TO ELECTRICAL)
- 47 CEILING MOUNTED ELECTRICAL ITEM (REFER TO ELECTRICAL)
- 48 PLUMBING FIXTURE AND ACCESSORIES (REFER TO MECHANICAL & STANDARD MOUNTING HEIGHTS CHART)
- 49 BASE MATERIAL (REFER TO SCHEDULE)
- 50 CONTROL JOINT

NO.	REVISION	DATE

STATE OF MICHIGAN
DEPARTMENT OF TECHNOLOGY, MANAGEMENT AND BUDGET
FACILITIES AND BUSINESS SERVICES ADMINISTRATION
DESIGN AND CONSTRUCTION DIVISION
ADAM LACEL, R.A. DIRECTOR

FILE NO.
491/20167.SDW

FUNDING CODE 171CODHHS7255 CONTRACT NO. Y22003

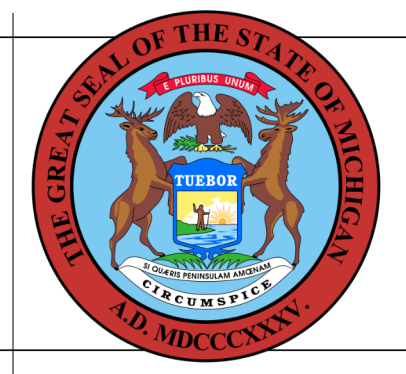

BUILDING
These documents are approved for compliance with the STATE OF MICHIGAN BUILDING CODE subject to field inspection and the conditions of approval.

WTAARCH.COM

WTA ARCHITECTS

100 S Jefferson Ave, Suite 601
Saginaw, Michigan 48607
989 752 8107 COPYRIGHT © 2023

PROJECT TITLE
491/20167.SDW - PHASE 500:
CENTER FOR FORENSIC PSYCHIATRY - CREATE KITCHEN
SALINE, MICHIGAN

SHEET TITLE
PLAN DETAILS

PROJECT NUMBER
2021094


PROJECT DATE
SEPTEMBER 6, 2023
CHECKED BY
C.D.S.

SHEET NUMBER
A2.31

ROOM FINISH SCHEDULE													
ROOM NO.	ROOM NAME	FLOOR	BASE	MAT.	FINISH	NORTH WALL	EAST WALL	SOUTH WALL	WEST WALL	CEILING	CL.G.	HEIGHT	REMARKS
E124	GYMNASIUM	EXISTING	EXIST.	EXIST.	PAINT	EXIST.	EXIST.	EXIST.	EXIST.	EXIST.			O
E126	SECURE CORR.	EXIST. / C. TILE	EXIST. / C. TILE	EXIST. / C.M.U.	PAINT	EXIST.	EXIST.	EXIST.	EXIST.	EXIST.			O
H104	WAREHOUSE	EXISTING	EXIST.	EXIST.	EXIST.	EXIST.	EXIST.	EXIST.	EXIST.	EXIST.			O
H116A	SECUR. VEST.	C. TILE	C. TILE	C.M.U.	PAINT	C.M.U.	PAINT	C.M.U.	PAINT	SAT-1		9'-0"	
H119	STORAGE	RTF	R.W.B.	C.M.U.	PAINT	C.M.U.	PAINT	C.M.U.	PAINT	SAT-1		9'-0"	L
H120	CORRIDOR (WEST CONNECTOR)	SEALED CONC.	R.W.B.	C.M.U.	PAINT	--	--	C.M.U.	PAINT	SAT-1		9'-0"	L
H121	STAIR	SEALED CONC.	R.W.B.	C.M.U.	EPOXY PAINT	C.M.U.	EPOXY PAINT	C.M.U.	EPOXY PAINT	EXP.			
H122	CORRIDOR	SEALED CONC.	R.W.B.	C.M.U.	PAINT	C.M.U.	PAINT	C.M.U.	PAINT	SAT-1		9'-0"	L
H123	KITCHEN	RSF	RSF COVE	C.M.U.	EPOXY PAINT	C.M.U.	EPOXY PAINT	C.M.U.	EPOXY PAINT	SAT-2		9'-0"	N
H123A	DISH AREA	RSF	RSF COVE	C.M.U.	EPOXY PAINT	C.M.U.	EPOXY PAINT	C.M.U.	EPOXY PAINT	SAT-2		9'-0"	N
H124	DRY STORAGE	RSF	RSF COVE	C.M.U.	EPOXY PAINT	C.M.U.	EPOXY PAINT	C.M.U.	EPOXY PAINT	SAT-2		8'-0"	N
H125	OFFICE	RSF	R.W.B.	C.M.U.	PAINT	C.M.U.	PAINT	C.M.U.	PAINT	SAT-1		10'-0"	
H126	STAFF TOILET	RSF	R.W.B.	C.M.U.	EPOXY PAINT	C.M.U.	EPOXY PAINT	C.M.U.	EPOXY PAINT	SAT-2		8'-0"	
H127	BREAK ROOM	RSF	R.W.B.	C.M.U.	EPOXY PAINT	C.M.U.	EPOXY PAINT	C.M.U.	EPOXY PAINT	SAT-1		10'-0"	
H128	CART WASH	RSF	RSF COVE	C.M.U.	EPOXY PAINT	C.M.U.	EPOXY PAINT	C.M.U.	EPOXY PAINT	SAT-2		9'-0"	N
H129	CHEMICAL STOR.	RSF	RSF COVE	C.M.U.	EPOXY PAINT	C.M.U.	EPOXY PAINT	C.M.U.	EPOXY PAINT	SAT-2		9'-0"	N
H130	SERVERY	C. TILE	C. TILE	C.M.U.	PAINT	C.M.U.	PAINT	C.M.U.	PAINT	SAT-2		9'-0"	
H131	DINING	C. TILE	C. TILE	C.M.U.	EPOXY PAINT	C.M.U.	EPOXY PAINT	C.M.U.	EPOXY PAINT	GYP. BD.			M
H132	CORRIDOR (SOUTH CONNECTOR)	C. TILE / CPT	C. TILE	C.M.U.	PAINT	C.M.U.	PAINT	C.M.U.	PAINT	SAT-1		8'-0"	L
H133	CORR. (GYM CONN.)	RTF	R.W.B.	C.M.U.	PAINT	C.M.U.	PAINT	C.M.U.	PAINT	SAT-1		9'-0"	
H200	STAIR	SEALED CONC.	R.W.B.	C.M.U.	EPOXY PAINT	C.M.U.	EPOXY PAINT	C.M.U.	EPOXY PAINT	EXP.			
H201	MECHANICAL / ELECTRICAL	SEALED CONC.	--	C.M.U.	EPOXY PAINT	C.M.U.	EPOXY PAINT	C.M.U.	EPOXY PAINT	EXP.			


DOOR & FRAME SCHEDULE													
DOOR NUMBER	ROOM NAME	PAIR	WIDTH	HEIGHT	THK.	MAT.	TYPE	FRAME	HEAD	JAMB	SILL	FIRE RATING	REMARKS
E124.C	CORR. (GYM CONN.)		3'-0"	7'-0"	1 3/4"	H.M.	D4	H.M.	F2	27/A7.02 SIM	30/A7.02 SIM		90 D, K, S
E126.A	SECURE CORR.	X	3'-0"	7'-2"	1 3/4"	H.M.	D2	H.M.	F1	20/A3.01 SIM	25/A3.01		20 B, C, D, G, S
H120.A	CORRIDOR (WEST CONNECTOR)	X	3'-6"	7'-0"	1 3/4"	H.M.	D4	H.M.	F2	27/A7.02	1/A2.31	30/A7.02	90 B, C, G, R
H120.B	CORRIDOR (WEST CONNECTOR)		10'-0"	8'-0"	1 3/8"	STEEL	D3	STEEL	-	27/A3.01	28/A3.01		H
H120.C	CORRIDOR (WEST CONNECTOR)		10'-0"	8'-0"	1 3/8"	STEEL	D3	STEEL	-	27/A3.01	28/A3.01		H
H120.D	CORRIDOR (WEST CONNECTOR)		3'-0"	7'-2"	1 3/4"	ALUM.	D2	ALUM.	F1	21/A3.01	29/A2.31 SIM		C, G, T
H120.E	CORRIDOR (WEST CONNECTOR)		3'-0"	7'-2"	1 3/4"	ALUM.	D2	ALUM.	F1	21/A3.01	29/A2.31		C, G, T
H121.A	STAIR		3'-0"	7'-2"	1 3/4"	WD.	D4	H.M.	F1	30/A3.01	6/A2.31		B 60 H, R
H122.A	SECUR. VEST.		3'-8"	7'-2"	1 3/4"	WD.	D2	H.M.	F1	20/A3.01	6/A2.31		C, F, G, S
H122.B	CORRIDOR	X	3'-0"	7'-2"	1 3/4"	WD.	D2	H.M.	F1	20/A3.01	6/A2.31		B, C, G, R
H122.C	CORRIDOR	X	3'-0"	7'-2"	1 3/4"	WD.	D2	H.M.	F1	20/A3.01	6/A2.31		B, C, G, R
H122.D	CORRIDOR		4'-0"	7'-2"	1 3/4"	ALUM.	D2	ALUM.	F1	21/A3.01	29/A2.31		C, D, E, G, T
H124.A	DRY STORAGE		3'-0"	7'-2"	1 3/4"	H.M.	D1	H.M.	F1	20/A3.01	6/A2.31		H
H125.A	OFFICE		3'-0"	7'-2"	1 3/4"	WD.	D2	H.M.	F1	20/A3.01	6/A2.31		H, R
H126.A	STAFF TOILET		3'-0"	7'-2"	1 3/4"	H.M.	D1	H.M.	F1	20/A3.01	6/A2.31		H
H127.A	BREAK ROOM		3'-0"	7'-2"	1 3/4"	WD.	D2	H.M.	F1	20/A3.01	6/A2.31		H, R
H129.A	CHEMICAL STOR.		3'-0"	7'-2"	1 3/4"	H.M.	D1	H.M.	F1	20/A3.01	6/A2.31		H
H130.A	SERVERY		3'-8"	7'-2"	1 3/4"	WD.	D1	H.M.	F1	20/A3.01	6/A2.31		C, E, G
H130.B	SERVERY		3'-8"	7'-2"	1 3/4"	WD.	D2	H.M.	F1	20/A3.01	6/A2.31		B, E, H, S
H130.C	SERVERY		3'-8"	7'-2"	1 3/4"	WD.	D2	H.M.	F1	20/A3.01	6/A2.31		B, E, H, S
H131.A	DINING	X	3'-0"	7'-2"	1 3/4"	WD.	D2	H.M.	F1	20/A3.01	6/A2.31		B, E, H, S
H131.B	SECUR. VEST.		3'-8"	7'-2"	1 3/4"	WD.	D2	H.M.	F1	20/A3.01	6/A2.31		E, G, J, P, Q, S
H131.C	DINING	X	3'-0"	7'-2"	1 3/4"	D.H.M.	D2	D.H.M.	F1	29/A3.01	5/A2.31		C, D, E, G, U
H131.D	DINING		8'-0"	3'-4"	1/2"	STEEL	D3	STEEL	-	26/A3.01	26/A3.01		B, H
H132.A	CORR. (S. CONN.)	X	3'-6"	7'-0"	1 3/4"	H.M.	D4	H.M.	F2	27/A7.02	13/A2.31	30/A7.02	90 B, E, H, S
H132.B	STORAGE		3'-8"	7'-2"	1 3/4"	H.M.	D1	H.M.	F1	20/A3.01	6/A2.31		E, H
H132.C	CORRIDOR (SOUTH CONNECTOR)	X	3'-0"	7'-2"	1 3/4"	D.H.M.	D2	D.H.M.	F1	21/A3.01	5/A2.31		C, D, E, G, U
H133.A	CORR. (GYM CONN.)		3'-0"	7'-2"	1 3/4"	WD.	D4	H.M.	F1	20/A3.01	6/A2.31		D, E, K, S
H200.A	STAIR		3'-0"	7'-2"	1 3/4"	WD.	D4	H.M.	F1	20/A3.01	6/A2.31		H, R
H201.A	MECHANICAL / ELECTRICAL		3'-0"	7'-2"	1 3/4"	H.M.	D1	H.M.	F1	22/A3.01	22/A3.01		H

FINISH MATERIAL SCHEDULE					
MATERIAL	MANUFACTURER	STYLE	COLOR	SIZE	REMARKS
C. TILE - CERAMIC TILING	STONEPEAK	SIMPLY MODERN	SIMPLY TAN, HONED FINISH	12"x24"	WITH MATCHING SIMPLY MODERN 6"x12" COVE BASE, LATICRETE GROUT
CPT - CARPET TILE	TARKETT	ASSERTIVE ACTION RIB	CHROMIUM 26201	24"x24"	COLOR: HEMP 27. 1/3 ASHLAR LAYING PATTERN
PAINT - CEILINGS	SHERWIN-WILLIAMS		SW1004 PURE WHITE		GLUE-DOWN, FLEX AIRE CUSHION BACK
PAINT - EXTERIOR DOORS & FRAMES	SHERWIN-WILLIAMS		SW1004 PURE WHITE		
PAINT - INTERIOR DOORS & FRAMES	SHERWIN-WILLIAMS		SW1099 KNUBBY WOOL		
PAINT - STAIRS & RAILINGS	SHERWIN-WILLIAMS		SW6215 ROCKY RIVER		
PAINT - WALLS	SHERWIN-WILLIAMS		SW1102 CHENILLE WHITE		
RSF - RESILIENT SHEET VINYL	PROTECT-ALL	CLASSIC	LIGHT GRAY	5 FT. x 8 FT.	WITH MATCHING PROTECT-ALL 6" COVE BASE SYSTEM - ONLY WHERE NOTED.
RTF - RESILIENT TILE FLOORING	TARKETT	ID LATITUDE	HEARTHSTONE	18"x18"	DIRECT GLUE DOWN
RWB - RESILIENT WALL BASE	TARKETT	TP RUBBER	CHARCOAL 20	4" COVE	
SAT-1 - SUSPENDED ACOUSTIC TILE	ARMSTRONG	FISSURED	WHITE	24"x24"	
SAT-2 - SUSPENDED ACOUSTIC TILE	ARMSTRONG	KITCHEN ZONE	WHITE	24"x24"	

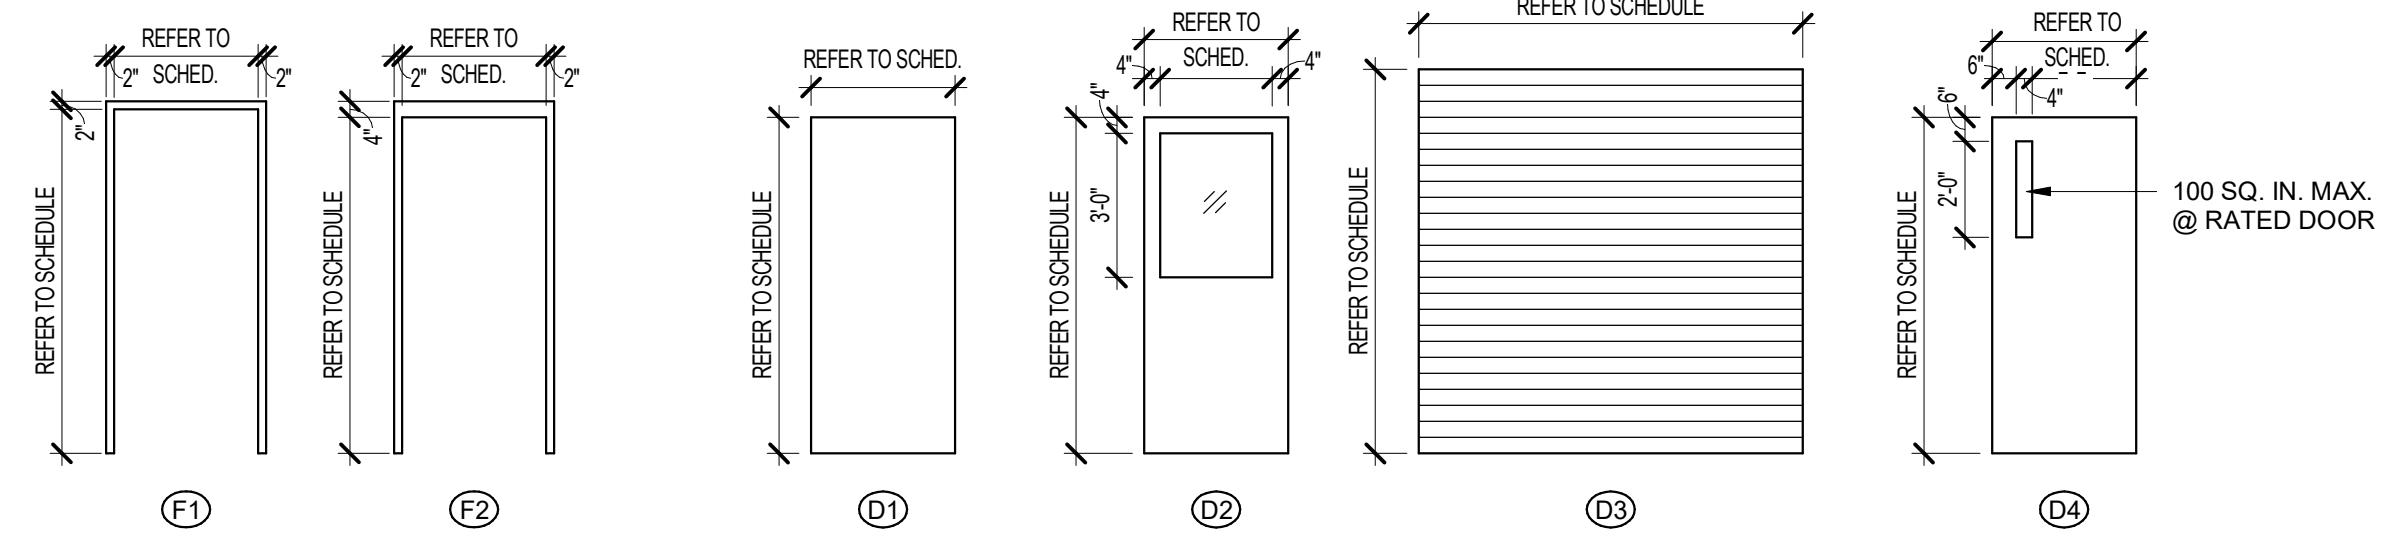


DOOR FRAMES
1/4" = 1'-0"

DOOR TYPES
1/4" = 1'-0"

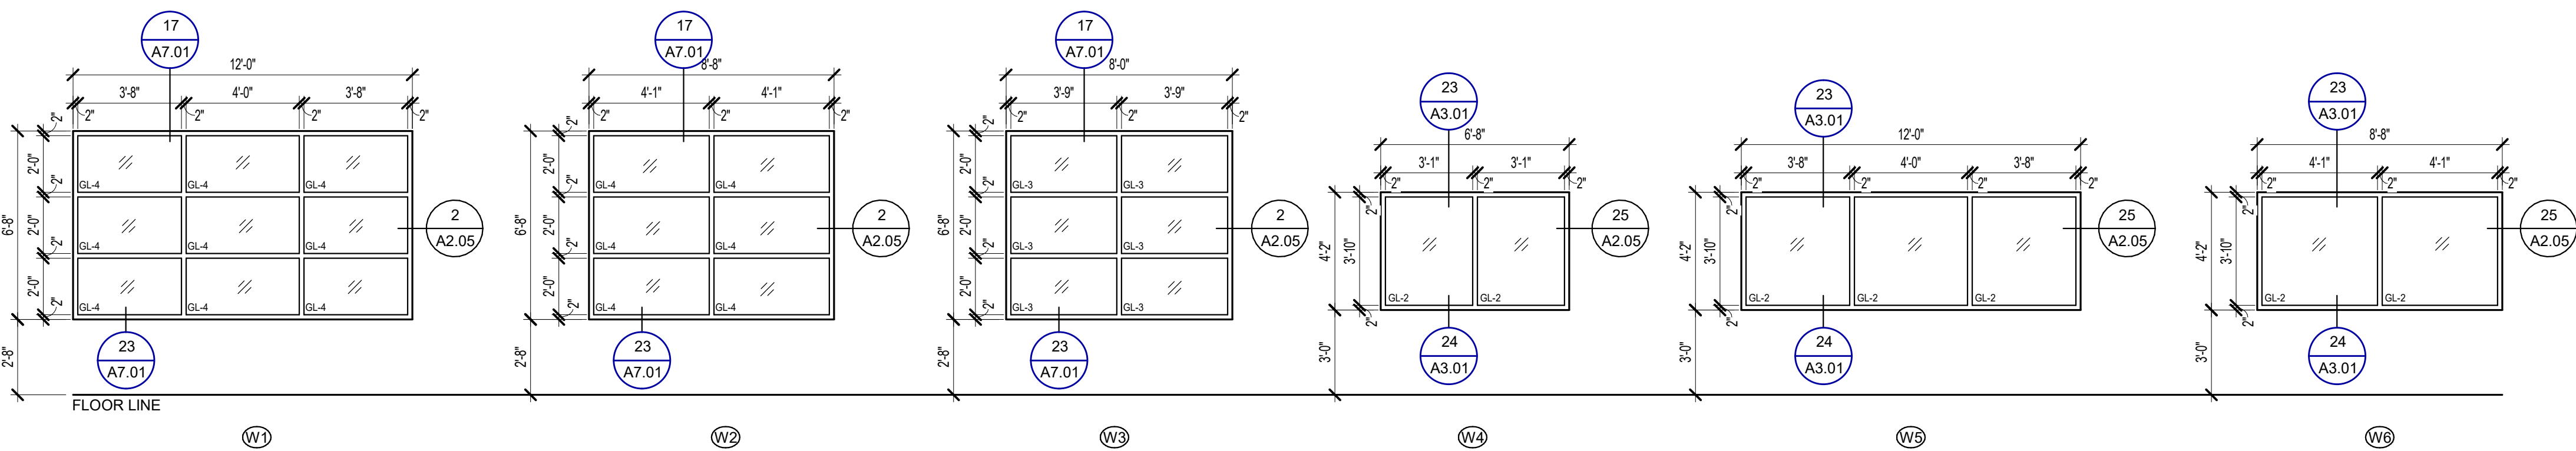

WINDOW TYPES
1/4" = 1'-0"

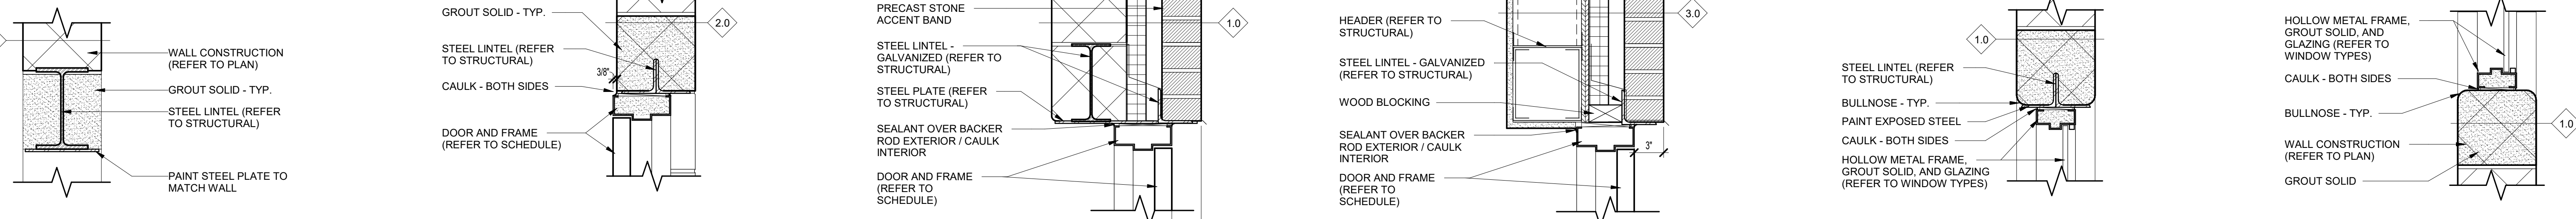

19 OPENING HEAD DETAIL @ SERVERY
SCALE: 1 1/2" = 1'-0"


20 TYP. INT. DOOR HEAD DETAIL
SCALE: 1 1/2" = 1'-0"

21 TYP. EXT. DOOR HEAD DETAIL
SCALE: 1 1/2" = 1'-0"


22 DOOR HEAD DETAIL @ MECHANICAL / ELECTRICAL
SCALE: 1 1/2" = 1'-0"

23 TYP. WINDOW HEAD DETAIL
SCALE: 1 1/2" = 1'-0"


24 TYP. WINDOW SILL DETAIL
SCALE: 1 1/2" = 1'-0"

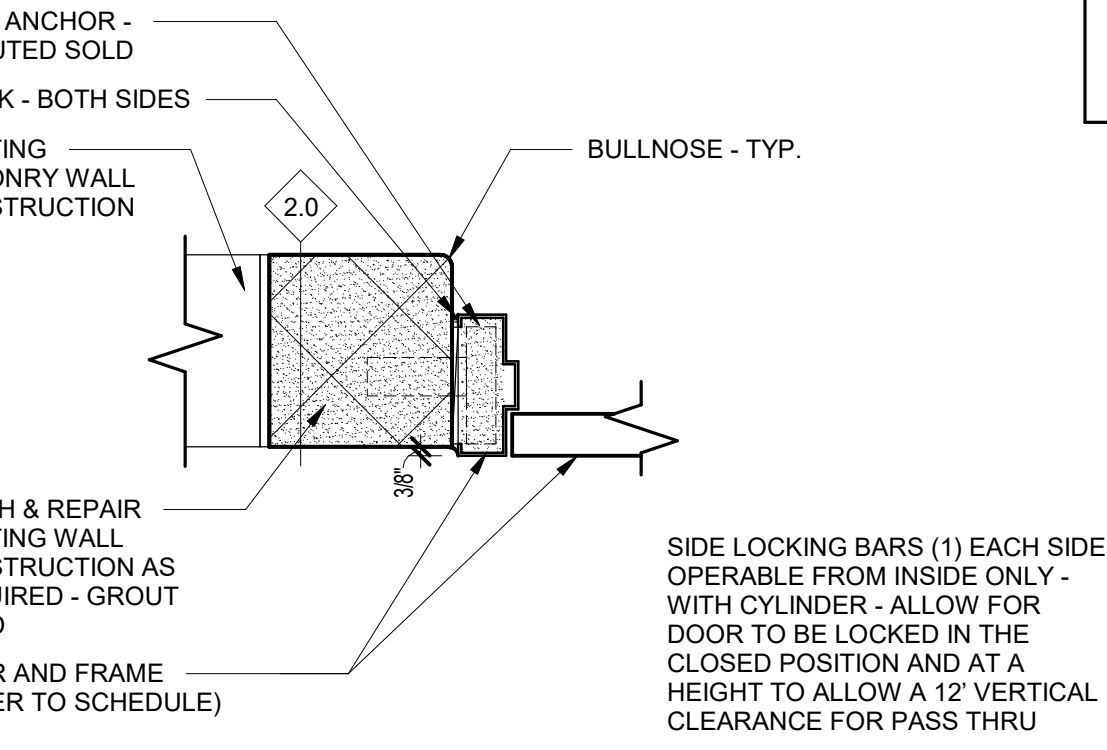


25 TYP. INT. DOOR JAMB DETAIL
SCALE: 1 1/2" = 1'-0"

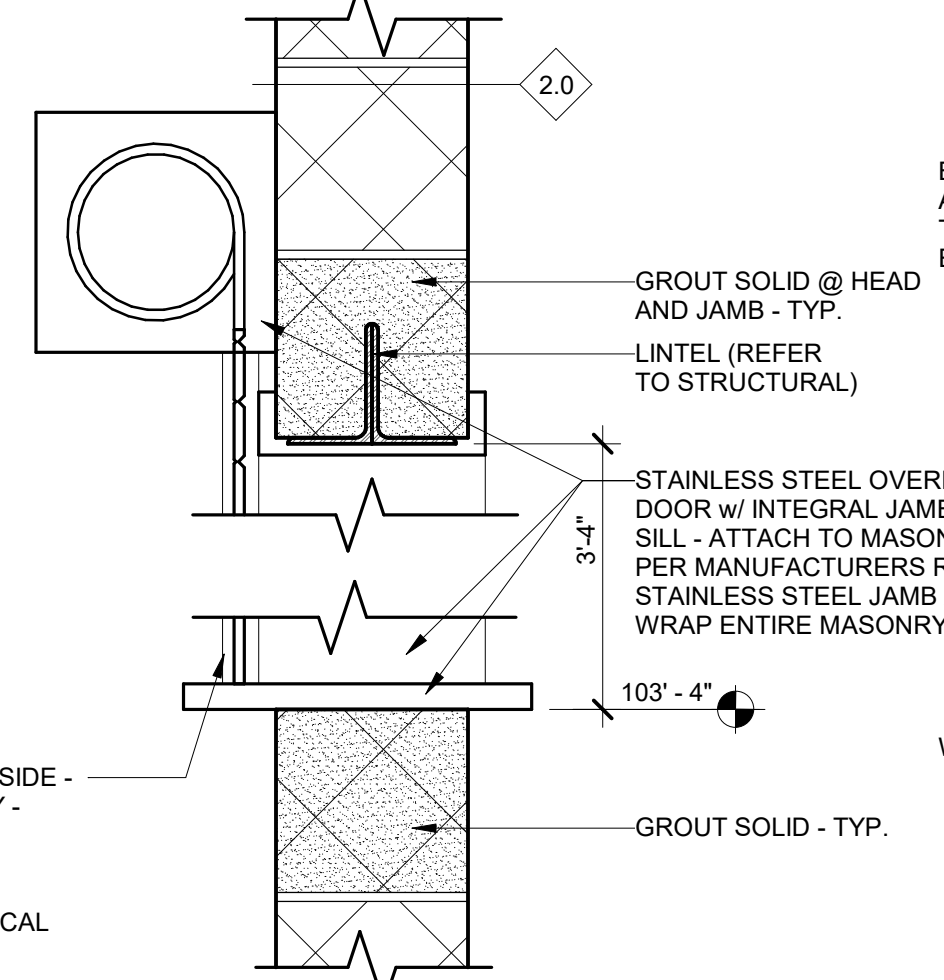


26 COILING DOOR HEAD DETAIL @ TRAY DROP OFF
SCALE: 1 1/2" = 1'-0"

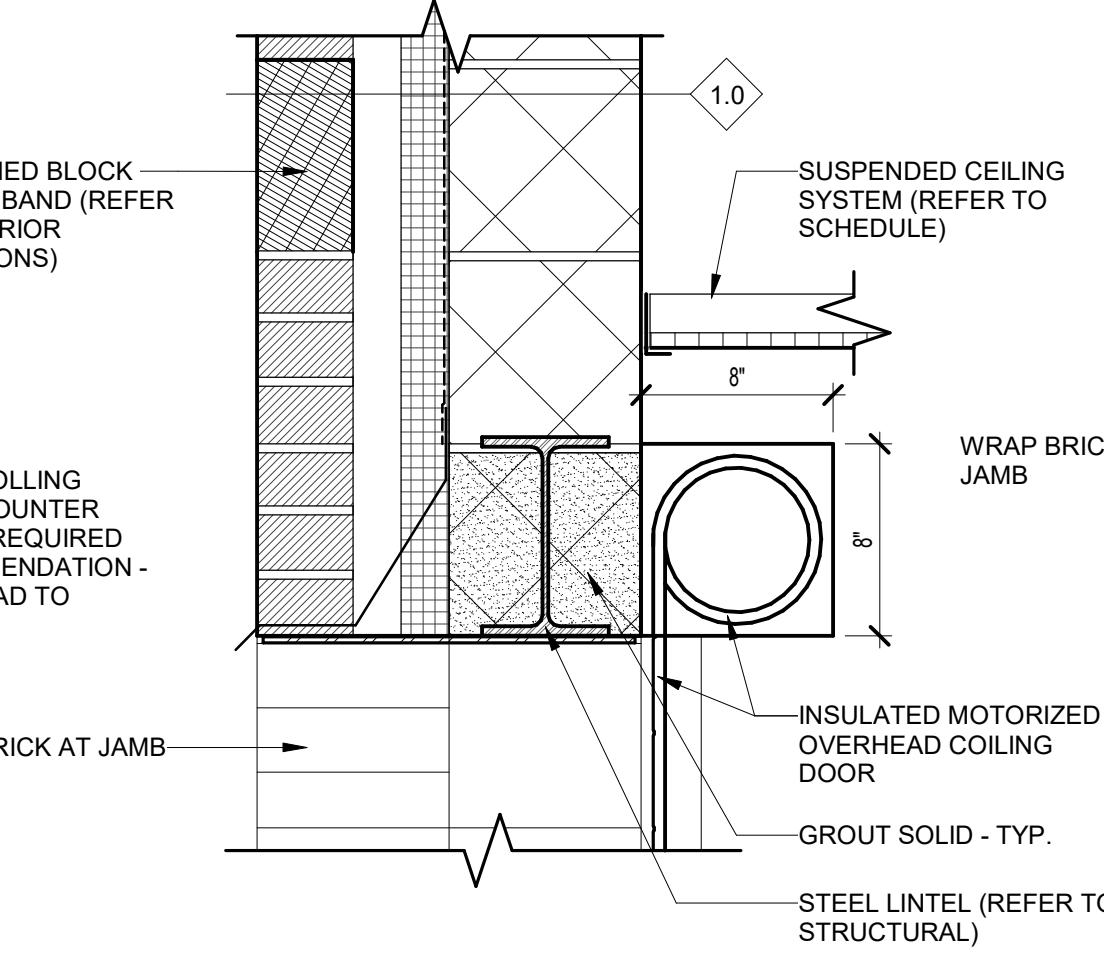


27 COILING DOOR HEAD DETAIL @ CORRIDOR (WEST CONNECTOR)
SCALE: 1 1/2" = 1'-0"

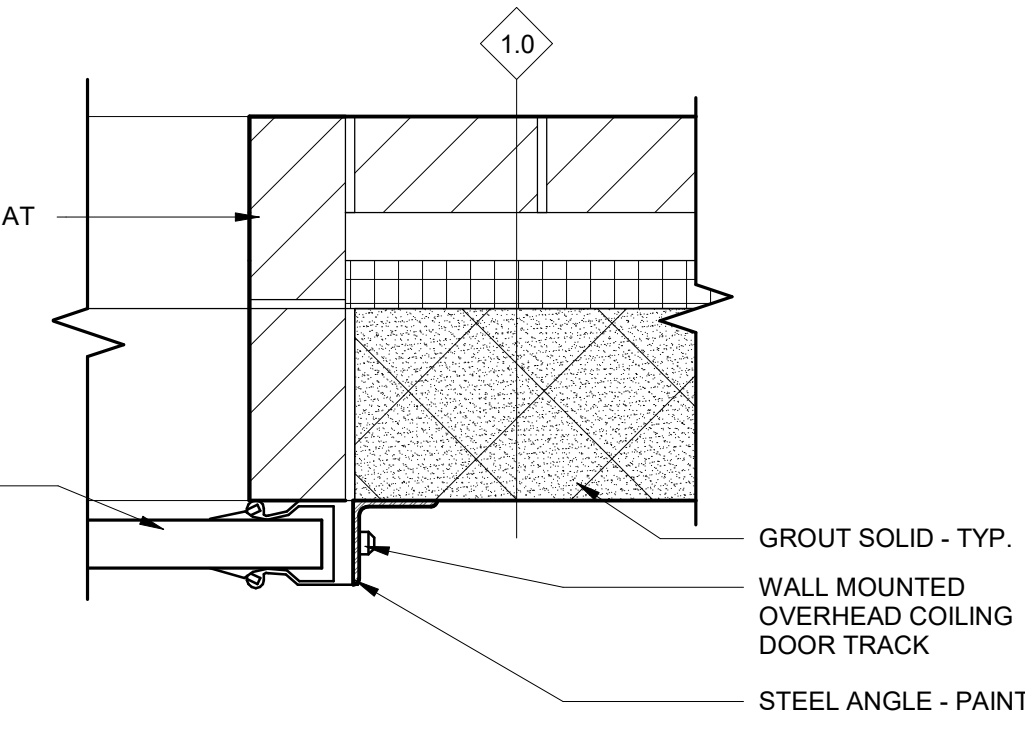

28 JAMB DETAIL @ CORRIDOR
SCALE: 1 1/2" = 1'-0"

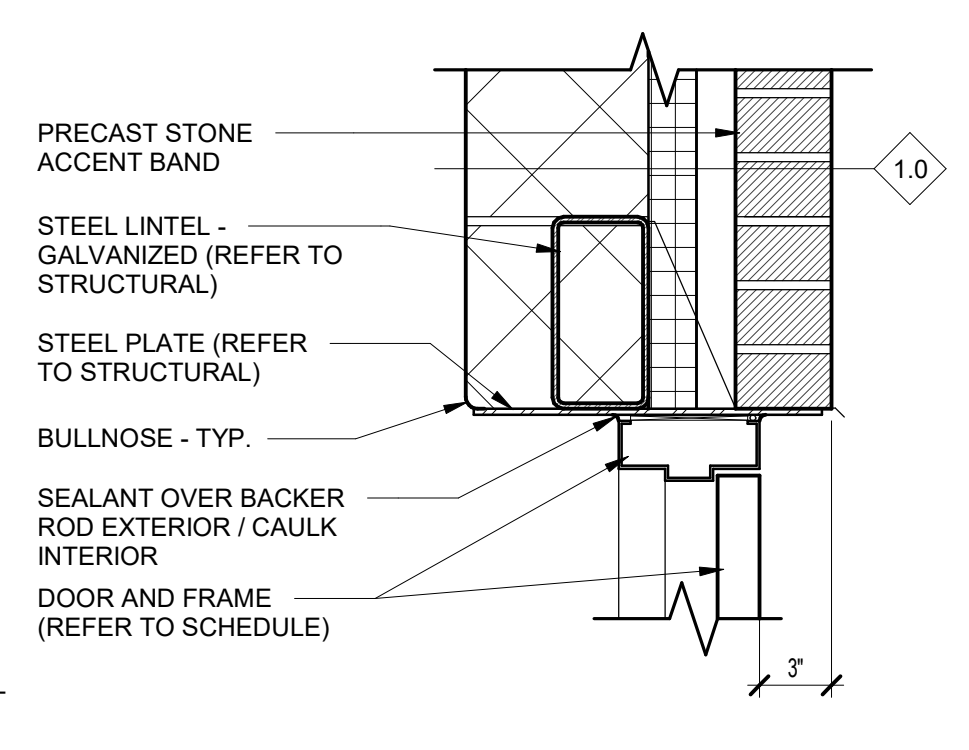

29 DOOR HEAD DETAIL
SCALE: 1 1/2" = 1'-0"

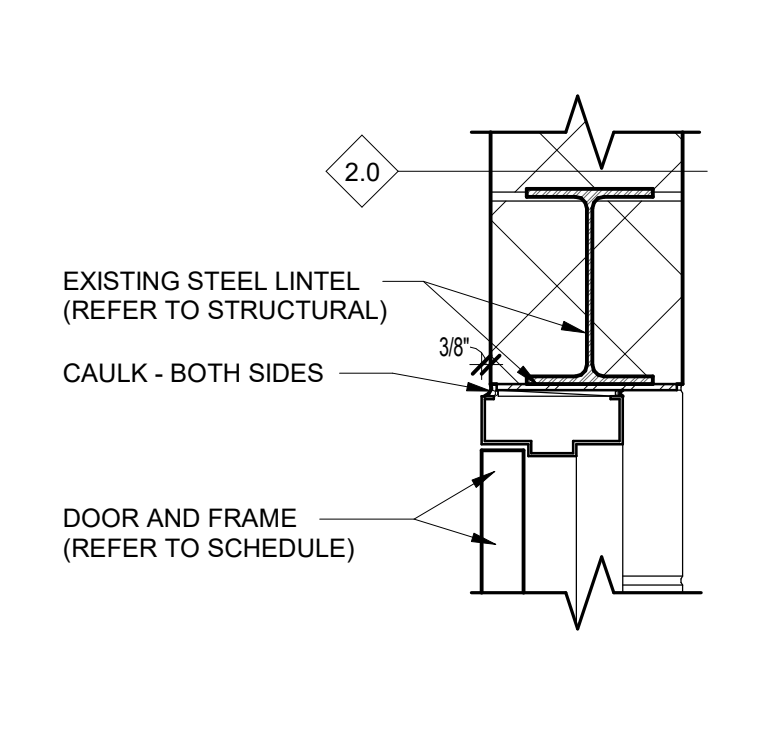


30 DOOR HEAD DETAIL
SCALE: 1 1/2" = 1'-0"

SCHEDULE GENERAL NOTES:

- FINAL LOCATIONS OF DOOR CARD READERS, DOOR INTERCOMS AND PUSH BUTTONS TO BE FIELD VERIFIED WITH OWNER.
- REFER TO SHEET A0.01 AND MATERIAL SCHEDULE (THIS SHEET) FOR ABBREVIATIONS.
- WALL TYPES ARE INDICATED w/ A DIAMOND AND A NUMBER. REFER TO SHEET A0.01 FOR DESCRIPTION OF WALL TYPES.

SCHEDULE OF REMARKS:

- PROVIDE DOOR CLOSER.
- PROVIDE HOLD OPEN w/ CLOSER TIED INTO FIRE ALARM.
- PROVIDE A CARD READER INSIDE AND OUTSIDE.
- PROVIDE A DOOR INTERCOM w/ PUSH BUTTON INSIDE AND OUTSIDE.
- REINFORCE DOOR.
- PROVIDE A DOOR INTERLOCKS INSIDE AND OUTSIDE.
- PROVIDE AN ELECTRIC LOCK.
- PROVIDE A MORTISE LOCK.
- NOT USED.
- PROVIDE A CARD READER OUTSIDE.
- PROVIDE A PUSH BAR ON INSIDE.
- PROVIDE HOLD-DOWN CLIPS FOR S.A.T. CEILING IN AREA NEAR EXTERIOR DOORS IN QUANTITY AND SPACING REQUIRED TO PREVENT MOVEMENT / UPLIFT OF CEILING TILES.
- CEILING HEIGHT VARIES (REFER TO CEILING PLAN).
- RSF FLOORING INCLUDES: Z-BAR COVE CAP, S.S. CORNER GUARDS @ COVE BASE CORNERS, AND S.S. TRANSITIONS STRIPS AT ALL FLOOR MATERIAL TRANSITIONS; BY FLRG MFR.
- PATCH AND REPAIR AT DEMOLITION POINTS.
- PROVIDE AN INTERLOCK INSIDE.
- PROVIDE AN INTERCOM w/ PUSH BUTTON INSIDE.
- DOOR LITE TO BE GL-1 (REFER TO SPECS).
- DOOR LITE TO BE GL-2 (REFER TO SPECS).
- DOOR LITE TO BE GL-3 (REFER TO SPECS).
- DOOR LITE TO BE GL-4 (REFER TO SPECS).

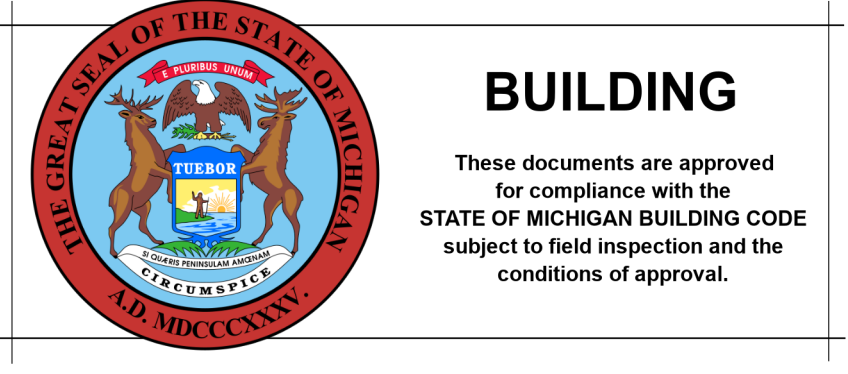

NO.	REVISION	DATE

STATE OF MICHIGAN
DEPARTMENT OF TECHNOLOGY, MANAGEMENT AND BUDGET
FACILITIES AND BUSINESS SERVICES ADMINISTRATION
DESIGN AND CONSTRUCTION DIVISION
ADAM LACR, R.A. DIRECTOR

FILE NO.
491/20167.SDW

FUNDING CODE
171CODHHS7255

CONTRACT NO.
Y22003

WTAARCH.COM

WTA ARCHITECTS

100 S. Jefferson Ave., Suite 601
Saginaw, Michigan 48607
989.752.8107

COPYRIGHT © 2023

PROJECT TITLE
491/20167.SDW - PHASE 500:
**CENTER FOR FORENSIC
PSYCHIATRY - CREATE
KITCHEN**
SALINE, MICHIGAN


SHEET TITLE
**ROOM FINISH & DOOR
SCHEDULES, DOOR & DW
TYPES, AND DOOR DTLs**

PROJECT NUMBER
2021094


PROJECT DATE
SEPTEMBER 6, 2023

CHECKED BY
C.D.S.


SHEET NUMBER
A3.01

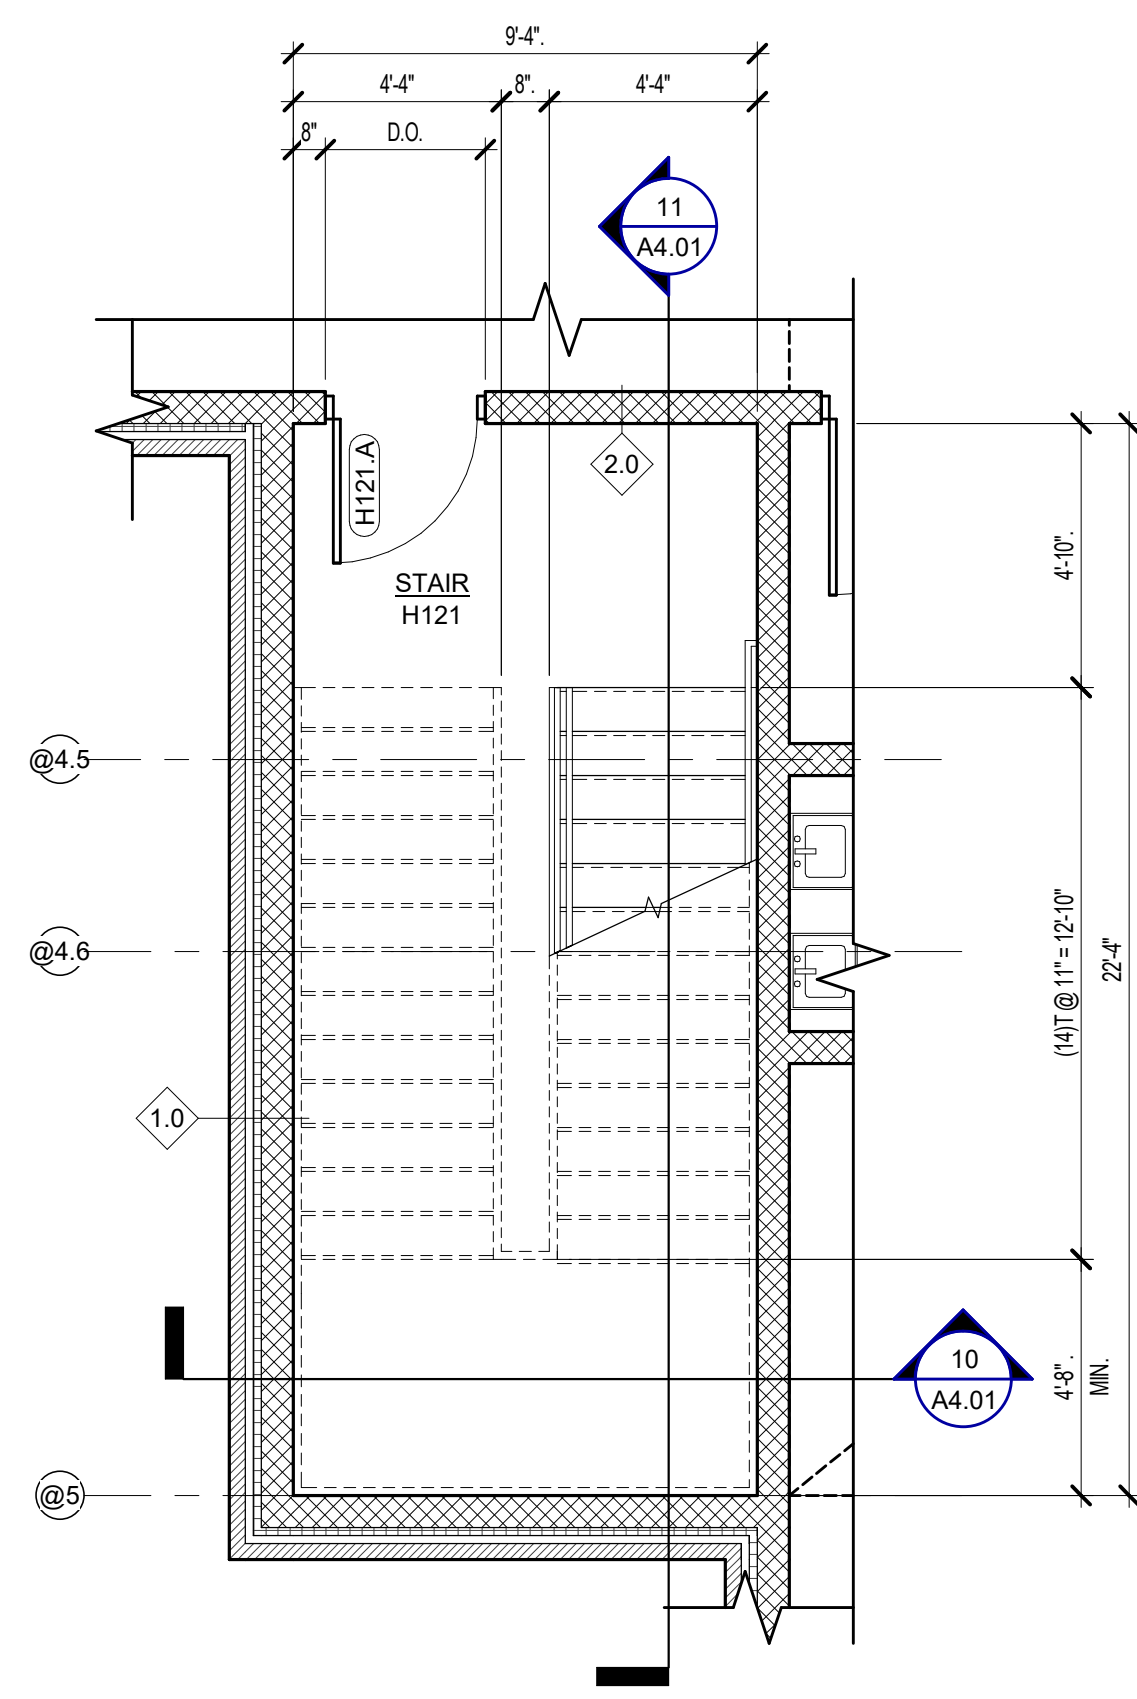


7 FIRST FLOOR STAIR PLAN
SCALE: 1/4" = 1'-0"

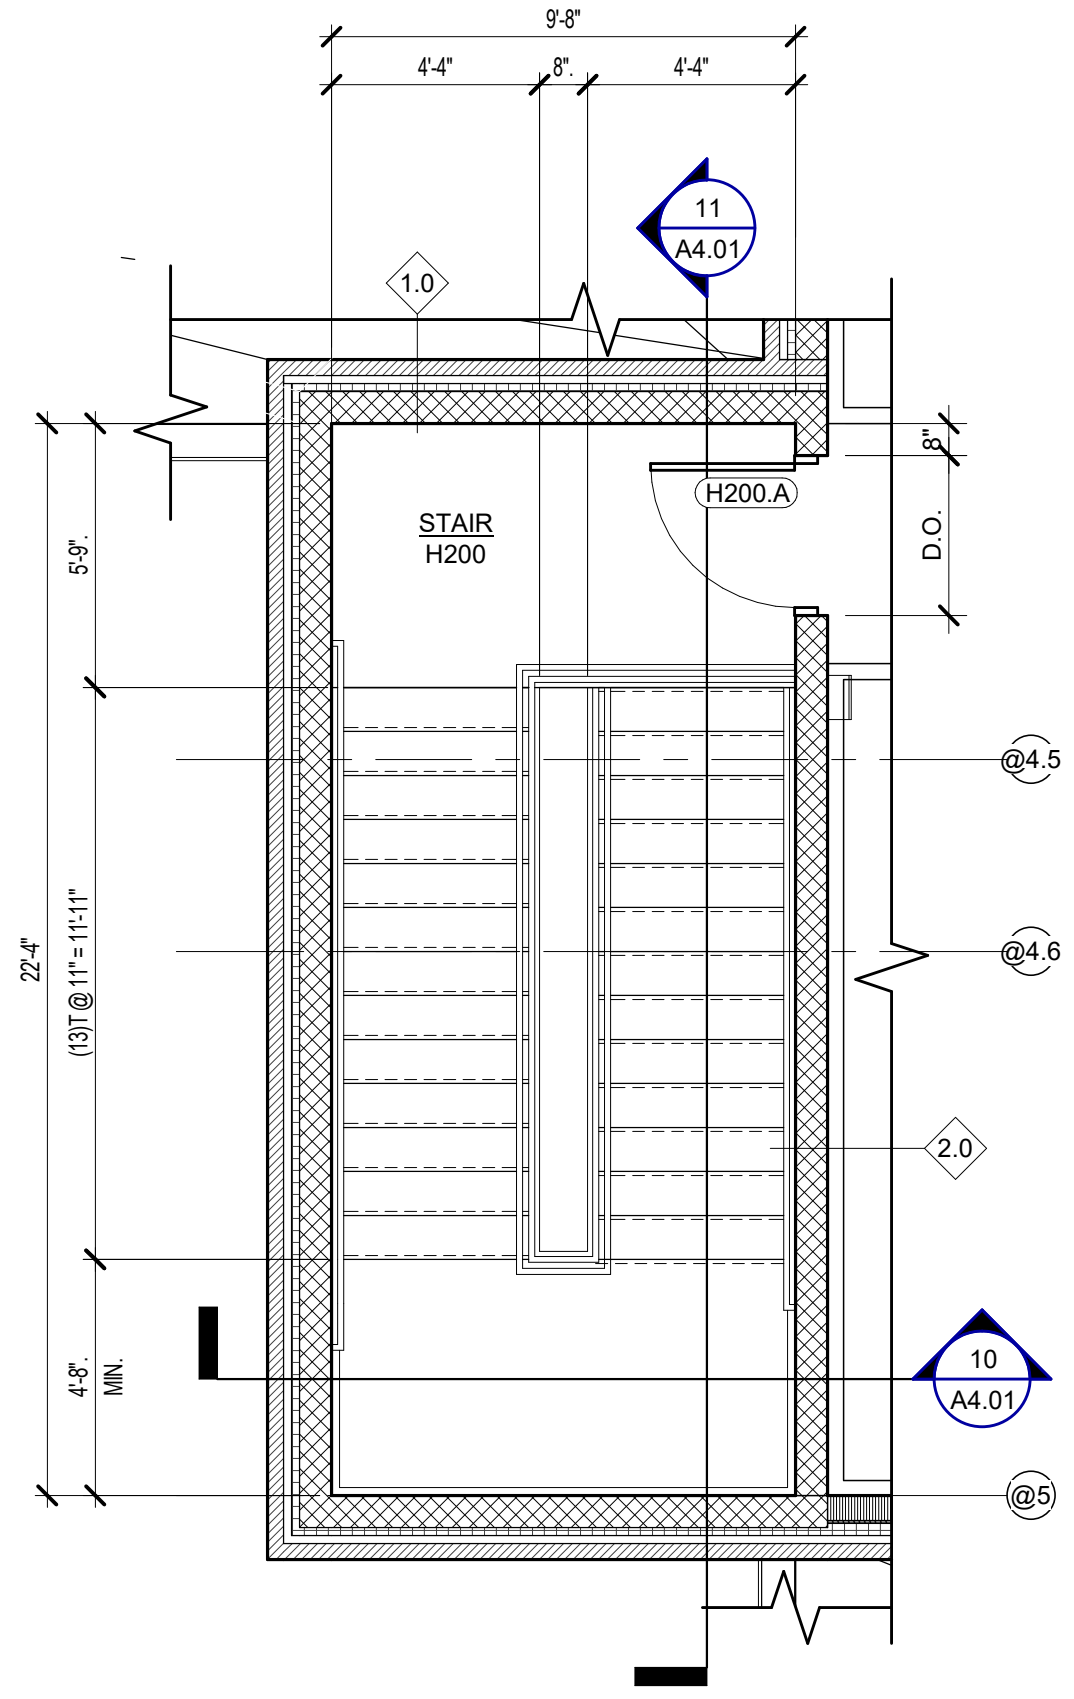


9 SECOND FLOOR STAIR PLAN
SCALE: 1/4" = 1'-0"

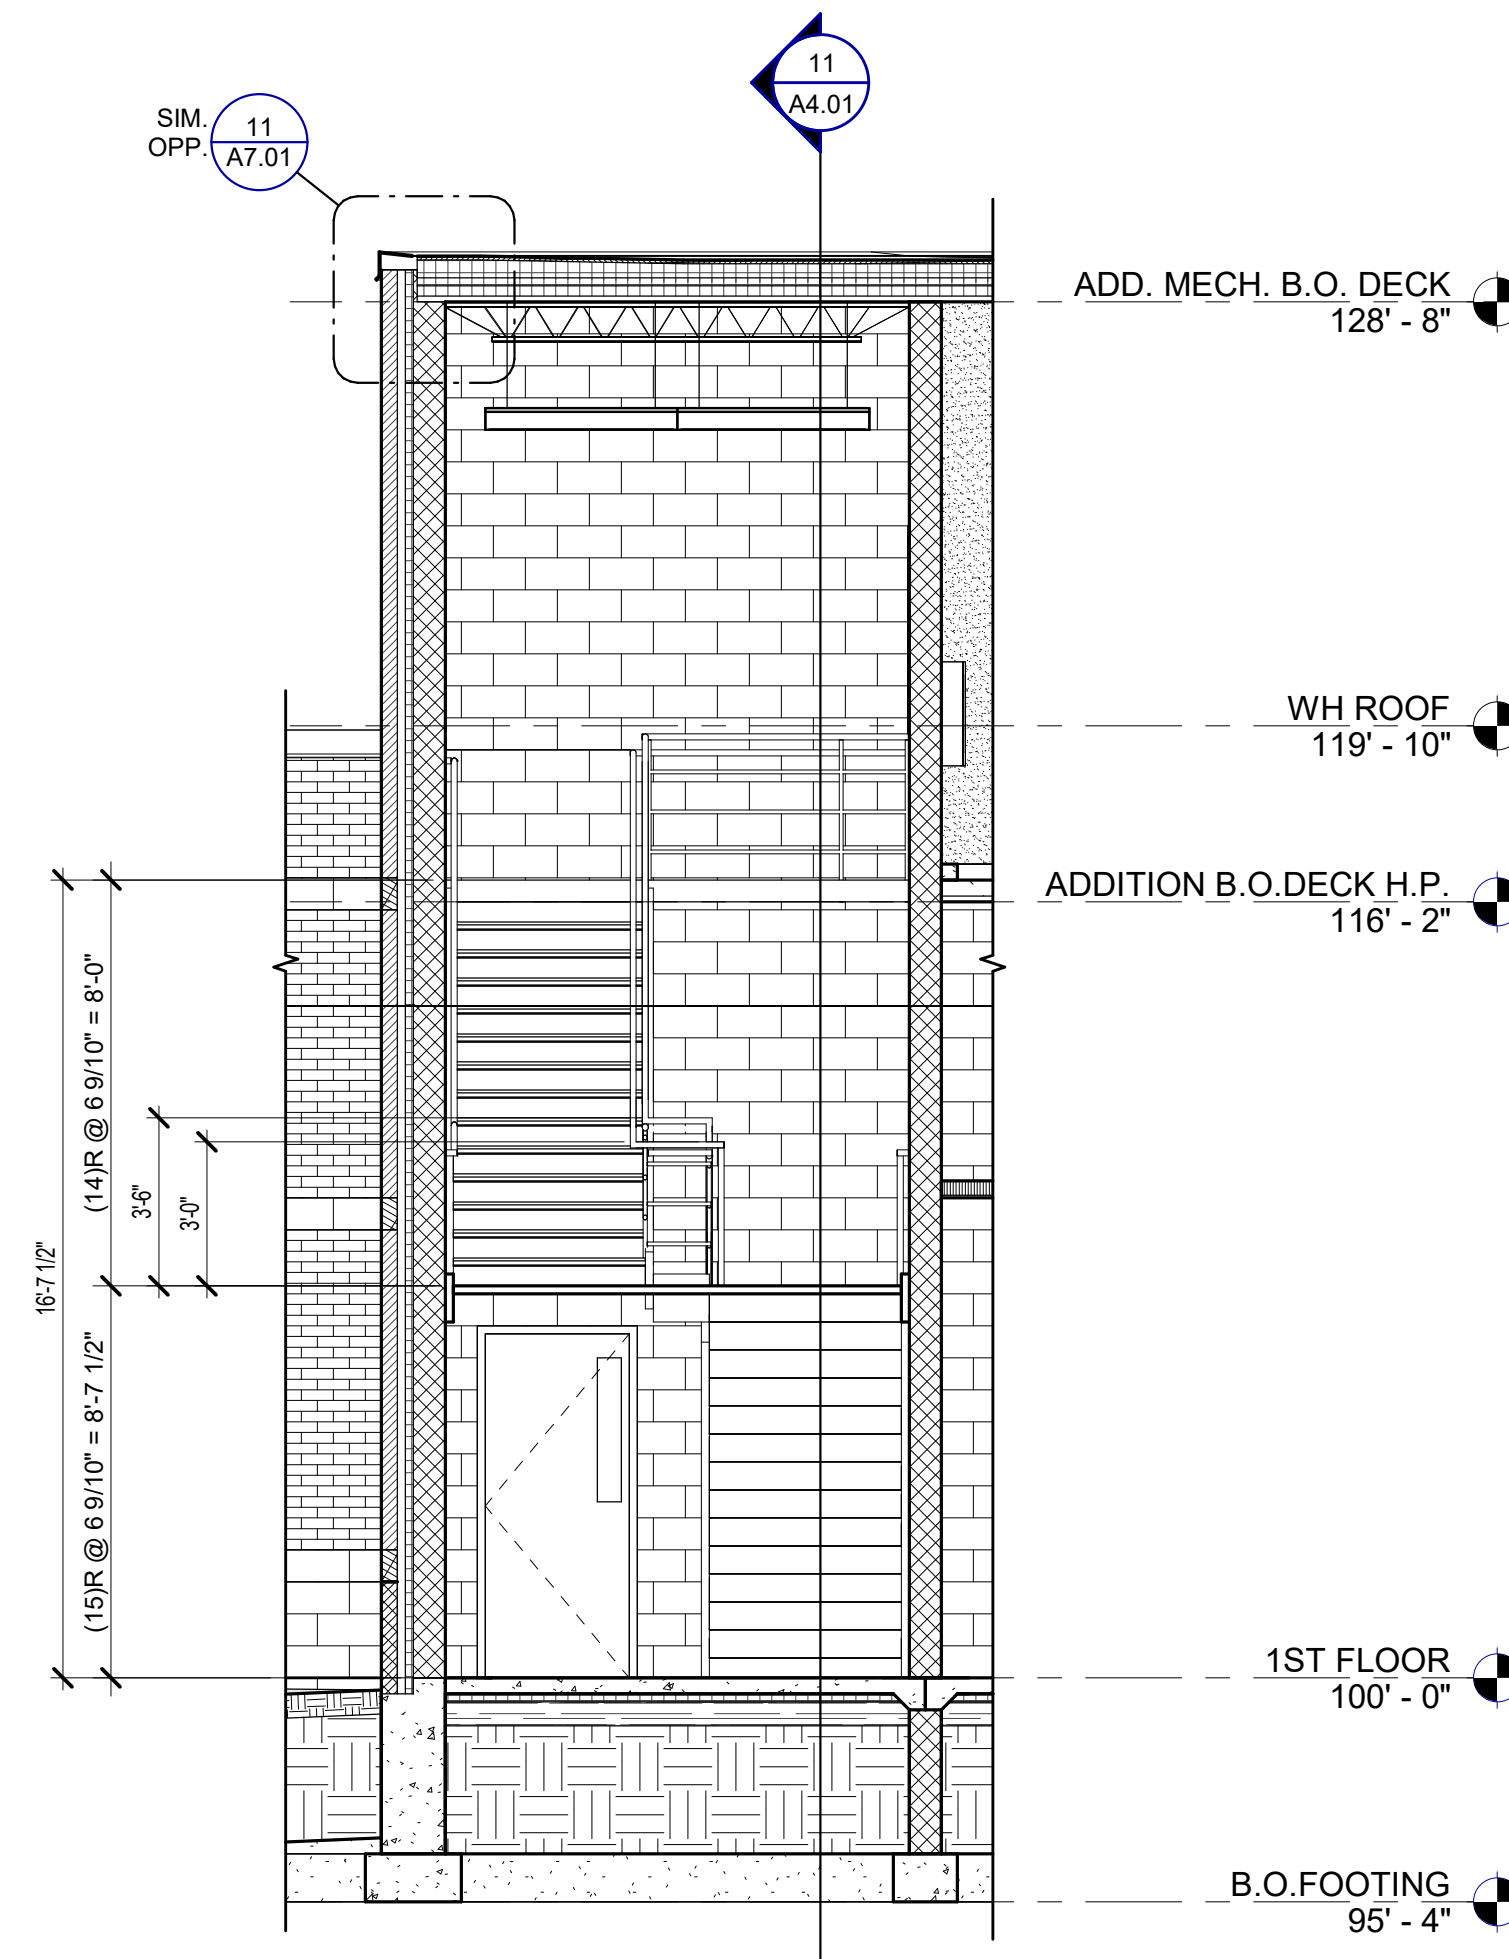


10 STAIR SECTION
SCALE: 1/4" = 1'-0"

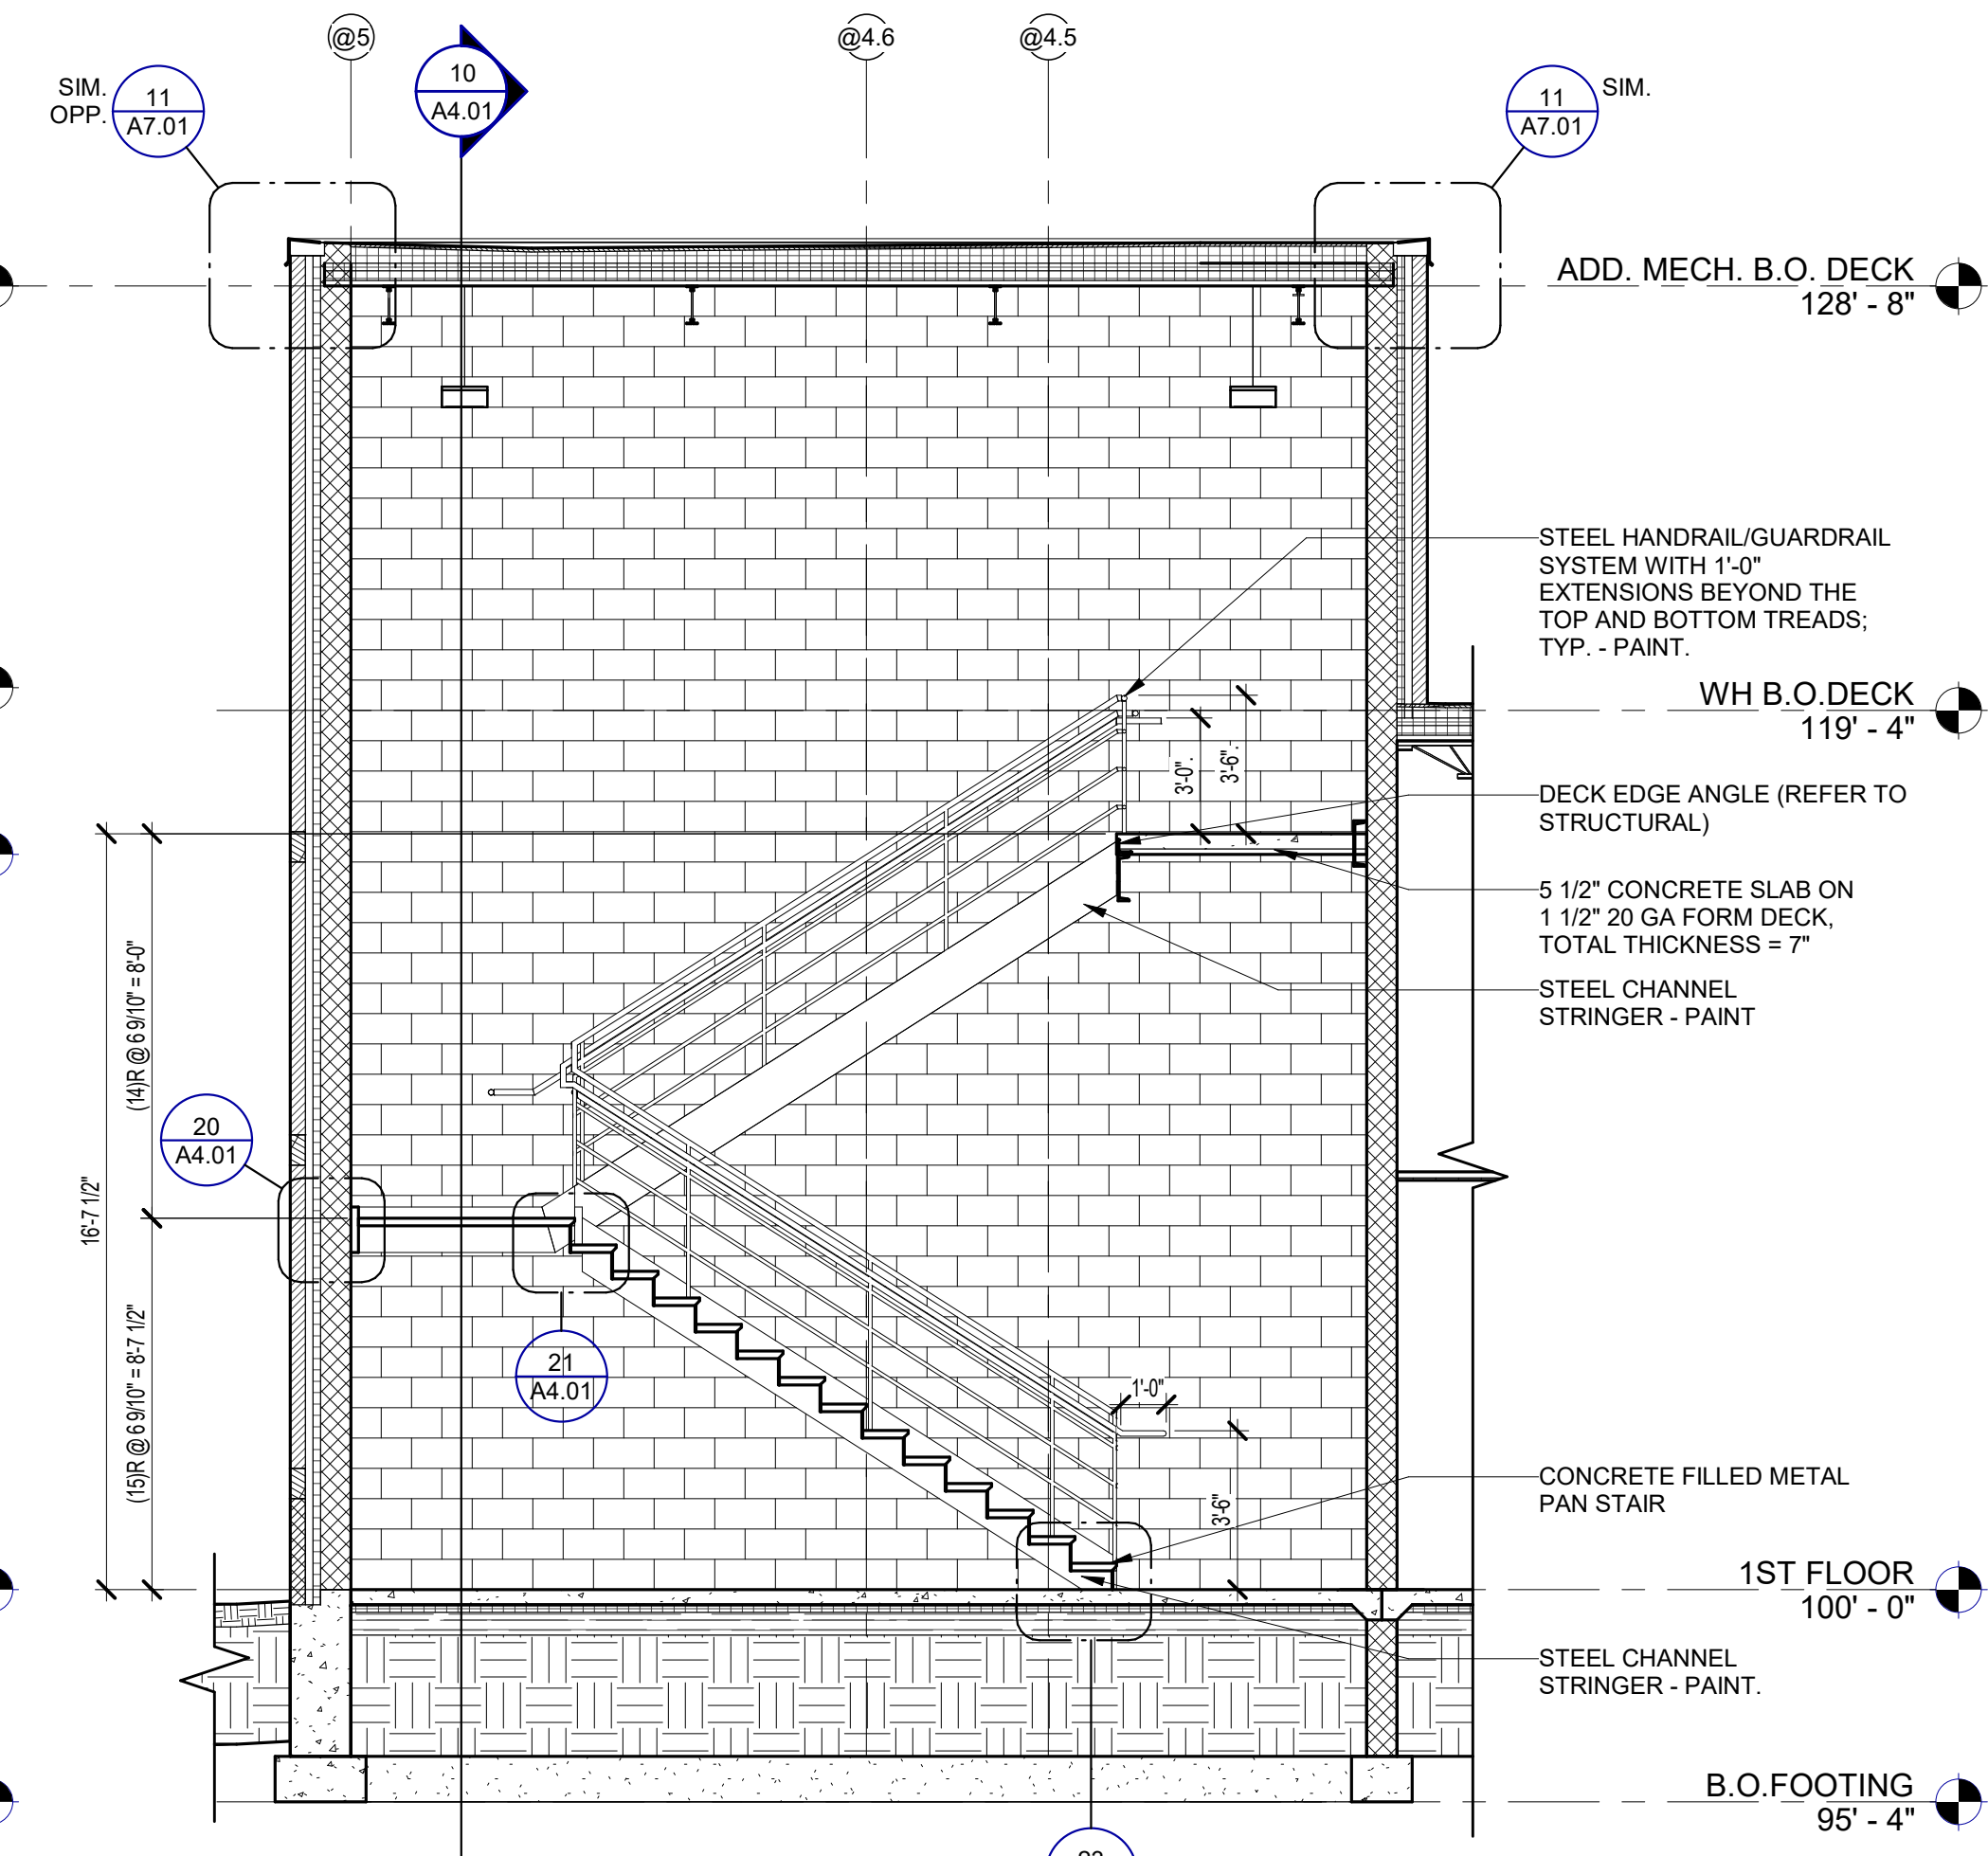


11 STAIR SECTION
SCALE: 1/4" = 1'-0"

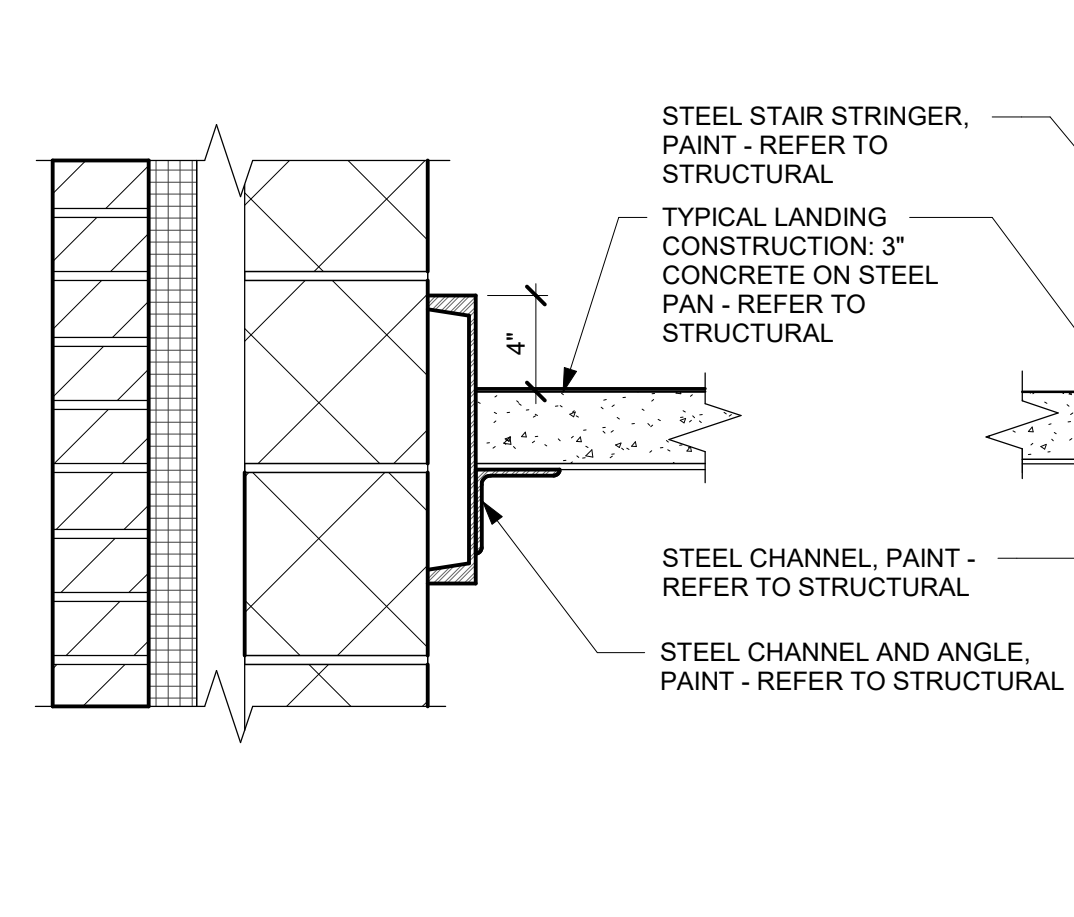

20 STAIR DETAIL
SCALE: 1 1/2" = 1'-0"

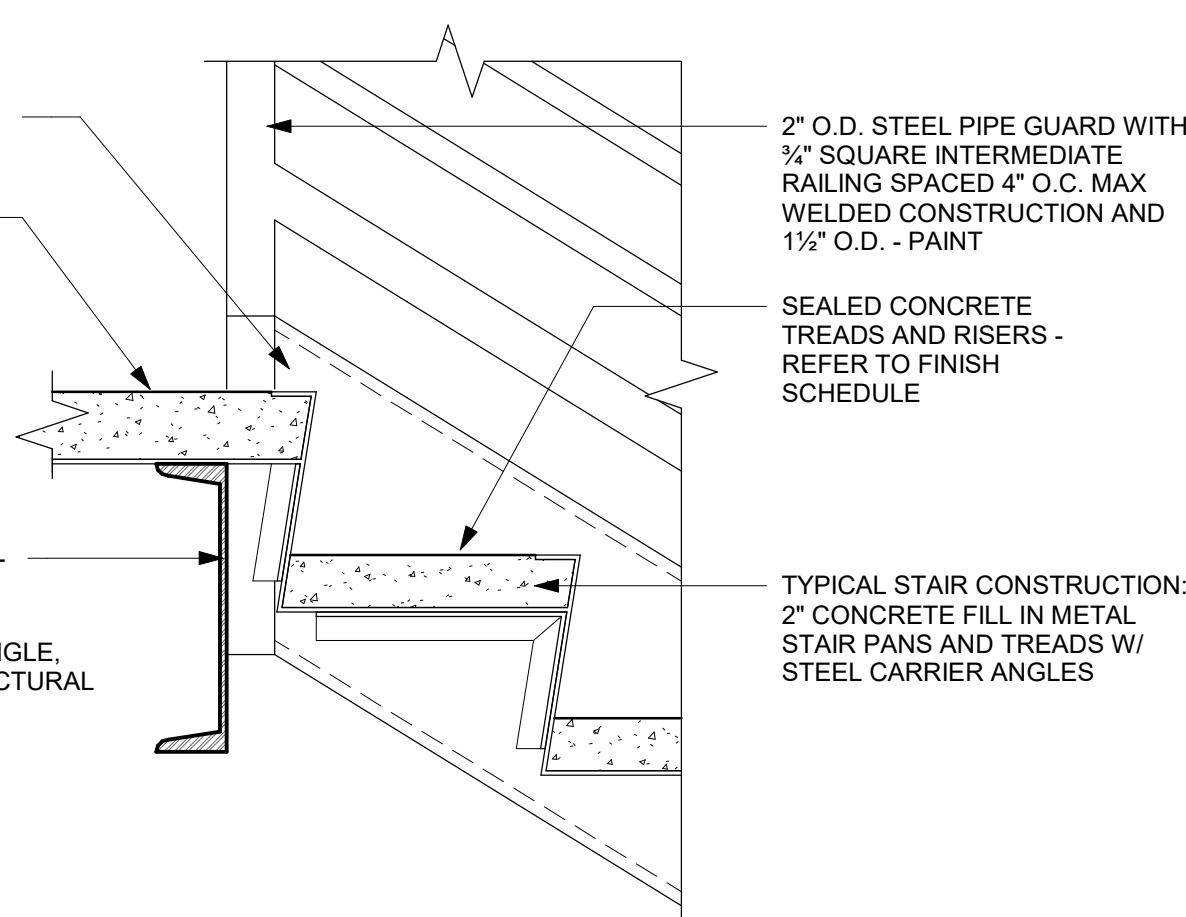

21 STAIR DETAIL
SCALE: 1 1/2" = 1'-0"

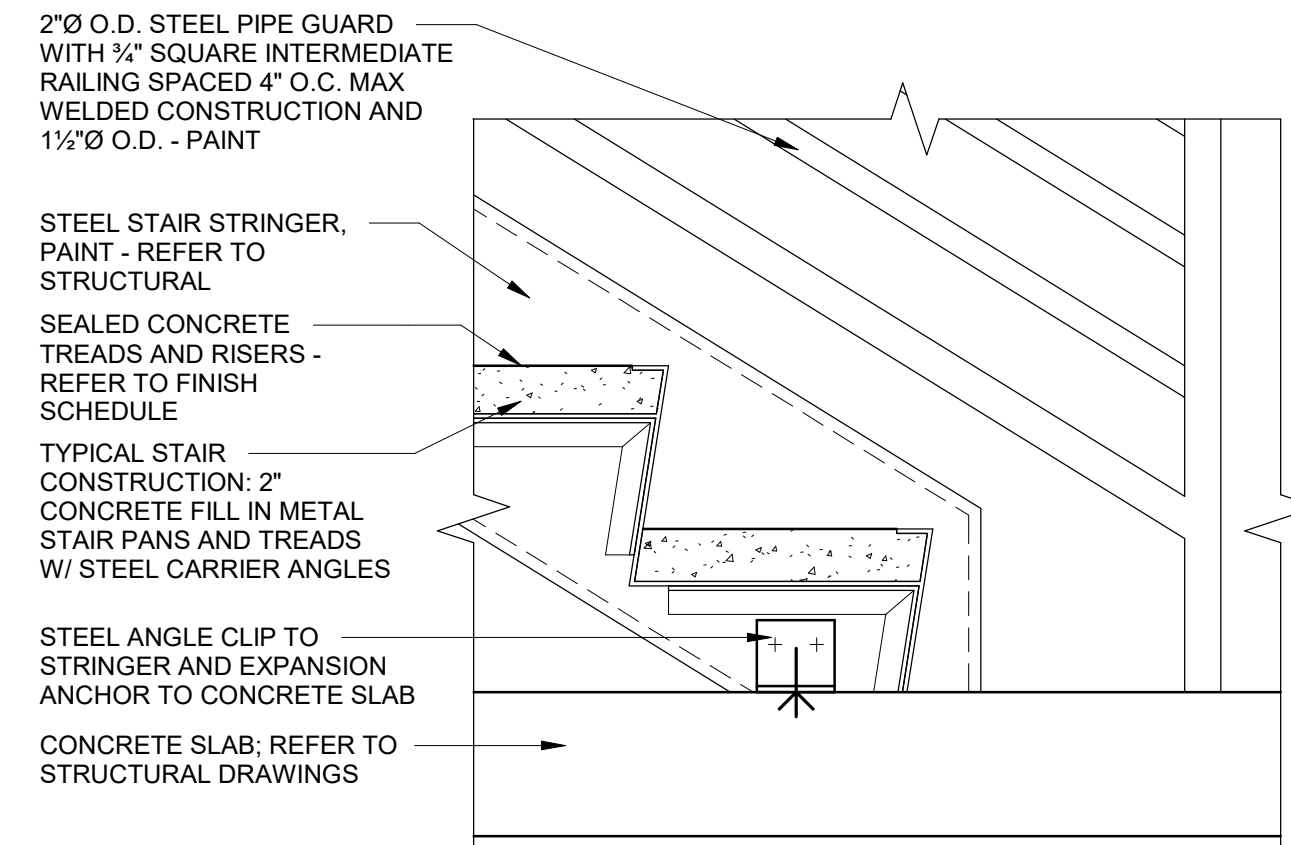

23 STAIR DETAIL
SCALE: 1 1/2" = 1'-0"

NO.	REVISION	DATE

STATE OF MICHIGAN
DEPARTMENT OF TECHNOLOGY, MANAGEMENT AND BUDGET
FACILITIES AND BUSINESS SERVICES ADMINISTRATION
DESIGN AND CONSTRUCTION DIVISION
ADAM LACH, R.A. DIRECTOR

FILE NO.
491/20167.SDW

FUNDING CODE
171CODHHS7255

CONTRACT NO.
Y22003

WTAARCH.COM

WTA ARCHITECTS

100 S Jefferson Ave, Suite 601
Saginaw, Michigan 48607
989 752 8107

COPYRIGHT © 2023

PROJECT TITLE
491/20167.SDW - PHASE 500:

**CENTER FOR FORENSIC
PSYCHIATRY - CREATE
KITCHEN**

SALINE, MICHIGAN


SHEET TITLE
VERTICAL CIRCULATION


PROJECT NUMBER
2021094

SHEET NUMBER
A4.01


PROJECT DATE
SEPTEMBER 6, 2023

CHECKED BY
C.D.S.

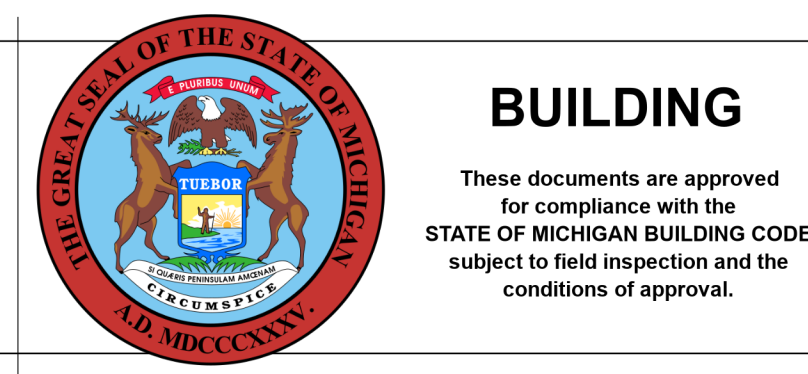


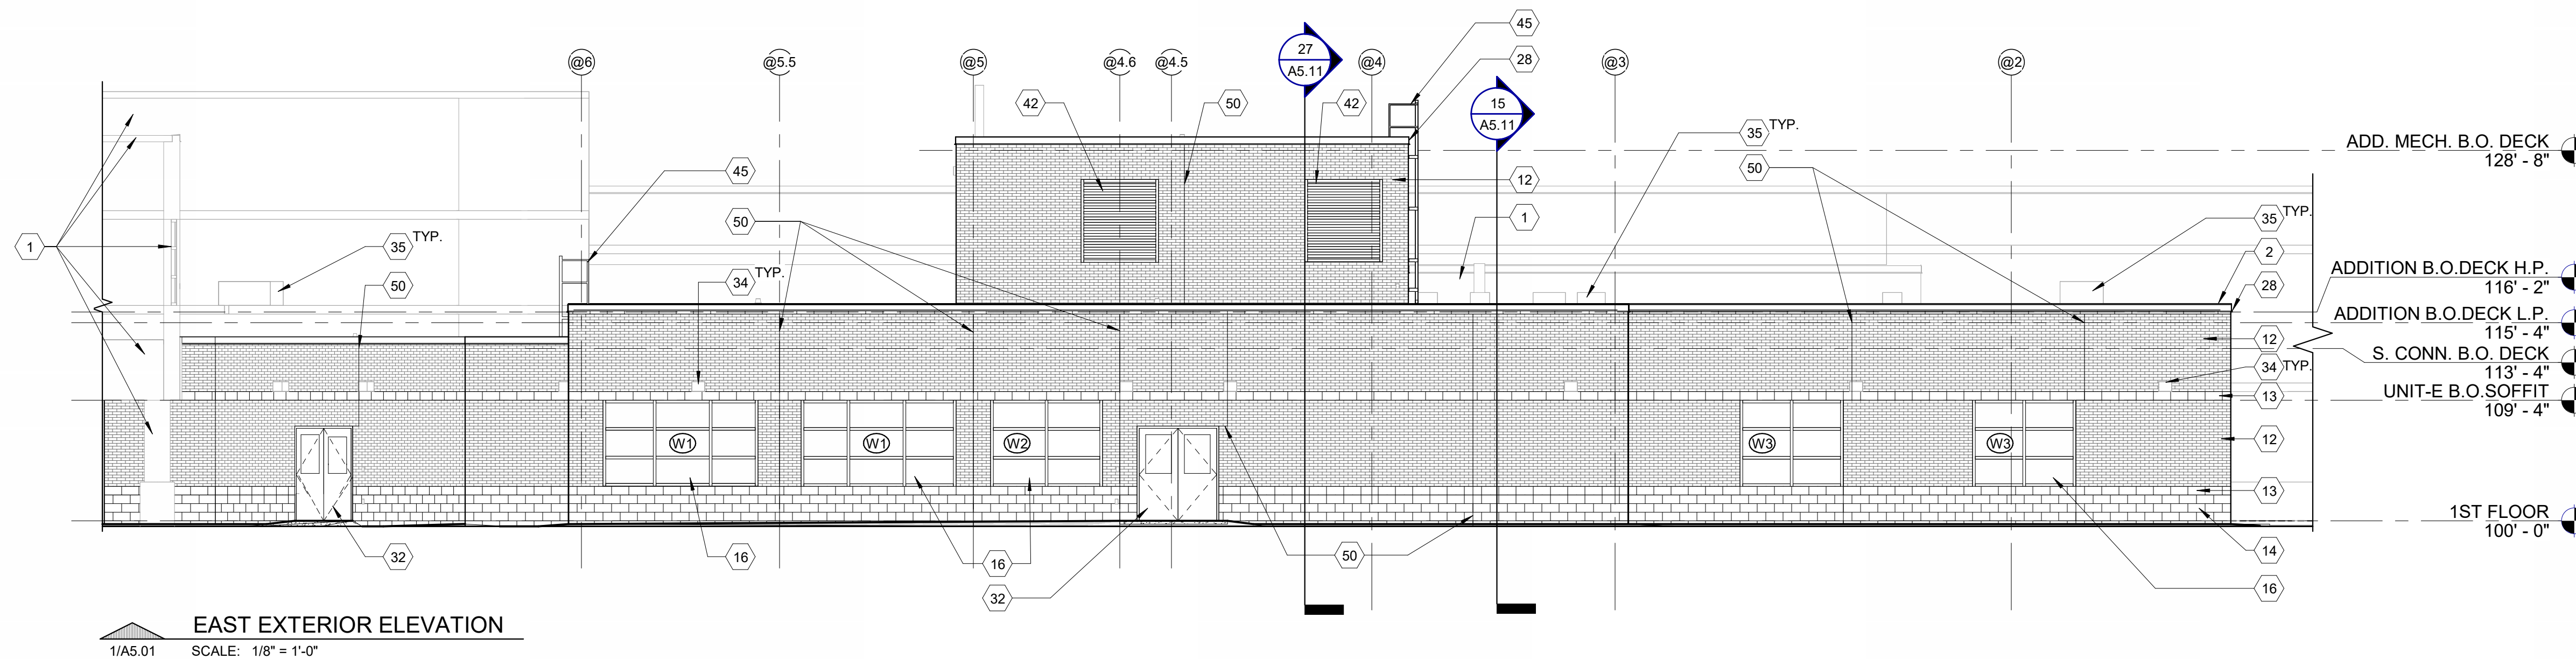


EAST EXTERIOR ELEVATION
1/A5.01 SCALE: 1/8" = 1'-0"

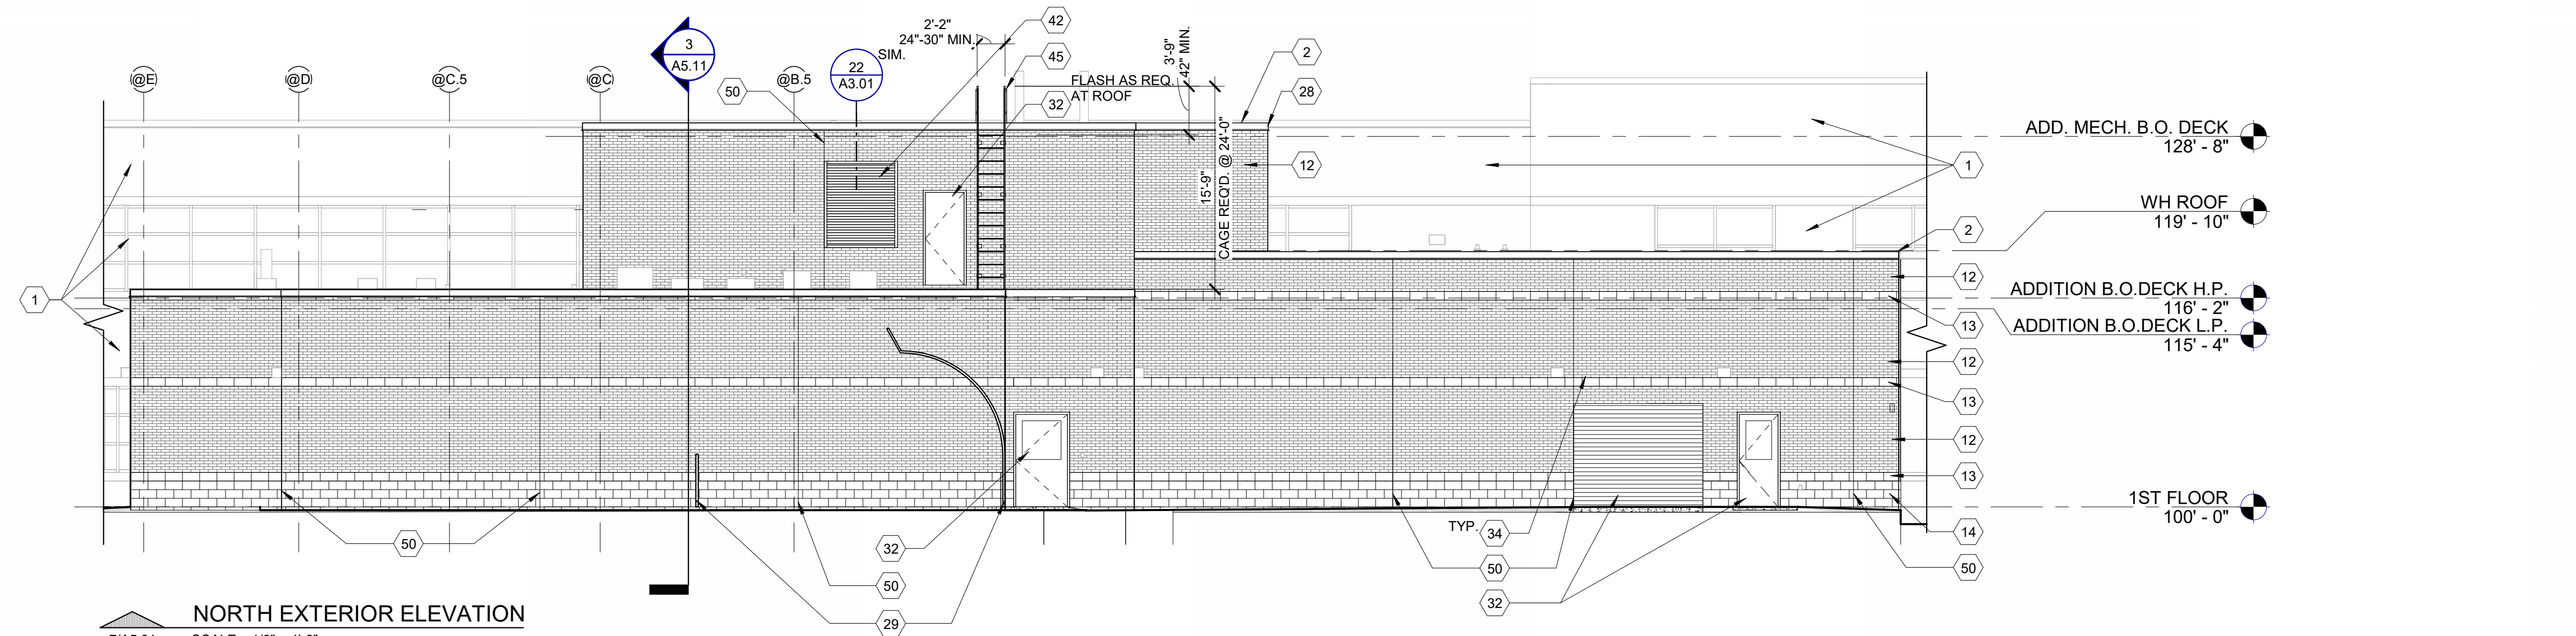


NORTH EXTERIOR ELEVATION
7/A5.01 SCALE: 1/8" = 1'-0"

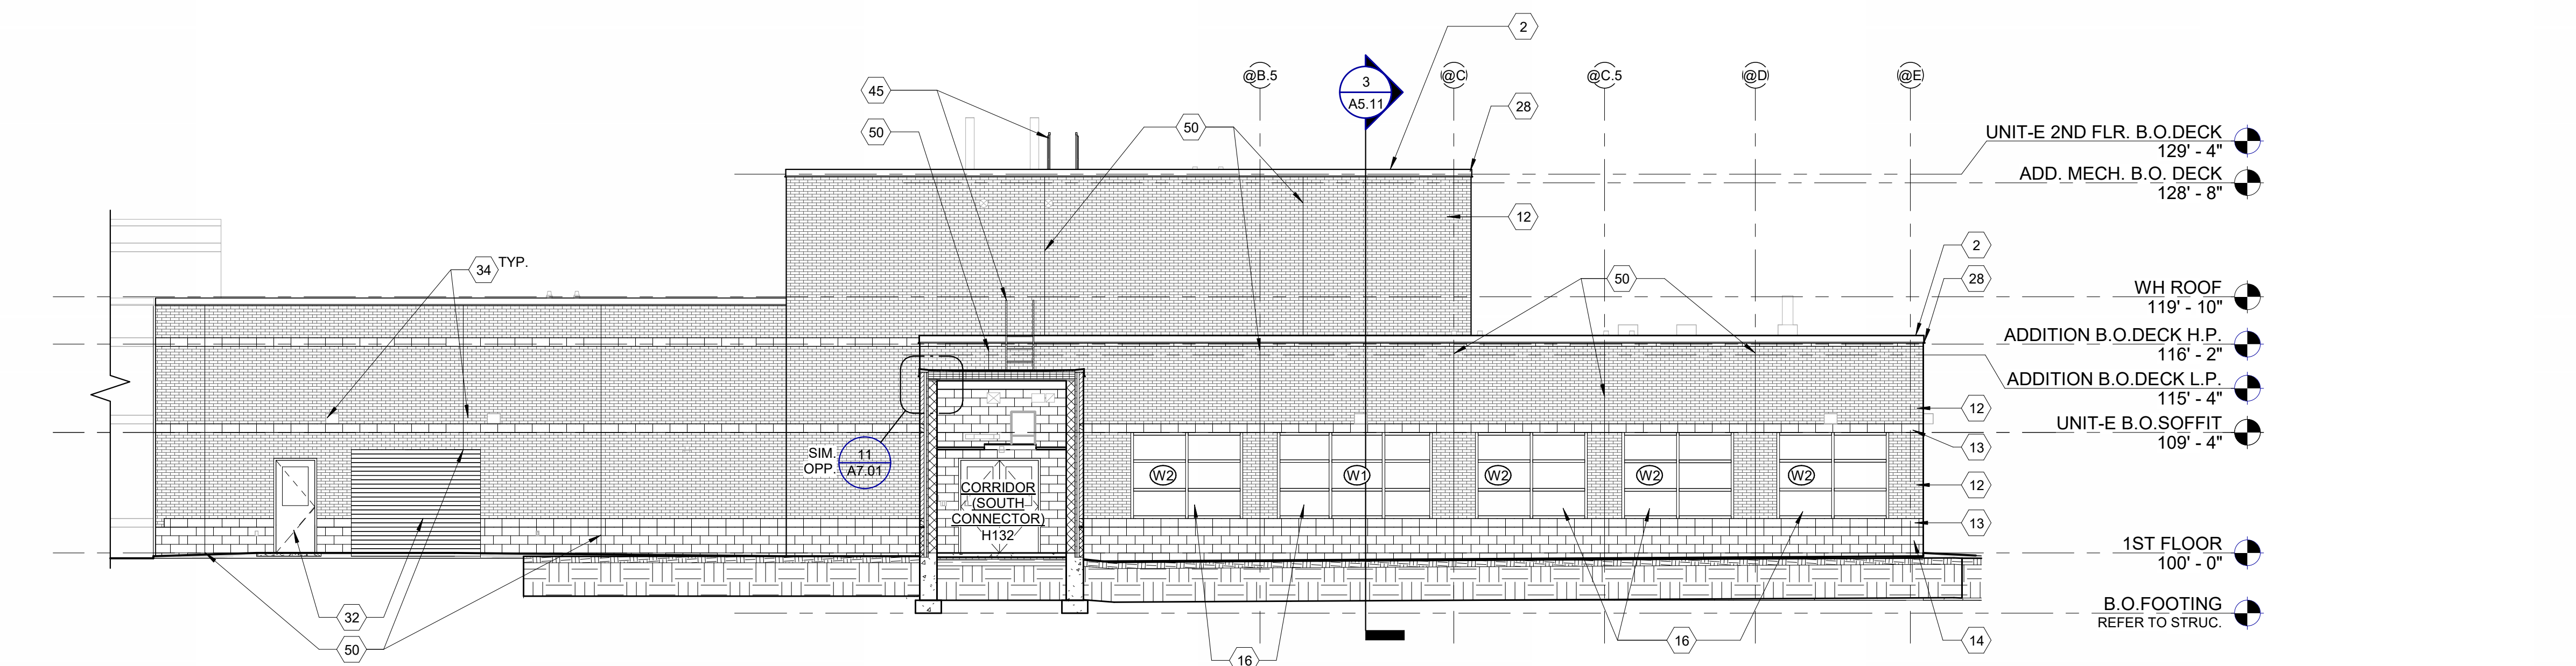


SOUTH EXTERIOR ELEVATION
19/A5.01 SCALE: 1/8" = 1'-0"

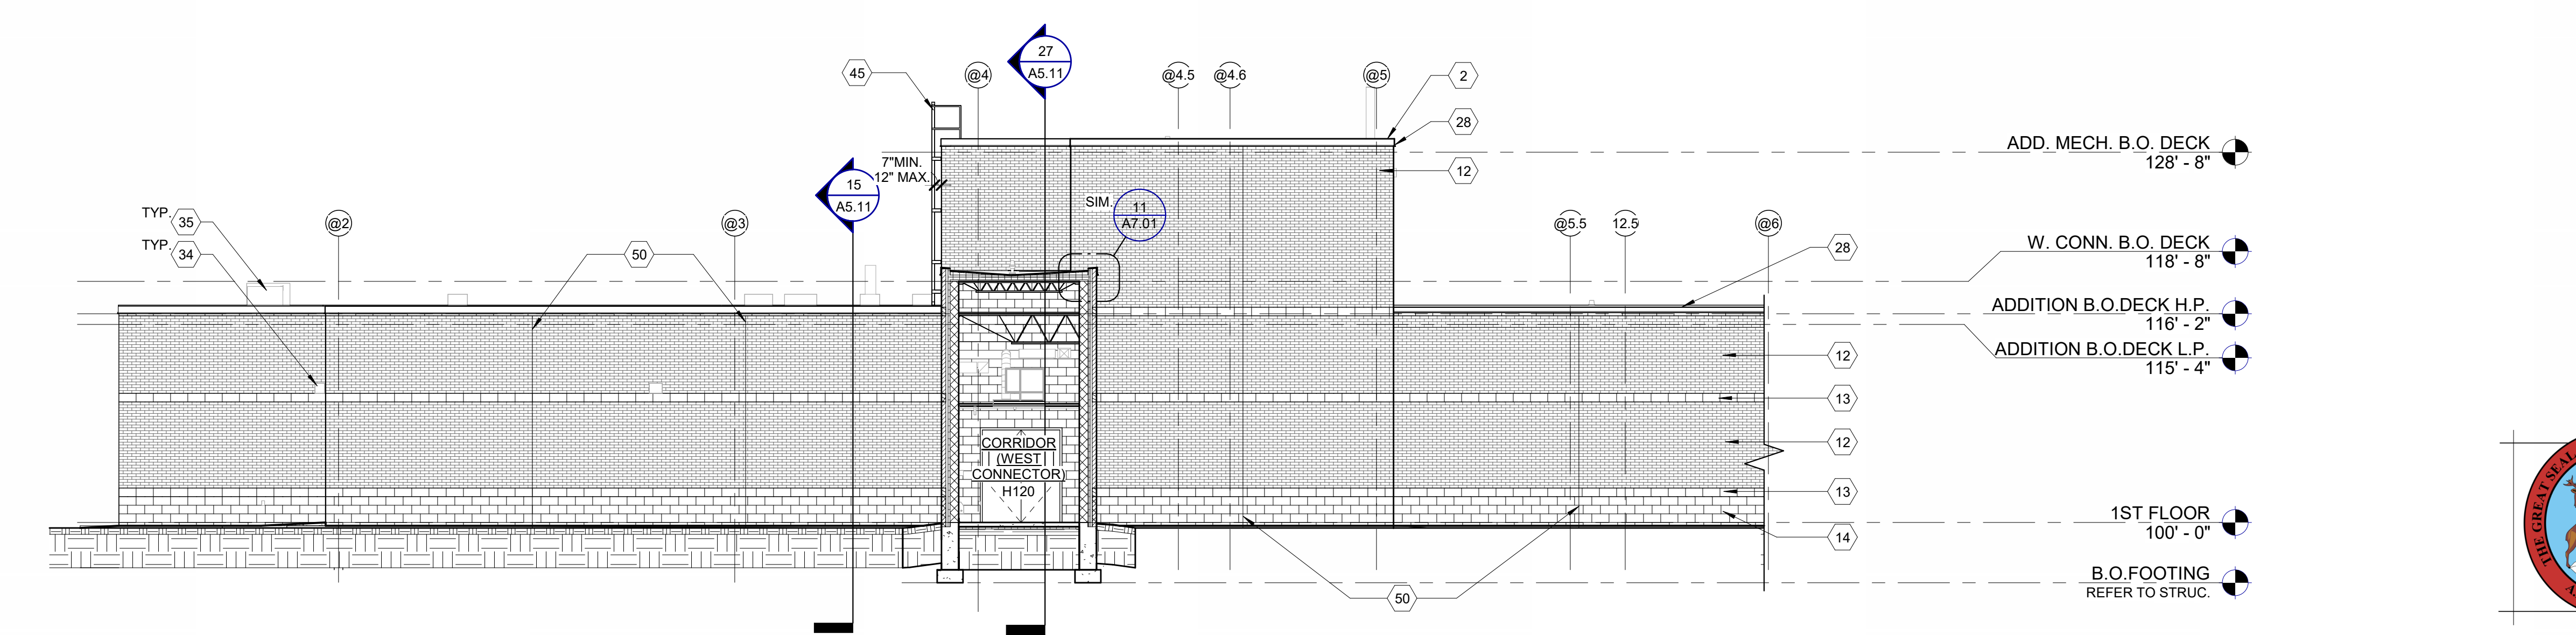

WEST EXTERIOR ELEVATION
25/A5.01 SCALE: 1/8" = 1'-0"

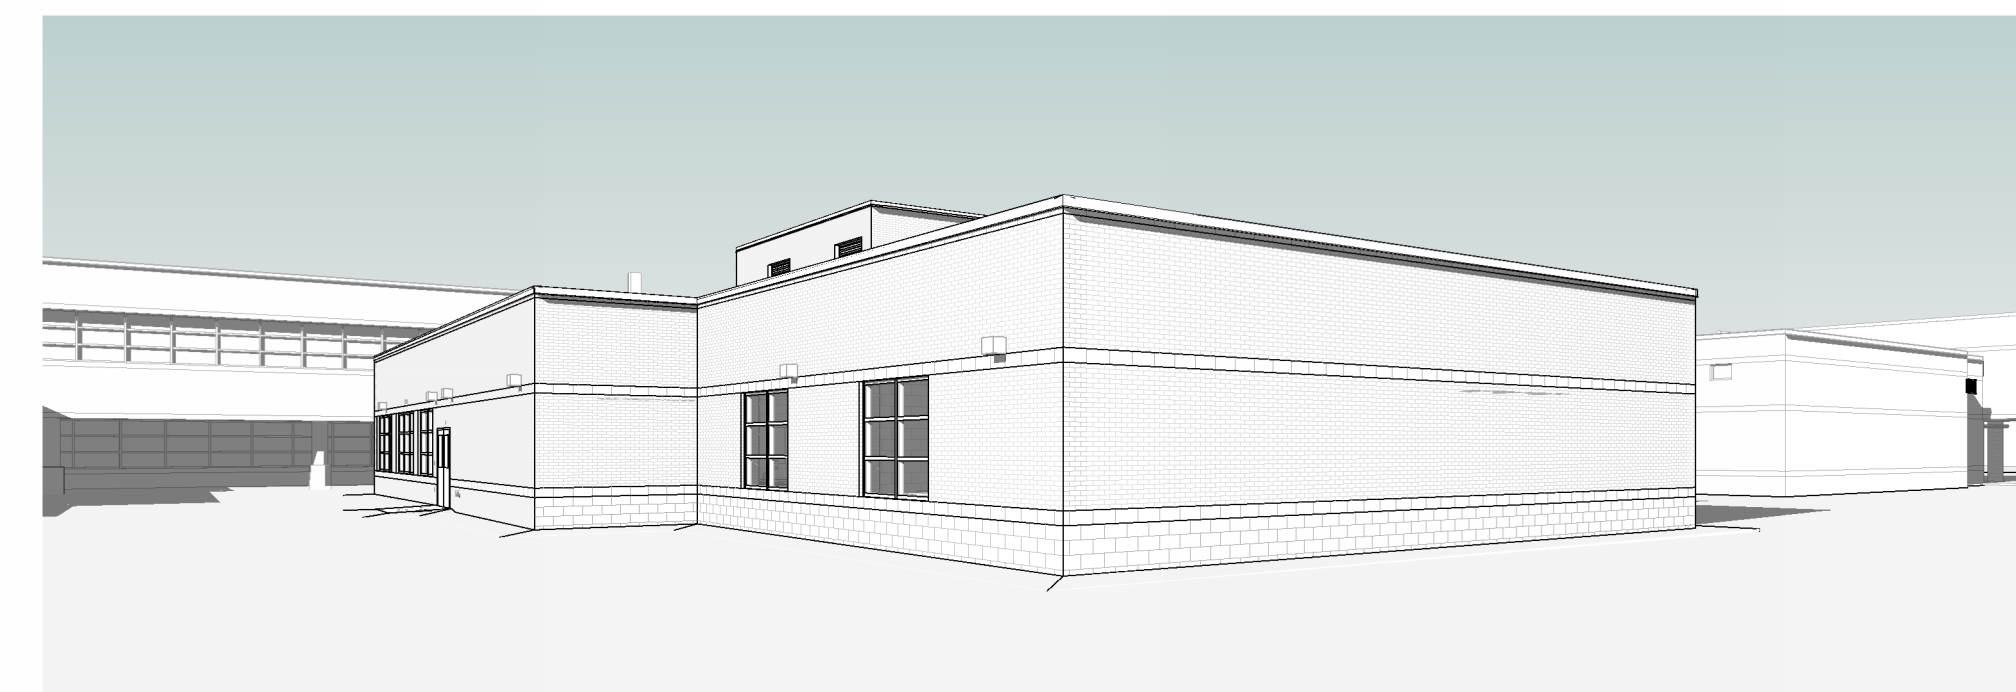

PERSPECTIVE VIEW - NORTHEAST ELEVATION

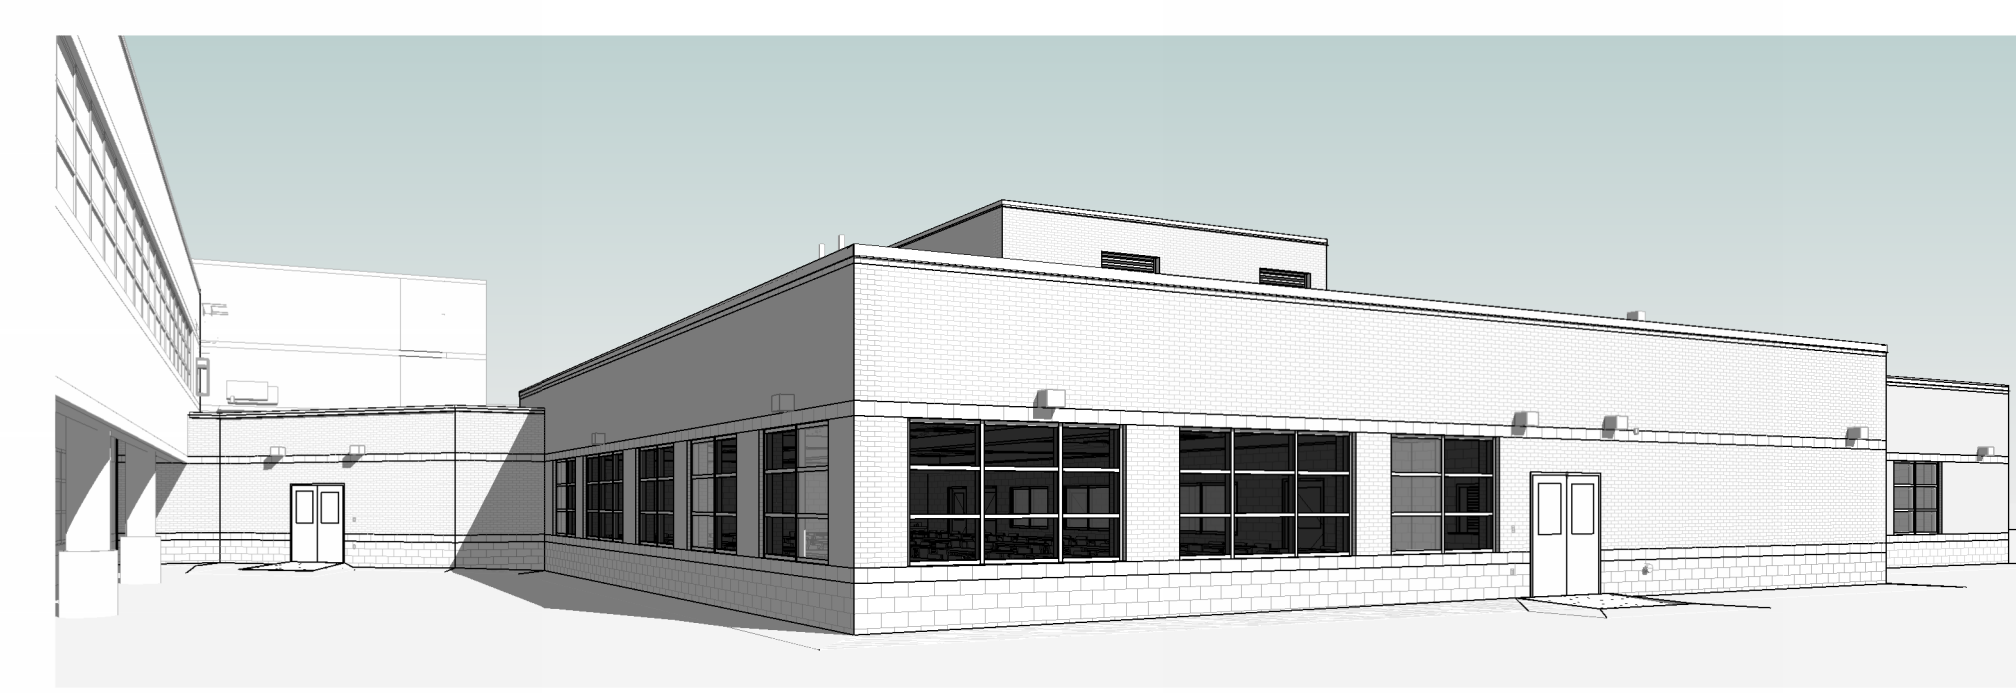

PERSPECTIVE VIEW - SOUTHEAST VIEW


MATERIAL KEYNOTES

- 1 EXISTING TO REMAIN
- 2 FULLY ADHEARED SINGLE PLY MEMBRANE ROOFING
- 3 3/4" ROOFING BOARD
- 4 RIDGID ROOF INSULATION R-30
- 5 METAL DECK (REFER TO STRUCTURAL)
- 6 2x PRESSURE TREATED WOOD BLOCKING
- 7 SPRAY INSULATION IN METAL DECK FLUTES TO ALLOW FOR CONTINUOUS INSULATION
- 8 STEEL LINTEL - EXTERIOR STEEL LINTELS TO BE GALVANIZED - PAINT (REFER TO STRUCTURAL)
- 9 GROUT SOLID
- 10 THRU WALL FLASHING
- 11 MORTAR NET
- 12 FACE BRICK - MATCH EXISTING
- 13 8x24 BURNISHED BLOCK ACCENT BAND - MATCH EXISTING
- 14 8x24 SPLIT FACE BLOCK WAINGSCOT - MATCH EXISTING
- 15 SEALANT OVER BACKER ROD EXTERIOR / CAULK INTERIOR - TYPICAL AT ALL WINDOWS AND DOORS
- 16 ALUMINIUM WINDOW SYSTEM WITH INSULATED GLAZING
- 17 BRICK VENT
- 18 BULLNOSE
- 19 BOND BREAK
- 20 4" CONCRETE SLAB ON VAPOR BARRIER (REFER TO STRUCTURAL)
- 21 PERIMETER INSULATION - EXTEND 2'-0" IN BOTH DIRECTIONS
- 22 COMPACTED GRANULAR FILL
- 23 GRADE (REFER TO CIVIL)
- 24 POURED CONCRETE FOUNDATION WALL (REFER TO STRUCTURAL)
- 25 BITUMINOUS DAMPPROOFING
- 26 STEEL COLUMN (REFER TO STRUCTURAL)
- 27 RIGID INSULATION
- 28 CONTINUOUS METAL ROOF EDGE - MATCH EXISTING PROFILE - AT CONNECTION POINTS ALSO MATCH EXISTING HEIGHT (V.I.F.)
- 29 NEW FENCE (REFER TO CIVIL AND ELECTRICAL)
- 30 CONCRETE MASONRY UNIT
- 31 COLD FORMED METAL FRAMING
- 32 DOOR AND FRAME (REFER TO SCHEDULE)
- 33 2" EXPANSION JOINT / CONTROL JOINT AS REQUIRED - FIRE RATE AS REQUIRED (REFER TO CODE PLAN)
- 34 LIGHT FIXTURE (REFER TO ELECTRICAL)
- 35 MECHANICAL ITEM (REFER TO MECHANICAL)
- 36 POURED CONCRETE FOOTING (REFER TO STRUCTURAL)
- 37 STEEL ANGLE (REFER TO STRUCTURAL)
- 38 STEEL TUBE (REFER TO STRUCTURAL)
- 39 STEEL JOIST (REFER TO STRUCTURAL)
- 40 STEEL BEAM (REFER TO STRUCTURAL)
- 41 SUSPENDED CEILING SYSTEM (REFER TO SCHEDULE)
- 42 LOUVER (REFER TO MECHANICAL)
- 43 BOND BEAM WITH (2) #5 CONT. GROUT SOLID (REFER TO STRUCTURAL)
- 44 CMU FOUNDATION WALL (REFER TO STRUCTURAL)
- 45 ROOF LADDER - ATTACH AND FLASH AS REQUIRED PER MANUFACTURER'S RECOMMENDATIONS (REFER TO REFERENCE ONLY DETAIL)
- 46 WALL MOUNTED ELECTRICAL ITEM (REFER TO ELECTRICAL)
- 47 CEILING MOUNTED ELECTRICAL ITEM (REFER TO ELECTRICAL)
- 48 PLUMBING FIXTURE AND ACCESSORIES (REFER TO MECHANICAL & STANDARD MOUNTING HEIGHTS CHART)
- 49 BASE MATERIAL (REFER TO SCHEDULE)
- 50 CONTROL JOINT

NO.	REVISION	DATE

STATE OF MICHIGAN
DEPARTMENT OF TECHNOLOGY, MANAGEMENT AND BUDGET
FACILITIES AND BUSINESS SERVICES ADMINISTRATION
DESIGN AND CONSTRUCTION DIVISION
ADAM LACEL, R.A. DIRECTOR

FILE NO.
491/20167.SDW
FUNDING CODE
171CODHHS7255
CONTRACT NO.
Y22003

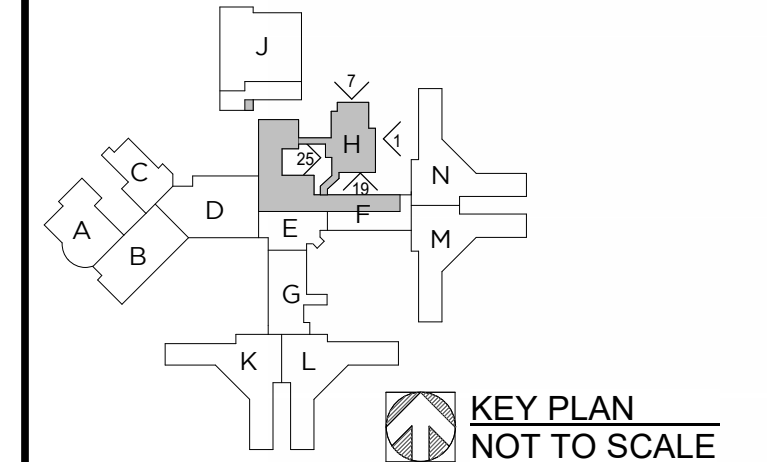

WTAARCH.COM


WTA ARCHITECTS

100 S Jefferson Ave, Suite 601
Saginaw, Michigan 48607
989 752 8107
COPYRIGHT © 2023

PROJECT TITLE
491/20167.SDW - PHASE 500:
CENTER FOR FORENSIC PSYCHIATRY - CREATE KITCHEN
SALINE, MICHIGAN





SHEET TITLE
EXTERIOR ELEVATIONS

PROJECT NUMBER 2021094	SHEET NUMBER A5.01
PROJECT DATE SEPTEMBER 6, 2023	CHECKED BY C.D.S.

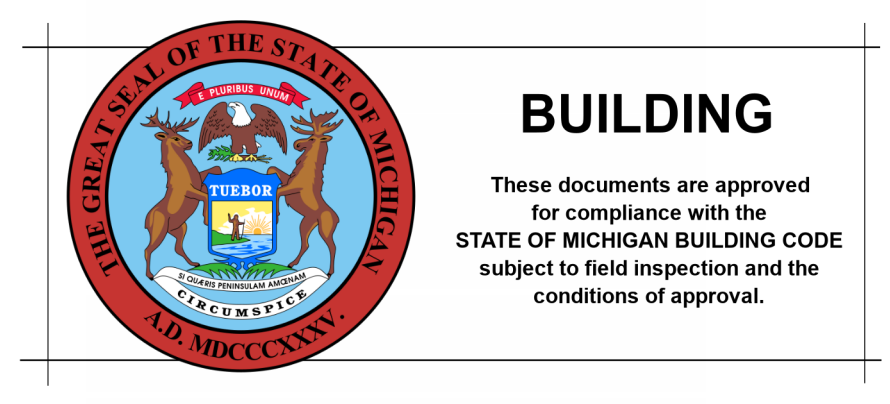

MATERIAL KEYNOTES

- 1 EXISTING TO REMAIN
- 2 FULLY ADHERED SINGLE PLY MEMBRANE ROOFING
- 3 3/4" ROOFING BOARD
- 4 RIGID ROOF INSULATION R-30
- 5 METAL DECK (REFER TO STRUCTURAL)
- 6 2x PRESSURE TREATED WOOD BLOCKING
- 7 SPRAY INSULATION IN METAL DECK FLUTES TO ALLOW FOR CONTINUOUS INSULATION
- 8 STEEL LINTEL - EXTERIOR STEEL LINTELS TO BE GALVANIZED - PAINT (REFER TO STRUCTURAL)
- 9 GROUT SOLID
- 10 THRU WALL FLASHING
- 11 MORTAR NET
- 12 FACE BRICK - MATCH EXISTING
- 13 8x24 BURNISHED BLOCK ACCENT BAND - MATCH EXISTING
- 14 8x24 SPLIT FACE BLOCK WAINSCOT - MATCH EXISTING
- 15 SEALANT OVER BACKER ROD EXTERIOR / CAULK INTERIOR - TYPICAL AT ALL WINDOWS AND DOORS
- 16 ALUMINUM WINDOW SYSTEM WITH INSULATED GLAZING
- 17 BRICK VENT
- 18 BULLNOSE
- 19 BOND BREAK
- 20 4" CONCRETE SLAB ON VAPOR BARRIER (REFER TO STRUCTURAL)
- 21 PERIMETER INSULATION - EXTEND 2'-0" IN BOTH DIRECTIONS
- 22 COMPACTED GRANULAR FILL
- 23 GRADE (REFER TO CIVIL)
- 24 POURED CONCRETE FOUNDATION WALL (REFER TO STRUCTURAL)
- 25 BITUMINOUS DAMPROOFING
- 26 STEEL COLUMN (REFER TO STRUCTURAL)
- 27 RIGID INSULATION
- 28 CONTINUOUS METAL ROOF EDGE - MATCH EXISTING PROFILE - AT CONNECTION POINTS ALSO MATCH EXISTING HEIGHT (V.I.F.)
- 29 NEW FENCE (REFER TO CIVIL AND ELECTRICAL)
- 30 CONCRETE MASONRY UNIT
- 31 COLD FORMED METAL FRAMING
- 32 DOOR AND FRAME (REFER TO SCHEDULE)
- 33 2" EXPANSION JOINT / CONTROL JOINT AS REQUIRED - FIRE RATE AS REQUIRED (REFER TO CODE PLAN)
- 34 LIGHT FIXTURE (REFER TO ELECTRICAL)
- 35 MECHANICAL ITEM (REFER TO MECHANICAL)
- 36 POURED CONCRETE FOOTING (REFER TO STRUCTURAL)
- 37 STEEL ANGLE (REFER TO STRUCTURAL)
- 38 STEEL TUBE (REFER TO STRUCTURAL)
- 39 STEEL JOIST (REFER TO STRUCTURAL)
- 40 STEEL BEAM (REFER TO STRUCTURAL)
- 41 SUSPENDED CEILING SYSTEM (REFER TO SCHEDULE)
- 42 LOUVER (REFER TO MECHANICAL)
- 43 BOND BEAM WITH (2) #5 CONT. GROUT SOLID (REFER TO STRUCTURAL)
- 44 CMU FOUNDATION WALL (REFER TO STRUCTURAL)
- 45 ROOF LADDER - ATTACH AND FLASH AS REQUIRED PER MANUFACTURER'S RECOMMENDATIONS (REFER TO REFERENCE ONLY DETAIL)
- 46 WALL MOUNTED ELECTRICAL ITEM (REFER TO ELECTRICAL)
- 47 CEILING MOUNTED ELECTRICAL ITEM (REFER TO ELECTRICAL)
- 48 PLUMBING FIXTURE AND ACCESSORIES (REFER TO MECHANICAL & STANDARD MOUNTING HEIGHTS CHART)
- 49 BASE MATERIAL (REFER TO SCHEDULE)
- 50 CONTROL JOINT

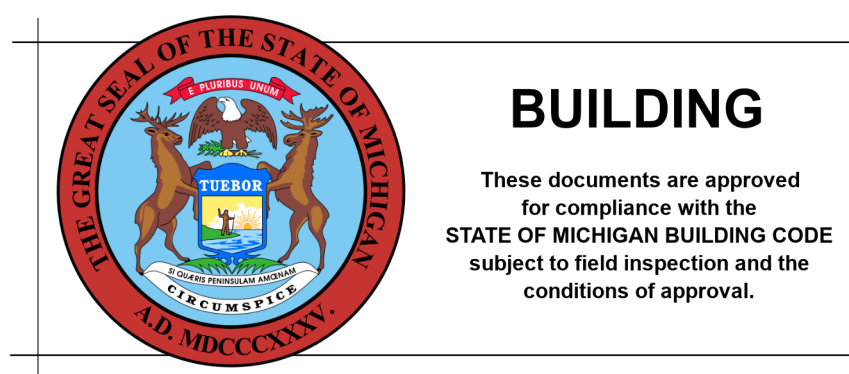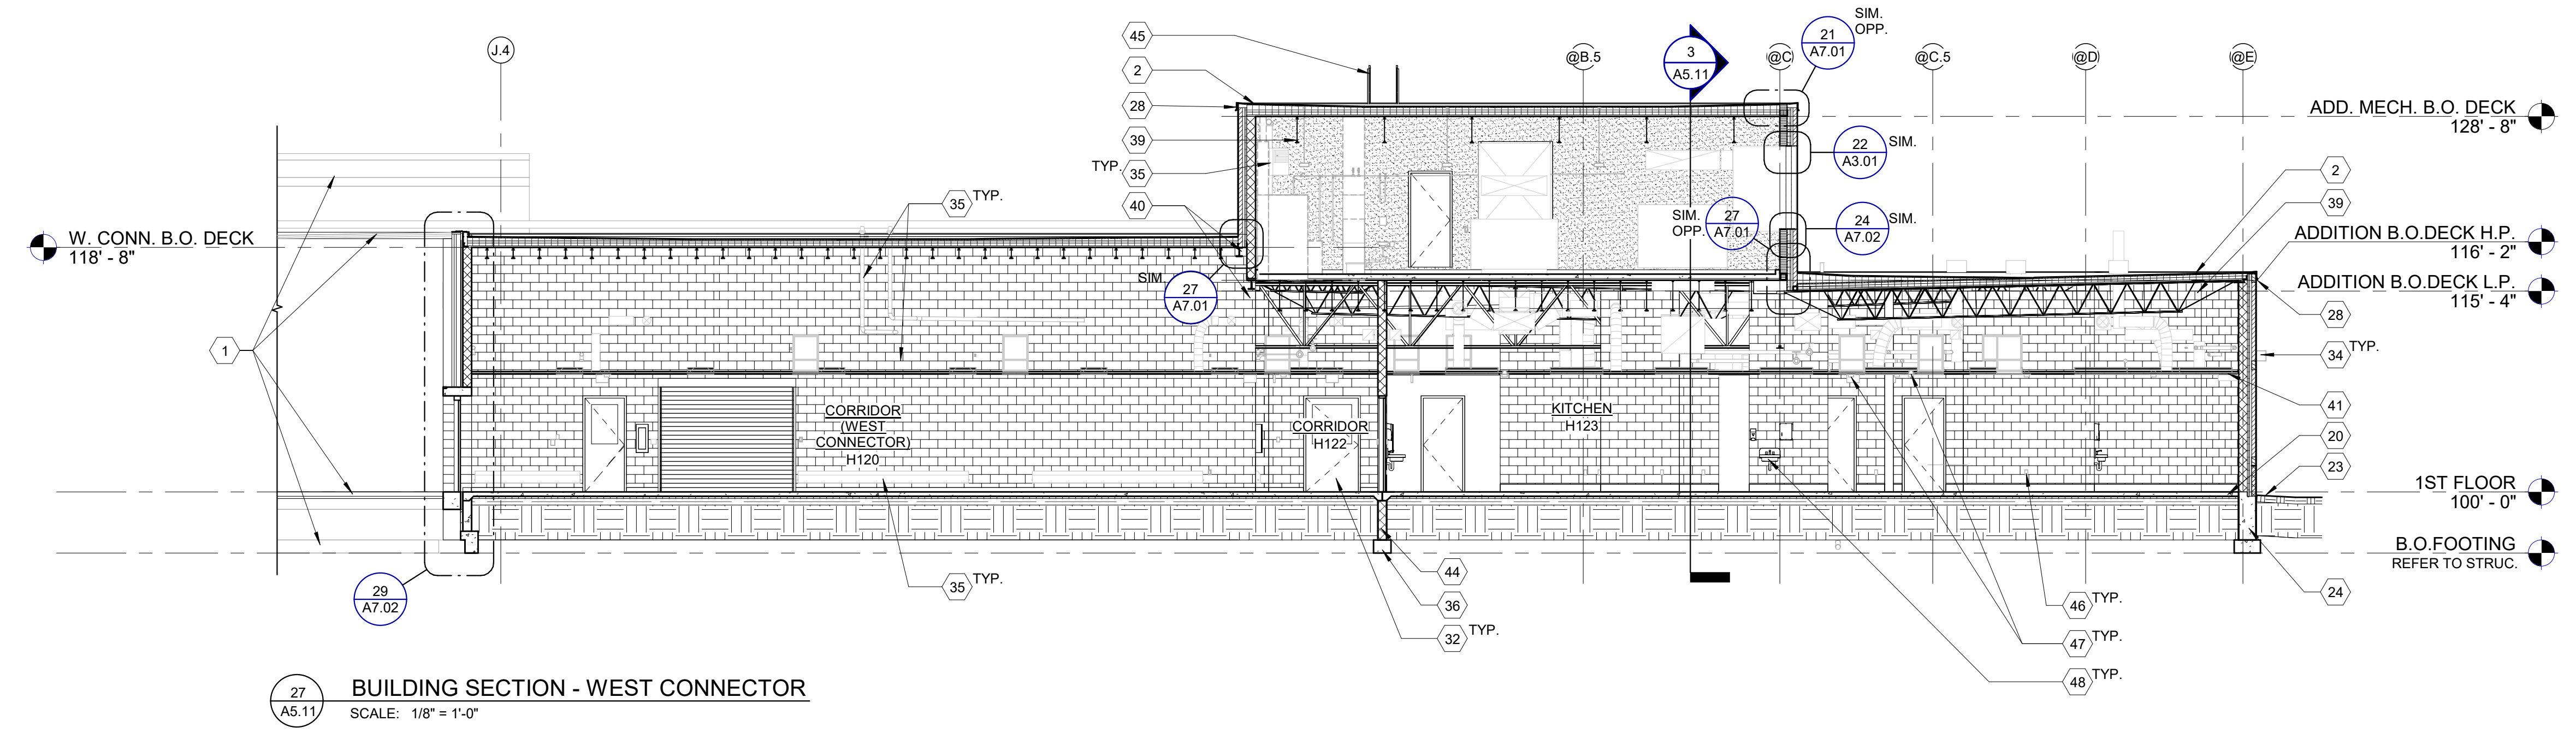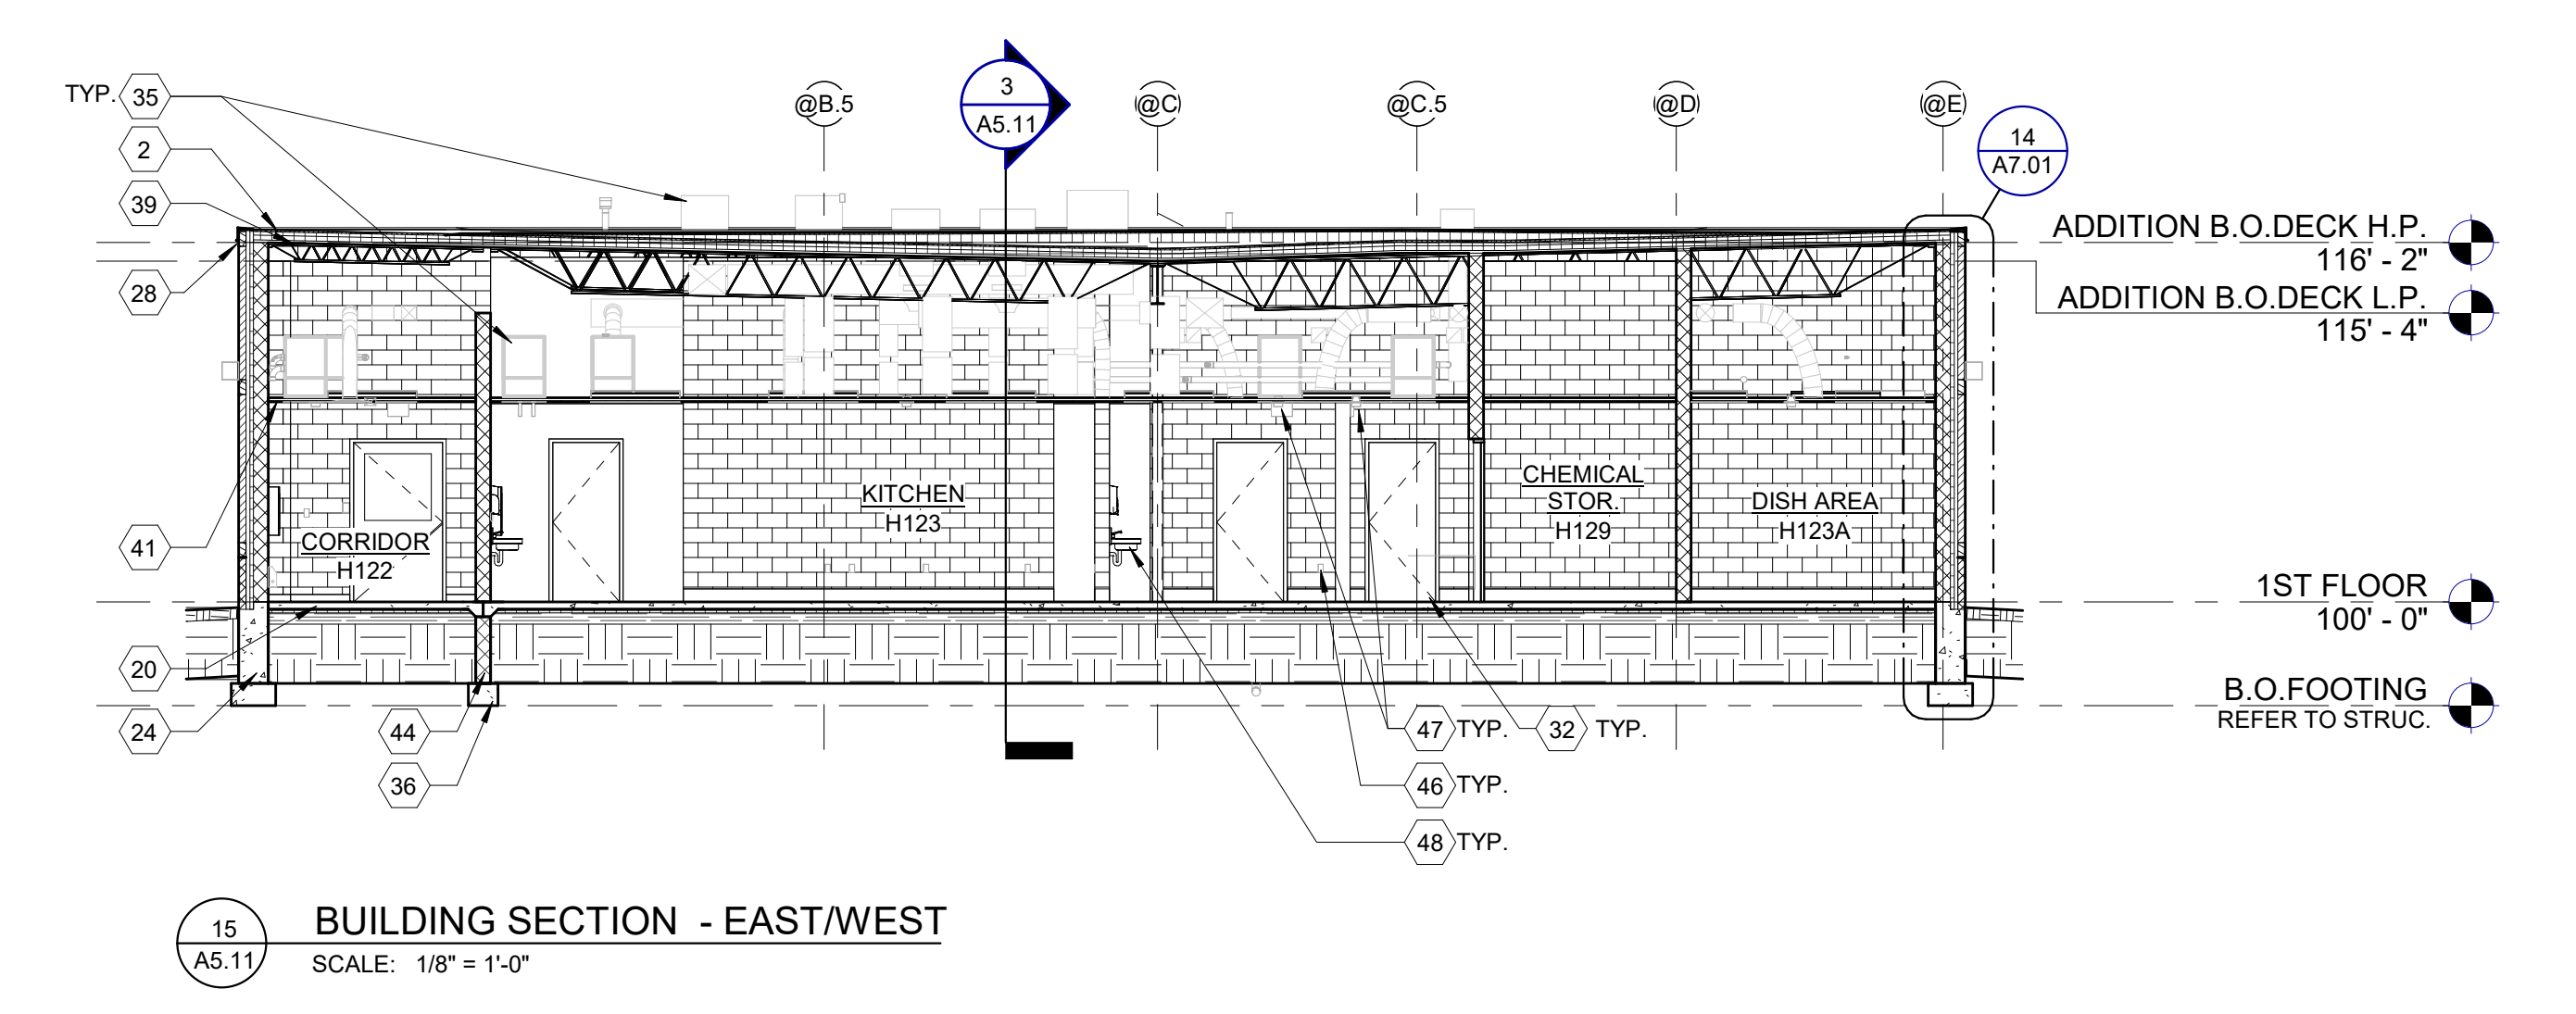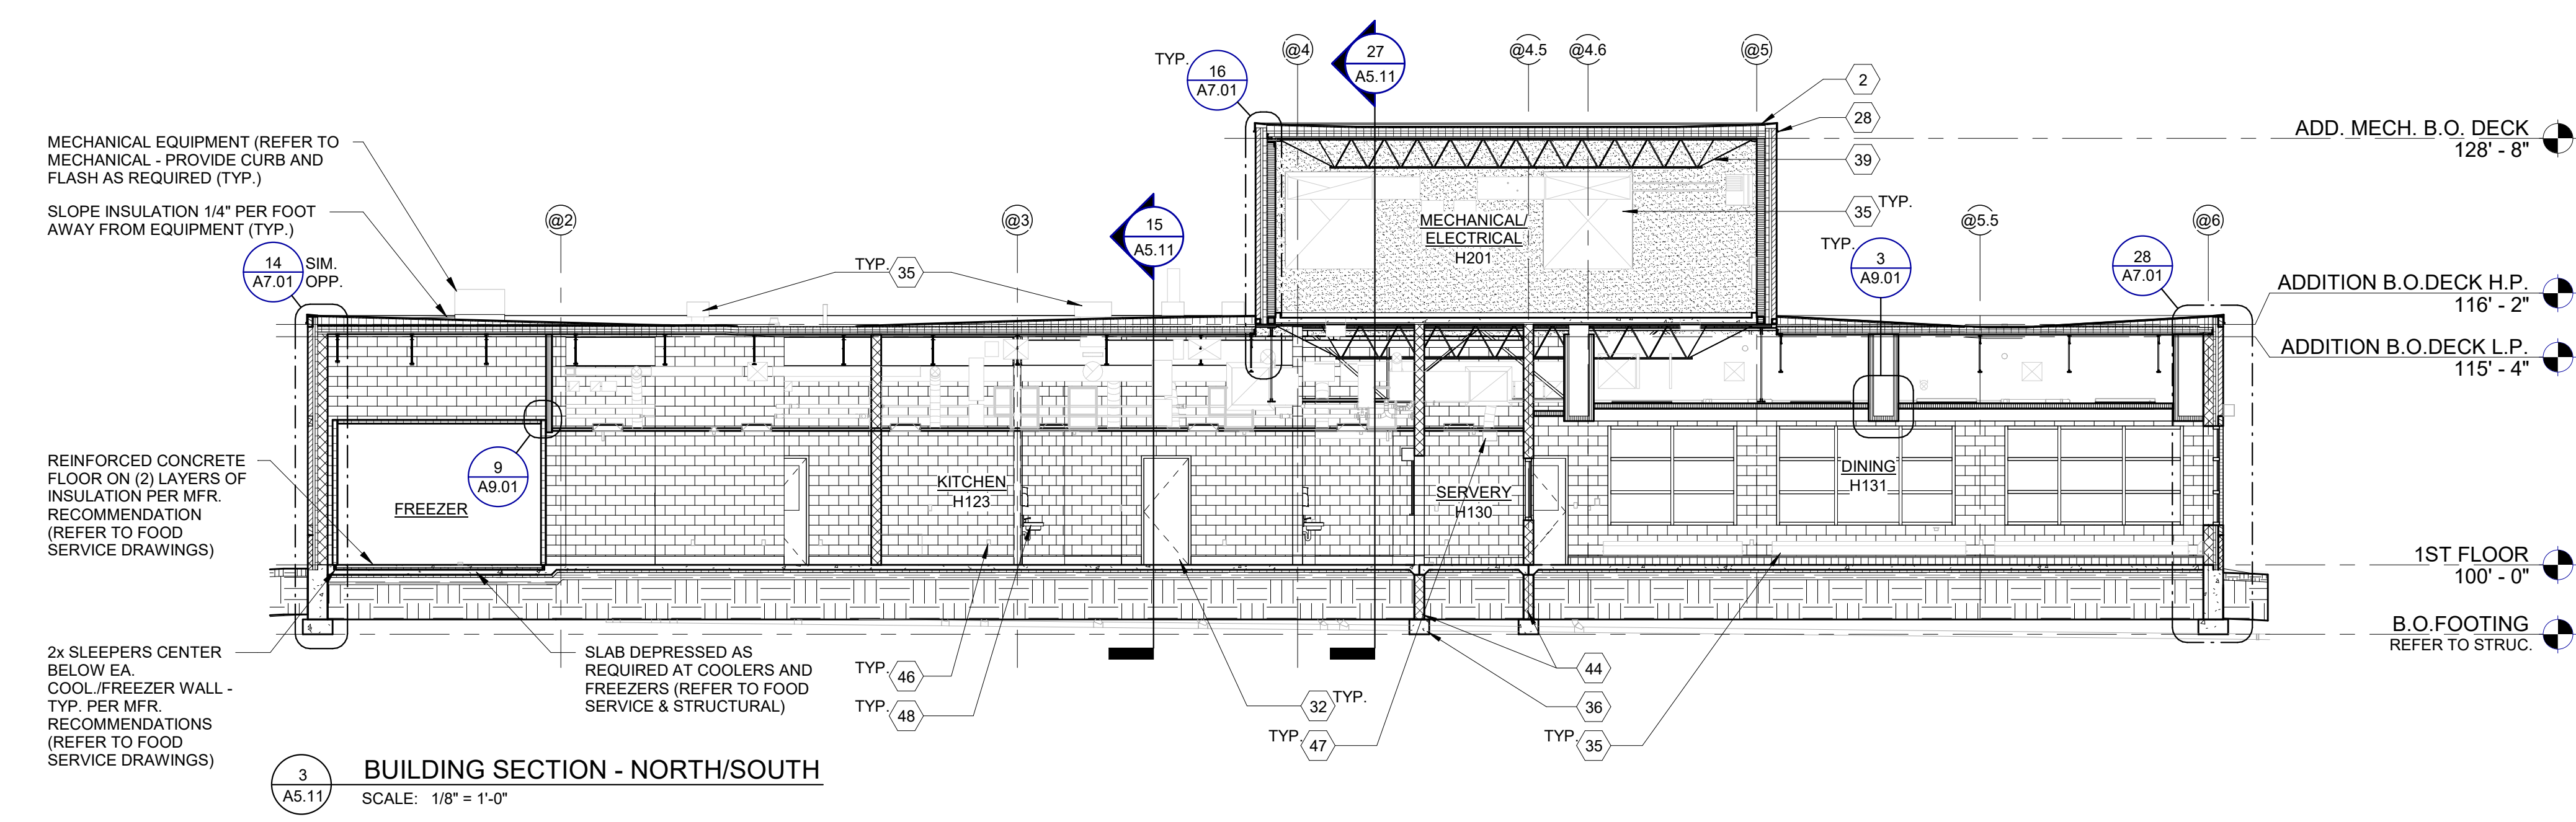

NO.	REVISION	DATE

STATE OF MICHIGAN
DEPARTMENT OF TECHNOLOGY, MANAGEMENT AND BUDGET
FACILITIES AND BUSINESS SERVICES ADMINISTRATION
DESIGN AND CONSTRUCTION DIVISION
ADAM LACEL, R.A. DIRECTOR

FILE NO.
491/20167.SDW

FUNDING CODE 171CODHHS7255 CONTRACT NO. Y22003

WTAARCH.COM

WTA ARCHITECTS

100 S. Jefferson Ave., Suite 601
Saginaw, Michigan 48607
989 752 8107 COPYRIGHT © 2023

PROJECT TITLE

491/20167.SDW - PHASE 500:
CENTER FOR FORENSIC
PSYCHIATRY - CREATE
KITCHEN

SALINE, MICHIGAN



SHEET TITLE
BUILDING SECTIONS

PROJECT NUMBER
2021094

PROJECT DATE
SEPTEMBER 6, 2023

CHECKED BY
C.D.S.

SHEET NUMBER
A5.11

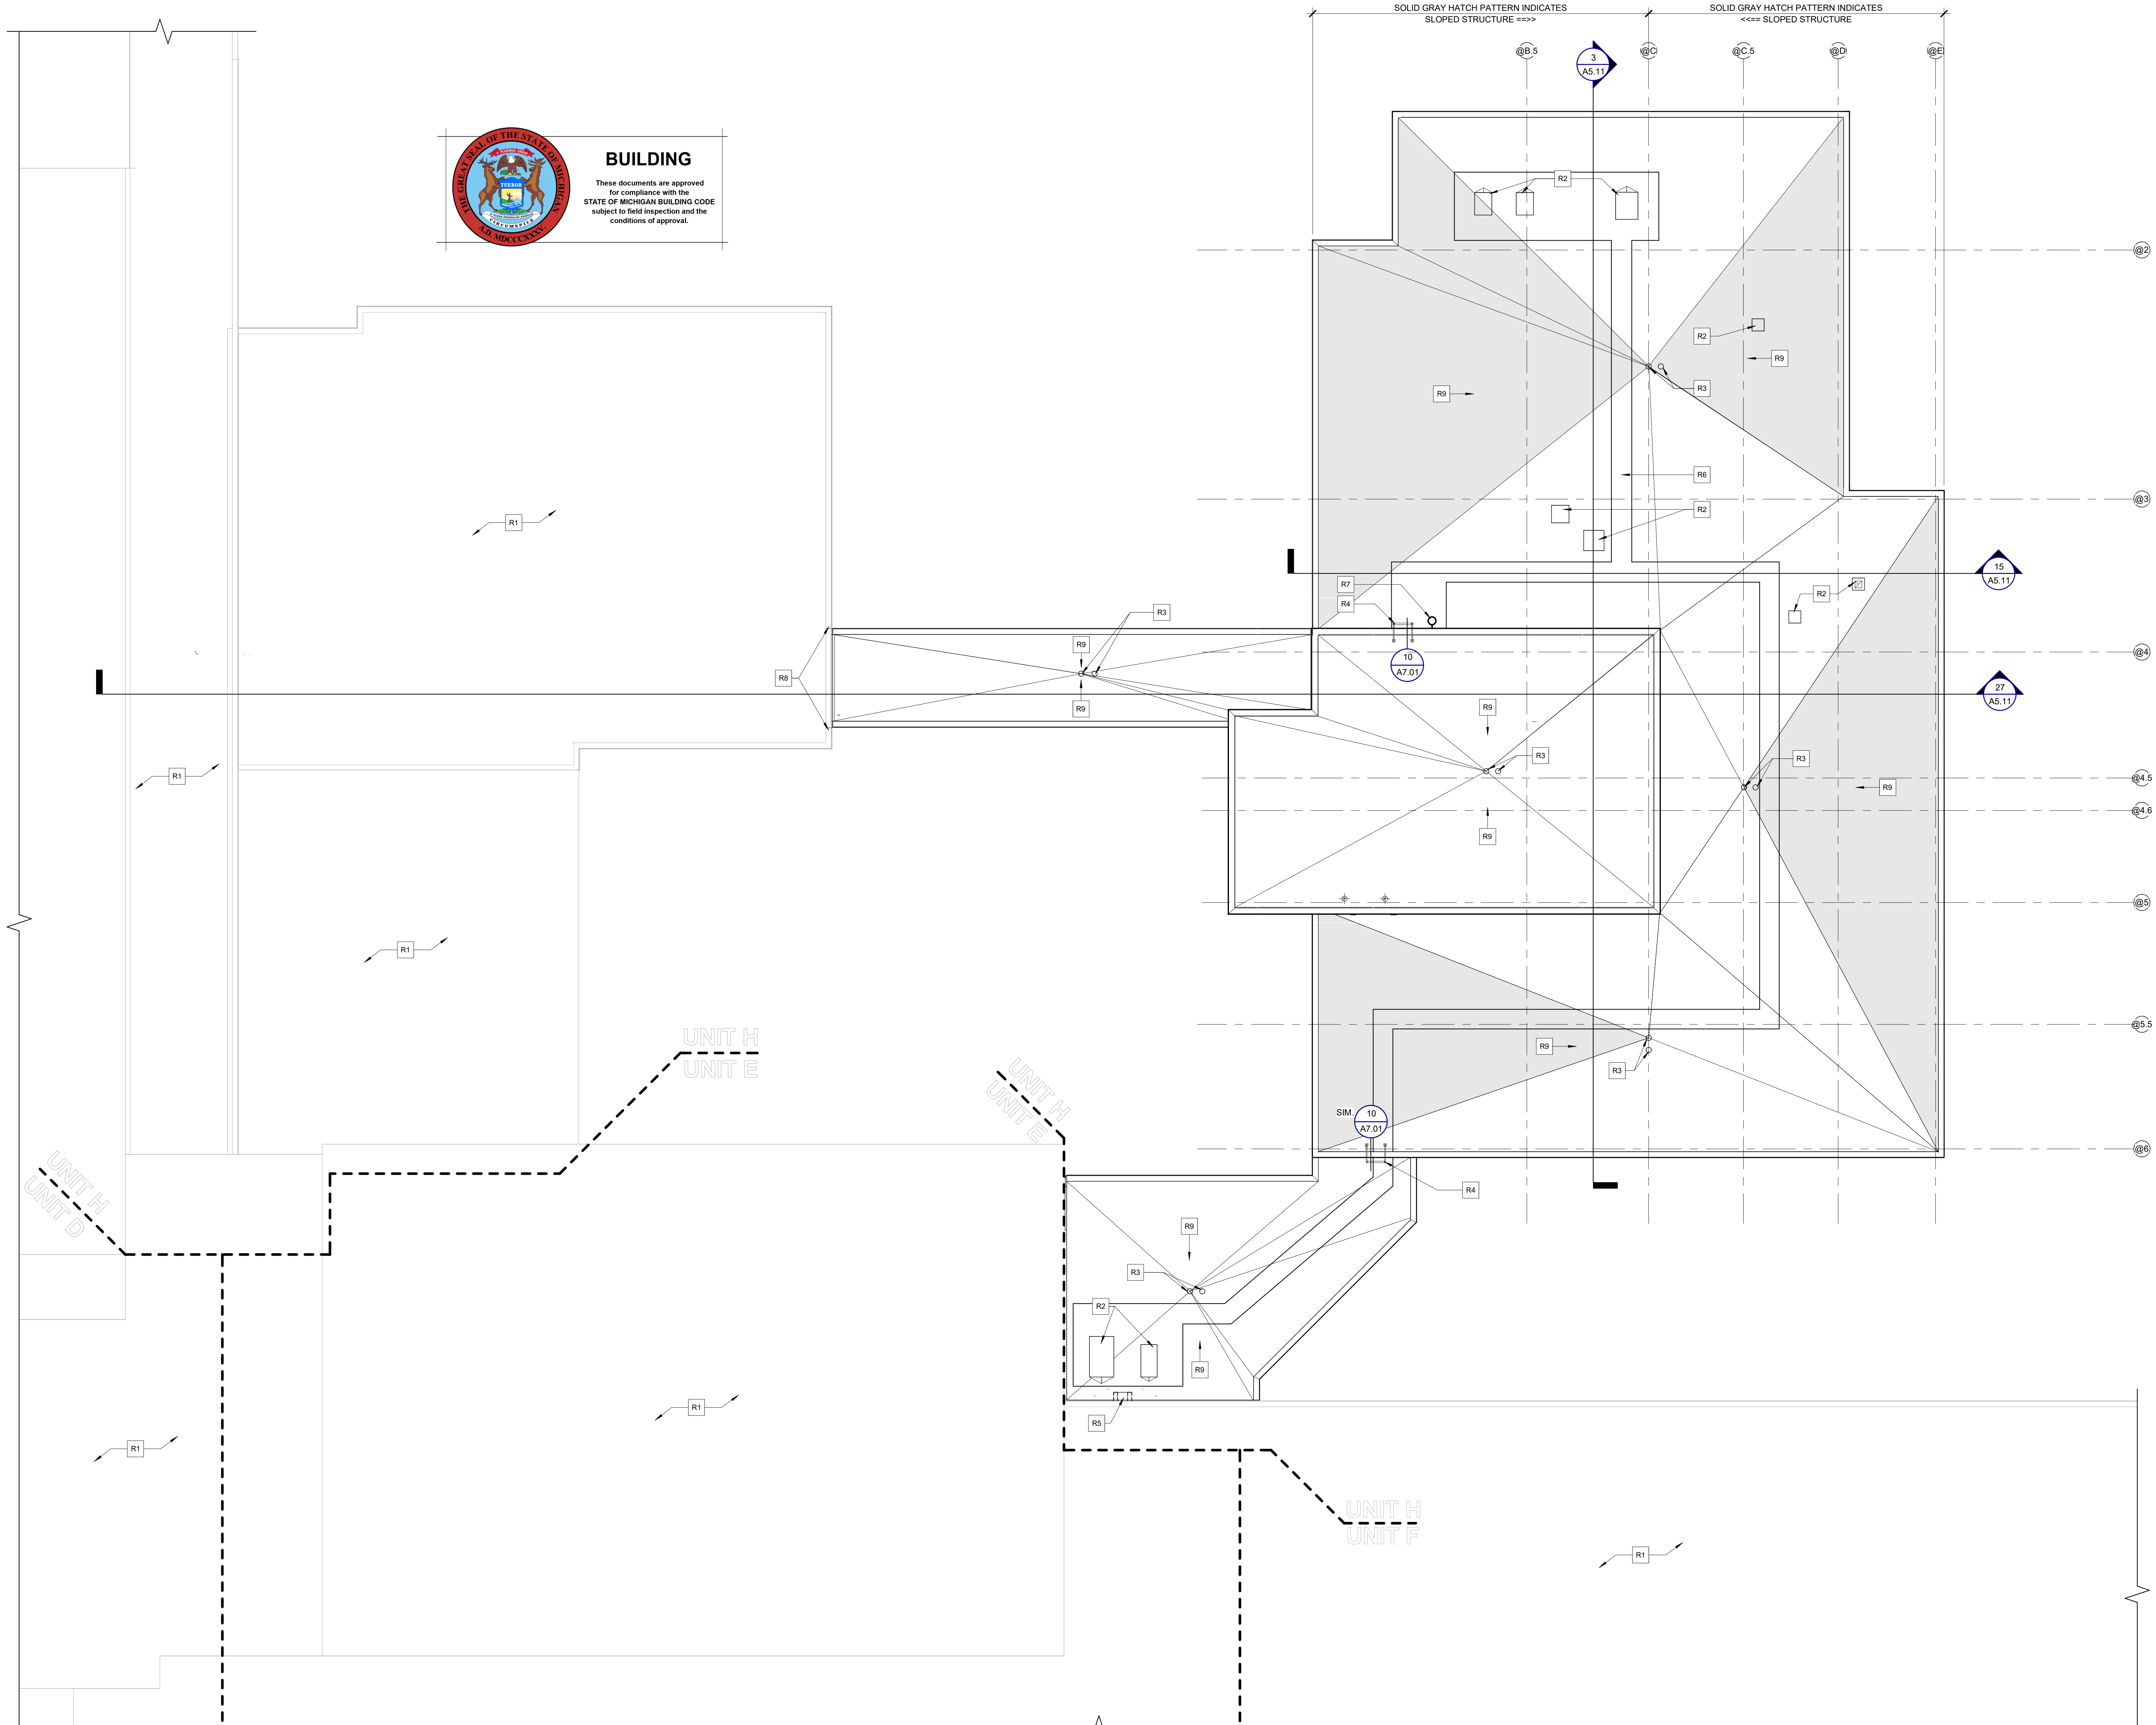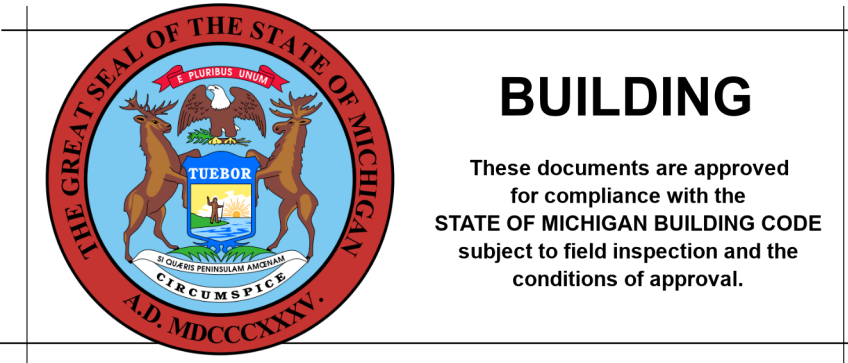

ROOF PLAN GENERAL NOTES:

1. PROVIDE FLASHING PER MANUFACTURERS RECOMMENDATIONS AT WALLS, ROOF PENETRATIONS (MECHANICAL AND ELECTRICAL), ROOF EDGES, ETC.
2. MECHANICAL AND ELECTRICAL EQUIPMENT SHOWN REFERENCE ONLY. REFER TO MECHANICAL AND ELECTRICAL DRAWINGS FOR EXACT QUANTITIES AND LOCATIONS OF ALL MECHANICAL AND ELECTRICAL EQUIPMENT, ROOF PENETRATIONS, VENTS THROUGH THE ROOF, ETC.
3. ALL ROOFING WORK, INCLUDING MEMBRANE ROOF FLASHING, ETC. SHALL BE PERFORMED BY ONE ROOFING CONTRACTOR TO LIMIT WARRANTY RESPONSIBILITY. REFER TO SPECIFICATIONS FOR FURTHER REQUIREMENTS.
4. ALL EXISTING ROOF WARRANTIES MUST BE MAINTAINED AT CONNECTION POINTS.

ROOF PLAN KEYNOTE


- R1 EXISTING TO REMAIN.
- R2 MECHANICAL EQUIPMENT (REFER TO MECHANICAL) - PROVIDE CURB AND FLASHING AS REQUIRED PER MANUFACTURERS RECOMMENDATIONS
- R3 ROOF DRAIN w/ OVERFLOW (REFER TO MECHANICAL)
- R4 ROOF LADDER - ATTACH AND FLASH AS REQUIRED - REFER TO DETAIL FOR REFERENCE
- R5 MECHANICAL EQUIPMENT (REFER TO MECHANICAL)
- R6 PROVIDE ROOF WALKING PADS - AS SHOWN TO ALL EQUIPMENT REQUIRING ROUTINE MAINTENANCE - VERIFY LOCATIONS WITH OWNER PRIOR TO INSTALLATION
- R7 LIGHT FIXTURE (REFER TO MECHANICAL)
- R8 PATCH & REPAIR EXISTING ROOF AND FASCIA AT NEW ROOF CONNECTION - FLASH AS REQUIRED
- R9 SLOPE 1/4" PER FOOT TOWARD ROOF DRAIN - HATCHED AREAS UTILIZE SLOPED STRUCTURE - REMAINING AREAS UTILIZE SLOPED INSULATION (REFER TO BUILDING SECTIONS & STRUCTURAL).

NO.	REVISION	DATE

STATE OF MICHIGAN
DEPARTMENT OF TECHNOLOGY, MANAGEMENT AND BUDGET
FACILITIES AND BUSINESS SERVICES ADMINISTRATION
DESIGN AND CONSTRUCTION DIVISION
ADAM LACR, P.E., DIRECTOR

FILE NO.
491/20167.SDW

FUNDING CODE 171CODHHS7255 CONTRACT NO. Y22003

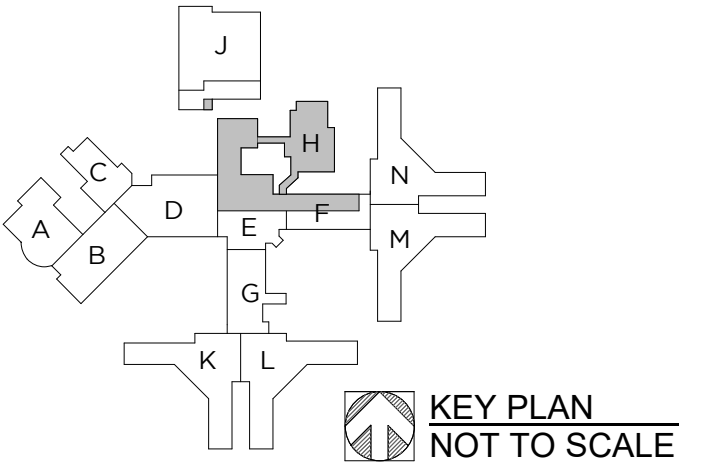

WTA ARCHITECTS
100 S Jefferson Ave, Suite 601
Saginaw, Michigan 48607
989 752 8107 COPYRIGHT © 2023

PROJECT TITLE
491/20167.SDW - PHASE 500:
CENTER FOR FORENSIC
PSYCHIATRY - CREATE
KITCHEN
SALINE, MICHIGAN


SHEET TITLE
ROOF PLAN

PROJECT NUMBER
2021094

PROJECT DATE
SEPTEMBER 6, 2023


SHEET NUMBER
A6.01

ROOF PLAN
NORTH SCALE: 1/8" = 1'-0"

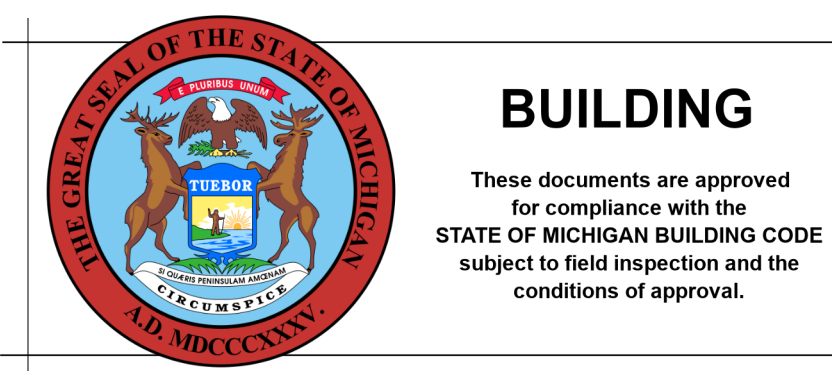


BUILDING


These documents are approved for compliance with the STATE OF MICHIGAN BUILDING CODE subject to field inspection and the conditions of approval.

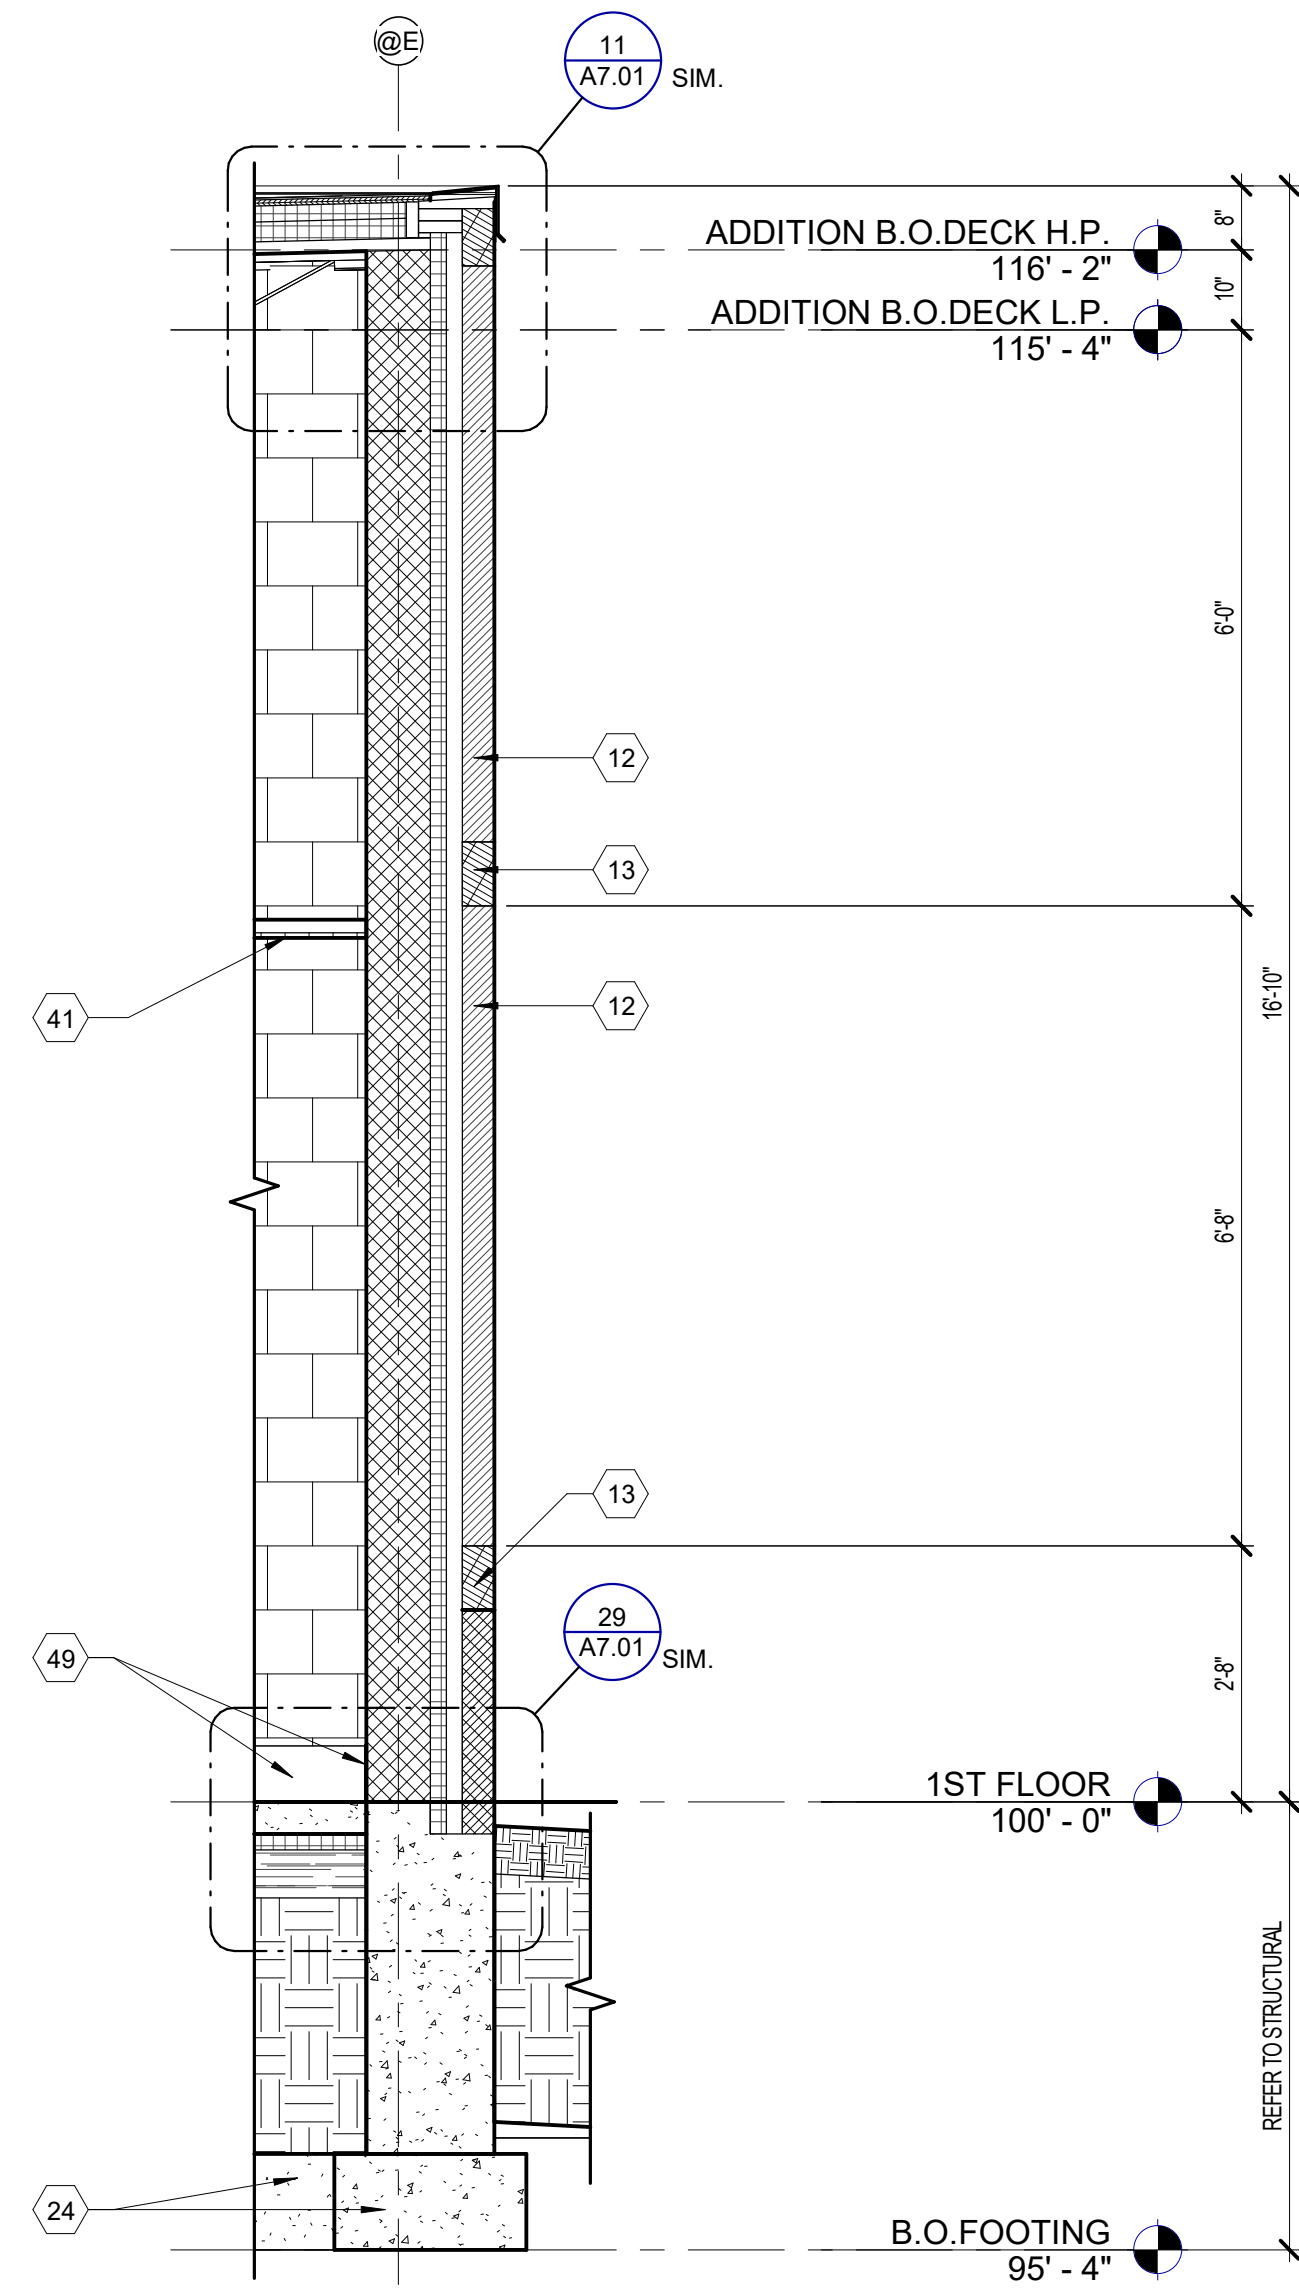


16 WALL SECTION
SCALE: 1/2" = 1'-0"

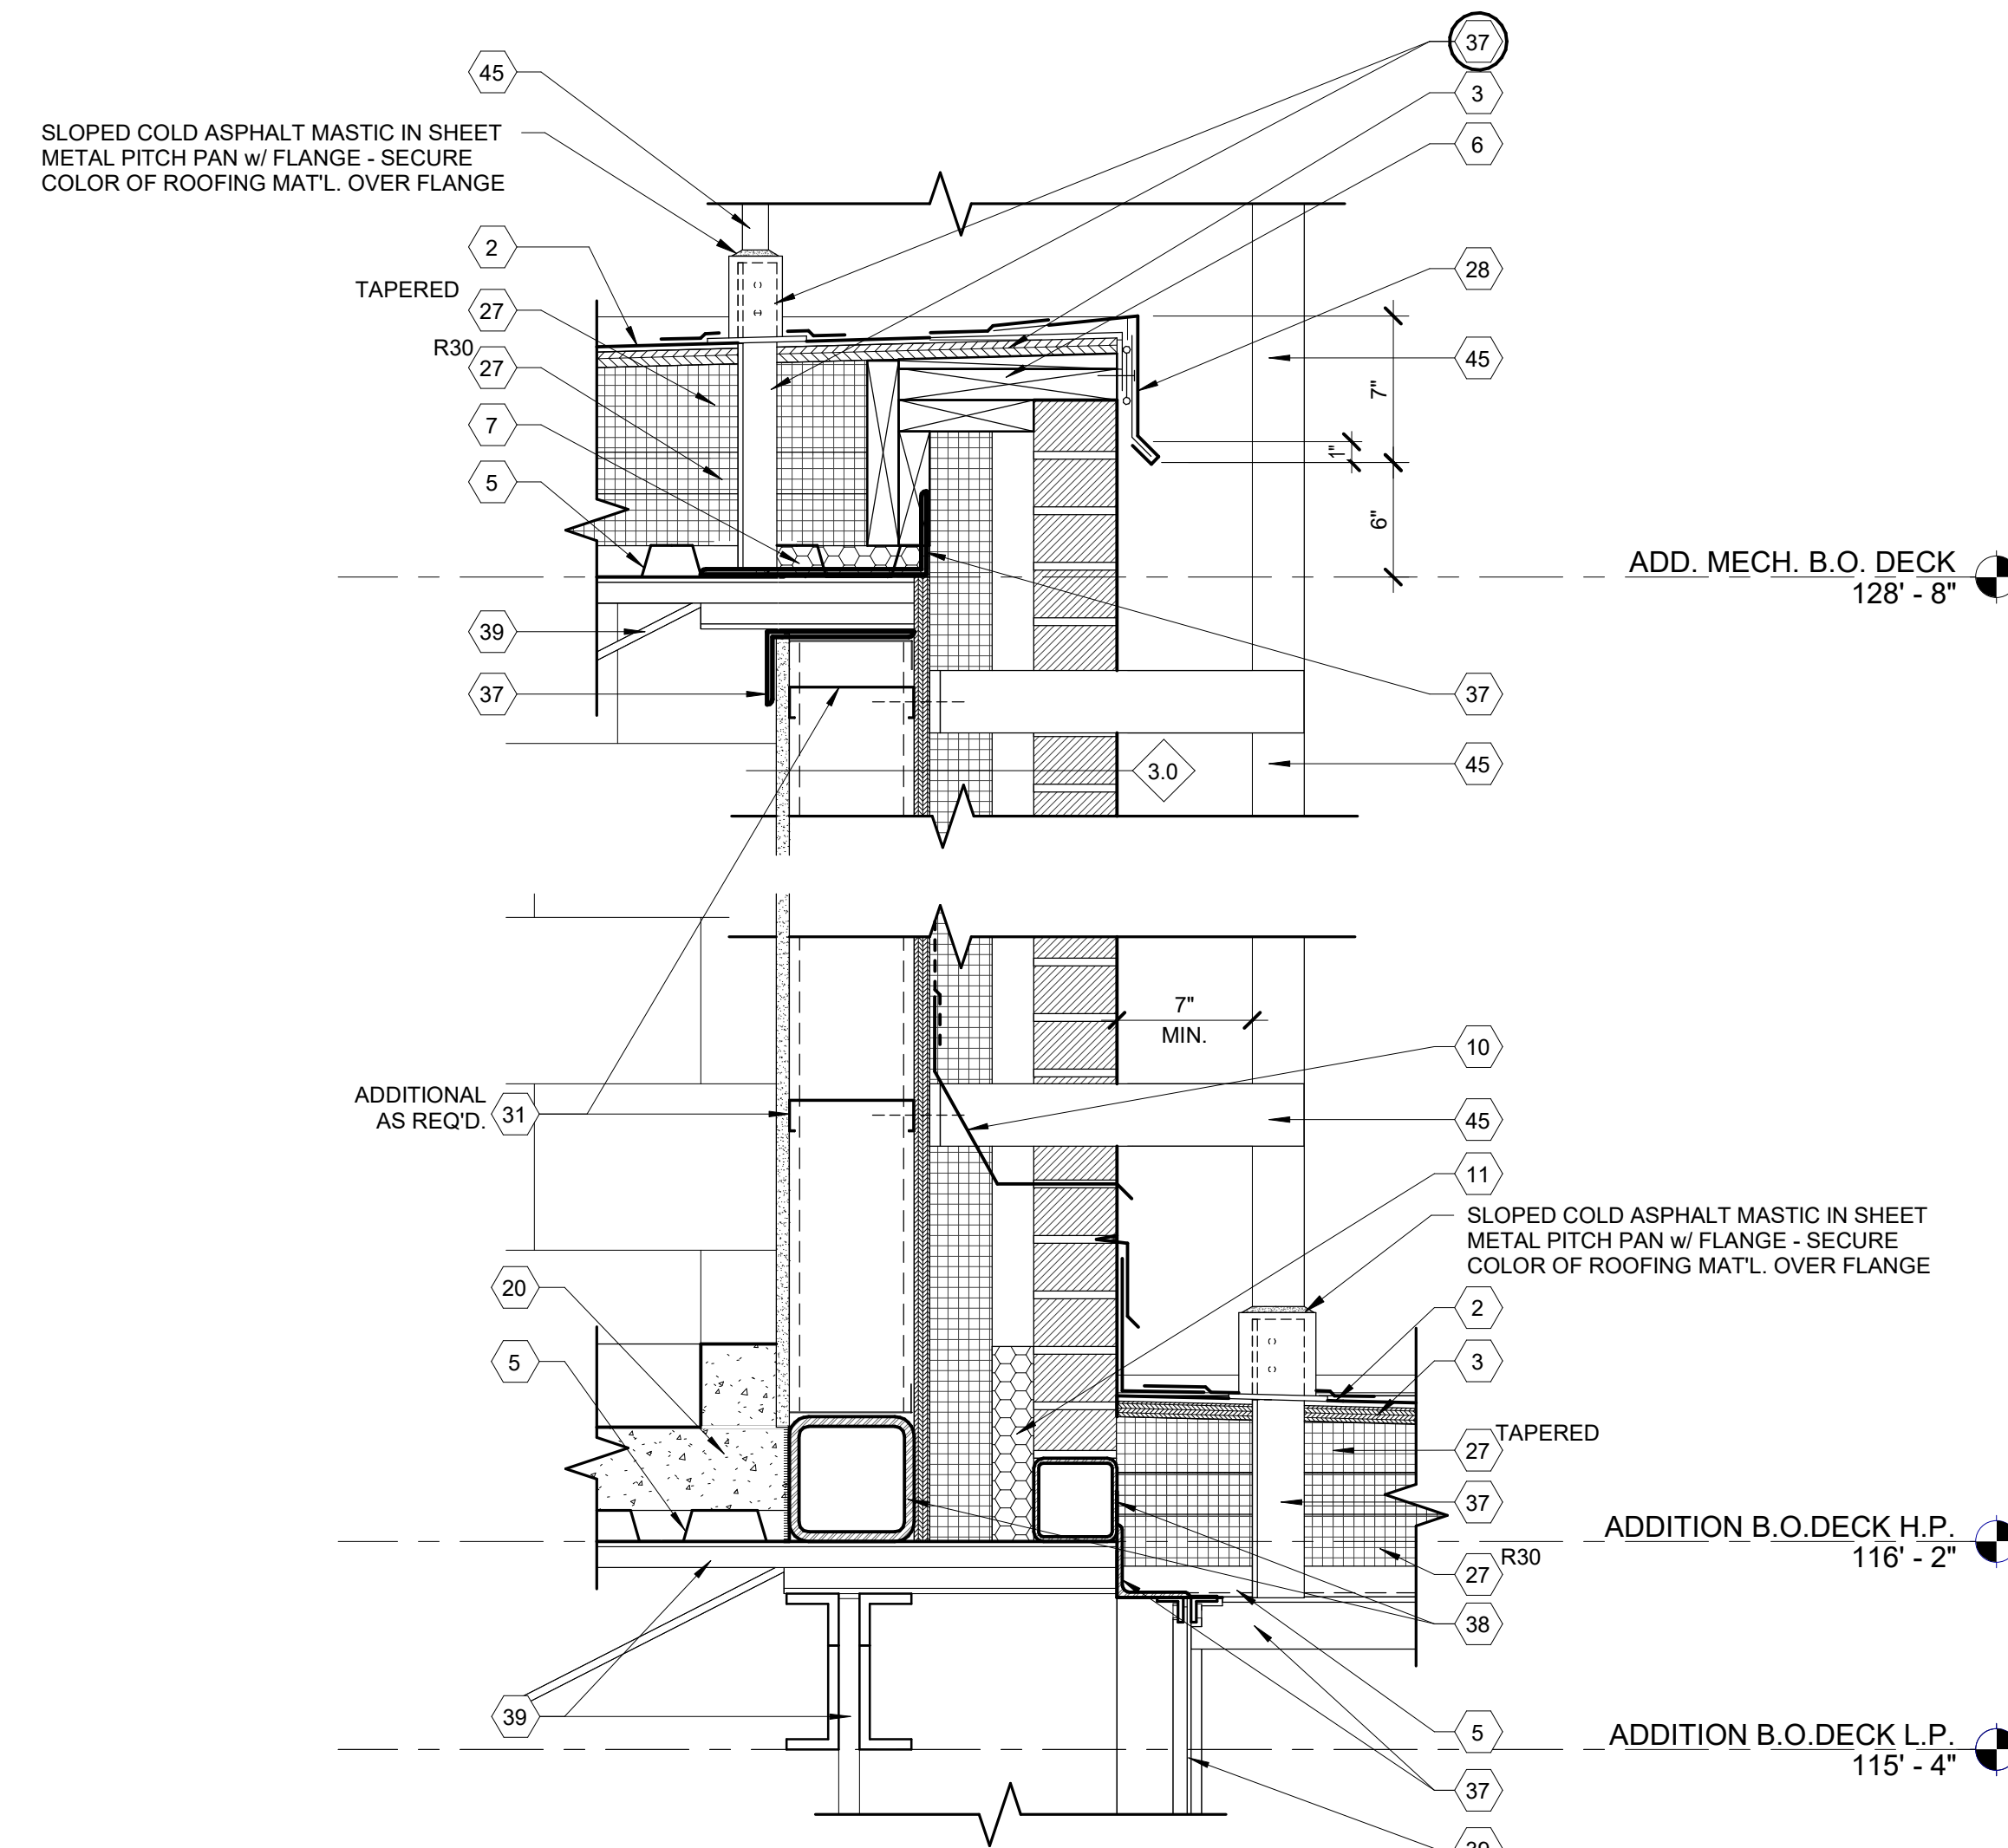


10 ROOF LADDER DETAIL
SCALE: 1 1/2" = 1'-0"

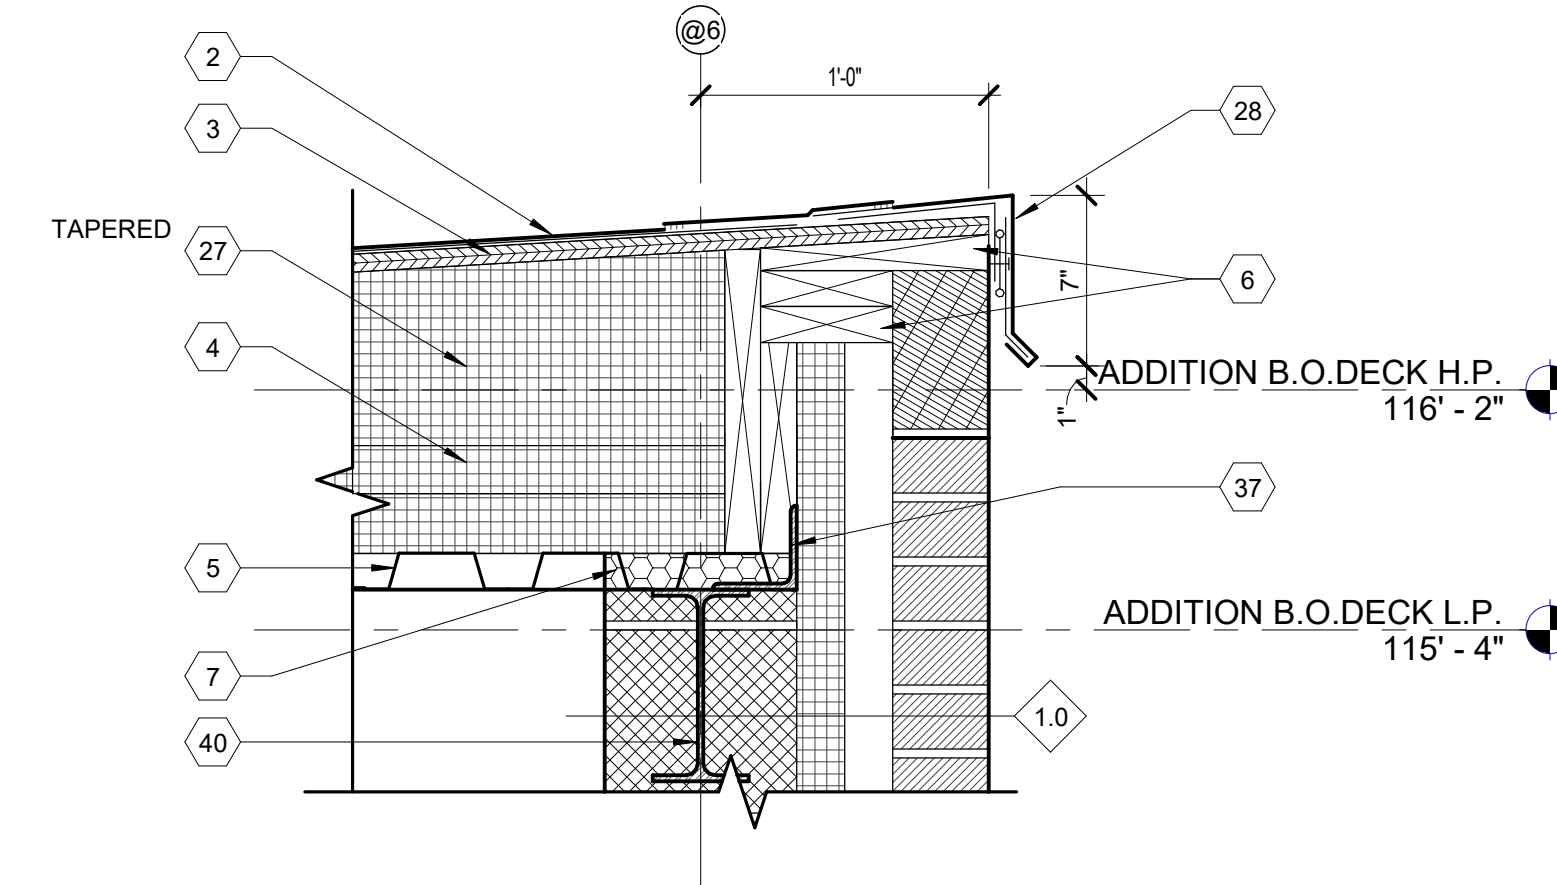


11 ROOF DETAIL
SCALE: 1 1/2" = 1'-0"

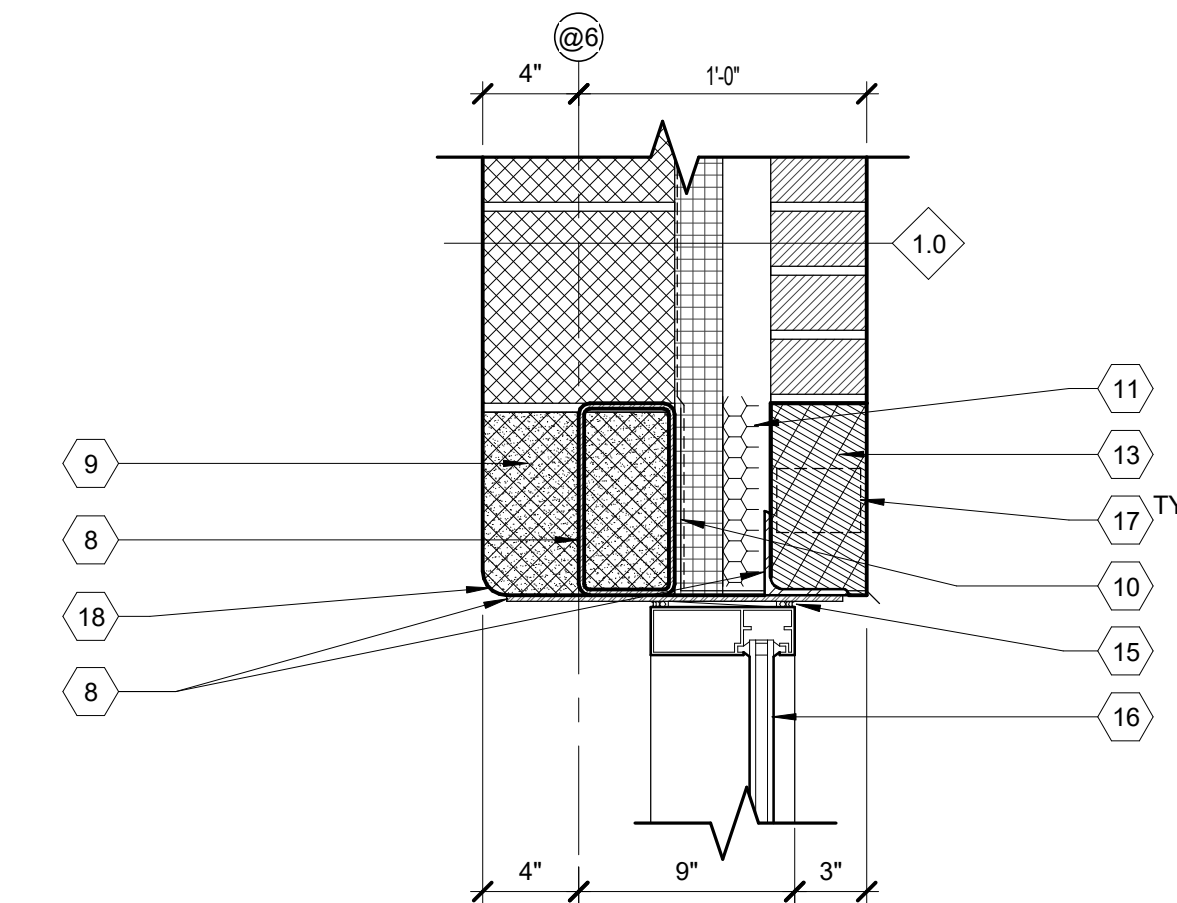


17 WINDOW HEAD
SCALE: 1 1/2" = 1'-0"

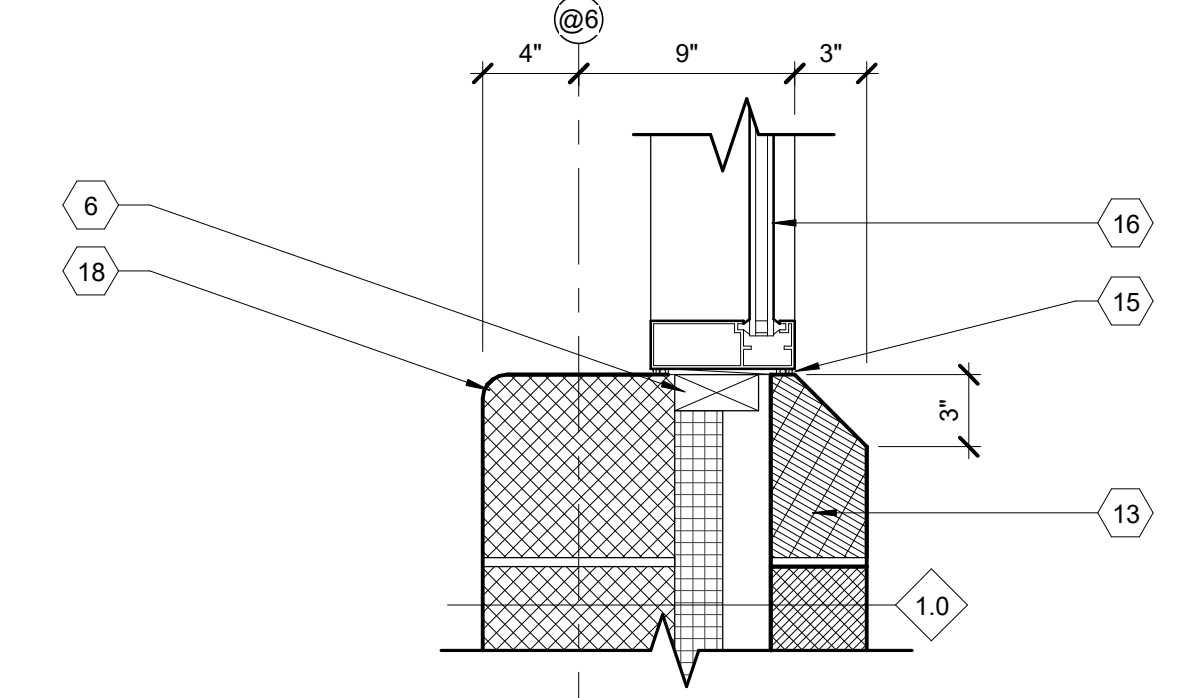


23 WINDOW SILL
SCALE: 1 1/2" = 1'-0"

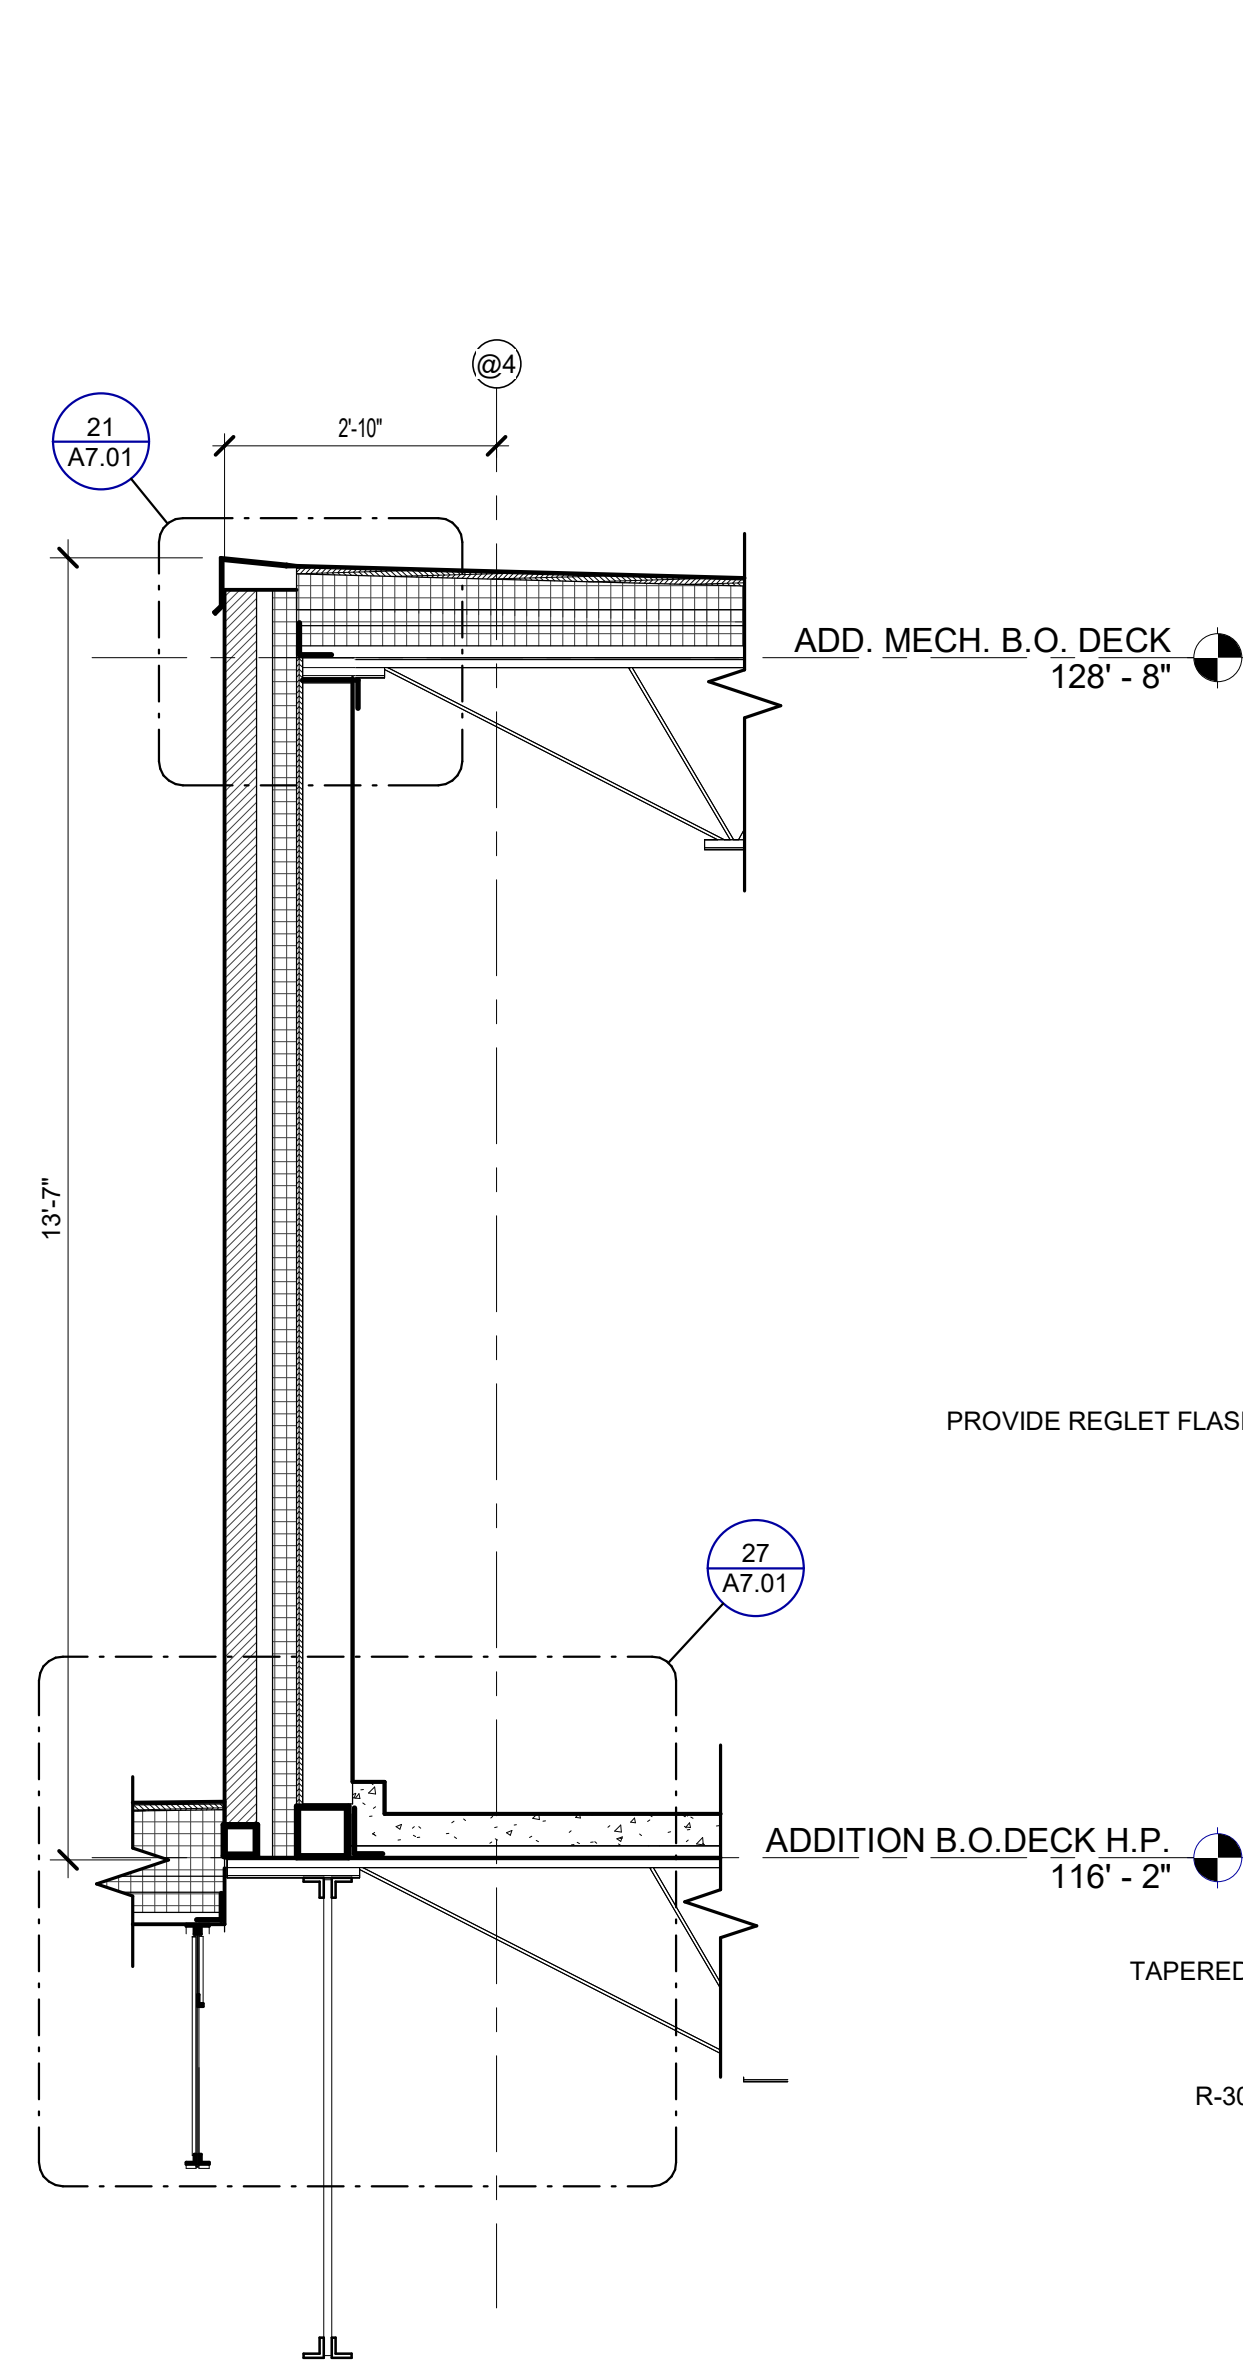


16 WALL SECTION
SCALE: 1/2" = 1'-0"

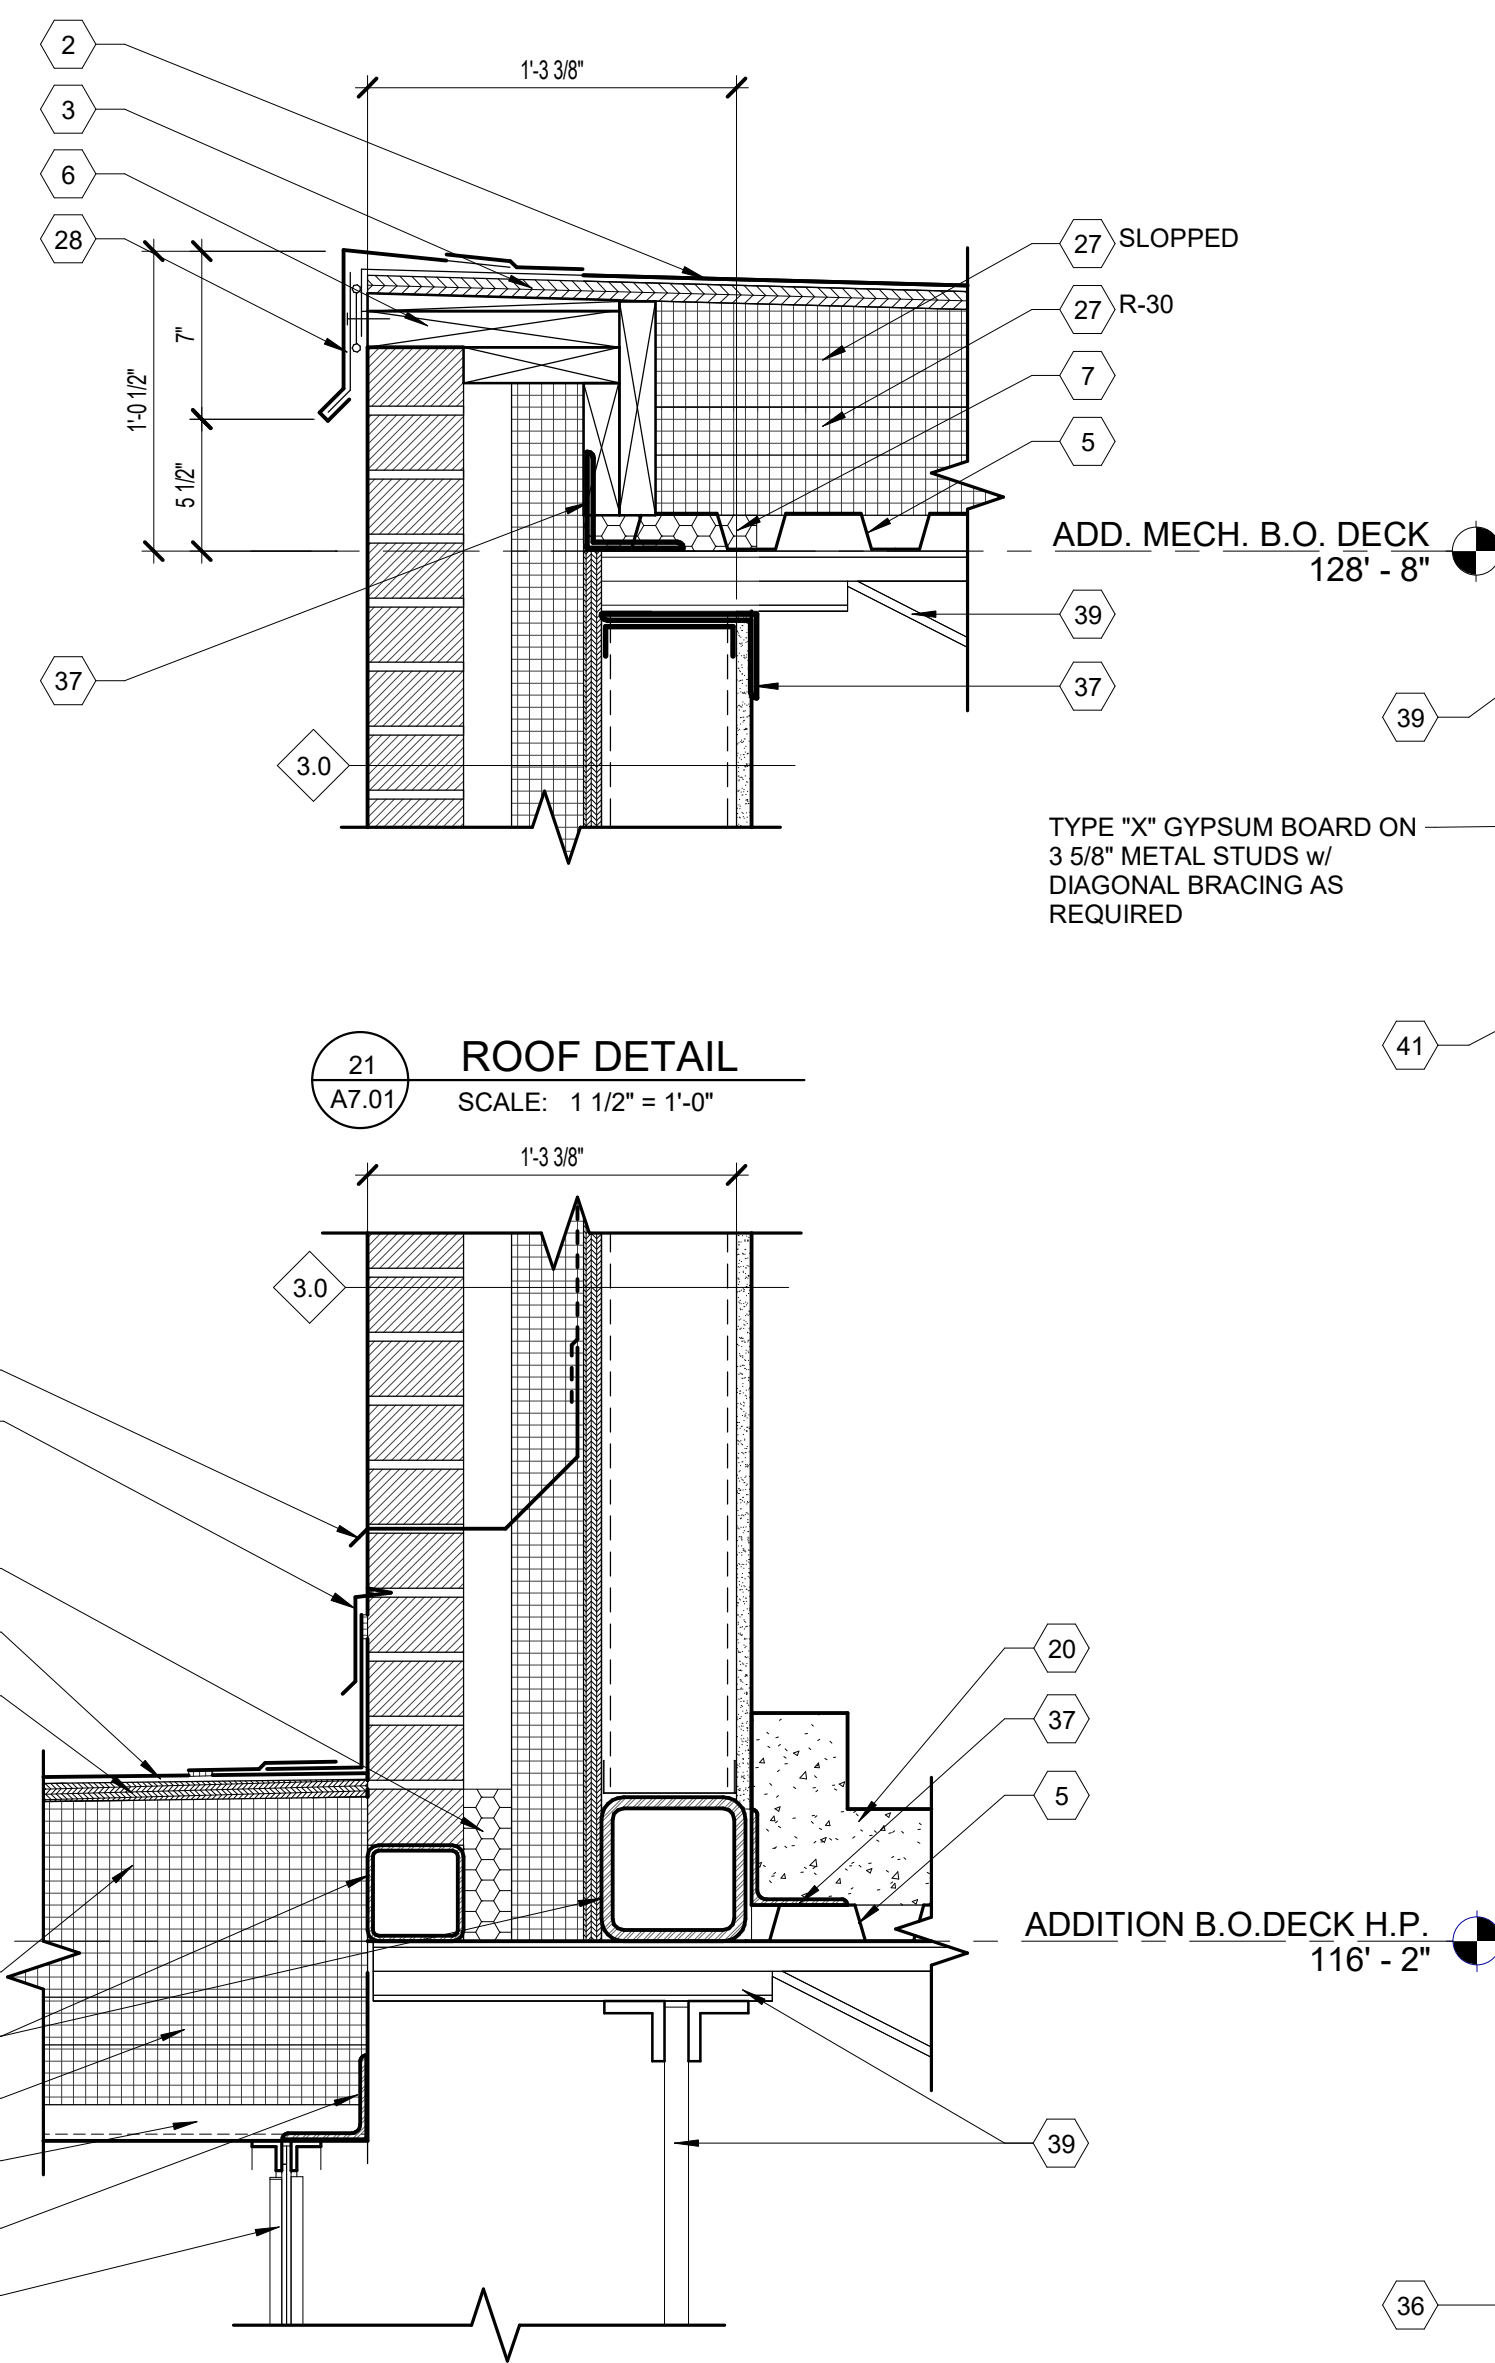

27 SILL DETAIL
SCALE: 1 1/2" = 1'-0"

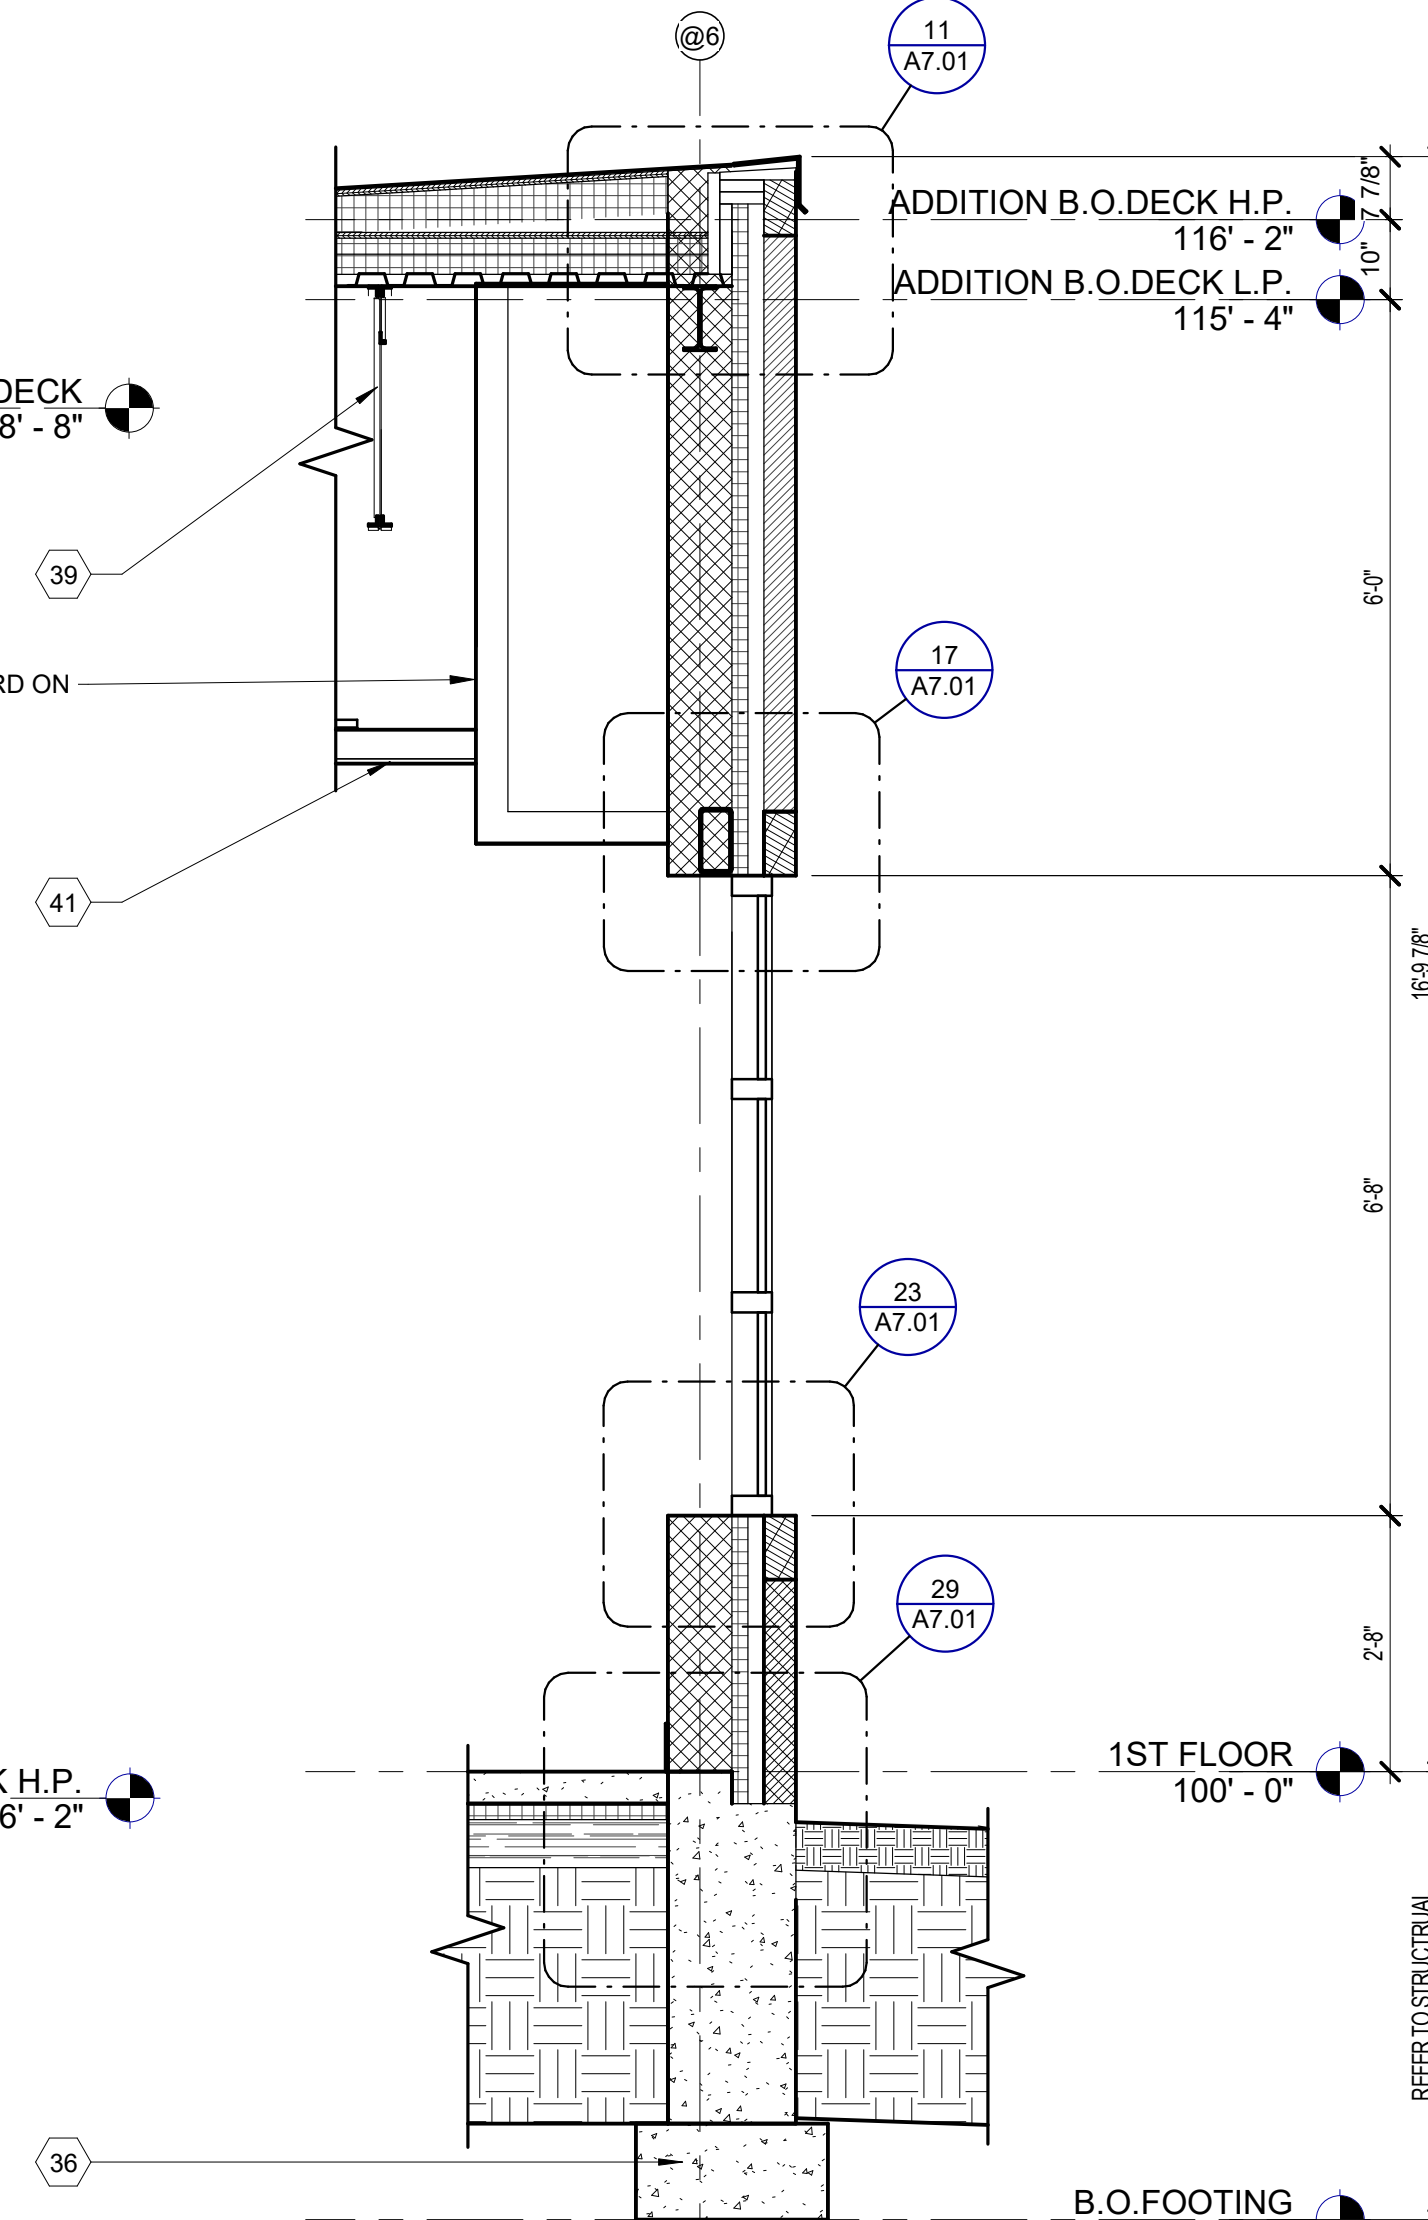

28 WALL SECTION
SCALE: 1/2" = 1'-0"

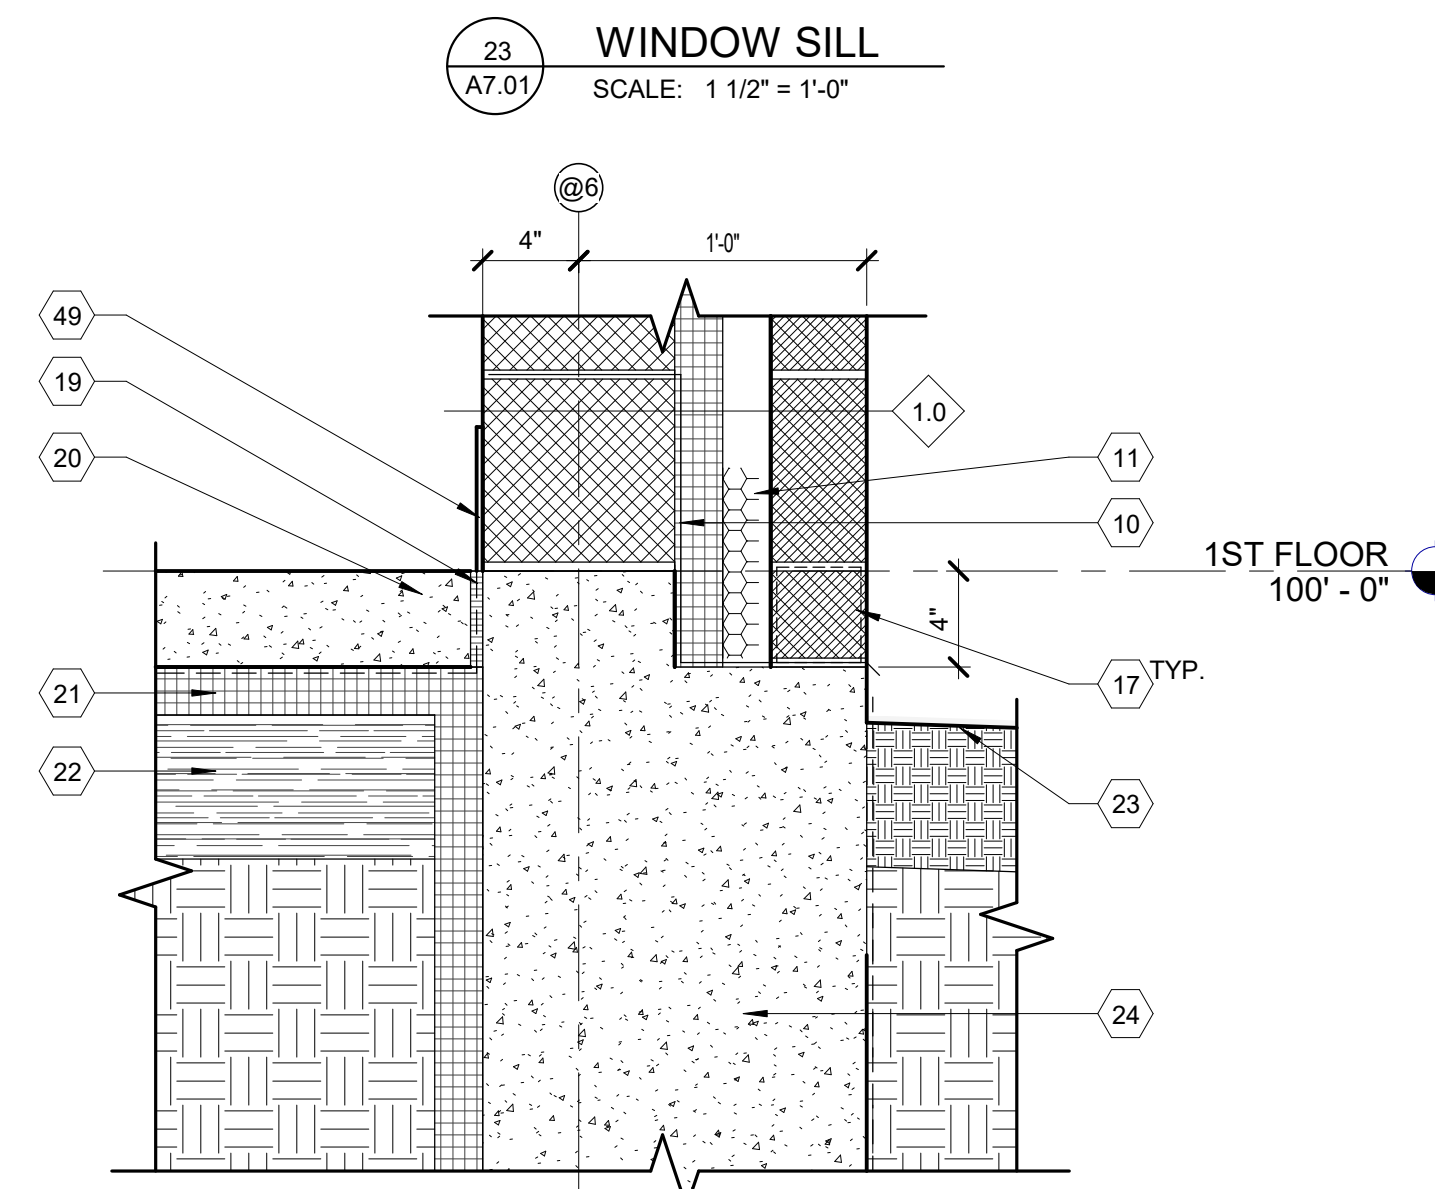

29 DETAIL @ GRADE
SCALE: 1 1/2" = 1'-0"

NOTE: WALL TYPES ARE INDICATED W/ A DIAMOND AND A NUMBER - REFER TO A0.01 FOR DESCRIPTION OF WALL TYPES

NOTE: ALL EXISTING ROOF WARRANTIES MUST BE MAINTAINED AT CONNECTION POINTS

MATERIAL KEYNOTES

- 1 EXISTING TO REMAIN
- 2 FULLY ADHERED SINGLE PLY MEMBRANE
- 3 3/4" ROOFING BOARD
- 4 RIGID ROOF INSULATION R-30
- 5 METAL DECK (REFER TO STRUCTURAL)
- 6 2x PRESSURE TREATED WOOD BLOCKING
- 7 SPRAY INSULATION IN METAL DECK FLUTES TO ALLOW FOR CONTINUOUS INSULATION
- 8 STEEL LINTEL - EXTERIOR STEEL LINTELS TO BE GALVANIZED - PAINT (REFER TO STRUCTURAL)
- 9 GROUT SOLID
- 10 THRU WALL FLASHING
- 11 MORTAR NET
- 12 FACE BRICK - MATCH EXISTING
- 13 8x24 BURNISHED BLOCK ACCENT BAND - MATCH EXISTING
- 14 8x24 SPLIT FACE BLOCK WAINSCOT - MATCH EXISTING
- 15 SEALANT OVER BACKER ROD EXTERIOR / CAULK INTERIOR - TYPICAL AT ALL WINDOWS AND DOORS
- 16 ALUMINUM WINDOW SYSTEM WITH INSULATED GLAZING
- 17 BRICK VENT
- 18 BULLNOSE
- 19 BOND BREAK
- 20 4" CONCRETE SLAB ON VAPOR BARRIER (REFER TO STRUCTURAL)
- 21 PERIMETER INSULATION - EXTEND 2'-0" IN BOTH DIRECTIONS
- 22 COMPACTED GRANULAR FILL
- 23 GRADE (REFER TO CIVIL)
- 24 POURED CONCRETE FOUNDATION WALL (REFER TO STRUCTURAL)
- 25 BITUMINOUS DAMPPROOFING
- 26 STEEL COLUMN (REFER TO STRUCTURAL)
- 27 RIGID INSULATION
- 28 CONTINUOUS METAL ROOF EDGE - MATCH EXISTING PROFILE - AT CONNECTION POINTS ALSO MATCH EXISTING HEIGHT (V.I.F.)
- 29 NEW FENCE (REFER TO CIVIL AND ELECTRICAL)
- 30 CONCRETE MASONRY UNIT
- 31 COLD FORMED METAL FRAMING
- 32 DOOR AND FRAME (REFER TO SCHEDULE)
- 33 2" EXPANSION JOINT / CONTROL JOINT AS REQUIRED - FIRE RATE AS REQUIRED (REFER TO CODE PLAN)
- 34 LIGHT FIXTURE (REFER TO ELECTRICAL)
- 35 MECHANICAL ITEM (REFER TO MECHANICAL)
- 36 POURED CONCRETE FOOTING (REFER TO STRUCTURAL)
- 37 STEEL ANGLE (REFER TO STRUCTURAL)
- 38 STEEL TUBE (REFER TO STRUCTURAL)
- 39 STEEL JOIST (REFER TO STRUCTURAL)
- 40 STEEL BEAM (REFER TO STRUCTURAL)
- 41 SUSPENDED CEILING SYSTEM (REFER TO SCHEDULE)
- 42 LOUVER (REFER TO MECHANICAL)
- 43 BOND BEAM WITH (2) #5 CONT. GROUT SOLID (REFER TO STRUCTURAL)
- 44 CMU FOUNDATION WALL (REFER TO STRUCTURAL)
- 45 ROOF LADDER - ATTACH AND FLASH AS REQUIRED PER MANUFACTURER'S RECOMMENDATIONS (REFER TO REFERENCE ONLY DETAIL)
- 46 WALL MOUNTED ELECTRICAL ITEM (REFER TO ELECTRICAL)
- 47 CEILING MOUNTED ELECTRICAL ITEM (REFER TO ELECTRICAL)
- 48 PLUMBING FIXTURE AND ACCESSORIES (REFER TO MECHANICAL & STANDARD MOUNTING HEIGHTS CHART)
- 49 BASE MATERIAL (REFER TO SCHEDULE)
- 50 CONTROL JOINT

NO.	REVISION	DATE

STATE OF MICHIGAN
DEPARTMENT OF TECHNOLOGY, MANAGEMENT AND BUDGET
FACILITIES AND BUSINESS SERVICES ADMINISTRATION
DESIGN AND CONSTRUCTION DIVISION
ADAM LACEL, R.A. DIRECTOR

FILE NO.
491/20167.SDW

FUNDING CODE
171CODHHS7255

CONTRACT NO.
Y22003

WTAARCH.COM

WTA ARCHITECTS

100 S Jefferson Ave, Suite 601
Saginaw, Michigan 48607
989 752 8107

PROJECT TITLE
491/20167.SDW - PHASE 500:
CENTER FOR FORENSIC
PSYCHIATRY - CREATE
KITCHEN

SALINE, MICHIGAN
SHEET TITLE
**WALL SECTIONS &
DETAILS**

PROJECT NUMBER
2021094

SHEET NUMBER
A7.01

PROJECT DATE
SEPTEMBER 6, 2023









CHECKED BY
C.D.S.

NOTE: WALL TYPES ARE INDICATED w/ A DIAMOND AND A NUMBER - REFER TO A0.01 FOR DESCRIPTION OF WALL TYPES

NOTE: ALL EXISTING ROOF WARRANTIES MUST BE MAINTAINED AT CONNECTION POINTS

MATERIAL KEYNOTES

- 1 EXISTING TO REMAIN
- 2 FULLY ADHERED SINGLE PLY MEMBRANE ROOFING
- 3 3/4" ROOFING BOARD
- 4 RIGID ROOF INSULATION R-30
- 5 METAL DECK (REFER TO STRUCTURAL)
- 6 2x PRESSURE TREATED WOOD BLOCKING
- 7 SPRAY INSULATION IN METAL DECK FLUTES TO ALLOW FOR CONTINUOUS INSULATION
- 8 STEEL LINTEL - EXTERIOR STEEL LINTELS TO BE GALVANIZED - PAINT (REFER TO STRUCTURAL)
- 9 GROUT SOLID
- 10 THRU WALL FLASHING
- 11 MORTAR NET
- 12 FACE BRICK - MATCH EXISTING
- 13 8x24 BURNISHED BLOCK ACCENT BAND - MATCH EXISTING
- 14 8x24 SPLIT FACE BLOCK WAINSCOT - MATCH EXISTING
- 15 SEALANT OVER BACKER ROD EXTERIOR / CAULK INTERIOR - TYPICAL AT ALL WINDOWS AND DOORS
- 16 ALUMINUM WINDOW SYSTEM WITH INSULATED GLAZING
- 17 BRICK VENT
- 18 BULLNOSE
- 19 BOND BREAK
- 20 4" CONCRETE SLAB ON VAPOR BARRIER (REFER TO STRUCTURAL)
- 21 PERIMETER INSULATION - EXTEND 2'-0" IN BOTH DIRECTIONS
- 22 COMPACTED GRANULAR FILL
- 23 GRADE (REFER TO CIVIL)
- 24 POURED CONCRETE FOUNDATION WALL (REFER TO STRUCTURAL)
- 25 BITUMINOUS DAMPPROOFING
- 26 STEEL COLUMN (REFER TO STRUCTURAL)
- 27 RIGID INSULATION
- 28 CONTINUOUS METAL ROOF EDGE - MATCH EXISTING PROFILE - AT CONNECTION POINTS ALSO MATCH EXISTING HEIGHT (V.I.F.)
- 29 NEW FENCE (REFER TO CIVIL AND ELECTRICAL)
- 30 CONCRETE MASONRY UNIT
- 31 COLD FORMED METAL FRAMING
- 32 DOOR AND FRAME (REFER TO SCHEDULE)
- 33 2" EXPANSION JOINT / CONTROL JOINT AS REQUIRED - FIRE RATE AS REQUIRED (REFER TO CODE PLAN)
- 34 LIGHT FIXTURE (REFER TO ELECTRICAL)
- 35 MECHANICAL ITEM (REFER TO MECHANICAL)
- 36 POURED CONCRETE FOOTING (REFER TO STRUCTURAL)
- 37 STEEL ANGLE (REFER TO STRUCTURAL)
- 38 STEEL TUBE (REFER TO STRUCTURAL)
- 39 STEEL JOIST (REFER TO STRUCTURAL)
- 40 STEEL BEAM (REFER TO STRUCTURAL)
- 41 SUSPENDED CEILING SYSTEM (REFER TO SCHEDULE)
- 42 LOUVER (REFER TO MECHANICAL)
- 43 BOND BEAM WITH (2) #5 CONT. GROUT SOLID (REFER TO STRUCTURAL)
- 44 CMU FOUNDATION WALL (REFER TO STRUCTURAL)
- 45 ROOF LADDER - ATTACH AND FLASH AS REQUIRED PER MANUFACTURER'S RECOMMENDATIONS (REFER TO REFERENCE ONLY DETAIL)
- 46 WALL MOUNTED ELECTRICAL ITEM (REFER TO ELECTRICAL)
- 47 CEILING MOUNTED ELECTRICAL ITEM (REFER TO ELECTRICAL)
- 48 PLUMBING FIXTURE AND ACCESSORIES (REFER TO MECHANICAL & STANDARD MOUNTING HEIGHTS CHART)
- 49 BASE MATERIAL (REFER TO SCHEDULE)
- 50 CONTROL JOINT

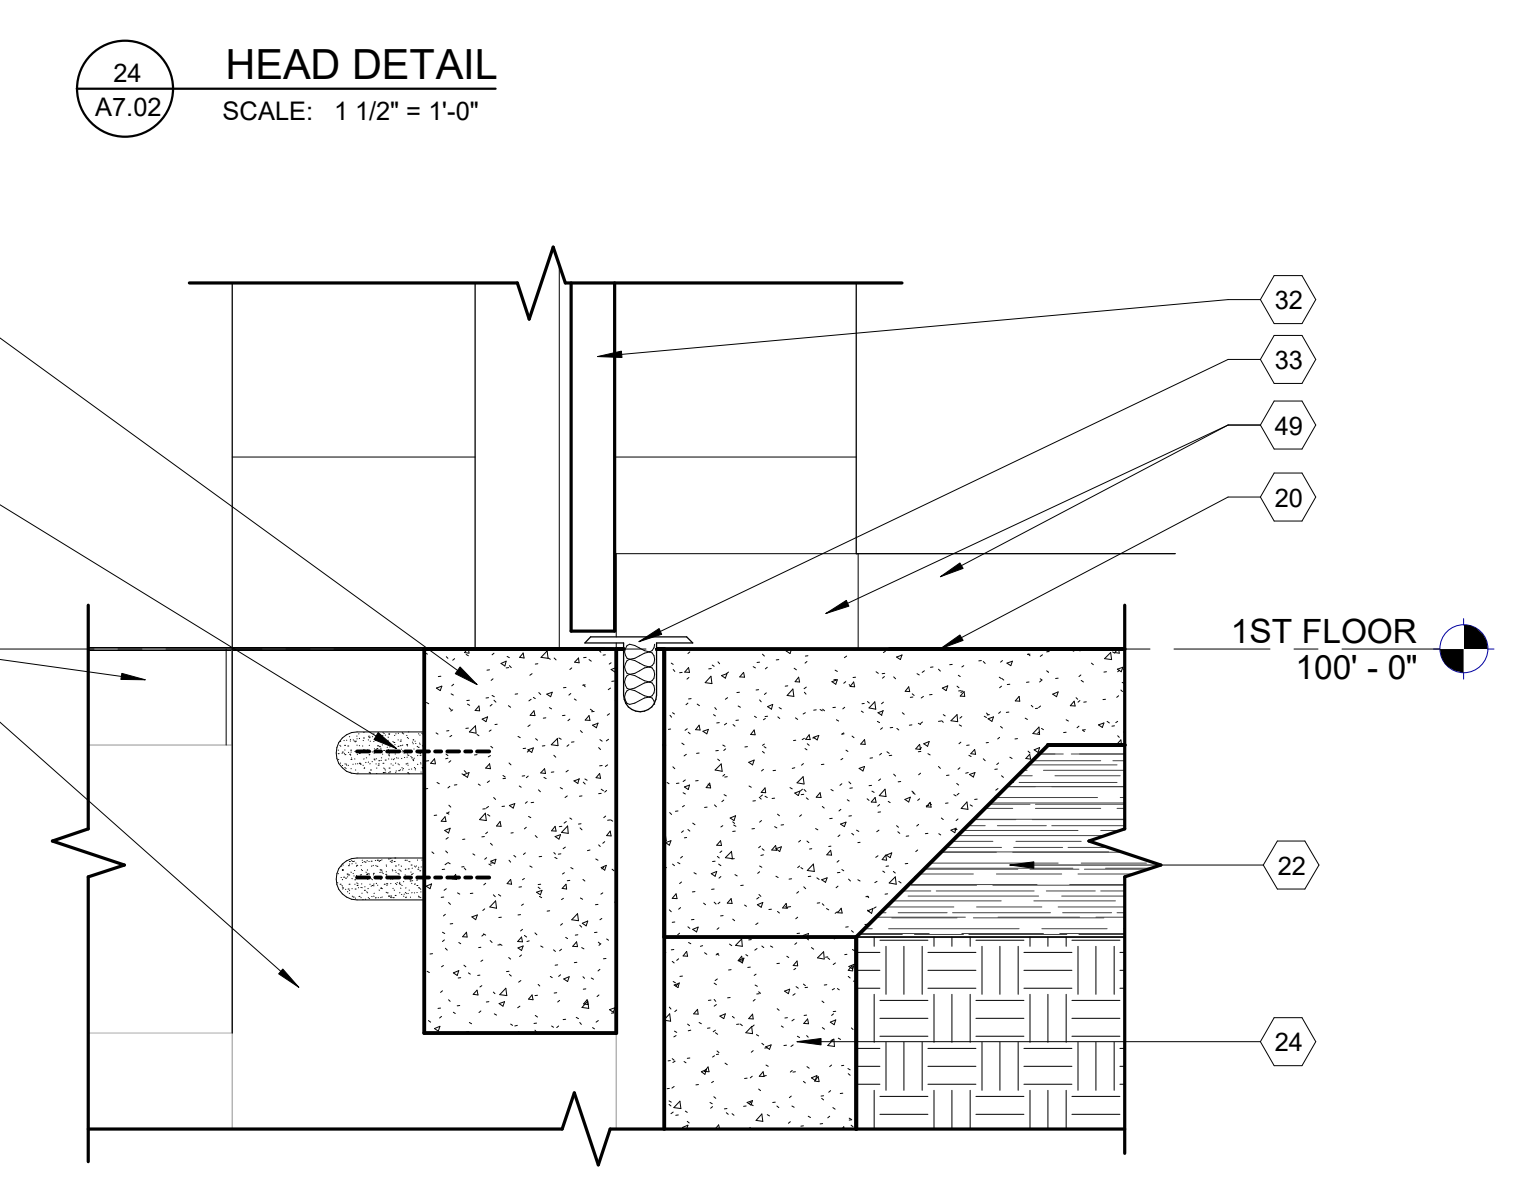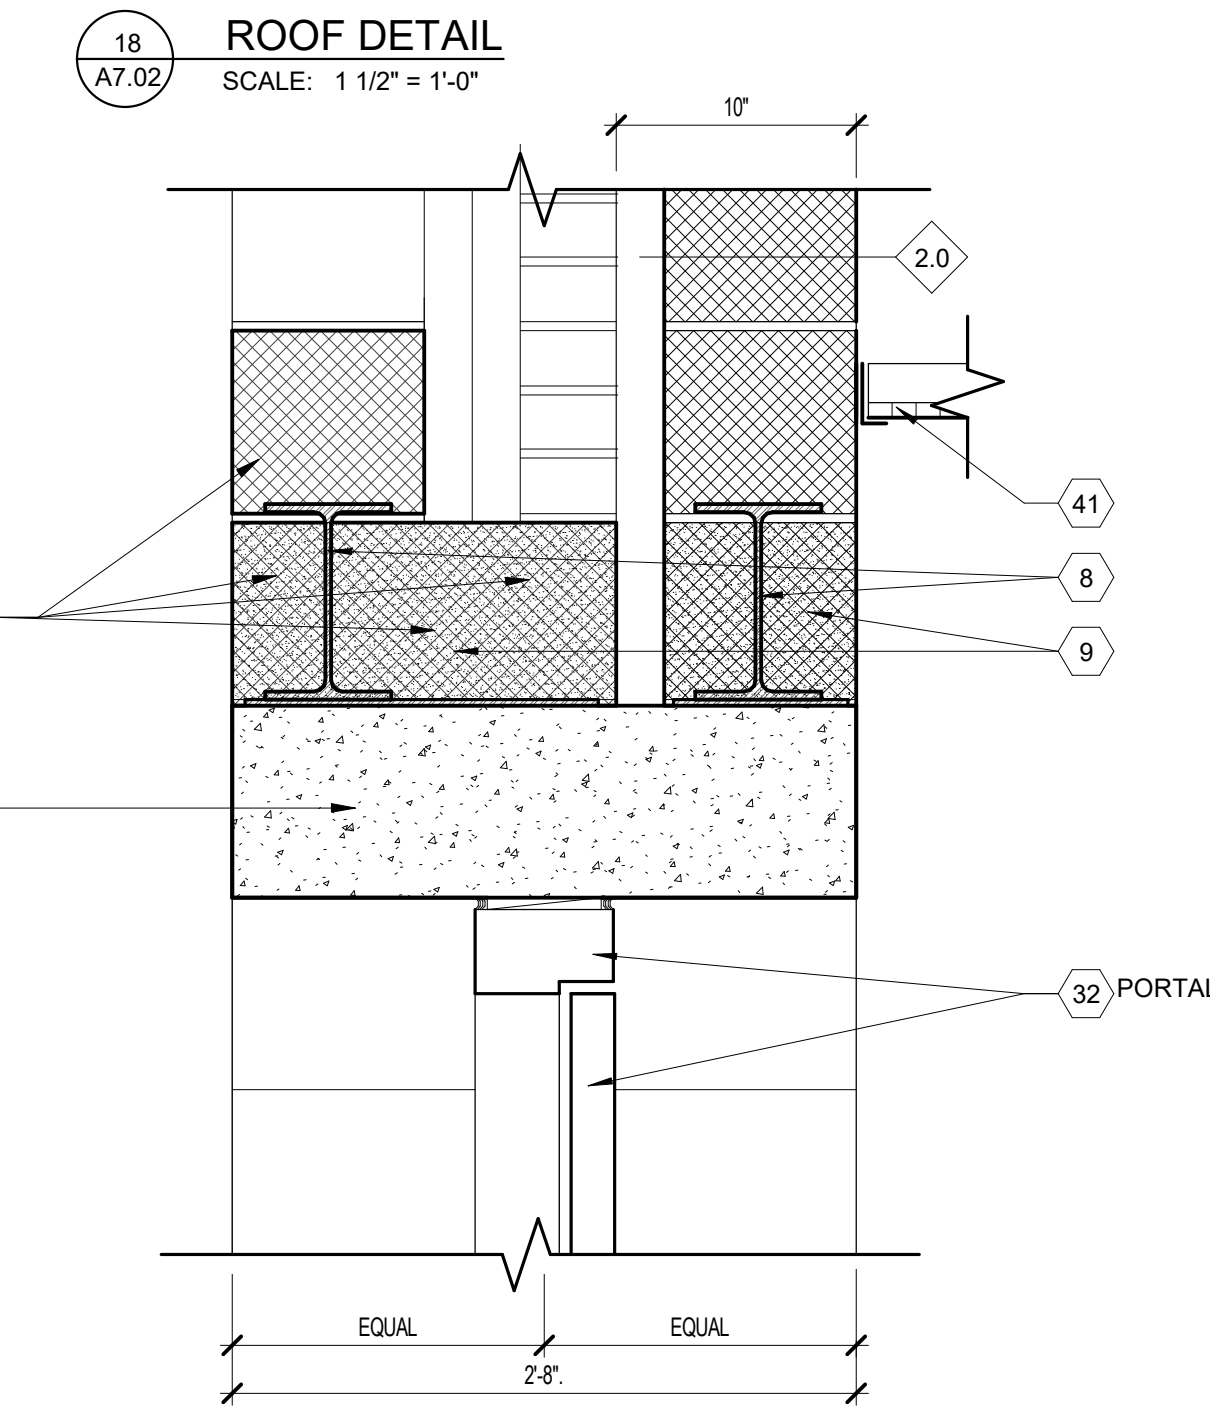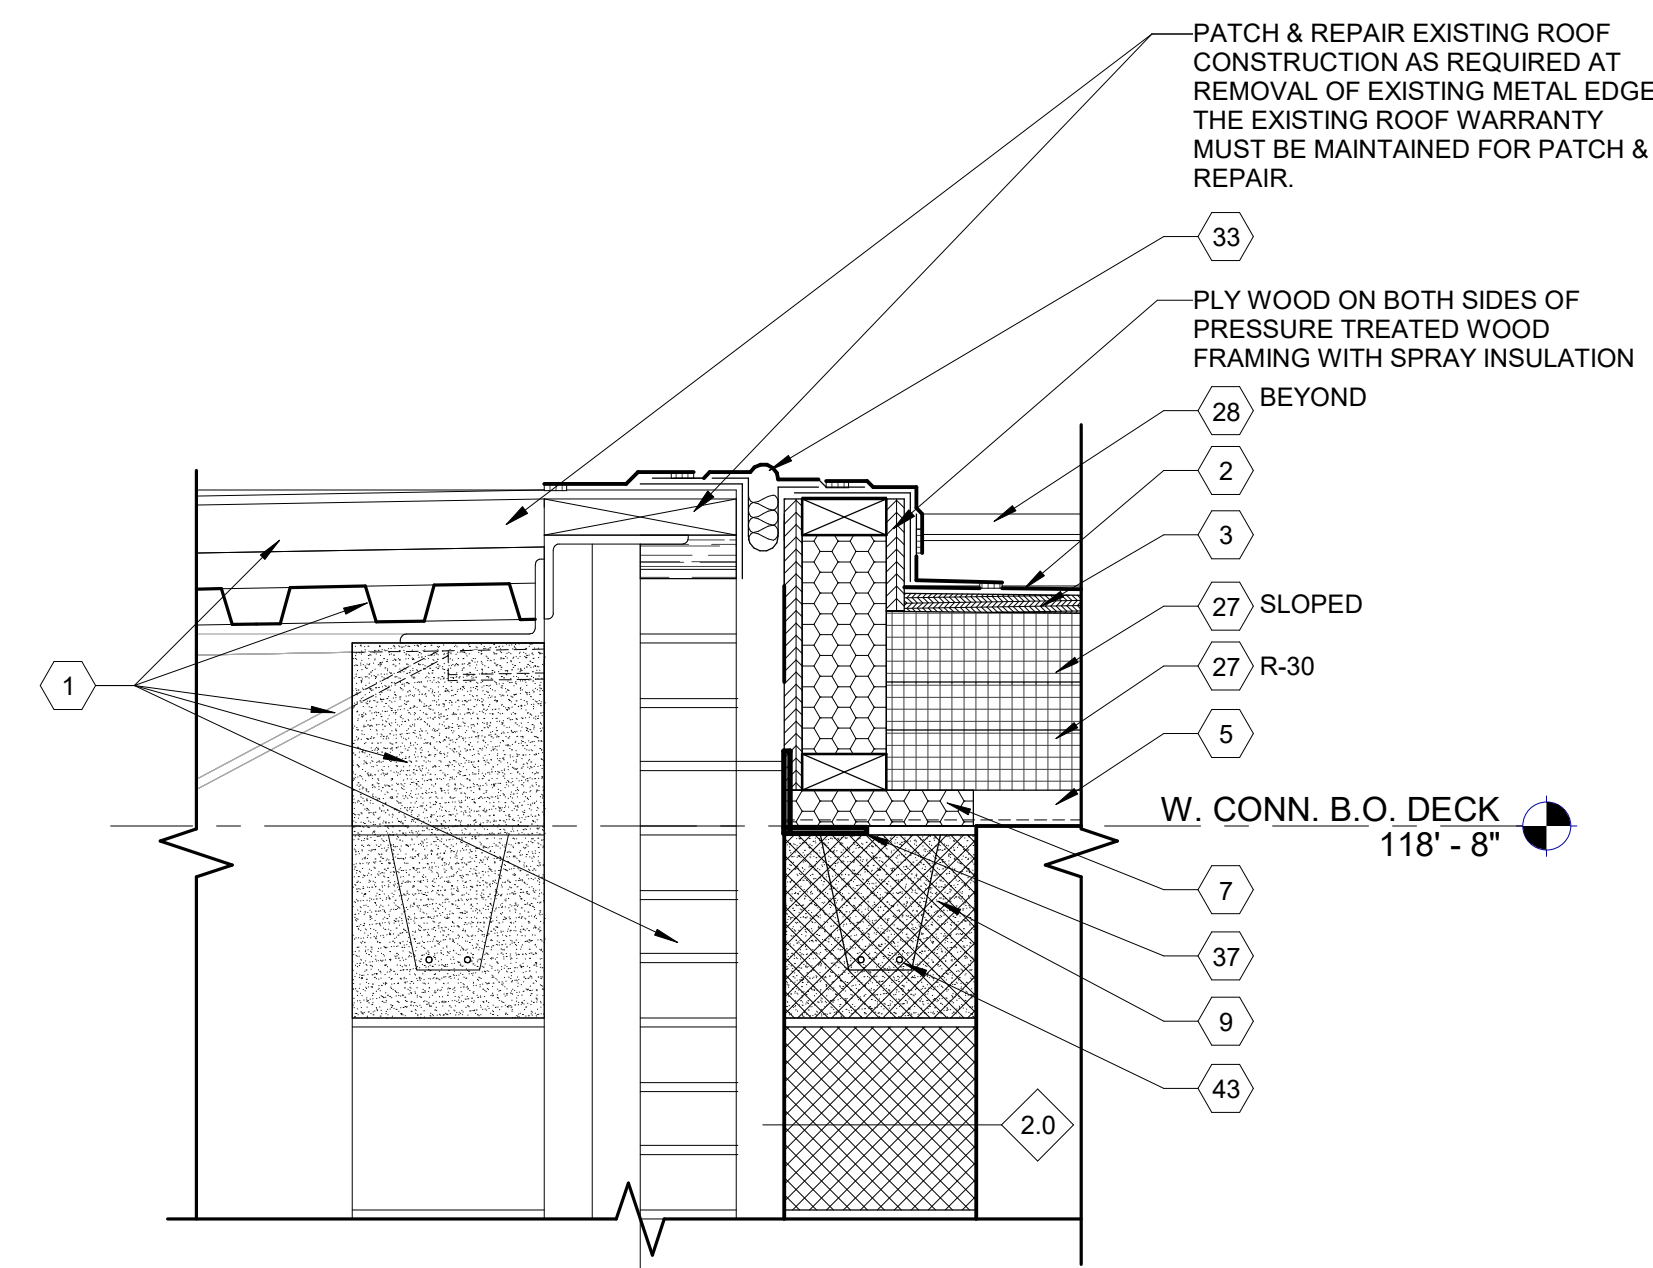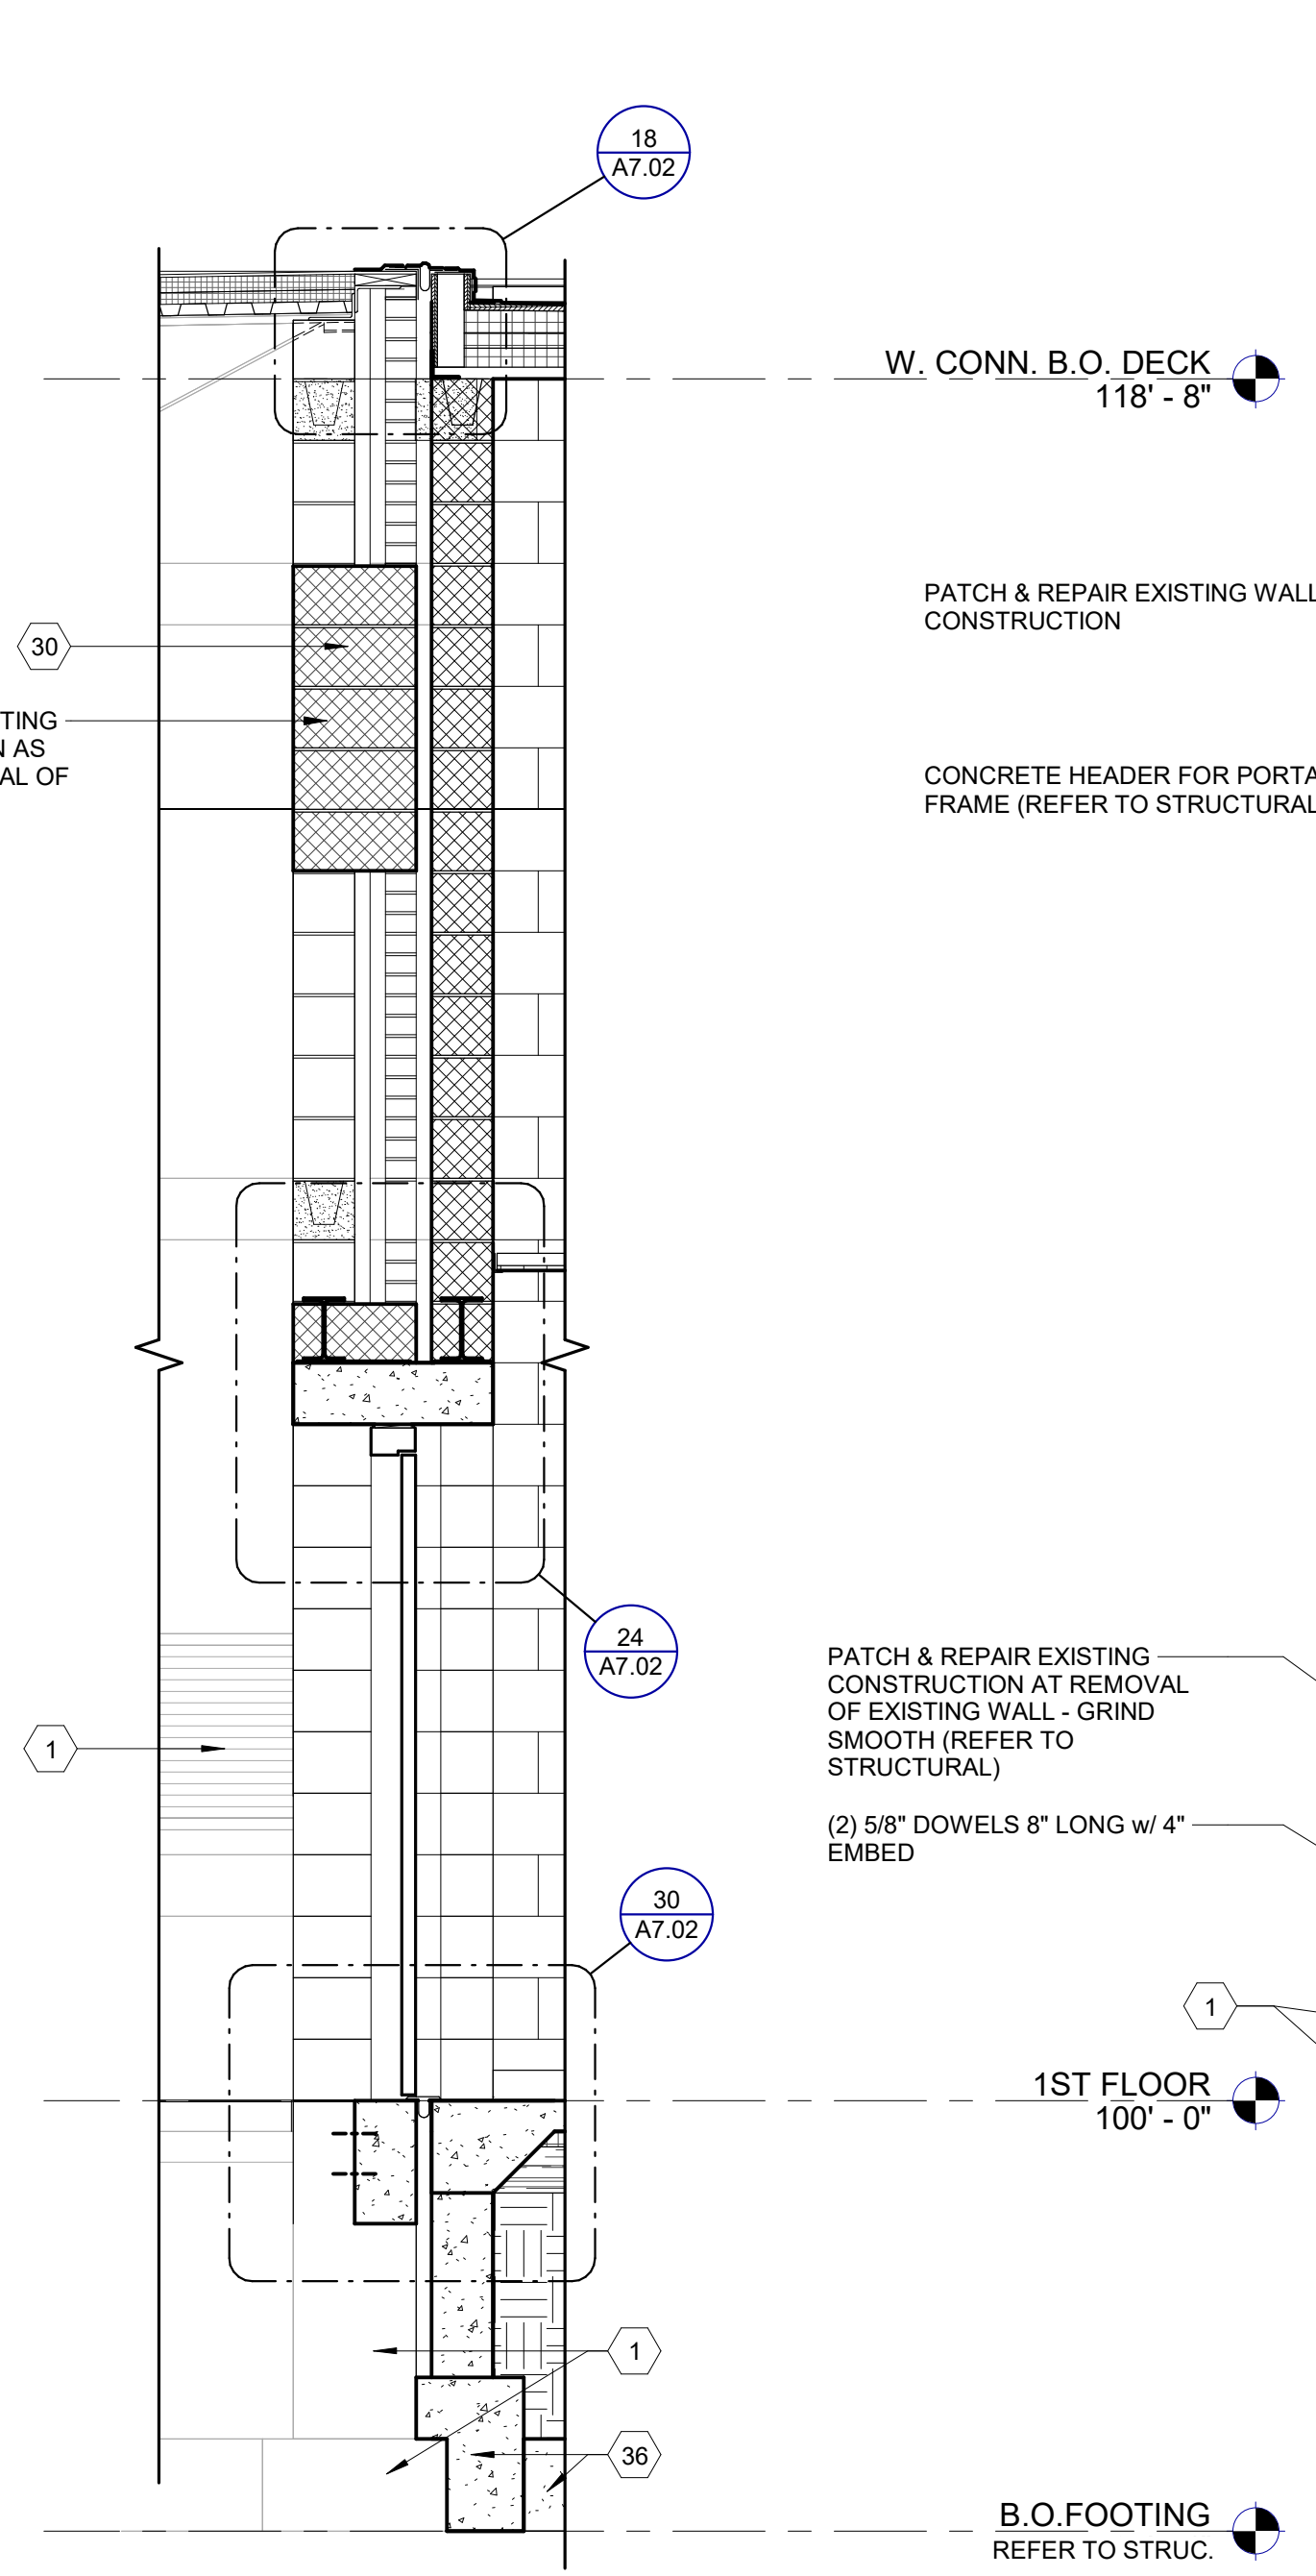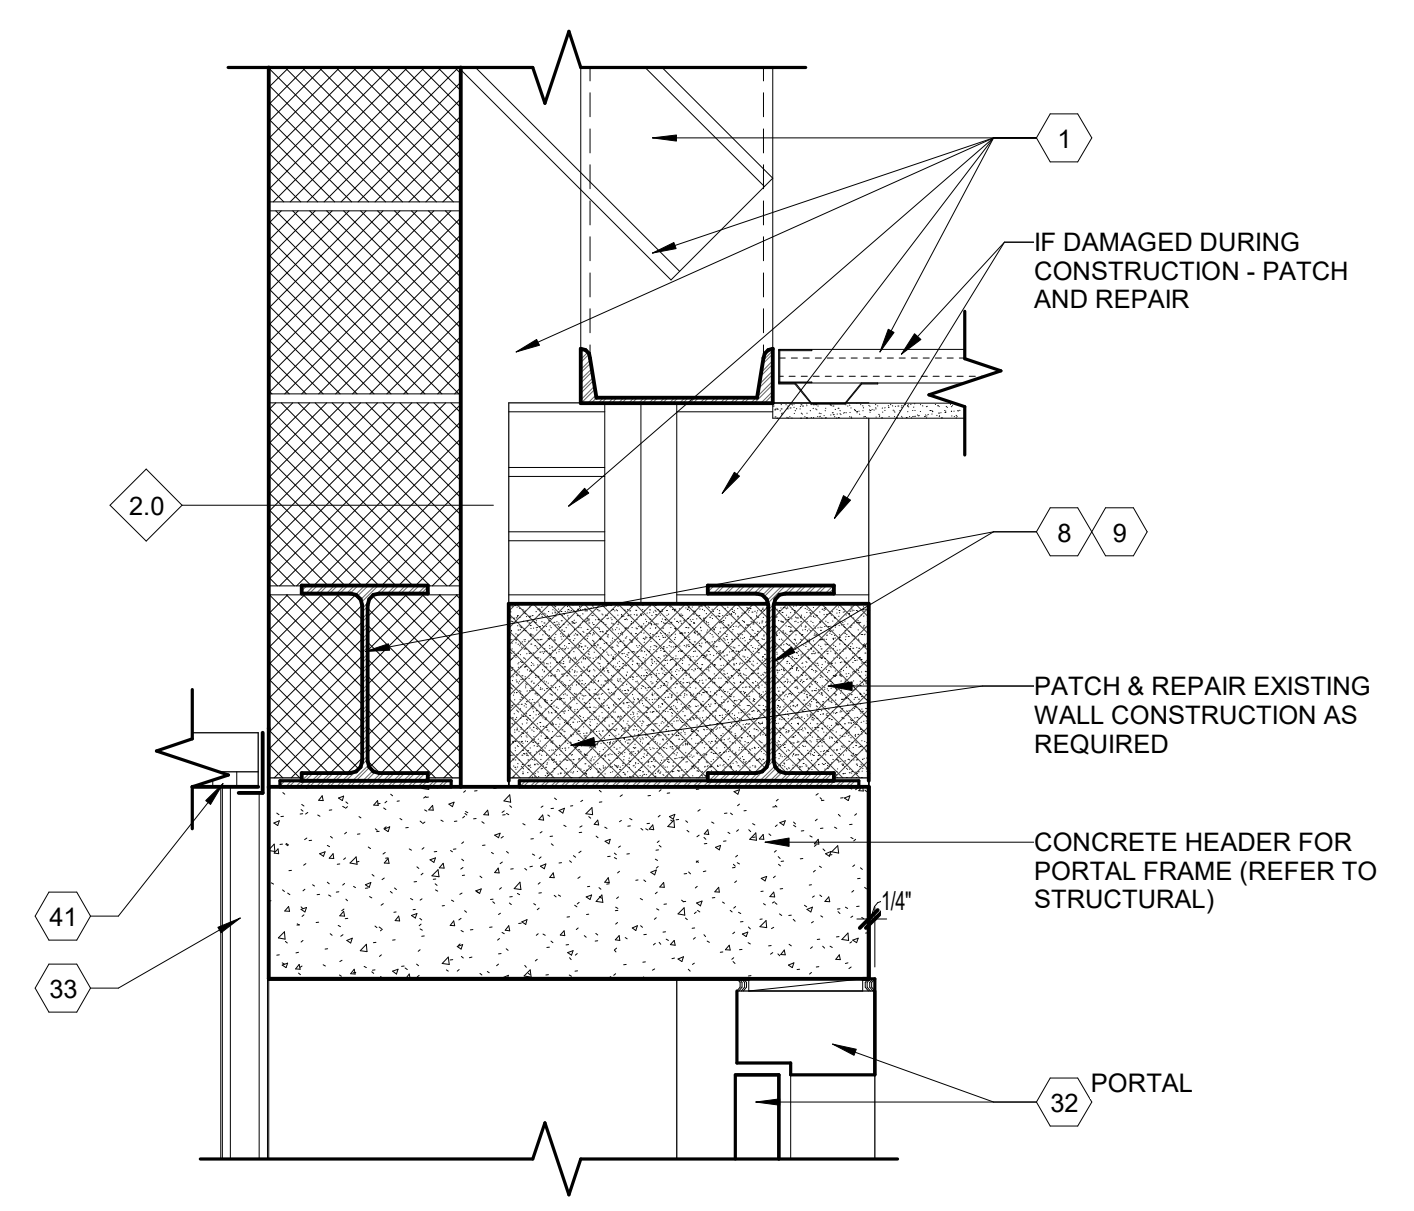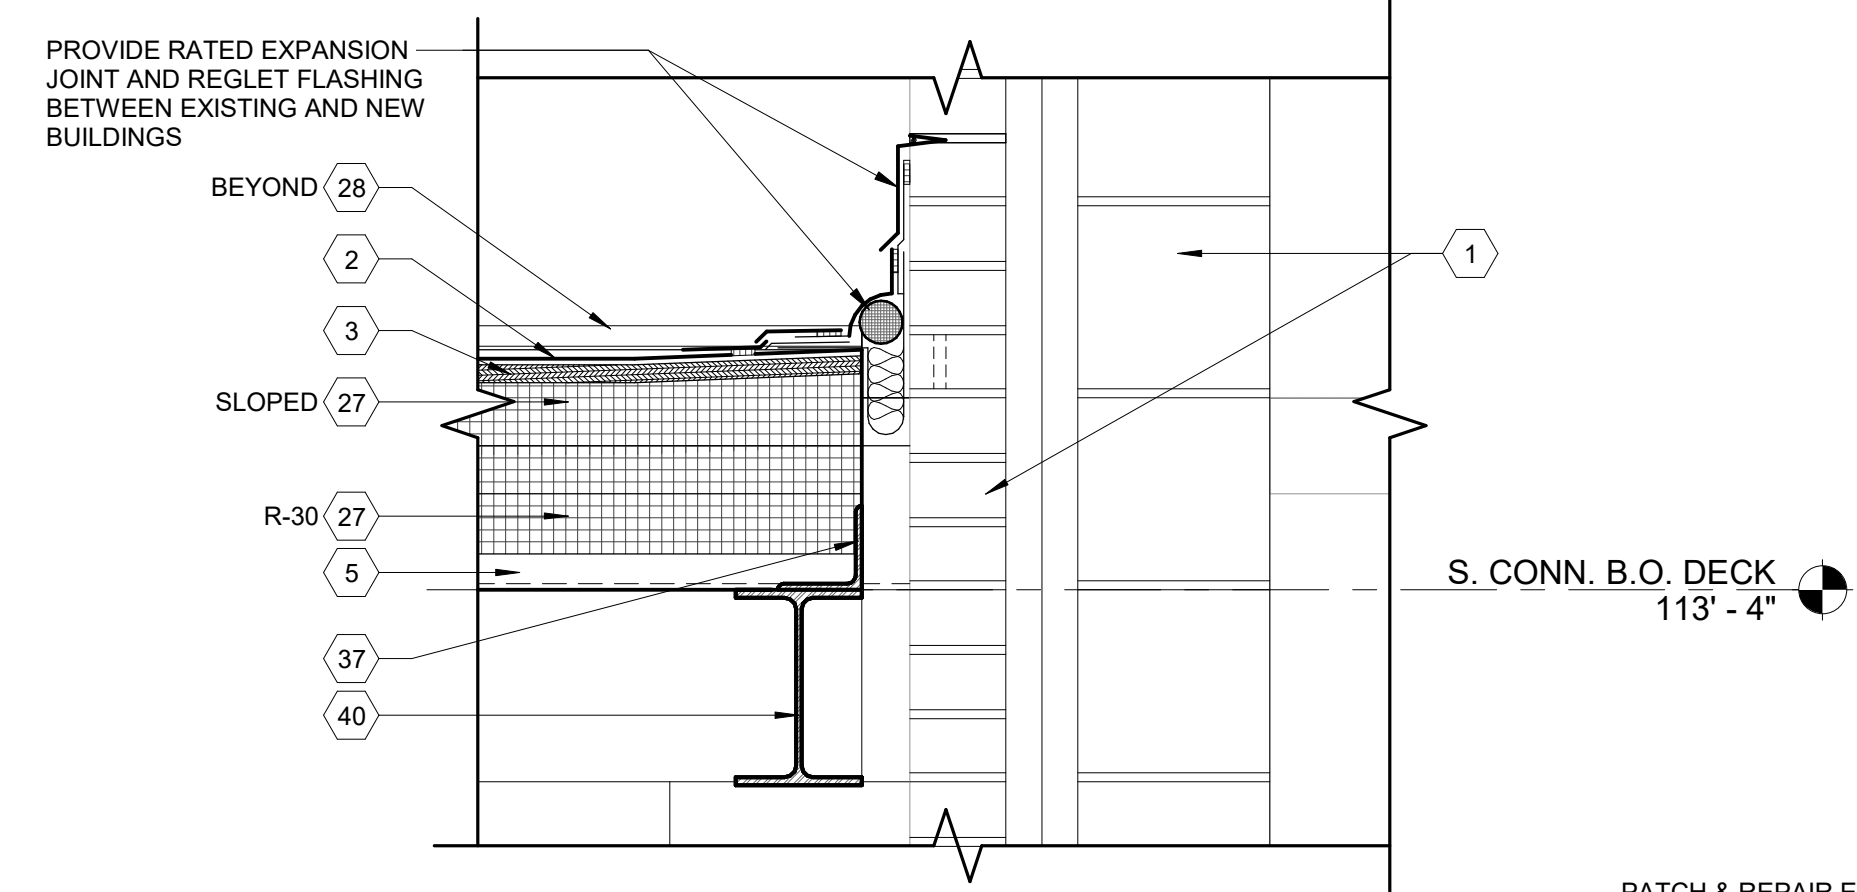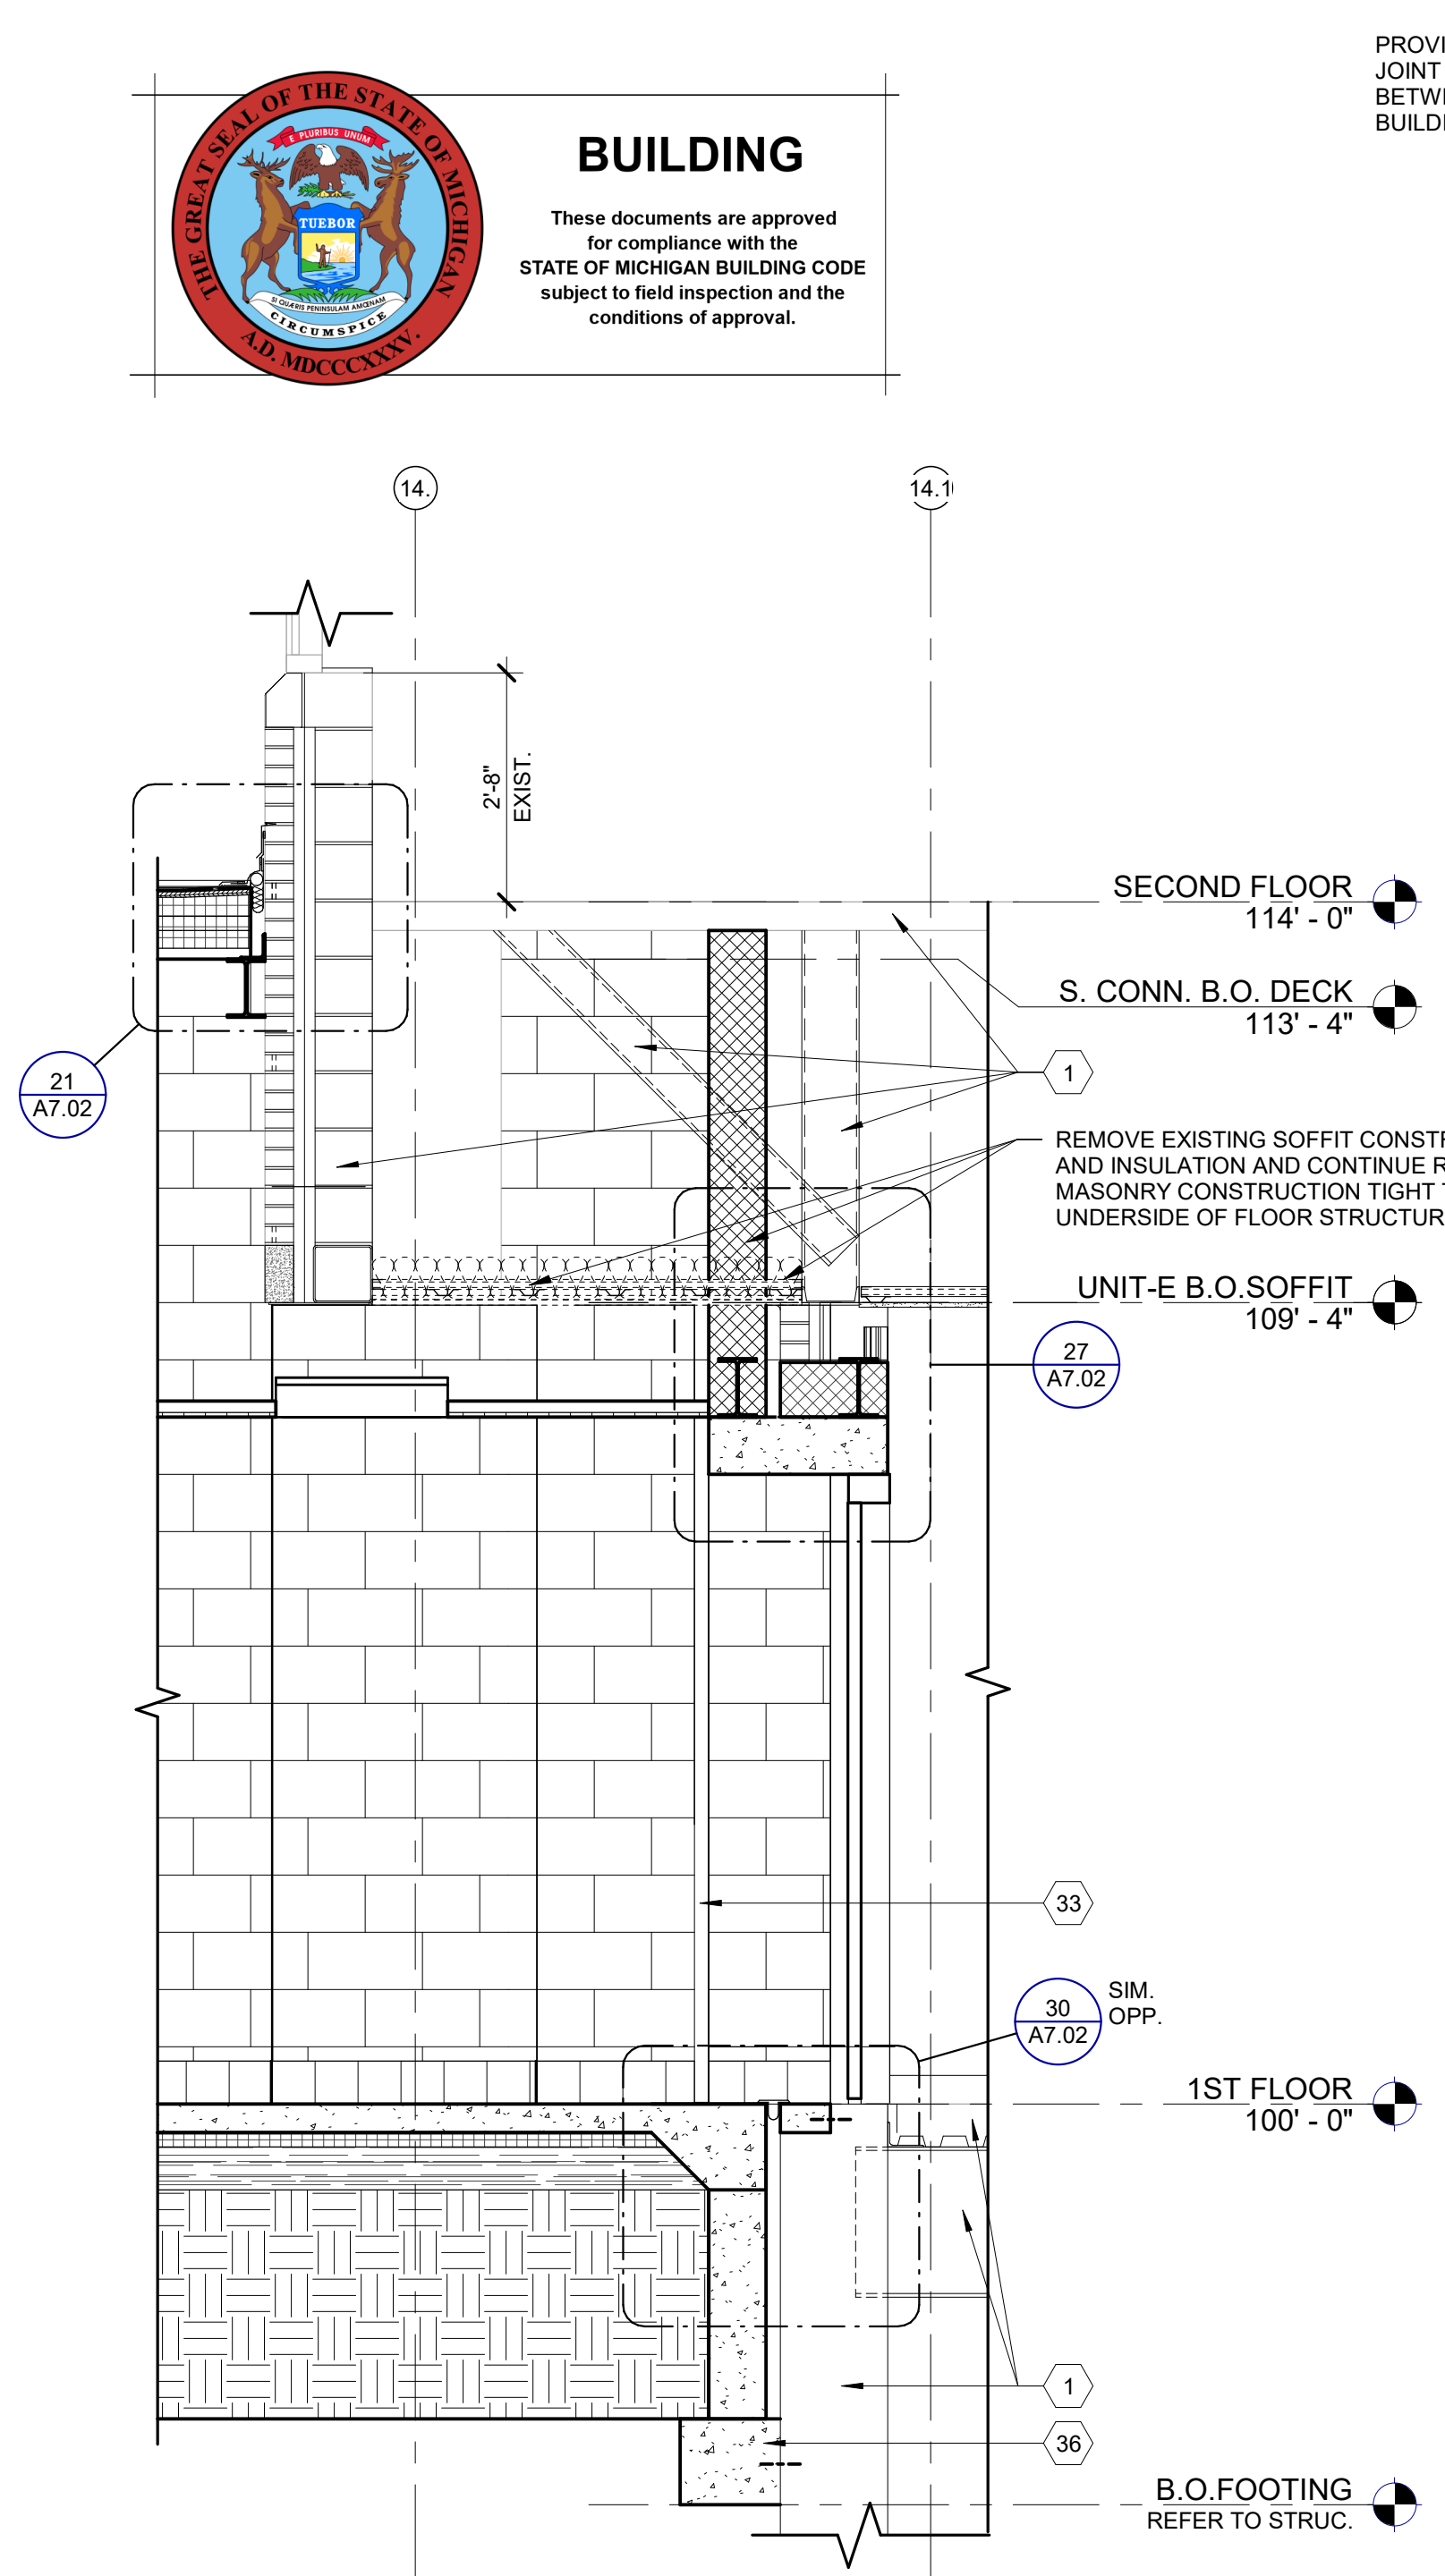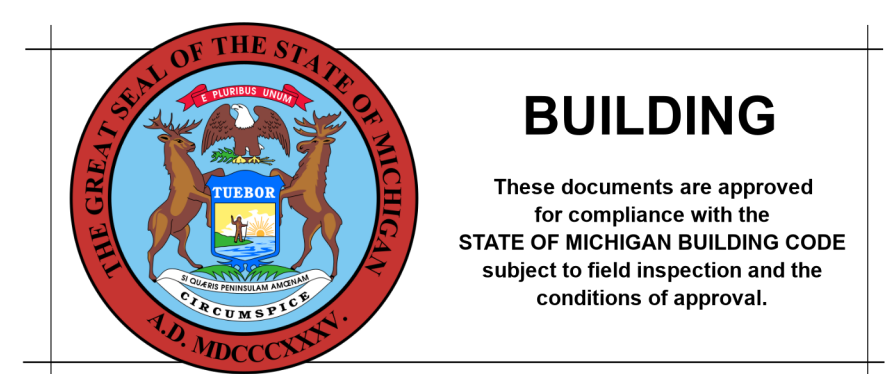

NO.	REVISION	DATE

STATE OF MICHIGAN
DEPARTMENT OF TECHNOLOGY, MANAGEMENT AND BUDGET
FACILITIES AND BUSINESS SERVICES ADMINISTRATION
DESIGN AND CONSTRUCTION DIVISION
ADAM LACEL, R.A. DIRECTOR

FILE NO.
491/20167.SDW

FUNDING CODE
171CODHHS7255

CONTRACT NO.
Y22003

WTA ARCHITECTS
100 S Jefferson Ave, Suite 601
Saginaw, Michigan 48607
989 752 8107
COPYRIGHT © 2023

PROJECT TITLE
491/20167.SDW - PHASE 500:
CENTER FOR FORENSIC
PSYCHIATRY - CREATE
KITCHEN
SALINE, MICHIGAN


SHEET TITLE
**WALL SECTIONS &
DETAILS**

PROJECT NUMBER
2021094

PROJECT DATE
SEPTEMBER 6, 2023

CHECKED BY
C.D.S.


SHEET NUMBER
A7.02

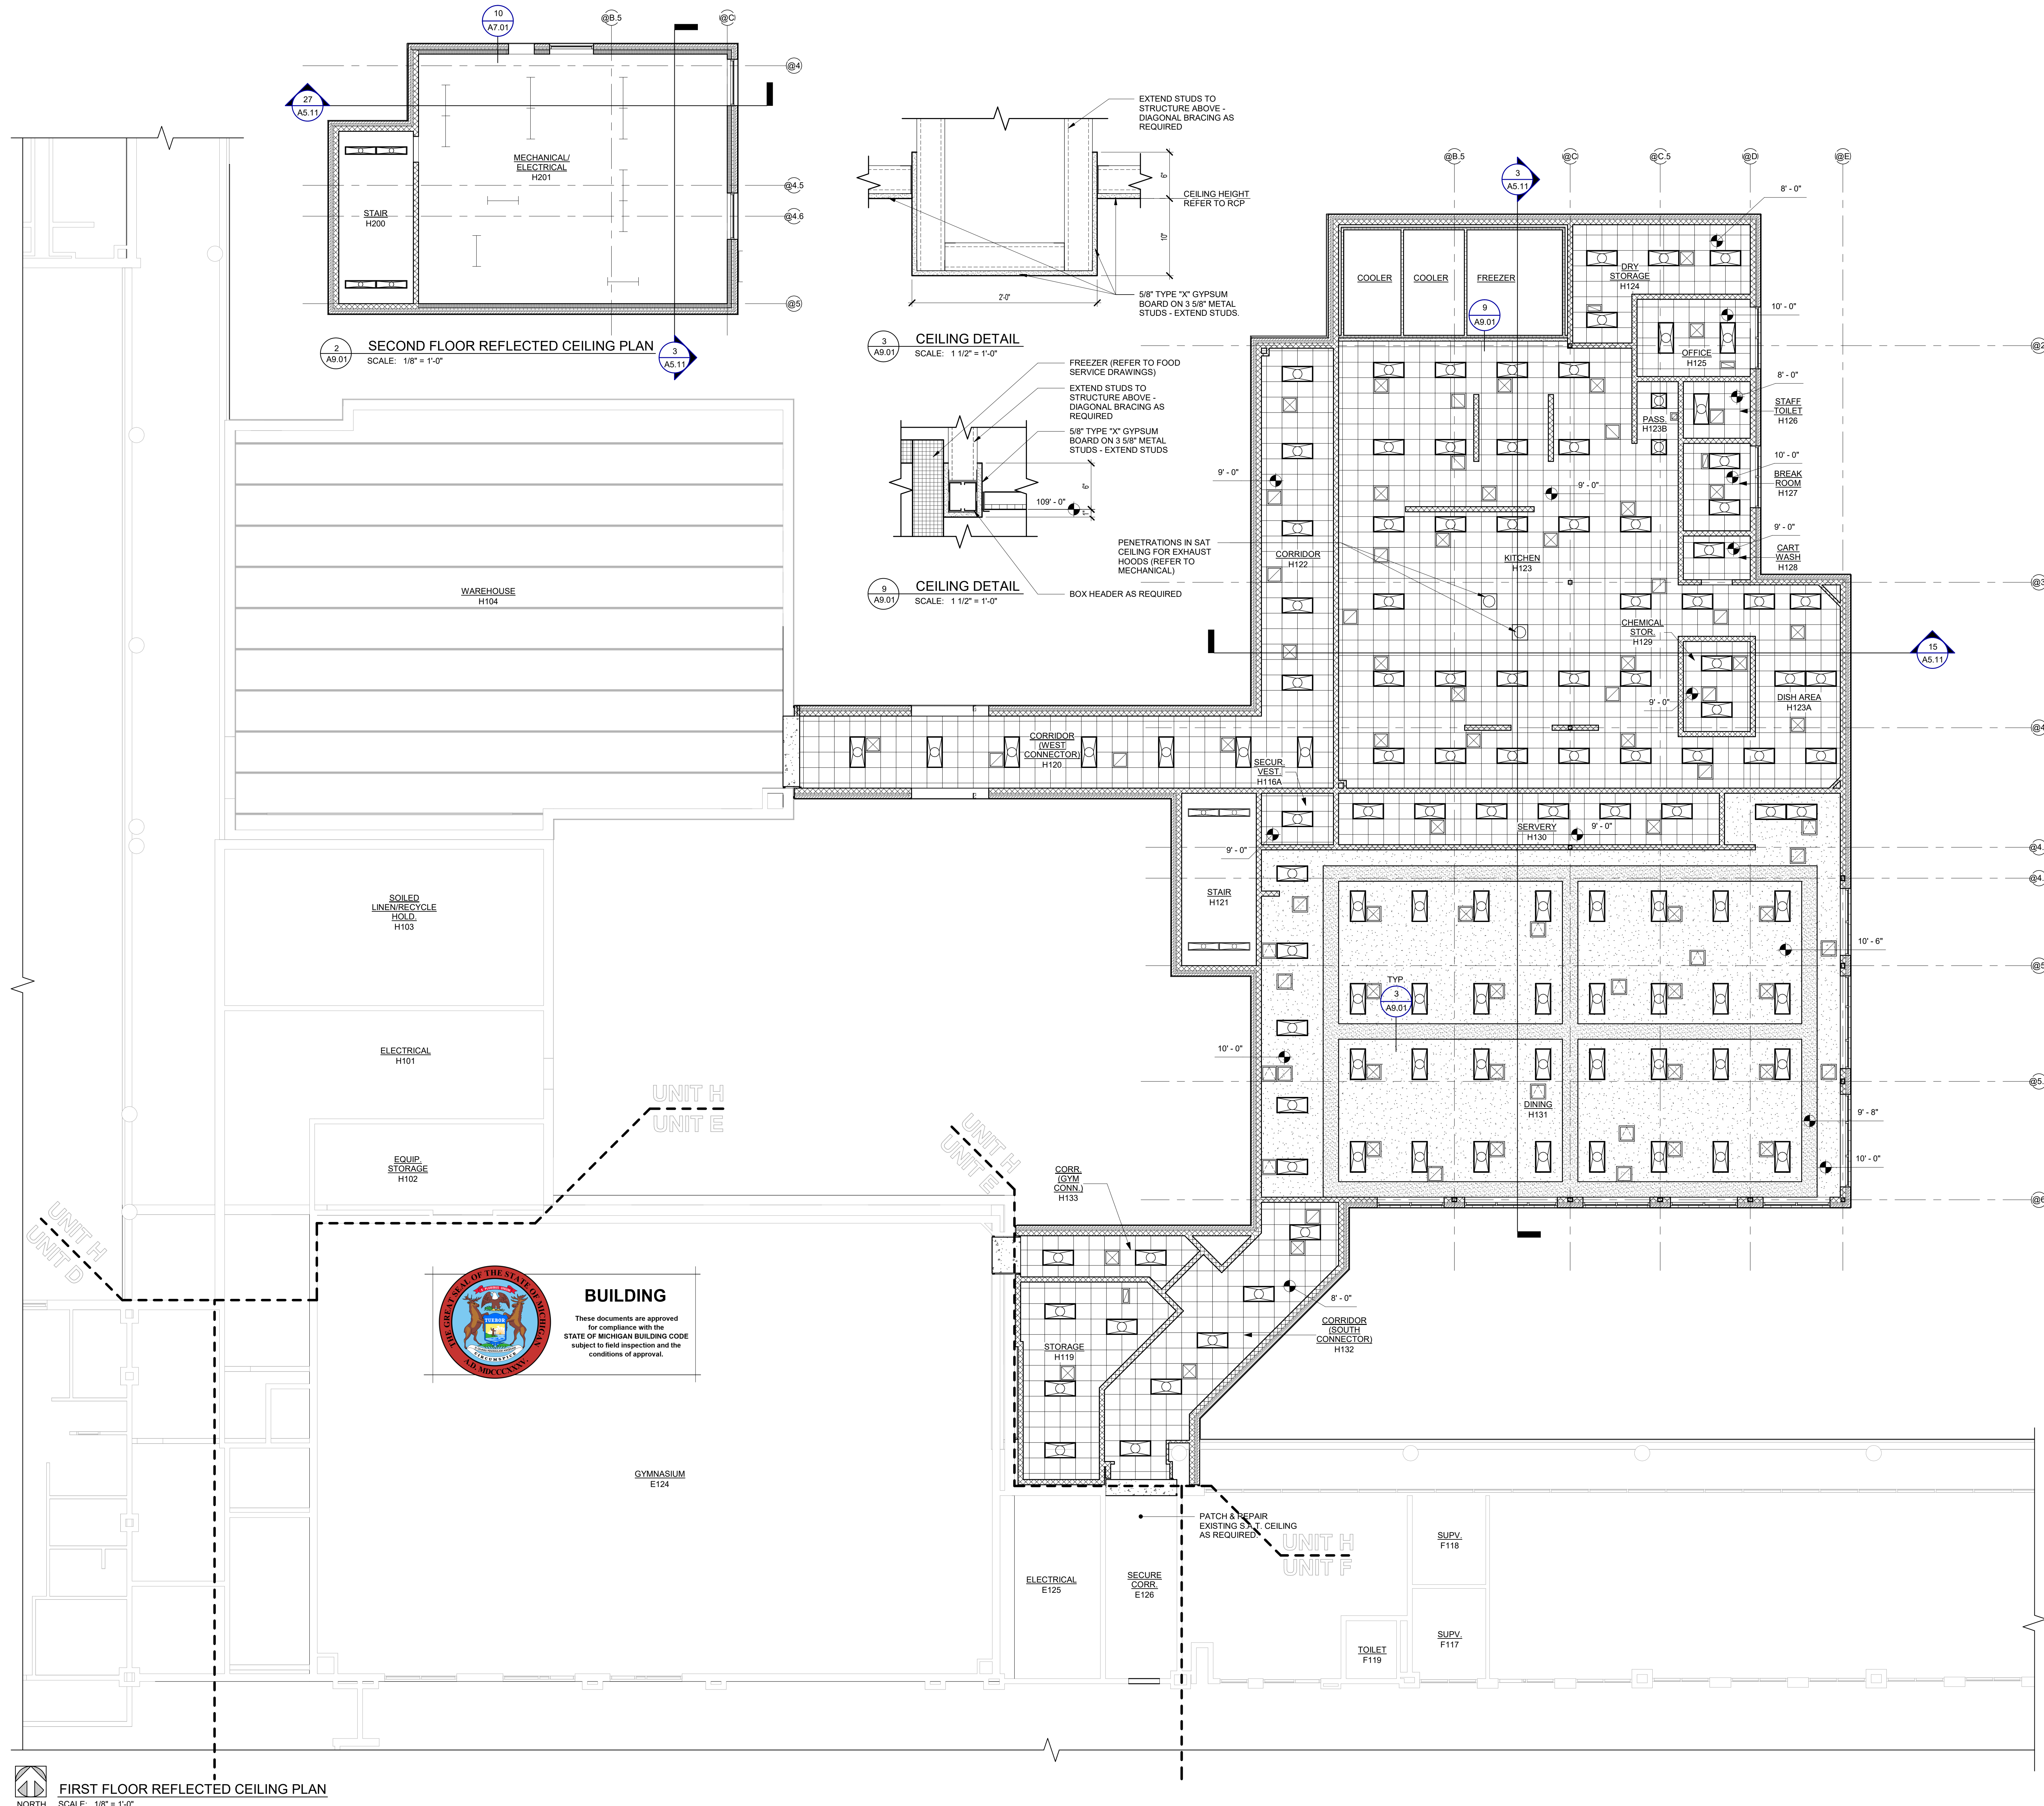

2 SECOND FLOOR REFLECTED CEILING PLAN
SCALE: 1/8" = 1'-0"

3 CEILING DETAIL
SCALE: 1 1/2" = 1'-0"

9 CEILING DETAIL
SCALE: 1 1/2" = 1'-0"

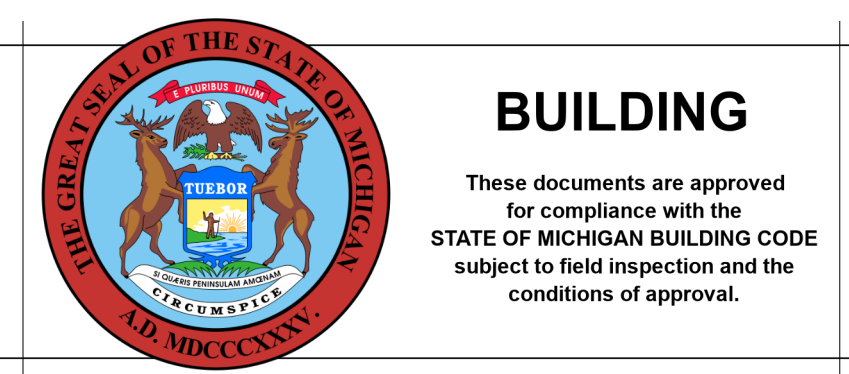

1 FIRST FLOOR REFLECTED CEILING PLAN
SCALE: 1/8" = 1'-0"

REFLECTED CEILING LEGEND:

- LIGHT FIXTURES (REFER TO ELECTRICAL)
- SUPPLY AIR GRILLE (REFER TO MECHANICAL)
- RETURN AIR GRILLE / EXHAUST FAN (REFER TO MECHANICAL)
- CEILING ACCESS PANEL - COORDINATE LOCATIONS WHERE CEILING ACCESS IS REQUIRED

GENERAL CEILING NOTES:

1. COORDINATE INSTALLATION OF SUSPENDED CEILING SYSTEM WITH MECHANICAL AND ELECTRICAL SYSTEMS.
2. POSITION LIGHT FIXTURES IN CENTER OF CEILING TILES UNLESS NOTED OR DIMENSIONED OTHERWISE.
3. REFERENCE SPECIFICATIONS FOR SUSPENDED CEILING SYSTEM DESCRIPTION AND LOCATION REQUIREMENTS.
4. ELECTRICAL FIXTURES ARE SHOWN FOR LOCATION REFERENCE ONLY. REFER TO ELECTRICAL DRAWINGS AND SPECIFICATIONS FOR DETAILS.
5. FIRE DEVICES AND EXIT LIGHTING NOT INDICATED ON ARCHITECTURAL DRAWINGS. REFER TO ELECTRICAL DRAWINGS FOR LOCATION, DETAILS, AND SPECIFICATIONS.
6. PROVIDE S.A.T. HOLD DOWN CLIPS AT EXTERIOR DOORS.


NO.	REVISION	DATE

STATE OF MICHIGAN
DEPARTMENT OF TECHNOLOGY, MANAGEMENT AND BUDGET
FACILITIES AND BUSINESS SERVICES ADMINISTRATION
DESIGN AND CONSTRUCTION DIVISION
ADAM LACR, R.A. DIRECTOR

FILE NO.
491/20167.SDW

FUNDING CODE
171CODHHS7255

CONTRACT NO.
Y22003

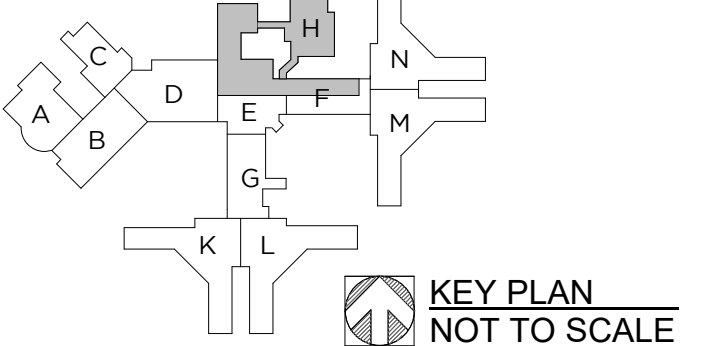

WTAARCH.COM

WTA ARCHITECTS

100 S Jefferson Ave, Suite 601
Saginaw, Michigan 48607
989 752 8107

COPYRIGHT © 2023

PROJECT TITLE
491/20167.SDW - PHASE 500:

CENTER FOR FORENSIC PSYCHIATRY - CREATE KITCHEN

SALINE, MICHIGAN


SHEET TITLE
FIRST & SECOND FLOOR REFLECTED CEILING PLAN

PROJECT NUMBER
2021094

PROJECT DATE
SEPTEMBER 6, 2023

CHECKED BY
C.D.S.

SHEET NUMBER
A9.01

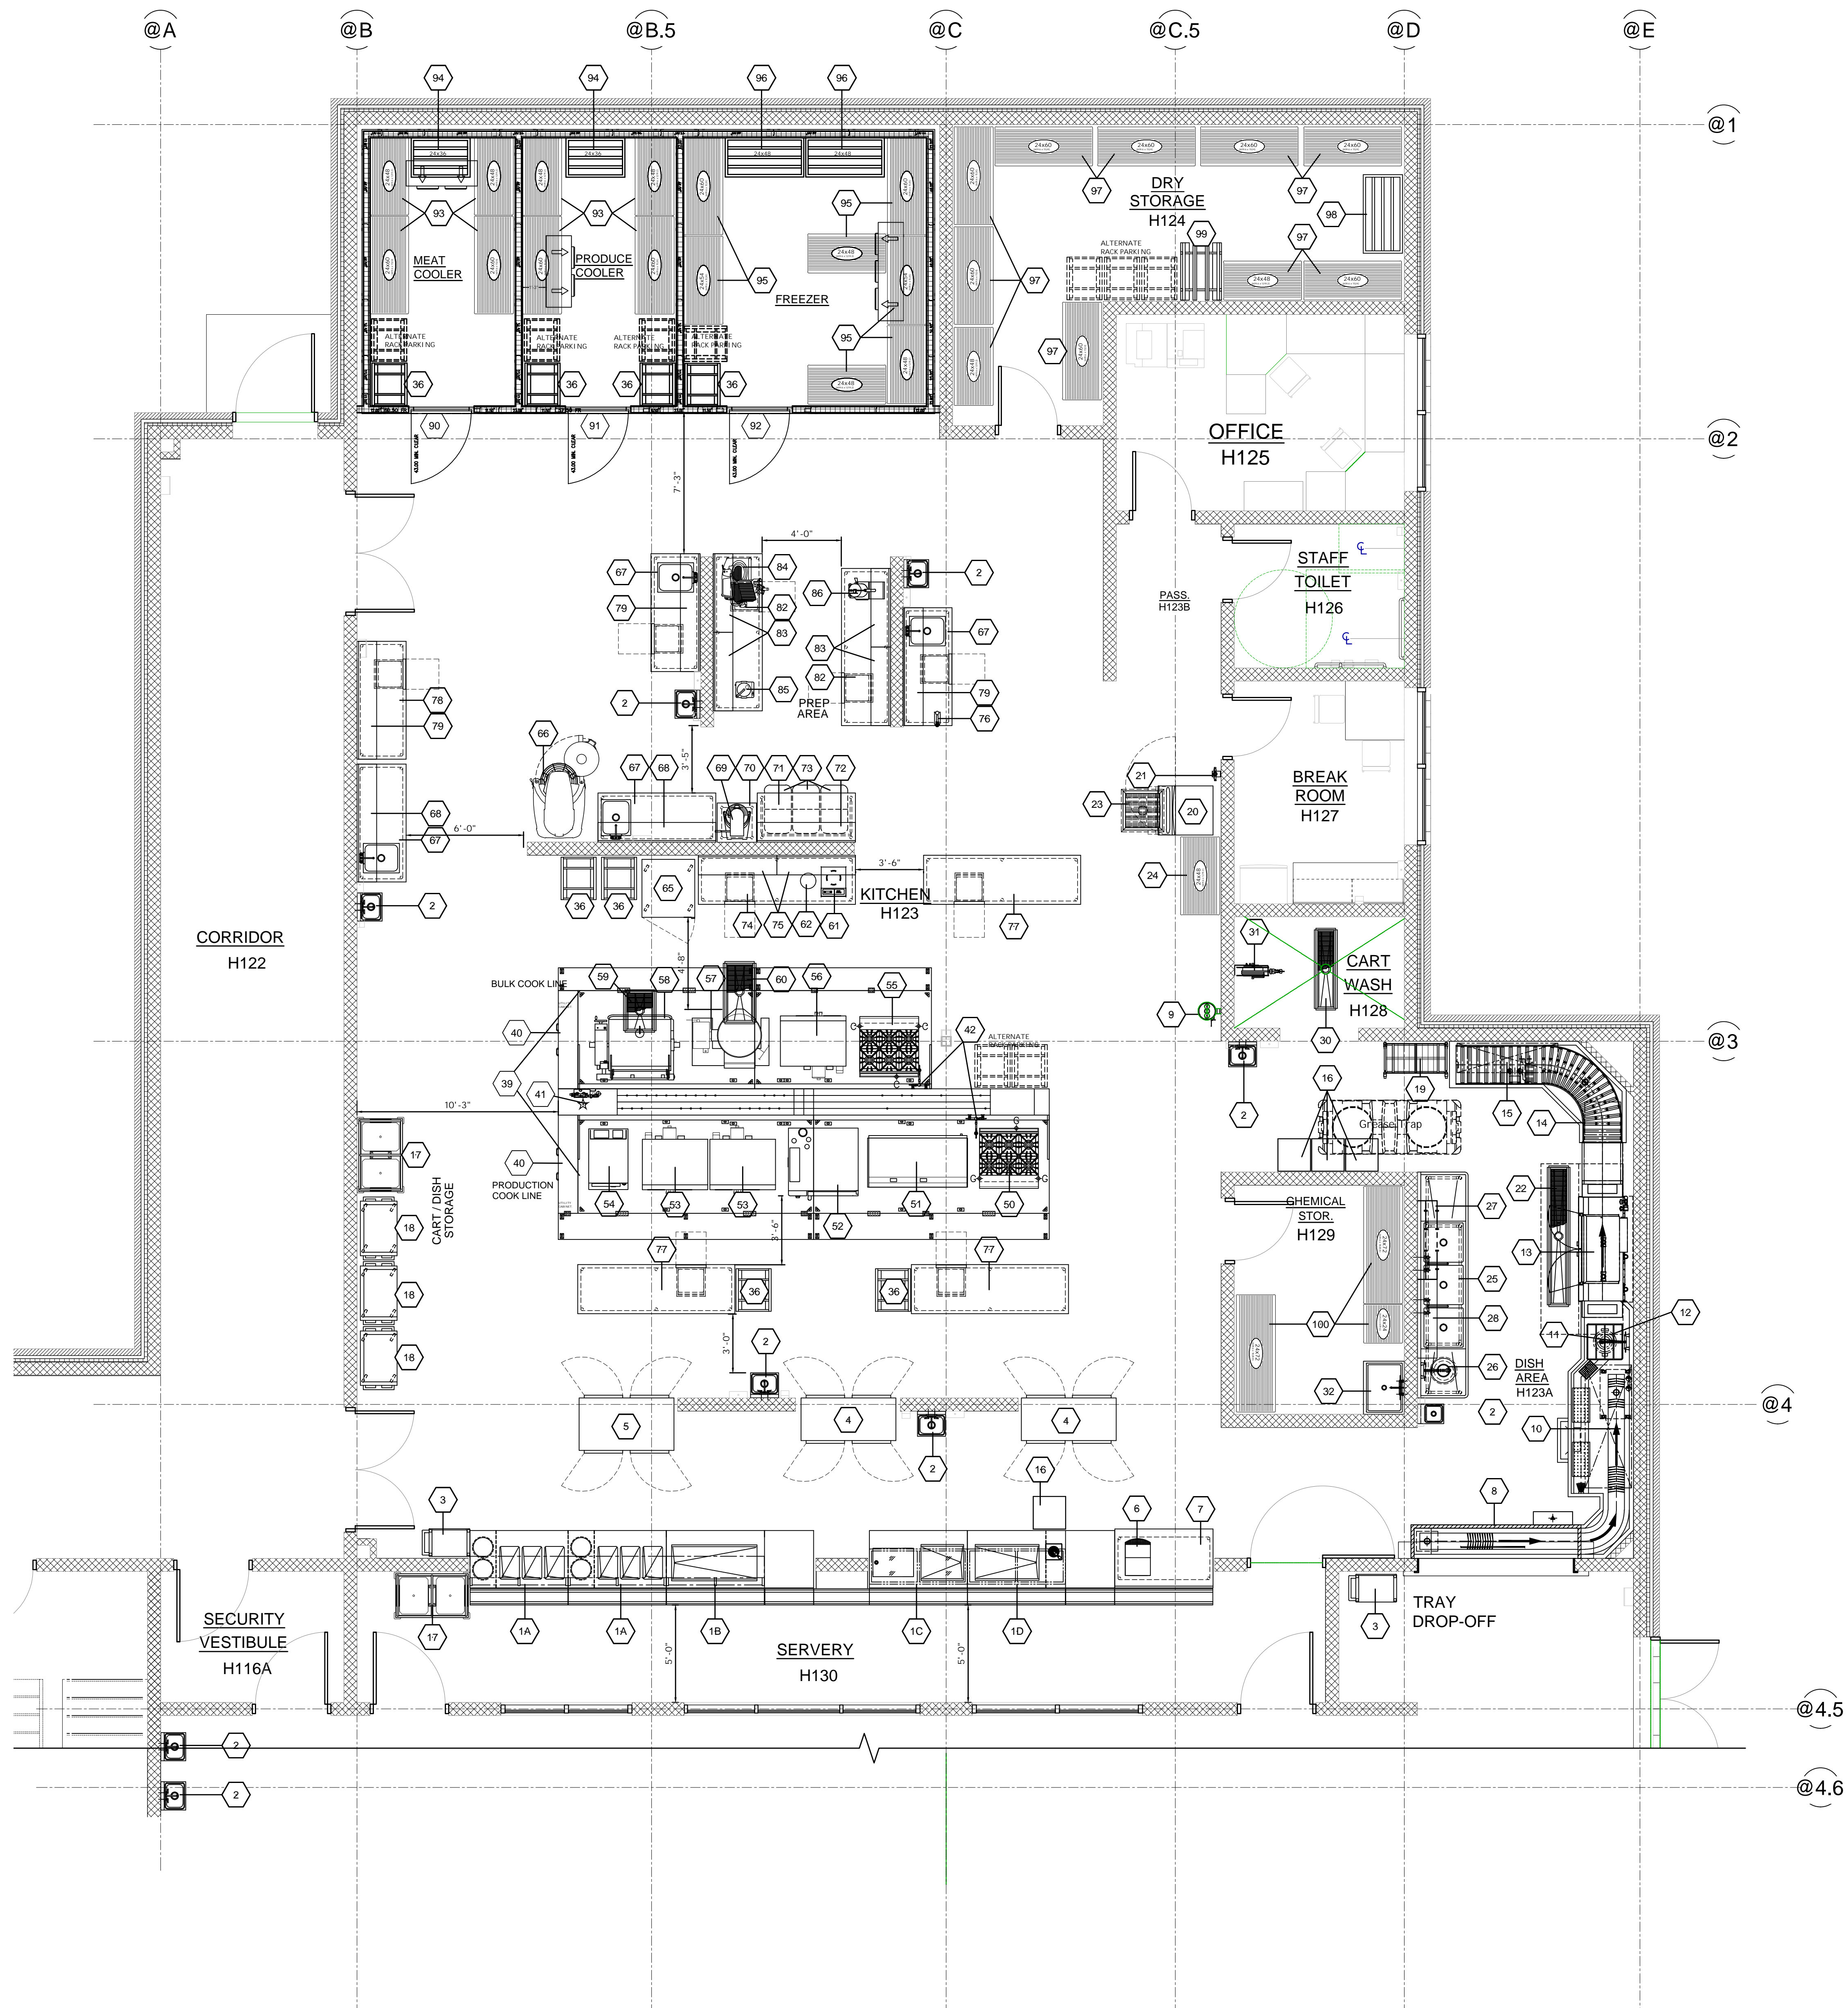

EQUIPMENT SCHEDULE			
ITEM NO	QTY	EQUIPMENT CATEGORY	EQUIPMENT REMARKS
1A	2	SERVING LINE - HOT FOOD	
1B	1	SERVING LINE - HOT/COLD FOOD COMBO	
1C	1	SERVING LINE - COLD FOOD	
1D	1	SERVING LINE - COLD FOOD	
2	9	HAND SINK, WALL MOUNT	
3	2	CART, UTILITY	
4	2	DISPLAY CASE, REFRIGERATED	
5	1	CABINET, HEATED, PASS-THRU	
6	1	COFFEE MAKER, DISPENSER	
7	1	TABLE, WORK	
8	1	SOILED DISHTABLE TRAY CONVEYOR	
9	1	EYE WASH STATION	
10	1	DISHTABLE, ACCESSORY	
11	1	PRE-RINSE FAUCET, WALL MOUNT	
12	1	DISPOSER, GARBAGE	
13	1	WAREWASHER, RACK CONVEYOR	
14	1	CLEAN DISH ROLLER TABLE	
15	1	SHELF, WALL MOUNT	
16	3	DOLLY, DISHRACK	
17	2	DISPENSER, SELF-LEVELING TRAY	
18	3	CART, DISH & TRAY	
19	1	RACK, DOME DRYING	
20	1	ICE MAKER W/ BIN	
21	1	FILTER SYSTEM, ICEMAKER	
22	1	FLOOR TROUGH	
23	1	FLOOR TROUGH	
24	1	SHELVING UNIT	
25	1	SINK, SCULLERY, 3 COMPARTMENTS	
26	1	DISPOSER, GARBAGE	
27	1	POT RACK, WALL MOUNT	
28	1	SHELF, WALL MOUNT	
29	-	SPARE NUMBER	
30	1	FLOOR TROUGH	
31	1	HOSE REEL WITH SPRAY	
32	1	SINK, MOP W/SERVICE FAUCET	
33	-	SPARE NUMBER	
34	-	SPARE NUMBER	
35	-	SPARE NUMBER	
36	8	RACK, PAN	
37	-	SPARE NUMBER	
38	-	SPARE NUMBER	
39	2	VENTILATION SYSTEM	
40	2	FIRE SUPPRESSION SYSTEM	
41	1	UDS SYSTEM	
42	2	FAUCET, POT FILLER, WALL MOUNT	
43	-	SPARE NUMBER	
44	-	SPARE NUMBER	
45	-	SPARE NUMBER	
46	-	SPARE NUMBER	
47	-	SPARE NUMBER	
48	-	SPARE NUMBER	
49	-	SPARE NUMBER	
50	1	RANGE, HEAVY DUTY, GAS	
51	1	GRIDLE, GAS W/STAND	
52	1	OVEN-STEAMER, COMBINATION, GAS	
53	2	DOUBLE OVEN, CONVECTION, GAS	
54	1	STEAMER, PRESSURELESS	
55	1	RANGE, HEAVY DUTY, GAS	
56	1	DOUBLE OVEN, CONVECTION, GAS	
57	1	KETTLE, STEAM JACKETED, GAS, TILT	
58	1	TILT SKILLET, GAS	
59	1	FLOOR TROUGH	
60	1	FLOOR TROUGH	
61	1	INDUCTION CHARGER	
62	101	THERMAL PELLET BASE	
63	-	SPARE NUMBER	
64	-	SPARE NUMBER	
65	1	CHILLER/FREEZER, BLAST	
66	1	MIXER, FLOOR	
67	4	TABLE, WORK W/SINK	
68	2	SHELF, WALL MOUNT	
69	1	MIXER, COUNTER	
70	1	STAND, EQUIPMENT	
71	1	TABLE, WORK	
72	1	SHELF, WALL MOUNT	
73	3	INGREDIENT BIN	
74	1	TABLE, WORK W/DRAWER ASSEMBLY	
75	1	SHELF, WALL MOUNT	
76	1	CAN OPENER	
77	3	TABLE, WORK W/DRAWER ASSEMBLY	
78	1	TABLE, WORK W/DRAWER ASSEMBLY	
79	3	SHELF, WALL MOUNT	
80	-	SPARE NUMBER	
81	-	SPARE NUMBER	
82	2	TABLE, WORK W/DRAWER ASSEMBLY	
83	4	SHELF, WALL MOUNT	
84	1	SLICER	
85	1	FOOD PROCESSOR	
86	1	FOOD PROCESSOR	
87	-	SPARE NUMBER	
90	1	WALK-IN MEAT COOLER	
91	1	WALK-IN PRODUCE COOLER	
92	1	WALK-IN FREEZER	
93	8	COOLER SHELVING UNIT	
94	2	COOLER DUNNAGE RACK	
95	7	FREEZER SHELVING UNIT	
96	2	FREEZER DUNNAGE RACK	
97	9	DRY STORAGE SHELVING UNIT	
98	1	DRY STORAGE DUNNAGE RACK	
99	1	CAN RACK	
100	3	CHEMICAL STORAGE SHELVING UNIT	

**NOT FOR CONSTRUCTION
PRELIMINARY**


NO.	REVISION	DATE

STATE OF MICHIGAN
DEPARTMENT OF TECHNOLOGY, MANAGEMENT AND BUDGET
FACILITIES AND BUSINESS SERVICES ADMINISTRATION
DESIGN AND CONSTRUCTION DIVISION
ADAM LACH, RA, DIRECTOR

FILE NO.
491/20167.SDW

FUNDING CODE
171C0DHH57255

CONTRACT NO.
Y22003

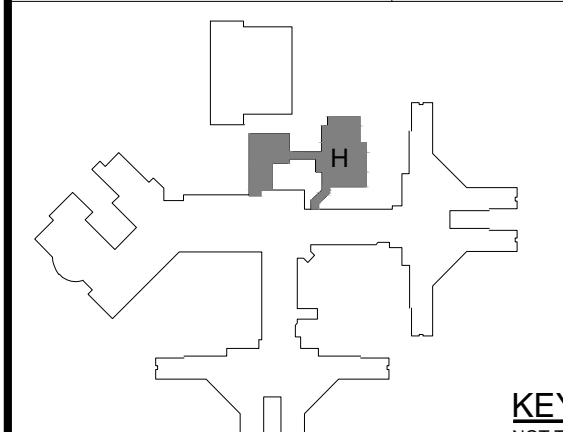

KEY PLAN
NOT TO SCALE



100 S Jefferson Ave, Suite 601
Saginaw, Michigan 48607
989 752 8107
COPYRIGHT © 2023



PROJECT TITLE
491/20167.SDW CFP - CREATE KITCHEN
BID AND CONSTRUCTION:
**CENTER FOR FORENSIC
PSYCHIATRY**

SALINE, MICHIGAN

SHEET TITLE

KITCHEN EQUIPMENT PLAN


PROJECT NUMBER
2021094


SHEET NUMBER

PROJECT DATE
SEPTEMBER 6, 2023


FS2.01

CHECKED BY
T.M.M.

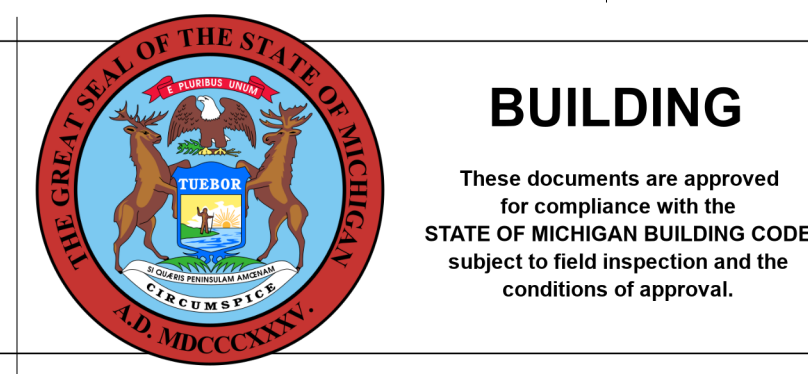

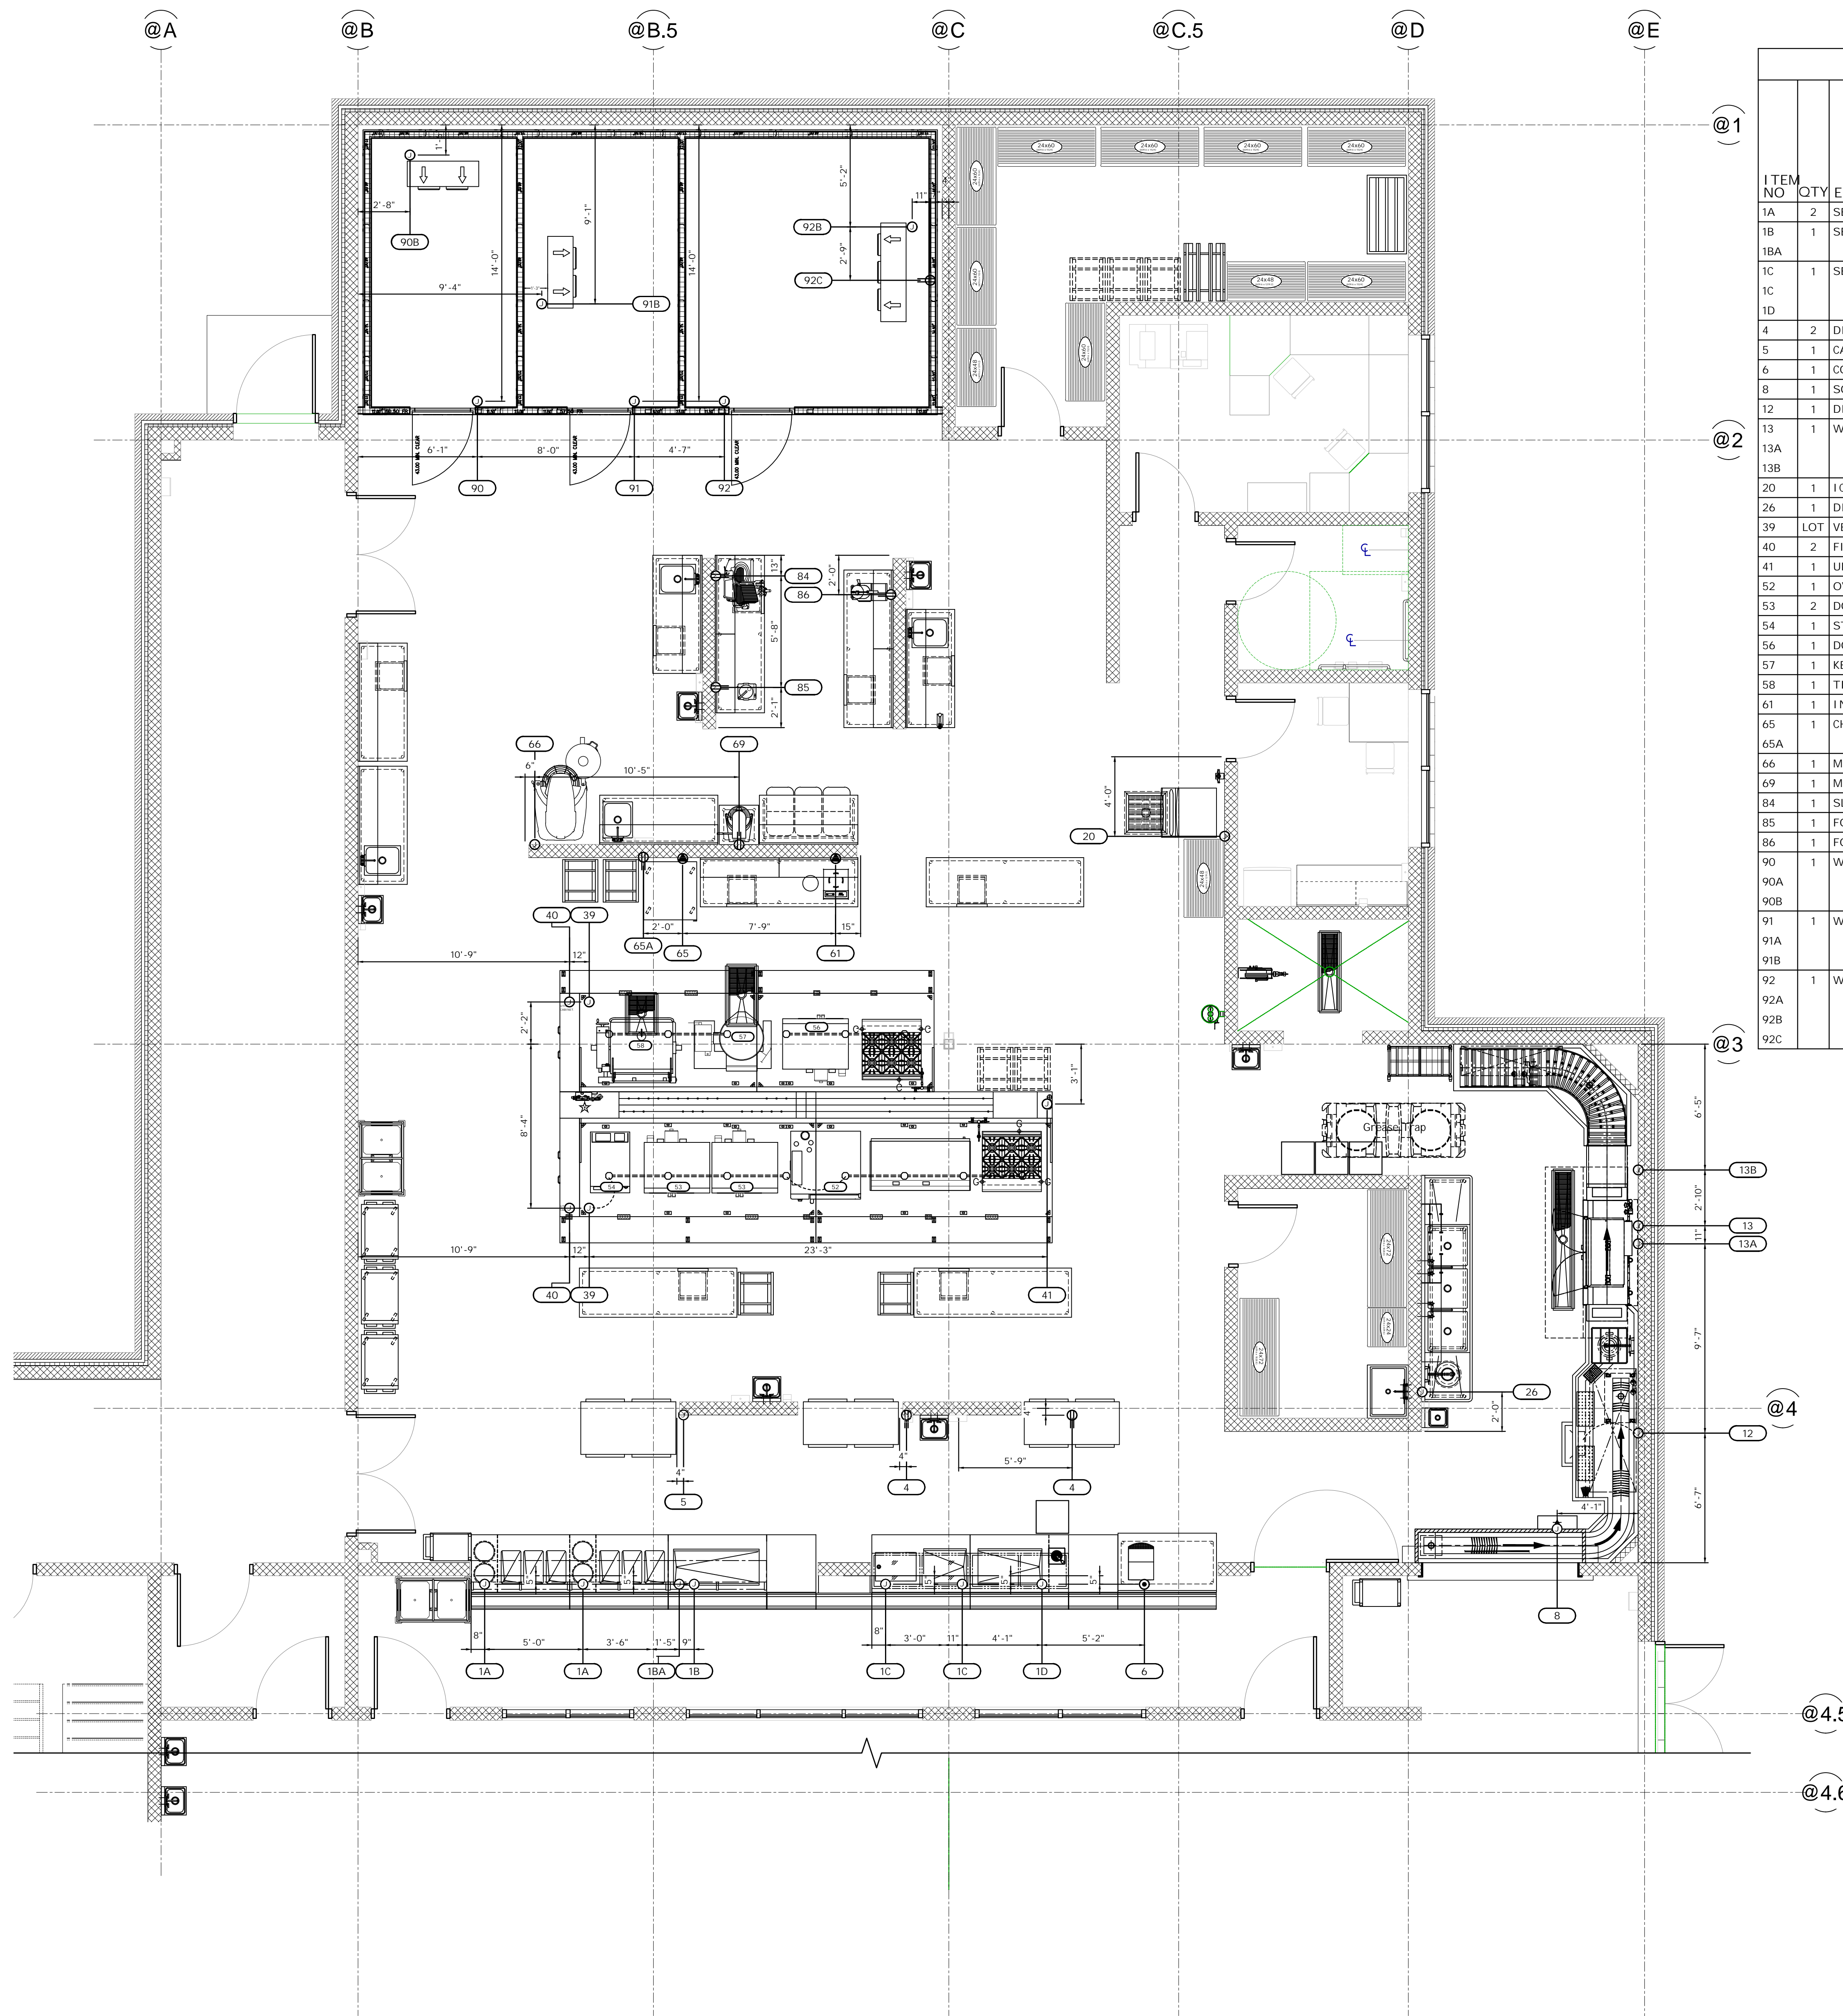

ELECTRICAL SCHEDULE													
ITEM NO	QTY	EQUIPMENT CATEGORY	AMPS	KW	HP	VOLTS	PHASE	CYCLE	DIRECT	PLUG	NEMA	ELECTRICAL AFF. (N)	ELEC REMARKS
1A	2	SERVING LINE - HOT FOOD	15.9	3.3		208	1		X			SU	'STUB UP' UTILITIES
1B	1	SERVING LINE - HOT/COLD FOOD COMBO	15.9	3.3		208	1		X			SU	'STUB UP' UTILITIES
1BA			3.5			115	1		X			SU	'STUB UP' UTILITIES
1C	1	SERVING LINE - COLD FOOD	3.5			115	1		X			SU	'STUB UP' UTILITIES
1C			3.5			115	1		X			SU	'STUB UP' UTILITIES
1D			3.5			115	1		X			SU	'STUB UP' UTILITIES
4	2	DISPLAY CASE, REFRIGERATED	10.6		0.5	115	1		X	5-20P	86		STUB UP OR BRING DOWN FROM ABOVE FOR UNIT AWAY FROM WALL
5	1	CABINET, HEATED, PASS-THRU	15.5	1.6		115/208	1		X			86	
6	1	COFFEE MAKER, DISPENSER	12.0	1.44		120	1		X	5-15P		SU	
8	1	SOILED DISH/TABLE TRAY CONVEYOR	15.0			208	1		X			60	
12	1	DISPOSER, GARBAGE	6.0		3.0	208	3		X			12	E.C. TO INTERWIRE TO CONTROL PANEL
13	1	WAREWASHER, RACK CONVEYOR	44.9	25.0		480	3		X			63.75	FOR MOTORS, CONTROLS & TANK HEAT
13A			40.1	30.0		480	3		X			63.75	FOR BOOSTER HEATER
13B			15.7			480	3		X			60	FOR BLOWER DRYER
20	1	ICE MAKER W/ BIN	11.9			115	1		X			72	
26	1	DISPOSER, GARBAGE	3.3		2.0	208	3		X			12	E.C. TO INTERWIRE TO CONTROL PANEL
39	LOT	VENTILATION SYSTEM	15.0			115	1		X			DFA	SERVICE TO LIGHTS & TEMP SENSORS
40	2	FIRE SUPPRESSION SYSTEM	20.0			120	1		X			DFA	20 AMP, 24-HR DEDICATED CIRCUIT
41	1	UDS SYSTEM	50.0	14.4		120/208	3		X			DFA	UDS SERVES ALL EQUIPMENT UNDER HOODS
52	1	OVEN-STEAMER, COMBINATION, GAS	9.6	2.2		208/240	1		X	6-50P	*		UTILITY SERVICE FROM ITEM 41, UDS SYSTEM
53	2	DOUBLE OVEN, CONVECTION, GAS	(2)7.7		(2)1/2	120	1		X	5-15P	*		UTILITY SERVICE FROM ITEM 41, UDS SYSTEM
54	1	STEAMER, PRESSURELESS	2.0	0.3		120	1		X			*	UTILITY SERVICE FROM ITEM 41, UDS SYSTEM
56	1	DOUBLE OVEN, CONVECTION, GAS	(2)7.7		(2)1/2	120	1		X	5-15P	*		UTILITY SERVICE FROM ITEM 41, UDS SYSTEM
57	1	KETTLE, STEAM JACKETED, GAS, TILT	5.0			115	1		X			*	UTILITY SERVICE FROM ITEM 41, UDS SYSTEM
58	1	TILT SKILLET, GAS	5.0			115	1		X			*	UTILITY SERVICE FROM ITEM 41, UDS SYSTEM
61	1	INDUCTION CHARGER	20.0	6.7		208	3		X	L15-20P	48		
65	1	CHILLER/FREEZER, BLAST	10.0		3.0	208	3		X	L15-20P	12		MAIN SERVICE TO UNIT
65A			2.0			120	1		X	5-15P	12		SERVICE FOR CONDENSATE EVAPORATOR
66	1	MIXER, FLOOR	12.0		3.0	200-240	3		X			54	CORD & PLUG NOT PROVIDED: L15-20P RECEPTACLE & PLUG CAN BE USED
69	1	MIXER, COUNTER	9.0		0.5	120	1		X	5-15P	36		
84	1	SLICER, FOOD	5.6		0.5	120	1		X	5-15P	45		
85	1	FOOD PROCESSOR	8.0		0.75	120	1		X	5-15P	45		
86	1	FOOD PROCESSOR	10.0		1.0	120	1		X	5-15P	45		
90	1	WALK-IN MEAT COOLER	15.0			120	1		X			DFA	SERVICE TO LIGHTS, ALARMS & HEATERS
90A			7.4		0.75	208-230	1		X			SU	SERVICE TO MEAT COOLER CONDENSING UNIT
90B			1.6			115	1		X			DFA	SERVICE TO MEAT COOLER EVAPORATOR COIL
91	1	WALK-IN PRODUCE COOLER	15.0			120	1		X			DFA	SERVICE TO LIGHTS, ALARMS & HEATERS
91A			7.0		0.75	208-230	1		X			SU	SERVICE TO PRODUCE COOLER CONDENSING UNIT
91B			1.6			115	1		X			DFA	SERVICE TO PRODUCE COOLER EVAPORATOR COIL
92	1	WALK-IN FREEZER	15.0			120	1		X			DFA	SERVICE TO LIGHTS, ALARMS & HEATERS
92A			21.4		3.0	208-230	1		X			SU	SERVICE TO FREEZER CONDENSING UNIT
92B			14.3			208-230	1		X			DFA	SERVICE TO FREEZER EVAPORATOR COIL
92C			15.0			120	1		X	5-15P	84		15 AMP CIRCUIT FOR DRAIN LINE HEAT TAPE

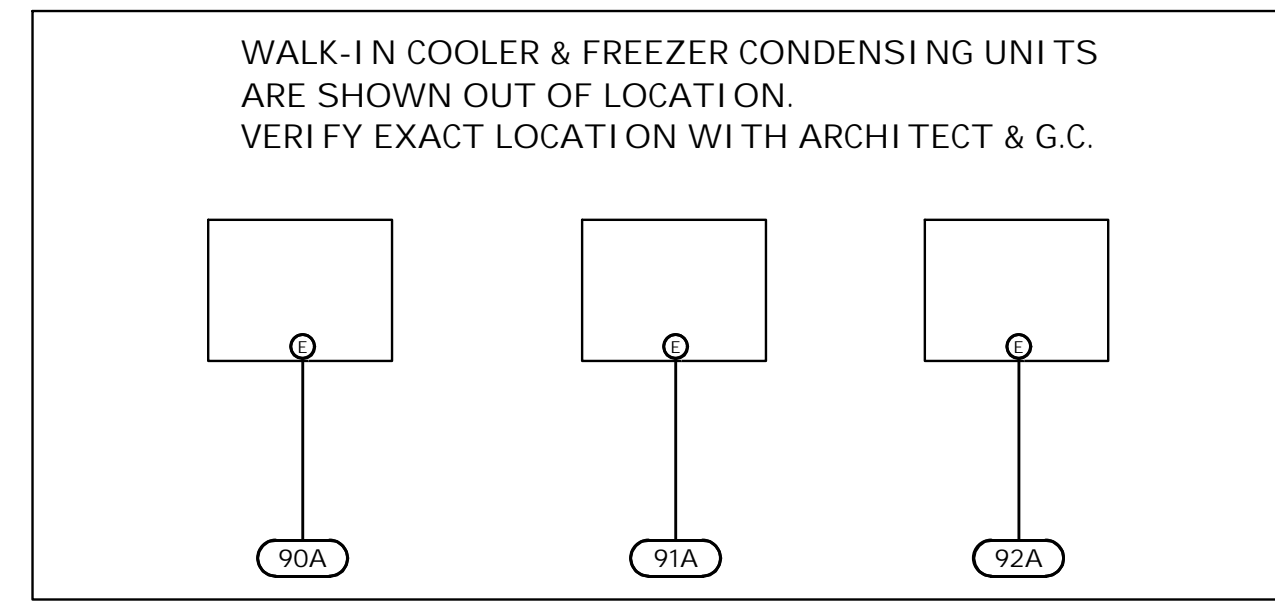

**NOT FOR CONSTRUCTION
PRELIMINARY**


NO.	REVISION	DATE

STATE OF MICHIGAN
DEPARTMENT OF TECHNOLOGY, MANAGEMENT AND BUDGET
FACILITIES AND BUSINESS SERVICES ADMINISTRATION
DESIGN AND CONSTRUCTION DIVISION
ADAM LACH, RA, DIRECTOR

FILE NO.
491/20167.SDW

FUNDING CODE
171C0DHHS7255

CONTRACT NO.
Y22003

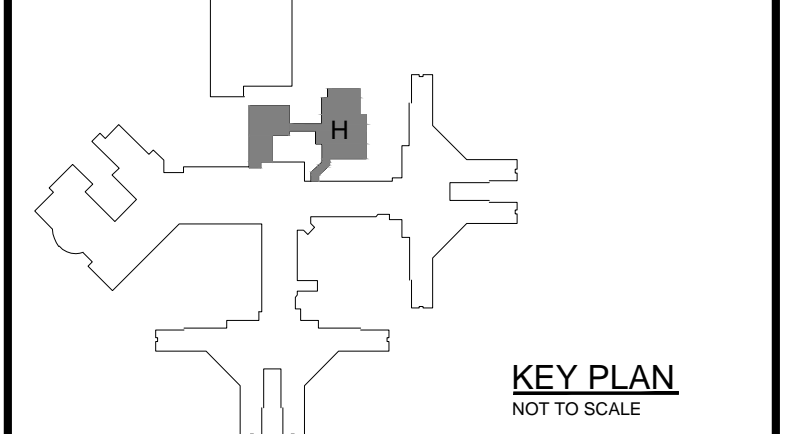

WTAARCHITECTS

100 S Jefferson Ave, Suite 601
Saginaw, Michigan 48607
989 752 8107
COPYRIGHT © 2023

STAFFORD-SMITH, Inc.
COMMERCIAL REFRIGERATION FOOD SERVICE EQUIPMENT
3014 S BURBANK ALAMADO, MICHIGAN 48601
PH: (989) 752 0271

PROJECT TITLE
491/20167.SDW CFP - CREATE KITCHEN
BID AND CONSTRUCTION:
**CENTER FOR FORENSIC
PSYCHIATRY**
SALINE, MICHIGAN
SHEET TITLE

KITCHEN ELECTRICAL PLAN

PROJECT NUMBER 2021094	SHEET NUMBER
PROJECT DATE SEPTEMBER 6, 2023	FS2.02
CHECKED BY T.M.M.	



ITEM NO. QTY		EQUIPMENT CATEGORY	COLD WATER SIZE (IN)	COLD WATER AFF. (IN)	COLD WATER SIZE (IN)	HOT WATER AFF. (IN)	DIRECT DRAIN SIZE (IN)	INDIRECT DRAIN AFF. (IN)	INDIRECT DRAIN SIZE (IN)	MBTUH	GAS PIPE (IN)	PLUMBING REMARKS
1A	2	SERVING LINE - HOT FOOD							FS			M.T. TO EXTEND DRAINS TO NEAREST FLOOR SINK
1B	1	SERVING LINE - HOT/COLD FOOD COMBO							FS			M.T. TO EXTEND DRAINS TO NEAREST FLOOR SINK
1C	1	SERVING LINE - COLD FOOD							FS			M.T. TO EXTEND DRAINS TO NEAREST FLOOR SINK
1D	1	SERVING LINE - COLD FOOD	0.5	SU					FS			STUB UP COLD WATER FOR WATER FILLER M.T. TO EXTEND DRAINS TO NEAREST FLOOR SINK
2	9	HAND SINK, WALL MOUNT	0.5	18	0.5	18	1.5	20				
6	1	COFFEE MAKER, DISPENSER	0.375	SU								
8	1	SOILED DISHTABLE TRAY CONVEYOR	(2)0.5	16	(2)0.5	16			1.5,FS			M.T. TO EXTEND DRAINS TO NEAREST FLOOR SINK
9	1	EYEWASH STATION	0.5	24	0.5	24	1.25	24				
11	1	PRE-RINSE FAUCET, WALL MOUNT	0.75	14	0.5	14						BRANCH CW FROM PRE-RINSE TO DISPOSER
12	1	DISPOSER, GARBAGE	0.5	*			3	8				BRANCH CW FROM PRE-RINSE TO DISPOSER
13	1	WAREWASHER, RACK CONVEYOR	0.5	8	0.5	8			2.0,FS			M.T. TO EXTEND DRAINS TO NEAREST FLOOR SINK
20	1	ICE MAKER W/ BIN	0.375	*					0.75,FS			BRANCH CW FROM ITEM 21, FILTER TO ICE MAKER M.T. TO EXTEND DRAINS TO NEAREST FLOOR SINK
21	1	FILTER SYSTEM, ICE MAKER	0.375	60								BRANCH CW FROM ITEM 21, FILTER TO ICE MAKER
22	1	FLOOR TROUGH							4.0	SU		
23	1	FLOOR TROUGH							4.0	SU		
25	1	SINK, SCULLERY, 3 COMPARTMENTS	(3)0.75	14	(3)0.75	14						H&C WATER TO FAUCETS & PRE-RINSE UNIT M.T. TO EXTEND WASH SINK DRAIN DIRECT TO GREASE TRAP
25A	1								2.0	FS		M.T. TO EXTEND RINSE & SANITIZE SINK DRAINS TO FLOOR SINK BRANCH CW FROM PRE-RINSE UNIT TO DISPOSER
26	1	DISPOSER, GARBAGE	0.5	*								
26A	1								2.0	8		
30	1	FLOOR TROUGH							4.0	SU		
31	1	HOSE REEL WITH SPRAY	0.5	42	0.5	42						STUB OUT TO MIXING VALVE & RUN UP TO HOSE REEL UNIT
32	1	SINK, MOP	0.5	36	0.5	36	2.0	SU				
41	1	UDS SYSTEM	0.75	DFA	0.75	DFA			2.0	2350	DFA	UDS SERVES EQUIPMENT UNDER HOODS 2" GAS LOOP SYSTEM
41A	1											
42	2	FAUCET, POT FILLER, WALL MOUNT	0.5	*	0.5	*						UTILITY SERVICE FROM ITEM 41, UDS SYSTEM
50	1	RANGE, HEAVY DUTY, GAS							1.25	260	*	UTILITY SERVICE FROM ITEM 41, UDS SYSTEM
51	1	GRIDDLE, GAS W/STAND							0.75	135	*	UTILITY SERVICE FROM ITEM 41, UDS SYSTEM
52	1	OVEN-STEAMER, COMBINATION, GAS							0.75	303.5	*	UTILITY SERVICE FROM ITEM 41, UDS SYSTEM M.T. TO EXTEND DRAINS TO NEAREST FLOOR SINK
53	2	OVEN, CONVECTION, GAS							0.75	100	*	UTILITY SERVICE FROM ITEM 41, UDS SYSTEM
54	1	STEAMER, PRESSURELESS (1-FILTERED & 1-NON-FILTERED)	(2)0.375						0.75	144	*	UTILITY SERVICE FROM ITEM 41, UDS SYSTEM M.T. TO EXTEND DRAINS TO NEAREST FLOOR SINK
55	1	RANGE, HEAVY DUTY, GAS							1.25	260	*	UTILITY SERVICE FROM ITEM 41, UDS SYSTEM
56	1	OVEN, CONVECTION, GAS							0.75	100	*	UTILITY SERVICE FROM ITEM 41, UDS SYSTEM
57	1	KETTLE, STEAM JACKETED, GAS, TILT	0.5	*	0.5	*			0.5	100	*	UTILITY SERVICE FROM ITEM 41, UDS SYSTEM
58	1	TILT SKILLET, GAS	0.5	*	0.5	*			0.5	144	*	UTILITY SERVICE FROM ITEM 41, UDS SYSTEM
59	1	FLOOR TROUGH							4.0	SU		
60	1	FLOOR TROUGH							4.0	SU		
65	1	CHILLER/FREEZER, BLAST							0.75	FS		M.T. TO EXTEND DRAINS TO NEAREST FLOOR SINK
67	4	TABLE, WORK W/SINK	0.5	14	0.5	14			1.5	FS		M.T. TO EXTEND DRAINS TO NEAREST FLOOR SINK
90	1	WALK-IN MEAT COOLER								FFD		M.T. TO EXTEND EVAPORATOR COIL DRAIN TO FUNNEL TYPE FLOOR DRAIN
91	1	WALK-IN PRODUCE COOLER								FFD		M.T. TO EXTEND EVAPORATOR COIL DRAIN TO FUNNEL TYPE FLOOR DRAIN
92	1	WALK-IN FREEZER								FFD		M.T. TO EXTEND EVAPORATOR COIL DRAIN TO FUNNEL TYPE FLOOR DRAIN

**NOT FOR CONSTRUCTION
PRELIMINARY**


NO.	REVISION	DATE

STATE OF MICHIGAN
DEPARTMENT OF TECHNOLOGY, MANAGEMENT AND BUDGET
FACILITIES AND BUSINESS SERVICES ADMINISTRATION
DESIGN AND CONSTRUCTION DIVISION
ADAM LACH, RA, DIRECTOR

FILE NO.
491/20167.SDW

FUNDING CODE
171C0DHHS7255

CONTRACT NO.
Y22003

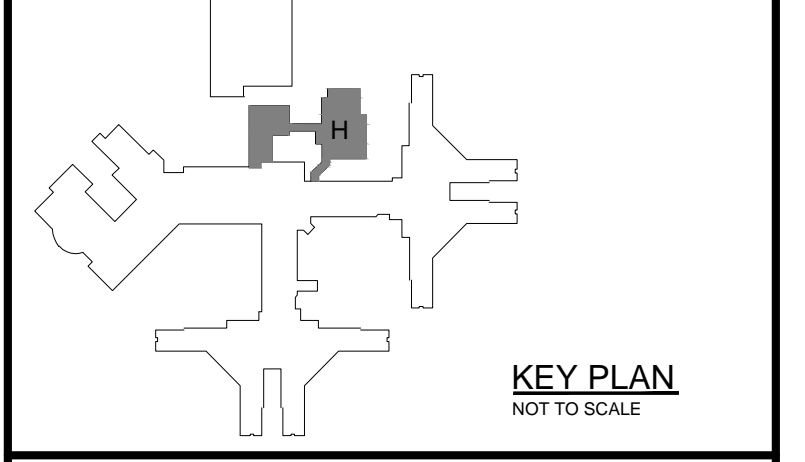


WTA ARCHITECTS
100 S Jefferson Ave, Suite 601
Saginaw, Michigan 48607
989 752 8107
COPYRIGHT © 2023

STAFFORD-SMITH, Inc.
COMMERCIAL REFRIGERATION, FOOD SERVICE EQUIPMENT
3916 S BURTON AVE, ANN ARBOR, MICHIGAN 48106
PH: (734) 963-0270

PROJECT TITLE
491/20167.SDW CFP - CREATE KITCHEN
BID AND CONSTRUCTION:
**CENTER FOR FORENSIC
PSYCHIATRY**
SALINE, MICHIGAN

SHEET TITLE
KITCHEN PLUMBING PLAN

PROJECT NUMBER 2021094	SHEET NUMBER
PROJECT DATE SEPTEMBER 6, 2023	FS2.03
CHECKED BY T.M.M.	

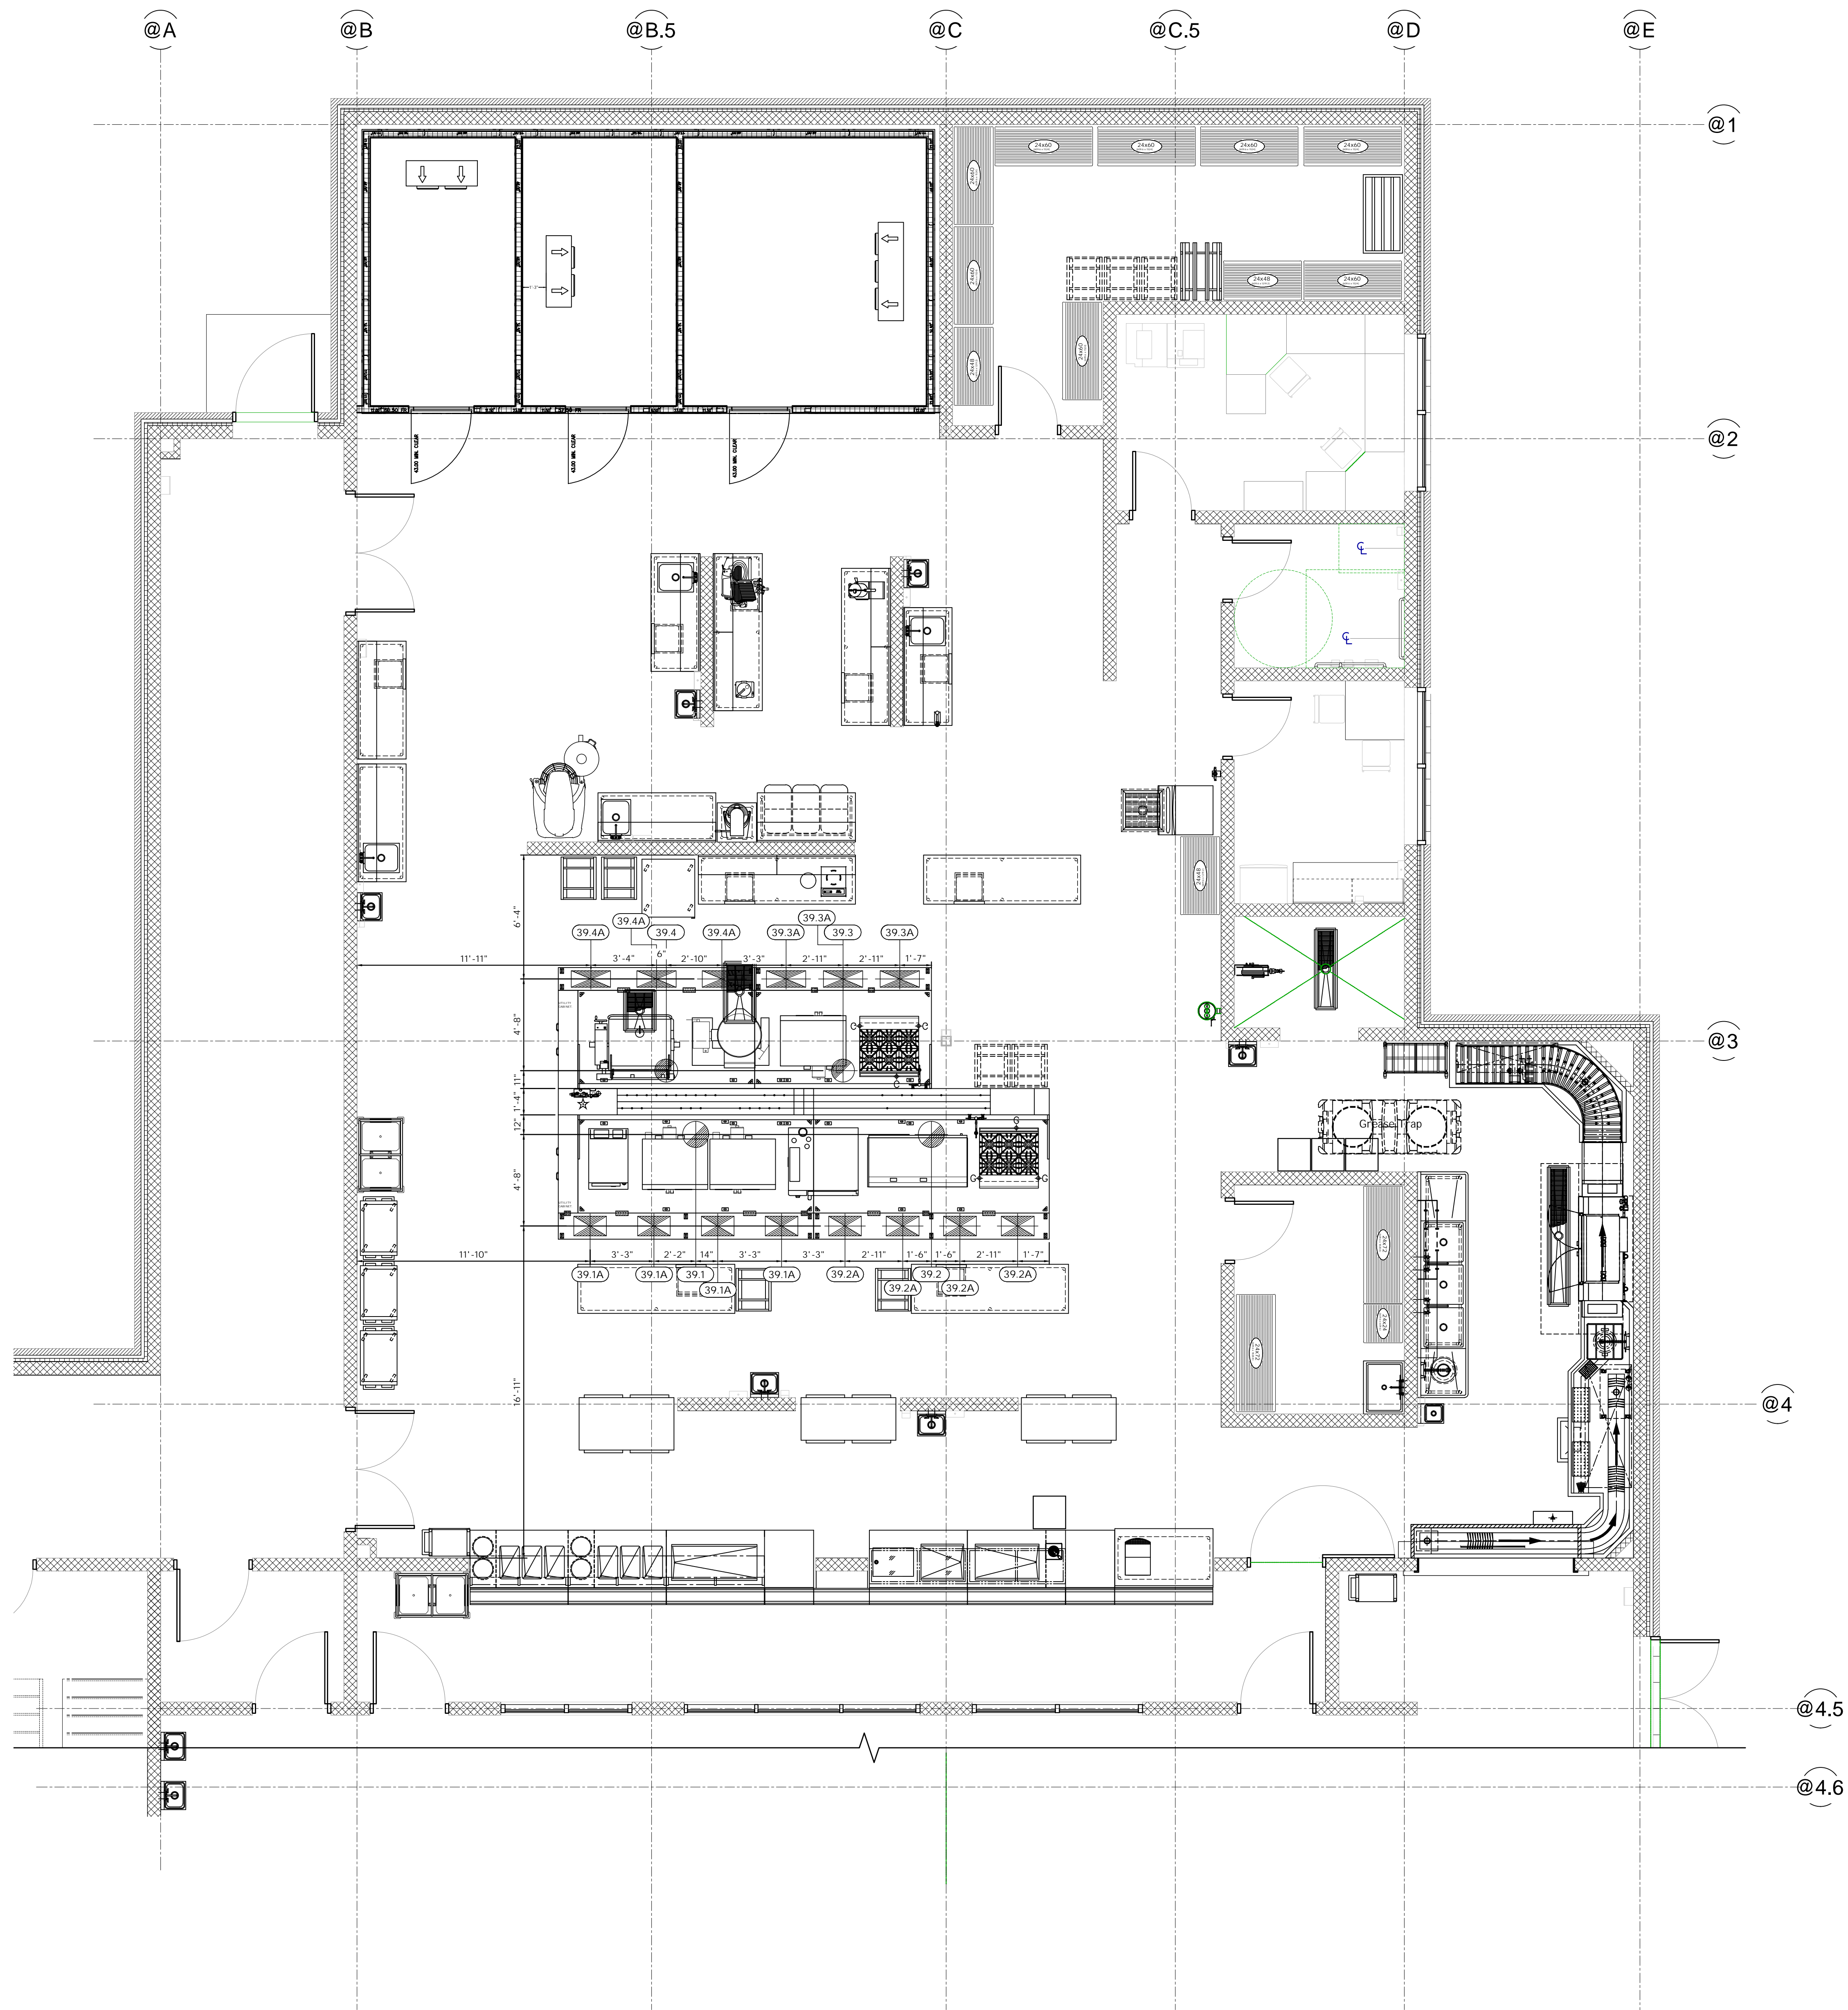

VENTILATION SCHEDULE										
ITEM NO	QTY	EQUIPMENT CATEGORY	HVAC EXHAUST DUCT SIZE (IN)	HVAC EXHAUST CFM	HVAC EXHAUST SPW/G	HVAC MAKE-UP DUCT SIZE (IN)	HVAC MAKE-UP CFM	HVAC MAKE-UP SPW/G	HVAC AFF (1/N)	HVAC REMARKS
39.1	1	VENTILATION SYSTEM	16" DIA	2350	-0.764	(4) 12" X 20"	637(EA)	0.217	DFA @ 113"-AFF	
39.1A			16" DIA	2750	-1.046	(4) 12" X 20"	637(EA)	0.217	DFA @ 113"-AFF	
39.2			14" DIA	1800	-0.666	(3) 10" X 24"	566(EA)	0.174	DFA @ 113"-AFF	
39.2A			14" DIA	1800	-0.666	(3) 10" X 24"	633(EA)	0.215	DFA @ 113"-AFF	
39.3										
39.3A										
39.4										
39.4A										

**NOT FOR CONSTRUCTION
PRELIMINARY**


NO.	REVISION	DATE

STATE OF MICHIGAN
DEPARTMENT OF TECHNOLOGY, MANAGEMENT AND BUDGET
FACILITIES AND BUSINESS SERVICES ADMINISTRATION
DESIGN AND CONSTRUCTION DIVISION
ADAM LACH, RA, DIRECTOR

FILE NO.
491/20167.SDW

FUNDING CODE
171C0DHH57255

CONTRACT NO.
Y22003

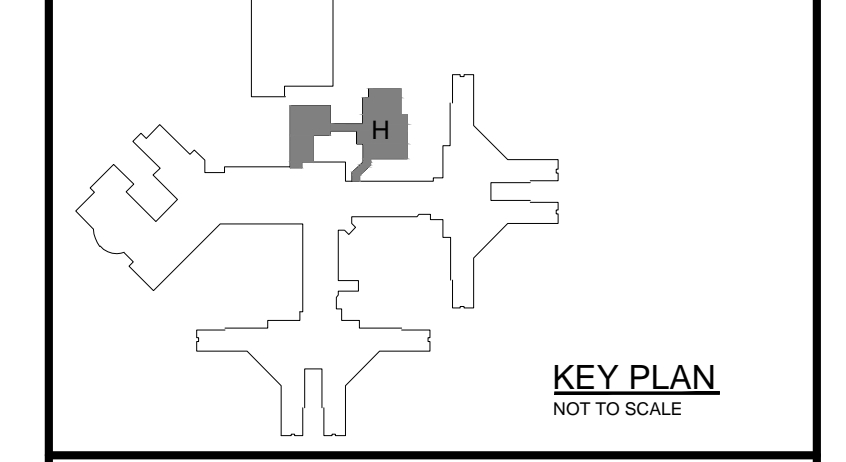

WTA ARCHITECTS
100 S Jefferson Ave, Suite 601
Saginaw, Michigan 48607
989 752 8107
COPYRIGHT © 2023

STAFFORD-SMITH, Inc.
COMMERCIAL REFRIGERATION FOOD SERVICE EQUIPMENT
301 S BURBANK/ALAMAZO, BIRMINGHAM, MI 48201
PH: (205) 951-2277


PROJECT TITLE
491/20167.SDW CFP - CREATE KITCHEN
BID AND CONSTRUCTION:
**CENTER FOR FORENSIC
PSYCHIATRY**

SALINE, MICHIGAN

SHEET TITLE

KITCHEN VENTILATION PLAN

PROJECT NUMBER 2021094	SHEET NUMBER
PROJECT DATE SEPTEMBER 6, 2023	FS2.04
CHECKED BY T.M.M.	

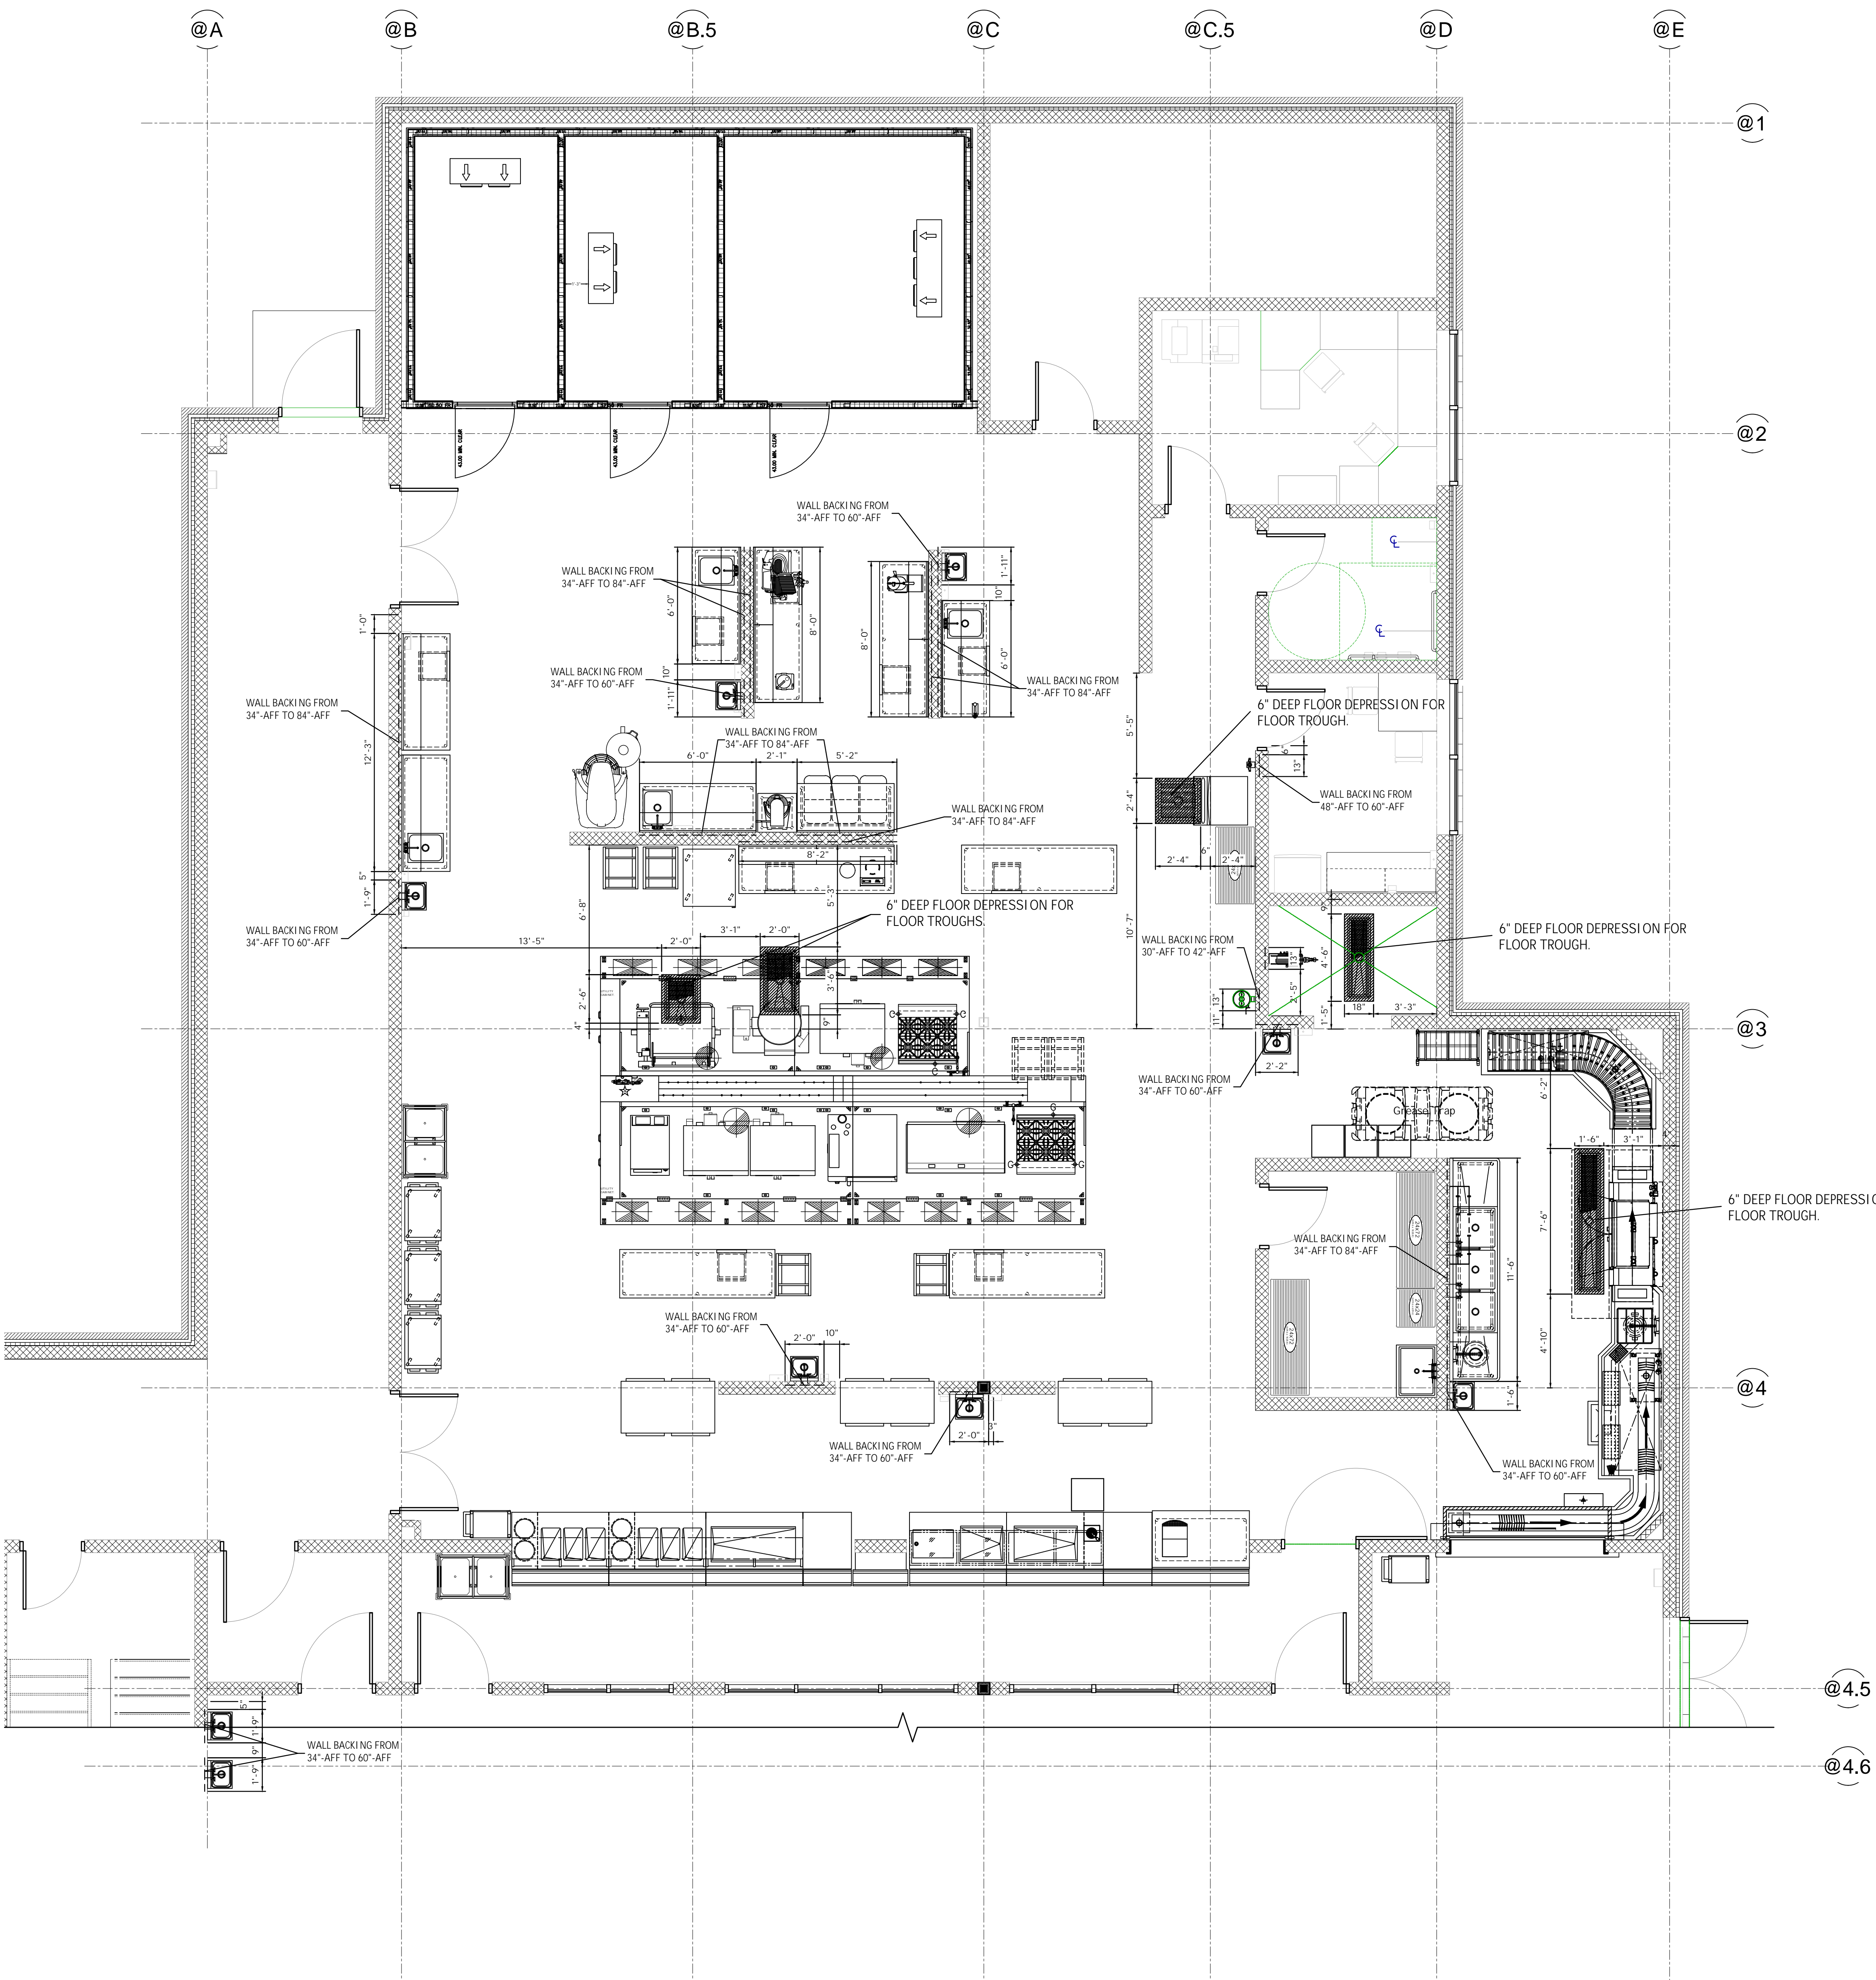

**NOT FOR CONSTRUCTION
PRELIMINARY**


NO.	REVISION	DATE

STATE OF MICHIGAN
DEPARTMENT OF TECHNOLOGY, MANAGEMENT AND BUDGET
FACILITIES AND BUSINESS SERVICES ADMINISTRATION
DESIGN AND CONSTRUCTION DIVISION
ADAM LACH, RA, DIRECTOR


FILE NO.
491/20167.SDW

FUNDING CODE
171CODHHS7255

CONTRACT NO.
Y22003

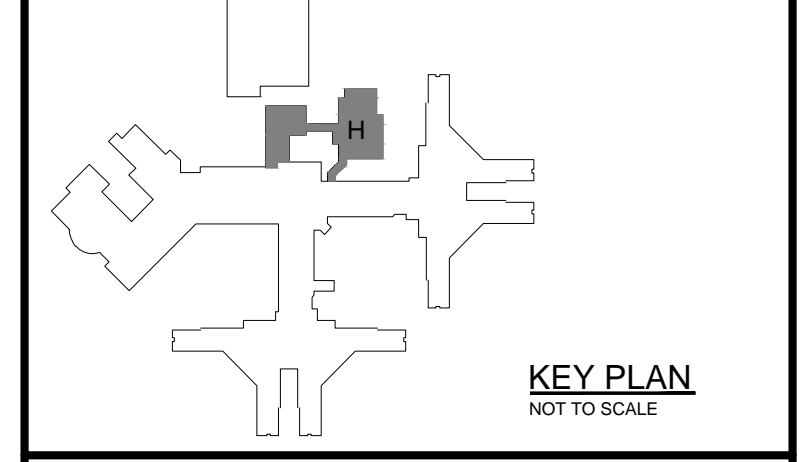

WTA ARCHITECTS
100 S Jefferson Ave, Suite 601
Saginaw, Michigan 48607
989 752 8107
COPYRIGHT © 2023


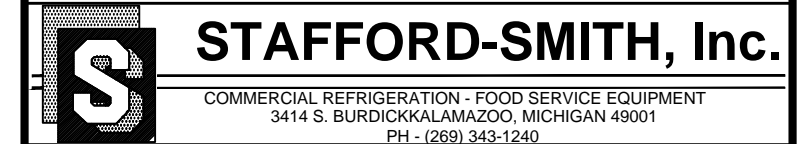


PROJECT TITLE
491/20167.SDW CFP - CREATE KITCHEN
AND CONSTRUCTION:
**CENTER FOR FORENSIC
PSYCHIATRY**
SALINE, MICHIGAN

SHEET TITLE
SPECIAL CONDITIONS PLAN

PROJECT NUMBER 2021094	SHEET NUMBER
PROJECT DATE SEPTEMBER 6, 2023	FS2.05
CHECKED BY T.M.M.	

BUILDING
These documents are approved
for compliance with the
STATE OF MICHIGAN BUILDING CODE
subject to field inspection and the
conditions of approval.

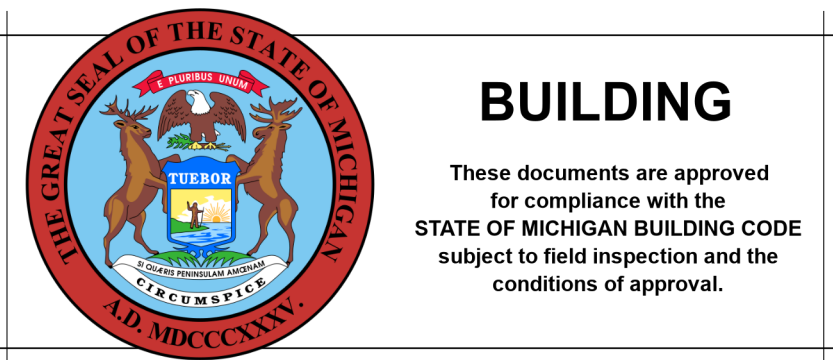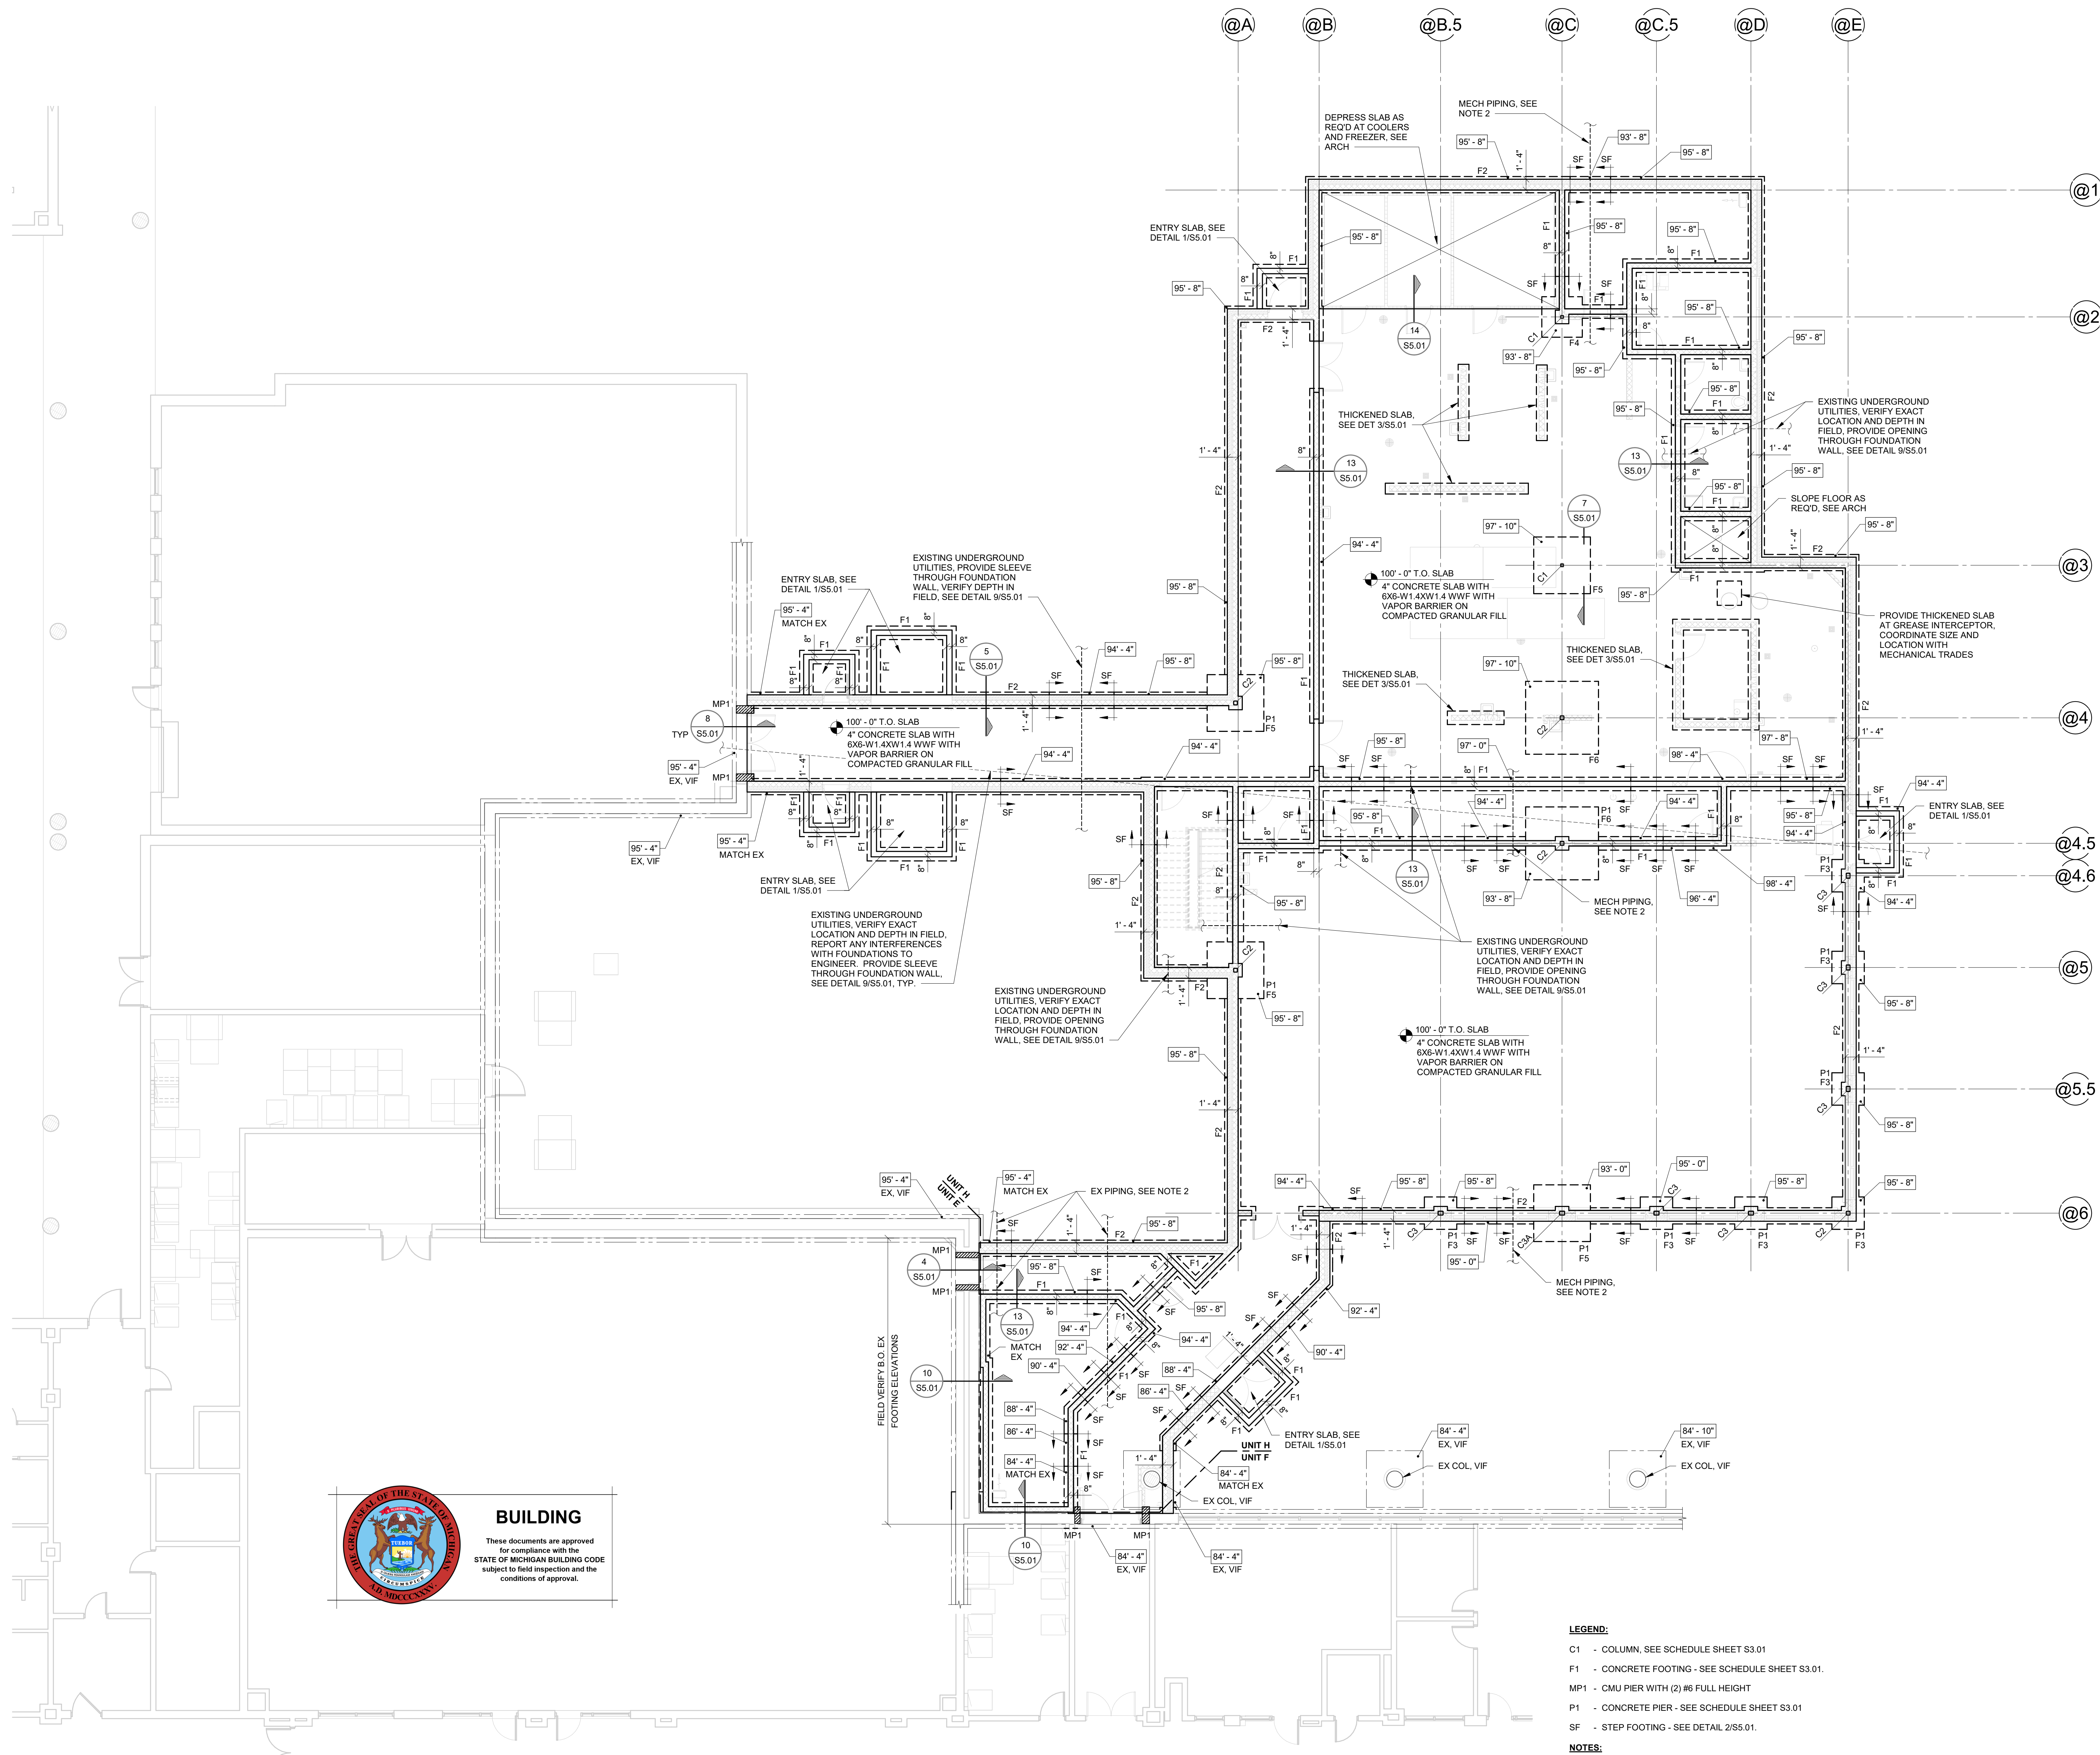

BUILDING
 These documents are approved for compliance with the STATE OF MICHIGAN BUILDING CODE subject to field inspection and the conditions of approval.


FOUNDATION PLAN
 1/8" = 1'-0" BOTTOM OF FOOTING ELEVATION = 95'-8" (UNO)

- LEGEND:**
 C1 - COLUMN, SEE SCHEDULE SHEET S3.01
 F1 - CONCRETE FOOTING - SEE SCHEDULE SHEET S3.01
 MP1 - CMU PIER WITH (2) #6 FULL HEIGHT
 P1 - CONCRETE PIER - SEE SCHEDULE SHEET S3.01
 SF - STEP FOOTING - SEE DETAIL 2/S5.01
- NOTES:**
 1. SEE SHEET S3.01 FOR GENERAL NOTES
 2. PROVIDE PIPE SLEEVE AT PIPE PENETRATIONS THROUGH FOUNDATION WALL. COORDINATE SIZE AND LOCATION WITH MECHANICAL TRADES, TYP. SEE DETAIL 1/S5.01 FOR PIPE SLEEVES THROUGH CONCRETE FOUNDATION WALLS.

NO.	REVISION	DATE

STATE OF MICHIGAN
 DEPARTMENT OF TECHNOLOGY, MANAGEMENT AND BUDGET
 FACILITIES AND BUSINESS SERVICES ADMINISTRATION
 DESIGN AND CONSTRUCTION DIVISION
 ADAM LACH, RA, DIRECTOR

FILE NO.
 491/20167.SDW
 FUNDING CODE
 171CODHHS7255
 CONTRACT NO.
 Y22003

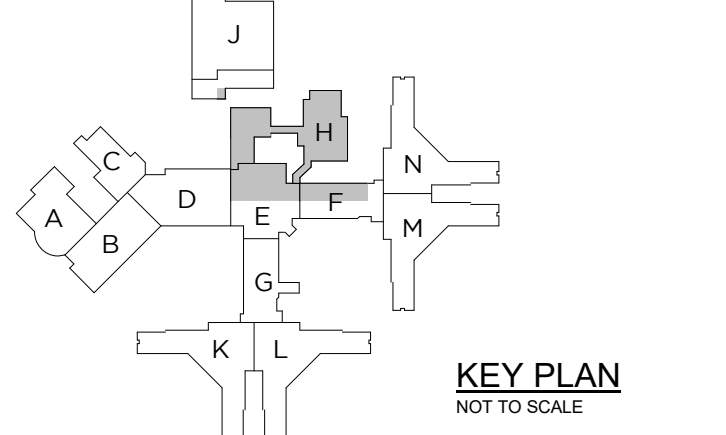

WTAARCH.COM

WTA ARCHITECTS

100 S. Jefferson Ave., Suite 601
 Saginaw, Michigan 48607
 989.752.8107 COPYRIGHT © 2023

MACMILLAN ASSOCIATES
 CONSULTING ENGINEERS
 10000 WOODLAND DRIVE • WOODSTOCK, MICHIGAN 48899
 (800) 894-4300 • (517) 894-9799 WWW.MACMILLANASSOCIATES.COM

PROJECT TITLE
 491/20167.SDW - PHASE 500:
 CENTER FOR FORENSIC
 PSYCHIATRY - CREATE
 KITCHEN
 SALINE, MICHIGAN

SHEET TITLE
FOUNDATION PLAN


PROJECT NUMBER
2021094

PROJECT DATE
 SEPTEMBER 6, 2023


CHECKED BY
 JAG

SHEET NUMBER
S2.01


Autumn2023 8:47:38 AM C:\Users\adam\Documents\2021-1830_Center for Forensic Psychiatry Kitchen\23_2021main\ND04.rvt

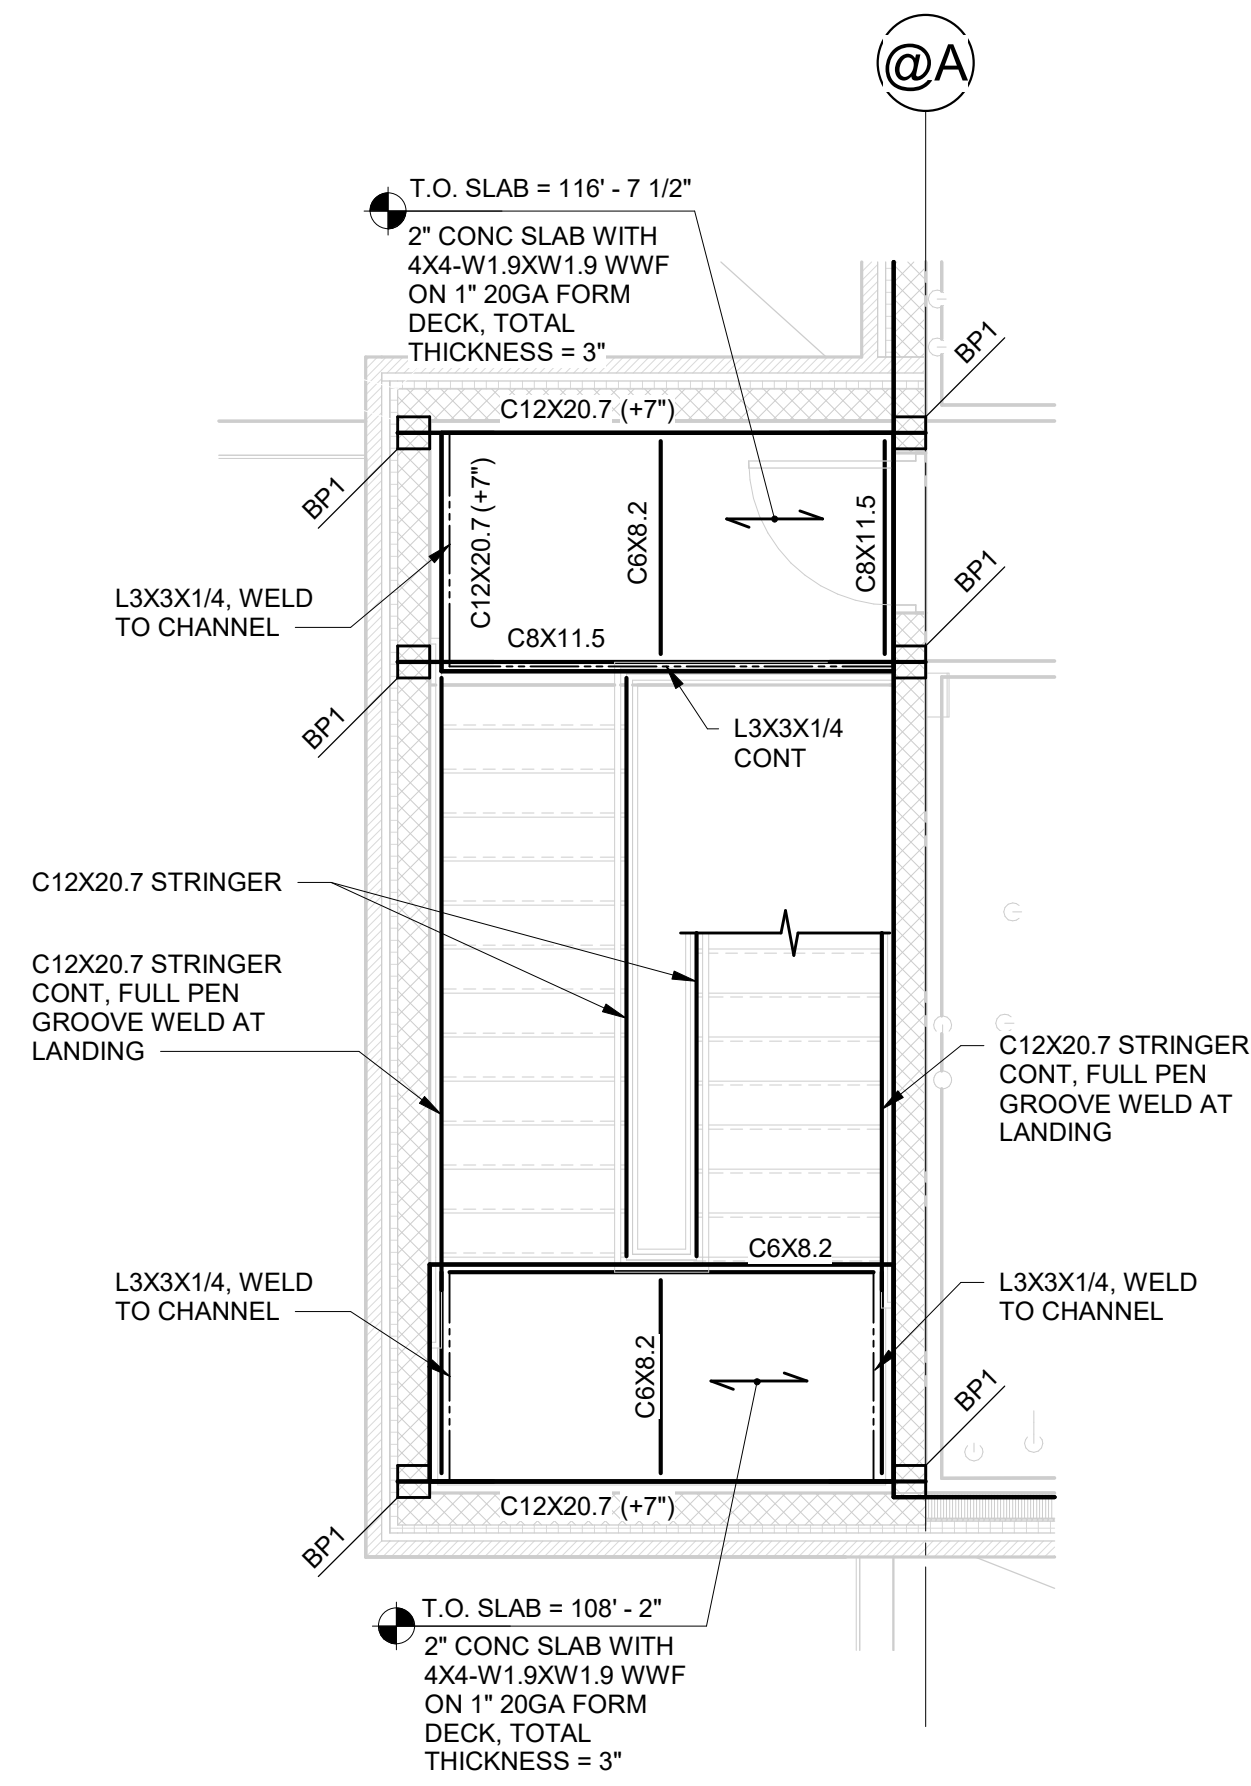


STAIR FRAMING PLAN
1/4" = 1'-0" T.O. STEEL = B.O. DECK UNO (+/-0'-0")

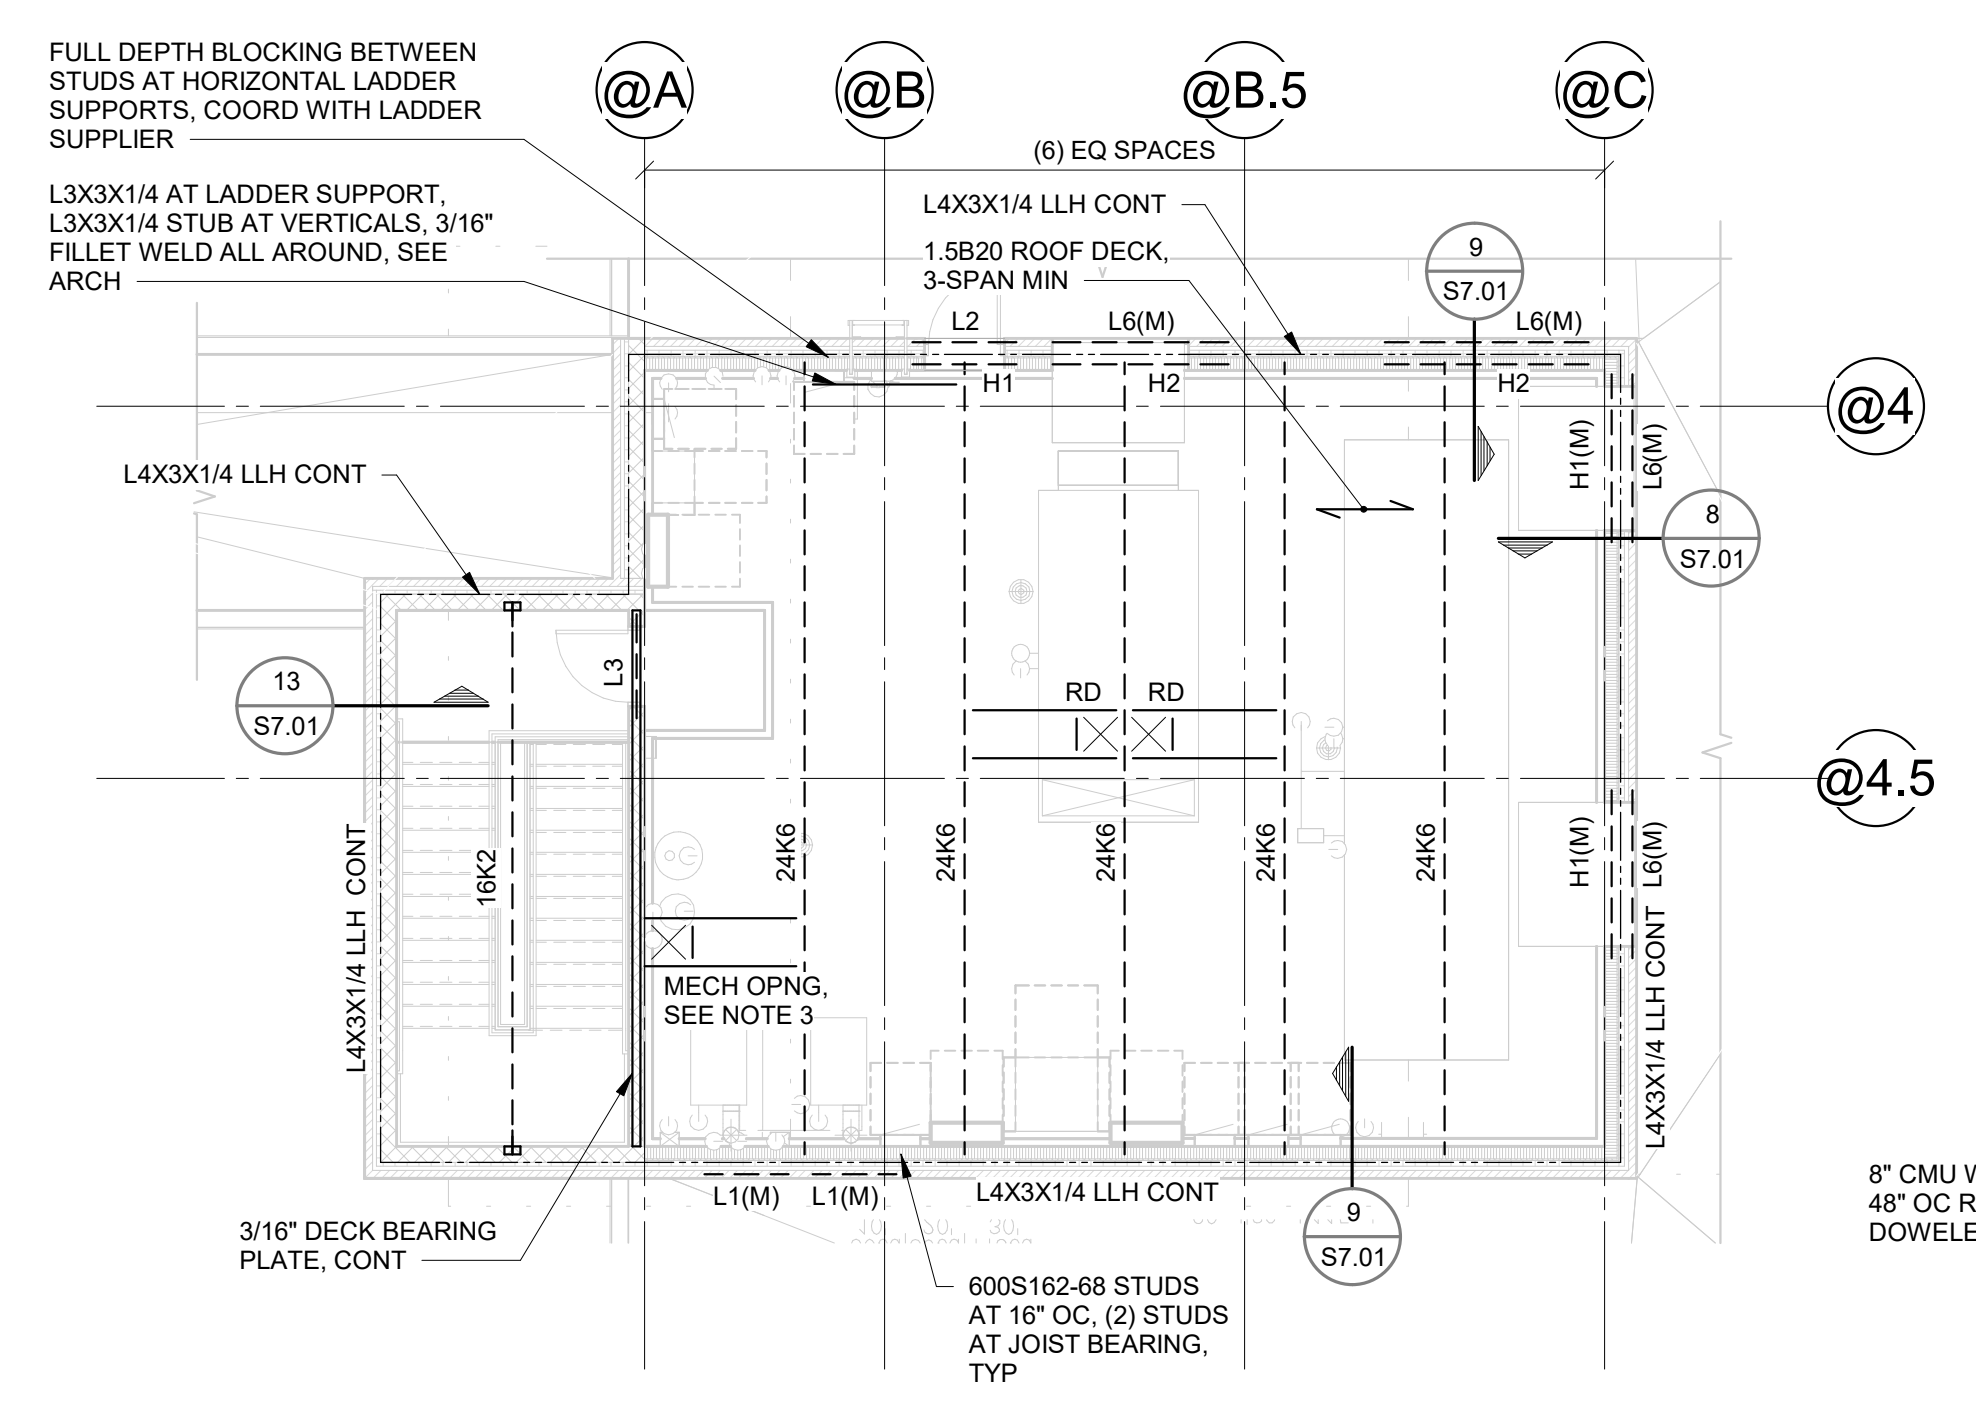

MECH PENTHOUSE ROOF FRAMING PLAN
1/8" = 1'-0" B.O. DECK = 128'-8" T.O. STEEL = B.O. DECK UNO (+/-0'-0")

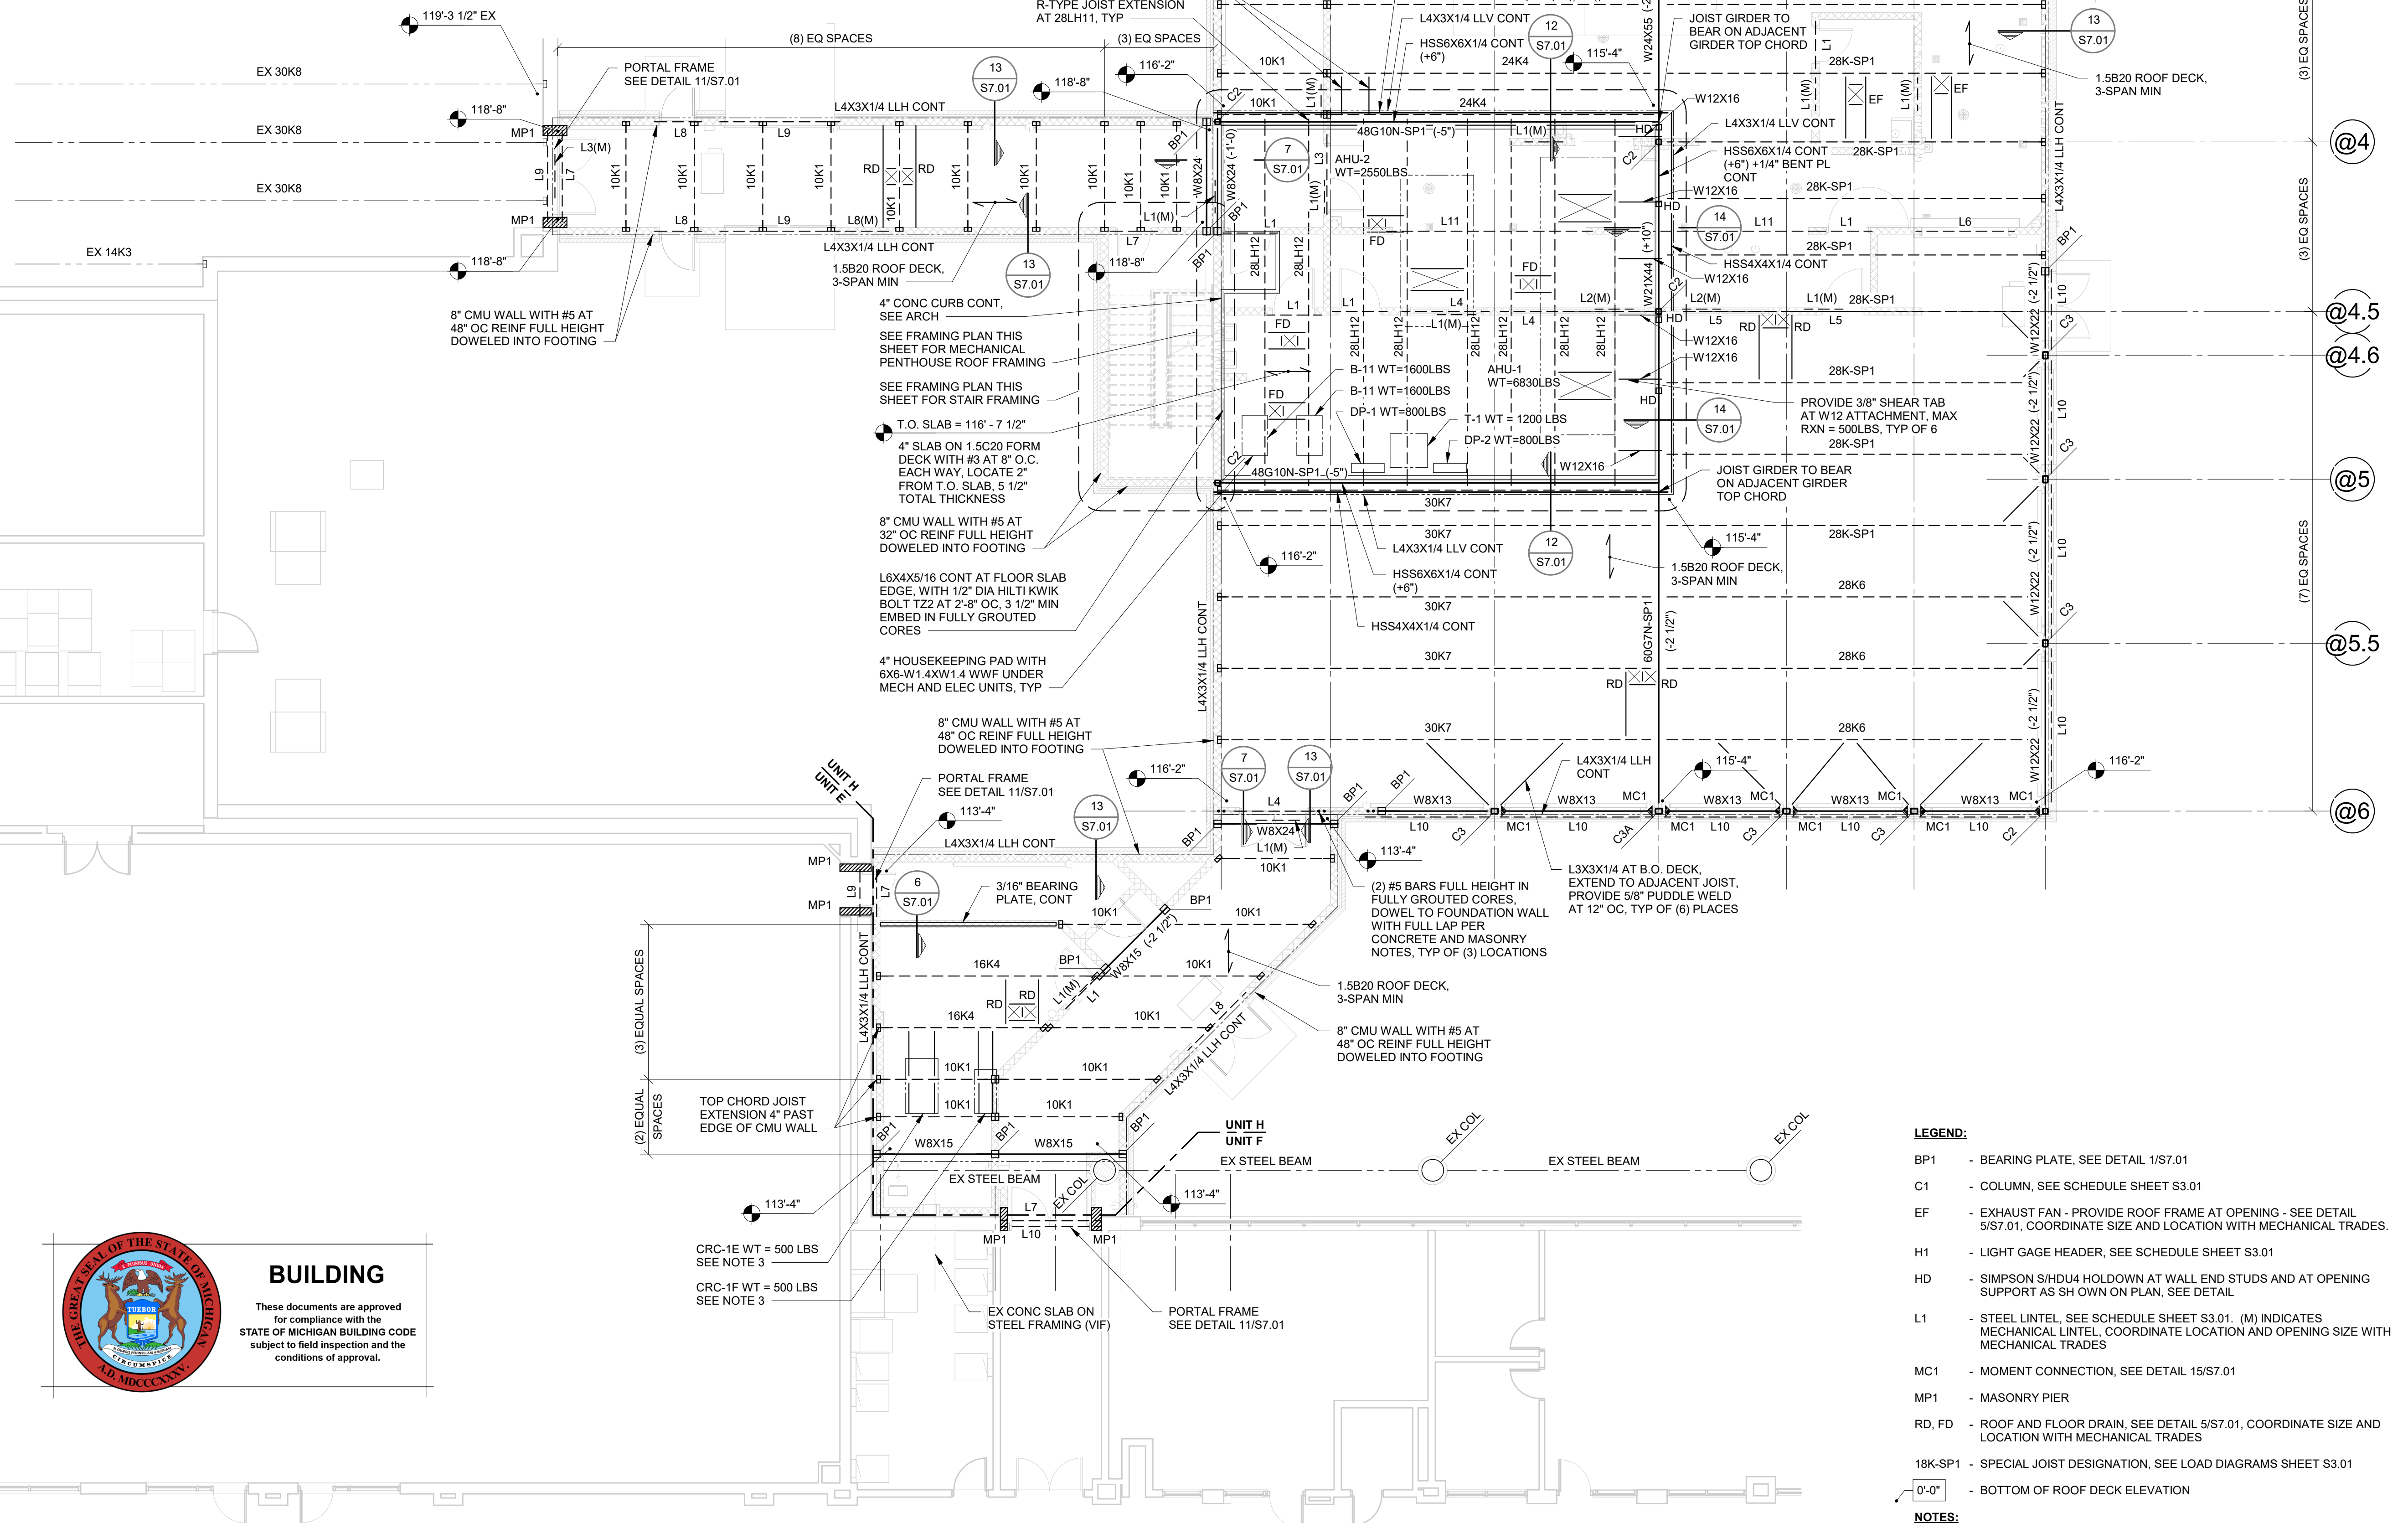


ROOF / PENTHOUSE FLOOR FRAMING PLAN
1/8" = 1'-0" T.O. STEEL = B.O. DECK UNO (+/-0'-0")

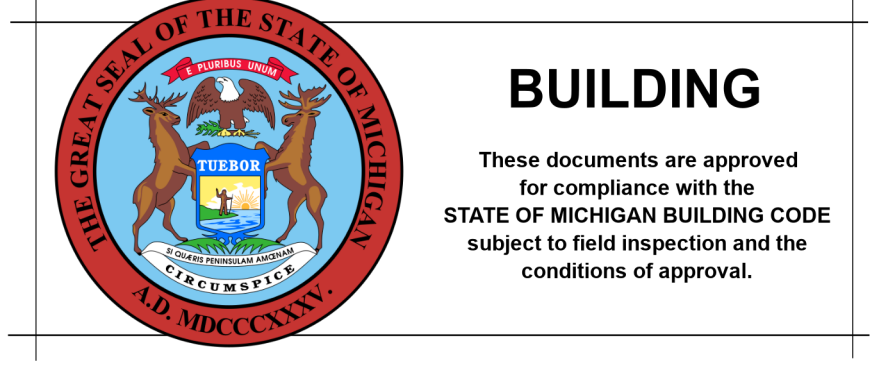

NO.	REVISION	DATE

STATE OF MICHIGAN
DEPARTMENT OF TECHNOLOGY, MANAGEMENT AND BUDGET
FACILITIES AND BUSINESS SERVICES ADMINISTRATION
DESIGN AND CONSTRUCTION DIVISION
ADAM LACH, RA, DIRECTOR

FILE NO:
491/20167.SDW
FUNDING CODE
17ICODHHS7255
CONTRACT NO.
Y22003

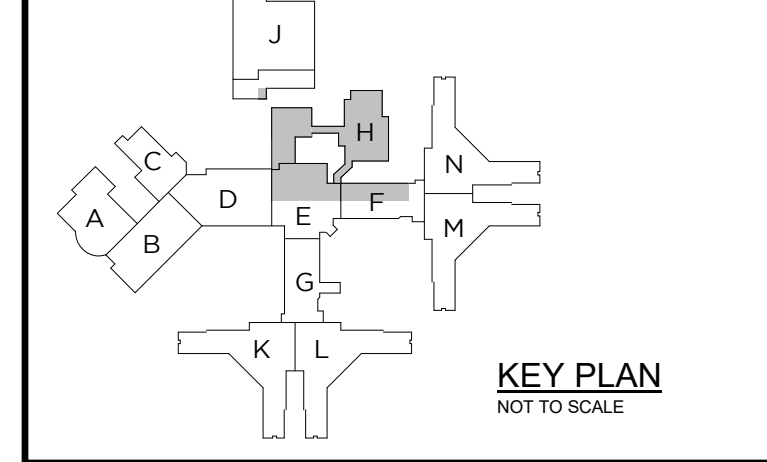

KEY PLAN
NOT TO SCALE

WTAARCH.COM

WTA ARCHITECTS
100 S. Jefferson Ave., Suite 601
Saginaw, Michigan 48607
989.752.8107 COPYRIGHT © 2023

MACMILLAN ASSOCIATES
CONSULTING ENGINEERS
7000 W. MICHIGAN STREET, SUITE 200, BENTON HARBOR, MI 48021
(800) 894-4300 T (800) 894-9778 WWW.MACMILLANASSOCIATES.COM

PROJECT TITLE
491/20167.SDW - PHASE 500:
CENTER FOR FORENSIC
PSYCHIATRY - CREATE
KITCHEN
SALINE, MICHIGAN

SHEET TITLE
ROOF FRAMING PLAN

PROJECT NUMBER 2021094	SHEET NUMBER
PROJECT DATE SEPTEMBER 6, 2023	S2.02
CHECKED BY JAG	

- LEGEND:**
- BP1 - BEARING PLATE, SEE DETAIL 1/S7.01
 - C1 - COLUMN, SEE SCHEDULE SHEET S3.01
 - EF - EXHAUST FAN - PROVIDE ROOF FRAME AT OPENING - SEE DETAIL 5/S7.01, COORDINATE SIZE AND LOCATION WITH MECHANICAL TRADES.
 - H1 - LIGHT GAGE HEADER, SEE SCHEDULE SHEET S3.01
 - HD - SIMPSON SHDU4 HOLDOWN AT WALL END STUDS AND AT OPENING SUPPORT AS SHOWN ON PLAN, SEE DETAIL.
 - L1 - STEEL LINTEL, SEE SCHEDULE SHEET S3.01. (M) INDICATES MECHANICAL LINTEL, COORDINATE LOCATION AND OPENING SIZE WITH MECHANICAL TRADES.
 - MC1 - MOMENT CONNECTION, SEE DETAIL 15/S7.01
 - MP1 - MASONRY PIER
 - RD, FD - ROOF AND FLOOR DRAIN, SEE DETAIL 5/S7.01, COORDINATE SIZE AND LOCATION WITH MECHANICAL TRADES
 - 18K-SP1 - SPECIAL JOIST DESIGNATION, SEE LOAD DIAGRAMS SHEET S3.01
 - 0'-0" - BOTTOM OF ROOF DECK ELEVATION

- NOTES:**
- SEE SHEET S3.01 FOR GENERAL NOTES
 - ALL 8" CMU WALLS REINFORCED WITH #4 AT 48" OC, UNO.
 - PROVIDE FRAMING UNDER MECHANICAL UNIT CURBS PER DETAIL 5/S7.01, COORDINATE SIZE AND LOCATION WITH MECHANICAL, TYP.
 - JOIST GIRDERS TO BEAR DIRECTLY ON COLUMN UNO.

GENERAL

- VERIFY DIMENSIONS BEFORE COMMENCING WORK. REPORT DISCREPANCIES TO THE ARCHITECT.
- VERIFY OPENINGS IN THE FRAMING PLANS WITH THE ARCHITECTURAL, MECHANICAL AND ELECTRICAL DRAWINGS.
- ALL WORK SHALL CONFORM TO MICHIGAN BUILDING CODE 2015.
- DESIGN LOADS
 - DESIGNED IN ACCORDANCE WITH MICHIGAN BUILDING CODE 2015.
 - ROOF SNOW LOAD: GROUND SNOW LOAD PG = 20 PSF
FLAT ROOF SNOW LOAD, PF = 20 PSF
SNOW EXPOSURE FACTOR, CE = 1.0
SNOW LOAD IMPORTANCE FACTOR, I = 1.1
THERMAL FACTOR, CT = 1.0
DRIFTED SNOW LOAD, SEE DIAGRAM THIS SHEET
 - FLOOR LIVE LOADS:

STAIR	100 PSF
CORRIDOR, KITCHEN	100 PSF
MECHANICAL ROOMS	125 PSF
 - WIND LOADS: BASIC WIND SPEED, VULT = 120 MPH
DRIFTED SNOW LOAD, SEE DIAGRAM THIS SHEET
- WIND EXPOSURE C

INTERNAL PRESSURE COEFFICIENT, GC PI = +/-0.18			
EFFECTIVE WIND AREA (FT ²)	POSITIVE PRESSURE (PSF)	NEGATIVE PRESSURE (PSF)	
-END ZONE	10	33	-44
	20	32	-41
	50	30	-38
	100	29	-35
-INTERIOR ZONE	10	33	-36
	20	32	-35
	50	30	-33
	100	29	-31
- EARTHQUAKE DESIGN DATA:
 - SEISMIC RISK CATEGORY III
 - SEISMIC IMPORTANCE FACTOR, I = 1.25
 - SPECTRAL RESPONSE COEFFICIENTS: SDS = 0.104, SD1 = .08
 - SITE CLASS D
 - BASIC SEISMIC - FORCE - RESISTING SYSTEM: SHEAR WALL, MOMENT FRAME
 - SEISMIC DESIGN CATEGORY, B
- SPECIAL INSPECTIONS:
 - SPECIAL INSPECTIONS SHALL BE IN ACCORDANCE WITH THE MICHIGAN BUILDING CODE 2015 SECTION 1700.
 - THE FOLLOWING TYPES OF WORK REQUIRE SPECIAL INSPECTIONS: (REFER TO THE BUILDING CODE AND SPECIFICATIONS FOR DETAILED INSPECTION REQUIREMENTS)
 - PREPARED FILL.
 - CONCRETE CONSTRUCTION.
 - STEEL CONSTRUCTION.
 - MASONRY CONSTRUCTION.
 - SPRAYED FIRE-RESISTIVE MATERIALS.

FOUNDATION NOTES

- FOUNDATIONS ARE DESIGNED BASED ON SOIL BEARING OF 2000 PSF. IF SOIL OF THIS CAPACITY IS NOT FOUND AT THE ELEVATION NOTED, ENLARGE OR LOWER FOOTINGS AT THE DIRECTION OF THE ARCHITECT/ENGINEER.
- PLACE STRUCTURAL BACKFILL MEETING OR EXCEEDING MDOT CLASS II IN LAYERS NOT EXCEEDING 9" LOOSE THICKNESS. COMPACT EACH LAYER TO AT LEAST 95% OF THE MAXIMUM DENSITY PER ASTM D-1557. COMPACTING BY FLOODING IS NOT PERMITTED.
- CENTER FOOTINGS UNDER WALL LOCATION AND COLUMNS UNLESS NOTED.
- EARTH FORMS ARE NOT PERMITTED UNLESS SPECIFICALLY NOTED.
- DISTURBANCE OF THE FOUNDATION BEARING SOILS SHALL BE AVOIDED.
- EXISTING FOUNDATIONS OR FLOOR SLAB ENCOUNTERED DURING SITE GRADINGS AND EXCAVATION SHALL BE REMOVED TO A DEPTH OF TWO (2) FEET BELOW NEW CONSTRUCTION. REPLACE WITH STRUCTURAL BACKFILL.
- PROVIDE BOND BREAK MATERIAL BETWEEN ALL GRADE SLABS AND VERTICAL SURFACES.
- BACKFILL AND EXCAVATION PER SPECIFICATIONS.
- FOLLOWING DEMOLITION OF STRUCTURES AND STRIPPING OF TOPSOIL, PREPARE SOILS IN ACCORDANCE WITH SOILS REPORT BY SME DATED FEBRUARY 9, 2022.

CONCRETE NOTES

- ACI BUILDING CODE (318-14); MANUAL OF STANDARD PRACTICE FOR DETAILING (315) FOR THE MIXING, FABRICATION AND PLACEMENT OF CONCRETE, REINFORCING STEEL AND ACCESSORIES.
- CONCRETE STRENGTH - STANDARD WEIGHT CONCRETE:

FOOTINGS, WALLS, PIERS:	FC = 3000 MINIMUM PSI
CONCRETE SLABS ON GRADE:	FC = 3500 MINIMUM PSI
EXTERIOR CONCRETE SLABS EXPOSED TO DE-ICING:	FC = 4500 MINIMUM PSI
- REINFORCING - BARS: ASTM A-615 GRADE 60
WELDED WIRE FABRIC: ASTM A-1064
- CONCRETE SLABS ON GRADE REINFORCING: 5/8" - W1.4XW1.4 WWF UNLESS NOTED. LOCATED IN THE UPPER 1/3 OF SLAB THICKNESS.
- PROVIDE SAWCUT CONTROL JOINTS AT APPROXIMATELY 20' ON CENTER EACH WAY IN SLABS ON GRADE. SEE DETAILS. LOCATE JOINTS UNDER PARTITIONS WHENEVER POSSIBLE. CONSTRUCTION JOINTS AT CONTRACTOR'S OPTION.
- DEPRESS SLABS AS REQUIRED FOR FLOOR FINISHES. SEE ARCHITECT.
- SLOPE FLOORS AS REQUIRED TO FLOOR DRAINS. SEE ARCHITECT.
- FORM ALL CONCRETE.
- EXPOSED EDGES OF CONCRETE BEAMS, COLUMNS, ETC. SHALL BE CHAMFERED 1/4".
- PROVIDE CORNER BARS FOR ALL CONTIGUOUS CORNERS.
- WATER-CEMENT RATIO LIMITS:

FC = 3000 PSI	0.58 NON-AIR ENTRAINED, 0.55 AIR ENTRAINED
FC = 3500 PSI	0.62 NON-AIR ENTRAINED, 0.50 AIR ENTRAINED
FC = 4500 PSI	0.4 AIR-ENTRAINED
- SLUMP LIMITS:

3" FOR FOUNDATIONS, 4" FOR SLABS AND WALLS
--
- PROVIDE AIR ENTRAINED CONCRETE FOR EXTERIOR EXPOSURES.
- CONTRACTOR TO SUBMIT SIZE AND LAYOUT OF CONCRETE WALL SLEEVES, OPENINGS, ETC. FOR REVIEW PRIOR TO CONCRETE PLACEMENT.
- REINFORCING LAP LENGTH: 45 BAR DIAMETERS (36" STAGGERED) FOR BARS UP TO #5, 60 BAR DIAMETERS (48" IF STAGGERED) FOR BARS LARGER THAN #5.

MASONRY NOTES

- WORK SHALL BE PERFORMED IN ACCORDANCE WITH ACI 530 SPECIFICATIONS.
- MORTAR: AS SPECIFIED.
- GROUT: ASTM C476, F'C=2000 PSI, TESTED PER ASTM C1019.
- REINFORCING BARS SHALL BE ASTM A-615, GRADE 60, LAP MINIMUM 40 BAR DIAMETERS FOR #5 BARS AND SMALLER, LAP MINIMUM 60 BAR DIAMETERS FOR BARS LARGER THAN #5 UNLESS NOTED OTHERWISE.
- HORIZONTAL WALL REINFORCING: PER ASTM A-82, 9 GA. HOT DIPPED GALVANIZED PER ASTM A-153 (1.5 OZ PER SF). LADDER TYPE, EQUAL TO DUR-A-WAL. BED JOINTS AT 10" O.C. AND AT 1" AND 1" BED JOINTS AT BOTTOM OF WALL. TOP OF WALL ABOVE LINTELS AND BELOW SILLS. REINFORCING CONTINUOUS EXCEPT AT VERTICAL CONTROL JOINTS. SIDE RODS LAPPED A MINIMUM OF 6" AT SPLICES. PROVIDE PREFABRICATED CORNERS AND TEES.
- CONCRETE MASONRY UNITS: ASTM C-90, GRADE N, TWO CORE TYPE FOR REINFORCED MASONRY. DESIGN BASED ON FM 4-2000 PSI.
- VERTICAL WALL REINFORCING: 1 - #5 EACH SIDE OF MASONRY OPENINGS, CONTROL JOINTS AND AS SHOWN. IN GROUT FILLED BLOCK CORES.
- VERTICAL BAR REINFORCING: PLACE ACCURATELY AND MECHANICALLY HOLD IN POSITION WHILE GROUTING. GROUTING SHALL BE DONE IN LIFTS NOT EXCEEDING 4'-0" AND MECHANICALLY CONSOLIDATED IN PLACE; CONSOLIDATION BY RODDING NOT ACCEPTABLE.
- PROVIDE COMPLETELY GROUTED UNITS:
 - UNDER PRECAST FLOOR PLANK BEARING
 - UNDER CAST-IN-PLACE CONCRETE FLOOR BEARING
 - UNDER PRECAST ARCHITECTURAL CONCRETE PANEL BEARING
 - UNDER BRICK VENEER BEARING
 - UNDER ANY CHANGE OF WALL THICKNESS, I.E.: 8" ON TOP OF 12"
 - UNDER STEEL JOIST OR BEAM BEARING.
- PROVIDE LINTELS FOR OPENINGS IN MASONRY WALLS OVER 8" WIDE. SEE SCHEDULE(S).
- RUNNING BOND MASONRY SHALL BE BUILT INTEGRALLY AT WALL CORNERS UNLESS INDICATED OTHERWISE.
- BLOCK CONTROL JOINTS SHALL BE "MICHIGAN" TYPE UNLESS NOTED OTHERWISE. HORIZONTAL REINFORCING SHALL BE DISCONTINUOUS AT CONTROL JOINTS.
- TEMPORARY WALL BRACING IS THE CONTRACTORS RESPONSIBILITY. CONFORM TO APPLICABLE CODES AND STANDARDS.
- CONTRACTOR SHALL KEEP THE AIR SPACE CAVITY BETWEEN THE CONCRETE MASONRY AND VENEER COMPLETELY CLEAR OF MORTAR AND DEBRIS.

STRUCTURAL STEEL

- STRUCTURAL STEEL: FABRICATED AND ERRECTED PER THE AISC MANUAL OF STEEL CONSTRUCTION.

W-BEAMS:	ASTM A-992 GR. 50
HSS:	ASTM A-500 GRADE B
STEEL PIPE:	ASTM A53, TYPE E, GRADE B.
ALL OTHER SHAPES:	ASTM A-36
- ANCHOR RODS: 36 KSI, ASTM F-1554.
- WELDS: TO BE 70 KSI LOW HYDROGEN FILLER METAL PLACED BY WELDERS CERTIFIED IN WELD POSITION BY AWS D1.1, STRUCTURAL WELDING CODE. ALL WELDS SHALL BE APPLIED TO SURFACES FREE OF GREASE, PAINT, DIRT, OR OTHER HARMFUL MATERIAL.
- BOLTED CONNECTIONS: 3/4" DIAMETER A-325 BOLTS WITH HEAVY HEX NUTS UNLESS NOTED. DESIGNED FOR BEARING CONNECTIONS, TIGHTENED TO **SNUG TIGHT** CRITERIA UNLESS NOTED OTHERWISE.
- STEEL PRIMER: RUST INHIBITING ALKYD INDUSTRIAL PRIMER, SSPC 6, 1.5 MIL MINIMUM THICKNESS EXCEPT STEEL WHICH WILL RECEIVE SPRAYED-ON FIRE PROOFING.
- BEAM CONNECTIONS SHALL BE DESIGNED TO SUPPORT ONE-HALF THE TOTAL UNIFORM LOAD CAPACITY PER AISC. WHEREVER POSSIBLE, EXTEND CONNECTIONS FULL DEPTH OF BEAM.
- SHEAR TAB CONNECTIONS TO STEEL BEAMS ARE NOT ACCEPTABLE UNLESS BEAMS OF EQUAL DEPTHS ARE FASTENED ON OPPOSITE SIDES OF THE STEEL BEAM.
- BEAM BEARING PLATES ARE TO BE LOCATED ON CENTER OF WALL UNLESS NOTED OTHERWISE. BEAR BEAM FULL LENGTH OF BEARING PLATES.
- WHERE BEAMS BEAR ON COLUMNS, BEAMS BEAR ON BEAMS, BEAMS HANG FROM BEAMS, OR COLUMNS BEAR ON BEAMS, STIFFENER PLATES MINIMUM 1/4" THICK.
- TEMPORARY BRACING IS TO BE MAINTAINED UNTIL PERMANENT CONNECTIONS ARE COMPLETED, APPROVED, AND SUPPORTED SLABS ARE CAST AND CURED.
- INSTALL BRICK SUPPORT SHELF MEMBERS AFTER ALL SUPPORTED CONCRETE FLOOR SLABS AND ROOF DECK WITH ROOFING IS IN PLACE.
- BEAMS AND GIRDERS HAVE BEEN DESIGNED WITHOUT SHORING REQUIRED. INSTALLATION OF SHORING IS PERMITTED AT CONTRACTOR'S OPTION. ANTICIPATED BEAM DEFLECTION UNDER WET CONCRETE LOAD IS SPAN/360, 3/4" MAX.
- DO NOT ALLOW LOADS ON SLAB UNTIL CONCRETE HAS ATTAINED A MINIMUM OF 75% OF THE 28-DAY SPECIFIED STRENGTH.
- OPEN WEB STEEL JOIST: DESIGN, FABRICATE AND ERRECT PER STEEL JOIST INSTITUTE (SJI) SPECIFICATIONS.
 - ITEMS SUPPORTED BY JOISTS SHALL BE ATTACHED AT PANEL POINTS WHERE POSSIBLE. SEE JOIST REINFORCEMENT DETAIL FOR NON-PANEL POINT LOADING.
 - WELDING OF SUPPORTS TO JOISTS WILL NOT BE PERMITTED UNLESS SPECIFICALLY NOTED.
 - NO STRUCTURAL MEMBER INCLUDING OPEN WEB STEEL JOIST SHALL BE CUT OR MODIFIED WITHOUT PRIOR WRITTEN APPROVAL OF THE JOIST MANUFACTURER AND THE ARCHITECT/ENGINEER.
 - BRIDGING: SIZED NOT LESS THAN MINIMUM REQUIREMENT OF SJI.
 - SPECIAL LOADING CONDITIONS ARE SHOWN ON THE DRAWINGS AND SHALL BE USED IN THE DESIGN OF THE STEEL JOIST AS INDICATED ON THE PLANS.
 - PROVIDE UPLIFT BRIDGING PER SJI. STEEL JOISTS SHALL BE DESIGNED FOR A NET UPLIFT PRESSURE OF 7 PSF.
 - JOIST GIRDERS TO BE DESIGNED FOR L600 DEFLECTION UNLESS NOTED OTHERWISE.

METAL DECK




- ROOF DECK: 1/2", 20 GAUGE, WIDE RIB, MINIMUM 3 SPANS. DESIGNED AND FABRICATED PER STEEL DECK INSTITUTE SPECIFICATIONS (SDI). WELD TO SUPPORTS WITH 5/8" DIAMETER PUDDLE WELDS 12" SPACING. FASTEN SIDE LAPS WITH #10 SCREWS AT 3'-0" MAXIMUM.
- FORM DECK: 1.0C20: S MIN = 167 IN/3FT, I MIN = .088 IN/4FT GALVANIZED.
1.5C20: S MIN = 224 IN/3FT, I MIN = .197 IN/4FT GALVANIZED.
CAPABLE OF SUPPORTING WET CONCRETE LOAD WITHOUT SHORING. WELD TO STEEL PER MANUFACTURER'S RECOMMENDATIONS.
- DECK FINISH: AS SPECIFIED.
- ROOF DECK OPENINGS LARGER THAN 12" SHALL BE REINFORCED WITH A STEEL ROOF FRAME. SEE ROOF FRAME DETAIL ON DRAWINGS.

LIGHT GAGE METAL FRAMING


- ALL STUDS SHALL BE FORMED FROM HOT-DIPPED GALVANIZED STEEL, G-60 COATING, CORRESPONDING TO THE REQUIREMENTS OF ASTM A653, STRUCTURAL QUALITY, GRADE 33, WITH A MINIMUM YIELD OF 33 KSI. MEMBERS DESIGNED PER AMERICAN IRON AND STEEL INSTITUTE (AISI) "SPECIFICATION FOR THE DESIGN OF COLD FORMED STEEL STRUCTURAL MEMBERS". MEMBER DESIGNATIONS IN ACCORDANCE WITH THE STEEL STUD MANUFACTURERS ASSOCIATION (SSMA) I.E. 600-S-162-33.
- MEMBER SIZES INDICATED ON THE DRAWINGS AND CAPABLE OF SUPPORTING THE AS INDICATED IN GENERAL NOTE "GENERAL 1 D" FOR WALL COMPONENTS AND CLADDINGS PRESSURES.
- MAX. ALLOWABLE DEFLECTION: L/600; BRICK VENEER SUPPORT, L/240; OTHER.
- CONTRACTOR TO BE RESPONSIBLE FOR FINAL DESIGN OF LIGHT GAGE FRAMING MEMBERS, CONNECTIONS AND COMPONENTS. SHOP DRAWINGS SHALL BE PREPARED UNDER THE SUPERVISION OF A REGISTERED PROFESSIONAL ENGINEER IN THE STATE OF MICHIGAN AND SUBMITTED TO THE ARCHITECT/ENGINEER FOR REVIEW.

PLYWOOD SHEATHING


- PLYWOOD FOR WALLS SHALL BE 1/2" THICK APA RATED SHEATHING. (24/16)
- ROOF SHEATHING FASTENED WITH #8 SCREWS AT 6" O.C. AT PANEL EDGES AND INTERMEDIATE SUPPORTS UNLESS NOTED OTHERWISE.
- PANELS SHALL BE LAID IN A STAGGERED PATTERN, CONTINUOUS OVER TWO SPANS.

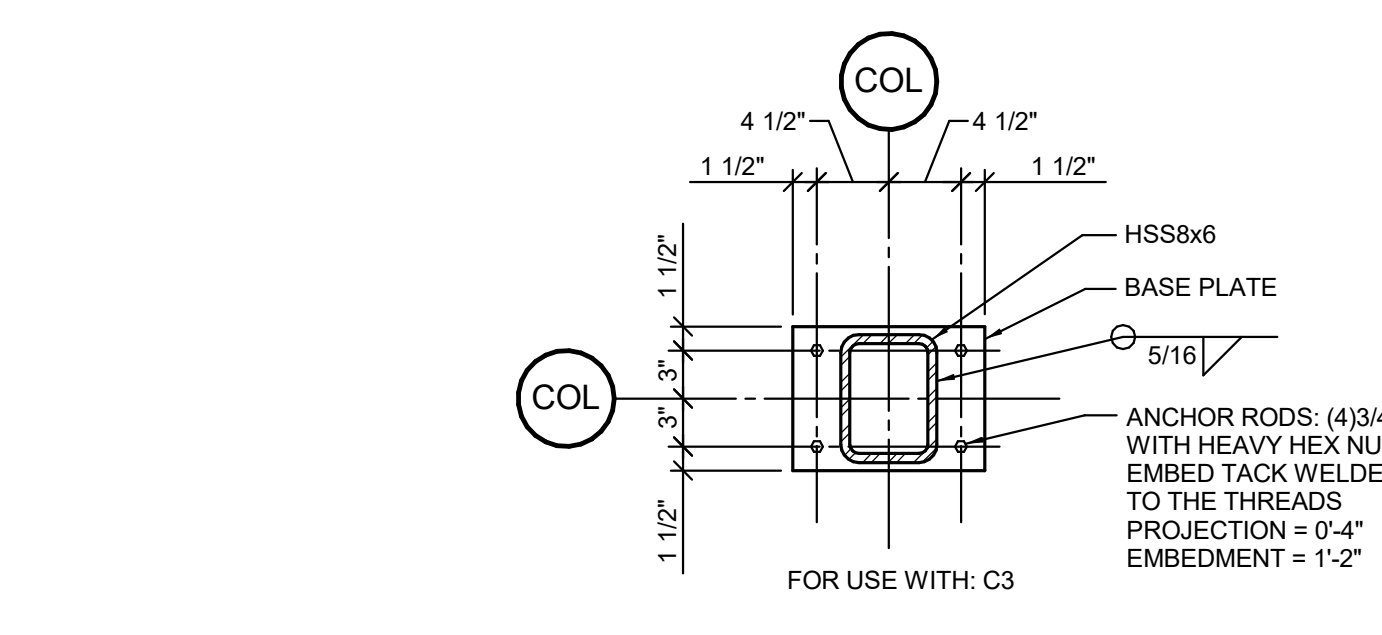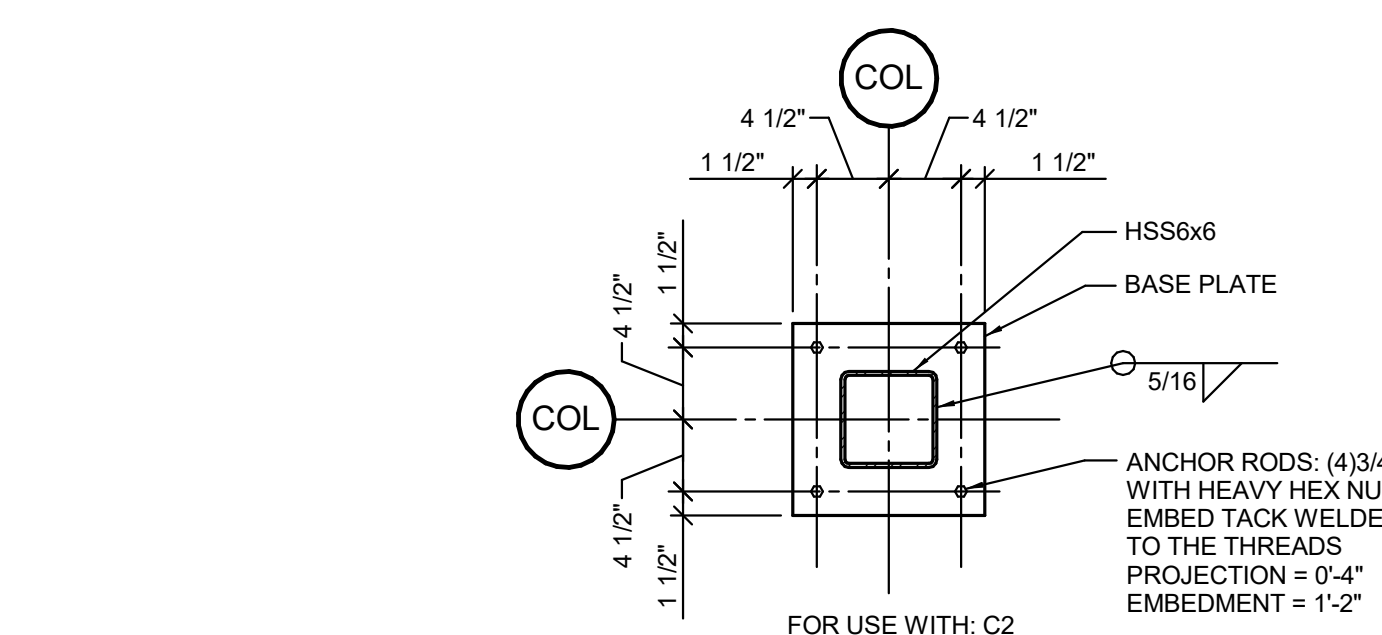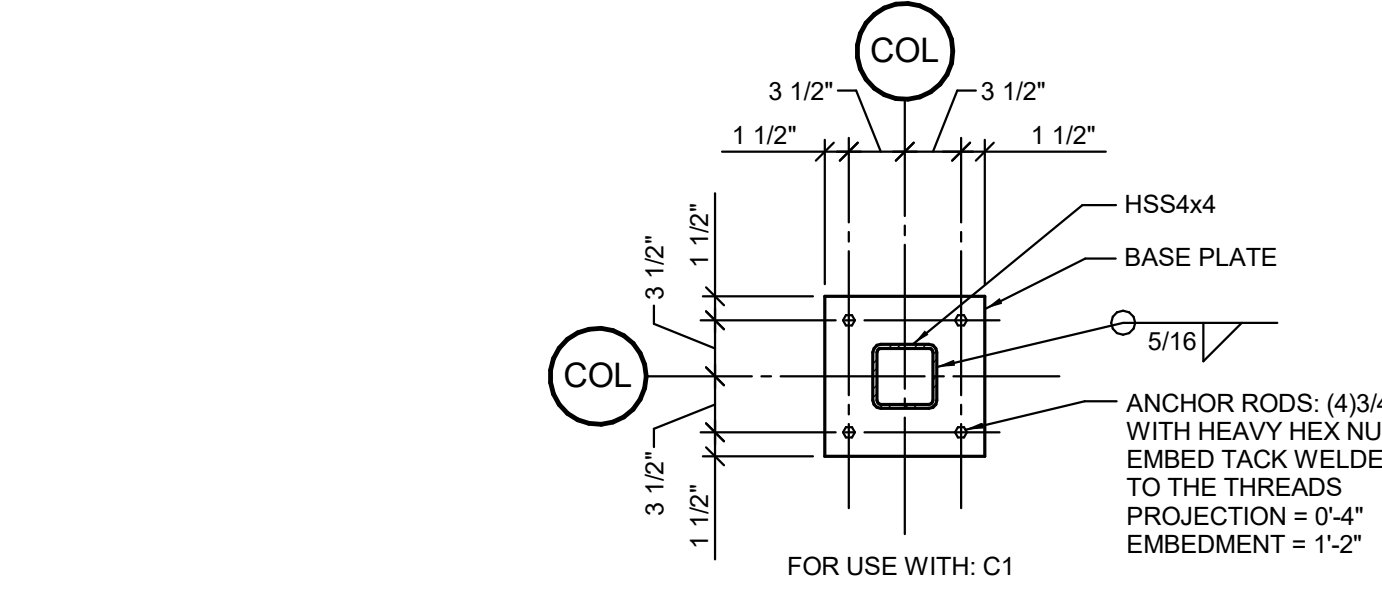


ANCHOR ROD LAYOUTS

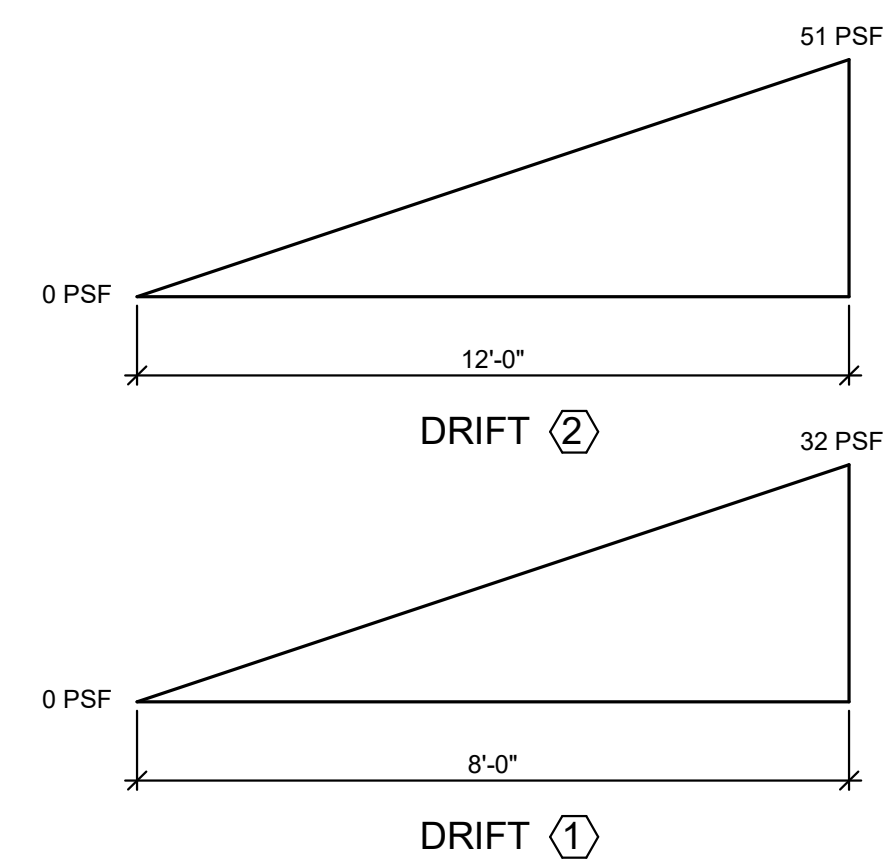

SNOW DRIFT LOAD DIAGRAM

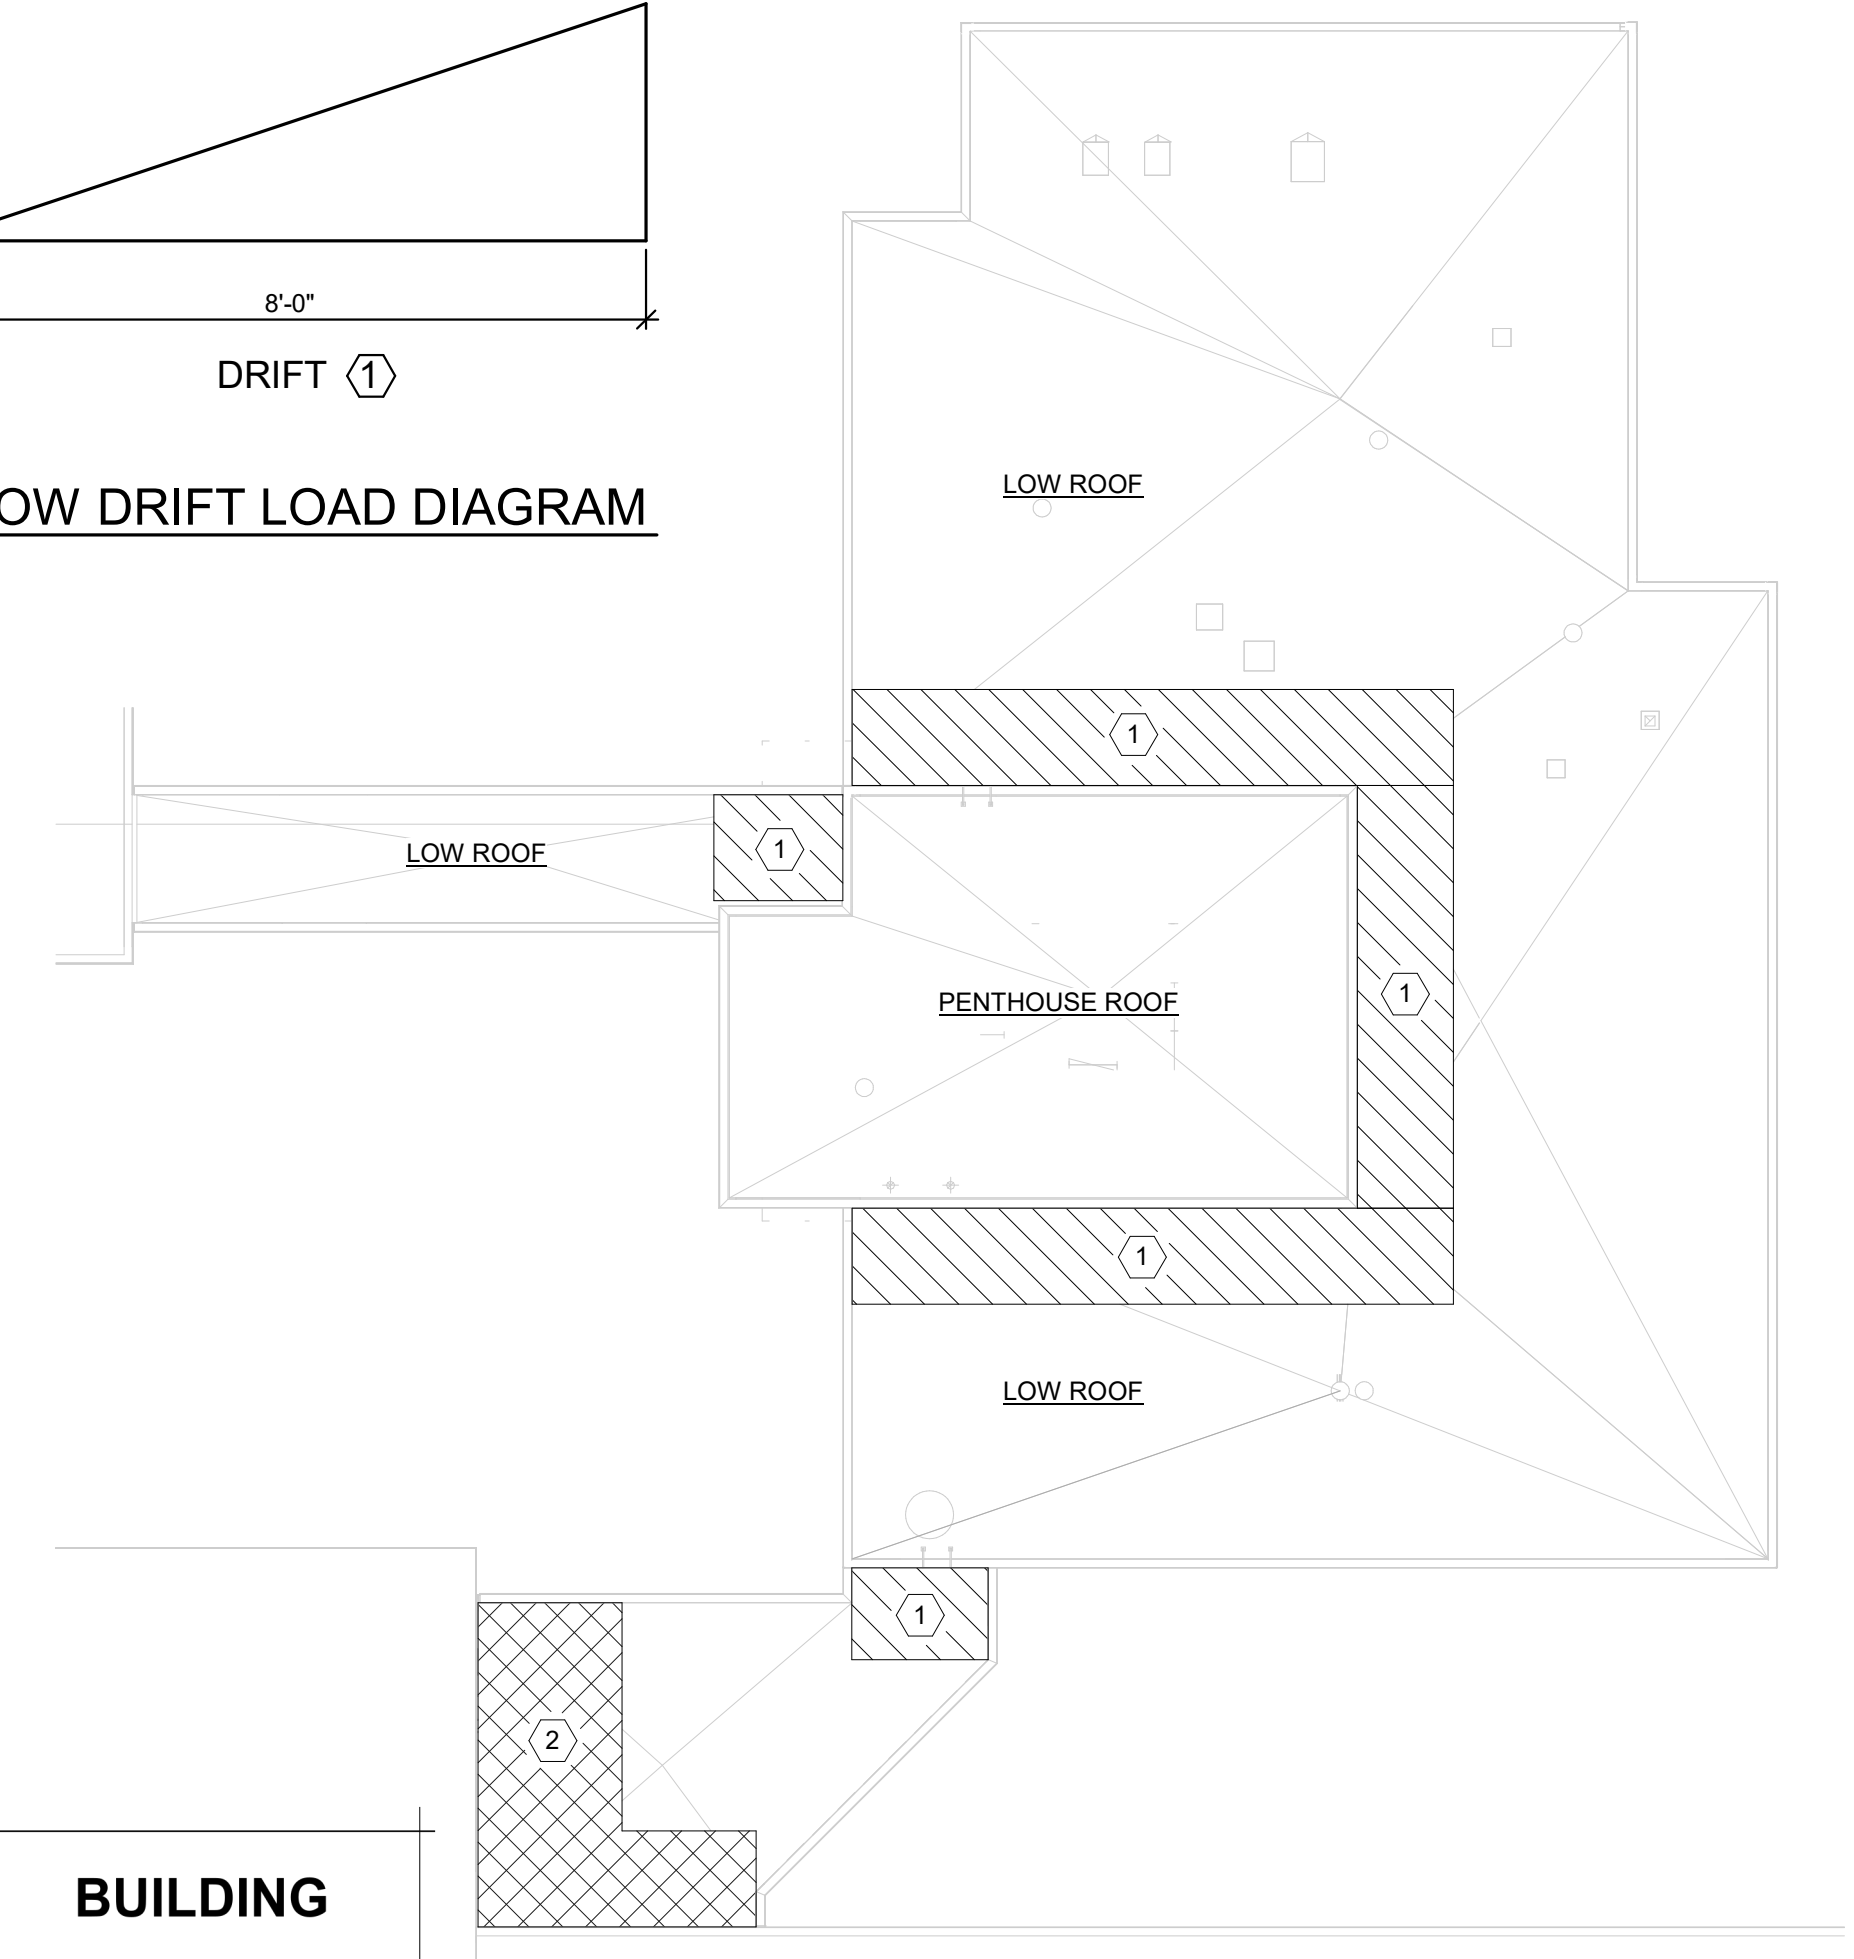

SNOW DRIFTING DIAGRAM - PLAN

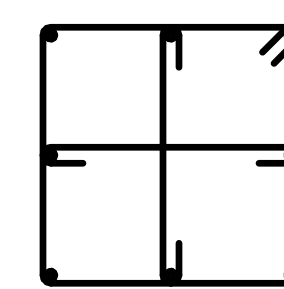

FOR USE WITH: P1

VERTICAL REINFORCEMENT LAYOUT

FOOTING SCHEDULE Fy=60 KSI, Fc=3000 PSI

MARK	SIZE	DEPTH	REINFORCING	DESCRIPTION
F1	1'-8" x CONT	1'-0"	(2) #5 CONT	-
F2	2'-0" x CONT	1'-0"	(2) #5 CONT	-
F3	4'-0" x 6'-0"	1'-0"	(3) #5 EACH WAY	-
F4	5'-0" x 6'-0"	1'-0"	(6) #5 EACH WAY	-
F5	7'-0" x 7'-0"	1'-6"	(8) #5 EACH WAY	-
F6	9'-0" x 9'-0"	1'-6"	(10) #6 EW, T&B	-

PIER SCHEDULE Fy=60ksi, Fc=3000 psi

MARK	SIZE	VERT REINF	TIES	REMARKS
P1	20"x20"	(8) #6	#3 AT 12"OC	-

SEE VERTICAL REINFORCEMENT LAYOUT THIS SHEET
TOP OF PIER = 99'-4" (UNO)

COLUMN SCHEDULE W SECTIONS: Fy=50KSI, HSS SECTIONS: Fy=48ksi

MARK	SIZE	BASE PL	CAP PL	REMARKS
C1	HSS4x4x1/4	3/4"x10"x10"	1/2"	-
C2	HSS6x6x1/2	1 1/8"x12"x12"	1 1/4"x8"x1-1"	-
C3	HSS8x6x5/8	3/4"x10"x12"	1/2"	-
C3A	HSS8x6x5/8	3/4"x10"x12"	1 1/4"x8"x1-1"	-

STEEL LINTEL SCHEDULE Fy=36 KSI

MARK	CLEAR SPAN	SIZE	BEARING EACH END
L1	4'-0"	L3 1/2x2 1/2x1/4 SLV	4"
L2	5'-0"	L3 1/2x3x1/4 SLV	6"
L3	6'-0"	L3 1/2x3 1/2x1/4	6"
L4	7'-0"	L4x3 1/2x1/4 LLV	6"
L5	8'-0"	L5x3 1/2x1/4 LLV	8"
L6	9'-0"	L6x3 1/2x 3/8 LLV	8"




DETAILS: L9 - 1/4" STIFF AT 2'-0" FROM END; L8, L9 - 1/2" @ COL; L7, L11 - 5", 5"; L10 - 1/2" @ COL. LINTELS SCHEDULED FOR SINGLE 4" OF WALL THICKNESS. PROVIDE 2 FOR 8" WALL, 3 FOR 10" WALL W/ 3" HORIZ LEGS AND 3 FOR 12" WALL. DETAIL 1587.01, BP1 AT CMU WALL.

- NOTE: 1. GROUT BELOW BEAM BEARING PER DETAIL 1/57.01.
2. BEARING LENGTH IS OVER CMU OR COMPOSITE BRICK/BLOCK. DO NOT BEAR ON BRICK VENEER.
3. ANCHOR MASONRY TO BEAMS WITH 9 GA WIRE TIES EACH SIDE AT 2'-0" O.C.
4. PROVIDE STEEL LINTELS AT ALL MASONRY WALL OPENINGS, INCLUDING MECHANICAL AND ELECTRICAL GREATER THAN 8" WIDE. SEE LINTEL SCHEDULE.


HEADER SCHEDULE

MARK	SIZE	MIN BEARING
H1	(2) 600S162-68	(2) STUDS
H2	(2) 800S300-97	(2) STUDS

NOTE: PROVIDE (2) FULL HEIGHT STUDS ON EITHER SIDE OF BEARING STUDS

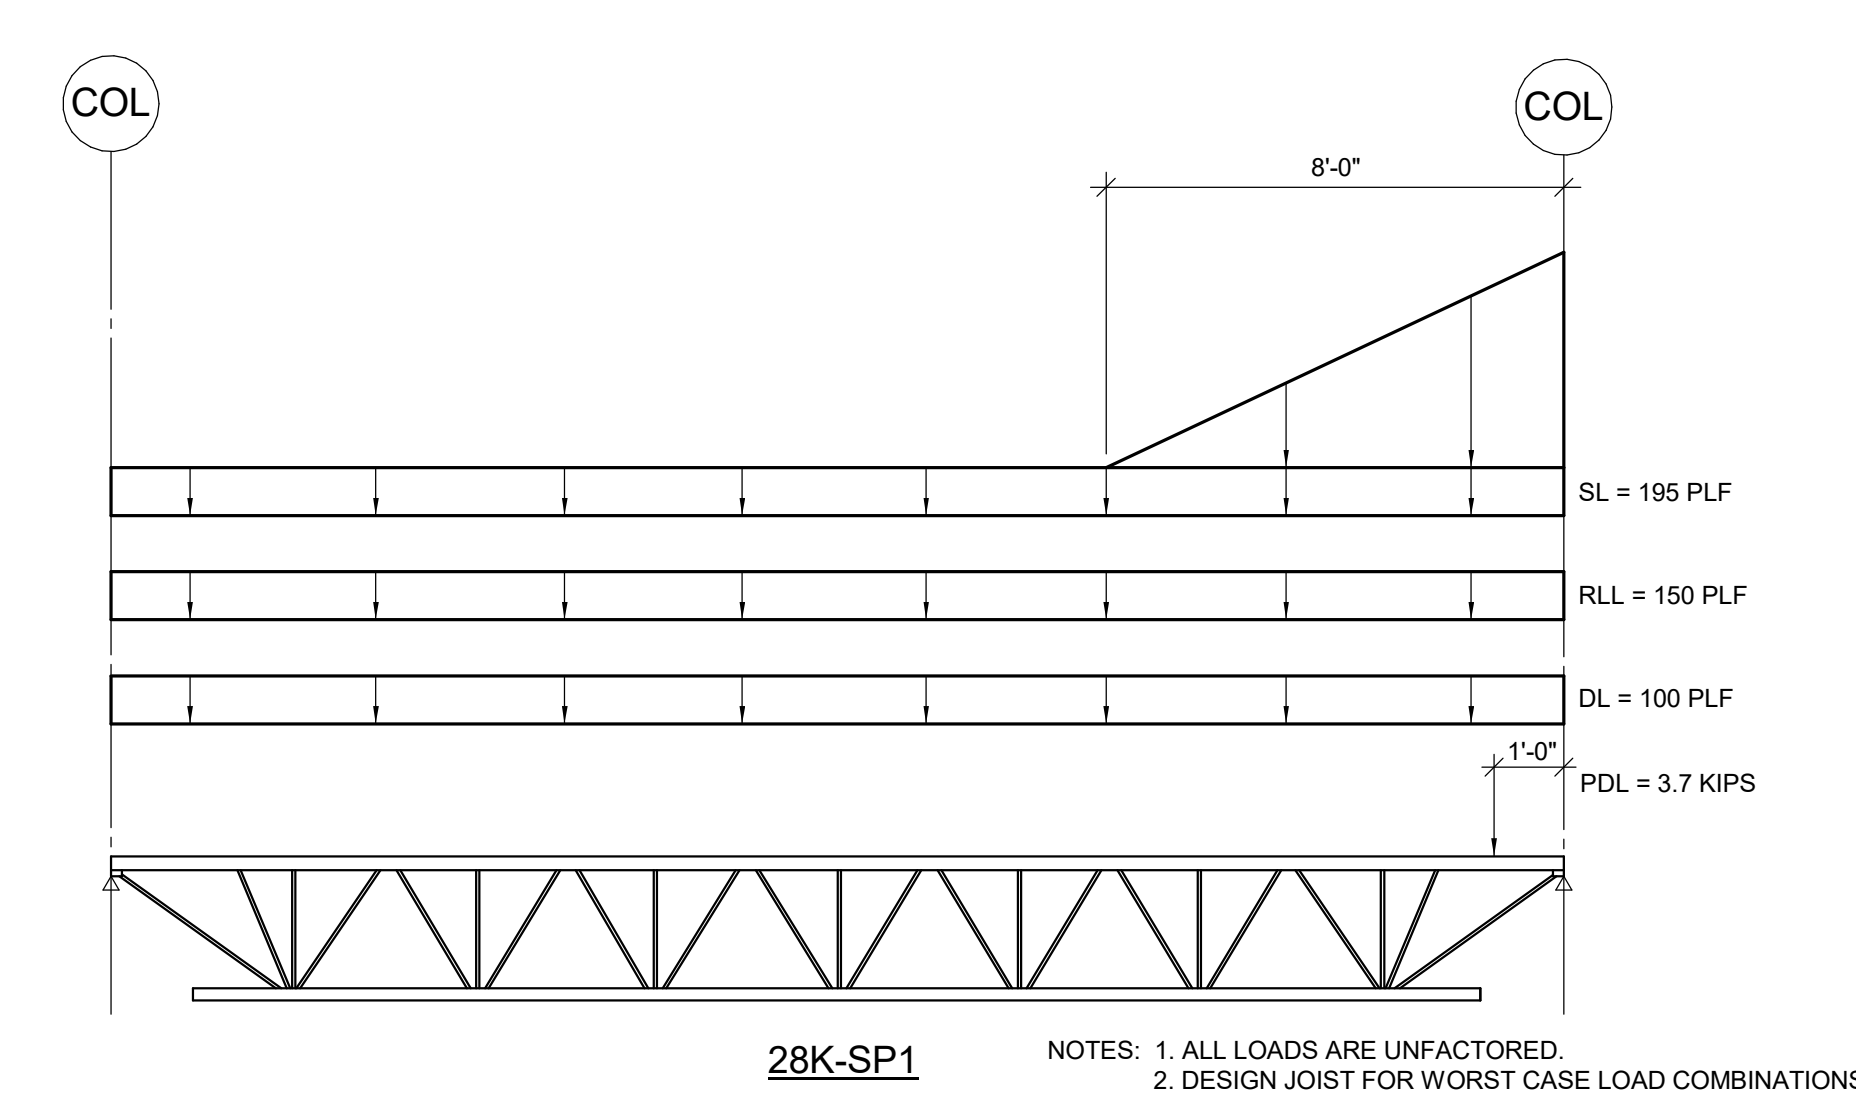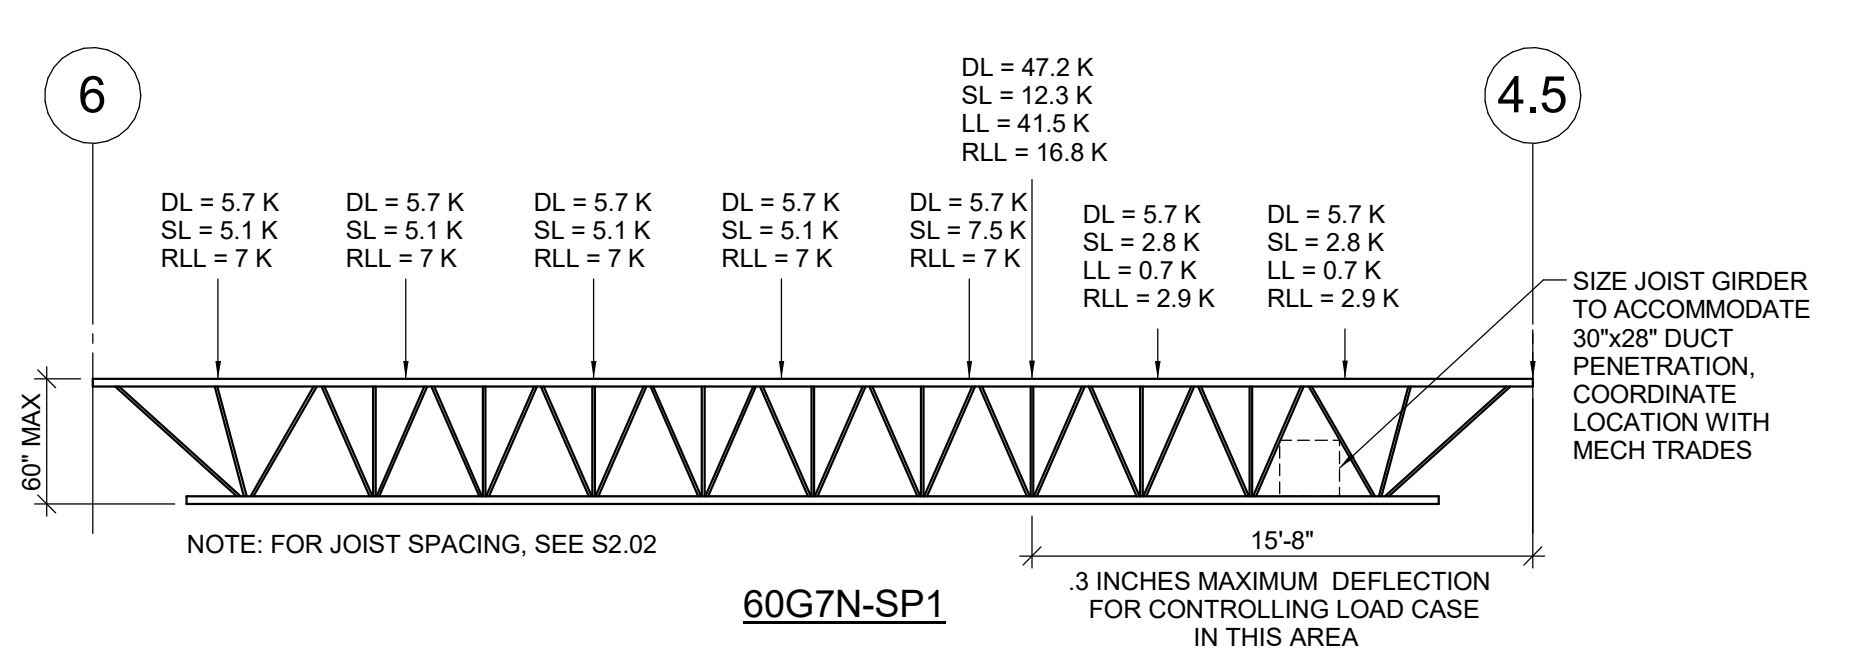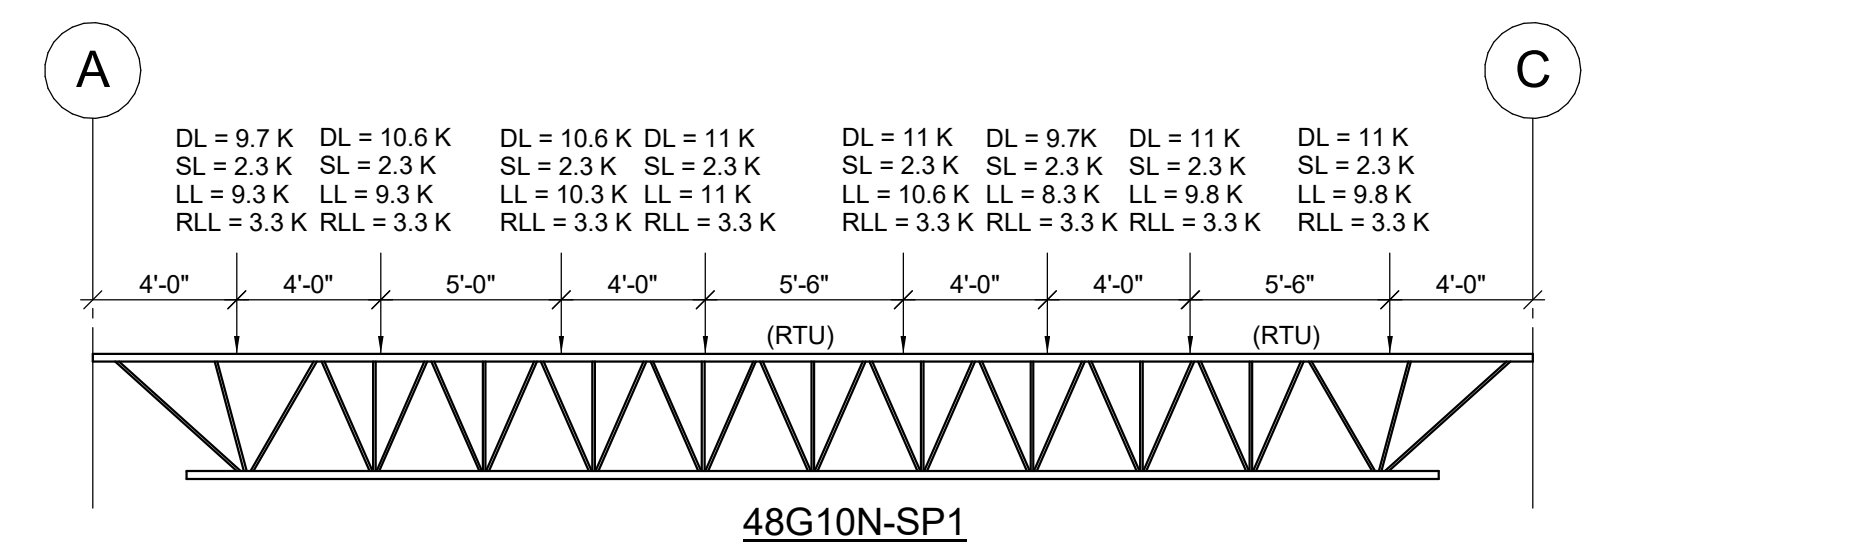


SPECIAL JOIST DIAGRAM

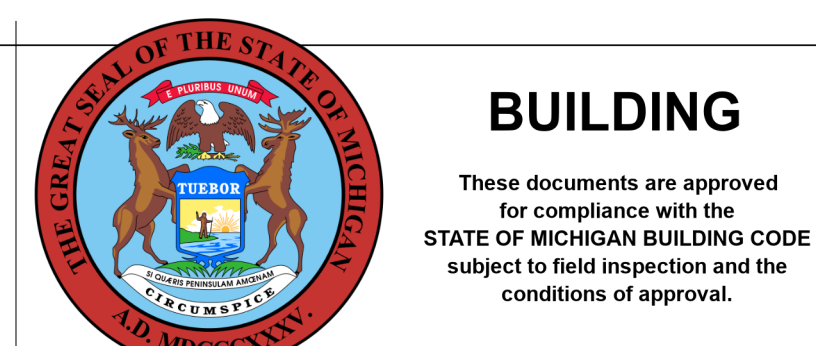


BUILDING
These documents are approved for compliance with the STATE OF MICHIGAN BUILDING CODE subject to field inspection and the conditions of approval.


NO.	REVISION	DATE
STATE OF MICHIGAN DEPARTMENT OF TECHNOLOGY, MANAGEMENT AND BUDGET FACILITIES AND BUSINESS SERVICES ADMINISTRATION DESIGN AND CONSTRUCTION DIVISION ADAM LACH, RA, DIRECTOR		
FILE NO:	491/20167.SDW	
FUNDING CODE:	17ICODHHS7255	CONTRACT NO. Y22003
KEY PLAN NOT TO SCALE		
WTAARCH.COM WTA ARCHITECTS 100 S Jefferson Ave, Suite 601 Saginaw, Michigan 48607 989 752 8107 COPYRIGHT © 2023		
MACMILLAN ASSOCIATES CONSULTING ENGINEERS 6801 BSA 4300 E (800) 894-9799 WWW.MACMILLANASSOCIATES.COM		
PROJECT TITLE:	491/20167.SDW - PHASE 500:	
CENTER FOR FORENSIC PSYCHIATRY - CREATE KITCHEN SALINE, MICHIGAN		
SHEET TITLE: NOTES AND SCHEDULES		
PROJECT NUMBER:	2021094	SHEET NUMBER
PROJECT DATE:	SEPTEMBER 6, 2023	S3.01
CHECKED BY:	JAG	

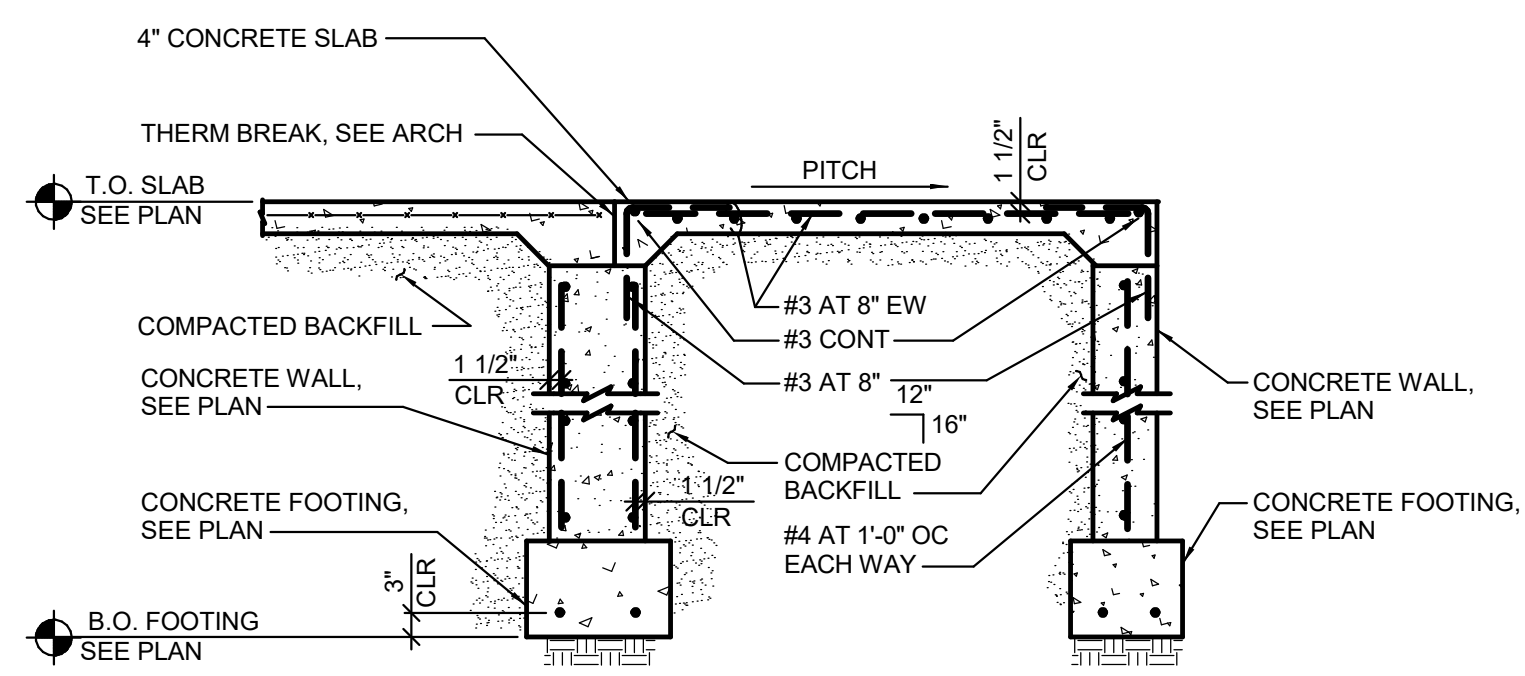


1 ENTRY SLAB
S5.01 1/2" = 1'-0"

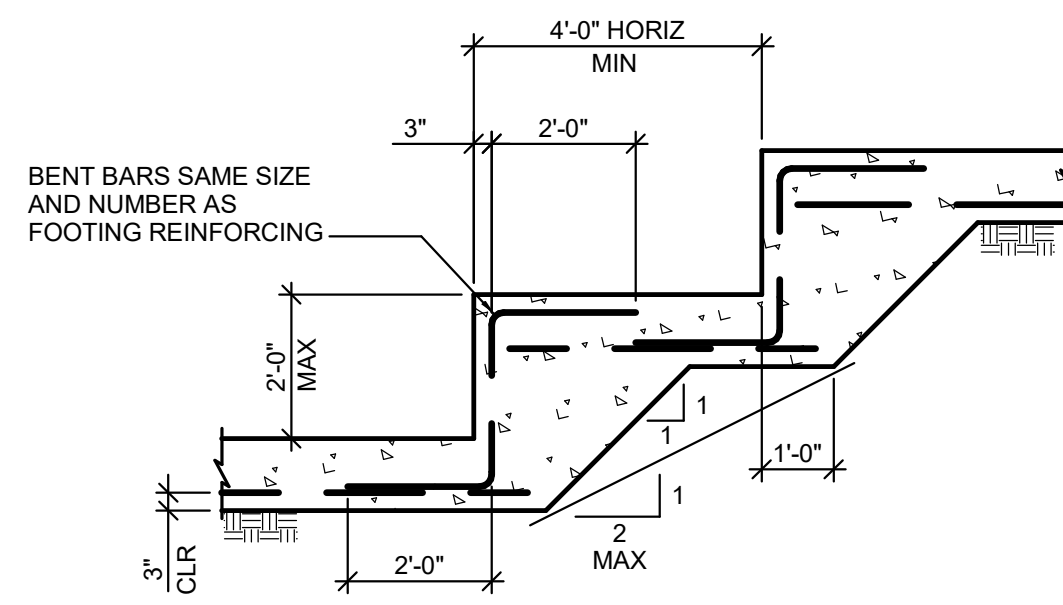


2 STEP FOOTING
S5.01 3/8" = 1'-0"

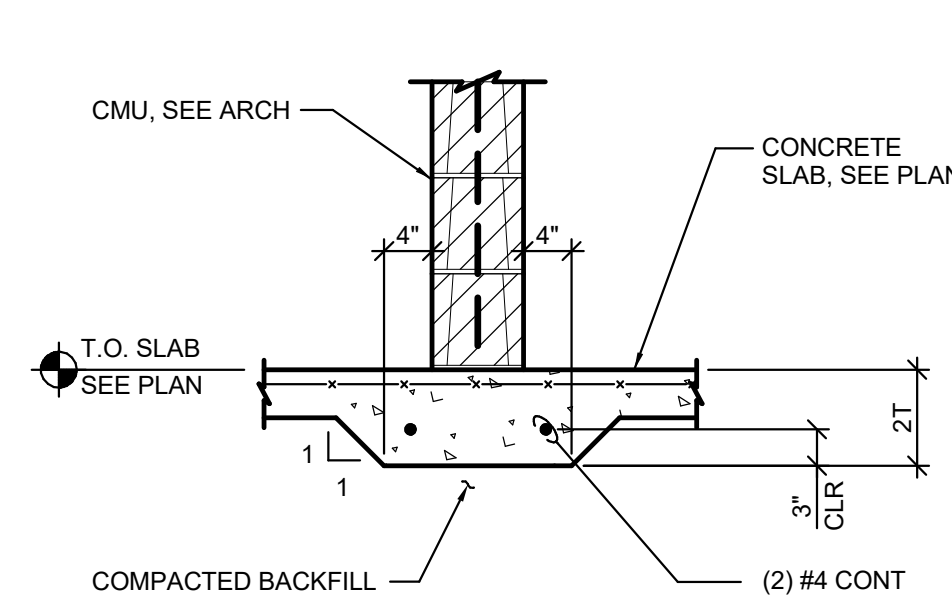


3 THICKENED SLAB
S5.01 3/4" = 1'-0"

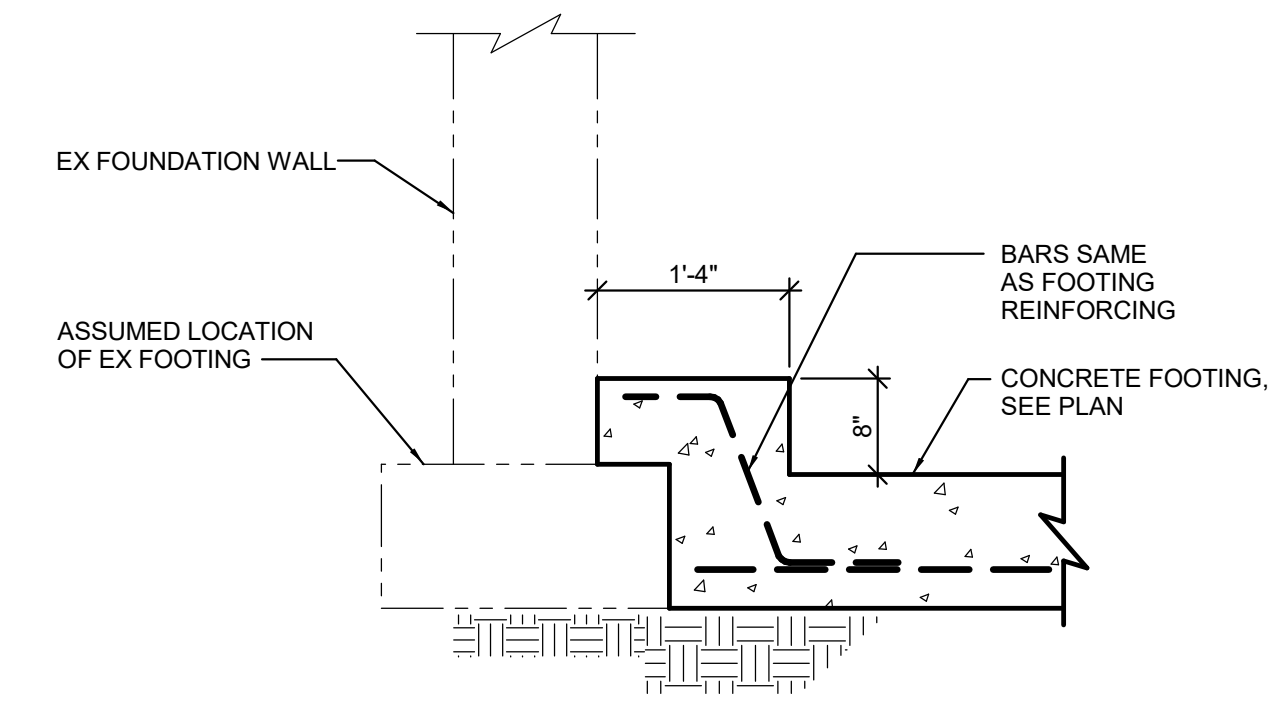


4 NEW FOOTING AT EXISTING
S5.01 3/4" = 1'-0"

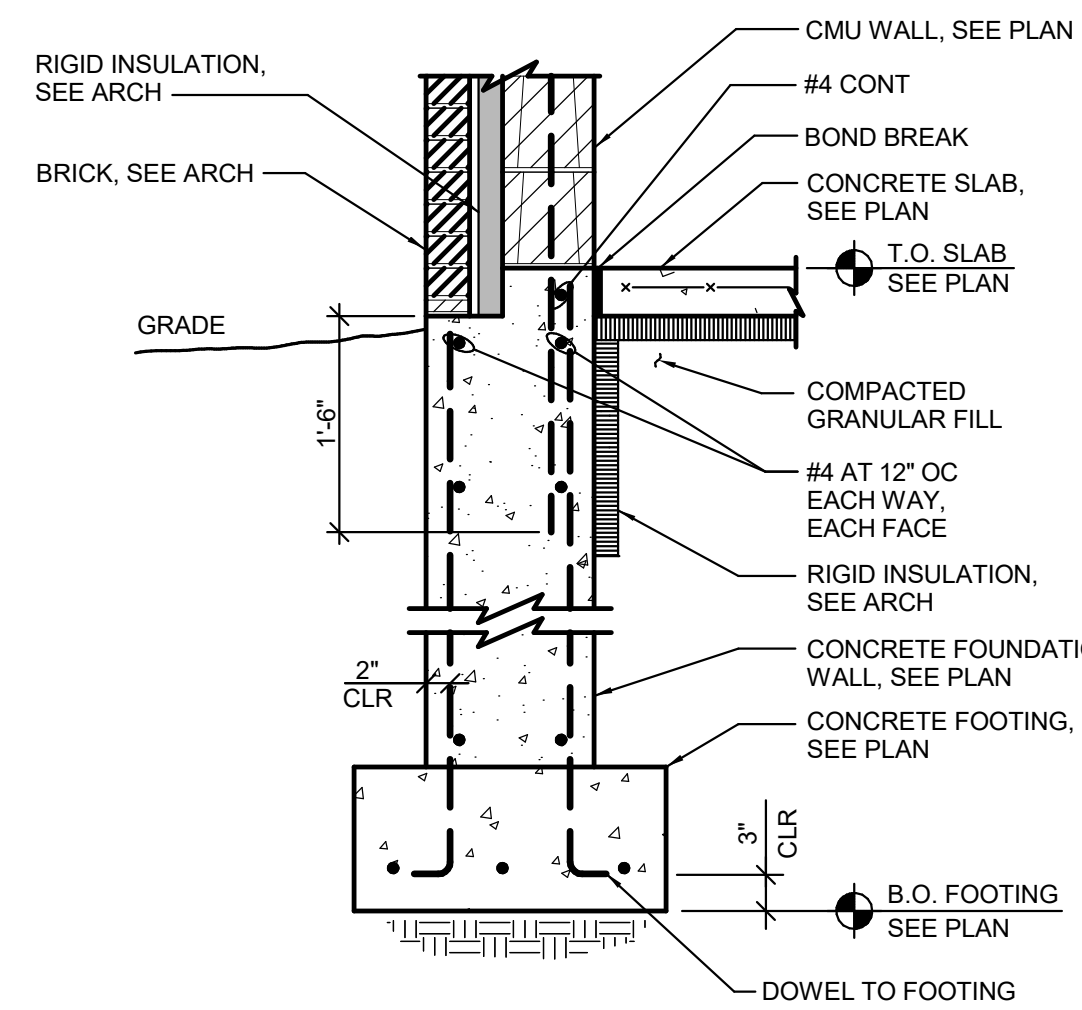


5 EXTERIOR WALL FOOTING
S5.01 3/4" = 1'-0"

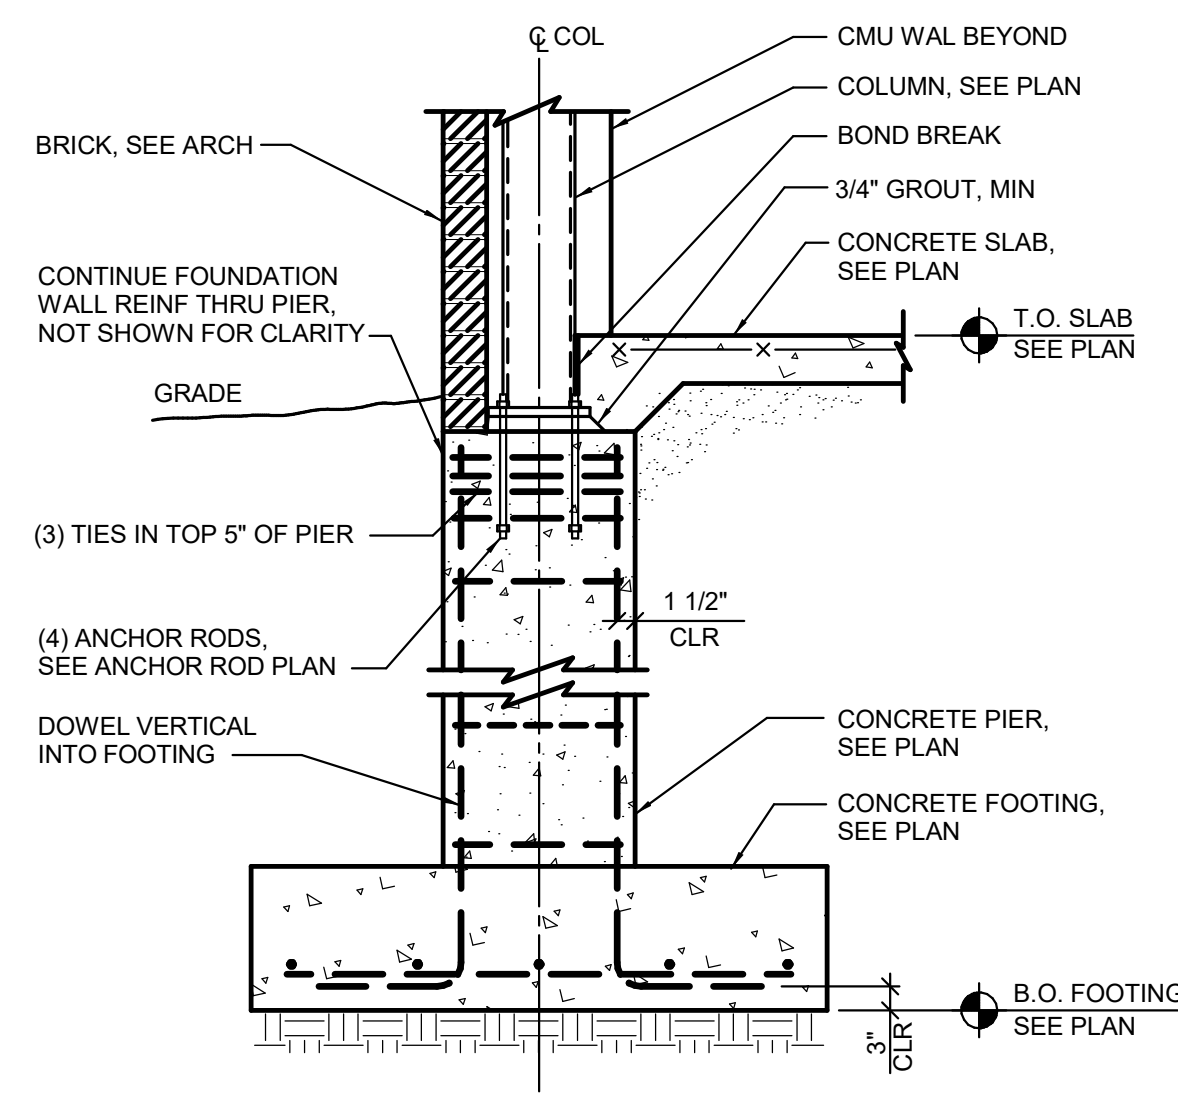


6 COLUMN FOOTING WITH PIER
S5.01 3/4" = 1'-0"

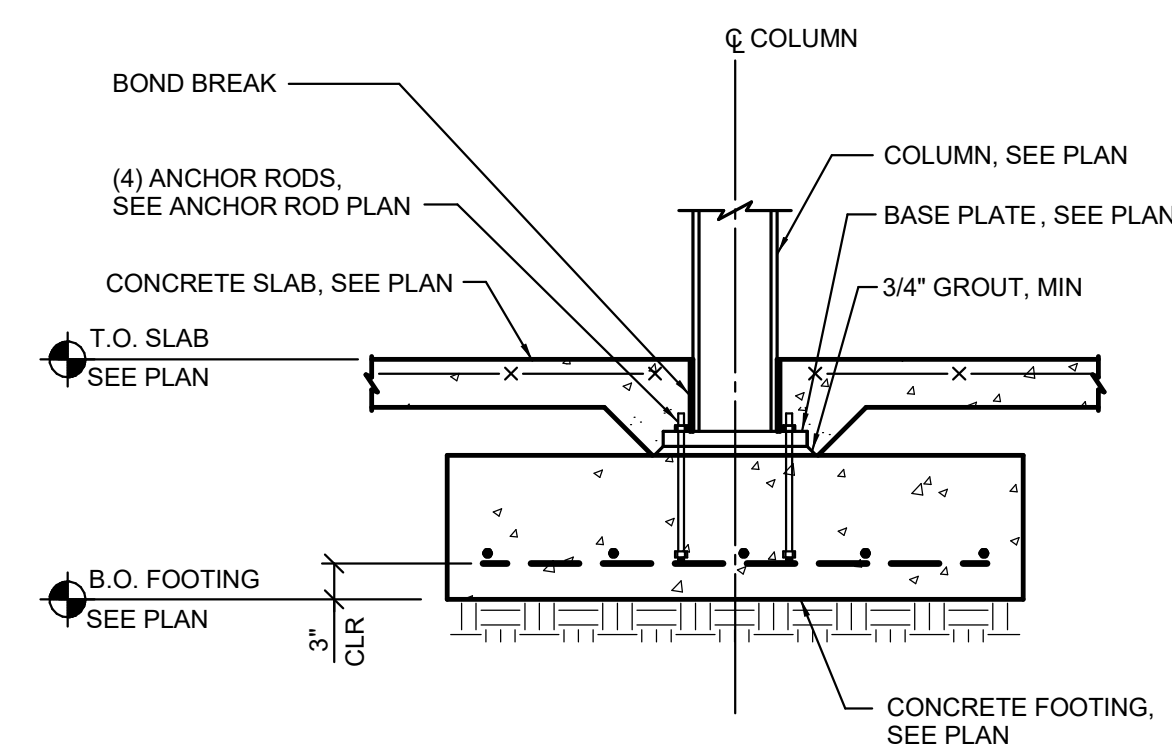


7 INTERIOR COLUMN FOOTING
S5.01 3/4" = 1'-0"

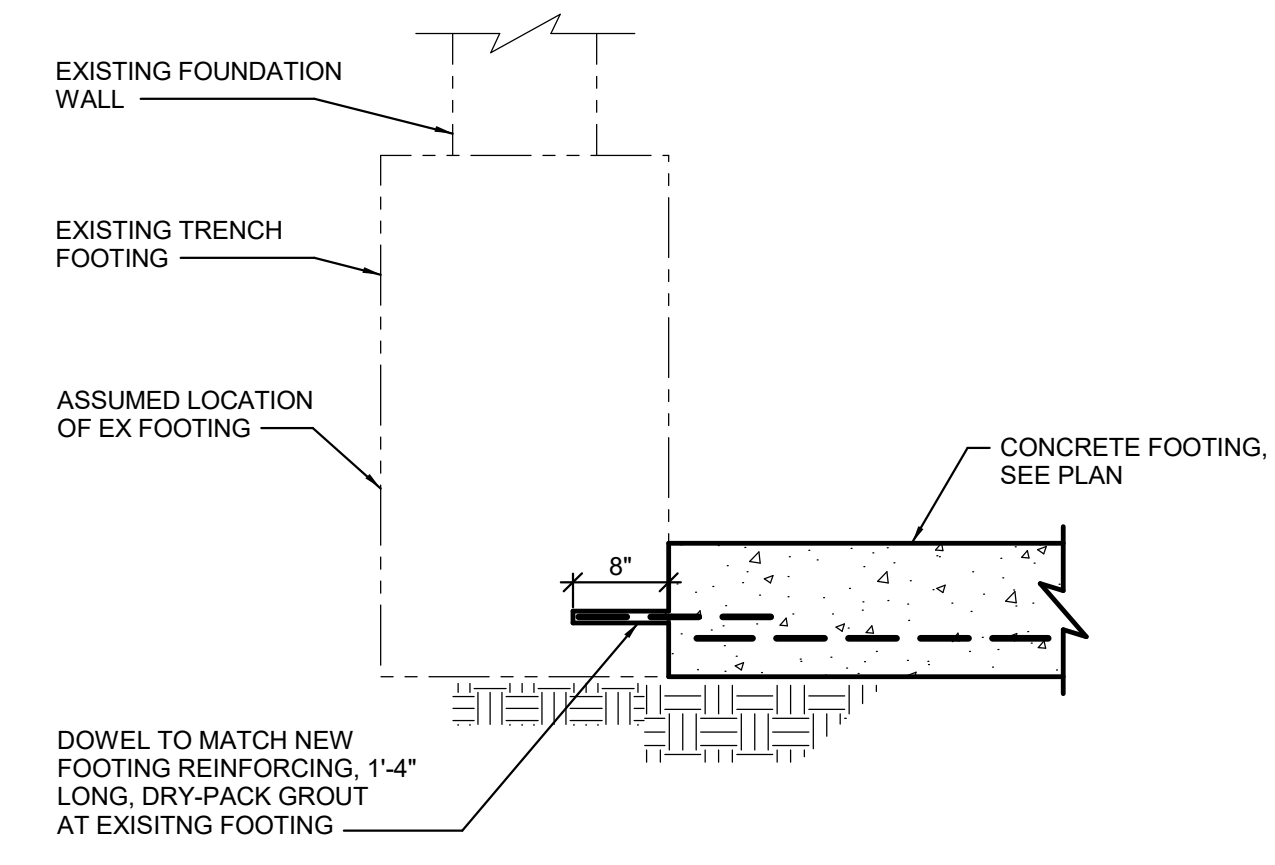


8 NEW FOOTING AT EXISTING
S5.01 3/4" = 1'-0"

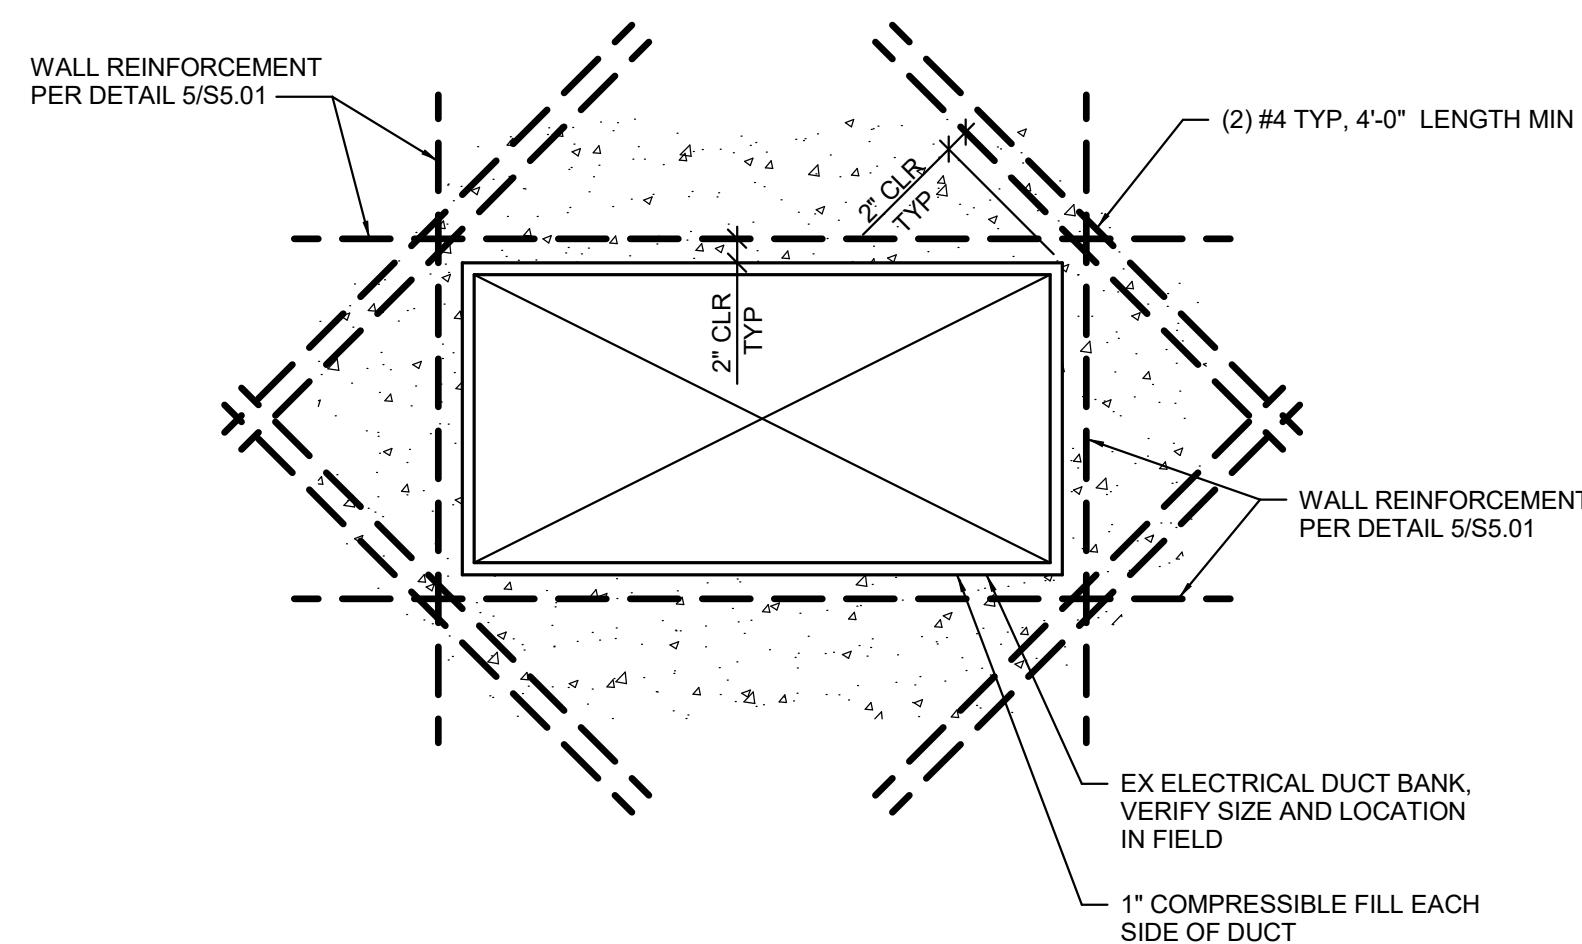


9 WALL REINFORCING AT EXISTING DUCT BANK
S5.01 3/4" = 1'-0"

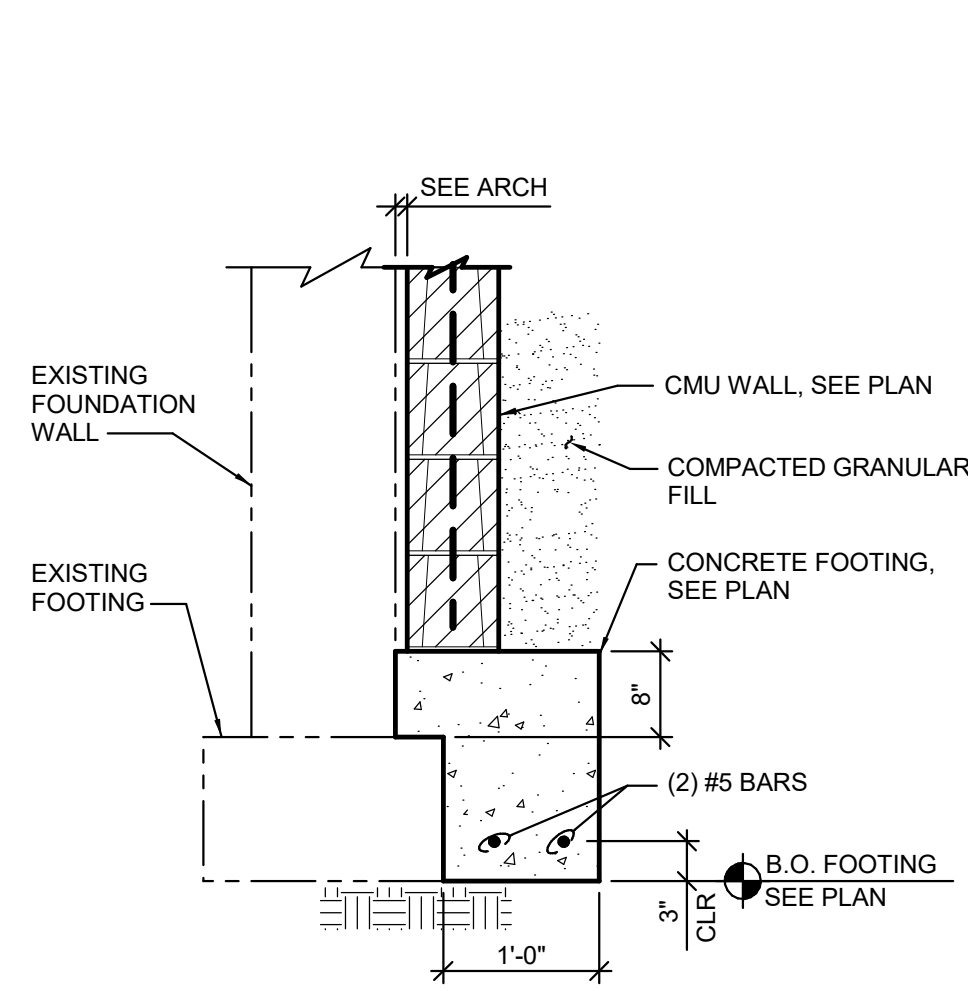


10 FOOTING AT EXISTING
S5.01 3/4" = 1'-0"

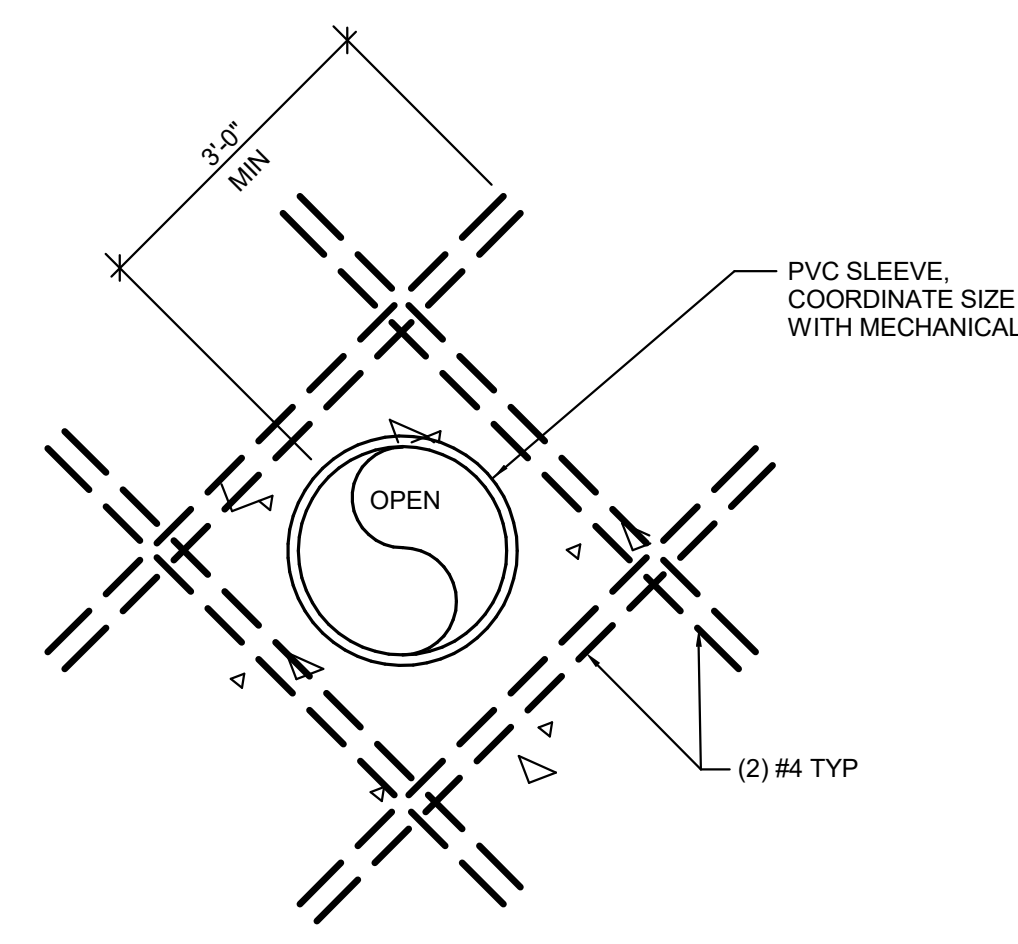


11 WALL OPENING REINFORCEMENT
S5.01 3/4" = 1'-0"

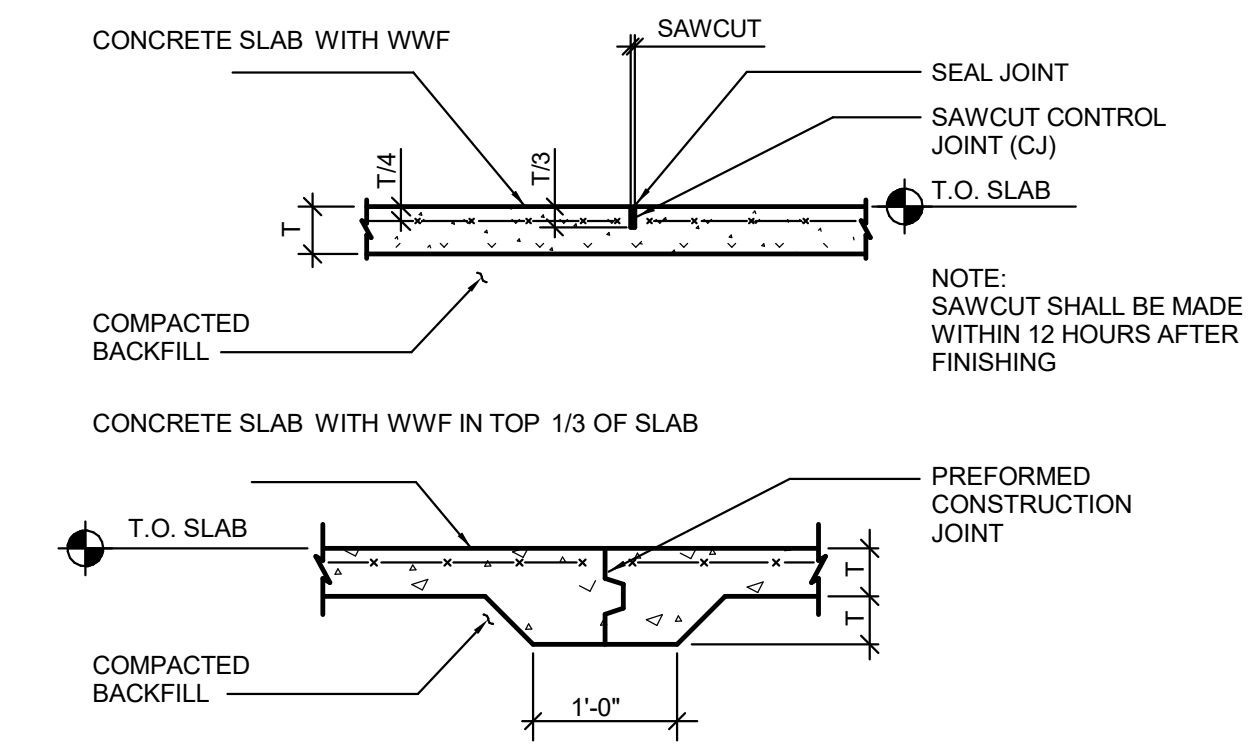

12 CONTROL/CONSTRUCTION JOINTS
S5.01 3/4" = 1'-0"

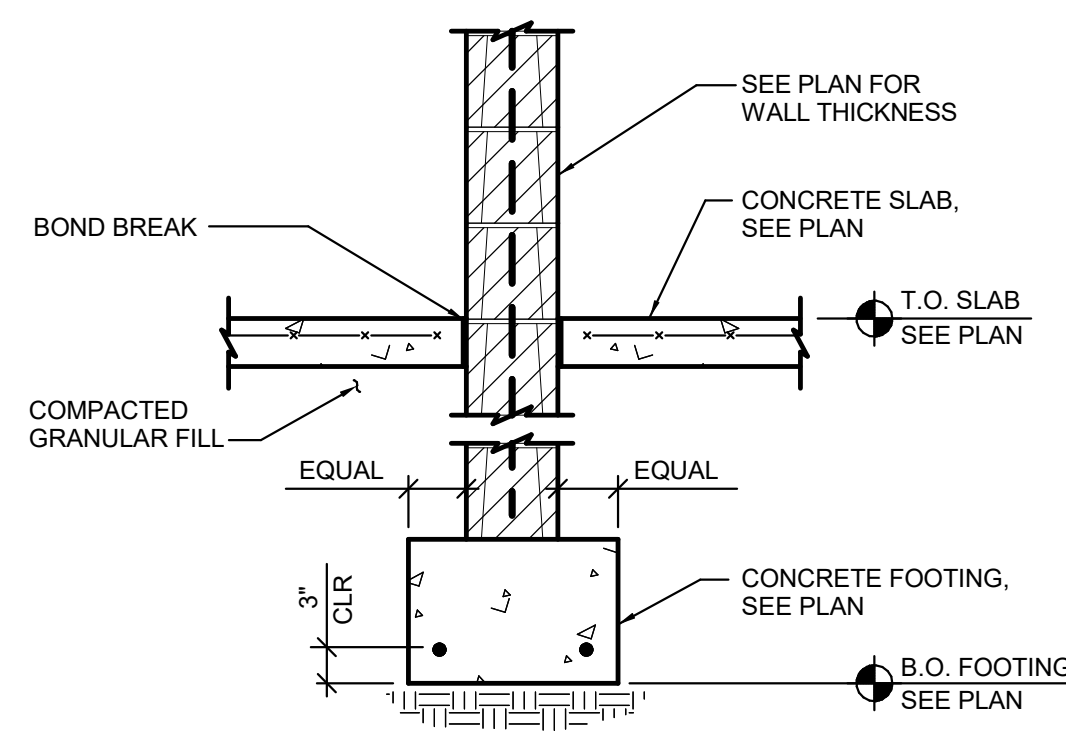

13 INTERIOR WALL FOOTING
S5.01 3/4" = 1'-0"

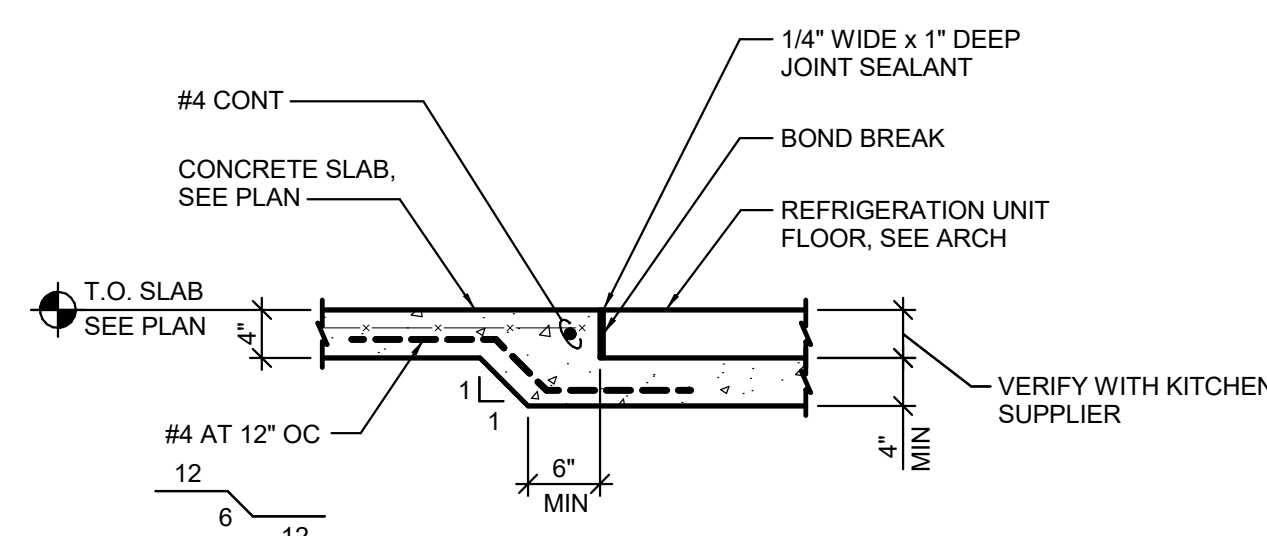


14 FLOOR SLAB EDGE DETAIL
S5.01 3/4" = 1'-0"

NO.	REVISION	DATE

STATE OF MICHIGAN
DEPARTMENT OF TECHNOLOGY, MANAGEMENT AND BUDGET
FACILITIES AND BUSINESS SERVICES ADMINISTRATION
DESIGN AND CONSTRUCTION DIVISION
ADAM LACH, RA, DIRECTOR

FILE NO:
491/20167.SDW

FUNDING CODE: 171CODHHS7255 CONTRACT NO. Y22003

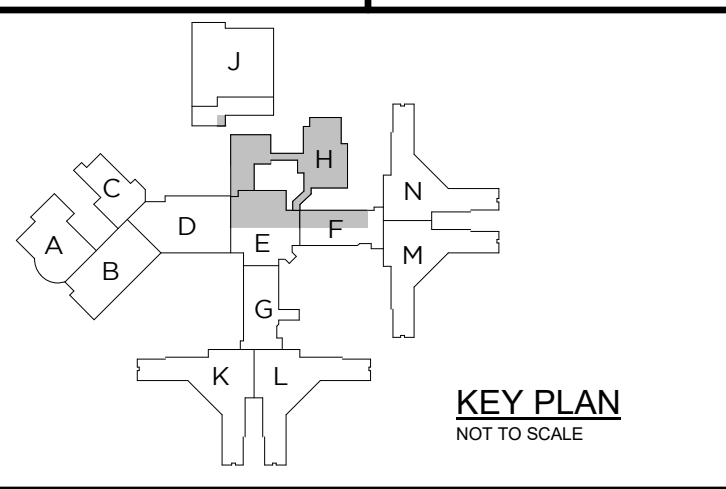

WTAARCH.COM

WTA ARCHITECTS

100 S. Jefferson Ave., Suite 601
Saginaw, Michigan 48607
989.752.8107 COPYRIGHT © 2023

MACMILLAN ASSOCIATES
CONSULTING ENGINEERS


PROJECT TITLE
491/20167.SDW - PHASE 500:
CENTER FOR FORENSIC PSYCHIATRY - CREATE KITCHEN
SALINE, MICHIGAN

SHEET TITLE
FOUNDATION DETAILS


PROJECT NUMBER: 2021094 SHEET NUMBER: S5.01

PROJECT DATE: SEPTEMBER 6, 2023


CHECKED BY: JAG

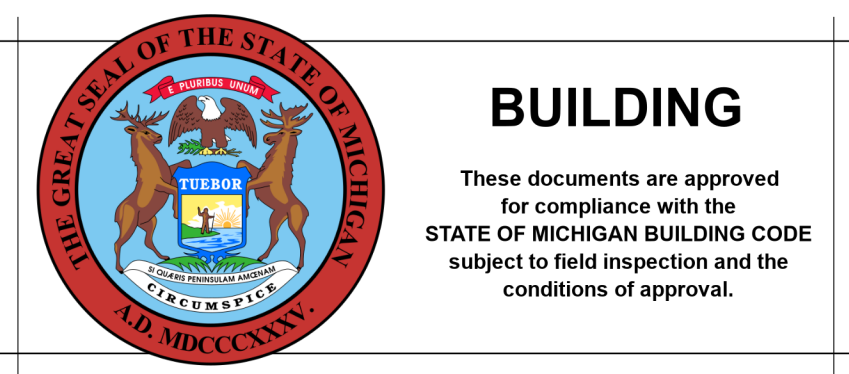


Autodesk 2023 8/4 10 AM C:\Users\mccormack\Documents\2021_1030_Center for Forensic Psychiatry Kitchen\1030_CenterforForensicPsychiatryKitchen\1030_CenterforForensicPsychiatryKitchen.dwg

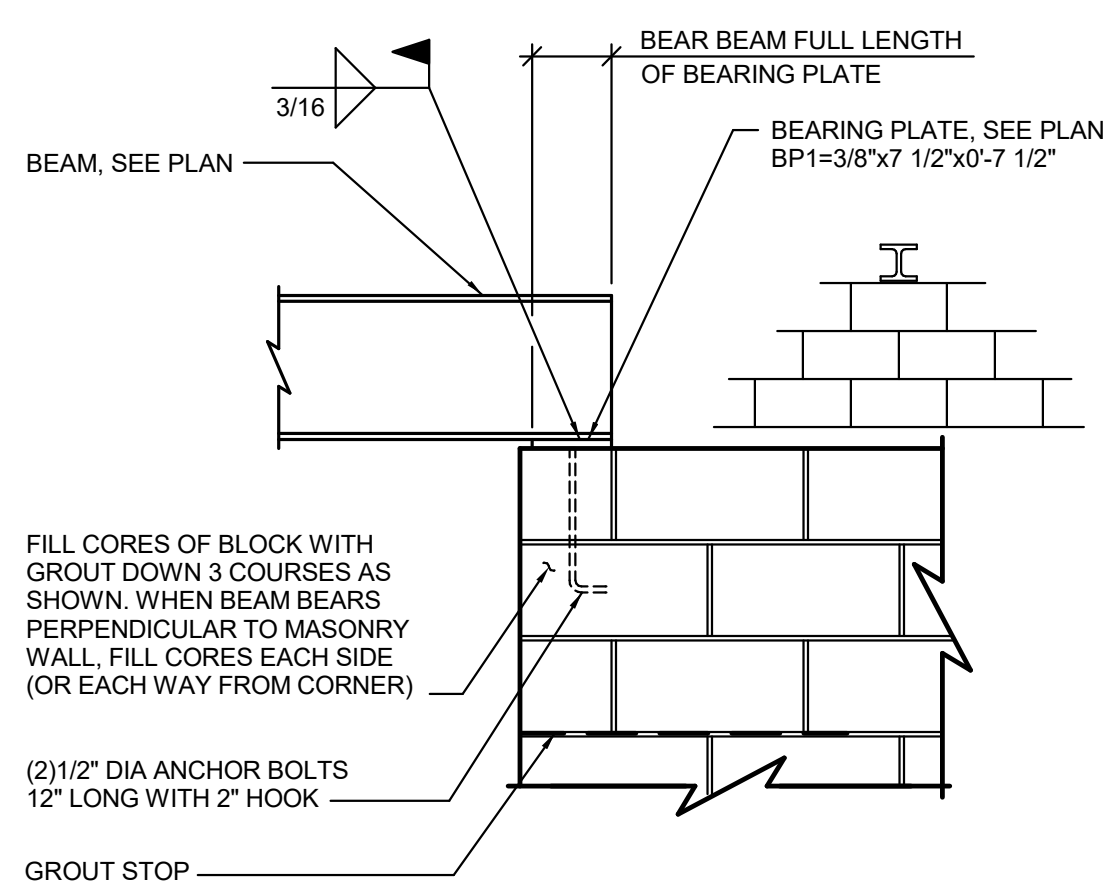


1 BEAM BEARING
S7.01 3/4" = 1'-0"

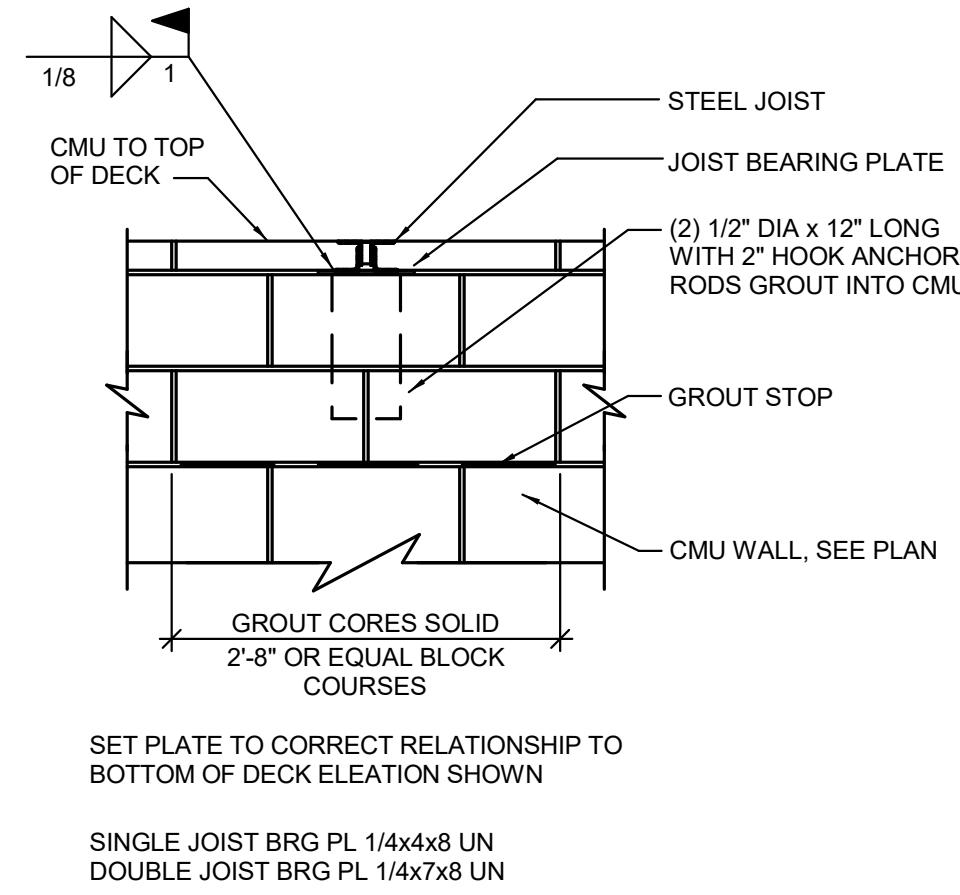


2 "K" JOIST END BEARING
S7.01 3/4" = 1'-0"

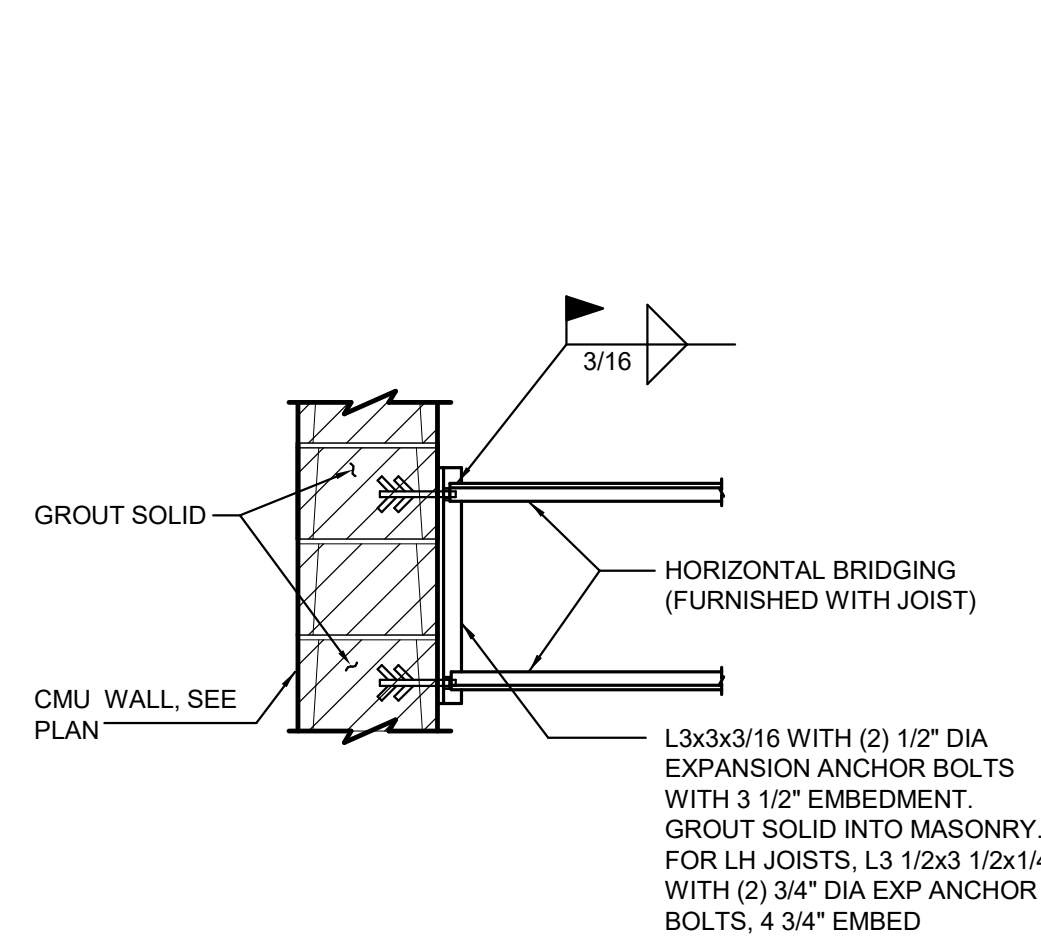


3 "K" AND "LH" BRIDGING ANCHOR
S7.01 3/4" = 1'-0"

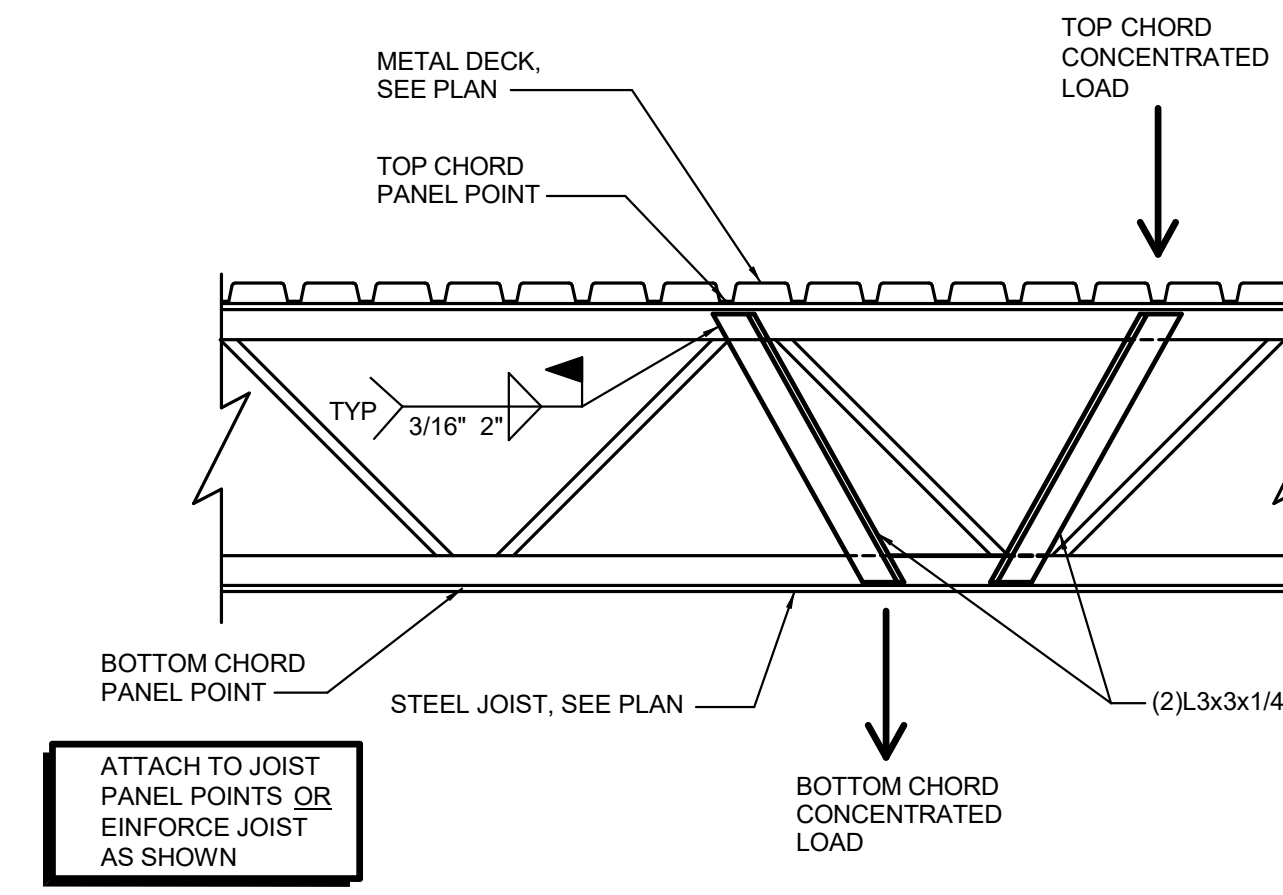


4 STEEL JOIST REINFORCEMENT AT NON-PANEL POINT CONCENTRATED LOADS
S7.01 3/4" = 1'-0"

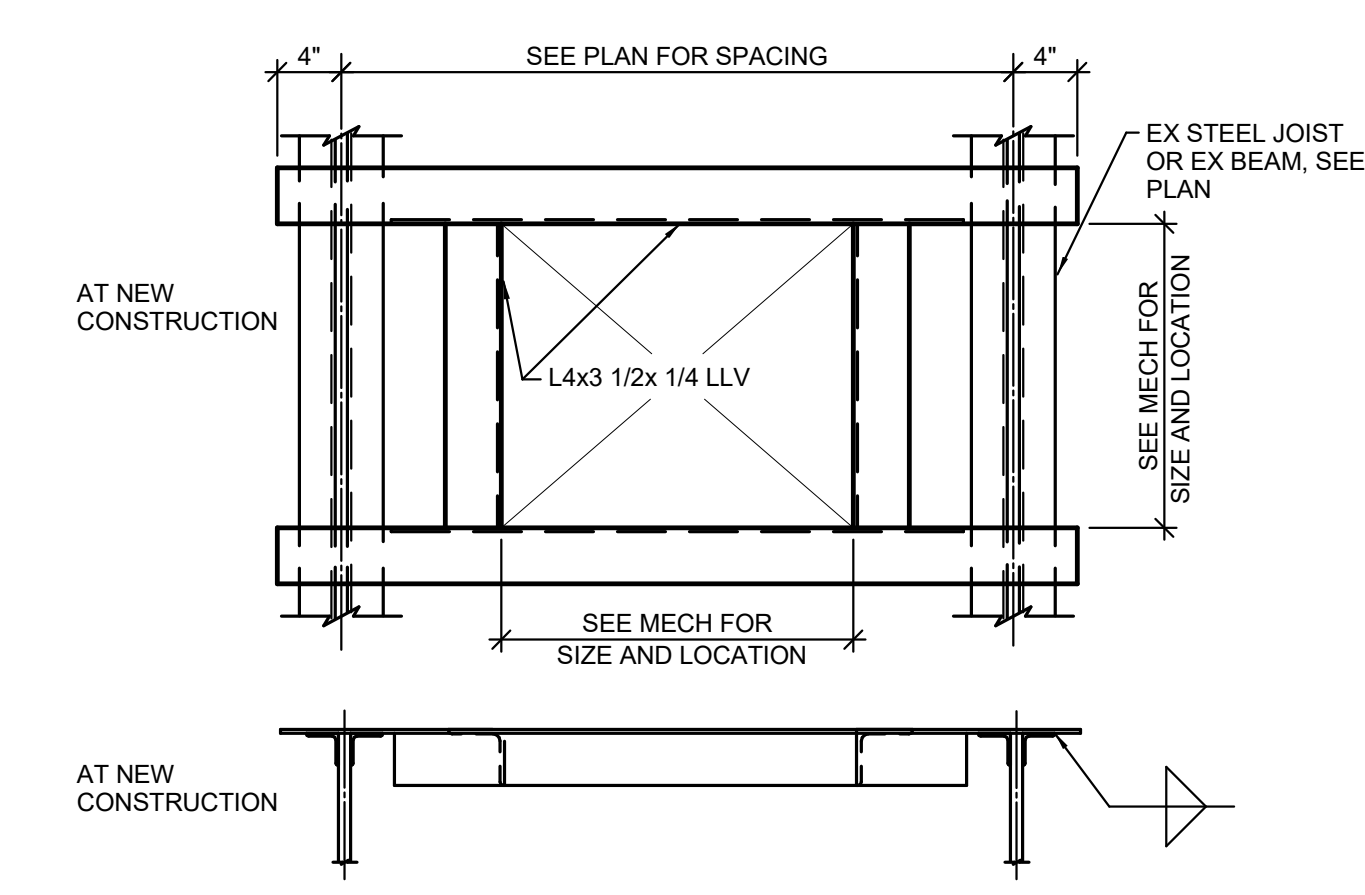


5 ROOF OPENING FRAME
S7.01 1" = 1'-0"

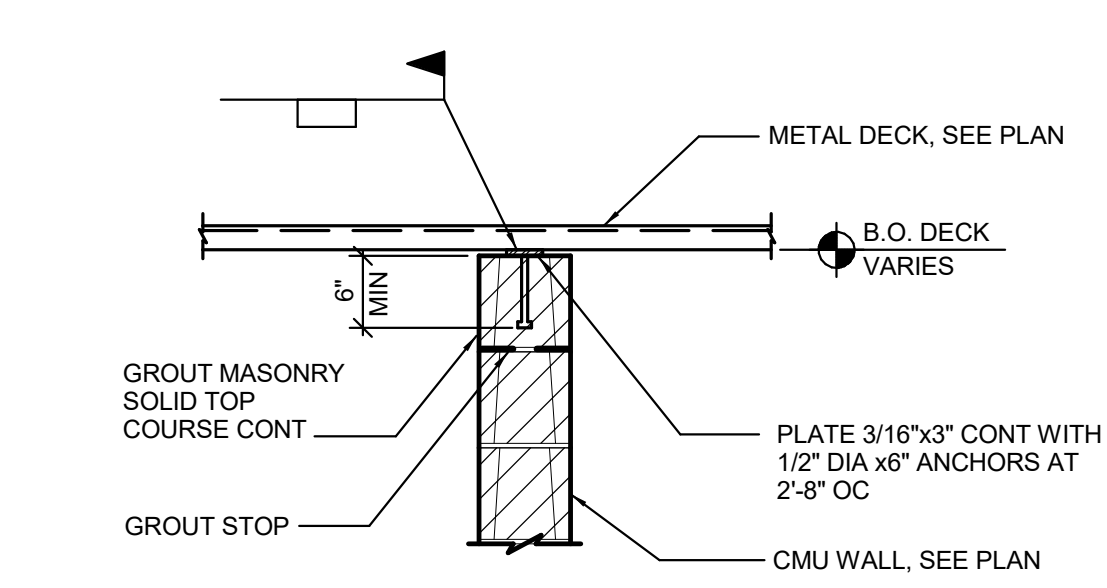


6 DECK BEARING
S7.01 3/4" = 1'-0"

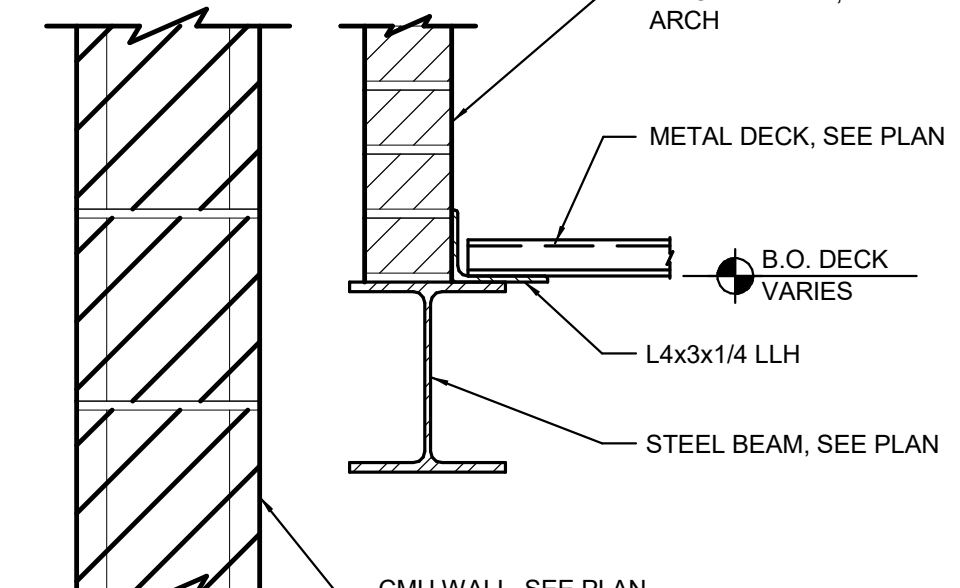


7 LOW ROOF DECK SUPPORT
S7.01 1 1/2" = 1'-0"

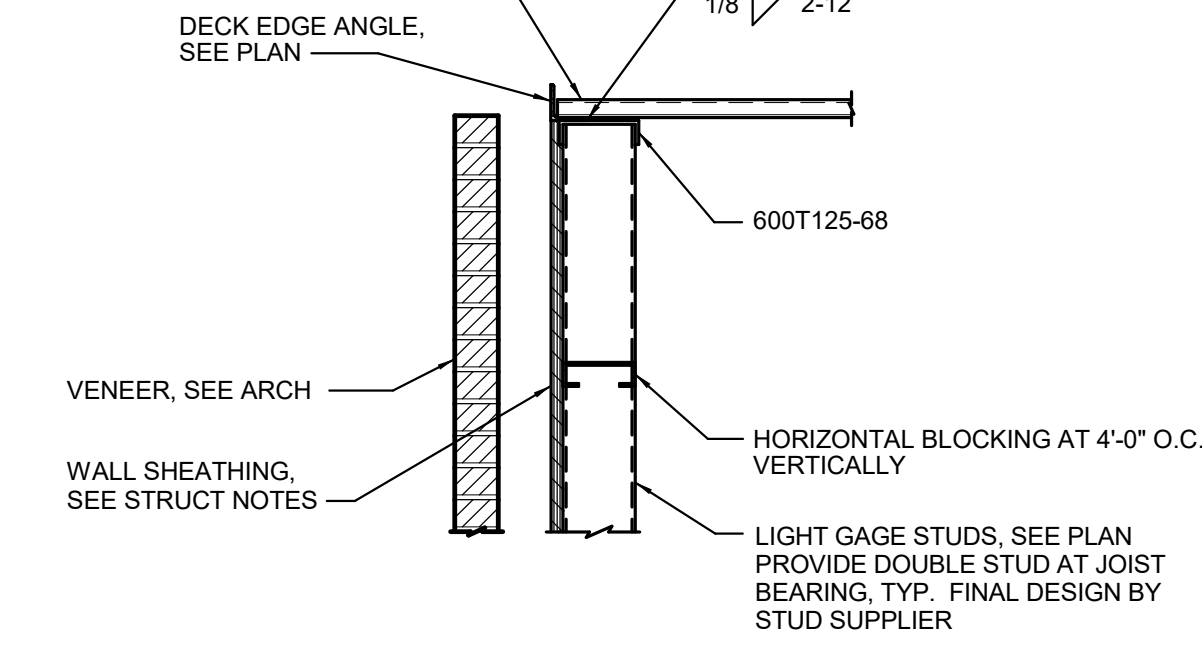


8 DECK EDGE AT LIGHT GAGE
S7.01 3/4" = 1'-0"

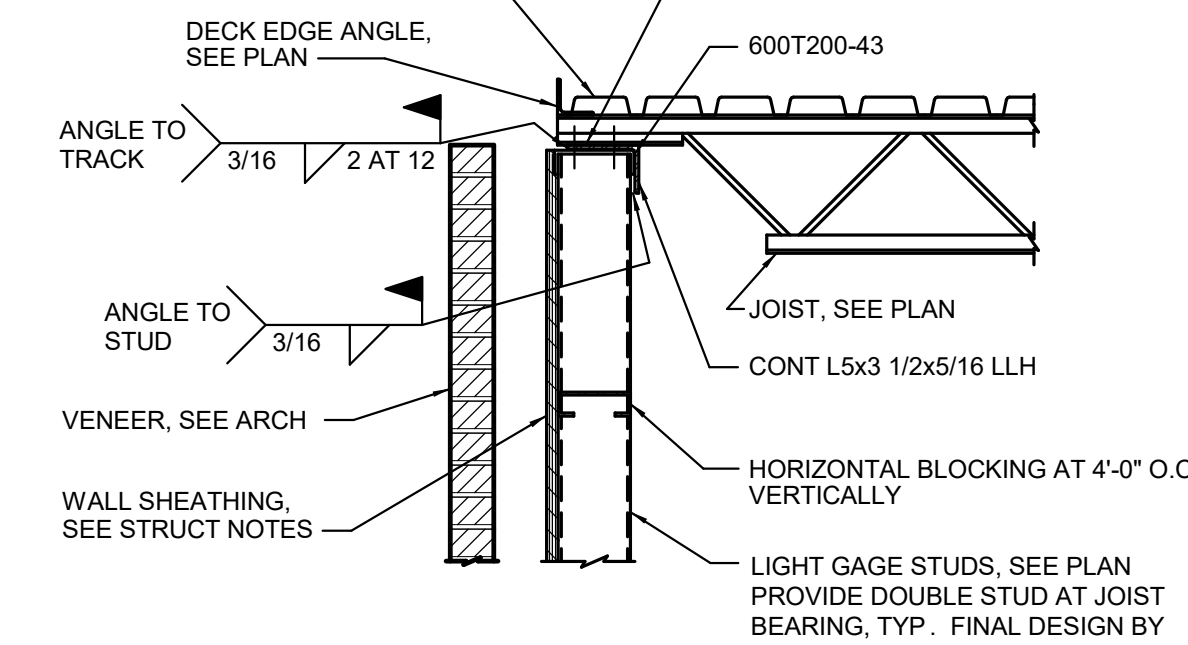


9 JOIST BEARING DETAIL
S7.01 3/4" = 1'-0"

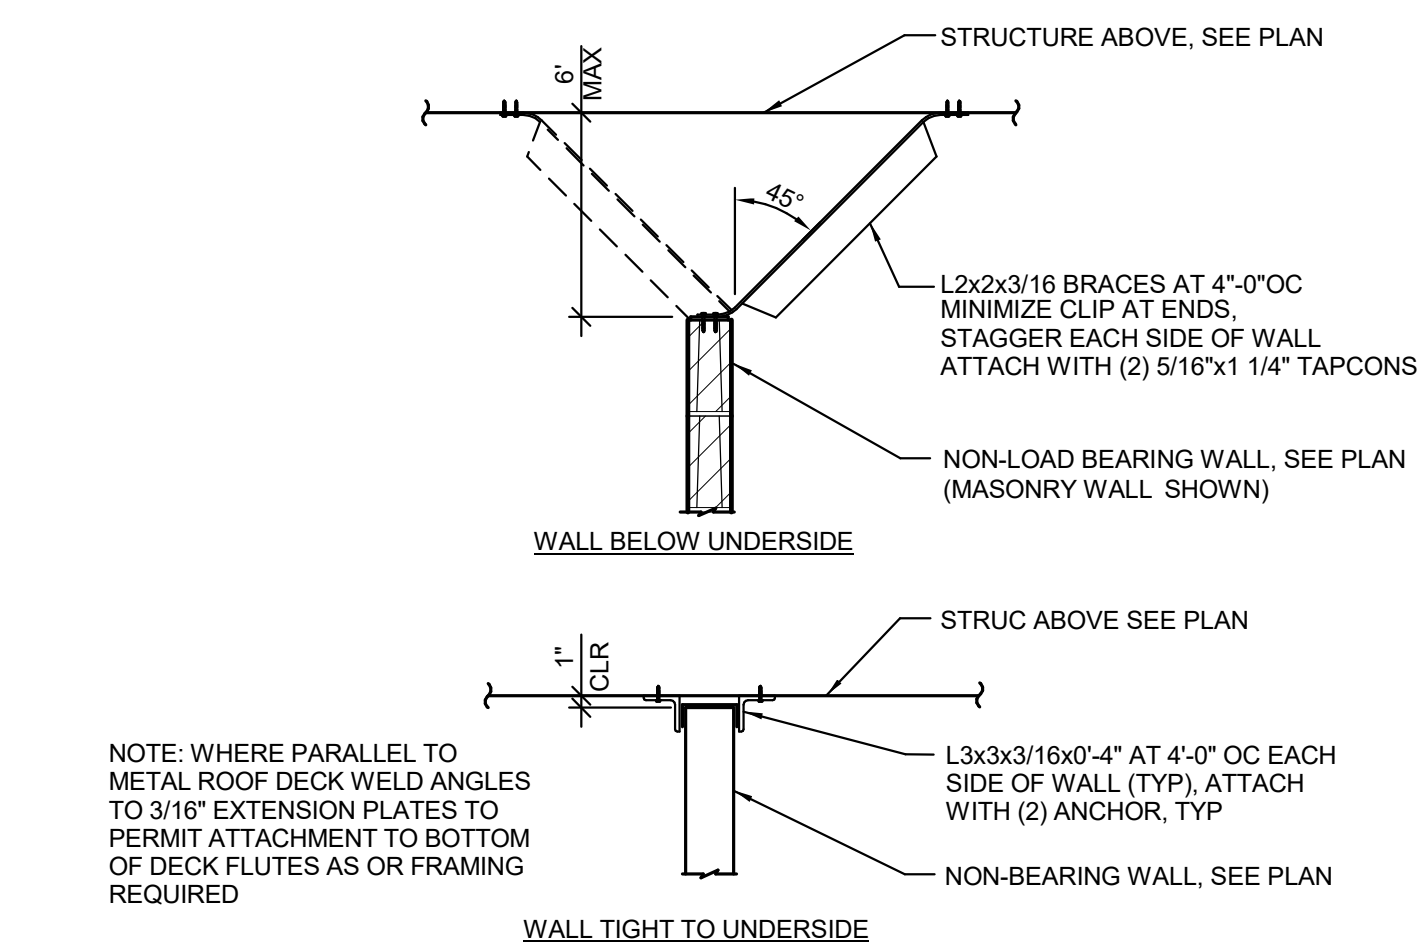


10 TYPICAL NON-BEARING WALL BRACING
S7.01 3/4" = 1'-0"

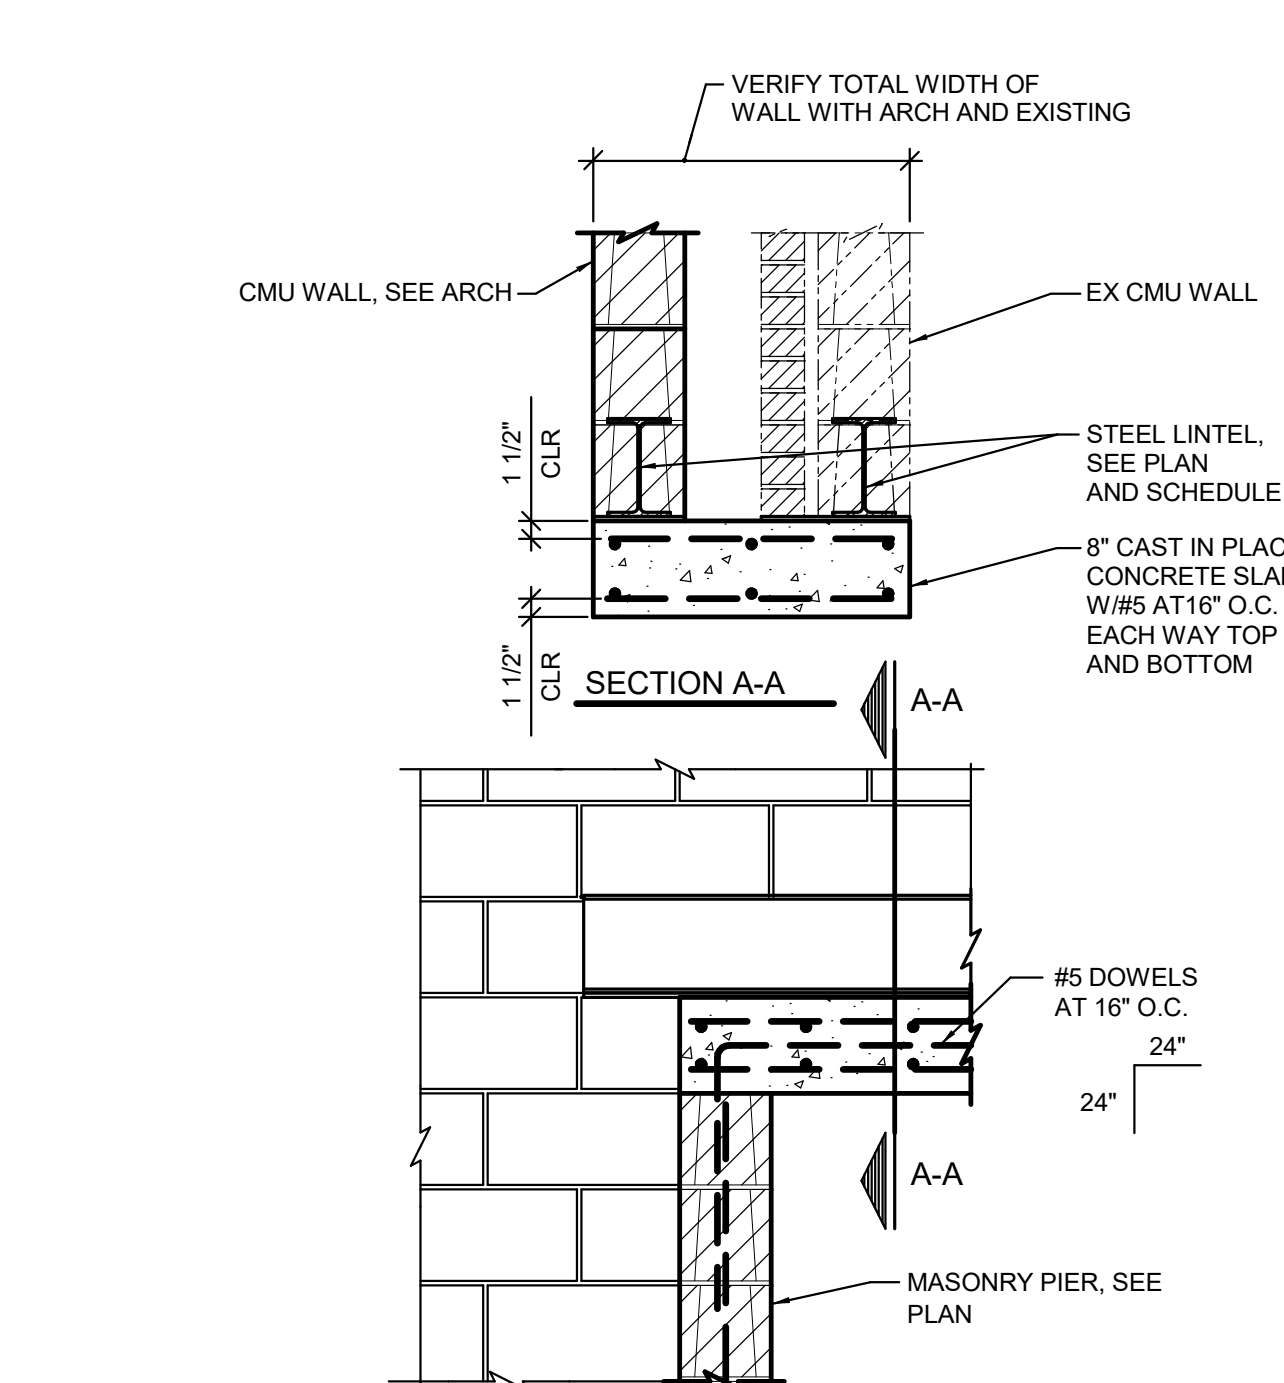


11 PORTAL FRAME
S7.01 3/4" = 1'-0"

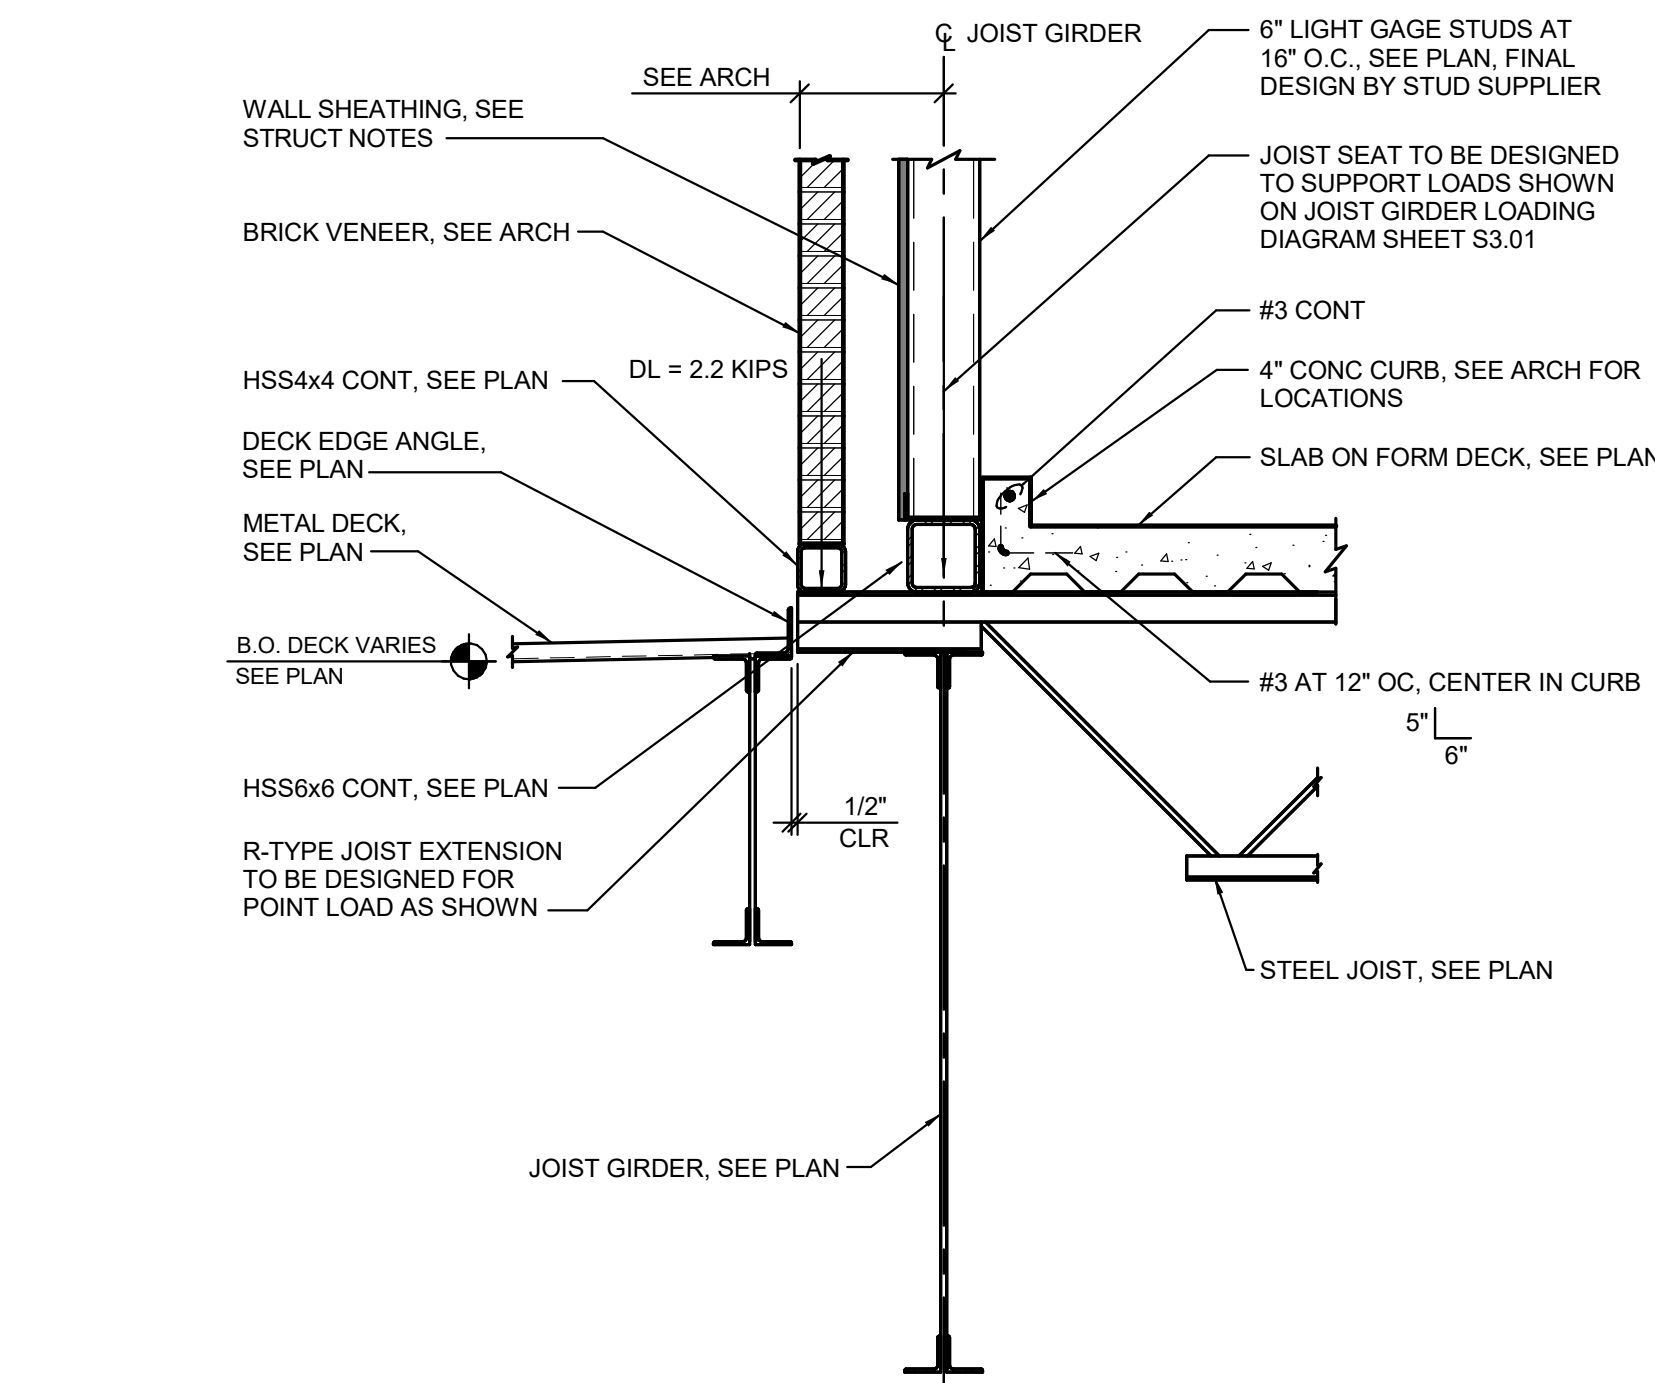


12 BRICK SUPPORT AT LOW ROOF
S7.01 3/4" = 1'-0"

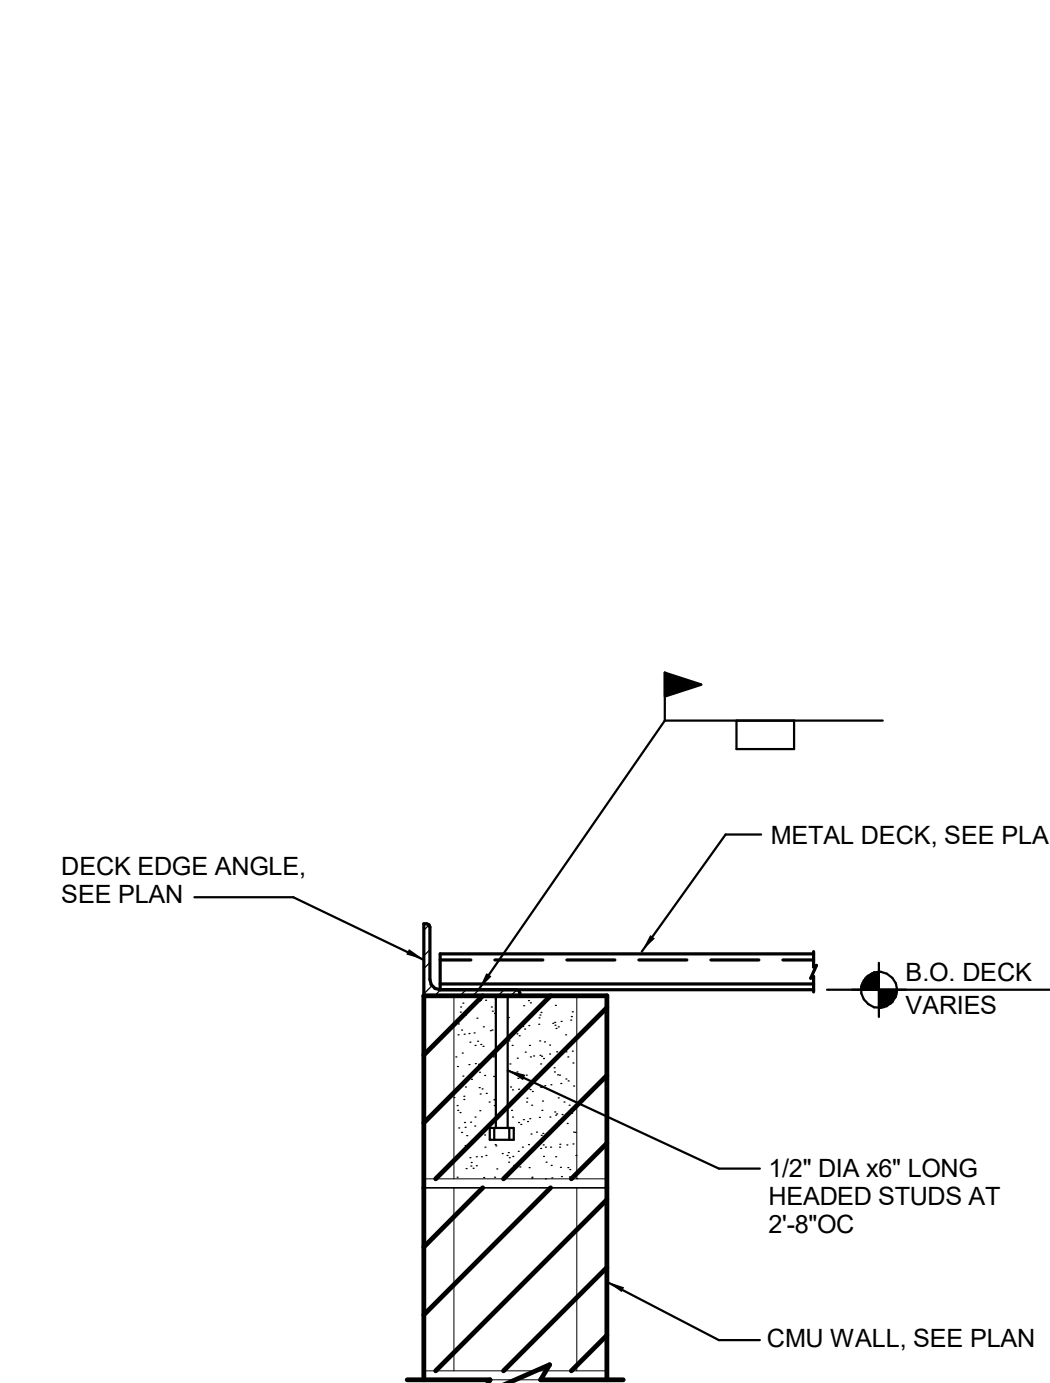


13 DECK SUPPORT ANGLE
S7.01 1 1/2" = 1'-0"

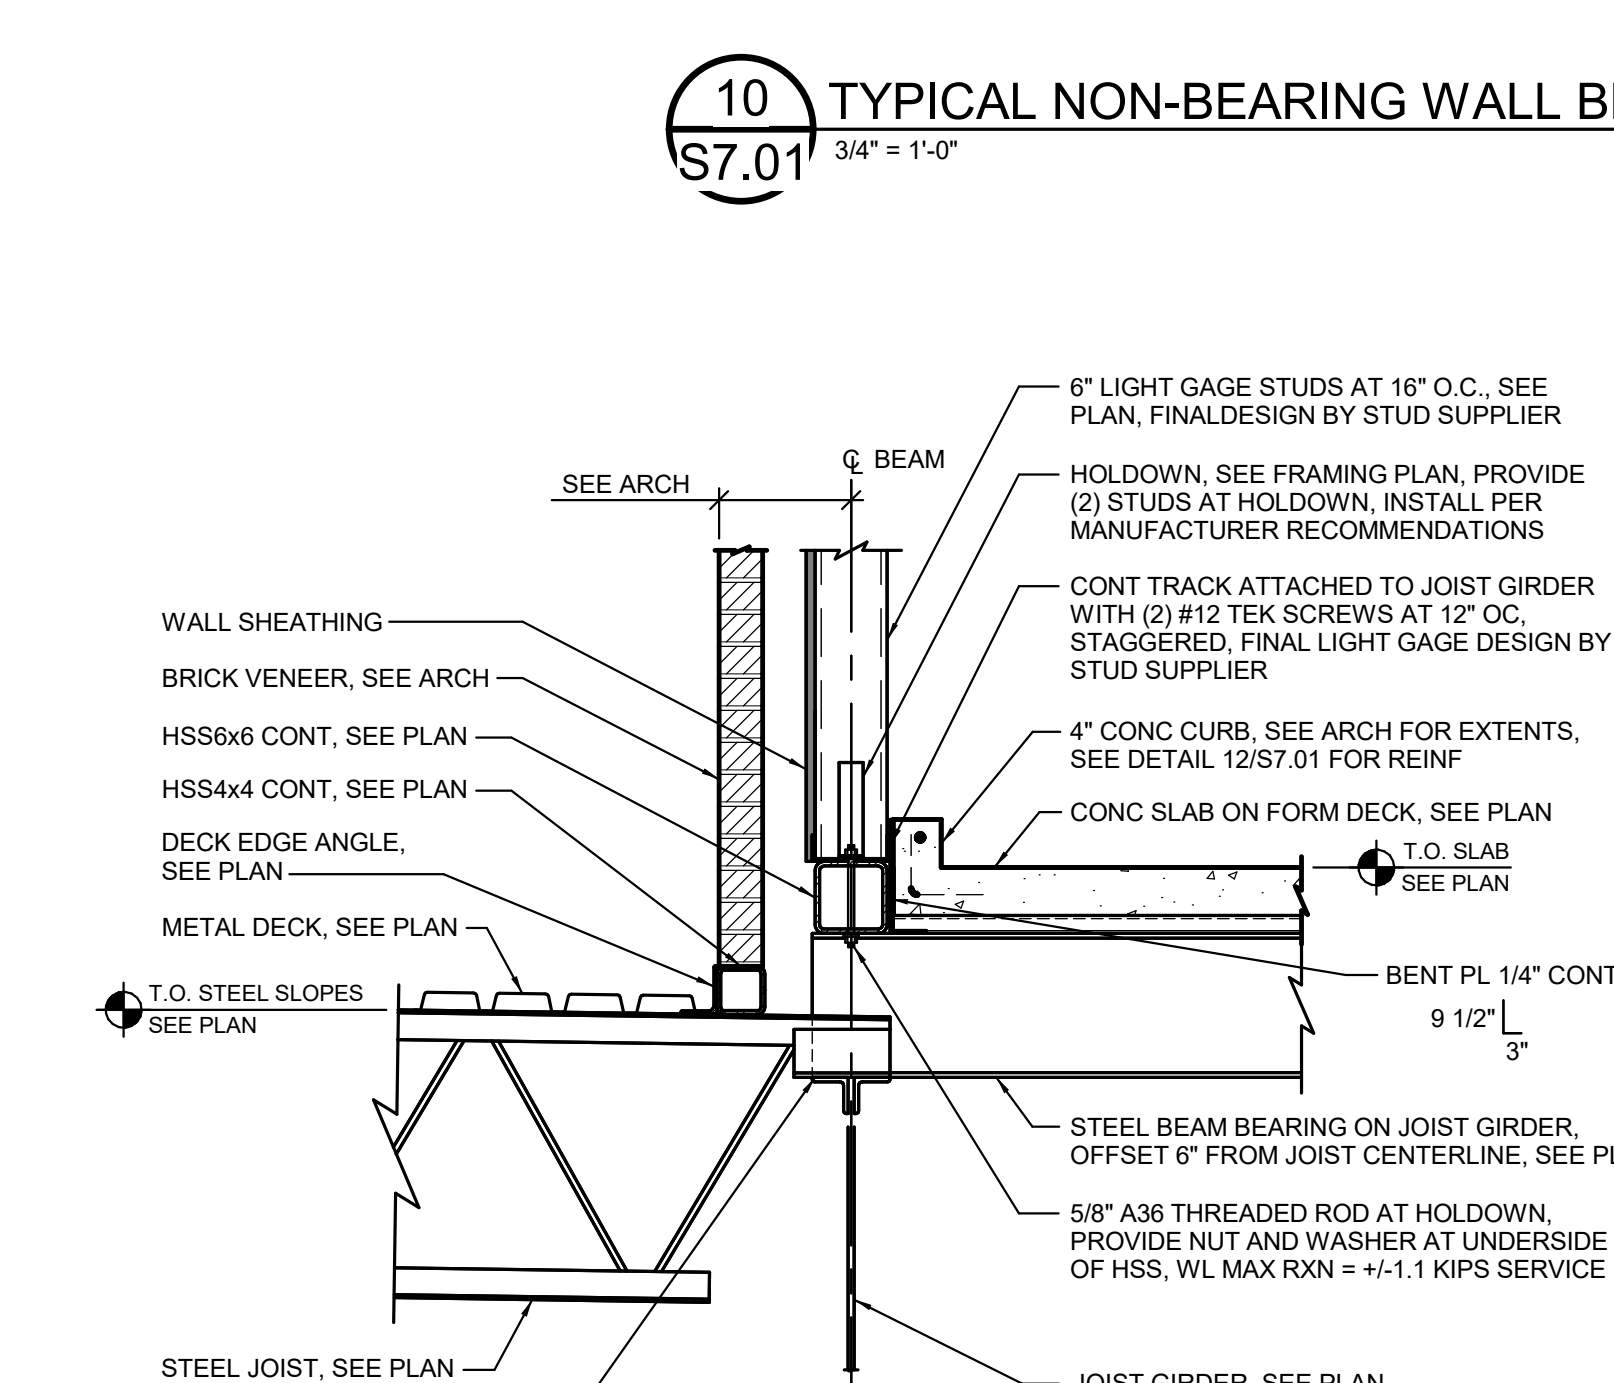


14 BRICK VENEER SUPPORT
S7.01 3/4" = 1'-0"

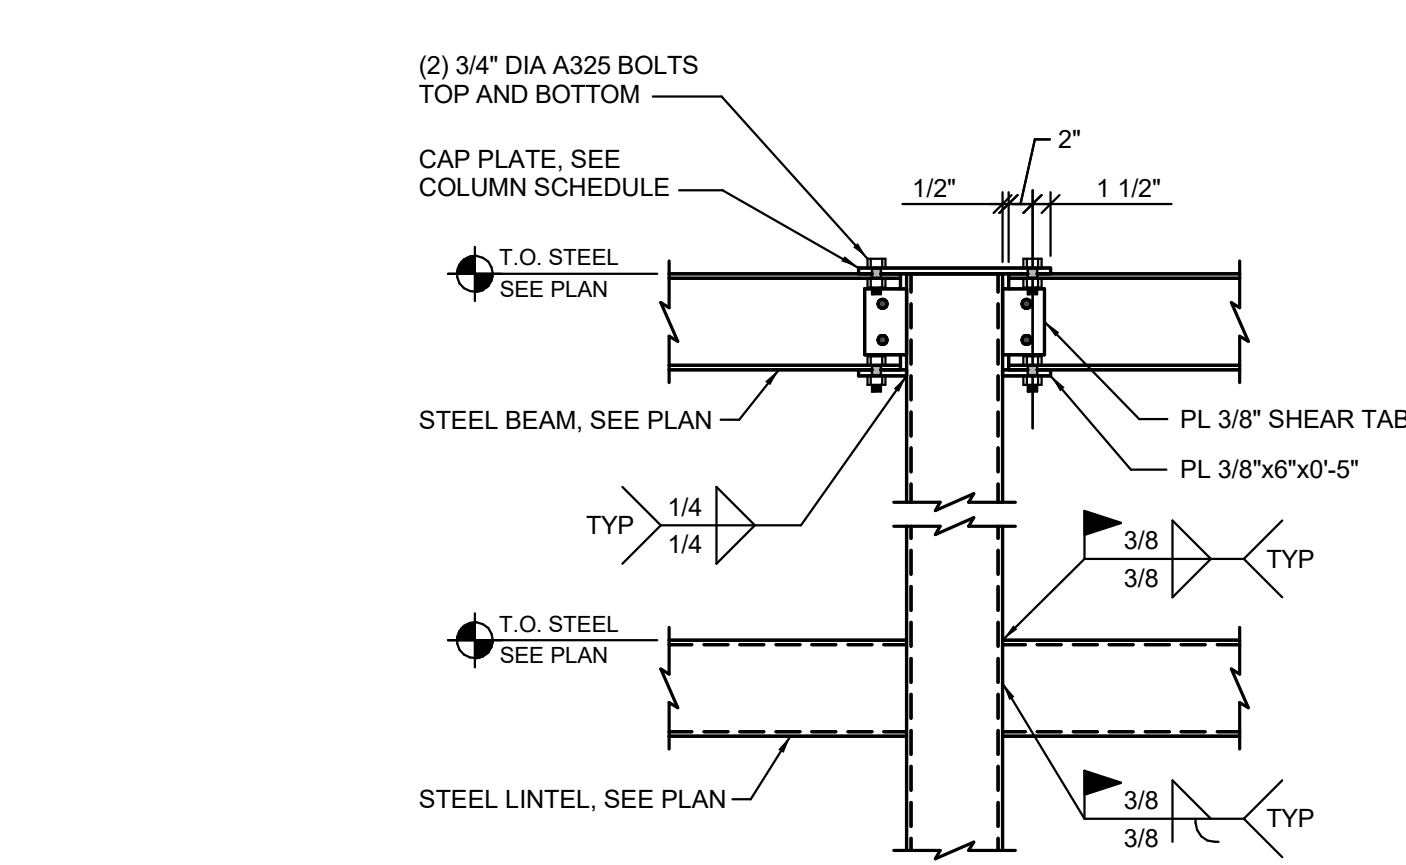

15 MC1 - MOMENT CONNECTION
S7.01 3/4" = 1'-0"

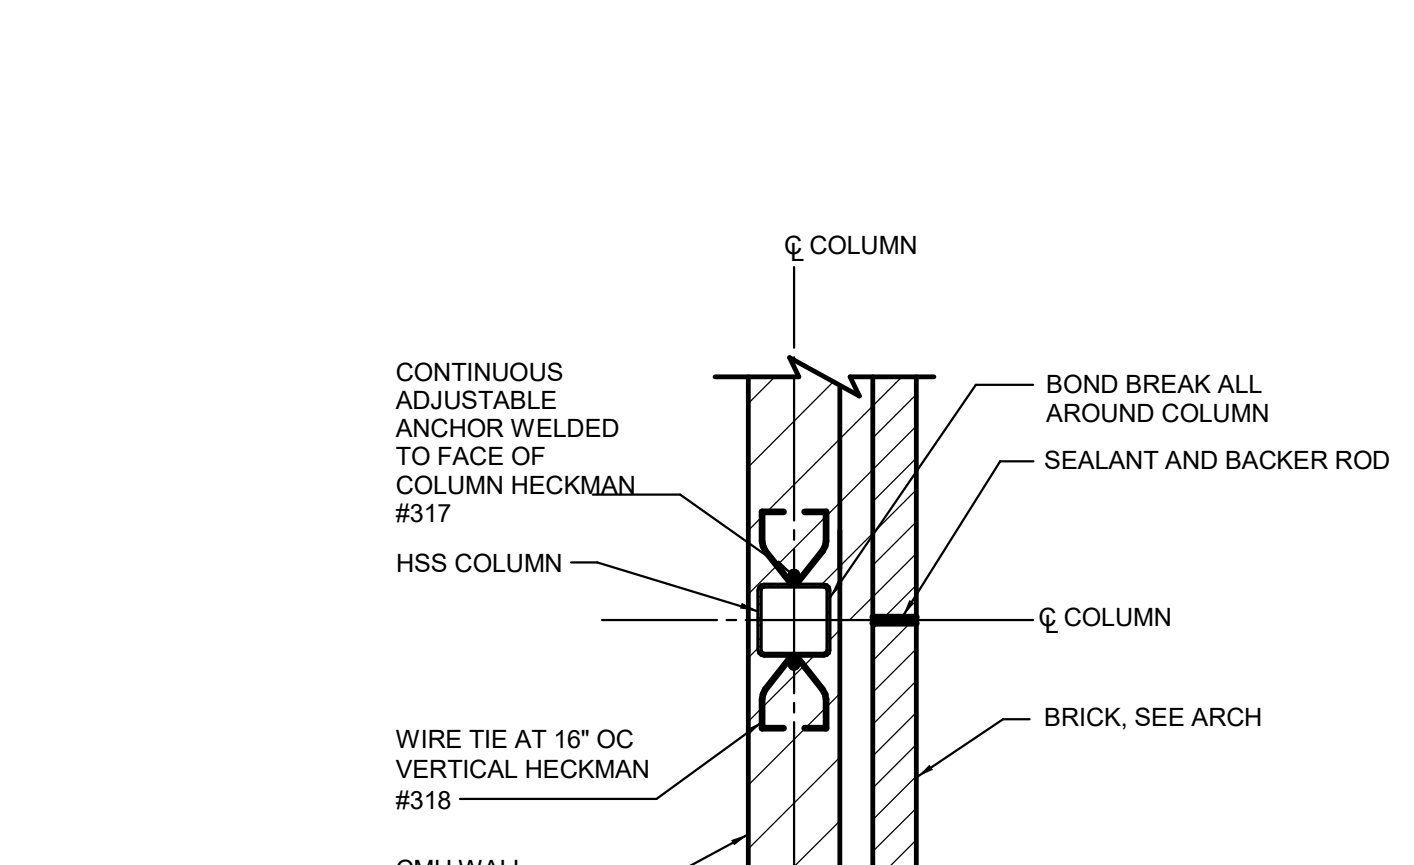

16 TYPICAL COLUMN MASONRY ANCHOR
S7.01 3/4" = 1'-0"

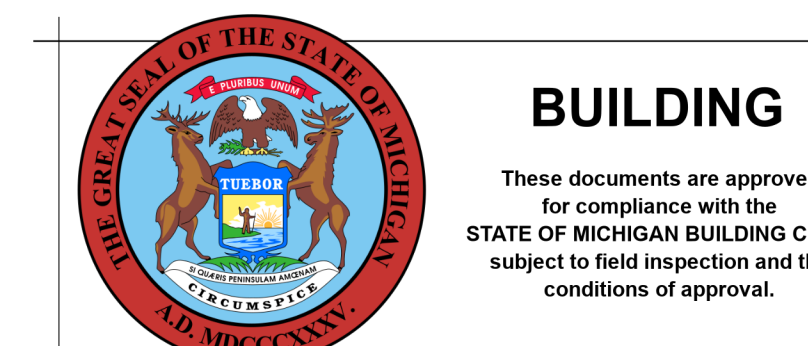


NO.	REVISION	DATE

STATE OF MICHIGAN
DEPARTMENT OF TECHNOLOGY, MANAGEMENT AND BUDGET
FACILITIES AND BUSINESS SERVICES ADMINISTRATION
DESIGN AND CONSTRUCTION DIVISION
ADAM LACH, RA, DIRECTOR

FILE NO:
491/20167.SDW

FUNDING CODE: 171CODHHS7255 CONTRACT NO.: Y22003

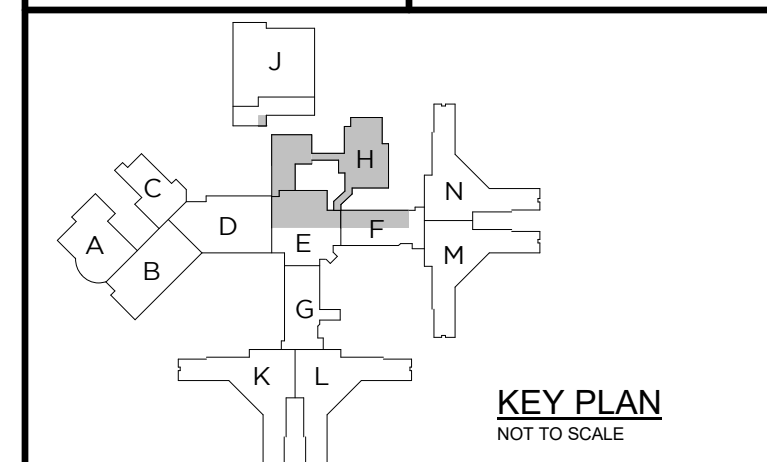

WTAARCH.COM

WTA ARCHITECTS

100 S. Jefferson Ave., Suite 601
Saginaw, Michigan 48607
989.752.8107 COPYRIGHT © 2023

MACMILLAN ASSOCIATES
CONSULTING ENGINEERS
7000 WOODLAND DRIVE • WYOMING, MICHIGAN 48186
(800) 894-4300 • (989) 894-9799 • WWW.MACMILLANASSOCIATES.COM

PROJECT TITLE
491/20167.SDW - PHASE 500:
CENTER FOR FORENSIC PSYCHIATRY - CREATE KITCHEN
SALINE, MICHIGAN

SHEET TITLE
ROOF FRAMING DETAILS

PROJECT NUMBER
2021094 SHEET NUMBER

PROJECT DATE
SEPTEMBER 6, 2023 **S7.01**

CHECKED BY
JAG

Autodesk 2023 8/21/24 AM C:\Users\mccormack\Documents\2021-1030-Center for Forensic Psychiatry Kitchen\03_2023\mccormack\DWG.dwg

MECHANICAL ABBREVIATION LIST

ABBREVIATION	DESCRIPTION	ABBREVIATION	DESCRIPTION	ABBREVIATION	DESCRIPTION
A	COMPRESSED AIR	FD	FLOOR DRAIN	O	OXYGEN
AL (#)	COMPRESSED AIR (SPECIFIC PSIG)	FFD	FUNNEL FLOOR DRAIN	OA	OUTSIDE AIR
AAV	AUTOMATIC AIR VENT	FH	FIRE HYDRANT	OAT	OUTSIDE AIR TEMPERATURE
ACC	AIR COOLED CONDENSER	FHC	FIRE HOSE CABINET	OB	OUTLET BOX
ACCU	AIR COOLED CONDENSER UNIT	FHR	FIRE HOSE RACK	OBID	OPPOSED BLADE DAMPER
AD	ACCESS DOOR	FHV	FIRE HOSE VALVE	OC	ON CENTER/CENTER TO CENTER
AD	AREA DRAIN	FLA	FULL LOAD AMPS	OD	OUTSIDE DIAMETER
AE	AIR EXTRACTOR	FLR	FLOOR	OED	OPEN ENDED DUCT
AFF	ABOVE FINISHED FLOOR	FM	FLOW METER	OFICI	OWNER FURNISHED, CONTRACTOR INSTALLED
AHU	AIR HANDLING UNIT	FMS	FLOW MEASURING STATION	OFPI	OWNER FURNISHED, OWNER INSTALLED
ALT	ALTERNATE	FS	FEET PER MINUTE	OL	OVERLOAD
AMP	AMPERE	FP	FIRE PUMP	ORC	OVERFLOW RAIN CONDUCTOR
APD	AIR PRESSURE DROP	FTTU	FAN POWERED (AIR) TERMINAL UNIT	ORD	OVERLIFT ROOF DRAIN
AR	ARGON	FS	FLOOR SINK	OSAY	OUTSIDE SCREW AND YOKE
ASHRAE	AMERICAN SOCIETY OF HEATING, REFRIGERATION AND AIR-CONDITIONING ENGINEERS	FSEC	FOOD SERVICE EQUIPMENT CONTRACTOR	OY	OUTLET VELOCITY
ASR	AUTOMATIC SPRINKLER RISER	FT	FEET	OYS	OPERATOR WORKSTATION
ATD	AIR TRANSFER DUCT	FV	FACE VELOCITY	PACU	PACKAGED AIR CONDITIONING UNIT
AUX	AUXILIARY	GD	GALLON	PBD	PARALLEL BLADE DAMPER
AV	ACID VENT	G	NATURAL GAS	PC	PUMPED CONDENSATE
AVTR	ACID VENT THROUGH ROOF	GA	GALVE	PCW	PROCESS COOLING WATER
AW	ACID WASTE	GAL	GALLON	PCWR	PROCESS COOLING WATER RETURN
		GRH	GRAVITY RELIEF HOOD	PCWS	PROCESS COOLING WATER SUPPLY
BAS	BUILDING AUTOMATION SYSTEM	GSN	GALLONS PER HOUR	PD	PRESSURE DROP (FEET OF WATER)
BCU	BLOWER COIL UNIT	GPM	GALLONS PER MINUTE	PH	PERIMETER HEAT
BDD	BACK DRAFT DAMPER	GSAN	GREASE SANITARY WASTE	PHR	PERIMETER HEAT RETURN
BFF	BELOW FINISHED FLOOR	H	HYDROGEN	PHS	PERIMETER HEAT SUPPLY
BFP	BACKFLOW PREVENTER	HB	HOSE BIBB	PPM	PARTS PER MILLION
BHP	BRAKE HORSEPOWER	HC	HEATING COIL	PPR	PRESSURE REDUCING VALVE
BOD	BOTTOM OF DUCT	HD	HOT DECK	PSAN	PUMPED SANITARY
BOP	BOTTOM OF PIPE	HEPA	HIGH EFFICIENCY PARTICULATE ARRESTANCE	PSI	POUNDS PER SQUARE INCH
BTU	BRITISH THERMAL UNIT PER HOUR	HL	HIGH LIMIT	PSIA	POUNDS PER SQUARE INCH - ABSOLUTE
BTUH	BRITISH THERMAL UNIT PER HOUR	HOA	HAND/OFF/AUTO	PSIG	POUNDS PER SQUARE INCH - GAUGE
BVC	BEVERAGE CONDUIT	HP	HORSEPOWER	PST	PUMPED STORM
BVV	BACKWATER VALVE	HPCW	HIGH PRESSURE DOMESTIC COLD WATER	PW	PURIFIED WATER
		HPHW	HIGH PRESSURE DOMESTIC HOT WATER	PWR	PURIFIED WATER RETURN
C	COMMON	HPHWR	HIGH PRESSURE DOMESTIC HOT WATER RETURN	PWS	PURIFIED WATER SUPPLY
CAP	CAPACITY	HPL	HEAT PUMP LOOP		
CAV	CONSTANT AIR VOLUME	HPLR	HEAT PUMP LOOP RETURN	(R)	RELOCATED
CB	CATCH BASIN	HPLS	HEAT PUMP LOOP SUPPLY	R	RETURN GRILLE OR REGISTER
CC	COOLING COIL	HRS	HEATING	RA	RETURN AIR
CD	COLD DECK	HTG	HEATING	RAT	RETURN AIR TEMPERATURE
CD	CONDENSATE DRAIN	HV	HEATING VENTILATING	RC	RAIN CONDUCTOR
CFCI	CONTRACTOR FURNISHED, CONTRACTOR INSTALLED	HWAC	HOT WATER HEATING, AIR CONDITIONING	RD	ROOF DRAIN
CFH	CUBIC FEET PER HOUR	HWHR	HOT WATER HEATING RETURN	REQD	REQUIRED
CFM	CUBIC FEET PER MINUTE	HWF	HOT WATER HEATING SUPPLY	RF	RETURN FAN
CH	CHILLER	HW	HOT WATER	RH	RELATIVE HUMIDITY
CHW	CHILLED WATER	HWR	HOT WATER RETURN	RHFA	REFRIGERANT LIQUID
CHWR	CHILLED WATER RETURN	HW	HOT WATER	RPM	REVOLUTIONS PER MINUTE
CHWS	CHILLED WATER SUPPLY	HWL	DOMESTIC HOT WATER (SPECIFIC TEMP °F)	RPSA	REDUCED PRESSURE BACKFLOW DETECTION ASSY
CLG	COOLING	HX	HEAT EXCHANGER	RPZA	REDUCED PRESSURE BACKFLOW ZONE ASSY
CND	CONDENSATE	HZ	HERTZ	RI	REFRIGERANT SUCTION
CNDS (#)	CONDENSATE (SPECIFIC PSIG)	IAQ	INDOOR AIR QUALITY	RTU	ROOFTOP UNIT
CO	CLEAN OUT	ID	INSIDE DIAMETER	S	SUPPLY AIR DIFFUSER OR GRILLE
CO2	CARBON DIOXIDE	IE	INVERT ELEVATION	SA	SOUND ATTENUATOR
CONT	CONTINUATION OR CONTINUED	IH	INTAKE HOOD	SA	SANITARY AIR
CONTR	CONTRACTOR	IN	INCHES	SAN	SANITARY WASTE
CONTR	CONTRACTOR	IR	INFRARED HEATER	SAT	SUPPLY AIR TEMPERATURE
COP	COEFFICIENT OF PERFORMANCE	IW	INDIRECT WASTE	SCCA	SHORT CIRCUIT CURRENT RATING SECTION
CP	CIRCULATING PUMP	JP	JANITOR'S CLOSET	SECT	SECTION
CR	CONDENSATE RETURN UNIT	JC	JOCKEY PUMP	SF	SUPPLY FAN
CSS	CLINICAL SERVICE SINK	KW	KILOWATT	SK	SINK
CT	COOLING TOWER	KWH	KILOWATT-HOUR	SMR	SNOW MELT RETURN
CUH	CABINET UNIT HEATER	LAT	LEAVING AIR TEMPERATURE	SMS	SNOW MELT SUPPLY
CW	CONDENSATE RETURN UNIT	LAB	LABORATORY	LAV	LAVATORY
CWR	CONDENSER WATER RETURN	LBS	POUNDS	LBS	POUNDS
CWS	CONDENSER WATER SUPPLY	LDB	LEAVING DRY BULB	LPC	LOW PRESSURE CONDENSATE
		LL	LOW LIMIT	LPS	LOW PRESSURE STEAM
D&T	DRIP AND TRAP	LRA	LOCKED ROTOR AMPS	LWB	LEAVING WET BULB
DA	DISCHARGE AIR	LWT	LEAVING WATER TEMPERATURE	MA	MIXED AIR
DAT	DISCHARGE AIR TEMPERATURE	MA	MIXED AIR	MAT	MIXED AIR TEMPERATURE
DB	DRY BULB	MAU	MAKE-UP AIR UNIT	MAU	MAKE-UP AIR UNIT
DDC	DRIFT DIGITAL CONTROL	MAX	MAXIMUM	MBH	THOUSAND BRITISH THERMAL UNITS PER HOUR
DEG	DEGREE	MCA	MINIMUM COMPRESSED AIR	MCA	MINIMUM COMPRESSED AIR
DFU	DRAINAGE FIXTURE UNITS	MCC	MOTOR CONTROL CENTER	MCC	MOTOR CONTROL CENTER
DIA	DIAMETER	MCH	MECHANICAL	MECH	MECHANICAL
DMPR	DAMPER	MEZZ	MEZZANINE	MEZZ	MEZZANINE
DN	DOWN	MFR	MANUFACTURER	MFR	MANUFACTURER
DNZ	DOWNSPOUT NOZZLE	MH	MANHOLE	MH	MANHOLE
DS	DUCT SILENCER	MI	MINIMUM	MI	MINIMUM
DT	DRAIN TILE	MIL	MILLI	MIL	MILLI
DTC	DRAIN TILE CONNECTION	MIN	MINIMUM	MIN	MINIMUM
DWH	DRAINING WATER HEATER	MIS	MISCELLANEOUS	MIS	MISCELLANEOUS
DWG	DRAWING	MMB	MILLION BRITISH THERMAL UNITS PER HOUR	MMB	MILLION BRITISH THERMAL UNITS PER HOUR
		MOP	MAXIMUM OVERCURRENT PROTECTION	MOP	MAXIMUM OVERCURRENT PROTECTION
(E)	EXISTING	MPS	MOUNTED	MPS	MOUNTED
E	EXHAUST GRILLE OR REGISTER	MTR	MOTOR	MTR	MOTOR
EA	EACH	MV	MANUAL AIR VENT	MV	MANUAL AIR VENT
EA	EXHAUST AIR	MVAC	MEDICAL VACUUM	MVAC	MEDICAL VACUUM
EAT	ENTERING AIR TEMPERATURE	N	NITROGEN	N	NITROGEN
EC	EXPANSION COMPENSATOR	N2O	NITROUS OXIDE	N2O	NITROUS OXIDE
ECU	ELECTRIC CABINET UNIT HEATER	NC	NOISE CRITERIA	NC	NOISE CRITERIA
EDB	ENTERING DRY BULB	NCN	NORMALLY CLOSED	NCN	NORMALLY CLOSED
EER	ENERGY EFFICIENCY RATIO	NCTC	NORMALLY CLOSED TIMED CLOSED	NCTC	NORMALLY CLOSED TIMED CLOSED
EESS	EMERGENCY EYE WASH / SHOWER	NCTO	NORMALLY CLOSED TIMED OPEN	NCTO	NORMALLY CLOSED TIMED OPEN
EEW	EMERGENCY EYE WASH	NFA	NATIONAL FIRE PROTECTION AGENCY	NFA	NATIONAL FIRE PROTECTION AGENCY
EF	EFFICIENCY	NOTC	NORMALLY OPEN TIMED CLOSED	NOTC	NORMALLY OPEN TIMED CLOSED
EH	ELECTRIC HEATING COIL	NOTO	NORMALLY OPEN TIMED OPEN	NOTO	NORMALLY OPEN TIMED OPEN
EJ	EXPANSION JOINT	NOT IN CONTRACT	NOT IN CONTRACT	NOT IN CONTRACT	NOT IN CONTRACT
EL	ELEVATION	NO	NORMALLY OPEN	NO	NORMALLY OPEN
ELEC	ELECTRICAL	NOM	NOMINAL	NOM	NOMINAL
EMS	ENERGY MANAGEMENT SYSTEM	NPCW	NON PORTABLE COLD WATER	NPCW	NON PORTABLE COLD WATER
ERL	ENERGY RECOVERY LOOP				
ERLR	ENERGY RECOVERY LOOP RETURN				
ERLS	ENERGY RECOVERY LOOP SUPPLY				
ERU	ENERGY RECOVERY UNIT				
ESH	EMERGENCY SHOWER				
ESP	EXTERNAL STATIC PRESSURE				
EUH	ELECTRIC UNIT HEATER				
EWB	ENTERING WET BULB				
EW	ELECTRIC WATER COOLER				
EWT	ENTERING WATER TEMPERATURE				
EXH	EXHAUST				
F	FIRE PROTECTION				
°F	DEGREES FAHRENHEIT				
F&B	FACE AND BYPASS				
F&T	FLOAT AND THERMOSTATIC				
FA	FACE AREA				
FCU	FAN COIL UNIT				

TEMPERATURE CONTROL - PARTIAL SYMBOLS LIST


SYMBOL	DESCRIPTION	SYMBOL	DESCRIPTION
	CARBON DIOXIDE SENSOR		OCCUPANCY SENSOR
	CARBON MONOXIDE SENSOR		PRESSURE TRANSMITTER
	DIFFERENTIAL PRESSURE TRANSMITTER		STATIC PRESSURE SENSOR OR PROBE
	FLOW METER		VALVE - 2 WAY CONTROL VALVE
	GUARD FOR STAT OR SENSOR		VALVE - 3 WAY CONTROL VALVE
	HUMIDISTAT OR HUMIDITY SENSOR (AS DEFINED ON TC DRAWINGS)		THERMOSTAT OR TEMPERATURE SENSOR (AS DEFINED ON TC DRAWINGS)

NOTE: LIST OF ADDITIONAL SYMBOLS & ABBREVIATIONS ASSOCIATED WITH TEMPERATURE CONTROLS ARE IDENTIFIED ON TC DRAWINGS.

MECHANICAL SYMBOL LIST

SYMBOL	DESCRIPTION	SYMBOL	DESCRIPTION
	AIR VENT - AUTOMATIC		AIR VENT - AUTOMATIC
	AIR VENT - MANUAL		AIR VENT - MANUAL
	BACKFLOW PREVENTER		BACKFLOW PREVENTER
	CATCH BASIN		CATCH BASIN
	CIRCULATING PUMP		CIRCULATING PUMP
	CLEAN OUT - IN FLOOR		CLEAN OUT - IN FLOOR
	CLEAN OUT - FLANGE		CLEAN OUT - FLANGE
	DIRECTION OF FLOW		DIRECTION OF FLOW
	DIRECTION OF PITCH - DOWN		DIRECTION OF PITCH - DOWN
	FINNED TUBE RADIATION		FINNED TUBE RADIATION
	FIRE PROTECTION - SIAMSESE CONNECTION - FREE STANDING		FIRE PROTECTION - SIAMSESE CONNECTION - FREE STANDING
	FIRE PROTECTION - SIAMSESE CONNECTION - WALL MOUNTED		FIRE PROTECTION - SIAMSESE CONNECTION - WALL MOUNTED
	FIRE PROTECTION - SPRINKLER HEAD, CONCEALED		FIRE PROTECTION - SPRINKLER HEAD, CONCEALED
	FIRE PROTECTION - SPRINKLER HEAD, PENDANT		FIRE PROTECTION - SPRINKLER HEAD, PENDANT
	FIRE PROTECTION - SPRINKLER HEAD, UPRIGHT		FIRE PROTECTION - SPRINKLER HEAD, UPRIGHT
	FIRE PROTECTION - SPRINKLER HEAD, SIDEWALL		FIRE PROTECTION - SPRINKLER HEAD, SIDEWALL
	FLOOR DRAIN		FLOOR DRAIN
	FLOOR DRAIN - ELEVATION		FLOOR DRAIN - ELEVATION
	FLOOR DRAIN - FUNNEL, ELEVATION		FLOOR DRAIN - FUNNEL, ELEVATION
	FLOW MEASURING DEVICE (FOR TEST AND BALANCING)		FLOW MEASURING DEVICE (FOR TEST AND BALANCING)
	FLOW SWITCH		FLOW SWITCH
	FLOW METER		FLOW METER
	HOSE BIBB		HOSE BIBB
	MANHOLE		MANHOLE
	RETURN GRILLE OR REGISTER		RETURN GRILLE OR REGISTER
	RETURN AIR		RETURN AIR
	RETURN AIR TEMPERATURE		RETURN AIR TEMPERATURE
	RAIN CONDUCTOR		RAIN CONDUCTOR
	ROOF DRAIN		ROOF DRAIN
	REQUIRED		REQUIRED
	RETURN FAN		RETURN FAN
	RELATIVE HUMIDITY		RELATIVE HUMIDITY
	REFRIGERANT LIQUID		REFRIGERANT LIQUID
	REVOLUTIONS PER MINUTE		REVOLUTIONS PER MINUTE
	REDUCED PRESSURE BACKFLOW DETECTION ASSY		REDUCED PRESSURE BACKFLOW DETECTION ASSY
	REFRIGERANT SUCTION		REFRIGERANT SUCTION
	ROOFTOP UNIT		ROOFTOP UNIT
	SUPPLY AIR DIFFUSER OR GRILLE		SUPPLY AIR DIFFUSER OR GRILLE
	SOUND ATTENUATOR		SOUND ATTENUATOR
	SANITARY AIR		SANITARY AIR
	SUPPLY AIR TEMPERATURE		SUPPLY AIR TEMPERATURE
	SHORT CIRCUIT CURRENT RATING SECTION		SHORT CIRCUIT CURRENT RATING SECTION
	SECTION		SECTION
	SUPPLY FAN		SUPPLY FAN
	SINK		SINK
	SNOW MELT RETURN		SNOW MELT RETURN
	SNOW MELT SUPPLY		SNOW MELT SUPPLY
	STATIC PRESSURE		STATIC PRESSURE
	SPECIFICATION		SPECIFICATION
	SPRINKLER		SPRINKLER
	SQUARE FEET/SQUARE FEET		SQUARE FEET/SQUARE FEET
	START/STOP		START/STOP
	SERVICE SINK		SERVICE SINK
	STORM		STORM
	STANDARD		STANDARD
	STACK		STACK
	STEAM		STEAM
	STEAM (SPECIFIC PSIG)		STEAM (SPECIFIC PSIG)
	SUMMER/WINTER SWITCH		SUMMER/WINTER SWITCH
	TRANSFER GRILLE		TRANSFER GRILLE
	TEMPERATURE CONTROL		TEMPERATURE CONTROL
	TEMPERING COIL		TEMPERING COIL
	TEMPERATURE CONTROL PANEL		TEMPERATURE CONTROL PANEL
	TRENCH DRAIN		TRENCH DRAIN
	TEMPERATURE		TEMPERATURE
	TEMPORARY		TEMPORARY
	TERMINAL HEATING		TERMINAL HEATING
	TOTAL HEAT ABSORBED		TOTAL HEAT ABSORBED
	TERMINAL HEATING RETURN		TERMINAL HEATING RETURN
	TOTAL HEAT REJECTED		TOTAL HEAT REJECTED
	TERMINAL HEATING SUPPLY		TERMINAL HEATING SUPPLY
	TEPID WATER		TEPID WATER
	TOTAL STATIC PRESSURE		TOTAL STATIC PRESSURE
	(AIR) TERMINAL UNIT		(AIR) TERMINAL UNIT
	TURNING VANES		TURNING VANES
	TEMPERED WATER		TEMPERED WATER
	TYPICAL		TYPICAL
	UNIT HEATER		UNIT HEATER
	UNDERWRITERS LABORATORY UNLESS OTHERWISE NOTED		UNDERWRITERS LABORATORY UNLESS OTHERWISE NOTED
	URINAL		URINAL
	UNIT VENTILATOR		UNIT VENTILATOR
	VALVE		VALVE
	VENT		VENT
	VACUUM		VACUUM
	VARIABLE AIR VOLUME		VARIABLE AIR VOLUME
	VACUUM BREAKER		VACUUM BREAKER
	VOLUME DAMPER (MANUALLY ADJUSTABLE)		VOLUME DAMPER (MANUALLY ADJUSTABLE)
	VOLUME		VOLUME
	VARIABLE FREQUENCY CONTROLLER		VARIABLE FREQUENCY CONTROLLER

THE FOLLOWING DIMENSION EQUALS ONE INCH WHEN PRINTED TO SCALE.

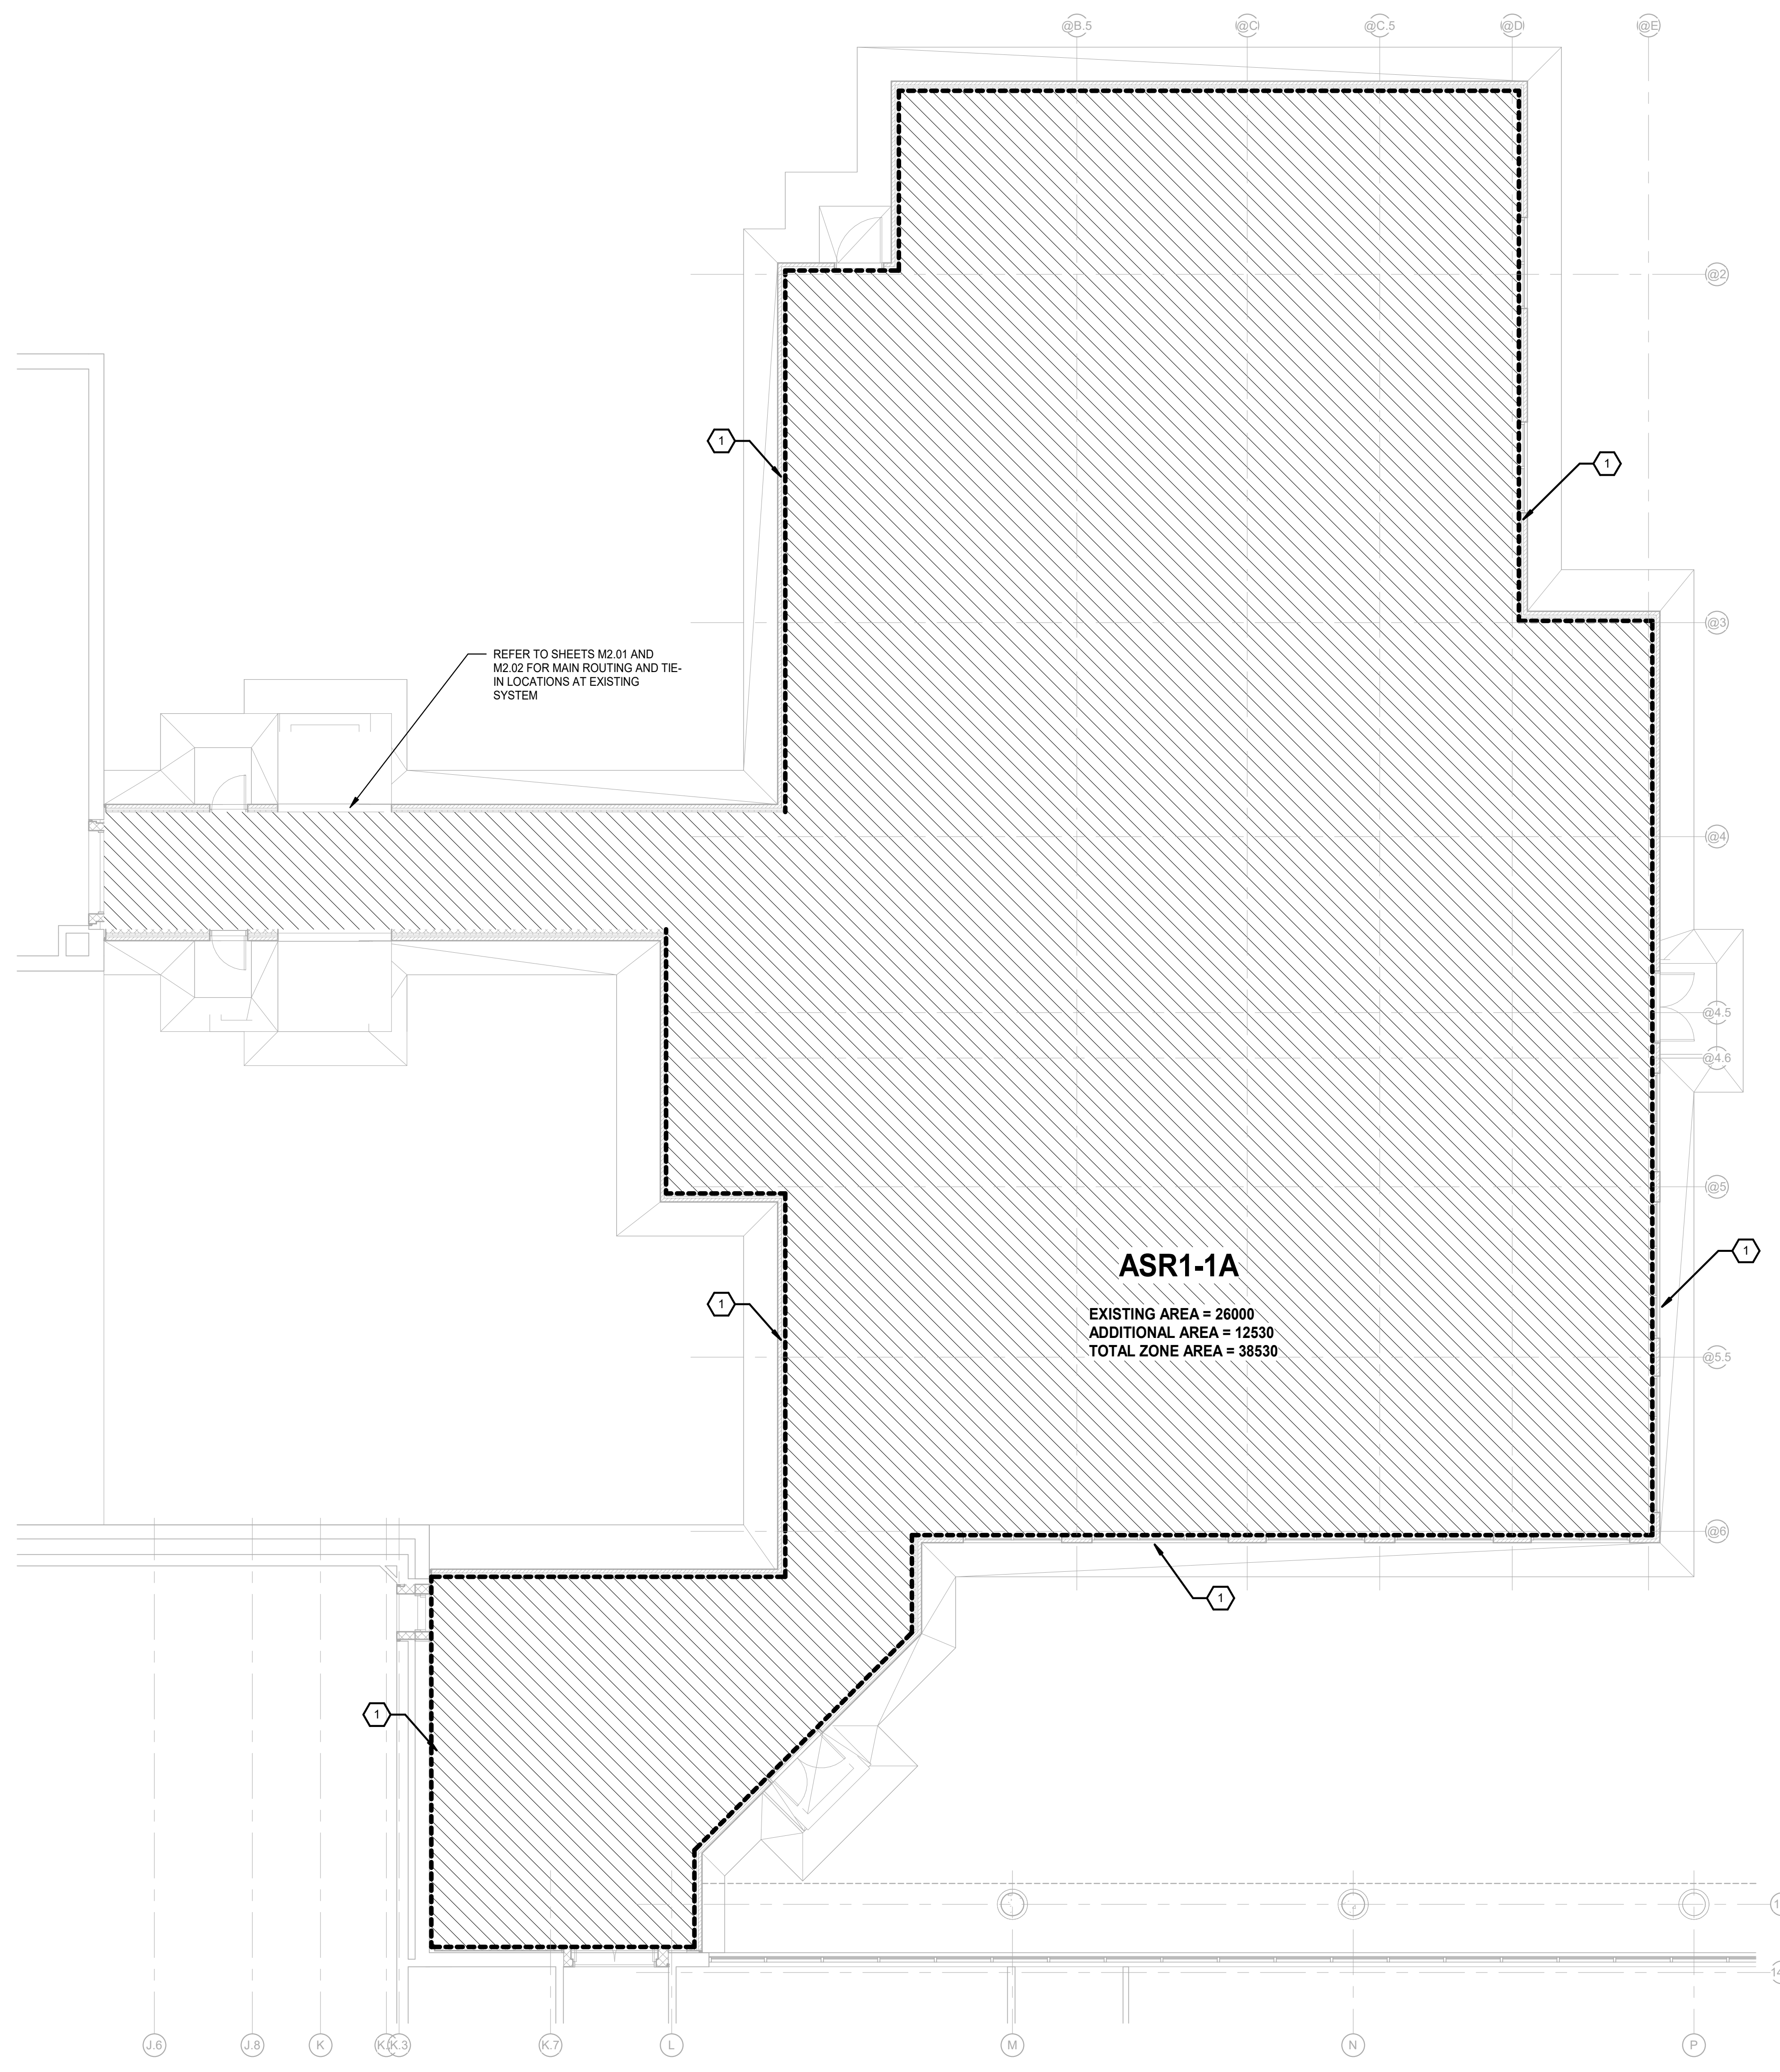

ASR1-1A
 EXISTING AREA = 26000
 ADDITIONAL AREA = 12530
 TOTAL ZONE AREA = 38530


FIRST FLOOR FIRE PROTECTION ZONING PLAN
 SCALE: 1/8" = 1'-0"

FIRE PROTECTION GENERAL NOTES:

- 1 THESE DRAWINGS ARE DIAGRAMMATIC, AND REPRESENT THE GENERAL INTENT AND ARRANGEMENT OF SYSTEMS. THEY ARE NOT TO BE CONSIDERED FABRICATION/COORDINATION/SHOP DRAWINGS. COORDINATION WITH OTHER TRADES IS REQUIRED. PROVIDE THE ADDITIONAL FITTINGS AND OFFSETS THAT WILL BE REQUIRED TO COMPLETE EACH SYSTEM AND TO AVOID INTERFERENCES WITH ALL OTHER SYSTEMS INCLUDING THE STRUCTURE, SHEET METAL, OTHER PIPING SYSTEMS, ELECTRICAL, CONDUITS, BUS DUCTS, CABLE TRAY, LIGHT FIXTURES, ETC. AND/OR OTHER SPACE CONSTRAINTS.
- 2 INSTALL SYSTEMS SUCH THAT REQUIRED CLEARANCE AND SERVICE ACCESS SPACE IS PROVIDED AROUND ALL MECHANICAL AND ELECTRICAL EQUIPMENT, AND AROUND ANY COMPONENTS WHICH REQUIRE SERVICE ACCESS.
- 3 NO SPRINKLER PIPING SHALL BE ROUTED THROUGH ELECTRICAL EQUIPMENT ROOMS, TELECOMMUNICATION EQUIPMENT ROOMS, ELEVATOR EQUIPMENT ROOMS OR SIMILAR ROOMS. ONLY SPRINKLER PIPING SERVING SPRINKLER HEADS IN THOSE ROOMS SHALL BE ALLOWED.
- 4 PIPING SHALL NOT BE INSTALLED ABOVE ELECTRICAL TRANSFORMERS, SWITCHBOARDS, PANELBOARDS OR MOTOR CONTROL CENTERS.
- 5 MINIMUM RUN-OUT PIPE SIZE TO SPRINKLER HEADS SHALL BE 1".
- 6 PROVIDE AN AUTOMATIC WET PIPE SPRINKLER SYSTEM IN ACCORDANCE WITH NFPA 13 <<LIGHT HAZARD>> CLASSIFICATION. HYDRAULIC CALCULATIONS SHALL BE BASED ON DENSITY OF <<0.10>> GPM/SQ. FT. OVER THE MOST REMOTE <<1500>> SQ. FT.
- 7 ACCORDING TO THE MOST RECENT FLOW TEST INFORMATION, THE STATIC PRESSURE AVAILABLE AT THE CITY WATER MAIN AT THE STREET IS <<XX>> PSIG. RESIDUAL PRESSURE WITH <<XXX>> GPM FLOWING IS <<XX>> PSIG. CONTRACTOR SHALL MAKE HIS OWN PRESSURE AND FLOW TEST PRIOR TO SYSTEM DESIGN.
- 8 FIRE PROTECTION WATER SERVICE ENTRANCE PIPING SHALL BE BURIED WITH DEPTH OF COVER OVER TOP OF PIPE OF AT LEAST <<72">> OR WITH TOP OF PIPE AT LEAST 12" BELOW LEVEL OF MAXIMUM FROST PENETRATION, OR AS REQUIRED BY AUTHORITIES HAVING JURISDICTION, WHICHEVER IS DEEPEST.

CONSTRUCTION KEY NOTES:

- 1 PROVIDE FULLY FUNCTIONING SPRINKLER SYSTEM IN ACCORDANCE WITH NFPA13, OWNERS INSURING AGENCY AND AUTHORITY HAVING JURISDICTION IN AREA INDICATED.

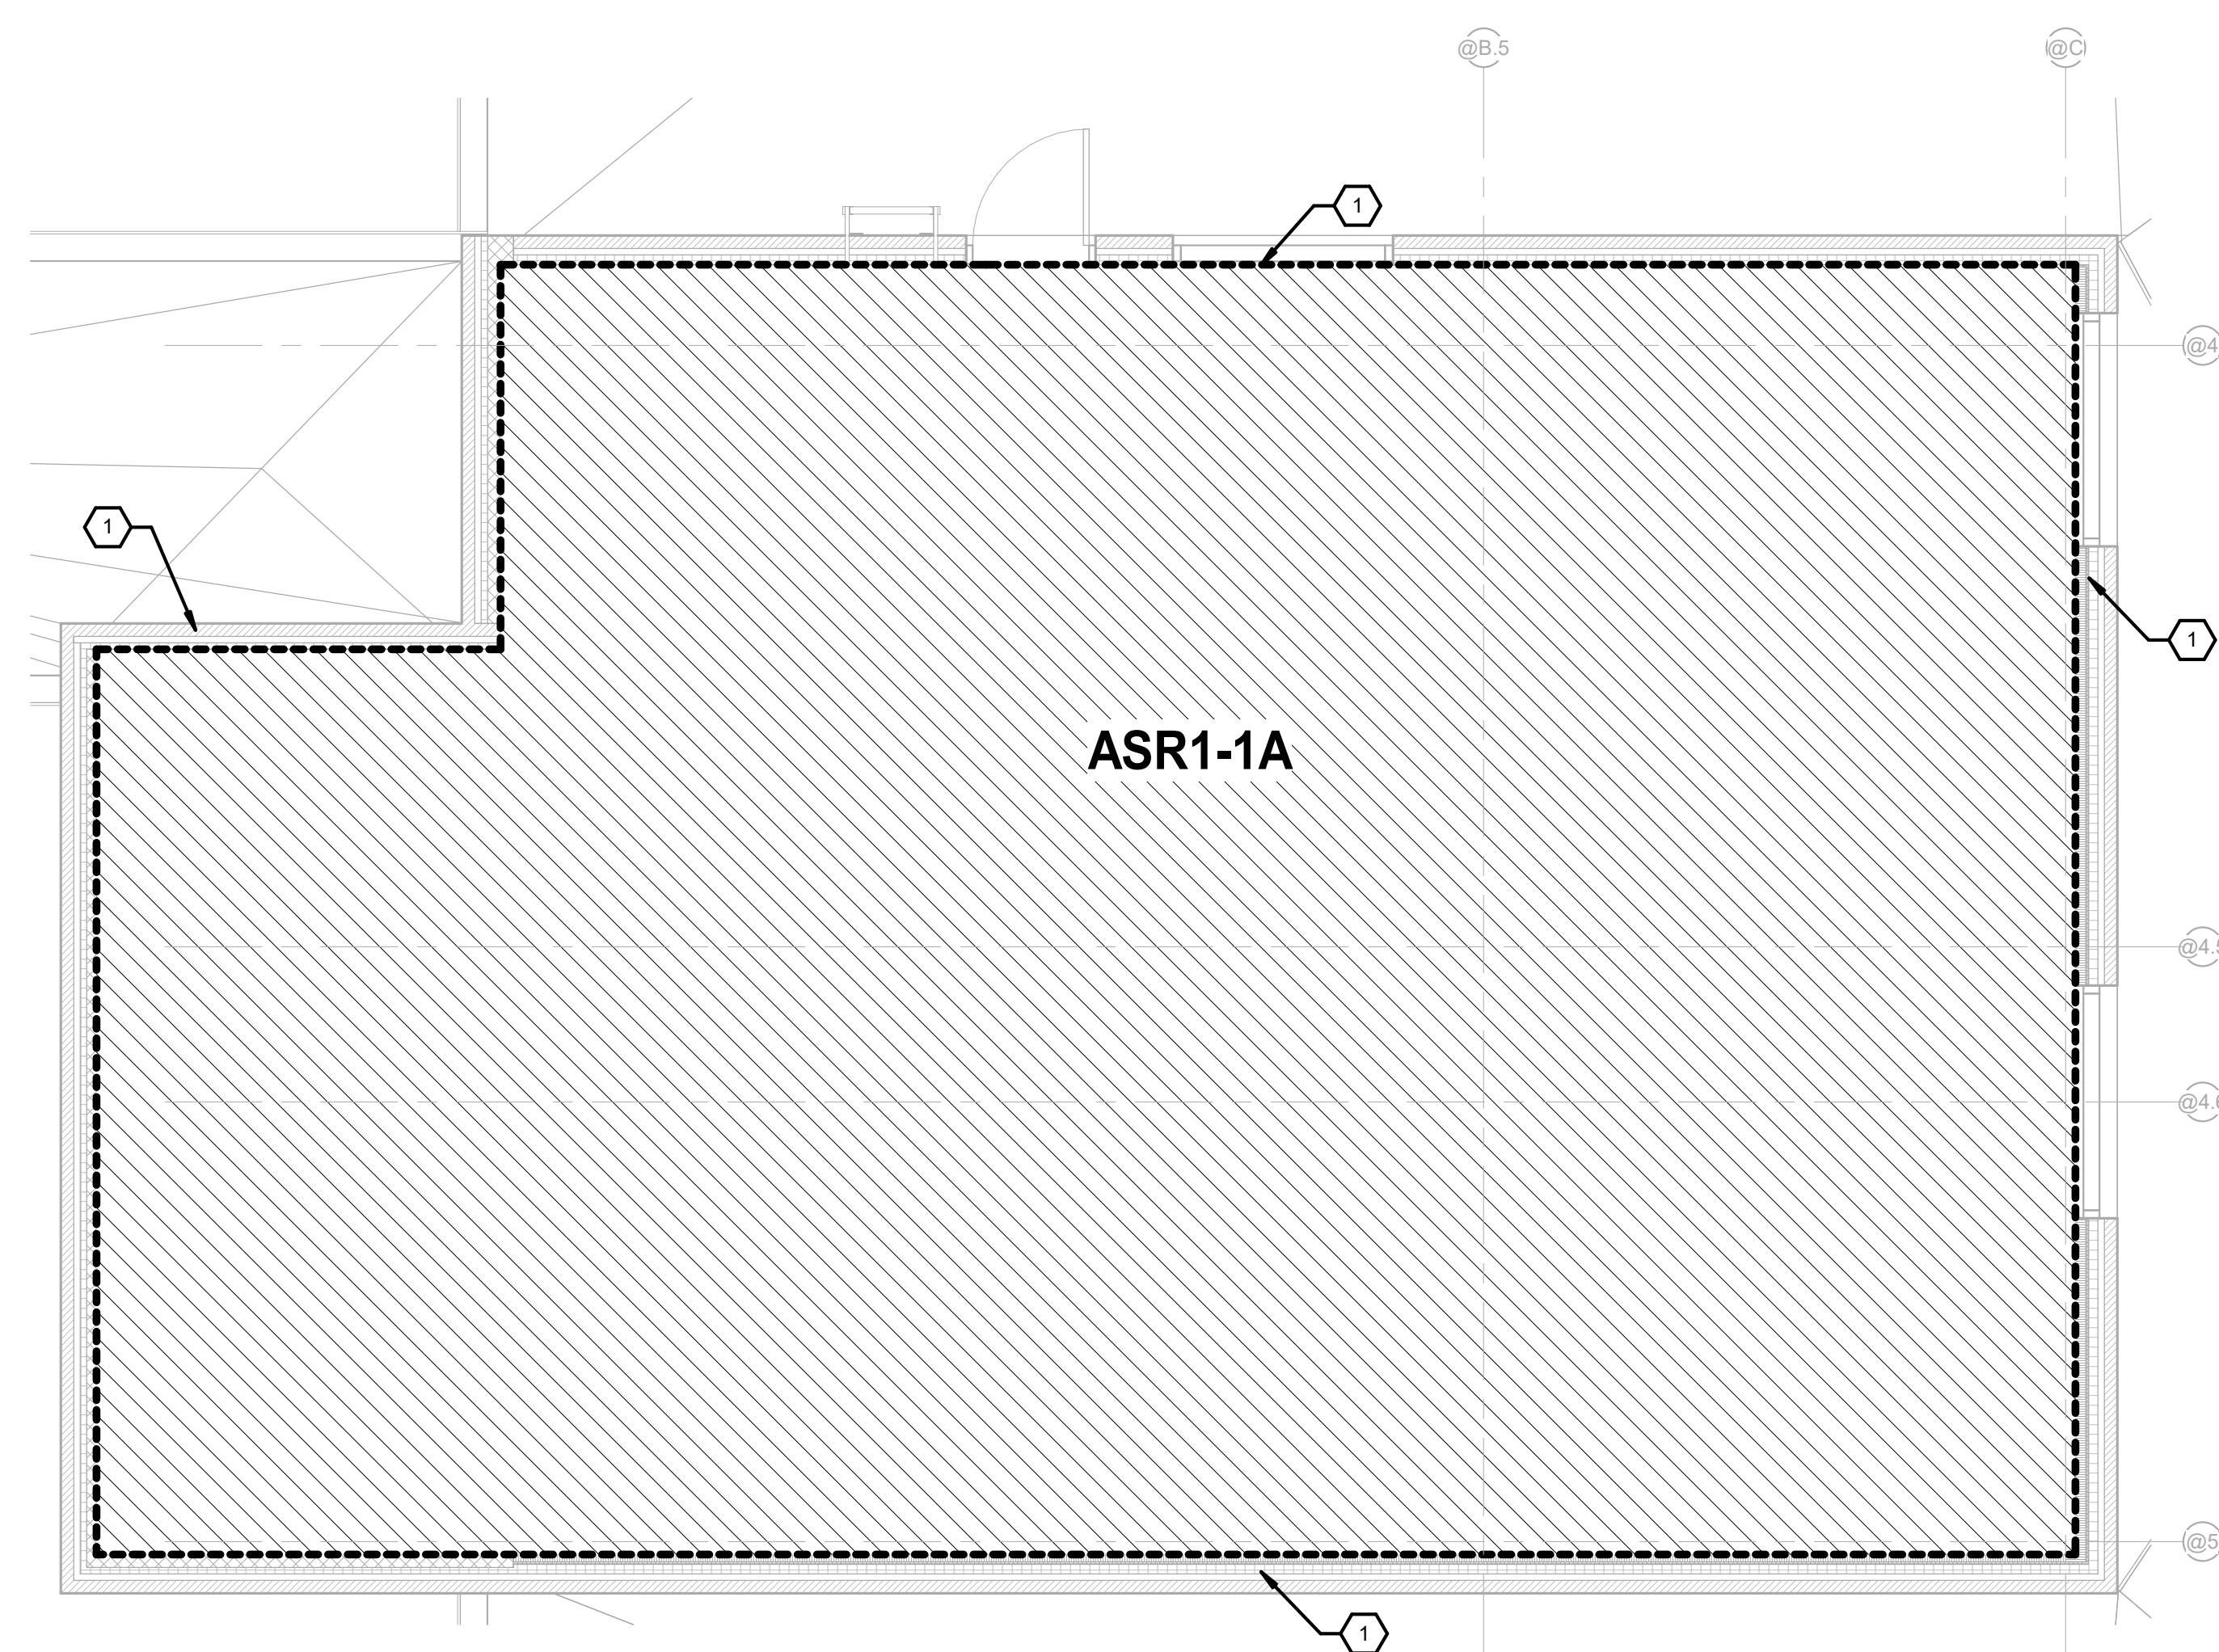

ASR1-1A

PENTHOUSE FIRE PROTECTION ZONING PLAN
 SCALE: 1/4" = 1'-0"


NO.	REVISION	DATE

STATE OF MICHIGAN
 DEPARTMENT OF TECHNOLOGY, MANAGEMENT AND BUDGET
 FACILITIES AND BUSINESS SERVICES ADMINISTRATION
 DESIGN AND CONSTRUCTION DIVISION
 ADAM LACH, RA, DIRECTOR

FILE NO.
 491/20167.SDW

FUNDING CODE
 171CODHHS7255

CONTRACT NO.
 Y22003

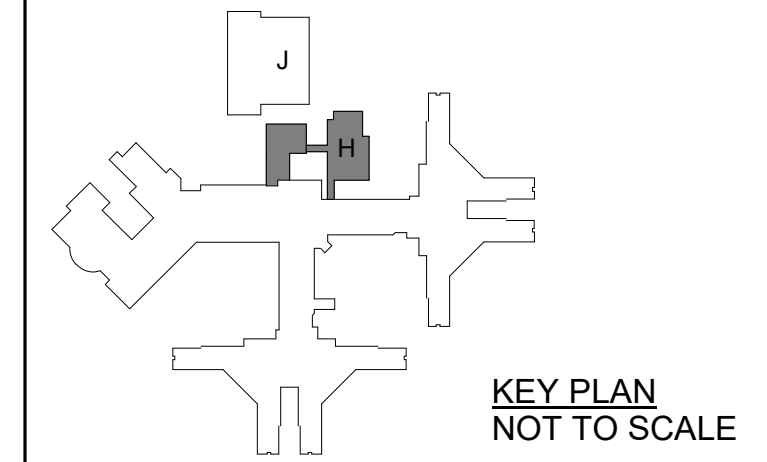

WTAARCH.COM

WTA ARCHITECTS
 100 S. Jefferson Ave., Suite 601
 Saginaw, Michigan 48607
 989 752 8107
 COPYRIGHT © 2023


PROJECT TITLE
 491/20167.SDW - PHASE 500:
**CENTER FOR FORENSIC
 PSYCHIATRY - CREATE
 KITCHEN**
 SALINE, MICHIGAN

SHEET TITLE
**FIRE PROTECTION ZONING
 PLAN**

PROJECT NUMBER 2021094	SHEET NUMBER M1.01
PROJECT DATE SEPTEMBER 6, 2023	CHECKED BY WEK


PBA
 Peter Basso Associates Inc
 CONSULTING ENGINEERS
 5145 Livernois, Suite 100
 Troy, Michigan 48068-3276
 Tel: 248-879-5666
 Fax: 248-879-0007
 www.PeterBassoAssociates.com
 PBA Project No. 303-0402

THE FOLLOWING DIMENSION EQUALS ONE INCH WHEN PRINTED TO SCALE.



PLUMBING

These documents are approved for compliance with the STATE OF MICHIGAN PLUMBING CODE subject to field inspection and the conditions of approval.

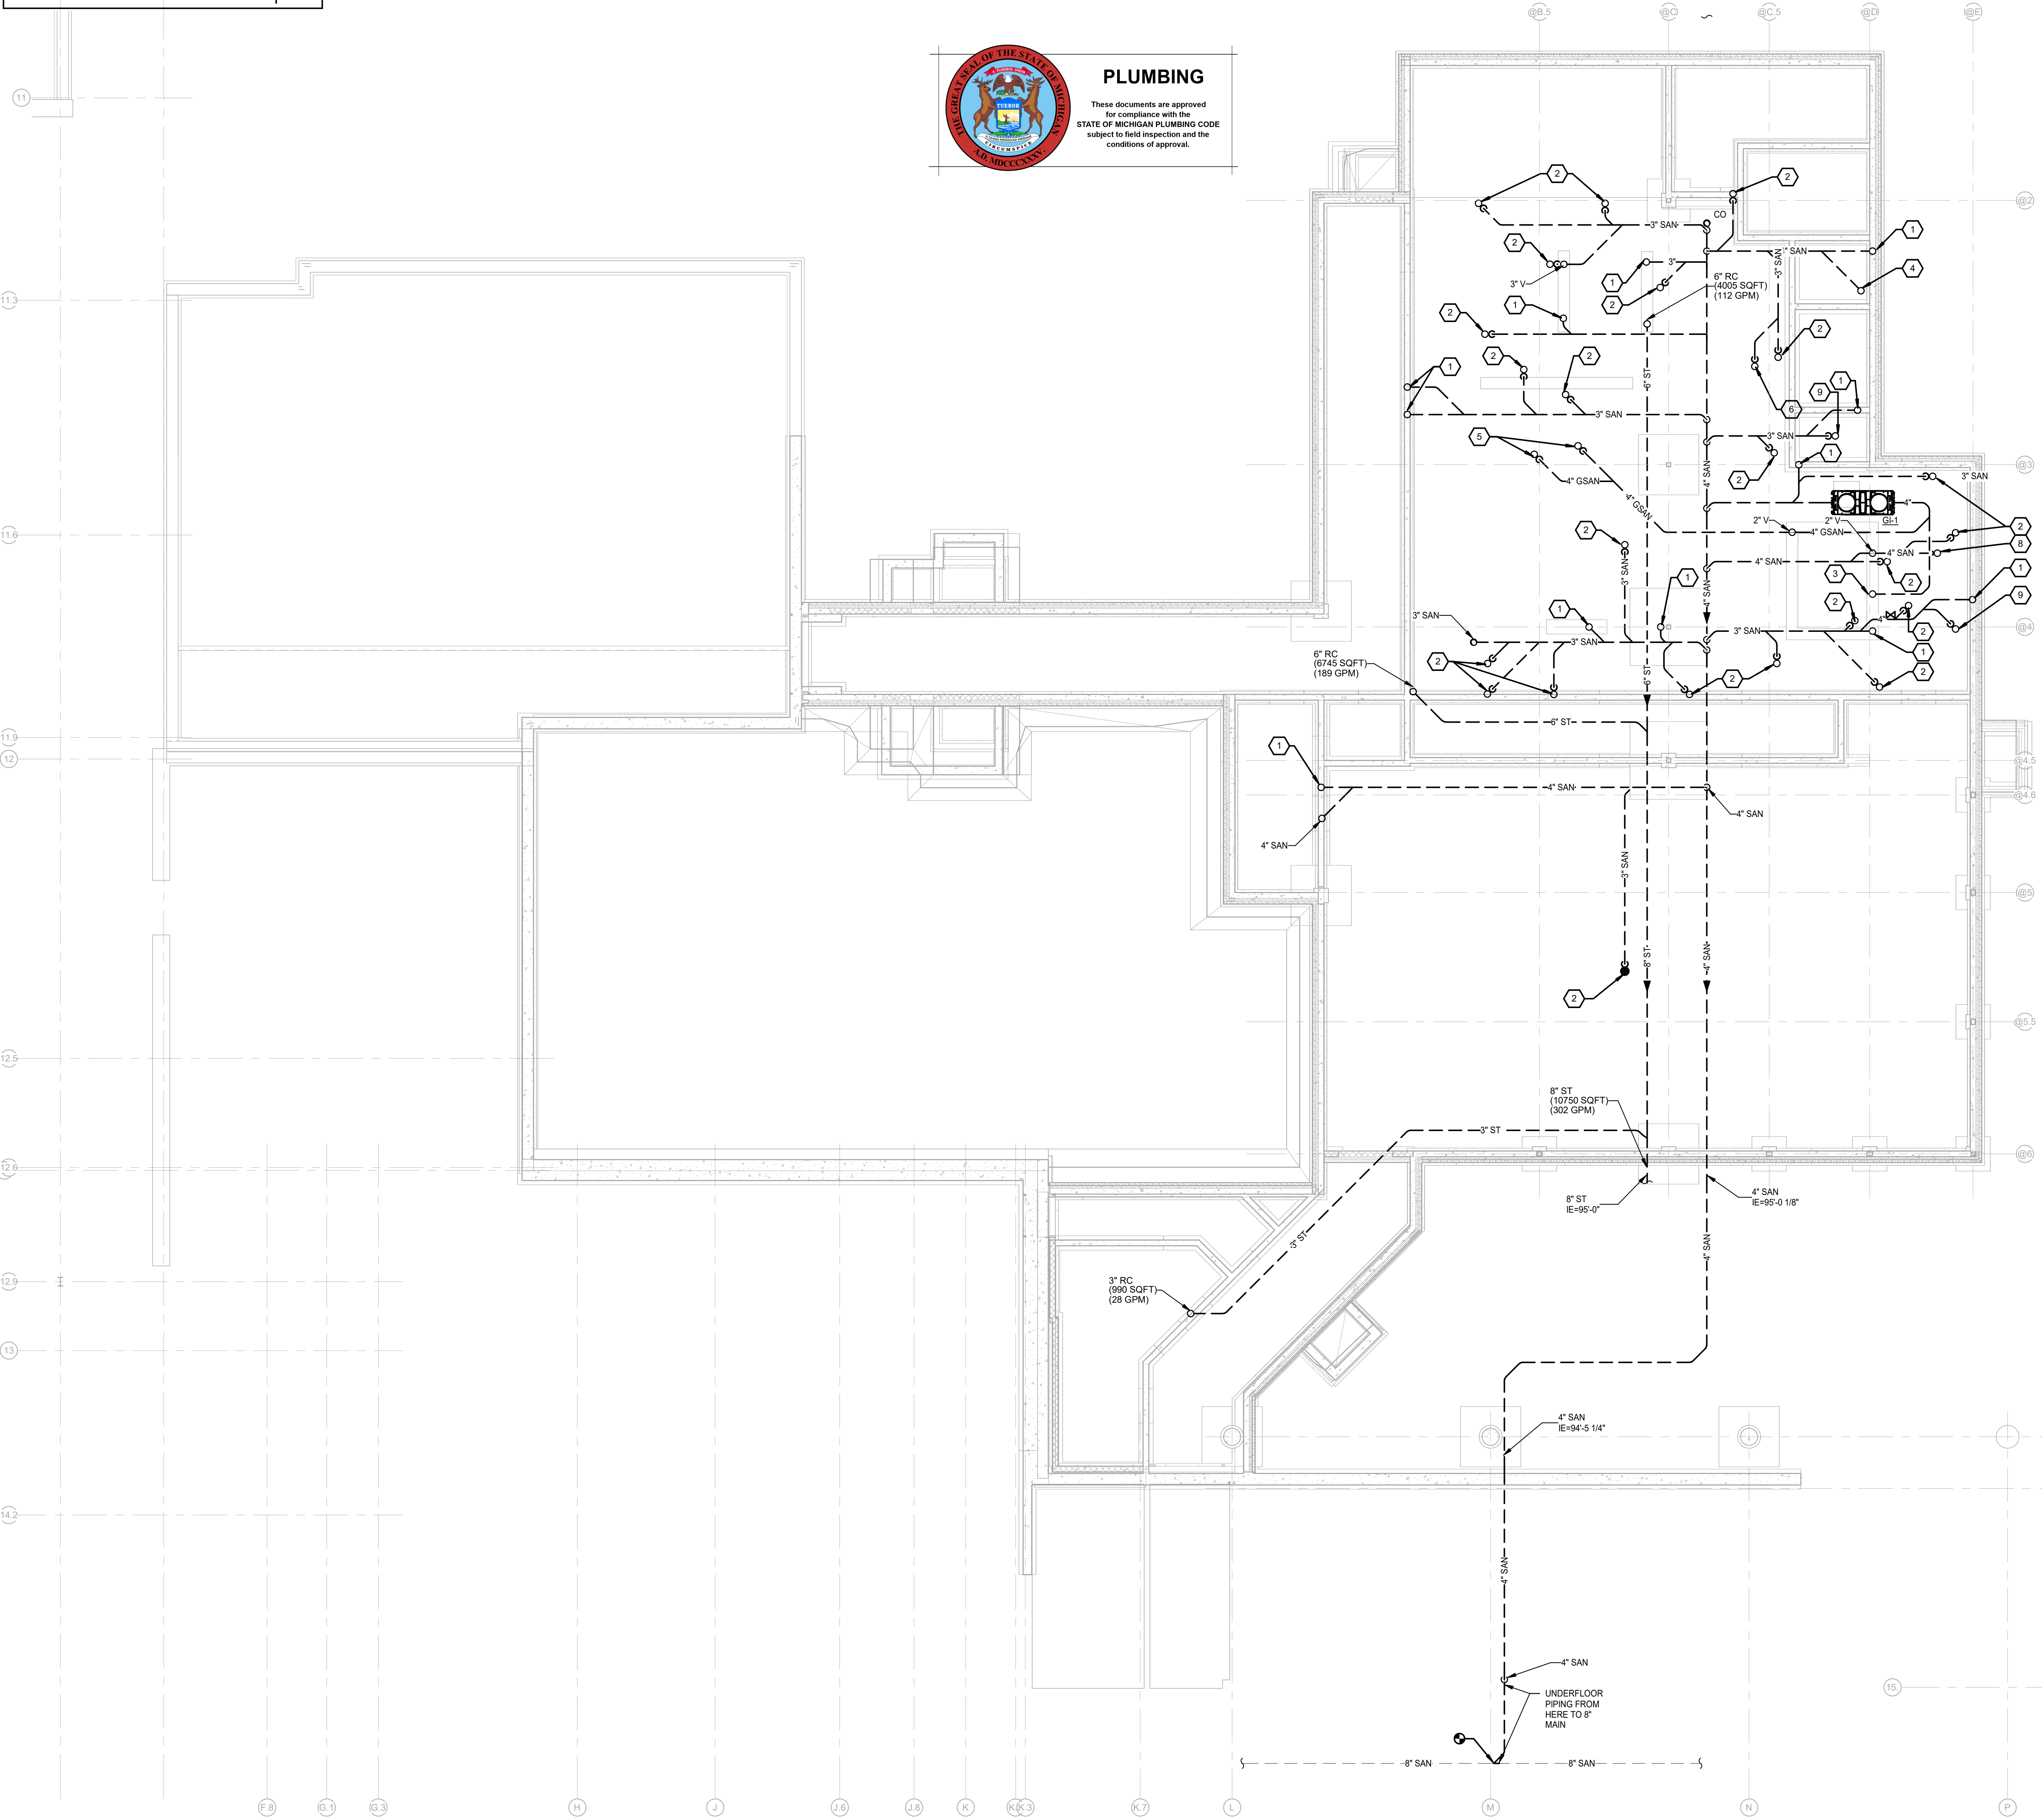

PLUMBING GENERAL NOTES:

- THESE DRAWINGS ARE DIAGRAMMATIC, AND REPRESENT THE GENERAL INTENT AND ARRANGEMENT OF SYSTEMS. THEY ARE NOT TO BE CONSIDERED FABRICATION/COORDINATION/SHOP DRAWINGS. COORDINATION WITH OTHER TRADES IS REQUIRED. PROVIDE THE ADDITIONAL FITTINGS AND OFFSETS THAT WILL BE REQUIRED TO COMPLETE EACH SYSTEM AND TO AVOID INTERFERENCES WITH ALL OTHER SYSTEMS INCLUDING THE STRUCTURE, SHEET METAL, OTHER PIPING SYSTEMS, ELECTRICAL CONDUITS, BUS DUCTS, CABLE TRAY, LIGHT FIXTURES, ETC. AND/OR OTHER SPACE CONSTRAINTS.
- INSTALL SYSTEMS SUCH THAT REQUIRED CLEARANCE AND SERVICE ACCESS SPACE IS PROVIDED AROUND ALL MECHANICAL AND ELECTRICAL EQUIPMENT, AND AROUND ANY COMPONENTS WHICH REQUIRE SERVICE ACCESS.
- PIPING SHALL NOT BE INSTALLED ABOVE ELECTRICAL TRANSFORMERS, SWITCHBOARDS, PANELBOARDS OR MOTOR CONTROL CENTERS.
- COORDINATE AND PROVIDE ACCESS DOORS WITHIN INACCESSIBLE CEILING, SHAFT, AND CHASE AREAS FOR ALL COMPONENTS WHICH REQUIRE SERVICE ACCESS. REFER TO ARCHITECTURAL DRAWINGS FOR CEILING TYPES.
- PROVIDE SUPPLEMENTARY STEEL AS REQUIRED FOR THE PROPER SUPPORT OF ALL SYSTEMS.
- REFER TO ARCHITECTURAL PLANS FOR DIMENSIONED LOCATIONS OF PLUMBING FIXTURES.
- HOT AND COLD WATER PIPING RUN-OUTS TO LAVATORIES AND SINKS SHALL BE 1/2" UNLESS OTHERWISE NOTED.
- PLUMBING VENT PIPING THROUGH ROOF SHALL BE LOCATED A MINIMUM OF 10'-0" FROM ANY FRESH AIR INTAKE LOCATION AND A MINIMUM OF 18" CLEAR FROM THE INSIDE FACE OF PARAPET.
- PROVIDE CODE REQUIRED CLEARANCE FOR ALL CLEANOUTS INSTALLED IN SANITARY WASTE AND VENT PIPING.
- MINIMUM UNDERGROUND PIPE SIZE SHALL BE 3".

CONSTRUCTION KEY NOTES:

- 3 SAN TO LAV/SINK.
- 3 SAN TO FLOOR DRAIN/SINK.
- 3 GSAN TO SINK.
- 4 SAN TO WC.
- 4 GSAN TO FLOOR TROUGH.
- 3 SAN TO FLOOR TROUGH.
- 1/2 CW TO DRAIN COOLER.
- 4 SAN TO FLOOR TROUGH.
- 4 SAN TO FLOOR DRAIN/SINK.
- ROUTE IN CEILING SPACE OF GYM. ROUTE ALONG SIDE NEW MECHANICAL PIPING. COORDINATE FINAL ROUTING WITH MECHANICAL TRADES.
- PIPING IN THIS AREA ROUTED WITHIN SECOND FLOOR CEILING SPACE.

C:\REVIT\LOCAL FILES\2021-06-02-ME2_Forensic_Plan_v21_Ghentich.rvt 9/2/2023 4:36:42 PM

UNDERGROUND PLUMBING PLAN
SCALE: 1/8" = 1'-0"


NO.	REVISION	DATE

STATE OF MICHIGAN
DEPARTMENT OF TECHNOLOGY, MANAGEMENT AND BUDGET
FACILITIES AND BUSINESS SERVICES ADMINISTRATION
DESIGN AND CONSTRUCTION DIVISION
ADAM LACH, RA, DIRECTOR

FILE NO.
491/20167.SDW

FUNDING CODE
171CODHHS7255

CONTRACT NO.
Y22003

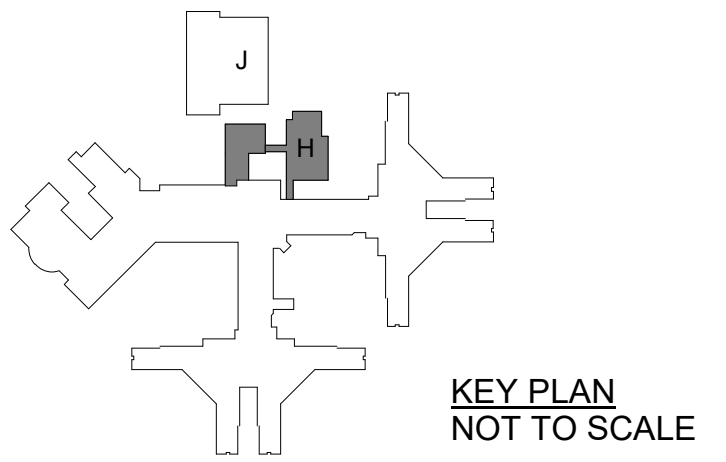

WTA ARCHITECTS

100 S. Jefferson Ave, Suite 601
Saginaw, Michigan 48607
989 752 8107

COPYRIGHT © 2023

PROJECT TITLE
491/20167.SDW - PHASE 500:
CENTER FOR FORENSIC PSYCHIATRY - CREATE KITCHEN
SALINE, MICHIGAN

SHEET TITLE
UNDERGROUND PLUMBING PLAN

PROJECT NUMBER
2021094

SHEET NUMBER

PROJECT DATE
SEPTEMBER 6, 2023


M2.00

CHECKED BY
WEK




Peter Basso Associates Inc.
CONSULTING ENGINEERS
5145 Livernois, Suite 100
Troy, Michigan 48068-3276
Tel: 248-879-5666
Fax: 248-879-0007
www.PeterBassoAssociates.com
PBA Project No. 303-0602

THE FOLLOWING DIMENSION EQUALS ONE INCH WHEN PRINTED TO SCALE.

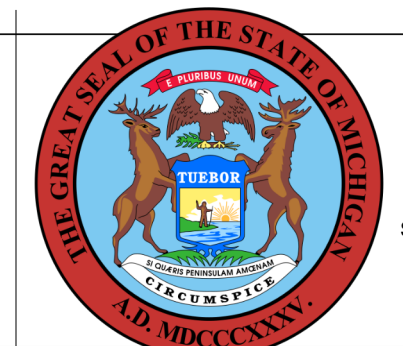

PLUMBING
 These documents are approved for compliance with the STATE OF MICHIGAN PLUMBING CODE subject to field inspection and the conditions of approval.

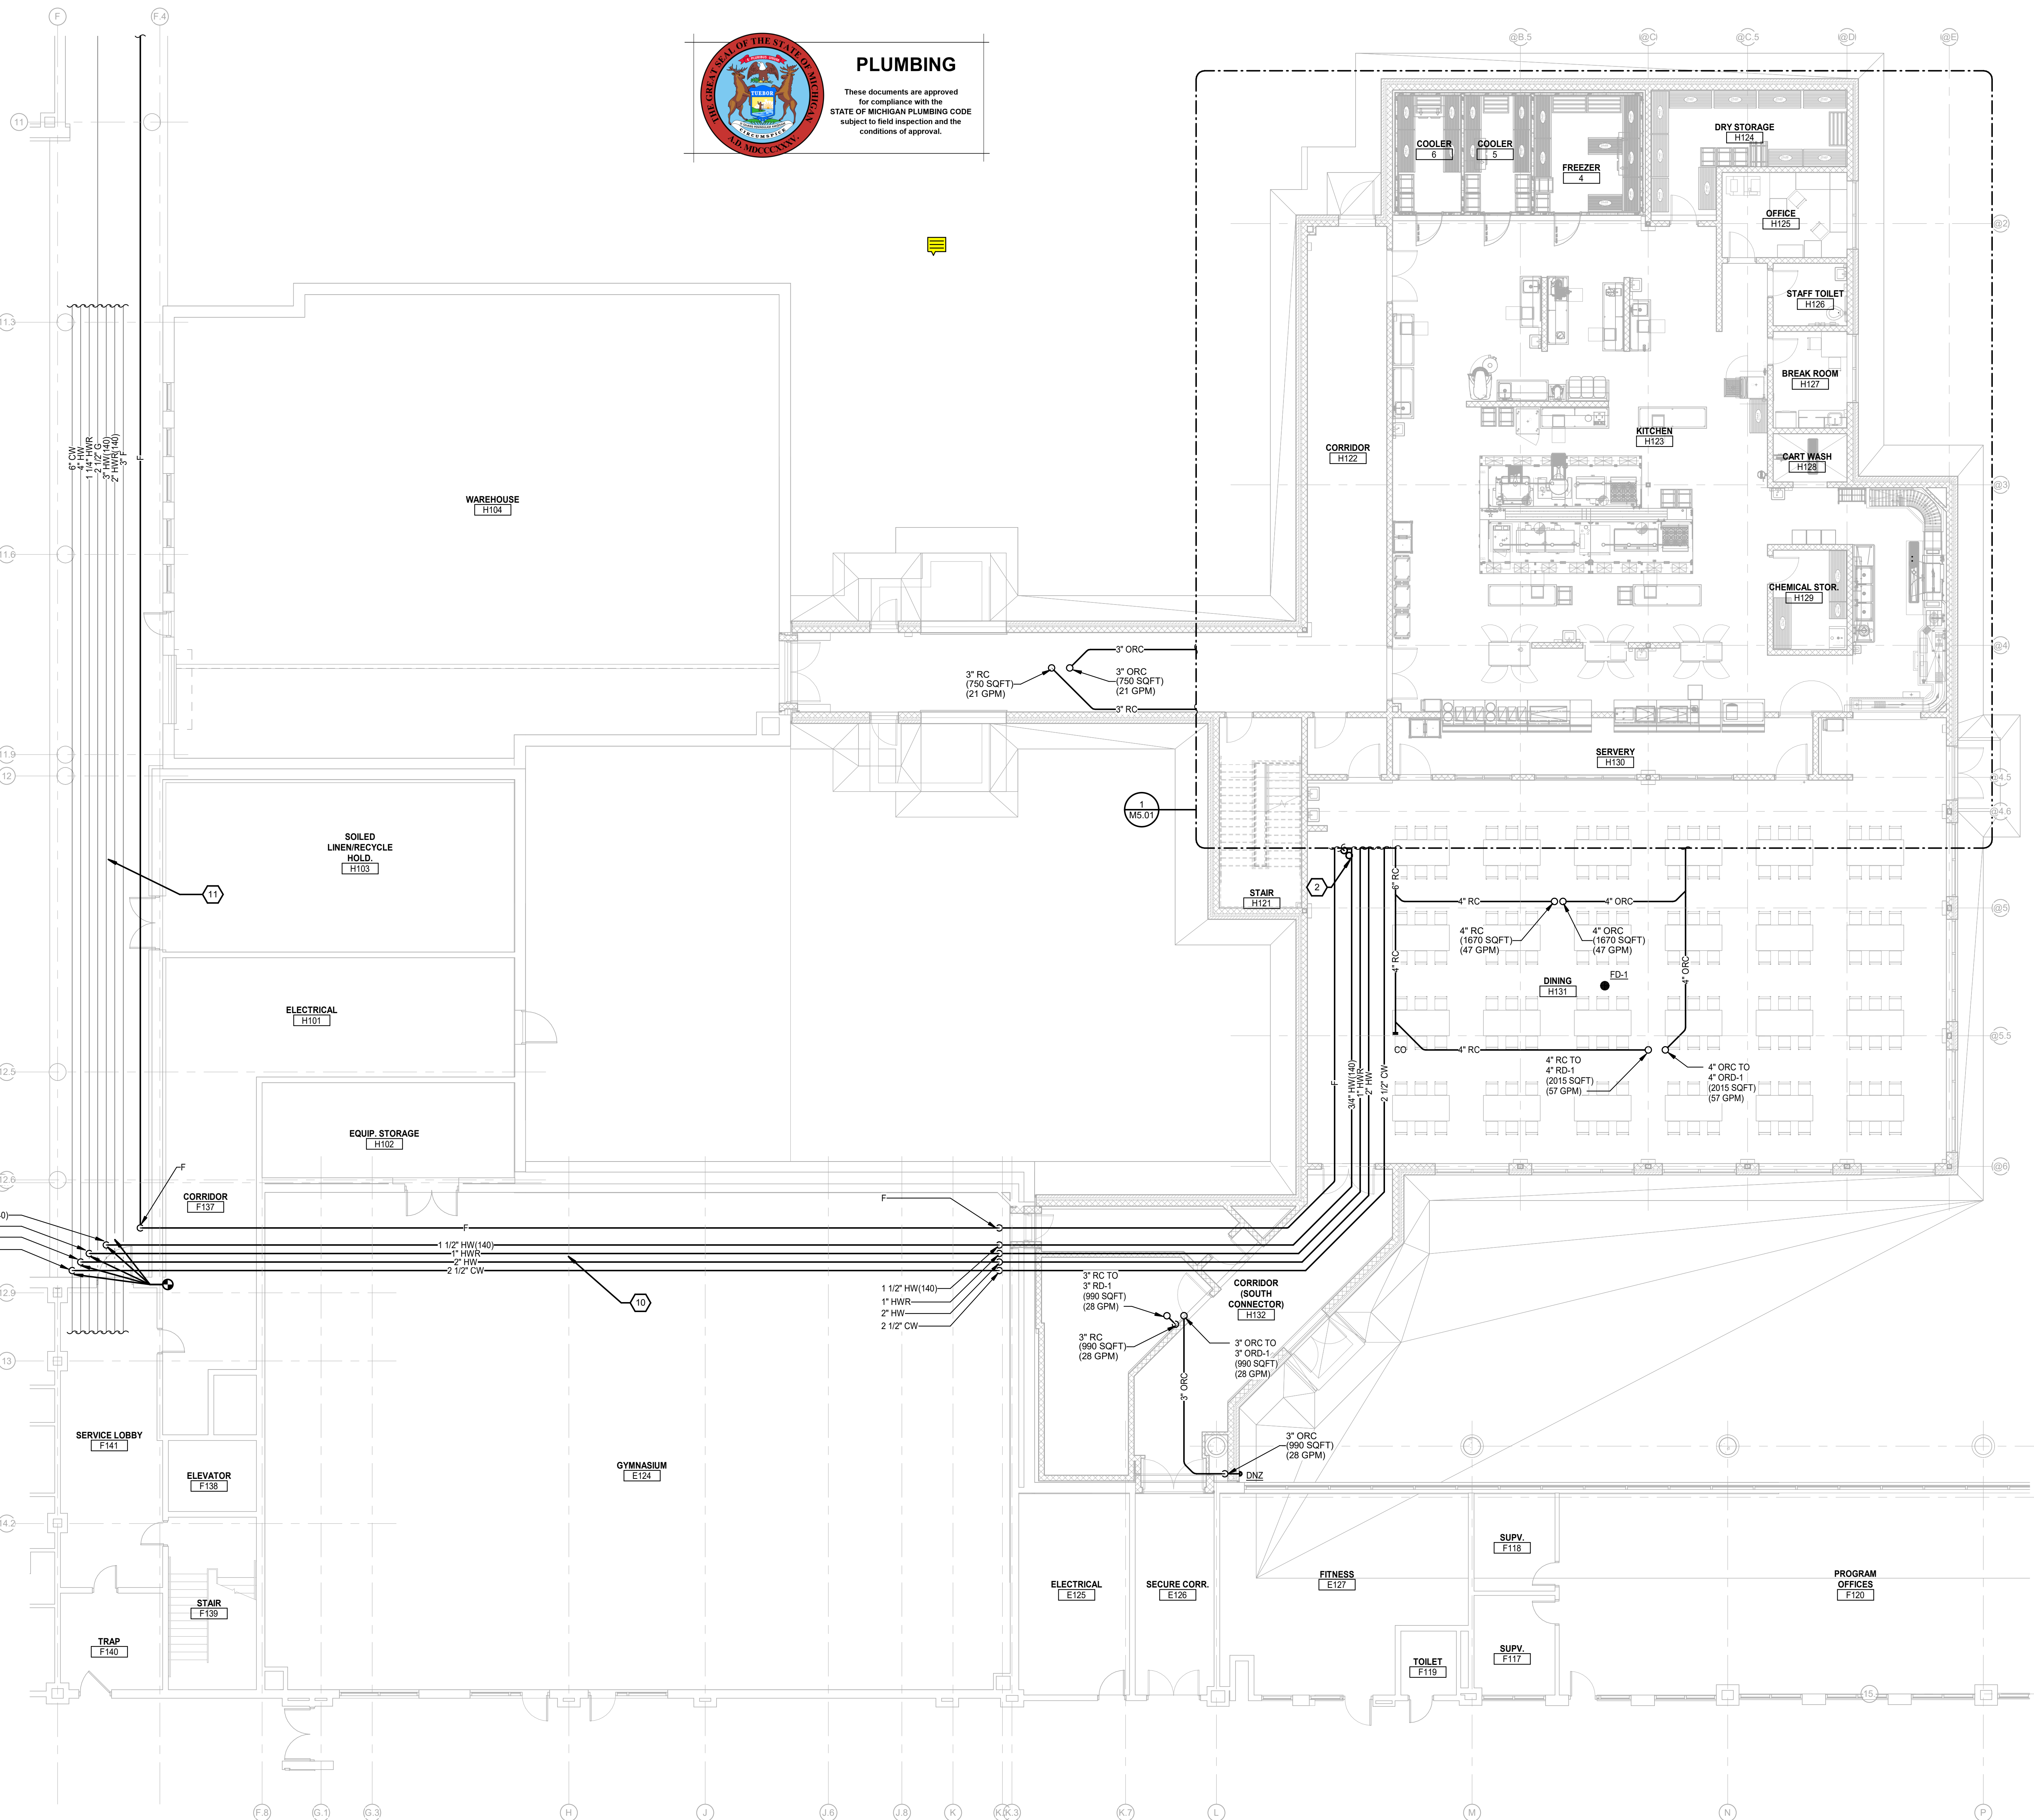

FIRE PROTECTION GENERAL NOTES:

- THESE DRAWINGS ARE DIAGRAMMATIC, AND REPRESENT THE GENERAL INTENT AND ARRANGEMENT OF SYSTEMS. THEY ARE NOT TO BE CONSIDERED FABRICATION/COORDINATION SHOP DRAWINGS. COORDINATION WITH OTHER TRADES IS REQUIRED. PROVIDE THE ADDITIONAL FITTINGS AND OFFSETS THAT WILL BE REQUIRED TO COMPLETE EACH SYSTEM AND TO AVOID INTERFERENCES WITH ALL OTHER SYSTEMS INCLUDING THE STRUCTURE, SHEET METAL, OTHER PIPING SYSTEMS, ELECTRICAL CONDUITS, BUS DUCTS, CABLE TRAY, LIGHT FIXTURES, ETC. AND/OR OTHER SPACE CONSTRAINTS.
- INSTALL SYSTEMS SUCH THAT REQUIRED CLEARANCE AND SERVICE ACCESS SPACE IS PROVIDED AROUND ALL MECHANICAL AND ELECTRICAL EQUIPMENT, AND AROUND ANY COMPONENTS WHICH REQUIRE SERVICE ACCESS.
- NO SPRINKLER PIPING SHALL BE ROUTED THROUGH ELECTRICAL EQUIPMENT ROOMS, TELECOMMUNICATION EQUIPMENT ROOMS, ELEVATOR EQUIPMENT ROOMS OR SIMILAR ROOMS. ONLY SPRINKLER PIPING SERVING SPRINKLER HEADS IN THOSE ROOMS SHALL BE ALLOWED.
- PIPING SHALL NOT BE INSTALLED ABOVE ELECTRICAL TRANSFORMERS, SWITCHBOARDS, PANELBOARDS OR MOTOR CONTROL CENTERS.
- MINIMUM RUN-OUT PIPE SIZE TO SPRINKLER HEADS SHALL BE 1".
- PROVIDE AN AUTOMATIC WET PIPE SPRINKLER SYSTEM IN ACCORDANCE WITH NFPA 13 <<<LIGHT HAZARD>>> CLASSIFICATION. HYDRAULIC CALCULATIONS SHALL BE BASED ON DENSITY OF <<<0.10>>> GPM/SQ FT. OVER THE MOST REMOTE <<<1500>>> SQ. FT.
- ACCORDING TO THE MOST RECENT FLOW TEST INFORMATION, THE STATIC PRESSURE AVAILABLE AT THE CITY WATER MAIN AT THE STREET IS <<<90>>> PSIG. RESIDUAL PRESSURE WITH <<<000>>> GPM FLOWING IS <<<80>>> PSIG. CONTRACTOR SHALL MAKE HIS OWN PRESSURE AND FLOW TEST PRIOR TO SYSTEM DESIGN.
- FIRE PROTECTION WATER SERVICE ENTRANCE PIPING SHALL BE BURIED WITH DEPTH OF COVER OVER TOP OF PIPE OF AT LEAST <<<12>>>, OR WITH TOP OF PIPE AT LEAST 12" BELOW LEVEL OF MAXIMUM FROST PENETRATION, OR AS REQUIRED BY AUTHORITIES HAVING JURISDICTION, WHICHEVER IS DEEPEST.

PLUMBING GENERAL NOTES:

- THESE DRAWINGS ARE DIAGRAMMATIC, AND REPRESENT THE GENERAL INTENT AND ARRANGEMENT OF SYSTEMS. THEY ARE NOT TO BE CONSIDERED FABRICATION/COORDINATION SHOP DRAWINGS. COORDINATION WITH OTHER TRADES IS REQUIRED. PROVIDE THE ADDITIONAL FITTINGS AND OFFSETS THAT WILL BE REQUIRED TO COMPLETE EACH SYSTEM AND TO AVOID INTERFERENCES WITH ALL OTHER SYSTEMS INCLUDING THE STRUCTURE, SHEET METAL, OTHER PIPING SYSTEMS, ELECTRICAL CONDUITS, BUS DUCTS, CABLE TRAY, LIGHT FIXTURES, ETC. AND/OR OTHER SPACE CONSTRAINTS.
- INSTALL SYSTEMS SUCH THAT REQUIRED CLEARANCE AND SERVICE ACCESS SPACE IS PROVIDED AROUND ALL MECHANICAL AND ELECTRICAL EQUIPMENT, AND AROUND ANY COMPONENTS WHICH REQUIRE SERVICE ACCESS.
- PIPING SHALL NOT BE INSTALLED ABOVE ELECTRICAL TRANSFORMERS, SWITCHBOARDS, PANELBOARDS OR MOTOR CONTROL CENTERS.
- COORDINATE AND PROVIDE ACCESS DOORS WITHIN INACCESSIBLE CEILING, SHAFT, AND CHASE AREAS FOR ALL COMPONENTS WHICH REQUIRE SERVICE ACCESS. REFER TO ARCHITECTURAL DRAWINGS FOR CEILING TYPES.
- PROVIDE SUPPLEMENTARY STEEL AS REQUIRED FOR THE PROPER SUPPORT OF ALL SYSTEMS.
- REFER TO ARCHITECTURAL PLANS FOR DIMENSIONED LOCATIONS OF PLUMBING FIXTURES.
- HOT AND COLD WATER PIPING RUN-OUTS TO LAVATORIES AND SINKS SHALL BE 1/2" UNLESS OTHERWISE NOTED.
- PLUMBING VENT PIPING THROUGH ROOF SHALL BE LOCATED A MINIMUM OF 10'-0" FROM ANY FRESH AIR INTAKE LOCATION AND A MINIMUM OF 18" CLEAR FROM THE INSIDE FACE OF PARAPET.
- PROVIDE CODE REQUIRED CLEARANCE FOR ALL CLEANOUTS INSTALLED IN SANITARY WASTE AND VENT PIPING.
- MINIMUM UNDERGROUND PIPE SIZE SHALL BE 3".

CONSTRUCTION KEY NOTES:

- 3 SAN TO LAV/SINK.
- 3 SAN TO FLOOR DRAIN/SINK.
- 3 GSAN TO SINK.
- 4 SAN TO WC.
- 4 GSAN TO FLOOR TROUGH.
- 3 SAN TO FLOOR TROUGH.
- 1/2 CW TO DRAIN COOLER.
- 4 SAN TO FLOOR TROUGH.
- 4 SAN TO FLOOR DRAIN/SINK.
- ROUTE IN CEILING SPACE OF GYM. ROUTE ALONG SIDE NEW MECHANICAL PIPING. COORDINATE FINAL ROUTING WITH MECHANICAL TRADES.
- PIPING IN THIS AREA ROUTED WITHIN SECOND FLOOR CEILING SPACE.


NO.	REVISION	DATE

STATE OF MICHIGAN
 DEPARTMENT OF TECHNOLOGY, MANAGEMENT AND BUDGET
 FACILITIES AND BUSINESS SERVICES ADMINISTRATION
 DESIGN AND CONSTRUCTION DIVISION
 ADAM LACH, RA, DIRECTOR

FILE NO.
 491/20167.SDW

FUNDING CODE
 171CODHHS7255

CONTRACT NO.
 Y22003

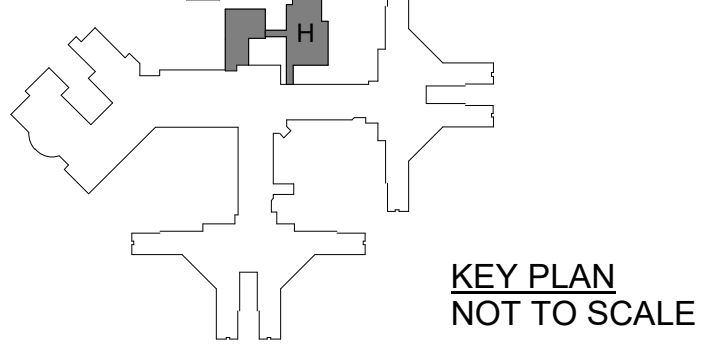

WTA ARCHITECTS

100 S. Jefferson Ave, Suite 601
 Saginaw, Michigan 48607
 989 752 8107

PROJECT TITLE
 491/20167.SDW - PHASE 500:
CENTER FOR FORENSIC PSYCHIATRY - CREATE KITCHEN
 SALINE, MICHIGAN

SHEET TITLE
FIRST FLOOR PLUMBING AND FIRE PROTECTION PLAN - UNIT H

PROJECT NUMBER
 2021094

PROJECT DATE
 SEPTEMBER 6, 2023

CHECKED BY
 WEK



SHEET NUMBER
M2.01

PBA
 Peter Basso Associates Inc
 CONSULTING ENGINEERS
 5145 Livernois, Suite 100
 Troy, Michigan 48068-3276
 Tel: 248-879-5666
 Fax: 248-879-0007
 www.PeterBassoAssociates.com
 PBA Project No. 303-0492

FIRST FLOOR PLUMBING AND FIRE PROTECTION PLAN - UNIT H
 SCALE: 1/8" = 1'-0"

9/20/2023 4:36:48 PM C:\REVIT LOCAL FILES\2023-0602-MEZ_Forensic_Plan_v23_Gheintich.rvt

THE FOLLOWING DIMENSION EQUALS ONE INCH WHEN PRINTED TO SCALE.

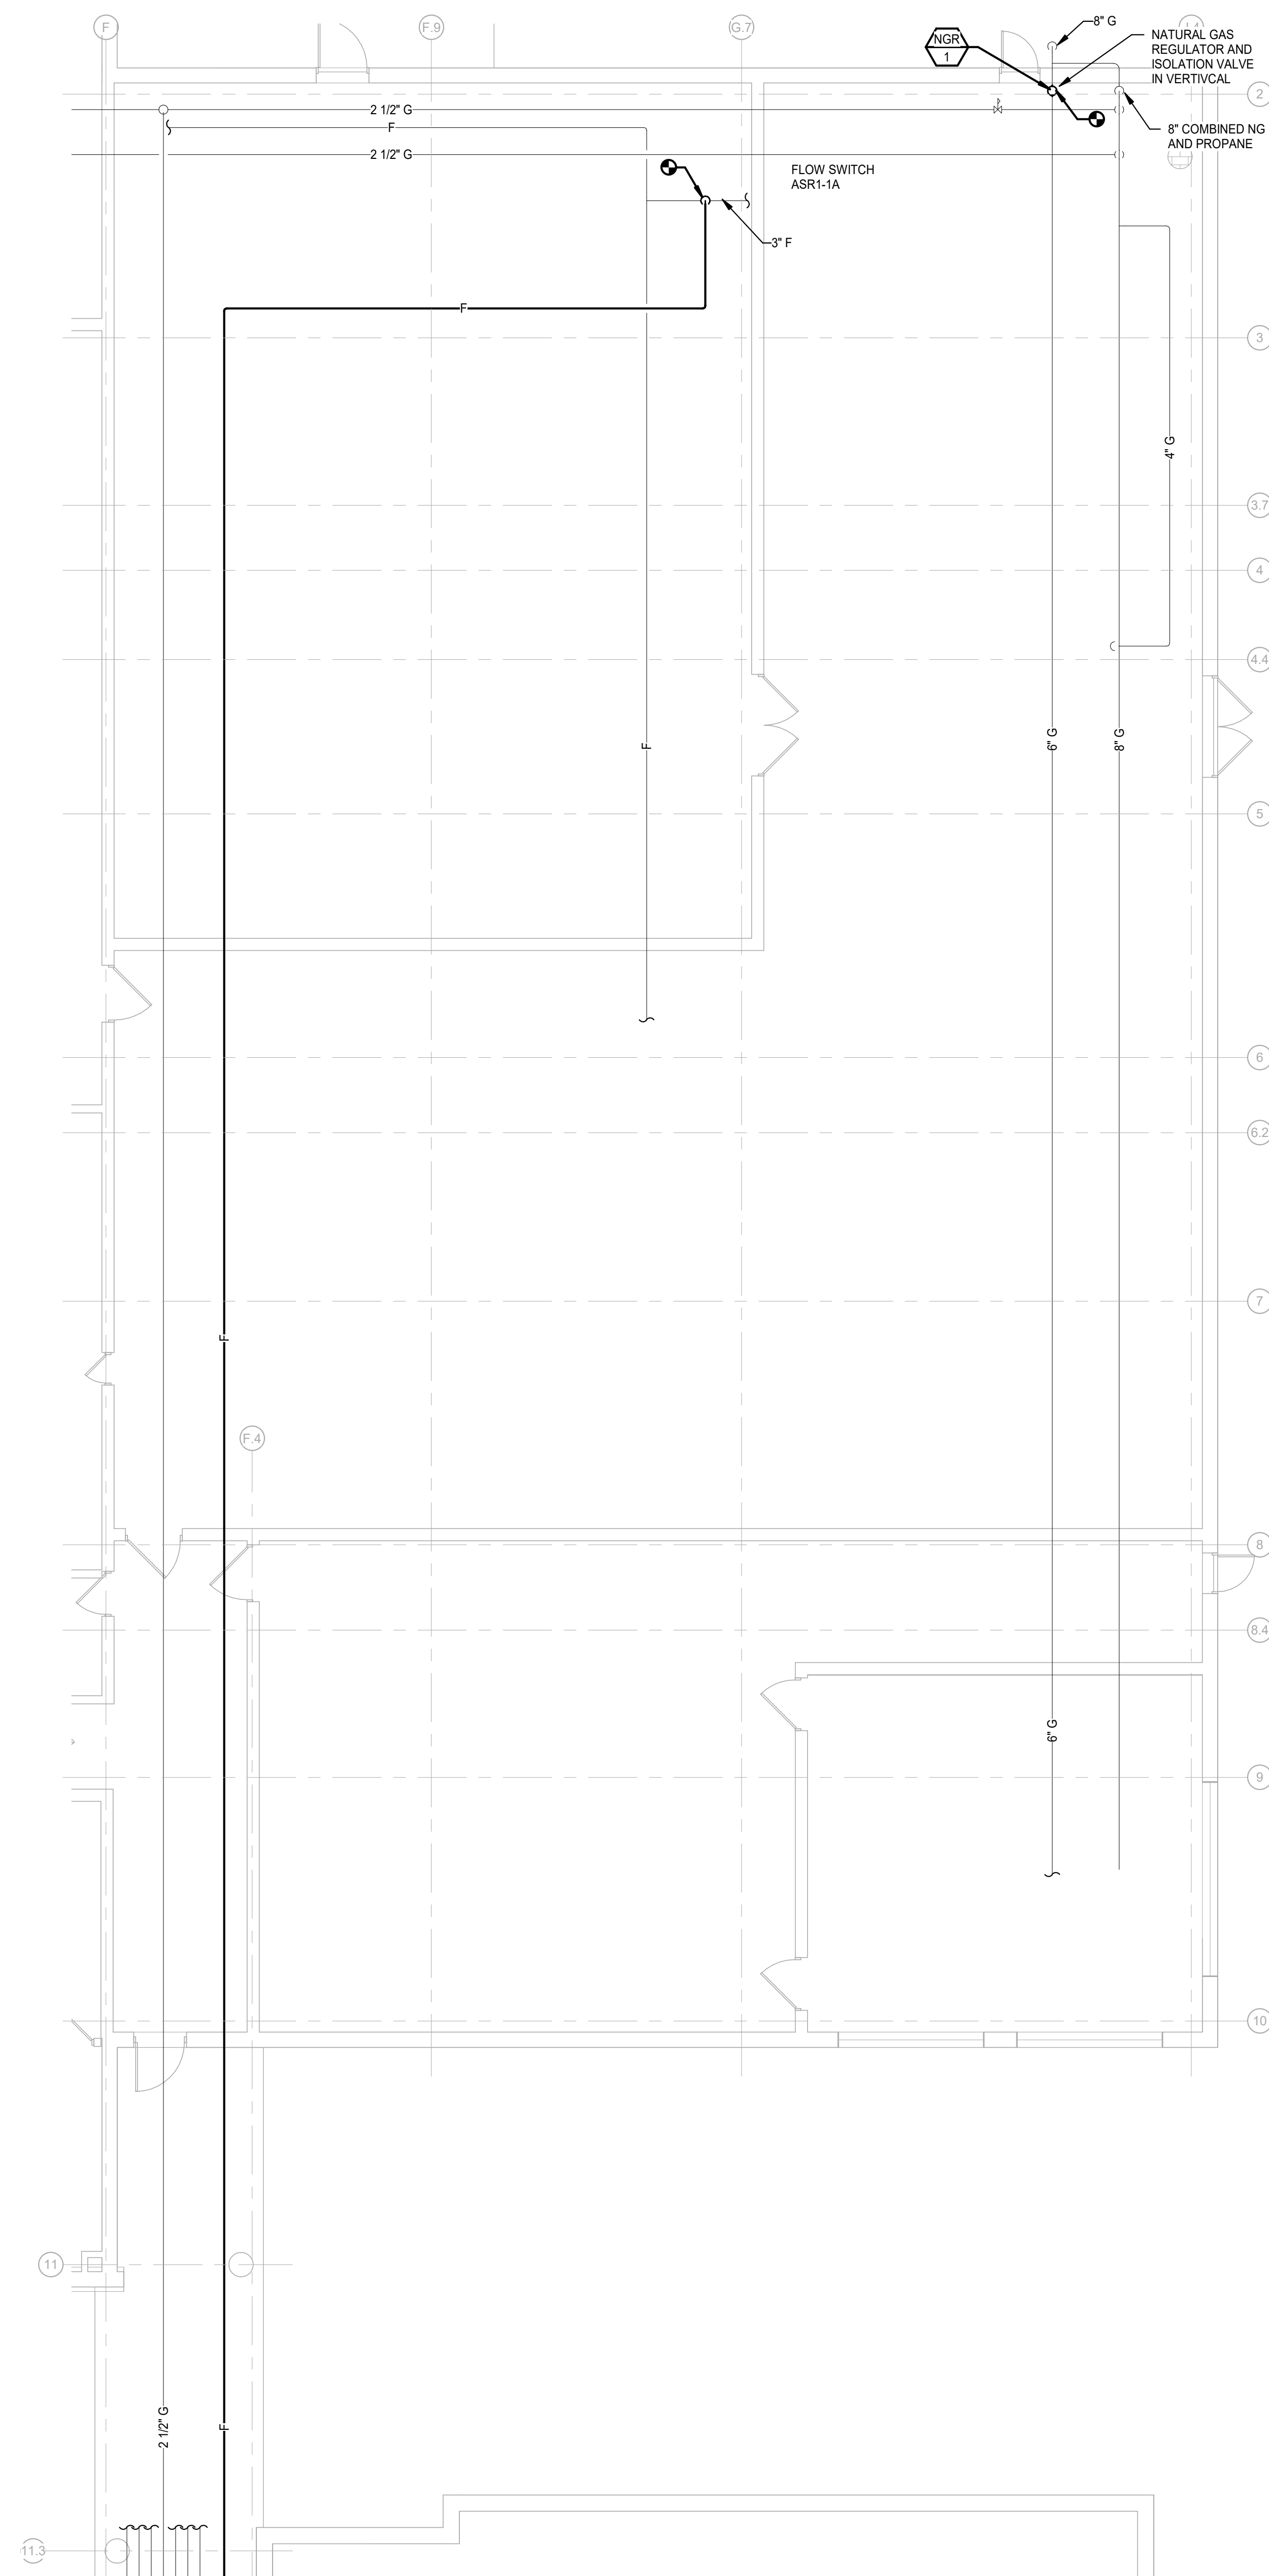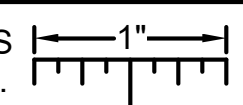

FIRE PROTECTION GENERAL NOTES:

- 1 THESE DRAWINGS ARE DIAGRAMMATIC, AND REPRESENT THE GENERAL INTENT AND ARRANGEMENT OF SYSTEMS. THEY ARE NOT TO BE CONSIDERED FABRICATION/COORDINATION SHOP DRAWINGS. COORDINATION WITH OTHER TRADES IS REQUIRED. PROVIDE THE ADDITIONAL FITTINGS AND OFFSETS THAT WILL BE REQUIRED TO COMPLETE EACH SYSTEM AND TO AVOID INTERFERENCES WITH ALL OTHER SYSTEMS INCLUDING THE STRUCTURE, SHEET METAL, OTHER PIPING SYSTEMS, ELECTRICAL CONDUITS, BUS DUCTS, CABLE TRAY, LIGHT FIXTURES, ETC. AND/OR OTHER SPACE CONSTRAINTS.
- 2 INSTALL SYSTEMS SUCH THAT REQUIRED CLEARANCE AND SERVICE ACCESS SPACE IS PROVIDED AROUND ALL MECHANICAL AND ELECTRICAL EQUIPMENT, AND AROUND ANY COMPONENTS WHICH REQUIRE SERVICE ACCESS.
- 3 NO SPRINKLER PIPING SHALL BE ROUTED THROUGH ELECTRICAL EQUIPMENT ROOMS, TELECOMMUNICATION EQUIPMENT ROOMS, ELEVATOR EQUIPMENT ROOMS OR SIMILAR ROOMS. ONLY SPRINKLER PIPING SERVING SPRINKLER HEADS IN THOSE ROOMS SHALL BE ALLOWED.
- 4 PIPING SHALL NOT BE INSTALLED ABOVE ELECTRICAL TRANSFORMERS, SWITCHBOARDS, PANELBOARDS OR MOTOR CONTROL CENTERS.
- 5 MINIMUM RUN-OUT PIPE SIZE TO SPRINKLER HEADS SHALL BE 1\"/>

PLUMBING GENERAL NOTES:

- 1 THESE DRAWINGS ARE DIAGRAMMATIC, AND REPRESENT THE GENERAL INTENT AND ARRANGEMENT OF SYSTEMS. THEY ARE NOT TO BE CONSIDERED FABRICATION/COORDINATION SHOP DRAWINGS. COORDINATION WITH OTHER TRADES IS REQUIRED. PROVIDE THE ADDITIONAL FITTINGS AND OFFSETS THAT WILL BE REQUIRED TO COMPLETE EACH SYSTEM AND TO AVOID INTERFERENCES WITH ALL OTHER SYSTEMS INCLUDING THE STRUCTURE, SHEET METAL, OTHER PIPING SYSTEMS, ELECTRICAL CONDUITS, BUS DUCTS, CABLE TRAY, LIGHT FIXTURES, ETC. AND/OR OTHER SPACE CONSTRAINTS.
- 2 INSTALL SYSTEMS SUCH THAT REQUIRED CLEARANCE AND SERVICE ACCESS SPACE IS PROVIDED AROUND ALL MECHANICAL AND ELECTRICAL EQUIPMENT, AND AROUND ANY COMPONENTS WHICH REQUIRE SERVICE ACCESS.
- 3 PIPING SHALL NOT BE INSTALLED ABOVE ELECTRICAL TRANSFORMERS, SWITCHBOARDS, PANELBOARDS OR MOTOR CONTROL CENTERS.
- 4 COORDINATE AND PROVIDE ACCESS DOORS WITHIN INACCESSIBLE CEILING, SHAFT, AND CHASE AREAS FOR ALL COMPONENTS WHICH REQUIRE SERVICE ACCESS. REFER TO ARCHITECTURAL DRAWINGS FOR CEILING TYPES.
- 5 PROVIDE SUPPLEMENTARY STEEL AS REQUIRED FOR THE PROPER SUPPORT OF ALL SYSTEMS.
- 6 REFER TO ARCHITECTURAL PLANS FOR DIMENSIONED LOCATIONS OF PLUMBING FIXTURES.
- 7 HOT AND COLD WATER PIPING RUN-OUTS TO LAVATORIES AND SINKS SHALL BE 1/2\"/>

CONSTRUCTION KEY NOTES:

- 1 3 SAN TO LAV/SINK.
- 2 3 SAN TO FLOOR DRAIN/SINK.
- 3 3 G SAN TO SINK.
- 4 4 SAN TO WC.
- 5 4 G SAN TO FLOOR TROUGH.
- 6 3 SAN TO FLOOR TROUGH.
- 7 1/2 CW TO DRAIN COOLER.
- 8 4 SAN TO FLOOR TROUGH.
- 9 4 SAN TO FLOOR DRAIN/SINK.
- 10 ROUTE IN CEILING SPACE OF GYM. ROUTE ALONG SIDE NEW MECHANICAL PIPING. COORDINATE FINAL ROUTING WITH MECHANICAL TRADES.
- 11 PIPING IN THIS AREA ROUTED WITHIN SECOND FLOOR CEILING SPACE.


NO.	REVISION	DATE

STATE OF MICHIGAN
DEPARTMENT OF TECHNOLOGY, MANAGEMENT AND BUDGET
FACILITIES AND BUSINESS SERVICES ADMINISTRATION
DESIGN AND CONSTRUCTION DIVISION
ADAM LACH, RA, DIRECTOR

FILE NO.
491/20167.SDW

FUNDING CODE
171CODHHS7255

CONTRACT NO.
Y22003

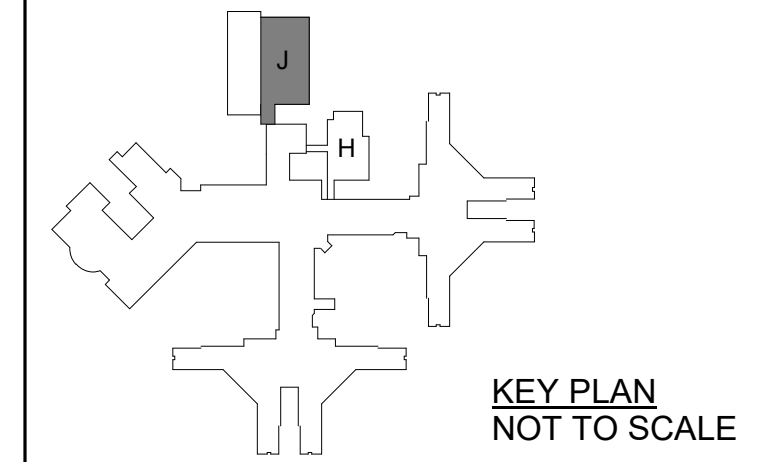

WTA ARCHITECTS

100 S. Jefferson Ave, Suite 601
Saginaw, Michigan 48607
989 752 8107

WTAARCH.COM

COPYRIGHT © 2023

PROJECT TITLE
491/20167.SDW - PHASE 500:
CENTER FOR FORENSIC PSYCHIATRY - CREATE KITCHEN
SALINE, MICHIGAN

SHEET TITLE
FIRST FLOOR PLUMBING AND FIRE PROTECTION PLAN - UNIT J


PROJECT NUMBER 2021094	SHEET NUMBER M2.02
PROJECT DATE SEPTEMBER 6, 2023	CHECKED BY WEK

PBA
Peter Basso Associates Inc
CONSULTING ENGINEERS
5145 Livernois, Suite 100
Troy, Michigan 48068-3276
Tel: 248-879-5666
Fax: 248-879-0007
www.PeterBassoAssociates.com
PBA Project No. 303-0402


FIRST FLOOR PLUMBING AND FIRE PROTECTION PLAN - UNIT J
SCALE: 1/8" = 1'-0"

MECHANICAL
These documents are approved for compliance with the STATE OF MICHIGAN MECHANICAL CODE subject to field inspection and the conditions of approval.

THE FOLLOWING DIMENSION EQUALS ONE INCH WHEN PRINTED TO SCALE.

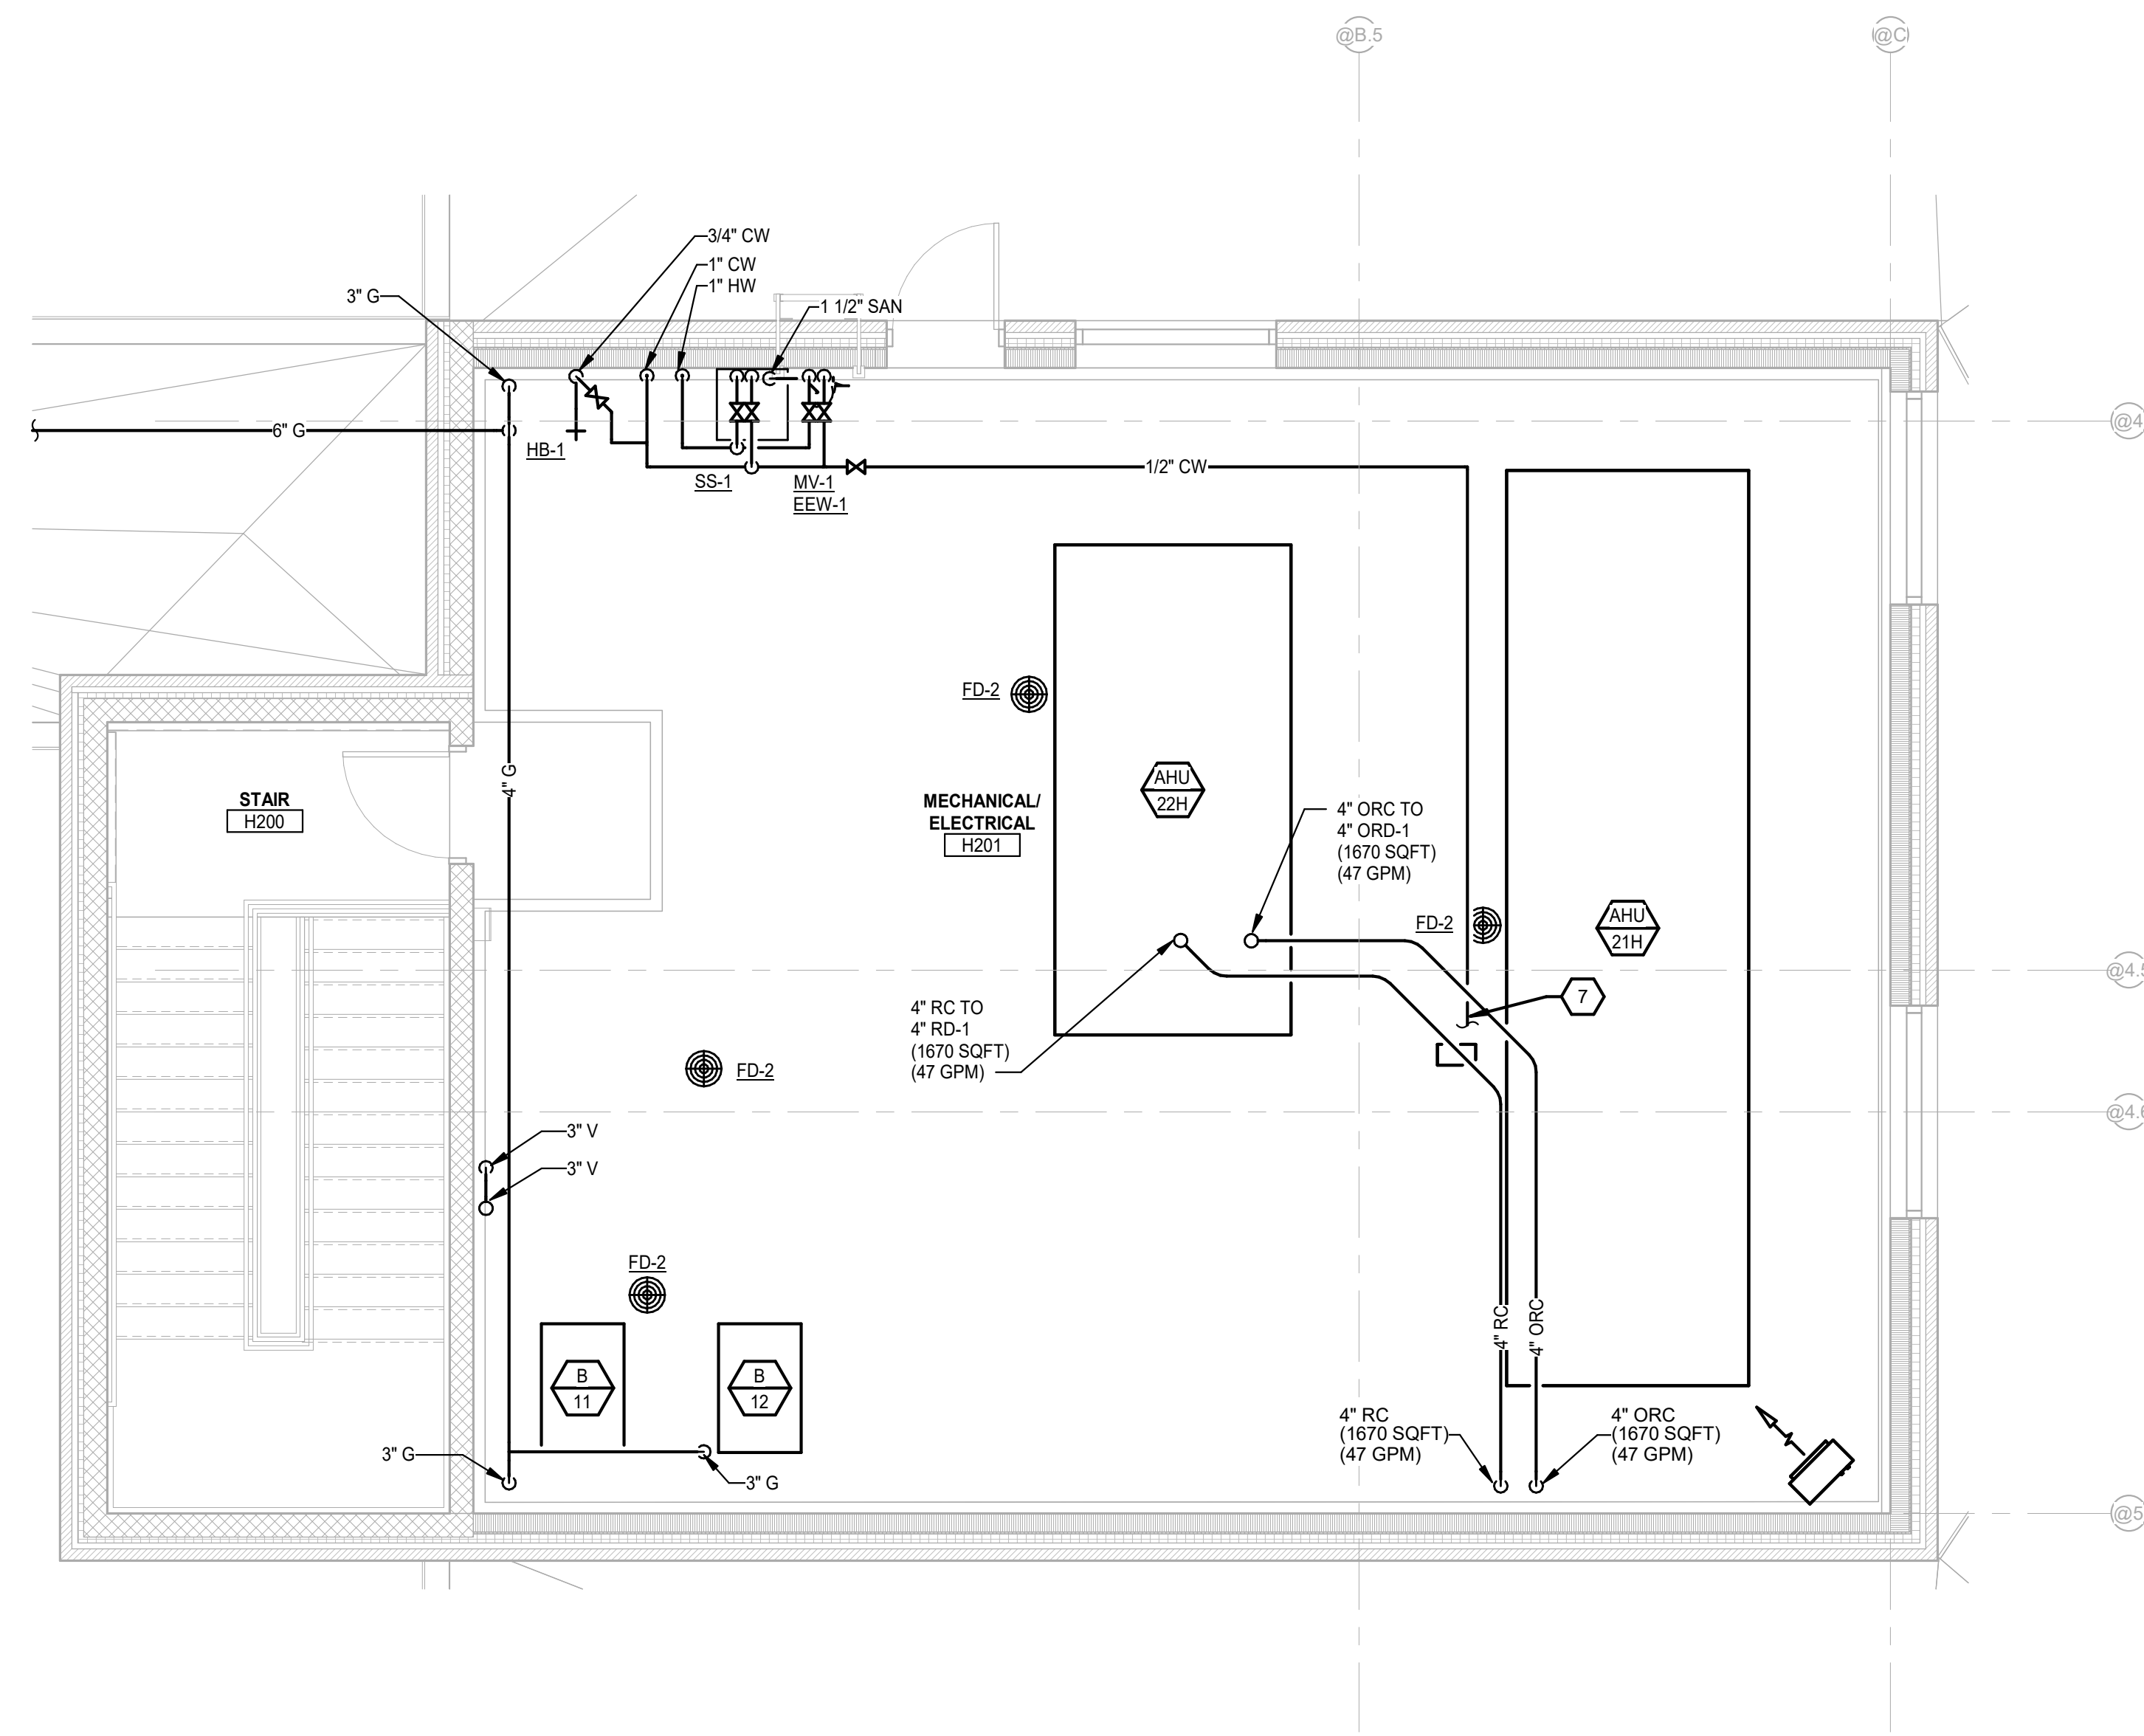

PENTHOUSE PLUMBING PLAN
SCALE: 1/4" = 1'-0"

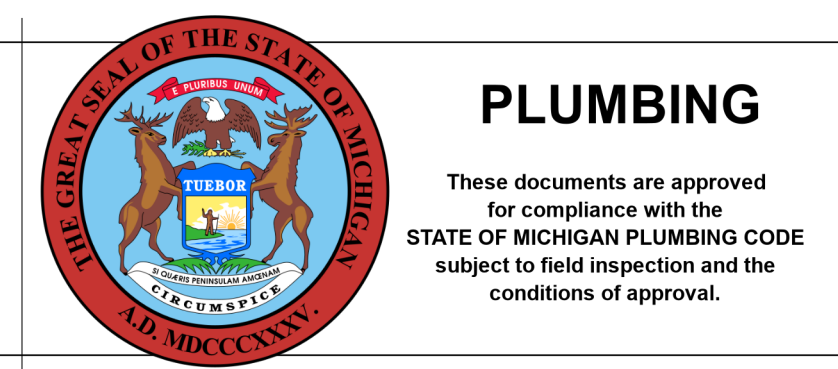

PLUMBING

These documents are approved for compliance with the STATE OF MICHIGAN PLUMBING CODE subject to field inspection and the conditions of approval.

FIRE PROTECTION GENERAL NOTES:

- THESE DRAWINGS ARE DIAGRAMMATIC, AND REPRESENT THE GENERAL INTENT AND ARRANGEMENT OF SYSTEMS. THEY ARE NOT TO BE CONSIDERED FABRICATION/COORDINATION/SHOP DRAWINGS. COORDINATION WITH OTHER TRADES IS REQUIRED. PROVIDE THE ADDITIONAL FITTINGS AND OFFSETS THAT WILL BE REQUIRED TO COMPLETE EACH SYSTEM AND TO AVOID INTERFERENCES WITH ALL OTHER SYSTEMS INCLUDING THE STRUCTURE, SHEET METAL, OTHER PIPING SYSTEMS, ELECTRICAL CONDUITS, BUS DUCTS, CABLE TRAY, LIGHT FIXTURES, ETC. AND/OR OTHER SPACE CONSTRAINTS.
- INSTALL SYSTEMS SUCH THAT REQUIRED CLEARANCE AND SERVICE ACCESS SPACE IS PROVIDED AROUND ALL MECHANICAL AND ELECTRICAL EQUIPMENT, AND AROUND ANY COMPONENTS WHICH REQUIRE SERVICE ACCESS.
- NO SPRINKLER PIPING SHALL BE ROUTED THROUGH ELECTRICAL EQUIPMENT ROOMS, TELECOMMUNICATION EQUIPMENT ROOMS, ELEVATOR EQUIPMENT ROOMS OR SIMILAR ROOMS. ONLY SPRINKLER PIPING SERVING SPRINKLER HEADS IN THOSE ROOMS SHALL BE ALLOWED.
- PIPING SHALL NOT BE INSTALLED ABOVE ELECTRICAL TRANSFORMERS, SWITCHBOARDS, PANELBOARDS OR MOTOR CONTROL CENTERS.
- MINIMUM RUN-OUT PIPE SIZE TO SPRINKLER HEADS SHALL BE 1".
- PROVIDE AN AUTOMATIC WET PIPE SPRINKLER SYSTEM IN ACCORDANCE WITH NFPA 13 <<<LIGHT HAZARD>> CLASSIFICATION. HYDRAULIC CALCULATIONS SHALL BE BASED ON DENSITY OF <<<0.10>> GPM/SQ FT. OVER THE MOST REMOTE <<<1500>> SQ. FT.
- ACCORDING TO THE MOST RECENT FLOW TEST INFORMATION, THE STATIC PRESSURE AVAILABLE AT THE CITY WATER MAIN AT THE STREET IS <<<90>> PSIG. RESIDUAL PRESSURE WITH <<<XXX>> GPM FLOWING IS <<<XX>> PSIG. CONTRACTOR SHALL MAKE HIS OWN PRESSURE AND FLOW TEST PRIOR TO SYSTEM DESIGN.
- FIRE PROTECTION WATER SERVICE ENTRANCE PIPING SHALL BE BURIED WITH DEPTH OF COVER OVER TOP OF PIPE OF AT LEAST <<<72">>, OR WITH TOP OF PIPE AT LEAST 12" BELOW LEVEL OF MAXIMUM FROST PENETRATION, OR AS REQUIRED BY AUTHORITIES HAVING JURISDICTION, WHICHEVER IS DEEPEST.

PLUMBING GENERAL NOTES:

- THESE DRAWINGS ARE DIAGRAMMATIC, AND REPRESENT THE GENERAL INTENT AND ARRANGEMENT OF SYSTEMS. THEY ARE NOT TO BE CONSIDERED FABRICATION/COORDINATION/SHOP DRAWINGS. COORDINATION WITH OTHER TRADES IS REQUIRED. PROVIDE THE ADDITIONAL FITTINGS AND OFFSETS THAT WILL BE REQUIRED TO COMPLETE EACH SYSTEM AND TO AVOID INTERFERENCES WITH ALL OTHER SYSTEMS INCLUDING THE STRUCTURE, SHEET METAL, OTHER PIPING SYSTEMS, ELECTRICAL CONDUITS, BUS DUCTS, CABLE TRAY, LIGHT FIXTURES, ETC. AND/OR OTHER SPACE CONSTRAINTS.
- INSTALL SYSTEMS SUCH THAT REQUIRED CLEARANCE AND SERVICE ACCESS SPACE IS PROVIDED AROUND ALL MECHANICAL AND ELECTRICAL EQUIPMENT, AND AROUND ANY COMPONENTS WHICH REQUIRE SERVICE ACCESS.
- PIPING SHALL NOT BE INSTALLED ABOVE ELECTRICAL TRANSFORMERS, SWITCHBOARDS, PANELBOARDS OR MOTOR CONTROL CENTERS.
- COORDINATE AND PROVIDE ACCESS DOORS WITHIN INACCESSIBLE CEILING, SHAFT, AND CHASE AREAS FOR ALL COMPONENTS WHICH REQUIRE SERVICE ACCESS. REFER TO ARCHITECTURAL DRAWINGS FOR CEILING TYPES.
- PROVIDE SUPPLEMENTARY STEEL AS REQUIRED FOR THE PROPER SUPPORT OF ALL SYSTEMS.
- REFER TO ARCHITECTURAL PLANS FOR DIMENSIONED LOCATIONS OF PLUMBING FIXTURES.
- HOT AND COLD WATER PIPING RUN-OUTS TO LAVATORIES AND SINKS SHALL BE 1/2" UNLESS OTHERWISE NOTED.
- PLUMBING VENT PIPING THROUGH ROOF SHALL BE LOCATED A MINIMUM OF 10'-0" FROM ANY FRESH AIR INTAKE LOCATION AND A MINIMUM OF 18" CLEAR FROM THE INSIDE FACE OF PARAPET.
- PROVIDE CODE REQUIRED CLEARANCE FOR ALL CLEANOUTS INSTALLED IN SANITARY WASTE AND VENT PIPING.
- MINIMUM UNDERGROUND PIPE SIZE SHALL BE 3".

CONSTRUCTION KEY NOTES:

- 3 SAN TO LAV/SINK.
- 3 SAN TO FLOOR DRAIN/SINK.
- 3 G SAN TO SINK.
- 4 SAN TO WC.
- 4 G SAN TO FLOOR TROUGH.
- 3 SAN TO FLOOR TROUGH.
- 1/2 CW TO DRAIN COOLER.
- 4 SAN TO FLOOR TROUGH.
- 4 SAN TO FLOOR DRAIN/SINK.
- ROUTE IN CEILING SPACE OF GYM. ROUTE ALONG SIDE NEW MECHANICAL PIPING. COORDINATE FINAL ROUTING WITH MECHANICAL TRADES.
- PIPING IN THIS AREA ROUTED WITHIN SECOND FLOOR CEILING SPACE.


NO.	REVISION	DATE

STATE OF MICHIGAN
DEPARTMENT OF TECHNOLOGY, MANAGEMENT AND BUDGET
FACILITIES AND BUSINESS SERVICES ADMINISTRATION
DESIGN AND CONSTRUCTION DIVISION
ADAM LACH, R.A. DIRECTOR

FILE NO.
491/20167.SDW

FUNDING CODE
171CODHHS7255

CONTRACT NO.
Y22003

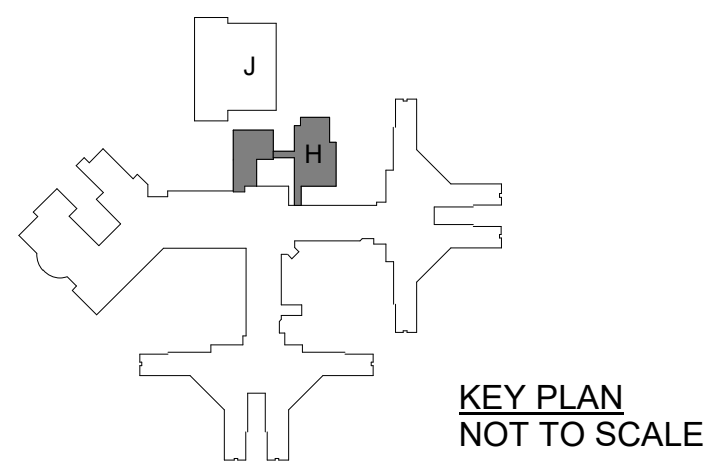


WTA ARCHITECTS
100 S. Jefferson Ave., Suite 601
Saginaw, Michigan 48607
989 752 8107
COPYRIGHT © 2023

PROJECT TITLE
491/20167.SDW - PHASE 500:
CENTER FOR FORENSIC PSYCHIATRY - CREATE KITCHEN
SALINE, MICHIGAN

SHEET TITLE
PENTHOUSE PLUMBING PLAN

PROJECT NUMBER 2021094	SHEET NUMBER M2.03
PROJECT DATE SEPTEMBER 6, 2023	CHECKED BY WEK

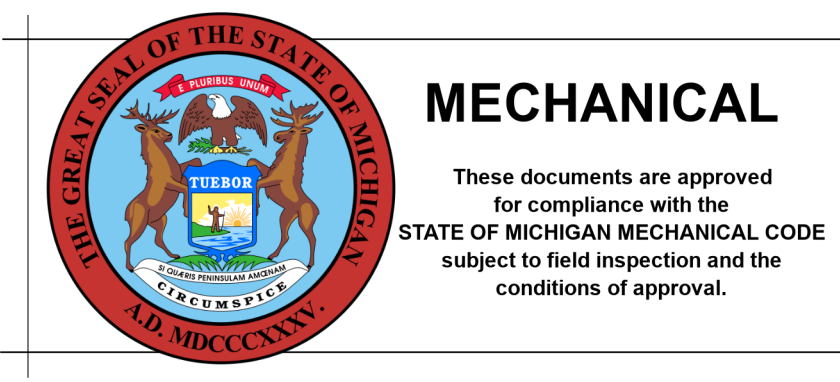


MECHANICAL

These documents are approved for compliance with the STATE OF MICHIGAN MECHANICAL CODE subject to field inspection and the conditions of approval.


PBA
Peter Basso Associates Inc
CONSULTING ENGINEERS
5145 Livernois, Suite 100
Troy, Michigan 48068-3276
Tel: 248-879-5666
Fax: 248-879-0007
www.PeterBassoAssociates.com
PBA Project No. 303-0492

THE FOLLOWING DIMENSION EQUALS ONE INCH WHEN PRINTED TO SCALE.

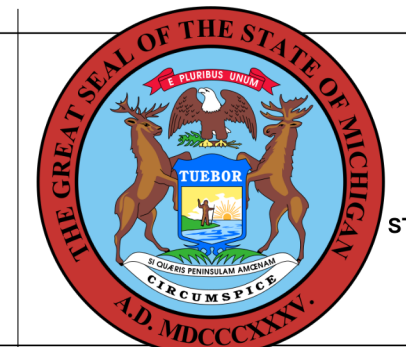

MECHANICAL

These documents are approved for compliance with the STATE OF MICHIGAN MECHANICAL CODE subject to field inspection and the conditions of approval.

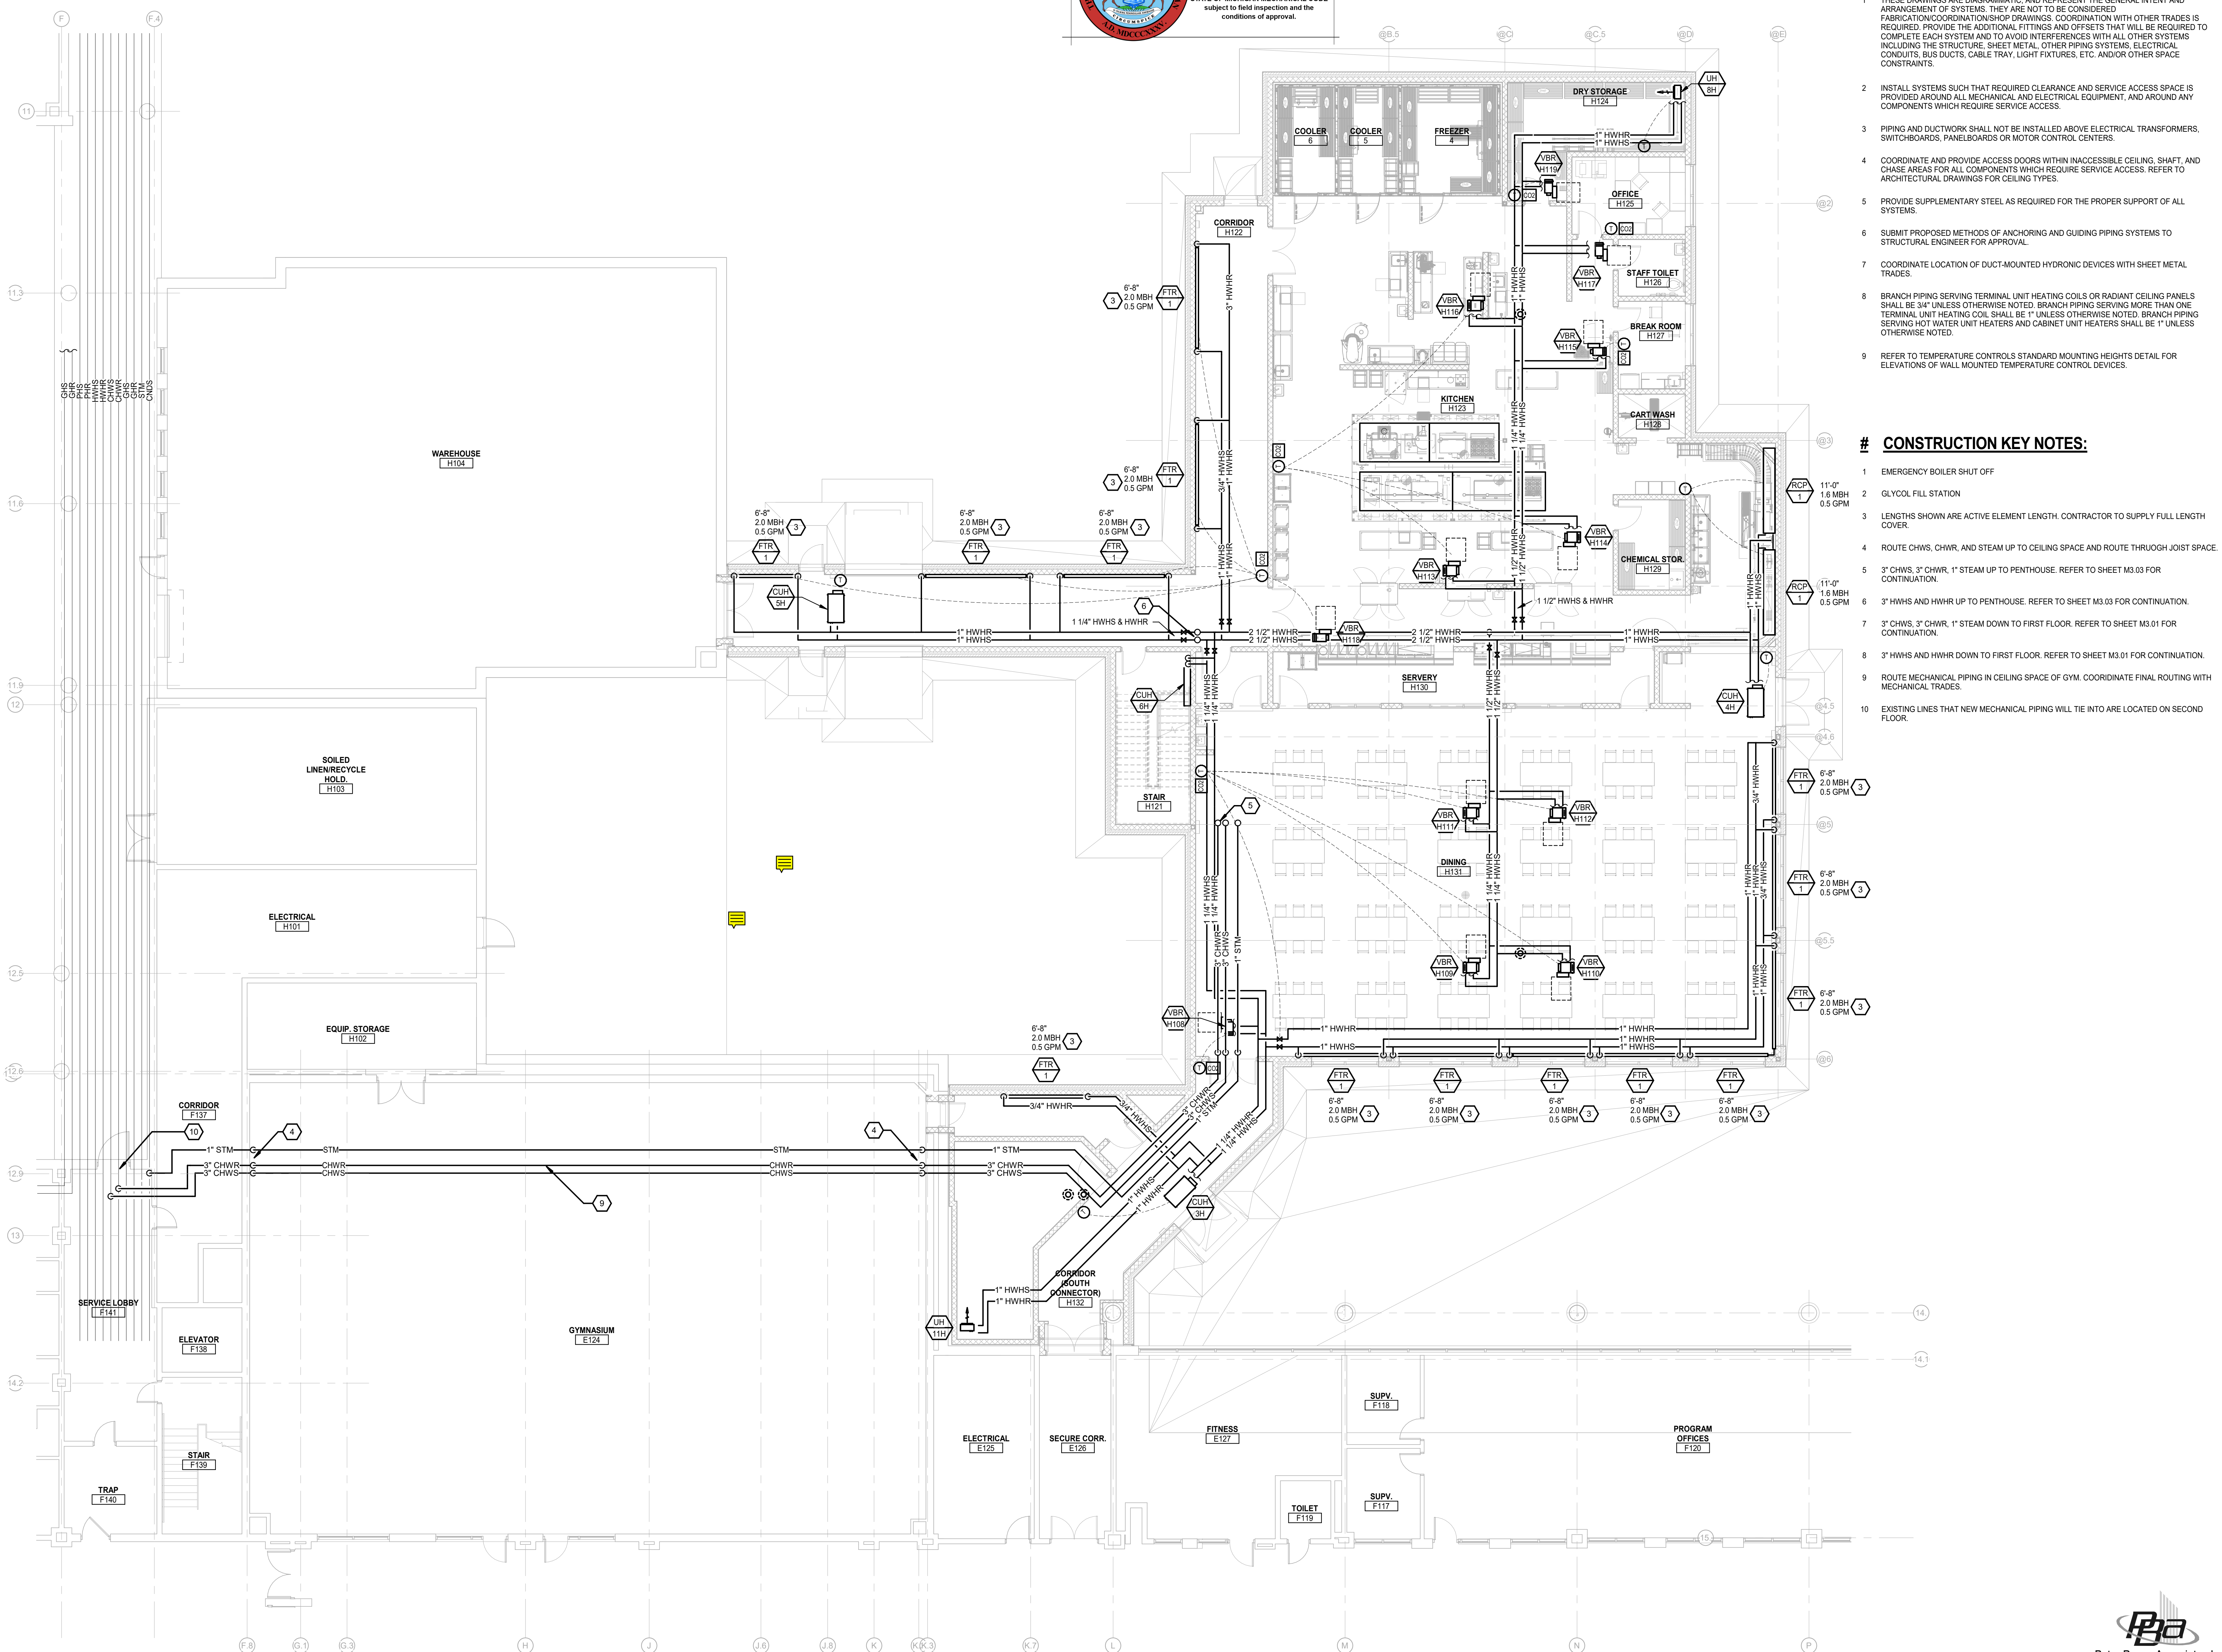

- HVAC PIPING GENERAL NOTES:**
- THESE DRAWINGS ARE DIAGRAMMATIC, AND REPRESENT THE GENERAL INTENT AND ARRANGEMENT OF SYSTEMS. THEY ARE NOT TO BE CONSIDERED FABRICATION/COORDINATION/SHOP DRAWINGS. COORDINATION WITH OTHER TRADES IS REQUIRED. PROVIDE THE ADDITIONAL FITTINGS AND OFFSETS THAT WILL BE REQUIRED TO COMPLETE EACH SYSTEM AND TO AVOID INTERFERENCES WITH ALL OTHER SYSTEMS INCLUDING THE STRUCTURE, SHEET METAL, OTHER PIPING SYSTEMS, ELECTRICAL CONDUITS, BUS DUCTS, CABLE TRAY, LIGHT FIXTURES, ETC. AND/OR OTHER SPACE CONSTRAINTS.
 - INSTALL SYSTEMS SUCH THAT REQUIRED CLEARANCE AND SERVICE ACCESS SPACE IS PROVIDED AROUND ALL MECHANICAL AND ELECTRICAL EQUIPMENT, AND AROUND ANY COMPONENTS WHICH REQUIRE SERVICE ACCESS.
 - PIPING AND DUCTWORK SHALL NOT BE INSTALLED ABOVE ELECTRICAL TRANSFORMERS, SWITCHBOARDS, PANELBOARDS OR MOTOR CONTROL CENTERS.
 - COORDINATE AND PROVIDE ACCESS DOORS WITHIN INACCESSIBLE CEILING, SHAFT, AND CHASE AREAS FOR ALL COMPONENTS WHICH REQUIRE SERVICE ACCESS. REFER TO ARCHITECTURAL DRAWINGS FOR CEILING TYPES.
 - PROVIDE SUPPLEMENTARY STEEL AS REQUIRED FOR THE PROPER SUPPORT OF ALL SYSTEMS.
 - SUBMIT PROPOSED METHODS OF ANCHORING AND GUIDING PIPING SYSTEMS TO STRUCTURAL ENGINEER FOR APPROVAL.
 - COORDINATE LOCATION OF DUCT-MOUNTED HYDRONIC DEVICES WITH SHEET METAL TRADES.
 - BRANCH PIPING SERVING TERMINAL UNIT HEATING COILS OR RADIANT CEILING PANELS SHALL BE 3/4" UNLESS OTHERWISE NOTED. BRANCH PIPING SERVING MORE THAN ONE TERMINAL UNIT HEATING COIL SHALL BE 1" UNLESS OTHERWISE NOTED. BRANCH PIPING SERVING HOT WATER UNIT HEATERS AND CABINET UNIT HEATERS SHALL BE 1" UNLESS OTHERWISE NOTED.
 - REFER TO TEMPERATURE CONTROLS STANDARD MOUNTING HEIGHTS DETAIL FOR ELEVATIONS OF WALL MOUNTED TEMPERATURE CONTROL DEVICES.

- # CONSTRUCTION KEY NOTES:**
- EMERGENCY BOILER SHUT OFF
 - GLYCOL FILL STATION
 - LENGTHS SHOWN ARE ACTIVE ELEMENT LENGTH. CONTRACTOR TO SUPPLY FULL LENGTH COVER.
 - ROUTE CHWS, CHWR, AND STEAM UP TO CEILING SPACE AND ROUTE THROUGH JOIST SPACE.
 - 3" CHWS, 3" CHWR, 1" STEAM UP TO PENTHOUSE. REFER TO SHEET M3.03 FOR CONTINUATION.
 - 3" HWHS AND HWHR UP TO PENTHOUSE. REFER TO SHEET M3.03 FOR CONTINUATION.
 - 3" CHWS, 3" CHWR, 1" STEAM DOWN TO FIRST FLOOR. REFER TO SHEET M3.01 FOR CONTINUATION.
 - 3" HWHS AND HWHR DOWN TO FIRST FLOOR. REFER TO SHEET M3.01 FOR CONTINUATION.
 - ROUTE MECHANICAL PIPING IN CEILING SPACE OF GYM. COORDINATE FINAL ROUTING WITH MECHANICAL TRADES.
 - EXISTING LINES THAT NEW MECHANICAL PIPING WILL TIE INTO ARE LOCATED ON SECOND FLOOR.


NO.	REVISION	DATE

STATE OF MICHIGAN
DEPARTMENT OF TECHNOLOGY, MANAGEMENT AND BUDGET
FACILITIES AND BUSINESS SERVICES ADMINISTRATION
DESIGN AND CONSTRUCTION DIVISION
ADAM LACH, RA, DIRECTOR

FILE NO.
491/20167.SDW

FUNDING CODE
171CODHHS7255

CONTRACT NO.
Y22003

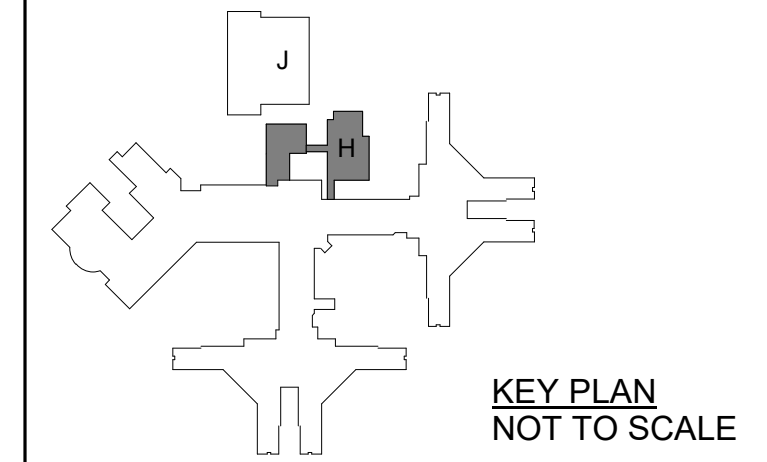

WTAARCH.COM

WTA ARCHITECTS

100 S. Jefferson Ave, Suite 601
Saginaw, Michigan 48607
989 752 8107

COPYRIGHT © 2023

PROJECT TITLE
491/20167.SDW - PHASE 500:
CENTER FOR FORENSIC PSYCHIATRY - CREATE KITCHEN
SALINE, MICHIGAN

SHEET TITLE
FIRST FLOOR HVAC PIPING PLAN - UNIT H

PROJECT NUMBER
2021094

SHEET NUMBER

PROJECT DATE
SEPTEMBER 6, 2023

M3.01

CHECKED BY
WEK


FIRST FLOOR HVAC PIPING PLAN - UNIT H
SCALE: 1/8" = 1'-0"



Peter Basso Associates Inc.
CONSULTING ENGINEERS
5145 Livernois, Suite 100
Troy, Michigan 48068-3276
Tel: 248-879-5666
Fax: 248-879-0007
www.PeterBassoAssociates.com
PBA Project No. 303-0492

9/2/2023 4:37:23 PM C:\REVIT LOCAL FILES\2023-0402-ME2_Forensic_Psyeh_v23_Ghent.rvt

THE FOLLOWING DIMENSION EQUALS ONE INCH WHEN PRINTED TO SCALE.

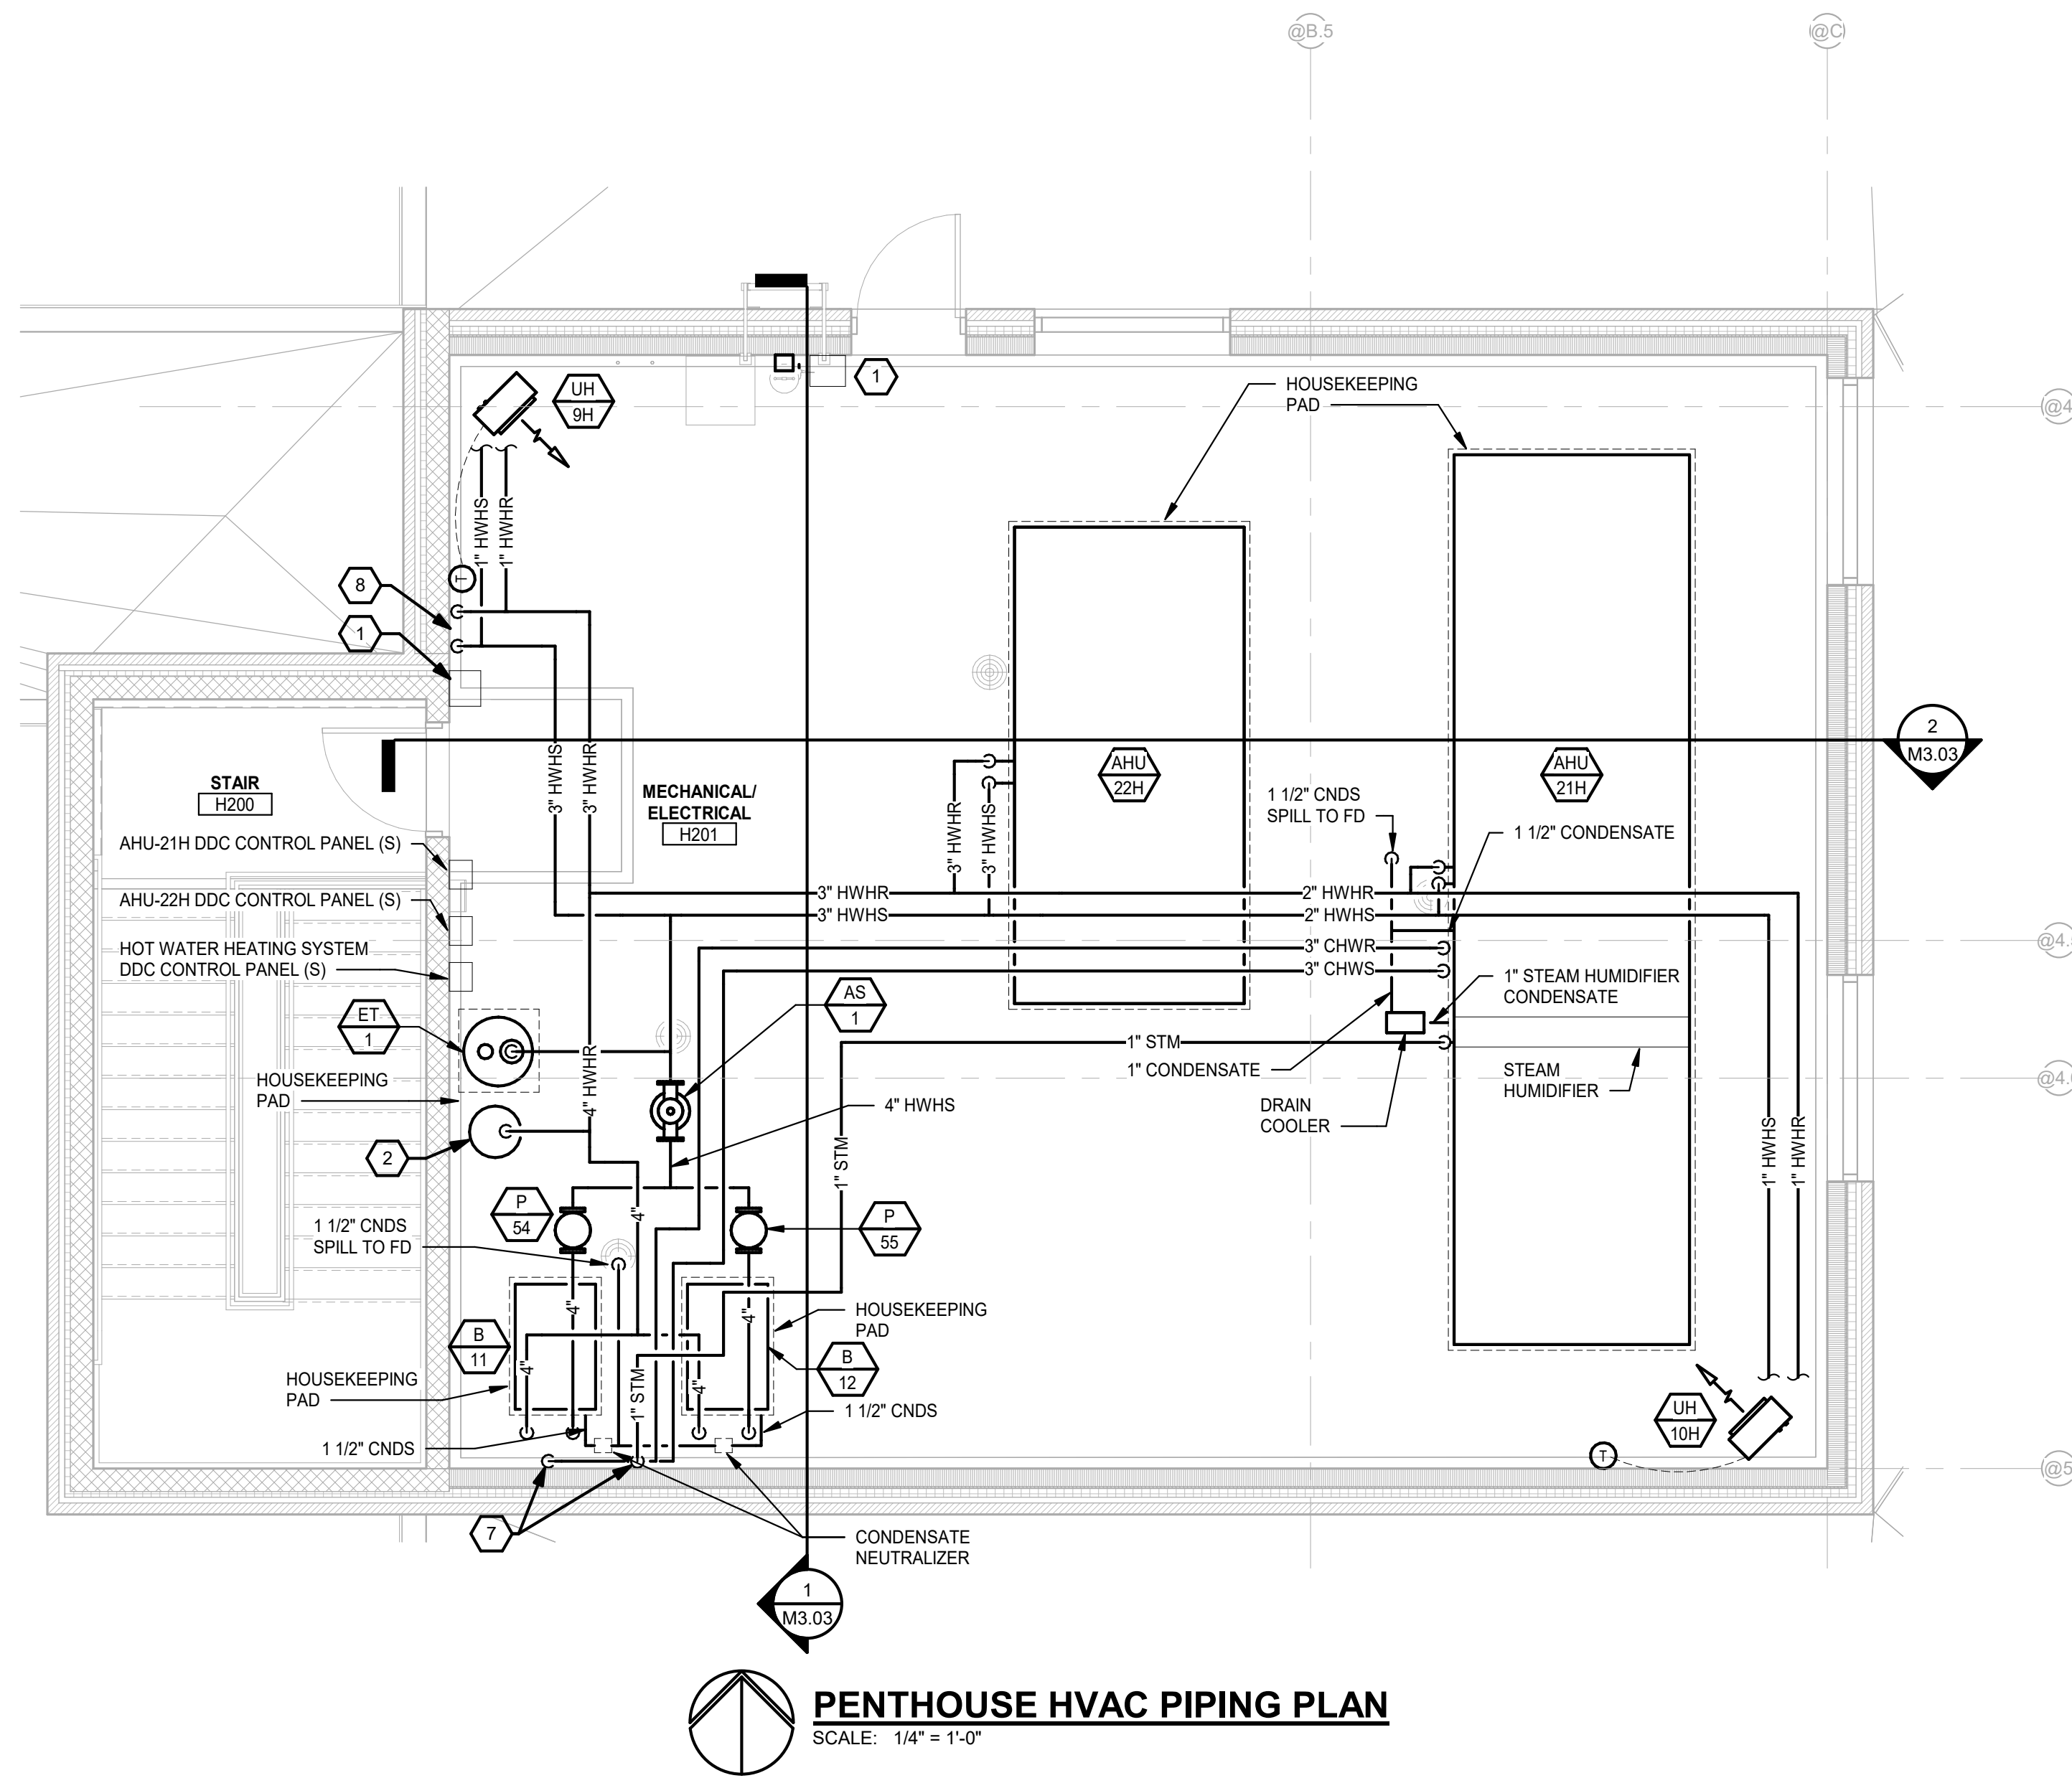



PENTHOUSE HVAC PIPING PLAN
SCALE: 1/4" = 1'-0"

HVAC PIPING GENERAL NOTES:


- THESE DRAWINGS ARE DIAGRAMMATIC, AND REPRESENT THE GENERAL INTENT AND ARRANGEMENT OF SYSTEMS. THEY ARE NOT TO BE CONSIDERED FABRICATION/COORDINATION/SHOP DRAWINGS. COORDINATION WITH OTHER TRADES IS REQUIRED. PROVIDE THE ADDITIONAL FITTINGS AND OFFSETS THAT WILL BE REQUIRED TO COMPLETE EACH SYSTEM AND TO AVOID INTERFERENCES WITH ALL OTHER SYSTEMS INCLUDING THE STRUCTURE, SHEET METAL, OTHER PIPING SYSTEMS, ELECTRICAL CONDUITS, BUS DUCTS, CABLE TRAY, LIGHT FIXTURES, ETC. AND/OR OTHER SPACE CONSTRAINTS.
- INSTALL SYSTEMS SUCH THAT REQUIRED CLEARANCE AND SERVICE ACCESS SPACE IS PROVIDED AROUND ALL MECHANICAL AND ELECTRICAL EQUIPMENT, AND AROUND ANY COMPONENTS WHICH REQUIRE SERVICE ACCESS.
- PIPING AND DUCTWORK SHALL NOT BE INSTALLED ABOVE ELECTRICAL TRANSFORMERS, SWITCHBOARDS, PANELBOARDS OR MOTOR CONTROL CENTERS.
- COORDINATE AND PROVIDE ACCESS DOORS WITHIN INACCESSIBLE CEILING, SHAFT, AND CHASE AREAS FOR ALL COMPONENTS WHICH REQUIRE SERVICE ACCESS. REFER TO ARCHITECTURAL DRAWINGS FOR CEILING TYPES.
- PROVIDE SUPPLEMENTARY STEEL AS REQUIRED FOR THE PROPER SUPPORT OF ALL SYSTEMS.
- SUBMIT PROPOSED METHODS OF ANCHORING AND GUIDING PIPING SYSTEMS TO STRUCTURAL ENGINEER FOR APPROVAL.
- COORDINATE LOCATION OF DUCT-MOUNTED HYDRONIC DEVICES WITH SHEET METAL TRADES.
- BRANCH PIPING SERVING TERMINAL UNIT HEATING COILS OR RADIANT CEILING PANELS SHALL BE 3/4" UNLESS OTHERWISE NOTED. BRANCH PIPING SERVING MORE THAN ONE TERMINAL UNIT HEATING COIL SHALL BE 1" UNLESS OTHERWISE NOTED. BRANCH PIPING SERVING HOT WATER UNIT HEATERS AND CABINET UNIT HEATERS SHALL BE 1" UNLESS OTHERWISE NOTED.
- REFER TO TEMPERATURE CONTROLS STANDARD MOUNTING HEIGHTS DETAIL FOR ELEVATIONS OF WALL MOUNTED TEMPERATURE CONTROL DEVICES.

CONSTRUCTION KEY NOTES:

- EMERGENCY BOILER SHUT OFF
- GLYCOL FILL STATION
- LENGTHS SHOWN ARE ACTIVE ELEMENT LENGTH. CONTRACTOR TO SUPPLY FULL LENGTH COVER.
- ROUTE CHWS, CHWR, AND STEAM UP TO CEILING SPACE AND ROUTE THROUGH JOIST SPACE.
- 3" CHWS, 3" CHWR, 1" STEAM UP TO PENTHOUSE. REFER TO SHEET M3.03 FOR CONTINUATION.
- 3" CHWS AND HWHR UP TO PENTHOUSE. REFER TO SHEET M3.03 FOR CONTINUATION.
- 3" CHWS, 3" CHWR, 1" STEAM DOWN TO FIRST FLOOR. REFER TO SHEET M3.01 FOR CONTINUATION.
- 3" HWHS AND HWHR DOWN TO FIRST FLOOR. REFER TO SHEET M3.01 FOR CONTINUATION.
- ROUTE MECHANICAL PIPING IN CEILING SPACE OF GYM. COORDINATE FINAL ROUTING WITH MECHANICAL TRADES.
- EXISTING LINES THAT NEW MECHANICAL PIPING WILL TIE INTO ARE LOCATED ON SECOND FLOOR.

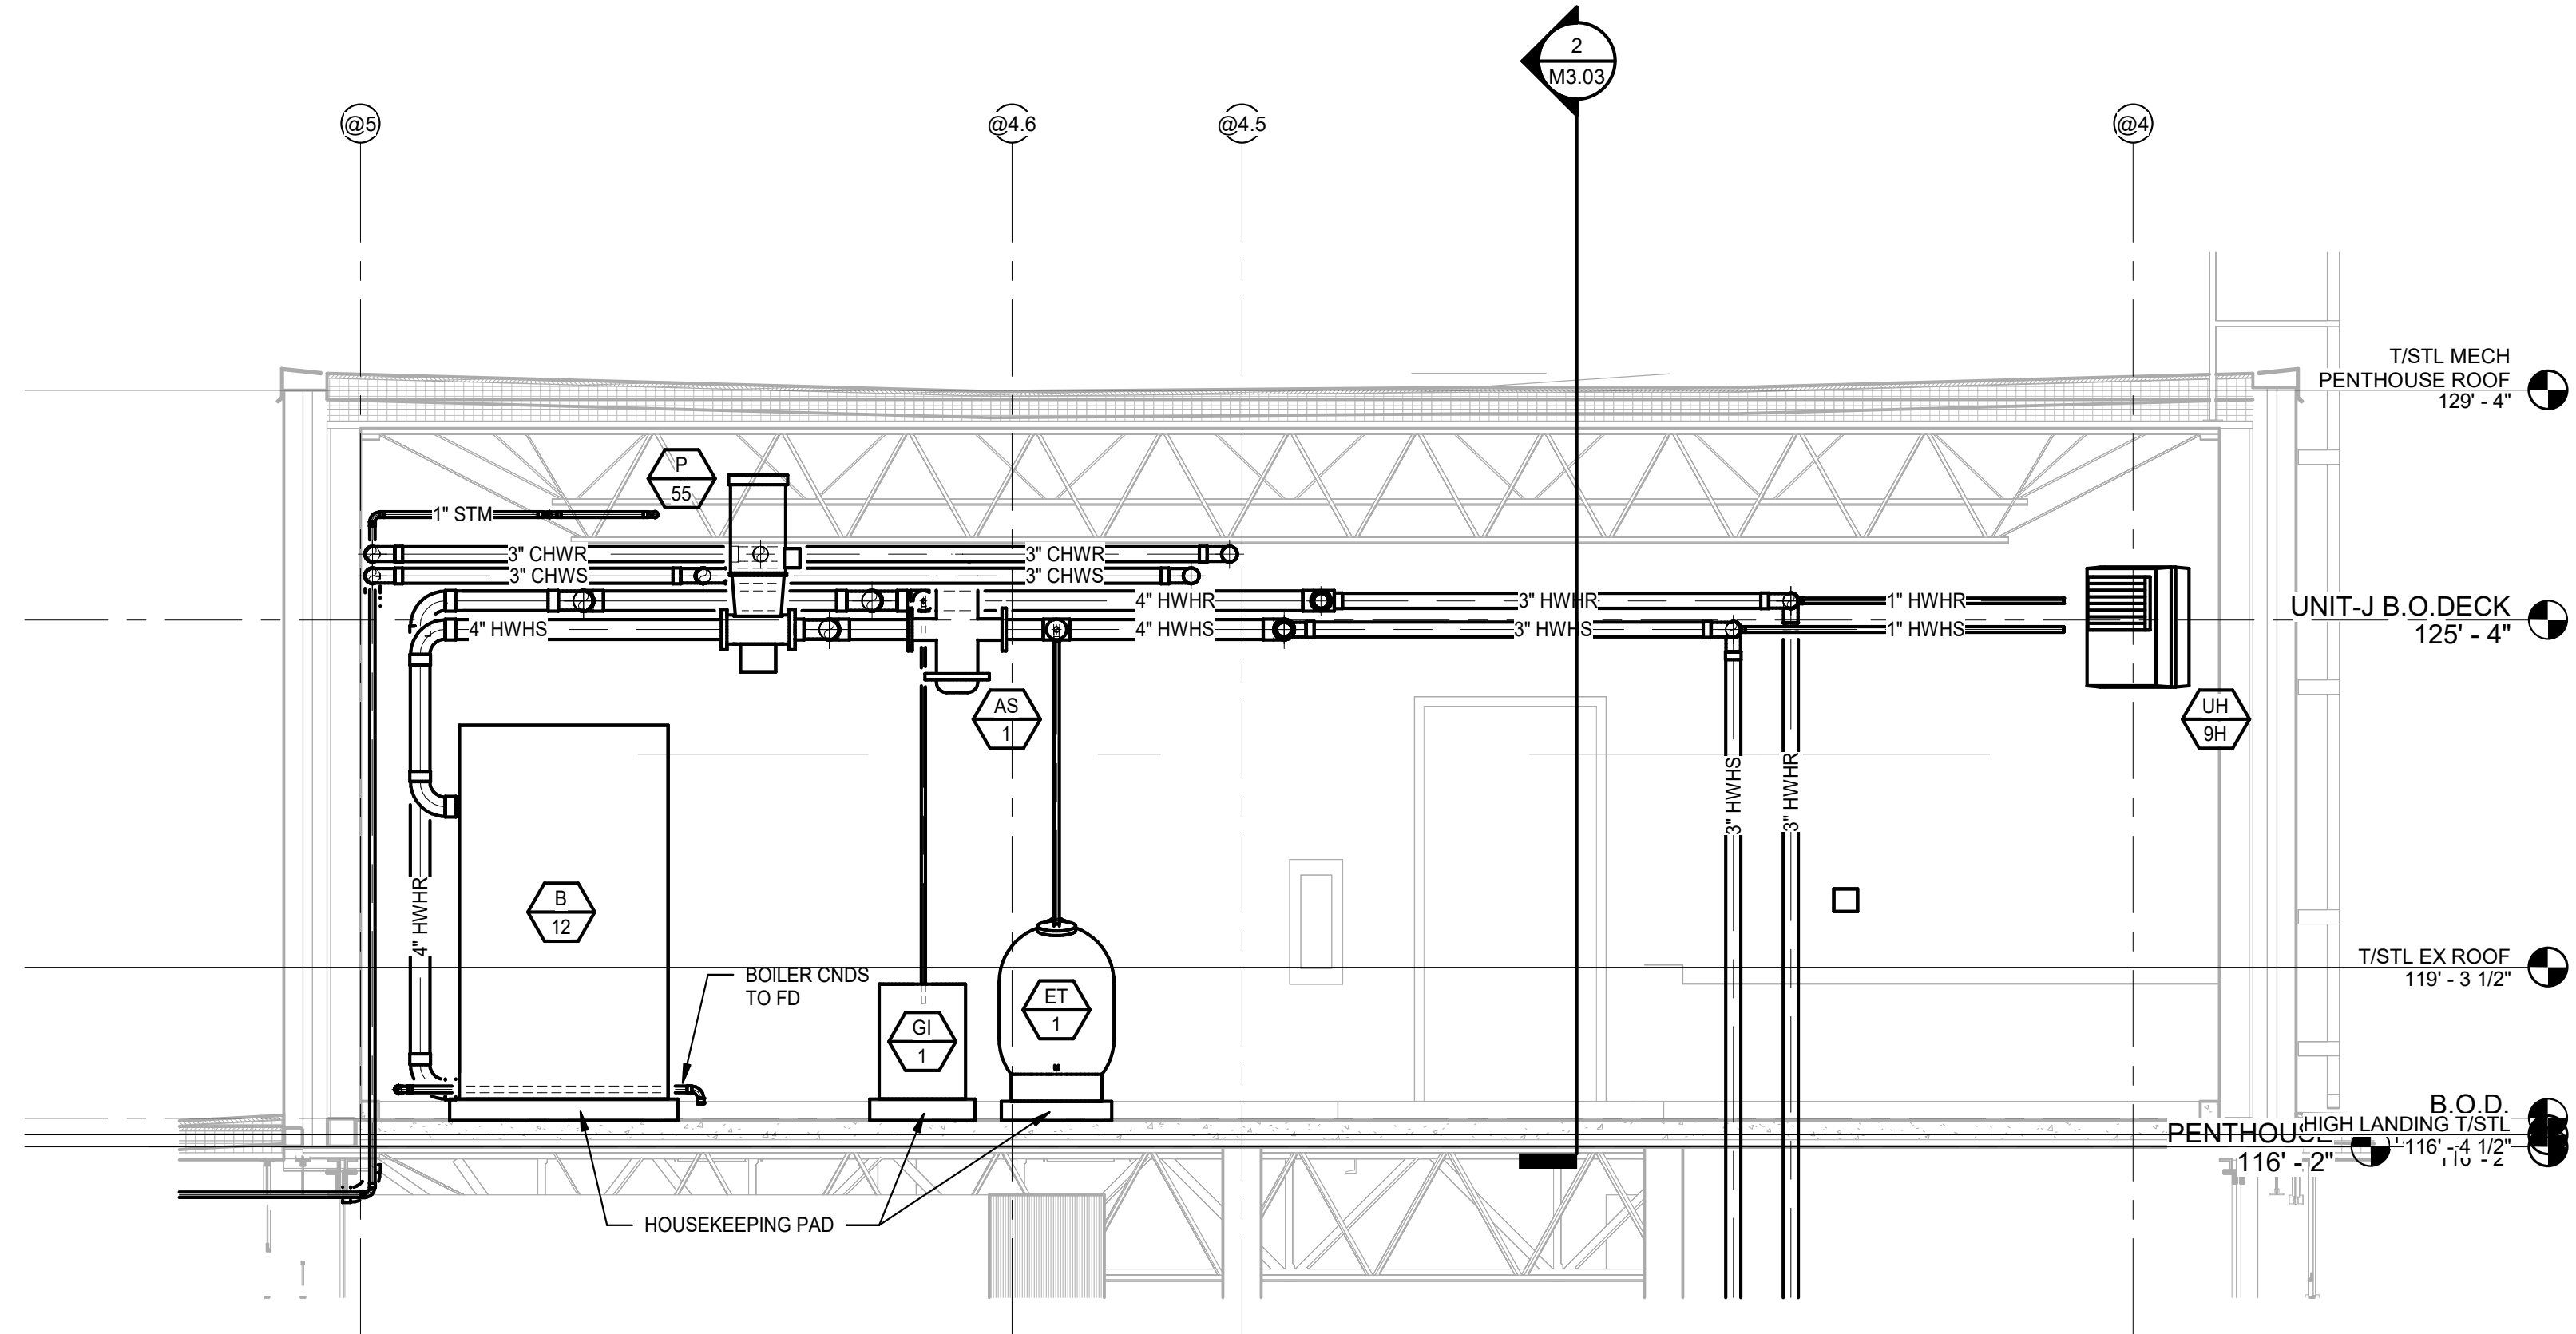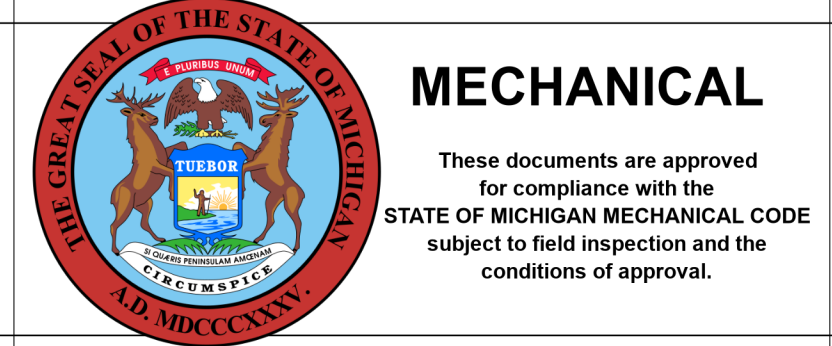

1 HVAC PIPING 1
SCALE: 3/8" = 1'-0"

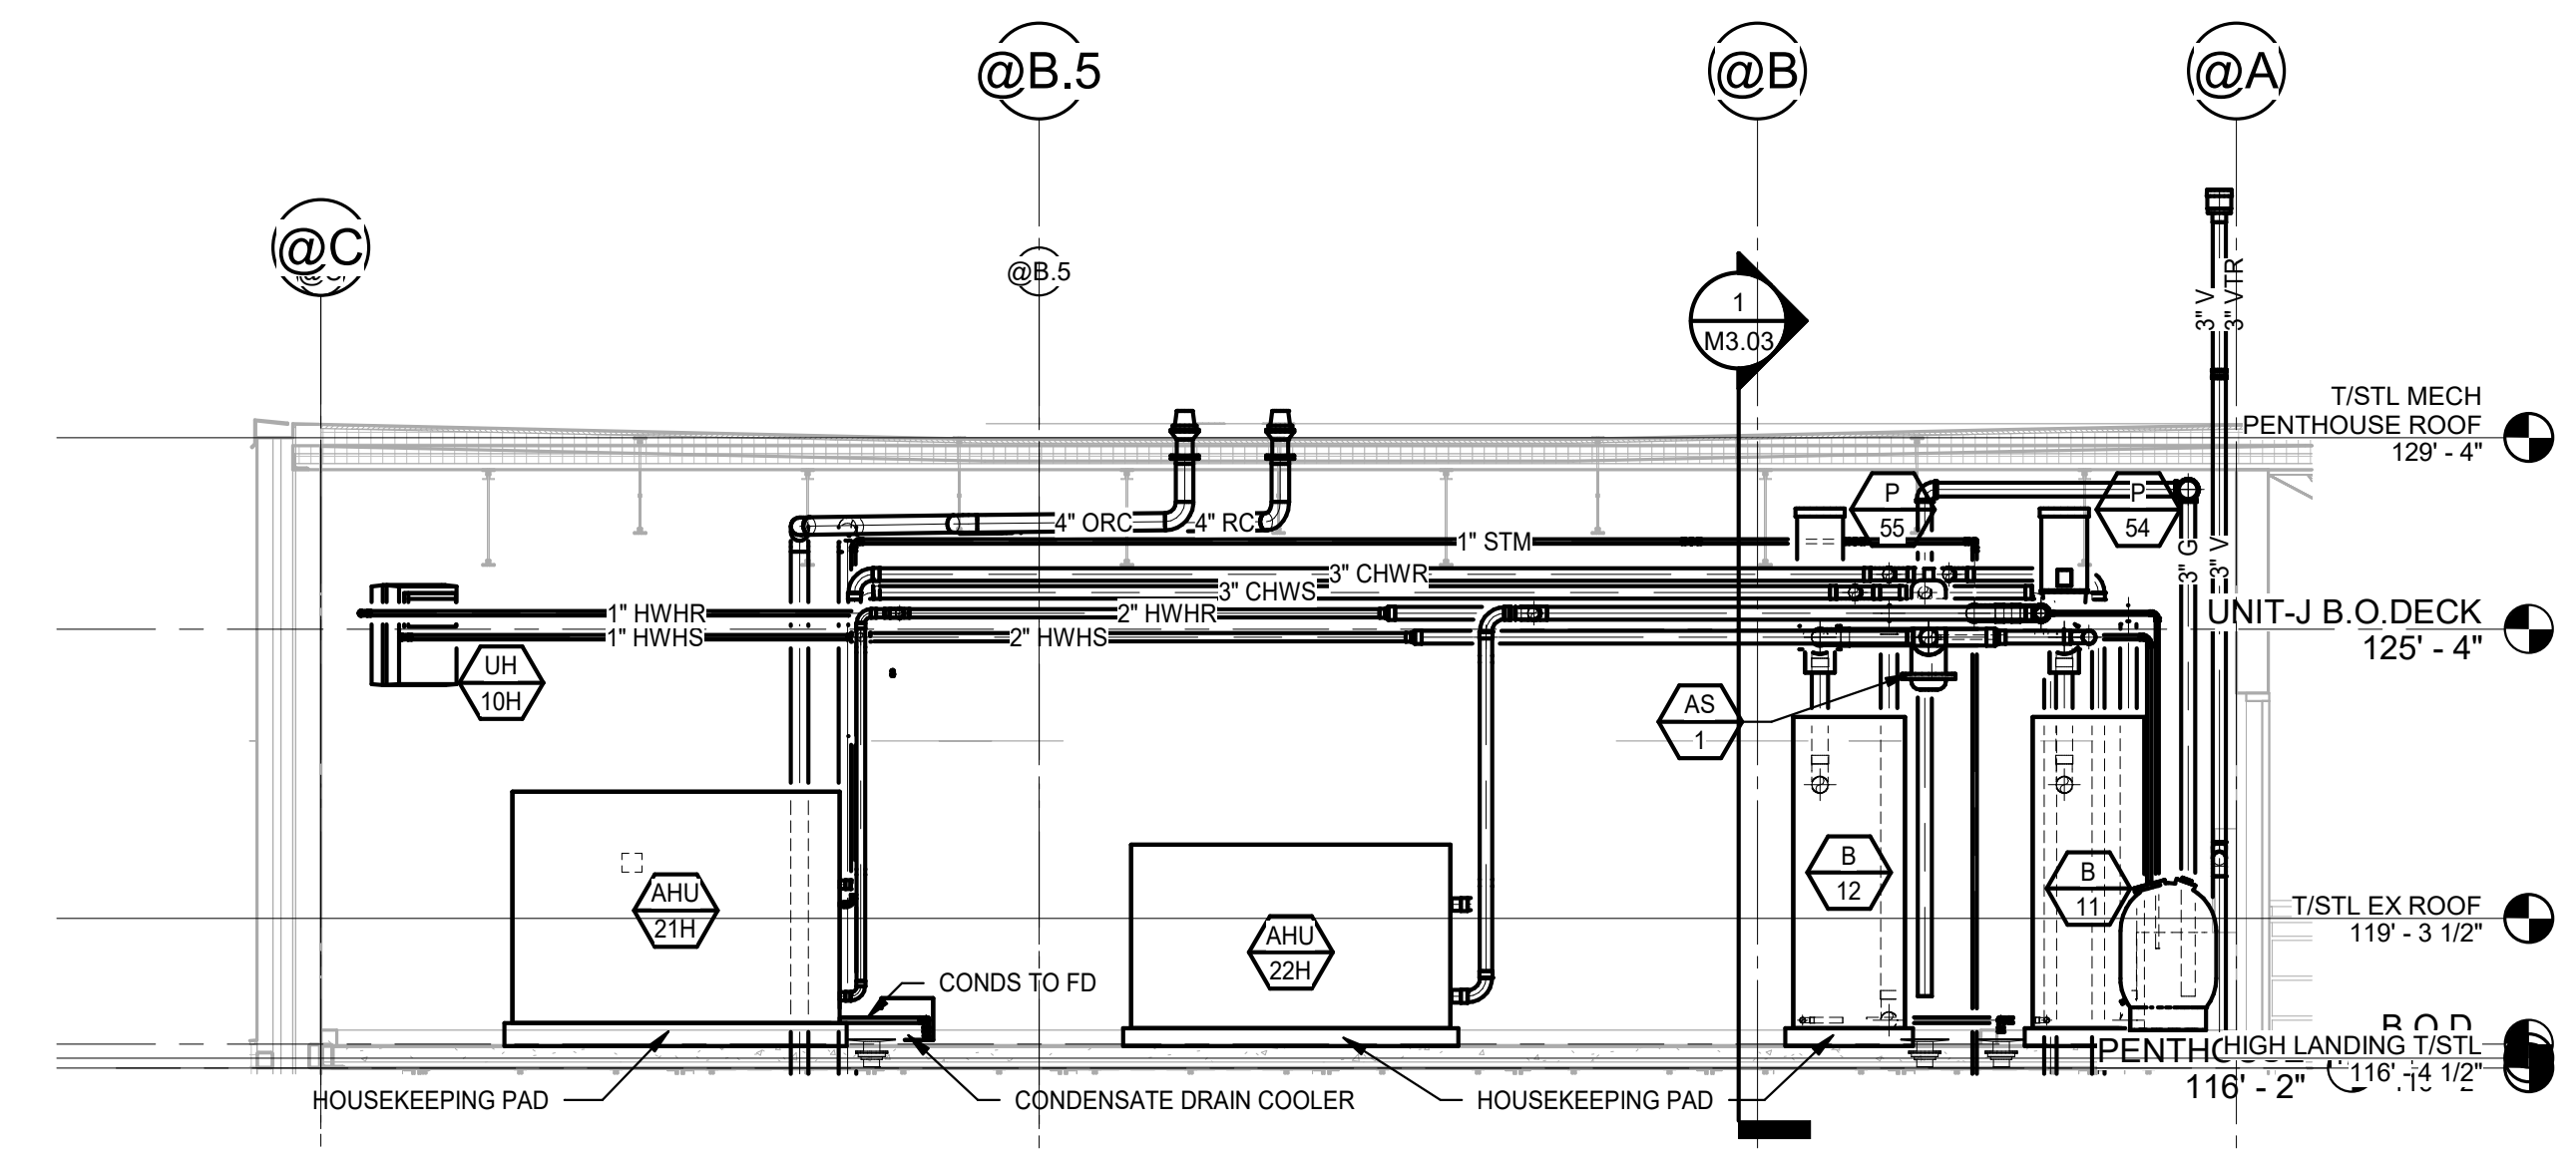

2 HVAC PIPING 2
SCALE: 1/4" = 1'-0"


NO.	REVISION	DATE

STATE OF MICHIGAN
DEPARTMENT OF TECHNOLOGY, MANAGEMENT AND BUDGET
FACILITIES AND BUSINESS SERVICES ADMINISTRATION
DESIGN AND CONSTRUCTION DIVISION
ADAM LACH, RA, DIRECTOR

FILE NO.
491/20167.SDW

FUNDING CODE
171CODHHS7255

CONTRACT NO.
Y22003

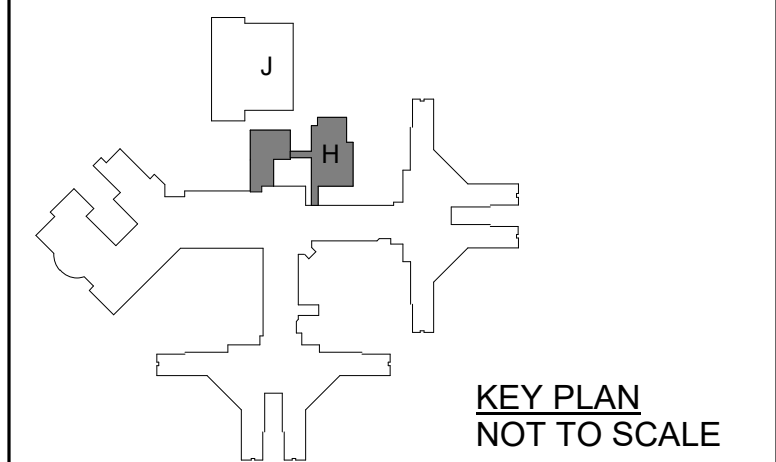

100 S. Jefferson Ave, Suite 601
Saginaw, Michigan 48607
989 752 8107

COPYRIGHT © 2023

PROJECT TITLE
491/20167.SDW - PHASE 500:
CENTER FOR FORENSIC
PSYCHIATRY - CREATE
KITCHEN
SALINE, MICHIGAN

SHEET TITLE
**PENTHOUSE HVAC PIPING
PLAN**

PROJECT NUMBER
2021094

SHEET NUMBER


PROJECT DATE
SEPTEMBER 6, 2023

M3.03


CHECKED BY
WEK





THE FOLLOWING DIMENSION EQUALS ONE INCH WHEN PRINTED TO SCALE.

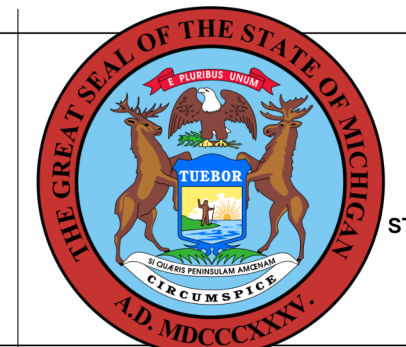

MECHANICAL
 These documents are approved for compliance with the STATE OF MICHIGAN MECHANICAL CODE subject to field inspection and the conditions of approval.

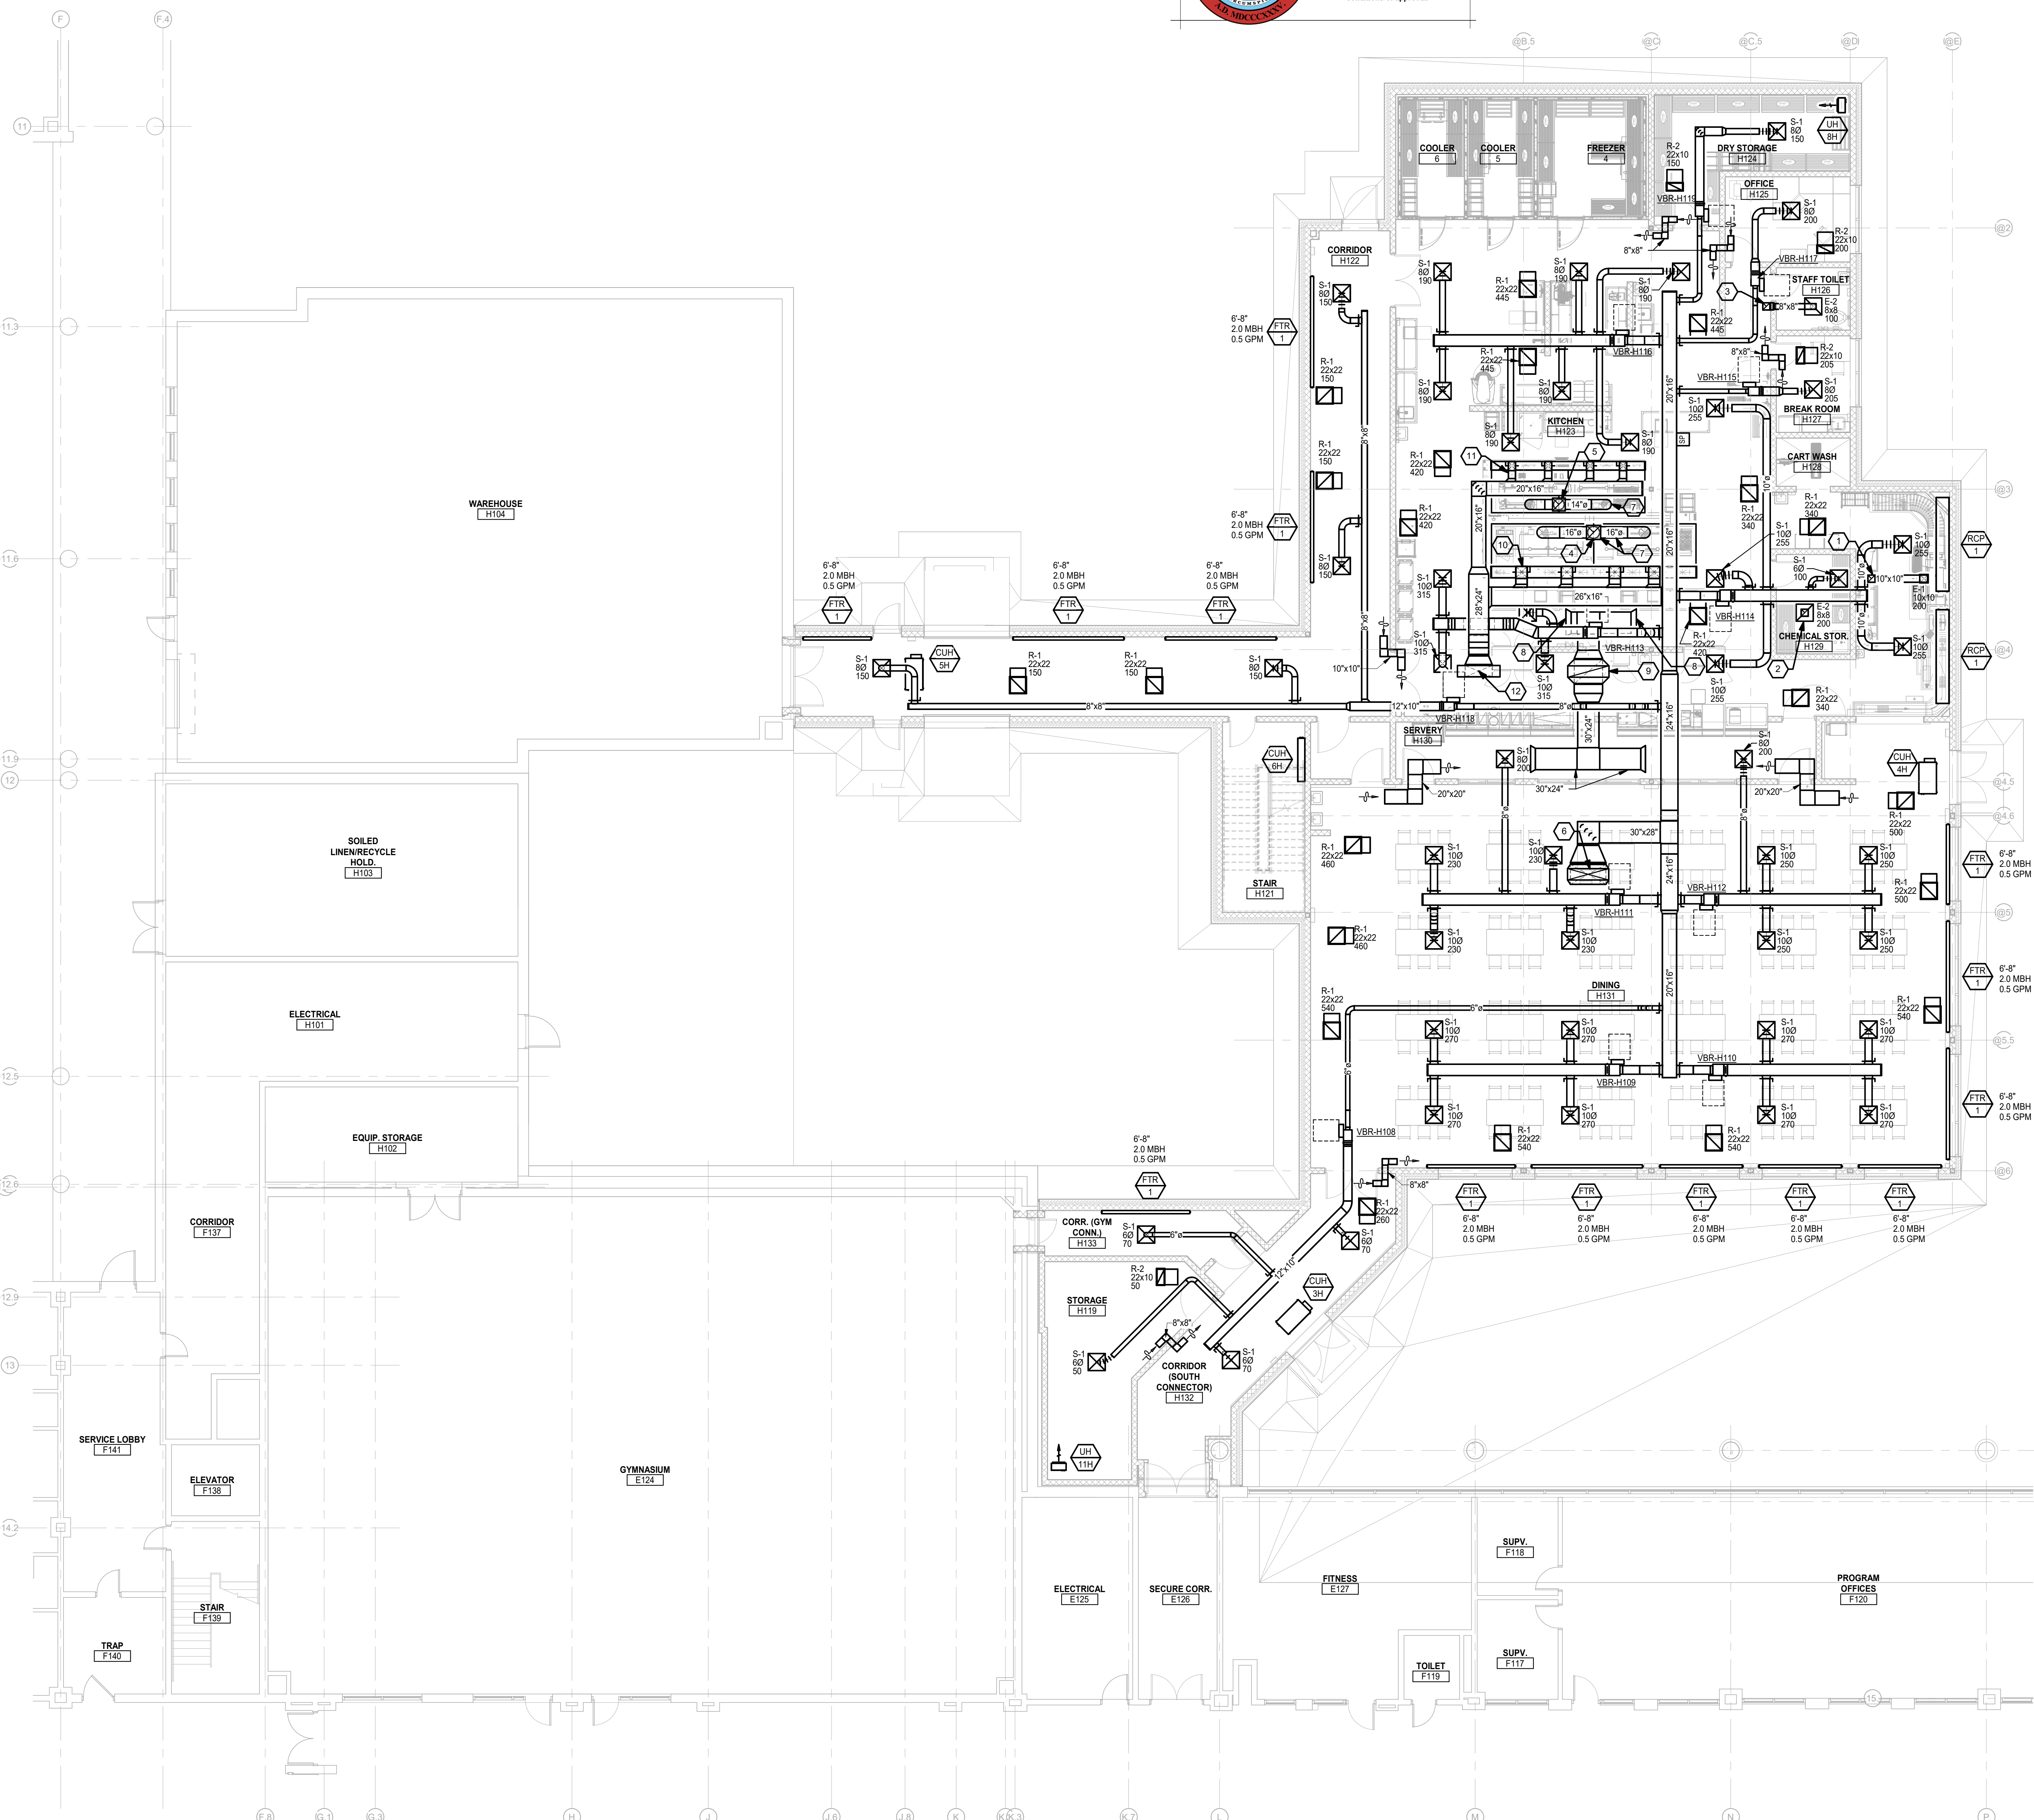

THE FOLLOWING DIMENSION EQUALS ONE INCH WHEN PRINTED TO SCALE.


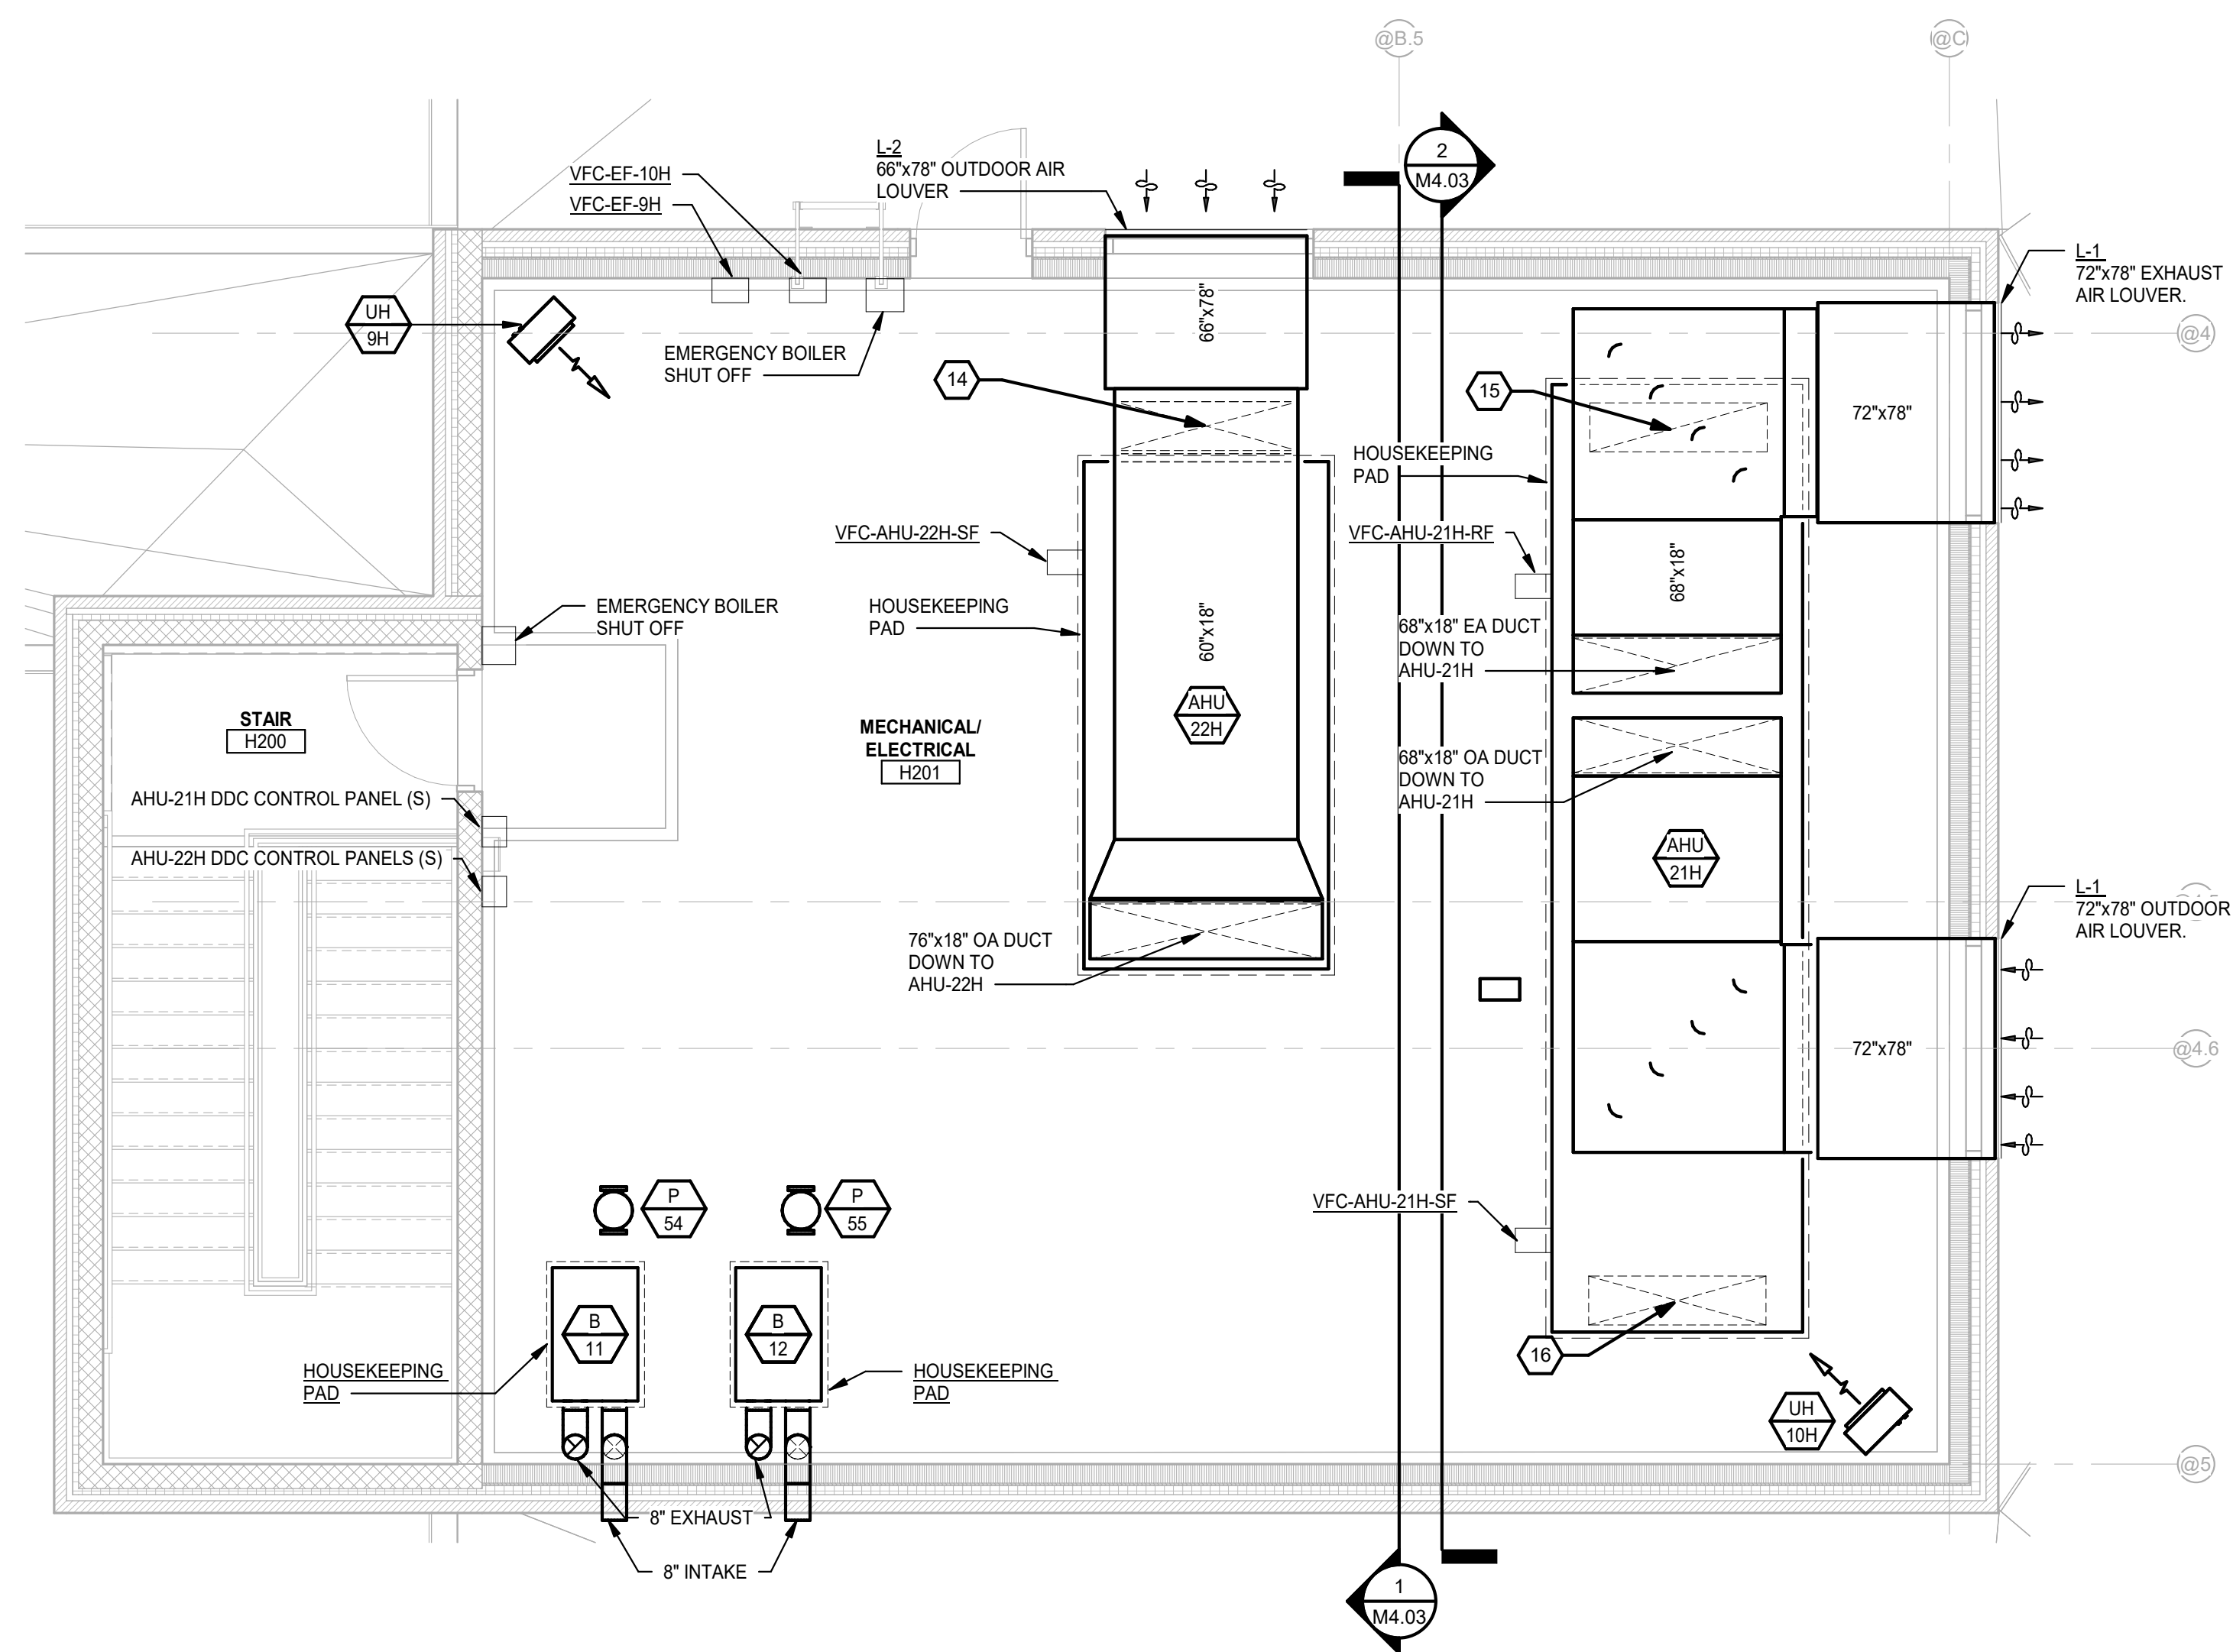
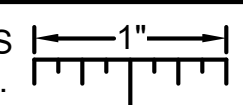


SHEET METAL GENERAL NOTES:

1. THESE DRAWINGS ARE DIAGRAMMATIC, AND REPRESENT THE GENERAL INTENT AND ARRANGEMENT OF SYSTEMS. THEY ARE NOT TO BE CONSIDERED FABRICATION/COORDINATION/SHOP DRAWINGS. COORDINATION WITH OTHER TRADES IS REQUIRED. PROVIDE THE ADDITIONAL FITTINGS AND OFFSETS THAT WILL BE REQUIRED TO COMPLETE EACH SYSTEM AND TO AVOID INTERFERENCES WITH ALL OTHER SYSTEMS INCLUDING THE STRUCTURE, PIPING SYSTEMS, ELECTRICAL CONDUITS, BUS DUCTS, CABLE TRAY, LIGHT FIXTURES, ETC. AND/OR OTHER SPACE CONSTRAINTS.
2. INSTALL SYSTEMS SUCH THAT REQUIRED CLEARANCE AND SERVICE ACCESS SPACE IS PROVIDED AROUND ALL MECHANICAL AND ELECTRICAL EQUIPMENT, AND AROUND ANY COMPONENTS WHICH REQUIRE SERVICE ACCESS.
3. PIPING AND DUCTWORK SHALL NOT BE INSTALLED ABOVE ELECTRICAL TRANSFORMERS, SWITCHBOARDS, PANELBOARDS OR MOTOR CONTROL CENTERS.
4. COORDINATE AND PROVIDE ACCESS DOORS WITHIN INACCESSIBLE CEILING, SHAFT, AND CHASE AREAS FOR ALL COMPONENTS WHICH REQUIRE SERVICE ACCESS. REFER TO ARCHITECTURAL DRAWINGS FOR CEILING TYPES.
5. PROVIDE SUPPLEMENTARY STEEL AS REQUIRED FOR THE PROPER SUPPORT OF ALL SYSTEMS.
6. REFER TO ARCHITECTURAL REFLECTED CEILING PLANS FOR DIMENSIONED LOCATION OF GRILLES, REGISTERS, AND DIFFUSERS.
7. REFER TO TEMPERATURE CONTROLS STANDARD MOUNTING HEIGHTS DETAIL FOR ELEVATIONS OF WALL MOUNTED TEMPERATURE CONTROL DEVICES.

CONSTRUCTION KEY NOTES:

1. 10x10 EXHAUST DUCT UP TO EF-8H
2. 10x10 EXHAUST DUCT UP TO EF-7H
3. 10x10 EXHAUST DUCT UP TO EF-6H
4. 20x20 DUCT UP TO EF-10H
5. 18x18 EXHAUST UP TO EF-6H
6. 58x16 UP TO AHU-21H. REFER TO SHEET M4.03 FOR CONTINUATION.
7. REFER TO DUCT SYSTEM APPLICATION SCHEDULE FOR DUCT TYPE.
8. 30"x30" RETURN DUCT WITH BELLMOUTH AT END.
9. 16"x28" RETURN AIR DUCT UP TO AHU-21H. REFER TO SHEET M4.03 FOR CONTINUATION.
10. 16"x16" MAKEUP AIR TO EXHAUST HOODS. (TYP. x 4)
11. 10"x12" MAKEUP AIR TO EXHAUST HOODS. (TYP. x 4)
12. 60"x16" UP TO AHU-22H. REFER TO SHEET M4.03 FOR CONTINUATION.
13. RECOMMENDED LOCATION FOR PIPE PORTAL.
14. 60"x16" SUPPLY AIR DUCT DOWN TO FIRST FLOOR. REFER TO SHEET M4.01 FOR CONTINUATION.
15. 58"x16" RETURN AIR DOWN TO FIRST FLOOR. REFER TO SHEET M4.01 FOR CONTINUATION.
16. 58"x16" SUPPLY AIR DOWN TO FIRST FLOOR. REFER TO SHEET M4.01 FOR CONTINUATION.
17. EVACUATE SYSTEM. RELOCATE EXISTING CONDENSING UNITS TO LOCATION SHOWN. PROVIDE NEW REFRIGERANT LINES. RECHARGE AND RECOMMISSION UNITS.

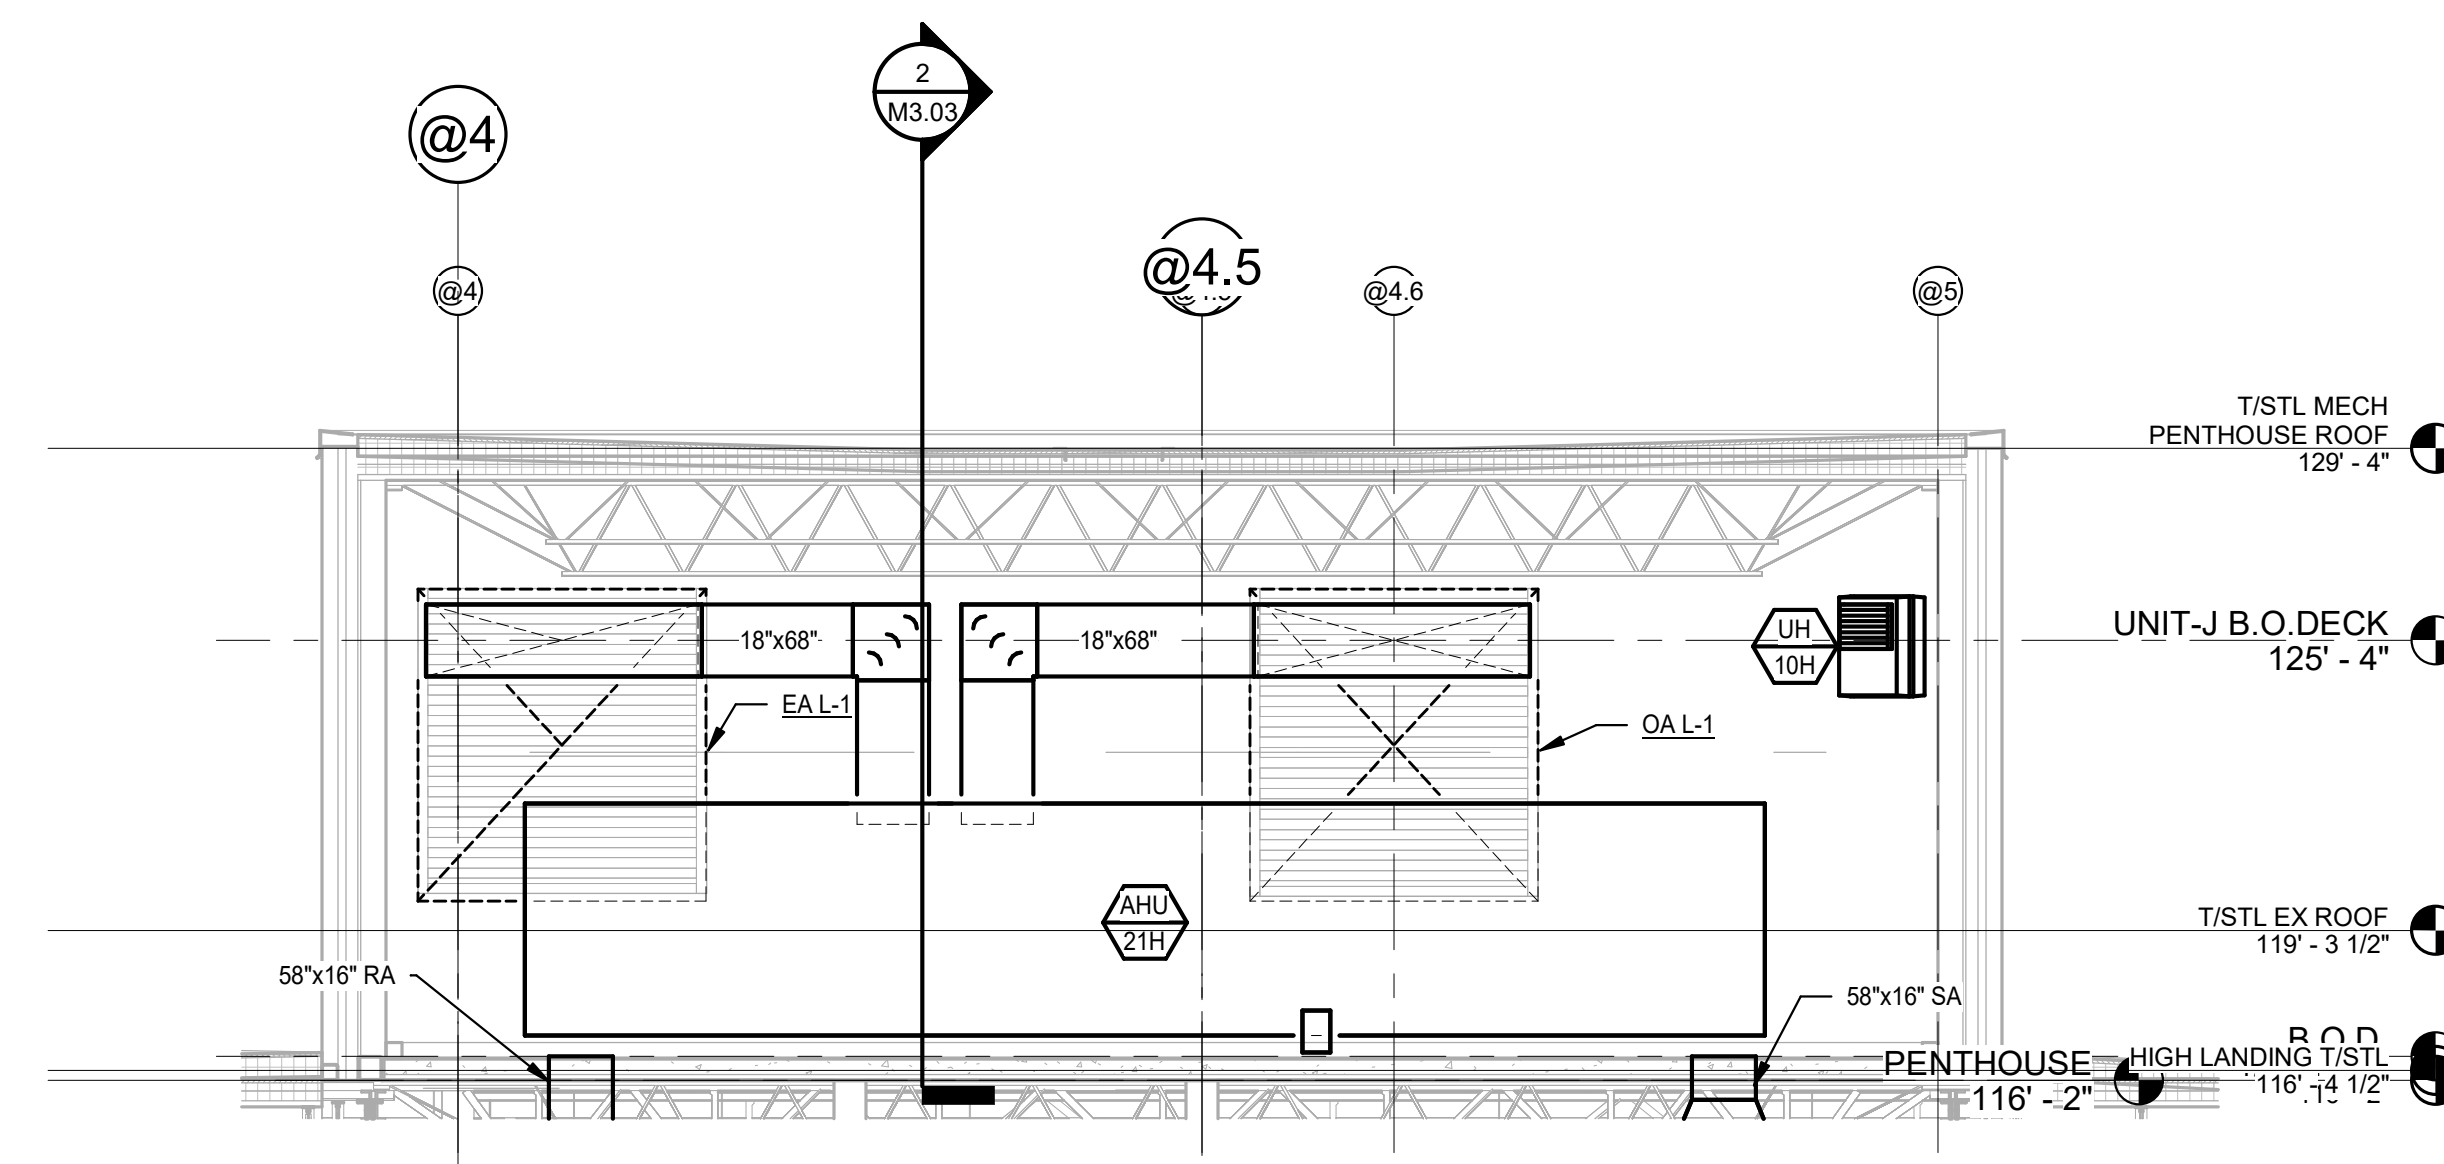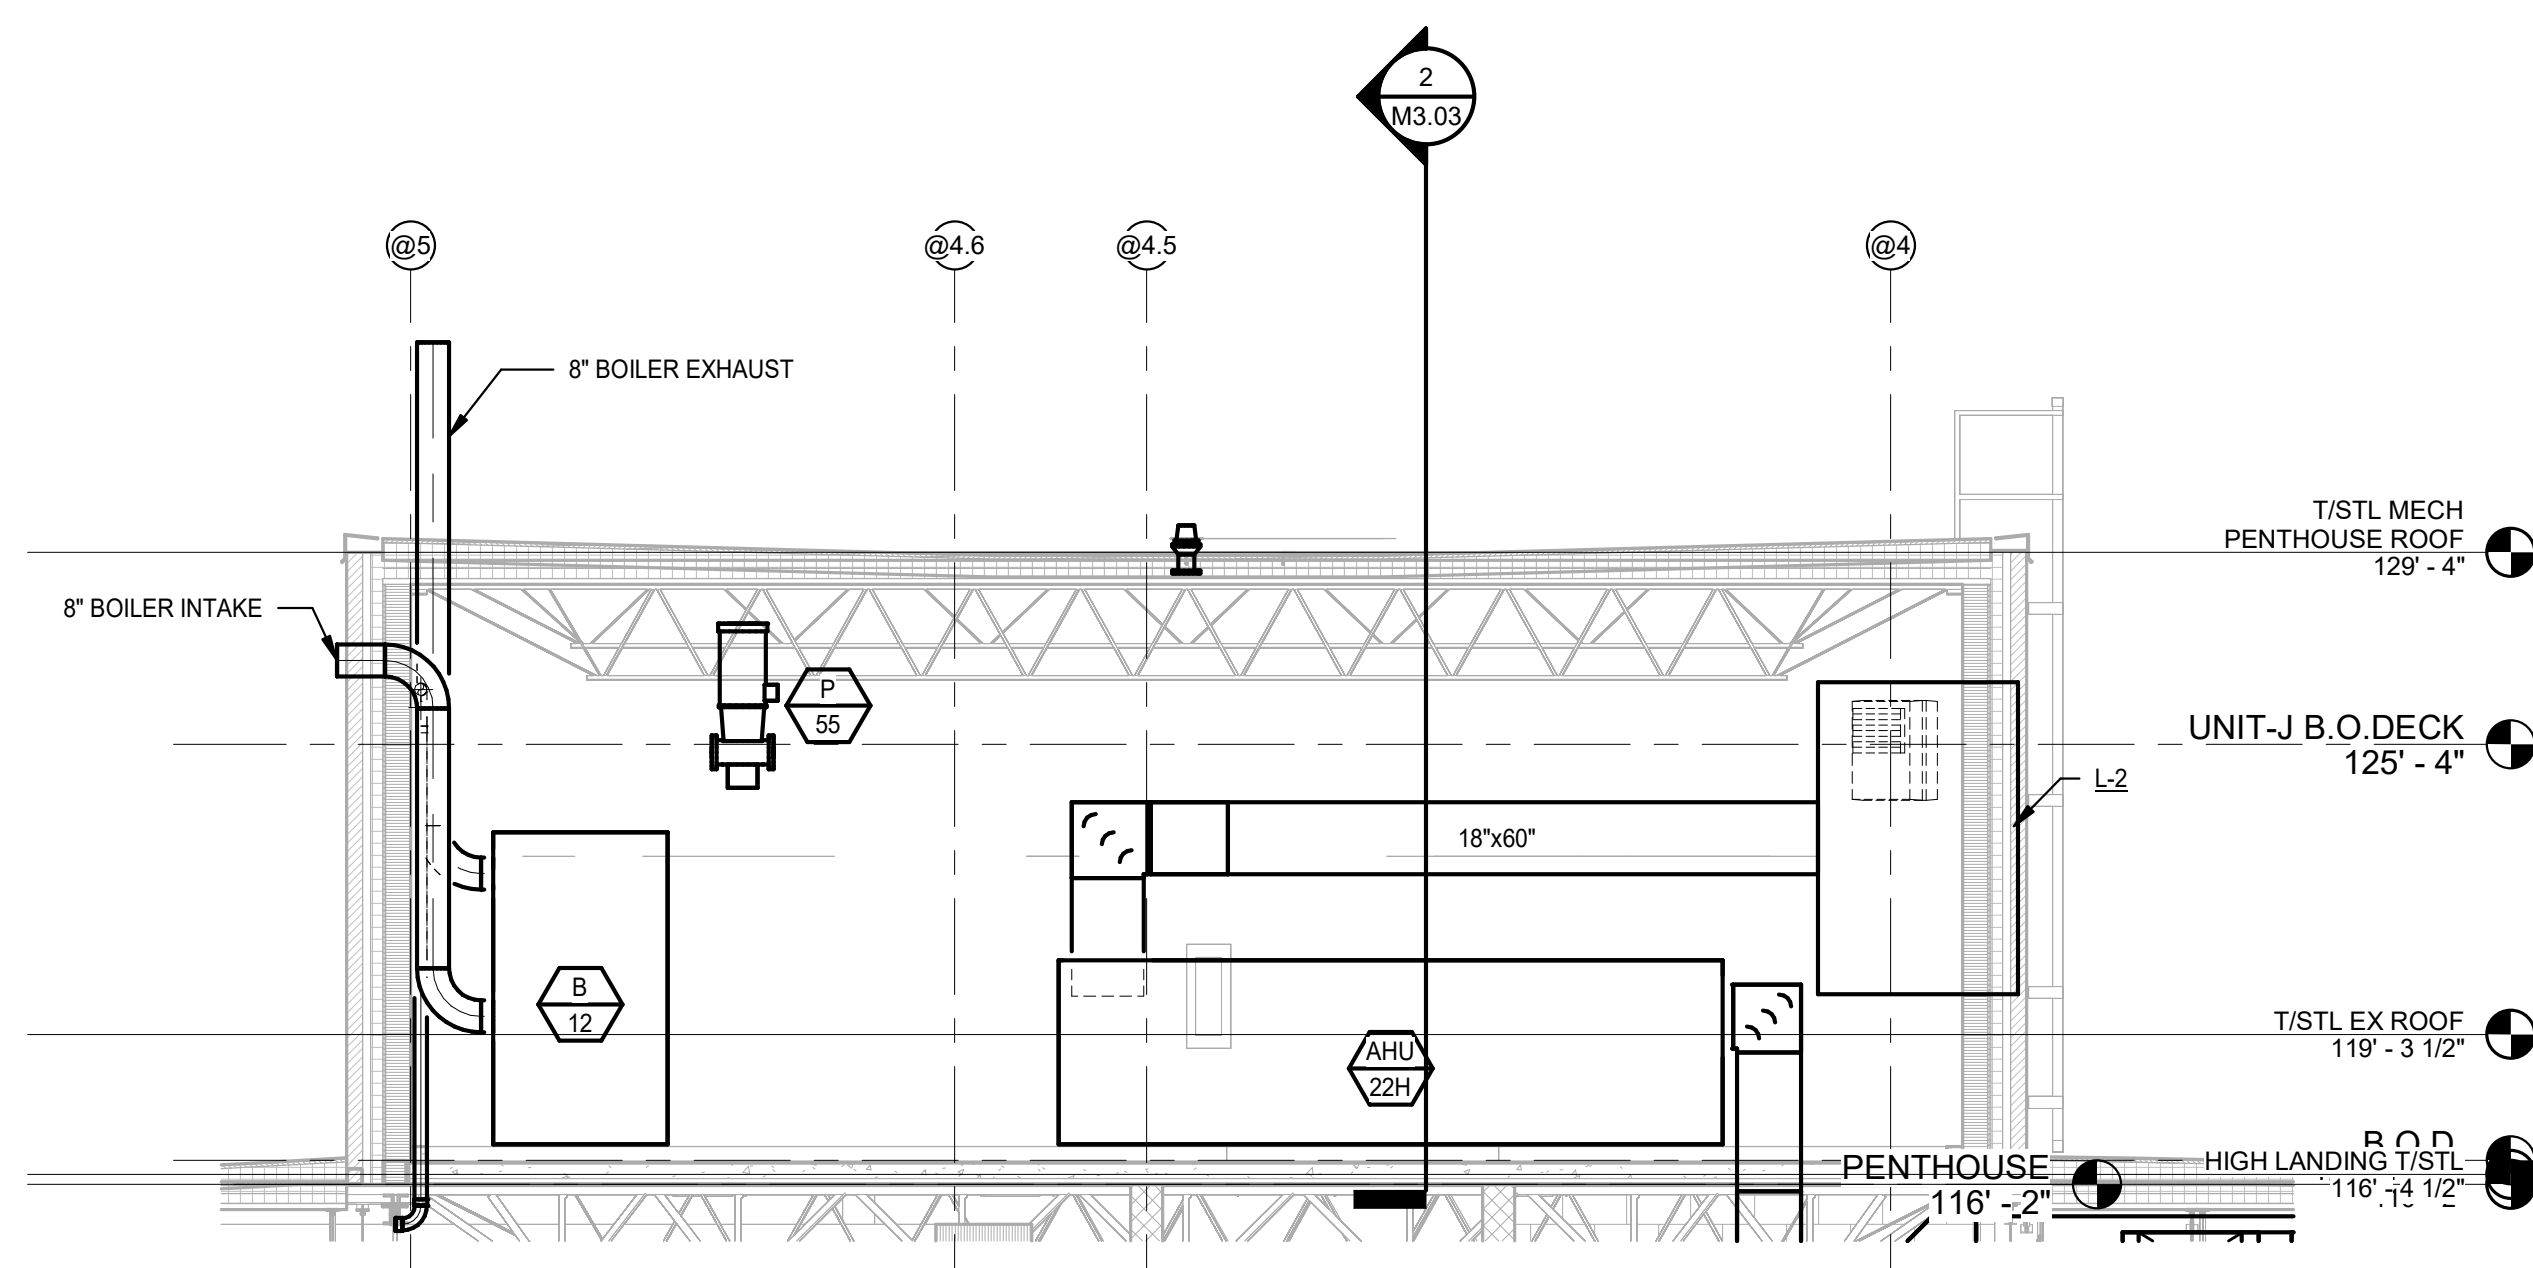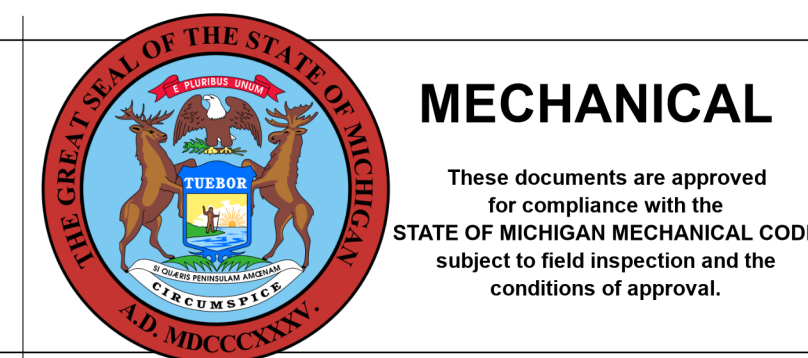


NO.	REVISION	DATE

STATE OF MICHIGAN
DEPARTMENT OF TECHNOLOGY, MANAGEMENT AND BUDGET
FACILITIES AND BUSINESS SERVICES ADMINISTRATION
DESIGN AND CONSTRUCTION DIVISION
ADAM LACH, RA, DIRECTOR

FILE NO.
491/20167.SDW

FUNDING CODE
171CODHHS7255

CONTRACT NO.
Y22003

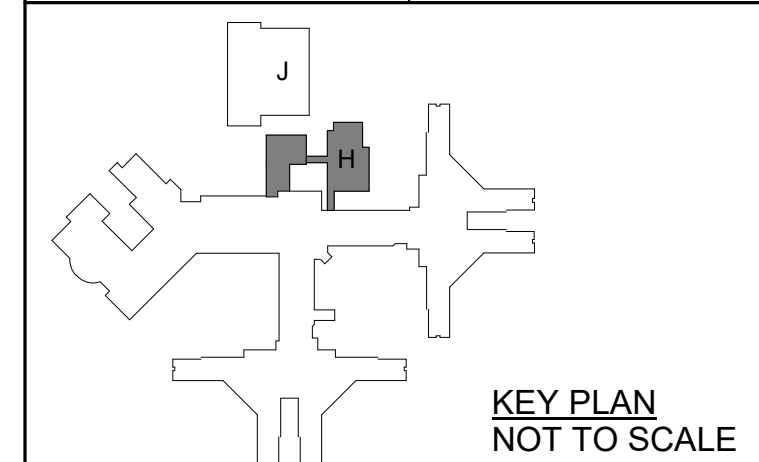

WTA ARCHITECTS
100 S. Jefferson Ave., Suite 601
Saginaw, Michigan 48607
989 752 8107
COPYRIGHT © 2023

PROJECT TITLE
491/20167.SDW - PHASE 500:
CENTER FOR FORENSIC
PSYCHIATRY - CREATE
KITCHEN
SALINE, MICHIGAN

SHEET TITLE
PENTHOUSE SHEET METAL
PLAN

PROJECT NUMBER
2021094



PROJECT DATE
SEPTEMBER 6, 2023

CHECKED BY
WEK

SHEET NUMBER
M4.03


PBA
Peter Basso Associates Inc
CONSULTING ENGINEERS
5445 Livernois, Suite 100
Troy, Michigan 48068-3276
Tel: 248-879-5666
Fax: 248-879-0007
www.PeterBassoAssociates.com
PBA Project No. 303-0602

THE FOLLOWING DIMENSION EQUALS ONE INCH WHEN PRINTED TO SCALE.

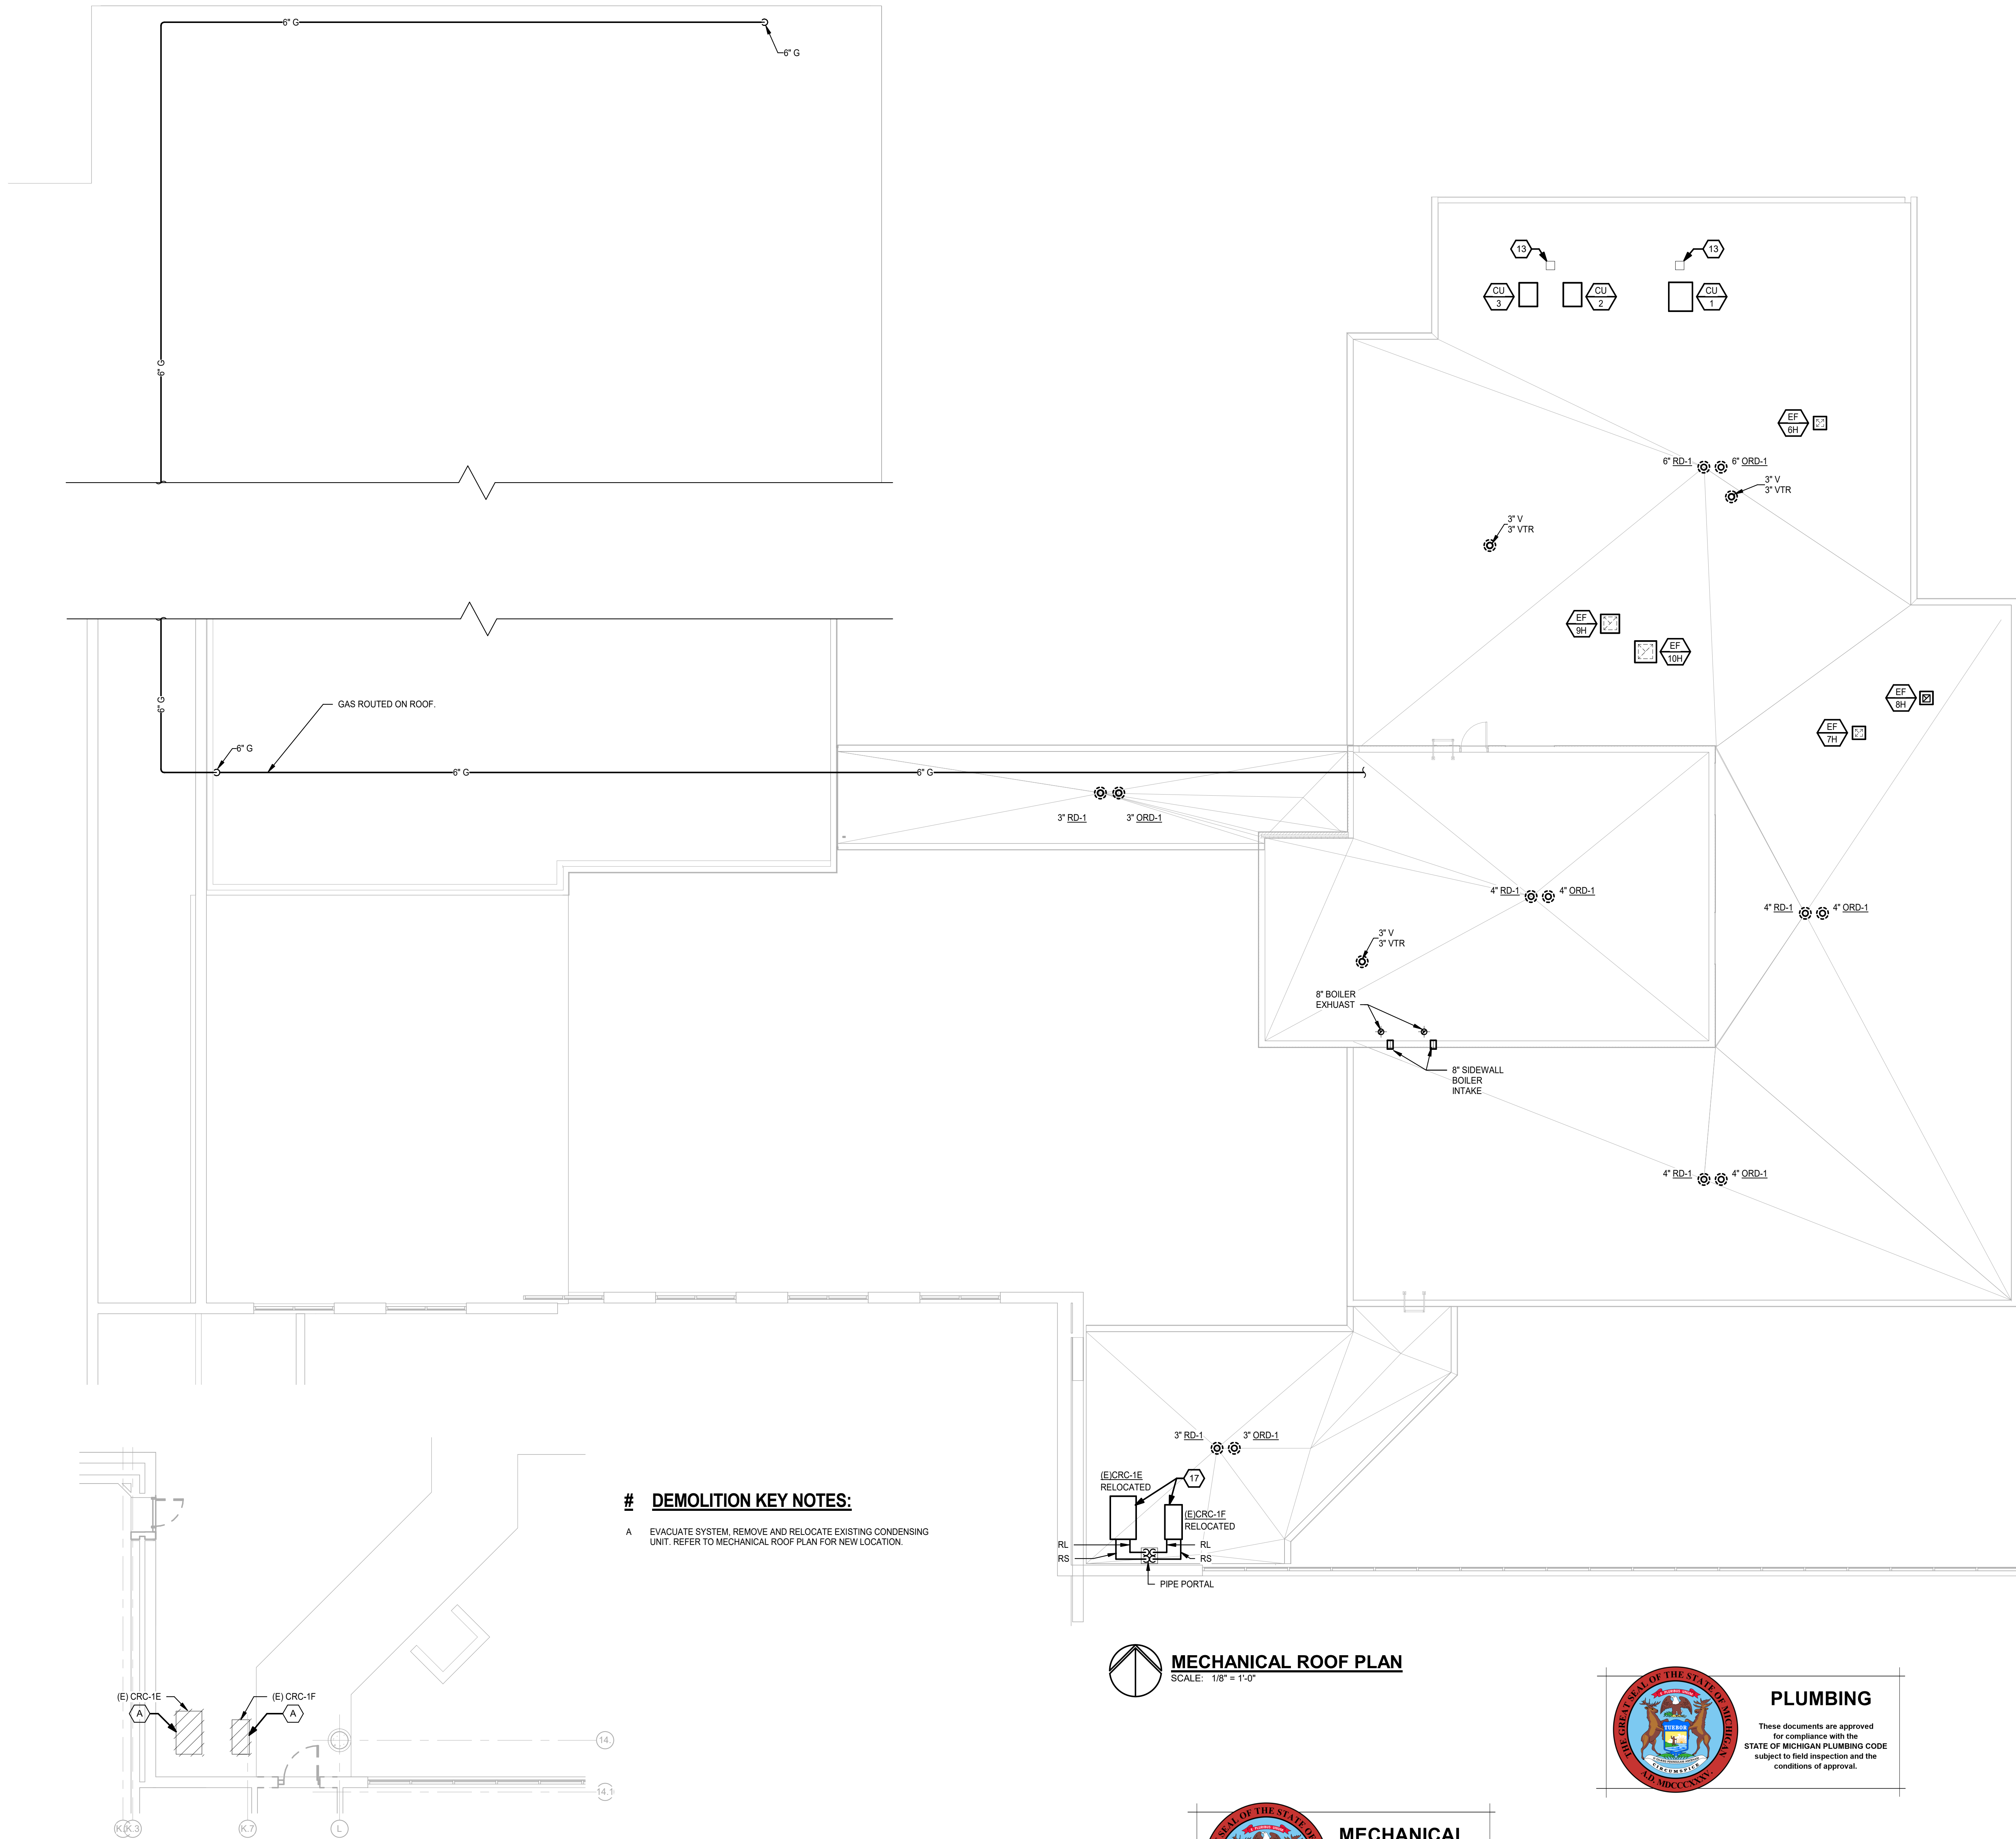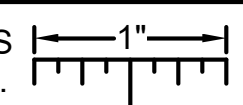



DEMOLITION KEY NOTES:

- A EVALUATE SYSTEM, REMOVE AND RELOCATE EXISTING CONDENSING UNIT. REFER TO MECHANICAL ROOF PLAN FOR NEW LOCATION.

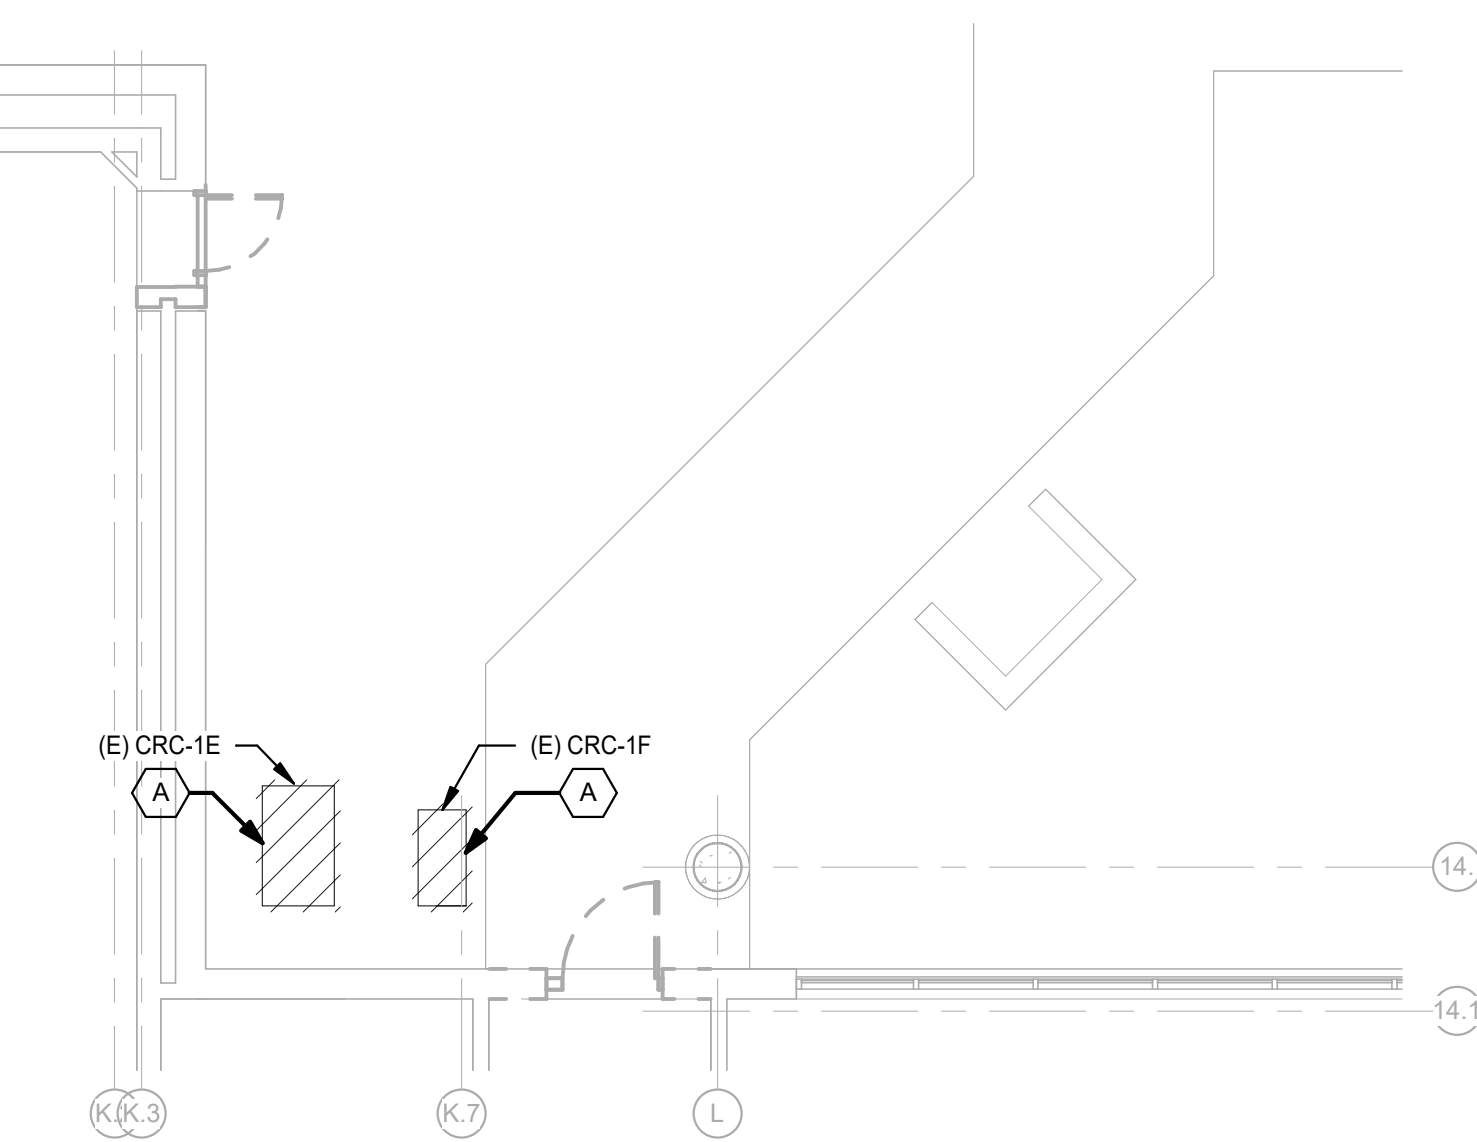

FIRST FLOOR MECHANICAL DEMOLITION PLAN
SCALE: 1/8" = 1'-0"

MECHANICAL ROOF PLAN
SCALE: 1/8" = 1'-0"

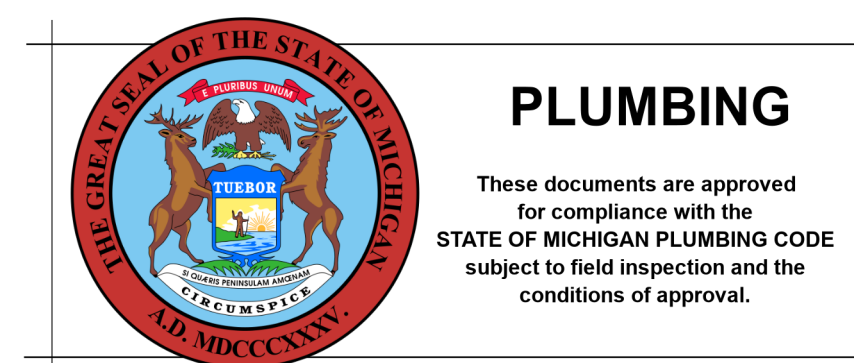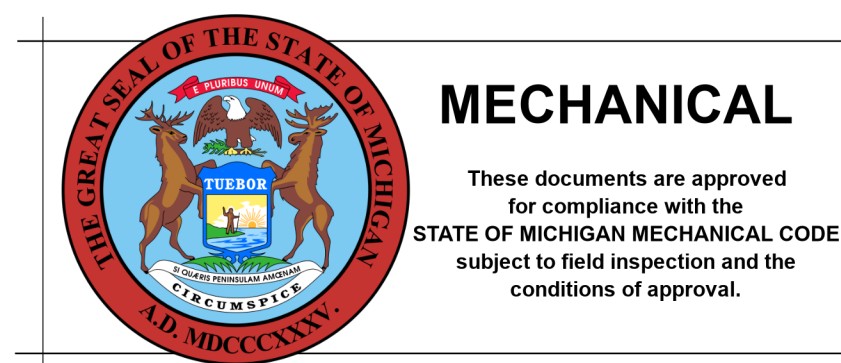

PLUMBING GENERAL NOTES:

- THESE DRAWINGS ARE DIAGRAMMATIC, AND REPRESENT THE GENERAL INTENT AND ARRANGEMENT OF SYSTEMS. THEY ARE NOT TO BE CONSIDERED FABRICATION/COORDINATION/SHOP DRAWINGS. COORDINATION WITH OTHER TRADES IS REQUIRED. PROVIDE THE ADDITIONAL FITTINGS AND OFFSETS THAT WILL BE REQUIRED TO COMPLETE EACH SYSTEM AND TO AVOID INTERFERENCES WITH ALL OTHER SYSTEMS INCLUDING THE STRUCTURE, SHEET METAL, OTHER PIPING SYSTEMS, ELECTRICAL CONDUITS, BUS DUCTS, CABLE TRAY, LIGHT FIXTURES, ETC. AND/OR OTHER SPACE CONSTRAINTS.
- INSTALL SYSTEMS SUCH THAT REQUIRED CLEARANCE AND SERVICE ACCESS SPACE IS PROVIDED AROUND ALL MECHANICAL AND ELECTRICAL EQUIPMENT, AND AROUND ANY COMPONENTS WHICH REQUIRE SERVICE ACCESS.
- PIPING SHALL NOT BE INSTALLED ABOVE ELECTRICAL TRANSFORMERS, SWITCHBOARDS, PANELBOARDS OR MOTOR CONTROL CENTERS.
- COORDINATE AND PROVIDE ACCESS DOORS WITHIN INACCESSIBLE CEILING, SHAFT, AND CHASE AREAS FOR ALL COMPONENTS WHICH REQUIRE SERVICE ACCESS. REFER TO ARCHITECTURAL DRAWINGS FOR CEILING TYPES.
- PROVIDE SUPPLEMENTARY STEEL AS REQUIRED FOR THE PROPER SUPPORT OF ALL SYSTEMS.
- REFER TO ARCHITECTURAL PLANS FOR DIMENSIONED LOCATIONS OF PLUMBING FIXTURES.
- HOT AND COLD WATER PIPING RUN-OUTS TO LAVATORIES AND SINKS SHALL BE 1/2" UNLESS OTHERWISE NOTED.
- PLUMBING VENT PIPING THROUGH ROOF SHALL BE LOCATED A MINIMUM OF 10'-0" FROM ANY FRESH AIR INTAKE LOCATION AND A MINIMUM OF 18" CLEAR FROM THE INSIDE FACE OF PARAPET.
- PROVIDE CODE REQUIRED CLEARANCE FOR ALL CLEANOUTS INSTALLED IN SANITARY WASTE AND VENT PIPING.
- MINIMUM UNDERGROUND PIPE SIZE SHALL BE 3".

SHEET METAL GENERAL NOTES:

- THESE DRAWINGS ARE DIAGRAMMATIC, AND REPRESENT THE GENERAL INTENT AND ARRANGEMENT OF SYSTEMS. THEY ARE NOT TO BE CONSIDERED FABRICATION/COORDINATION/SHOP DRAWINGS. COORDINATION WITH OTHER TRADES IS REQUIRED. PROVIDE THE ADDITIONAL FITTINGS AND OFFSETS THAT WILL BE REQUIRED TO COMPLETE EACH SYSTEM AND TO AVOID INTERFERENCES WITH ALL OTHER SYSTEMS INCLUDING THE STRUCTURE, PIPING SYSTEMS, ELECTRICAL CONDUITS, BUS DUCTS, CABLE TRAY, LIGHT FIXTURES, ETC. AND/OR OTHER SPACE CONSTRAINTS.
- INSTALL SYSTEMS SUCH THAT REQUIRED CLEARANCE AND SERVICE ACCESS SPACE IS PROVIDED AROUND ALL MECHANICAL AND ELECTRICAL EQUIPMENT, AND AROUND ANY COMPONENTS WHICH REQUIRE SERVICE ACCESS.
- PIPING AND DUCTWORK SHALL NOT BE INSTALLED ABOVE ELECTRICAL TRANSFORMERS, SWITCHBOARDS, PANELBOARDS OR MOTOR CONTROL CENTERS.
- COORDINATE AND PROVIDE ACCESS DOORS WITHIN INACCESSIBLE CEILING, SHAFT, AND CHASE AREAS FOR ALL COMPONENTS WHICH REQUIRE SERVICE ACCESS. REFER TO ARCHITECTURAL DRAWINGS FOR CEILING TYPES.
- PROVIDE SUPPLEMENTARY STEEL AS REQUIRED FOR THE PROPER SUPPORT OF ALL SYSTEMS.
- REFER TO ARCHITECTURAL REFLECTED CEILING PLANS FOR DIMENSIONED LOCATION OF GRILLES, REGISTERS, AND DIFFUSERS.
- REFER TO TEMPERATURE CONTROLS STANDARD MOUNTING HEIGHTS DETAIL FOR ELEVATIONS OF WALL MOUNTED TEMPERATURE CONTROL DEVICES.

CONSTRUCTION KEY NOTES:

- 10x10 EXHAUST DUCT UP TO EF-8H
- 10x10 EXHAUST DUCT UP TO EF-7H
- 10x10 EXHAUST DUCT UP TO EF-6H
- 20x20 DUCT UP TO EF-10H
- 18x18 EXHAUST UP TO EF-9H
- 58x16 UP TO AHU-21H. REFER TO SHEET M4.03 FOR CONTINUATION.
- REFER TO DUCT SYSTEM APPLICATION SCHEDULE FOR DUCT TYPE.
- 30"x30" RETURN DUCT WITH BELLMOUTH AT END.
- 16"x58" RETURN AIR DUCT UP TO AHU-21H. REFER TO SHEET M4.03 FOR CONTINUATION.
- 16"x16" MAKEUP AIR TO EXHAUST HOODS. (TYP. x 4)
- 10"x12" MAKEUP AIR TO EXHAUST HOODS. (TYP. x 4)
- 60"x16" UP TO AHU-22H. REFER TO SHEET M4.03 FOR CONTINUATION.
- RECOMMENDED LOCATION FOR PIPE PORTAL.
- 80"x16" SUPPLY AIR DUCT DOWN TO FIRST FLOOR. REFER TO SHEET M4.01 FOR CONTINUATION.
- 58"x16" RETURN AIR DOWN TO FIRST FLOOR. REFER TO SHEET M4.01 FOR CONTINUATION.
- 58"x16" SUPPLY AIR DOWN TO FIRST FLOOR. REFER TO SHEET M4.01 FOR CONTINUATION.
- EVACUATE SYSTEM. RELOCATE EXISTING CONDENSING UNITS TO LOCATION SHOWN. PROVIDE NEW REFRIGERANT LINES, RECHARGE AND RECOMMISSION UNITS.


NO.	REVISION	DATE

STATE OF MICHIGAN
DEPARTMENT OF TECHNOLOGY, MANAGEMENT AND BUDGET
FACILITIES AND BUSINESS SERVICES ADMINISTRATION
DESIGN AND CONSTRUCTION DIVISION
ADAM LACH, R.A. DIRECTOR

FILE NO.
491/20167.SDW

FUNDING CODE
171CODHHS7255

CONTRACT NO.
Y22003

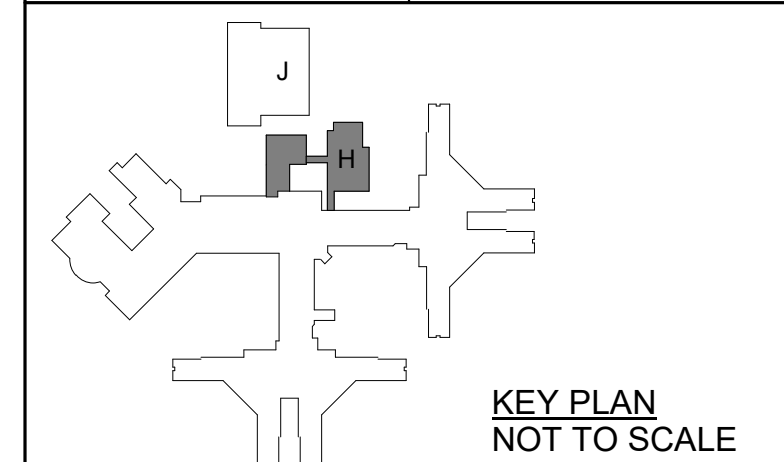

WTA ARCHITECTS
100 S. Jefferson Ave, Suite 601
Saginaw, Michigan 48607
989 752 8107
COPYRIGHT © 2023

PROJECT TITLE
491/20167.SDW - PHASE 500:
CENTER FOR FORENSIC PSYCHIATRY - CREATE KITCHEN
SALINE, MICHIGAN

SHEET TITLE
MECHANICAL ROOF PLAN

PROJECT NUMBER
2021094


SHEET NUMBER
M4.04

PROJECT DATE
SEPTEMBER 6, 2023

CHECKED BY
WEK

PBA
Peter Basso Associates Inc
CONSULTING ENGINEERS
5145 Livernois, Suite 100
Troy, Michigan 48068-3276
Tel: 248-879-5666
Fax: 248-879-0007
www.PeterBassoAssociates.com
PBA Project No. 303-0402

THE FOLLOWING DIMENSION EQUALS ONE INCH WHEN PRINTED TO SCALE.

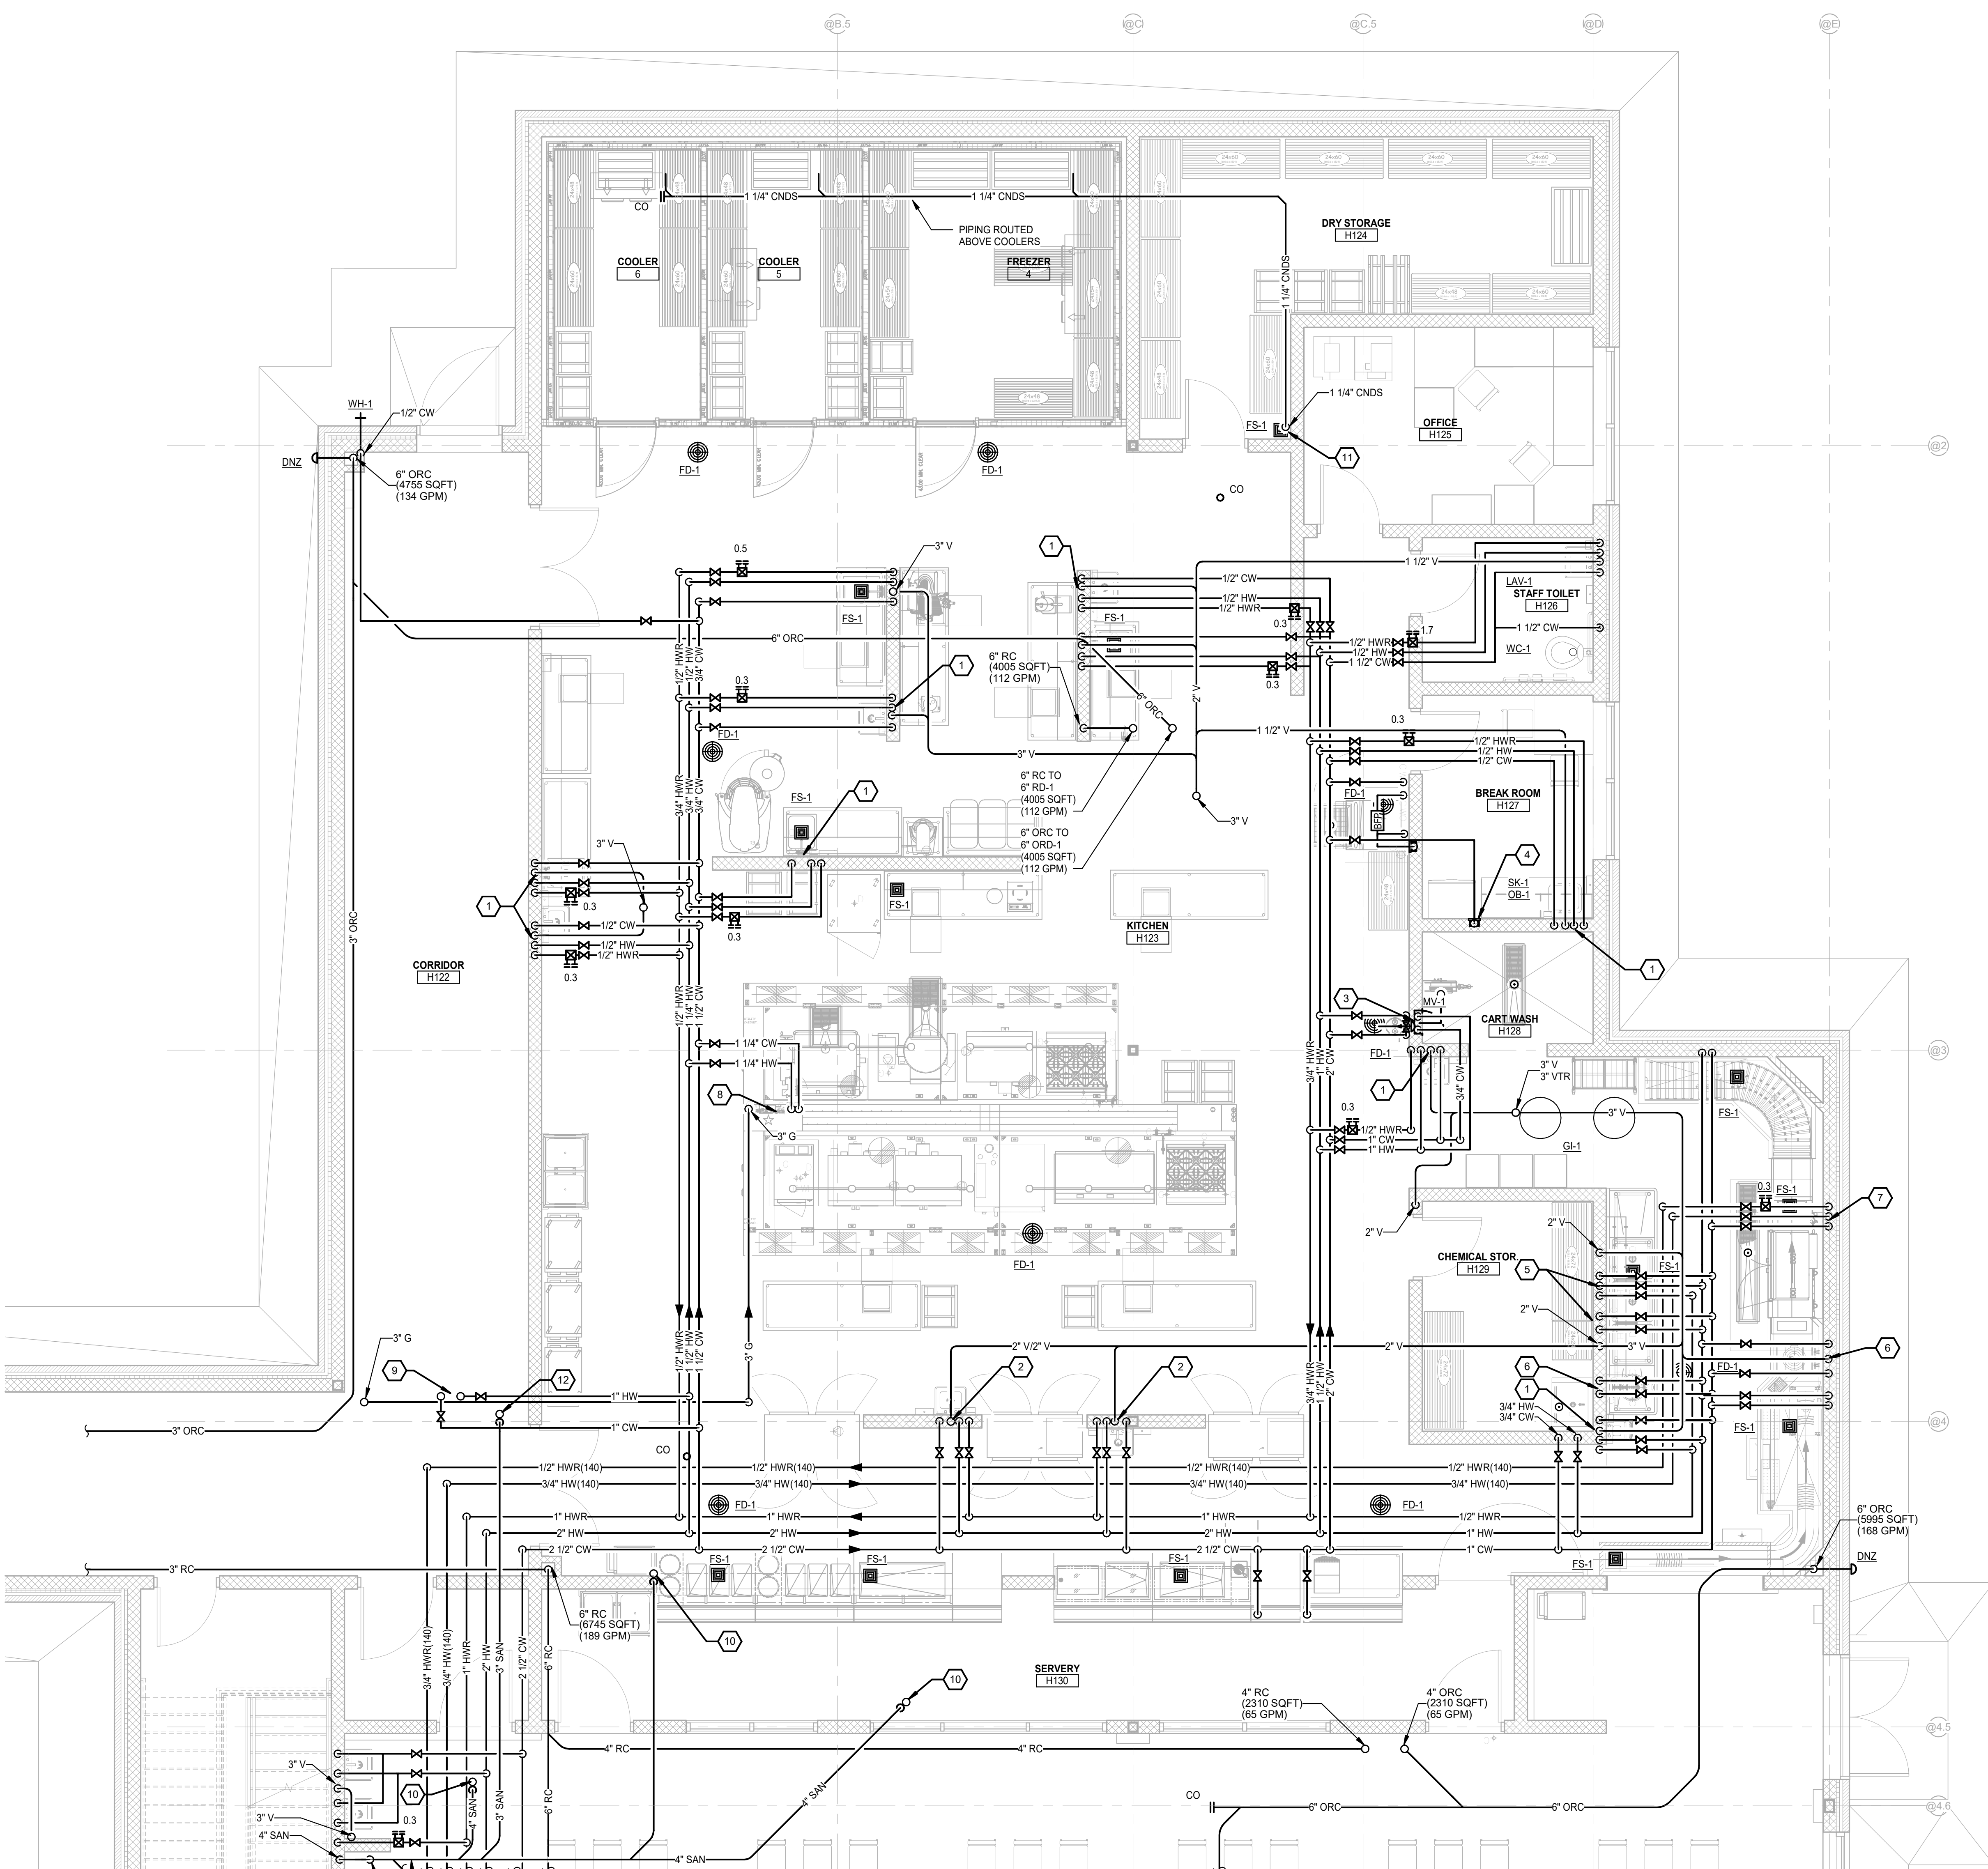


1 FIRST FLOOR PLUMBING ENLARGED KITCHEN PLAN
SCALE: 1/4" = 1'-0"

PLUMBING GENERAL NOTES:

- 1 THESE DRAWINGS ARE DIAGRAMMATIC, AND REPRESENT THE GENERAL INTENT AND ARRANGEMENT OF SYSTEMS. THEY ARE NOT TO BE CONSIDERED FABRICATION/COORDINATION/SHOP DRAWINGS. COORDINATION WITH OTHER TRADES IS REQUIRED. PROVIDE THE ADDITIONAL FITTINGS AND OFFSETS THAT WILL BE REQUIRED TO COMPLETE EACH SYSTEM AND TO AVOID INTERFERENCES WITH ALL OTHER SYSTEMS INCLUDING THE STRUCTURE, SHEET METAL, OTHER PIPING SYSTEMS, ELECTRICAL CONDUITS, BUS DUCTS, CABLE TRAY, LIGHT FIXTURES, ETC. AND/OR OTHER SPACE CONSTRAINTS.
- 2 INSTALL SYSTEMS SUCH THAT REQUIRED CLEARANCE AND SERVICE ACCESS SPACE IS PROVIDED AROUND ALL MECHANICAL AND ELECTRICAL EQUIPMENT, AND AROUND ANY COMPONENTS WHICH REQUIRE SERVICE ACCESS.
- 3 PIPING SHALL NOT BE INSTALLED ABOVE ELECTRICAL TRANSFORMERS, SWITCHBOARDS, PANELBOARDS OR MOTOR CONTROL CENTERS.
- 4 COORDINATE AND PROVIDE ACCESS DOORS WITHIN INACCESSIBLE CEILING, SHAFT, AND CHASE AREAS FOR ALL COMPONENTS WHICH REQUIRE SERVICE ACCESS. REFER TO ARCHITECTURAL DRAWINGS FOR CEILING TYPES.
- 5 PROVIDE SUPPLEMENTARY STEEL AS REQUIRED FOR THE PROPER SUPPORT OF ALL SYSTEMS.
- 6 REFER TO ARCHITECTURAL PLANS FOR DIMENSIONED LOCATIONS OF PLUMBING FIXTURES.
- 7 HOT AND COLD WATER PIPING RUN-OUTS TO LAVATORIES AND SINKS SHALL BE 1/2" UNLESS OTHERWISE NOTED.
- 8 PLUMBING VENT PIPING THROUGH ROOF SHALL BE LOCATED A MINIMUM OF 10'-0" FROM ANY FRESH AIR INTAKE LOCATION AND A MINIMUM OF 18" CLEAR FROM THE INSIDE FACE OF PARAPET.
- 9 PROVIDE CODE REQUIRED CLEARANCE FOR ALL CLEANOUTS INSTALLED IN SANITARY WASTE AND VENT PIPING.
- 10 MINIMUM UNDERGROUND PIPE SIZE SHALL BE 3".

CONSTRUCTION KEY NOTES:

- 1 3 SAN, 2 V, 1/2 CW, 1/2 HW, AND 1/2 HWR TO SINK.
- 2 3 SAN, 1 1/2 V, 1/2 CW, 1/2 HW TO SINK.
- 3 3/4 CW AND 3/4 HW THROUGHOUT CODE REQUIRED BACKFLOW PREVENTER AND CONNECT TO HOSE REAL MIXING VALVE.
- 4 1/2 CW TO OULETBOX FOR ICE MAKER.
- 5 3/4 CW, 3/4 HW TO 3 COMPARTMENT SINK. ROUTE 3 GSAN FROM WASH COMPARTMENT ROUTE W FROM RINSE AND SANITIZE COMPARTMENT AND TERMINATE AT CODE REQUIRED DISTANCE ABOVE FLOOR SINK.
- 6 3/4 CW, 3/4 HW TO PRE-SPRAY AND FOOD GRINDER.
- 7 1/2 CW, 1/2 HW(140), AND 1/2 HWR(140) THROUGHOUT CODE REQUIRED BACKFLOW PREVENTER. ROUTE W FROM RINSE AND SANITIZE COMPARTMENT AND TERMINATE AT CODE REQUIRED DISTANCE ABOVE FLOOR SINK.
- 8 3/4 CW, 3/4 HW, 1/2 HWR, AND 3 GAS TO UTILITY DISTRIBUTIONS SYSTEM.
- 9 1 CW AND 1 HW TO PENTHOUSE ABOVE.
- 10 4 SAN TO FLOOR DRAIN/SINK.
- 11 TERMINATE CONDENSATE AT CODE REQUIRED DISTANCE ABOVE FLOOR DRAIN/SINK.
- 12 3 SAN FOR FLOOR DRAIN/SINK.

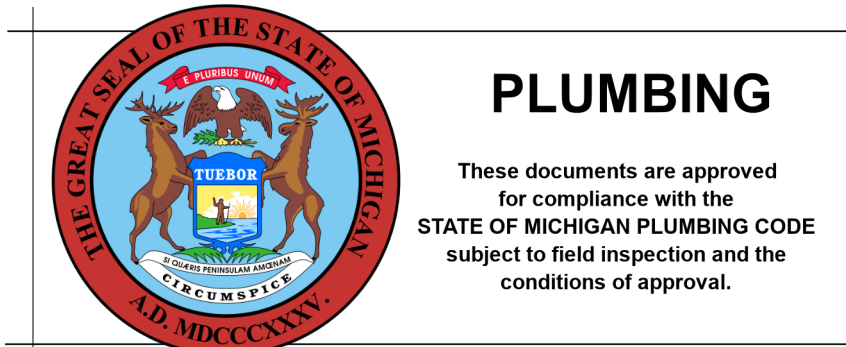


NO.	REVISION	DATE

STATE OF MICHIGAN
DEPARTMENT OF TECHNOLOGY, MANAGEMENT AND BUDGET
FACILITIES AND BUSINESS SERVICES ADMINISTRATION
DESIGN AND CONSTRUCTION DIVISION
ADAM LACH, R.A. DIRECTOR

FILE NO.
491/20167.SDW

FUNDING CODE
171CODHHS7255

CONTRACT NO.
Y22003

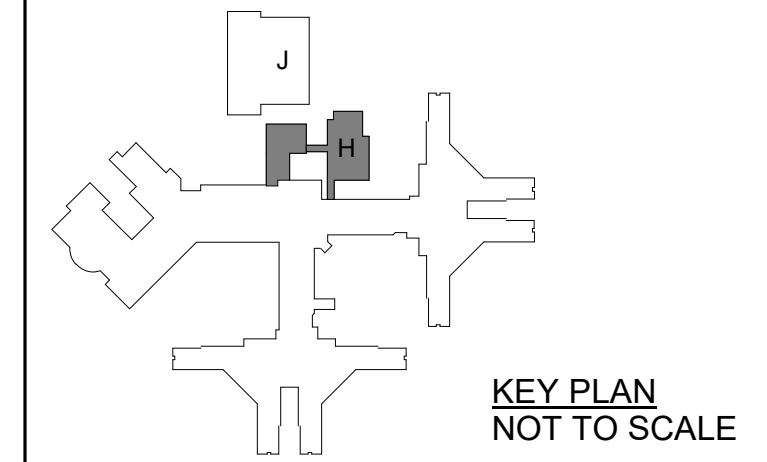

WTA ARCHITECTS

100 S. Jefferson Ave., Suite 601
Saginaw, Michigan 48607
989 752 8107

COPYRIGHT © 2023

PROJECT TITLE
491/20167.SDW - PHASE 500:

CENTER FOR FORENSIC PSYCHIATRY - CREATE KITCHEN

SALINE, MICHIGAN

SHEET TITLE
PLUMBING ENLARGED PLAN


PROJECT NUMBER
2021094

SHEET NUMBER

PROJECT DATE
SEPTEMBER 6, 2023


M5.01

CHECKED BY
WEK

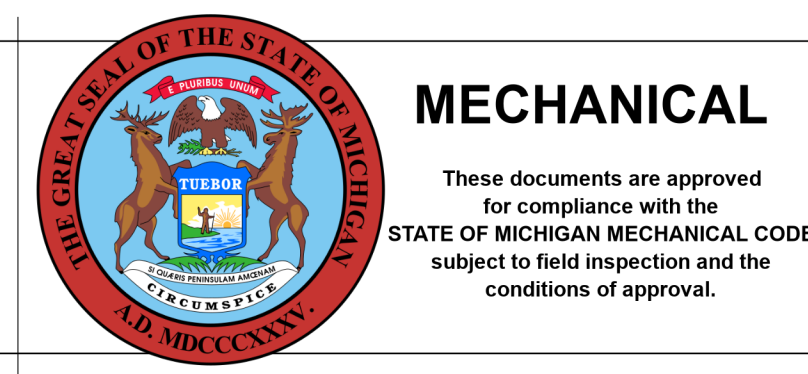


PBA
Peter Basso Associates Inc
CONSULTING ENGINEERS
5145 Livernois, Suite 100
Troy, Michigan 48068-3276
Tel: 248-879-5666
Fax: 248-879-0007
www.PeterBassoAssociates.com
PBA Project No. 303-0402

THE FOLLOWING DIMENSION EQUALS ONE INCH WHEN PRINTED TO SCALE.

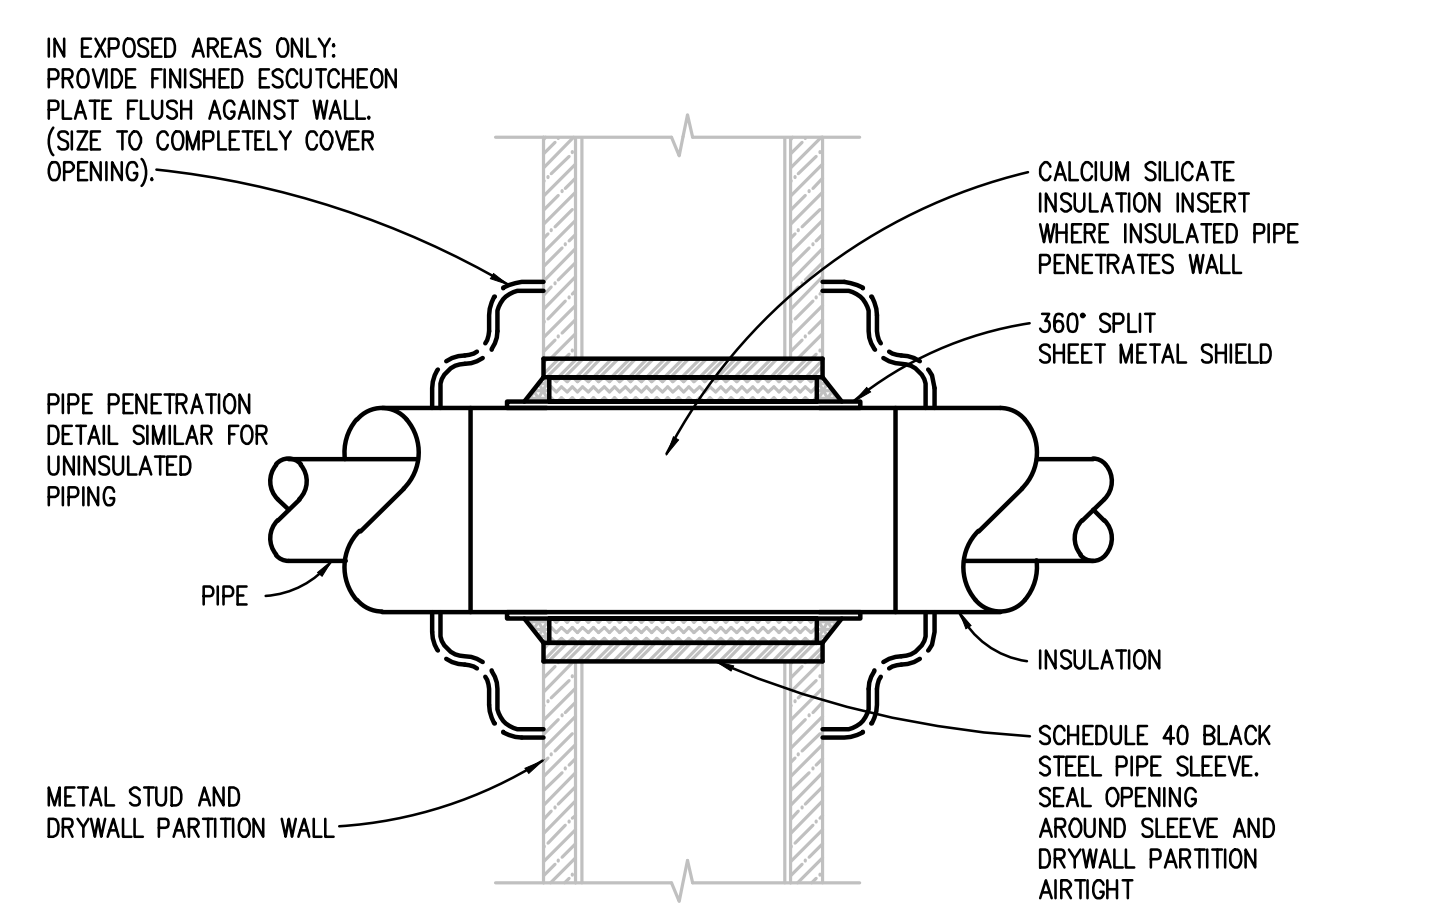


FIRE RATED AND NON-FIRE RATED METAL STUD AND DRYWALL PARTITION WALL PIPE PENETRATION DETAIL
NO SCALE

DETAIL INDICATES THE INSTALLATION REQUIREMENTS FOR A FIRE RATED ASSEMBLY. FOR A NON-FIRE RATED ASSEMBLY PACK SLEEVED OPENING WITH INSULATION MATERIAL AND CAULK WITH NON-HARDENING SEALANT.

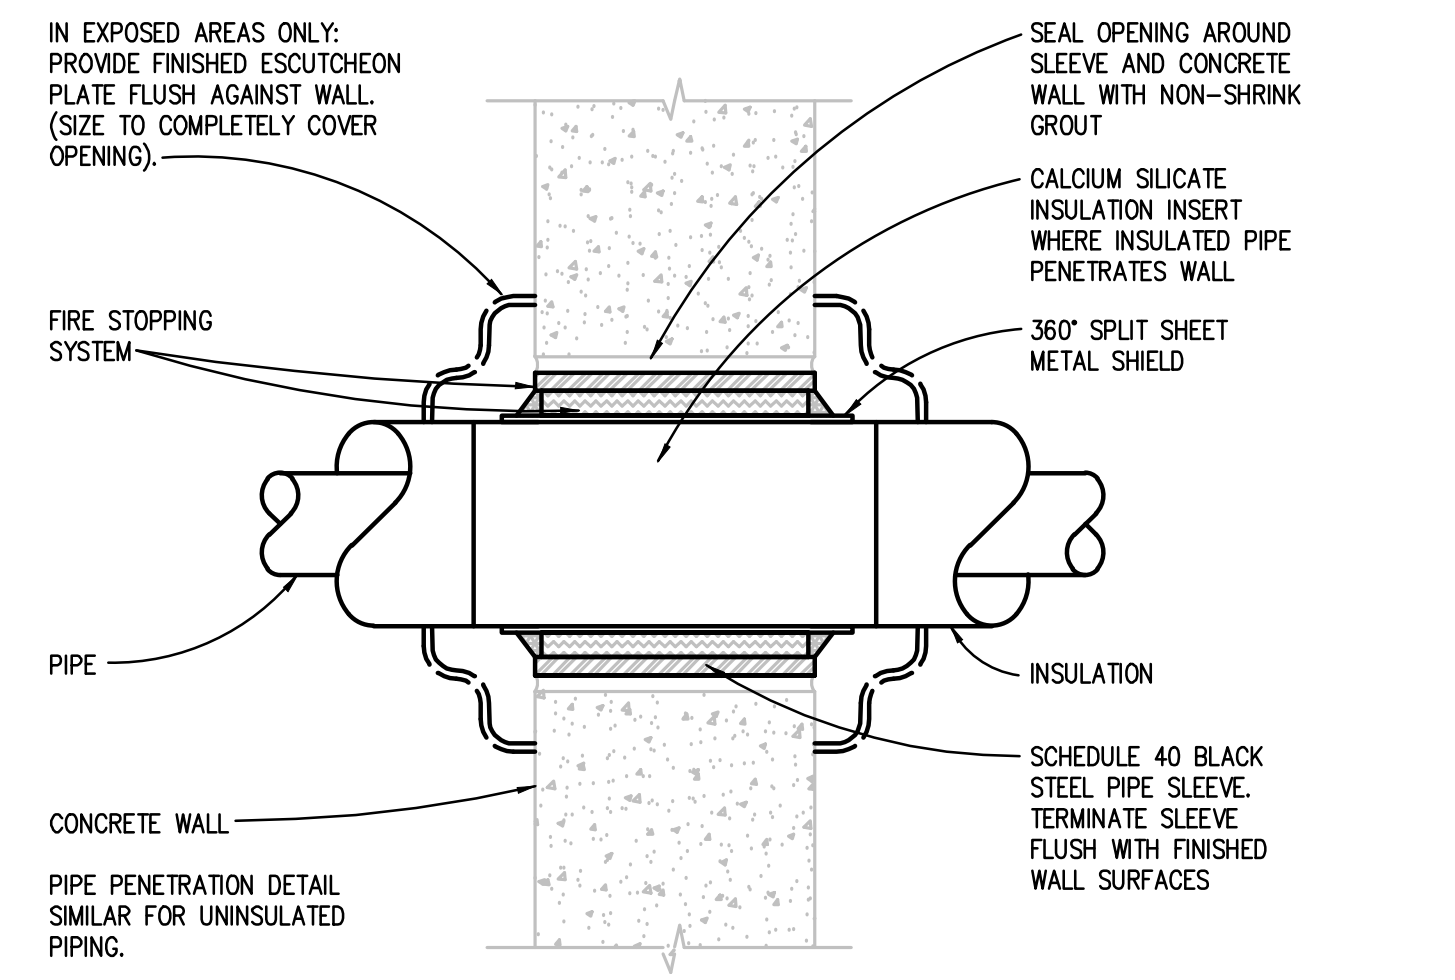


FIRE RATED AND NON-FIRE RATED POURED CONCRETE OR BLOCK WALL PIPE PENETRATION DETAIL
NO SCALE


DETAIL INDICATES THE INSTALLATION REQUIREMENTS FOR A FIRE RATED ASSEMBLY. FOR A NON-FIRE RATED ASSEMBLY PACK SLEEVED OPENING WITH INSULATION MATERIAL AND CAULK WITH NON-HARDENING SEALANT.

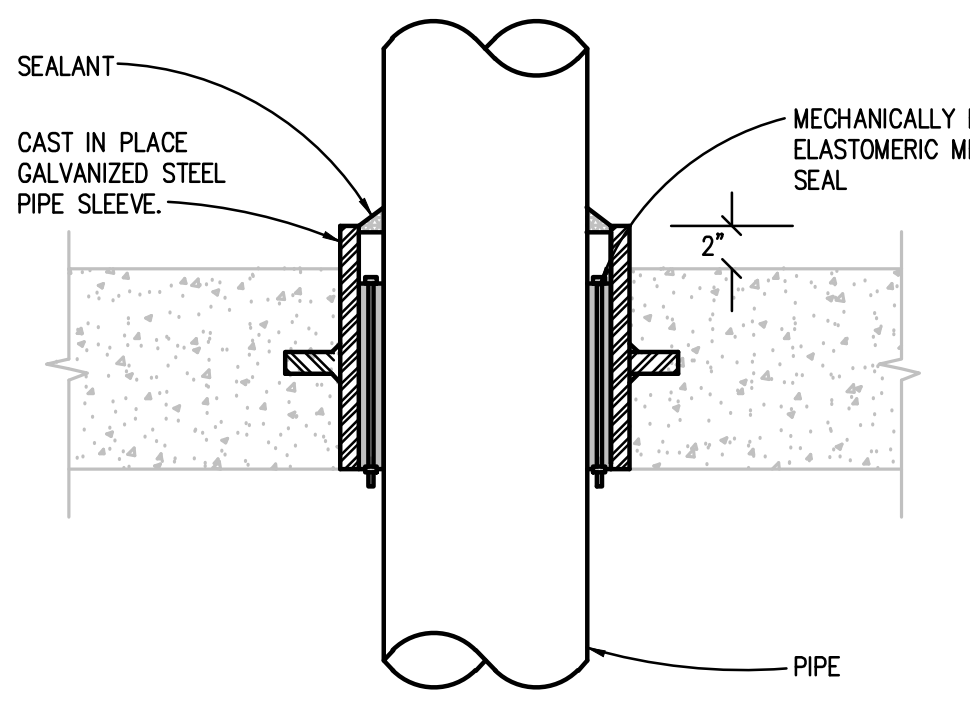


NEW SLAB ON GRADE FLOOR PIPE PENETRATION DETAIL
NO SCALE

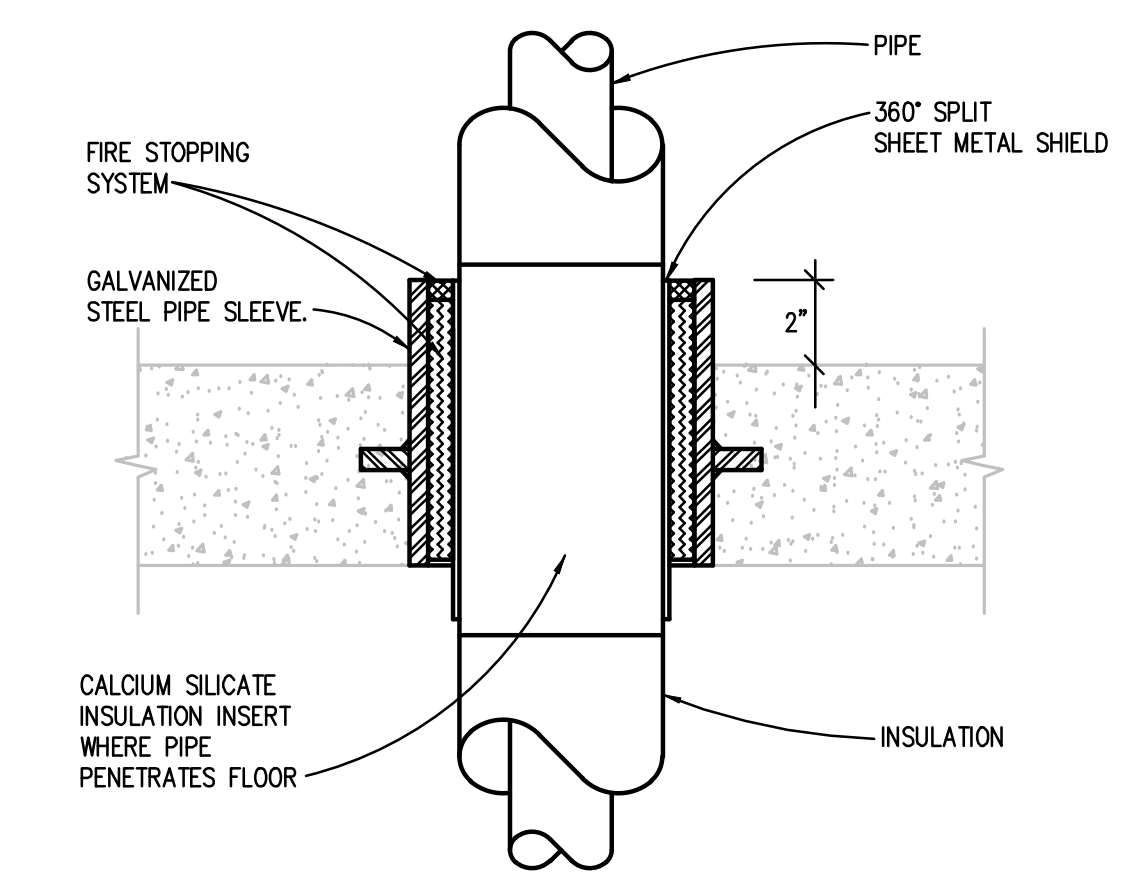


NEW FLOOR PIPE PENETRATION DETAIL
NO SCALE

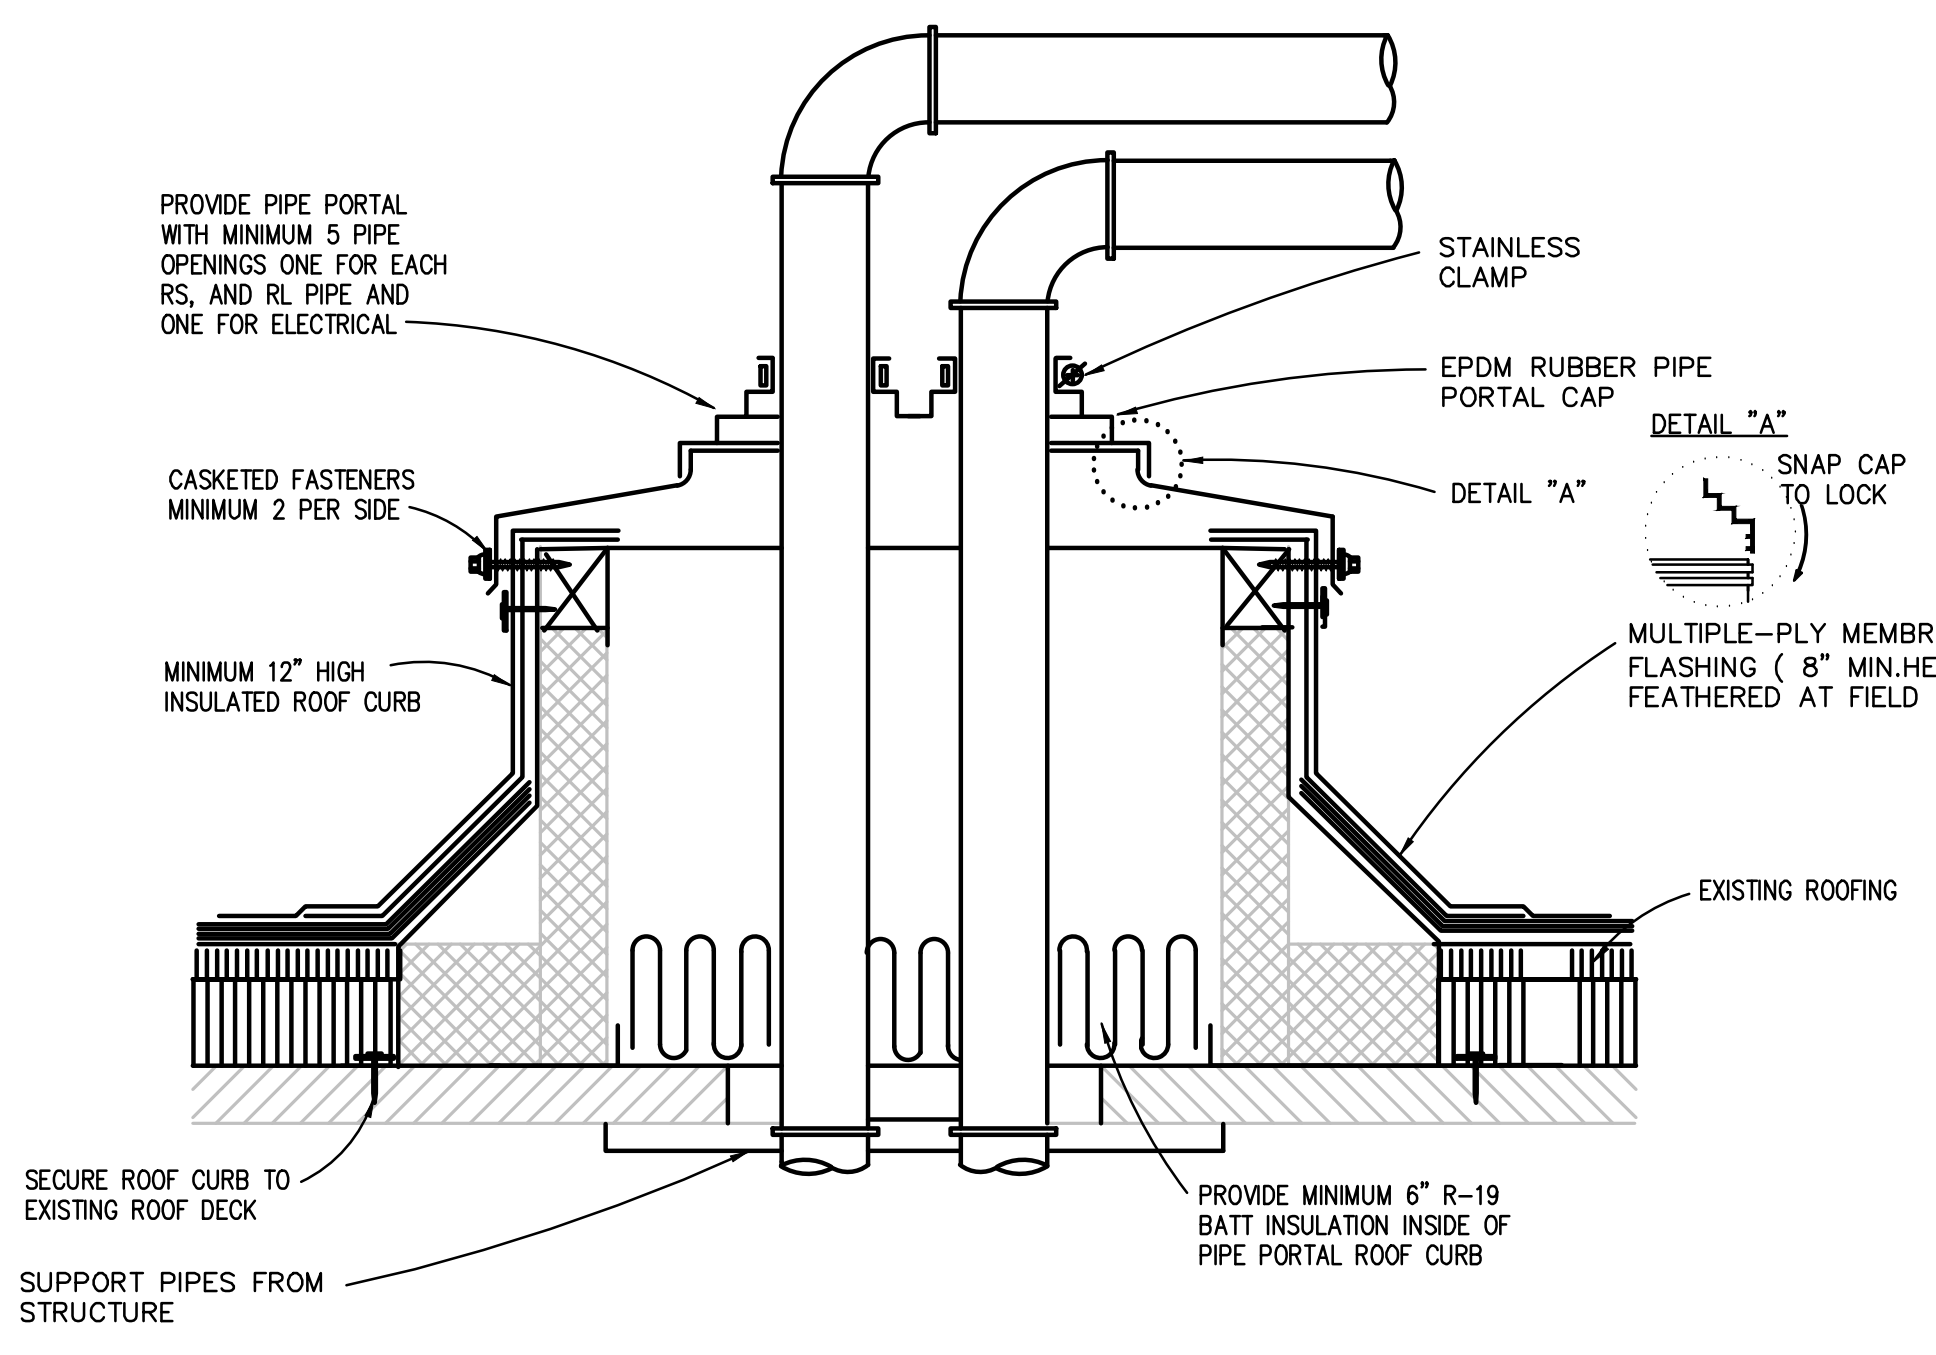


CONDENSING UNIT PIPE PORTAL DETAIL
NO SCALE

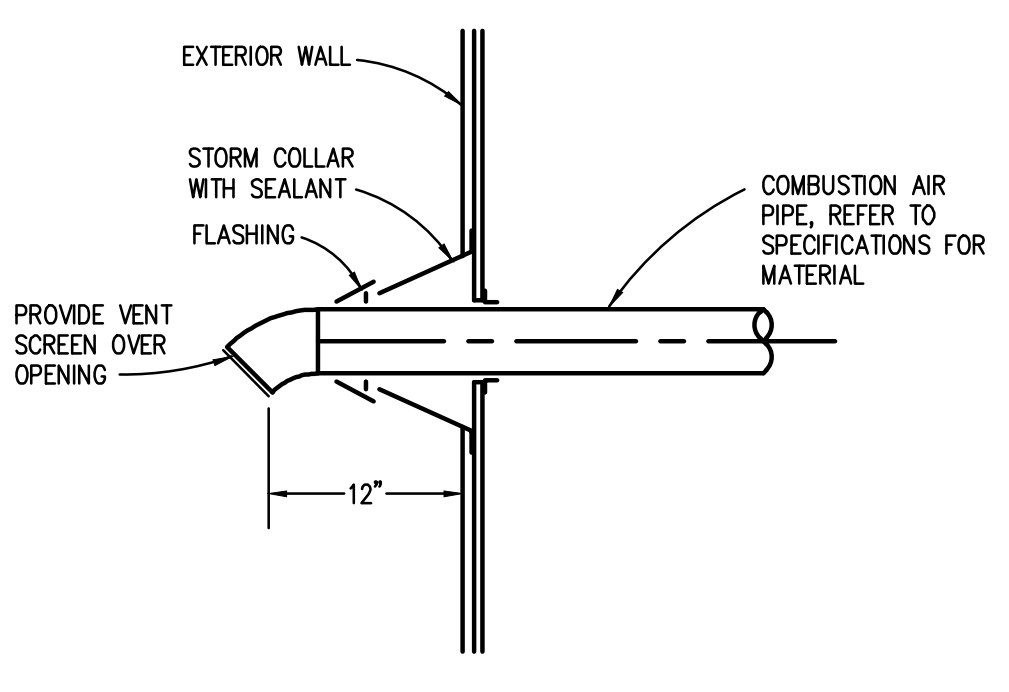

COMBUSTION AIR INTAKE DETAIL
NO SCALE

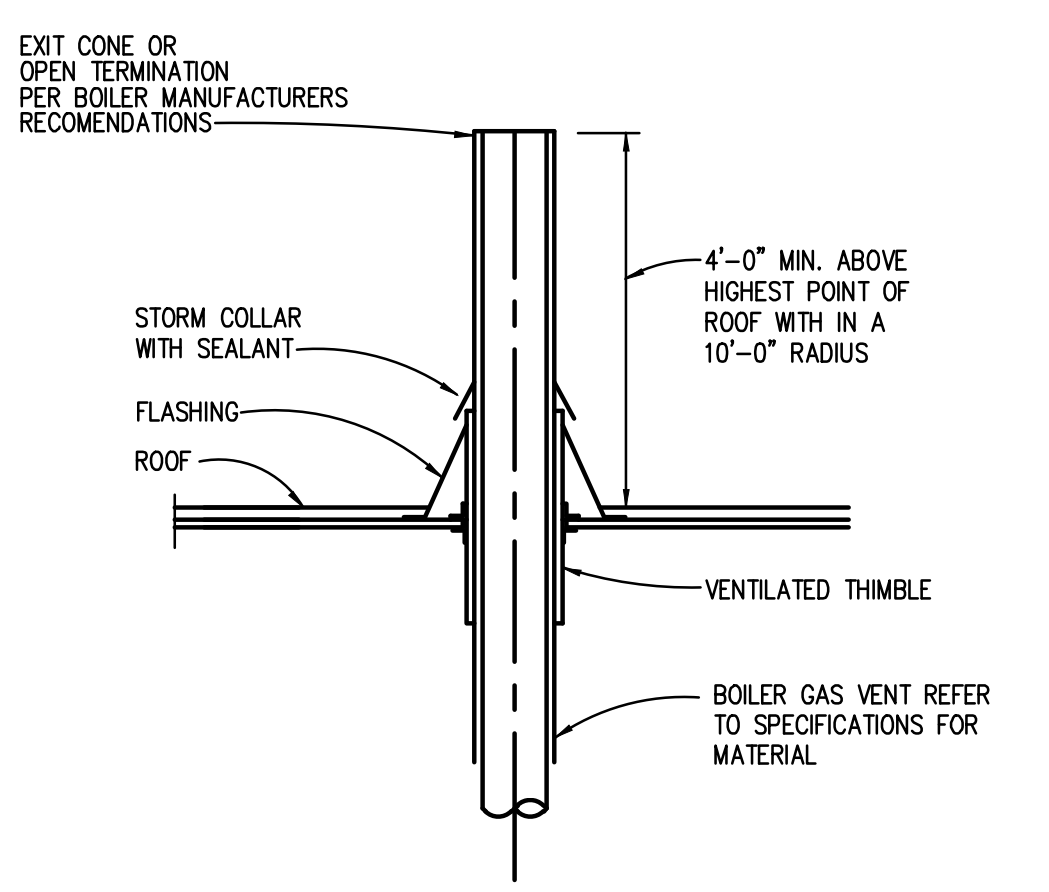

FLUE THRU ROOF DETAIL
NO SCALE

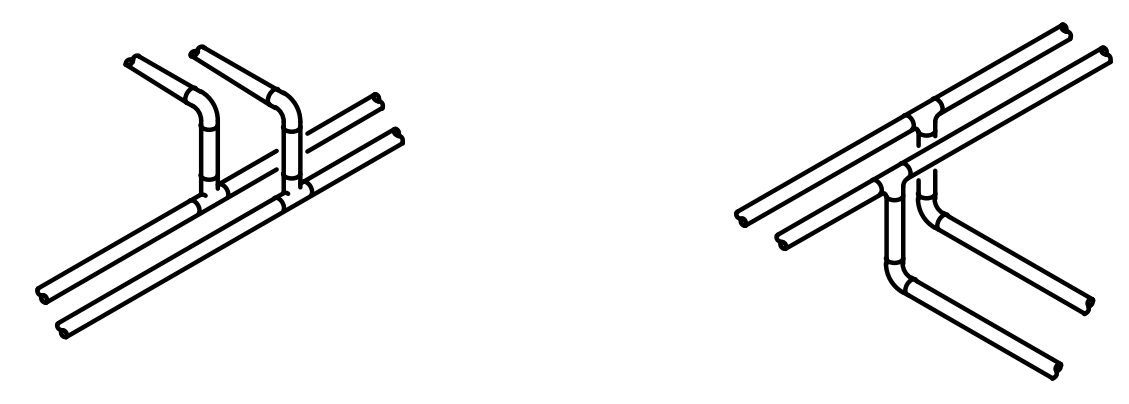


TYPICAL BRANCH TAKE-OFF CONNECTION PIPING DETAIL
NO SCALE

APPLIES TO THE FOLLOWING SYSTEMS:
DOMESTIC WATER
NATURAL GAS

APPLIES TO THE FOLLOWING SYSTEMS:
HOT WATER HEATING

NOTE: BOTTOM AS INDICATED OR SIDE CONNECTION IS ACCEPTABLE. CONNECTION ABOVE CENTERLINE OF MAINS IS NOT ACCEPTABLE.

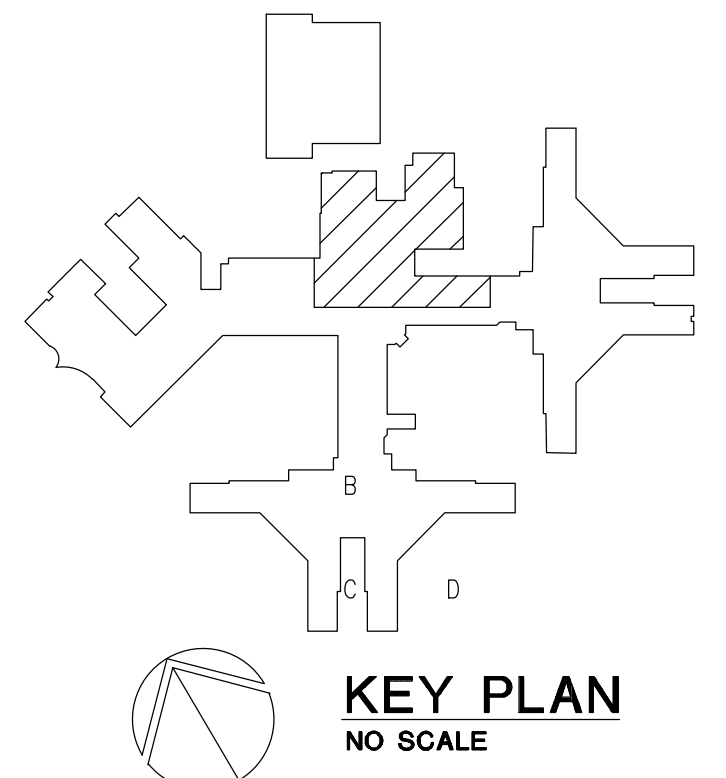

KEY PLAN
NO SCALE

1	OWNER REVIEW	08/02/23
NO.	REVISION	DATE

STATE OF MICHIGAN
DEPARTMENT OF TECHNOLOGY, MANAGEMENT AND BUDGET
FACILITIES AND BUSINESS SERVICES ADMINISTRATION
DESIGN AND CONSTRUCTION DIVISION
ADAM LACH, RA, DIRECTOR

FILE NO.
49120167.SDW

FUNDING CODE
171CODHHS7255

CONTRACT NO.
Y22003

WTA ARCHITECTS
100 S. Jefferson Ave., Suite 601
Saginaw, Michigan 48607
989 752 8107
COPYRIGHT © 2023

PROJECT TITLE
49120167.SDW - PHASE 500:
CENTER FOR FORENSIC
PSYCHIATRY - CREATE
KITCHEN
SALINE, MICHIGAN

SHEET TITLE
MECHANICAL DETAILS



PROJECT NUMBER
2021094

SHEET NUMBER

PROJECT DATE
AUGUST 23, 2023



M6.02

CHECKED BY
WEK

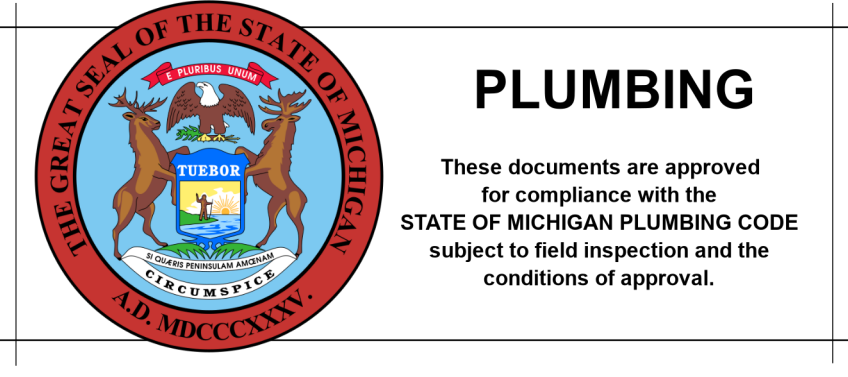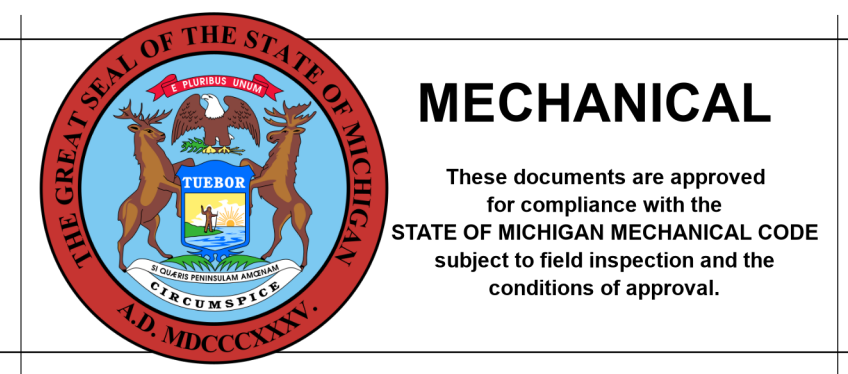


g:\2021\2021-0402-00\CA0\2021-0402-ME-DT.dwg, M-602, 9/5/2023, 4:32:46 PM, Gerard Henrich, Peter Basso Associates Inc.

THE FOLLOWING DIMENSION EQUALS ONE INCH WHEN PRINTED TO SCALE.

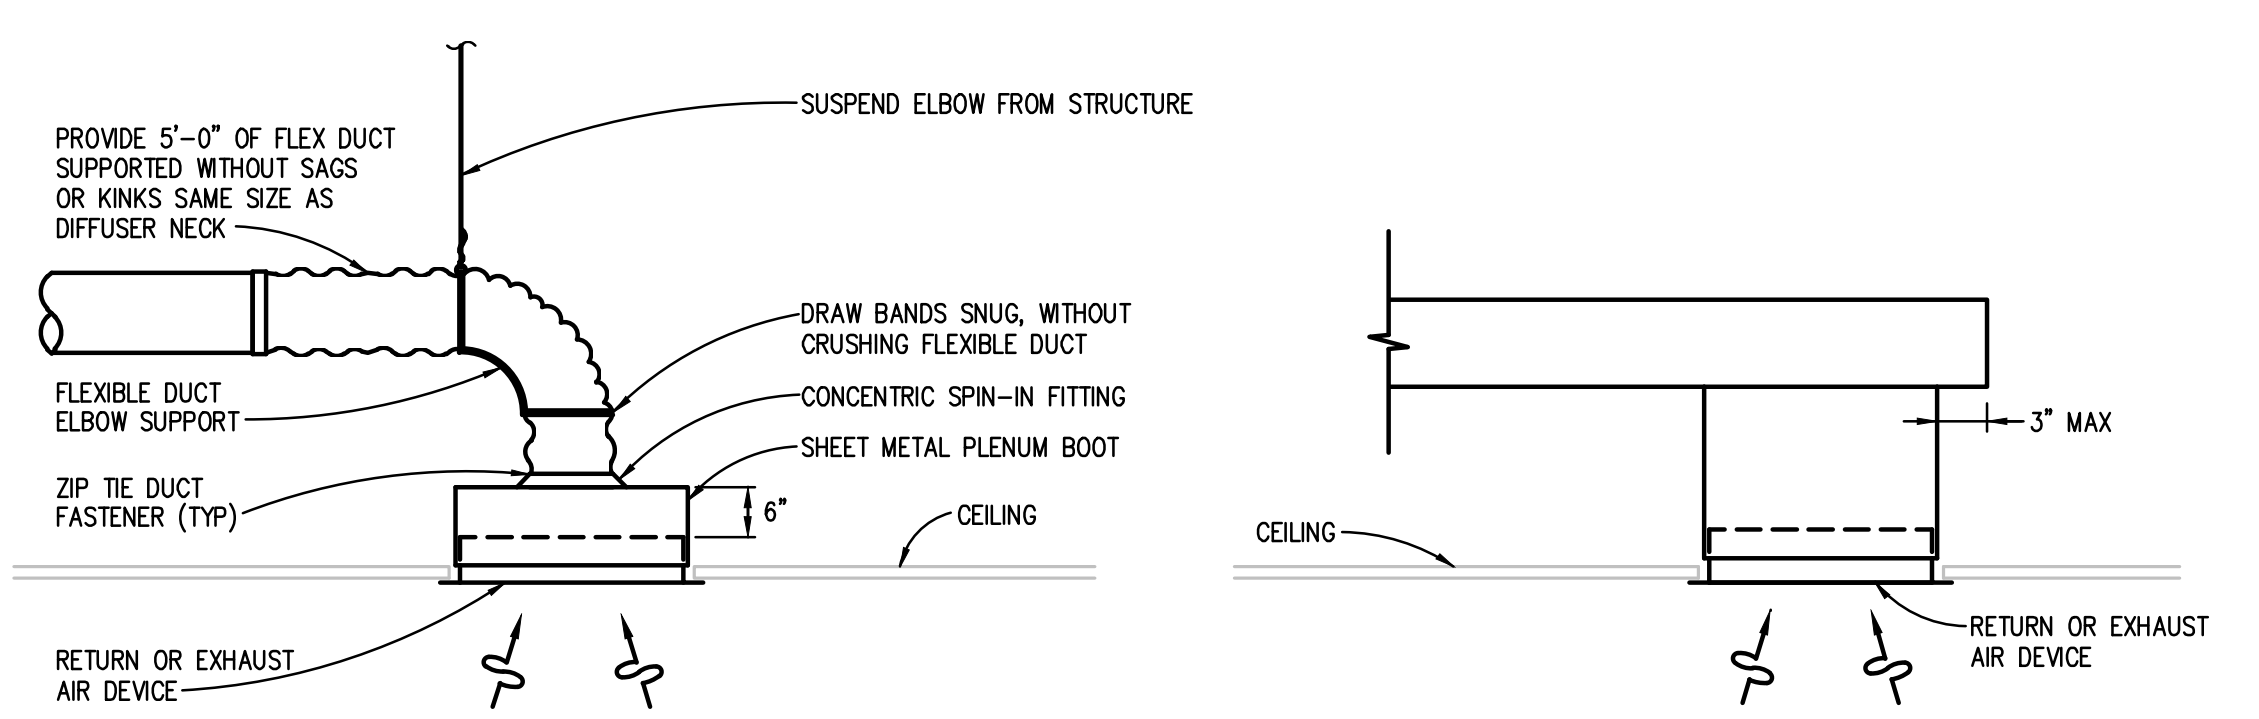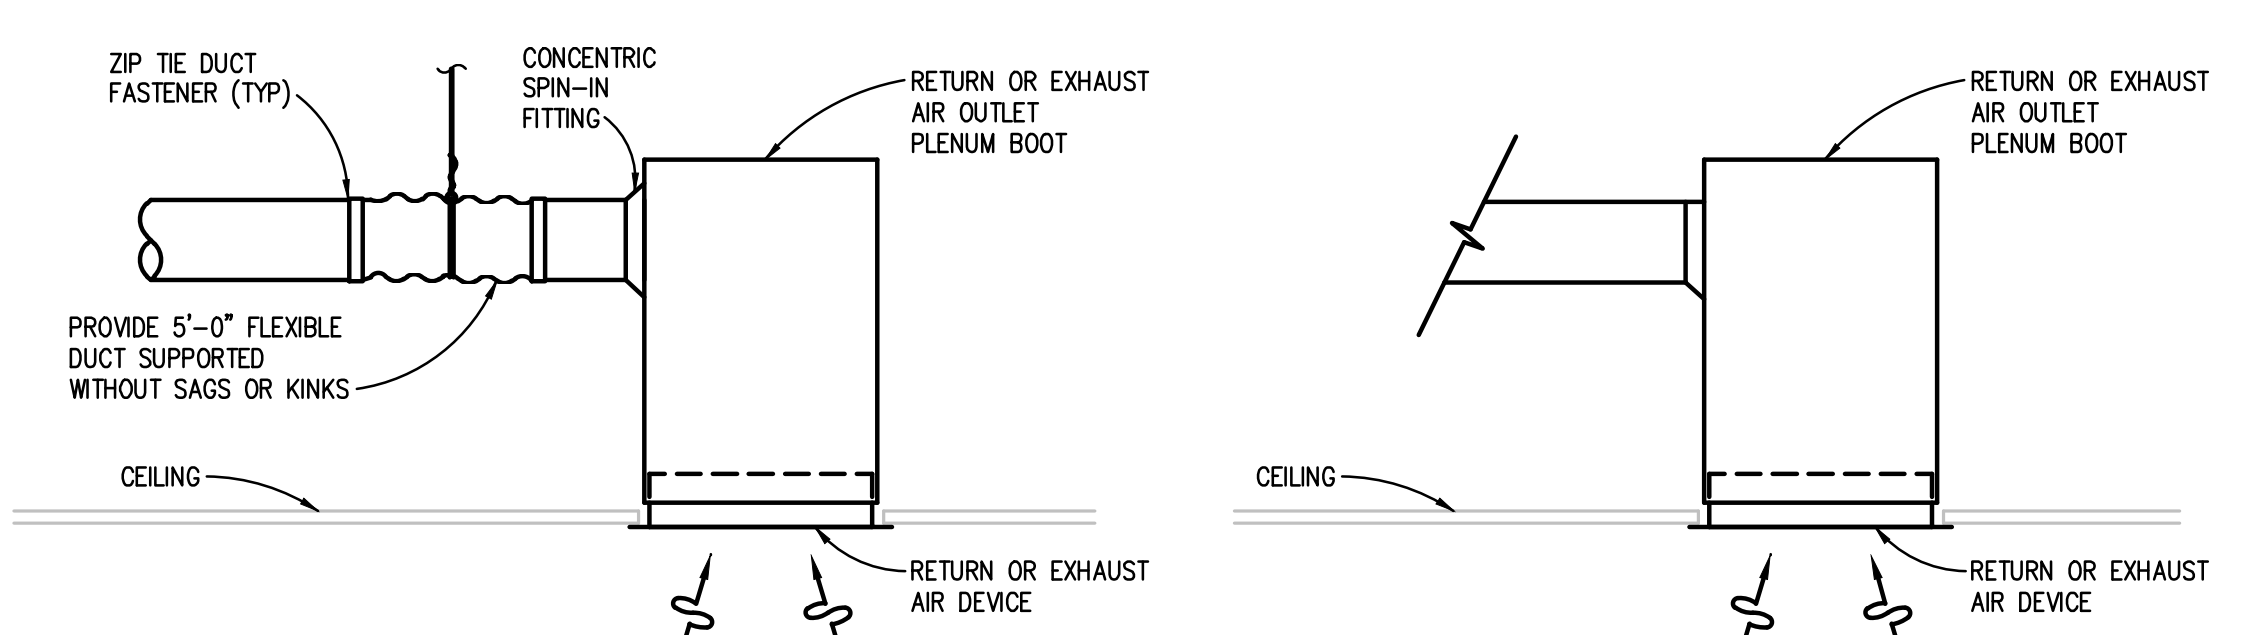


RETURN OR EXHAUST AIR DEVICE INSTALLATION DETAIL
NO SCALE

NOTE: PAINT INTERIOR SURFACE OF PLENUM BOX FLAT BLACK.

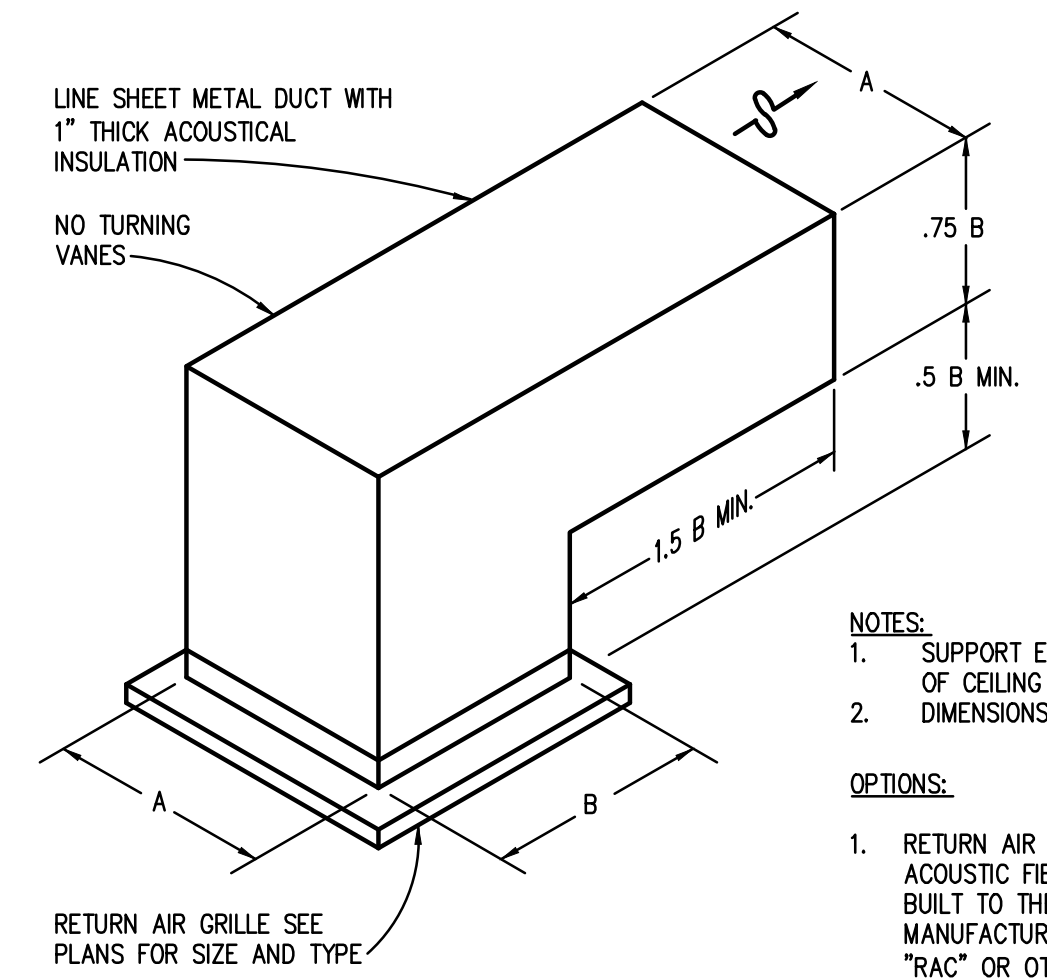

- NOTES:**
- SUPPORT ELBOW INDEPENDENT OF CEILING GRID DIMENSIONS ARE INSIDE CLEAR
- OPTIONS:**
- RETURN AIR CANOPY, GALVANIZED STEEL WITH ACOUSTIC FIBERGLASS LINER. UNIT SHALL BE BUILT TO THE RETURN GRILLE SIZE AS MANUFACTURED BY PRICE INDUSTRIES-MODEL "TRAC" OR OTHER APPROVED.
 - RIGID FIBER BOARD IN LIEU OF LINED SHEET METAL DUCT.

CEILING GRILLE TO/FROM PLENUM

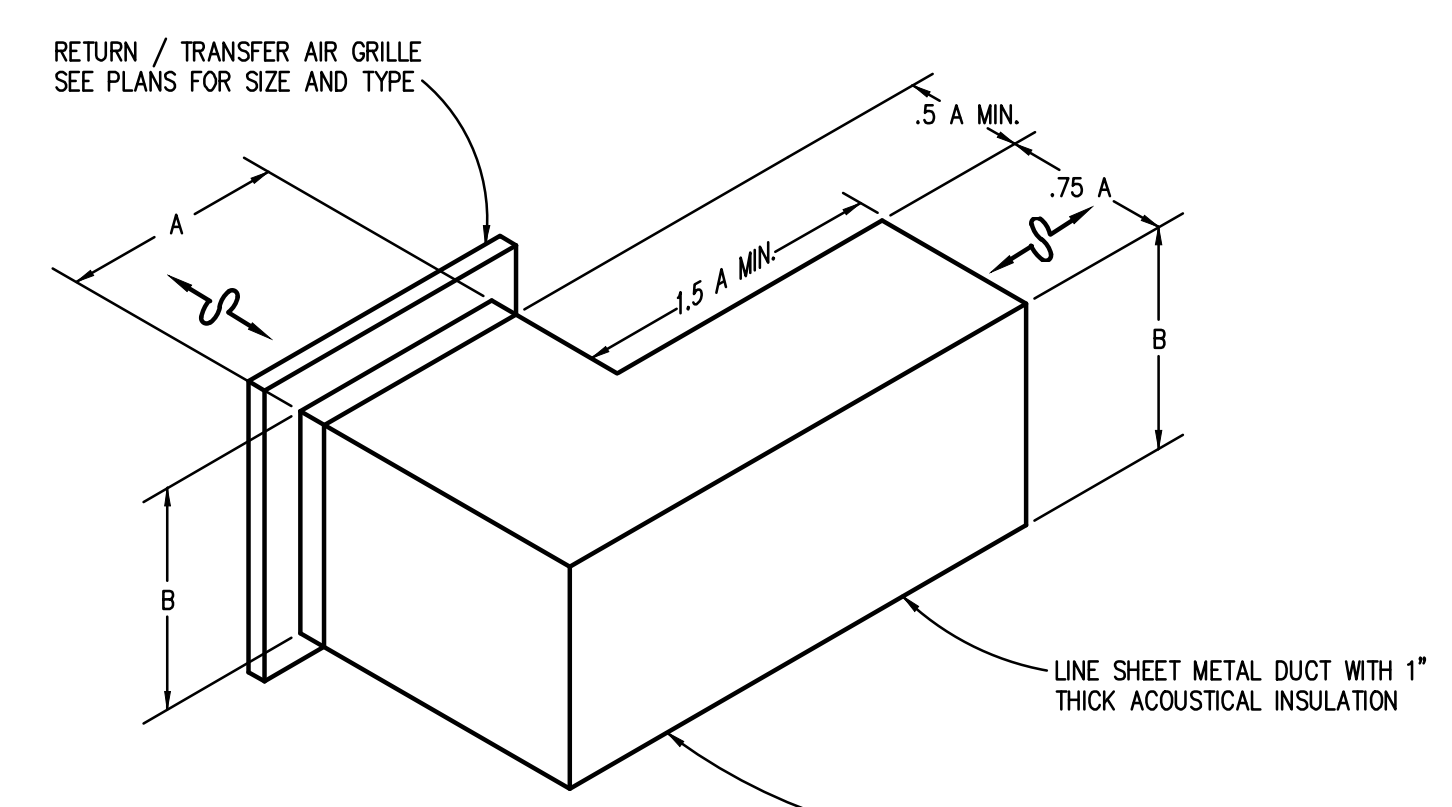


NOTE: DIMENSIONS ARE INSIDE CLEAR.


OPTIONAL: RIGID FIBER BOARD IN LIEU OF LINED SHEET METAL DUCT.

PLENUM TO / FROM WALL GRILLE



PLENUM RETURN AIR GRILLE DETAILS
NO SCALE

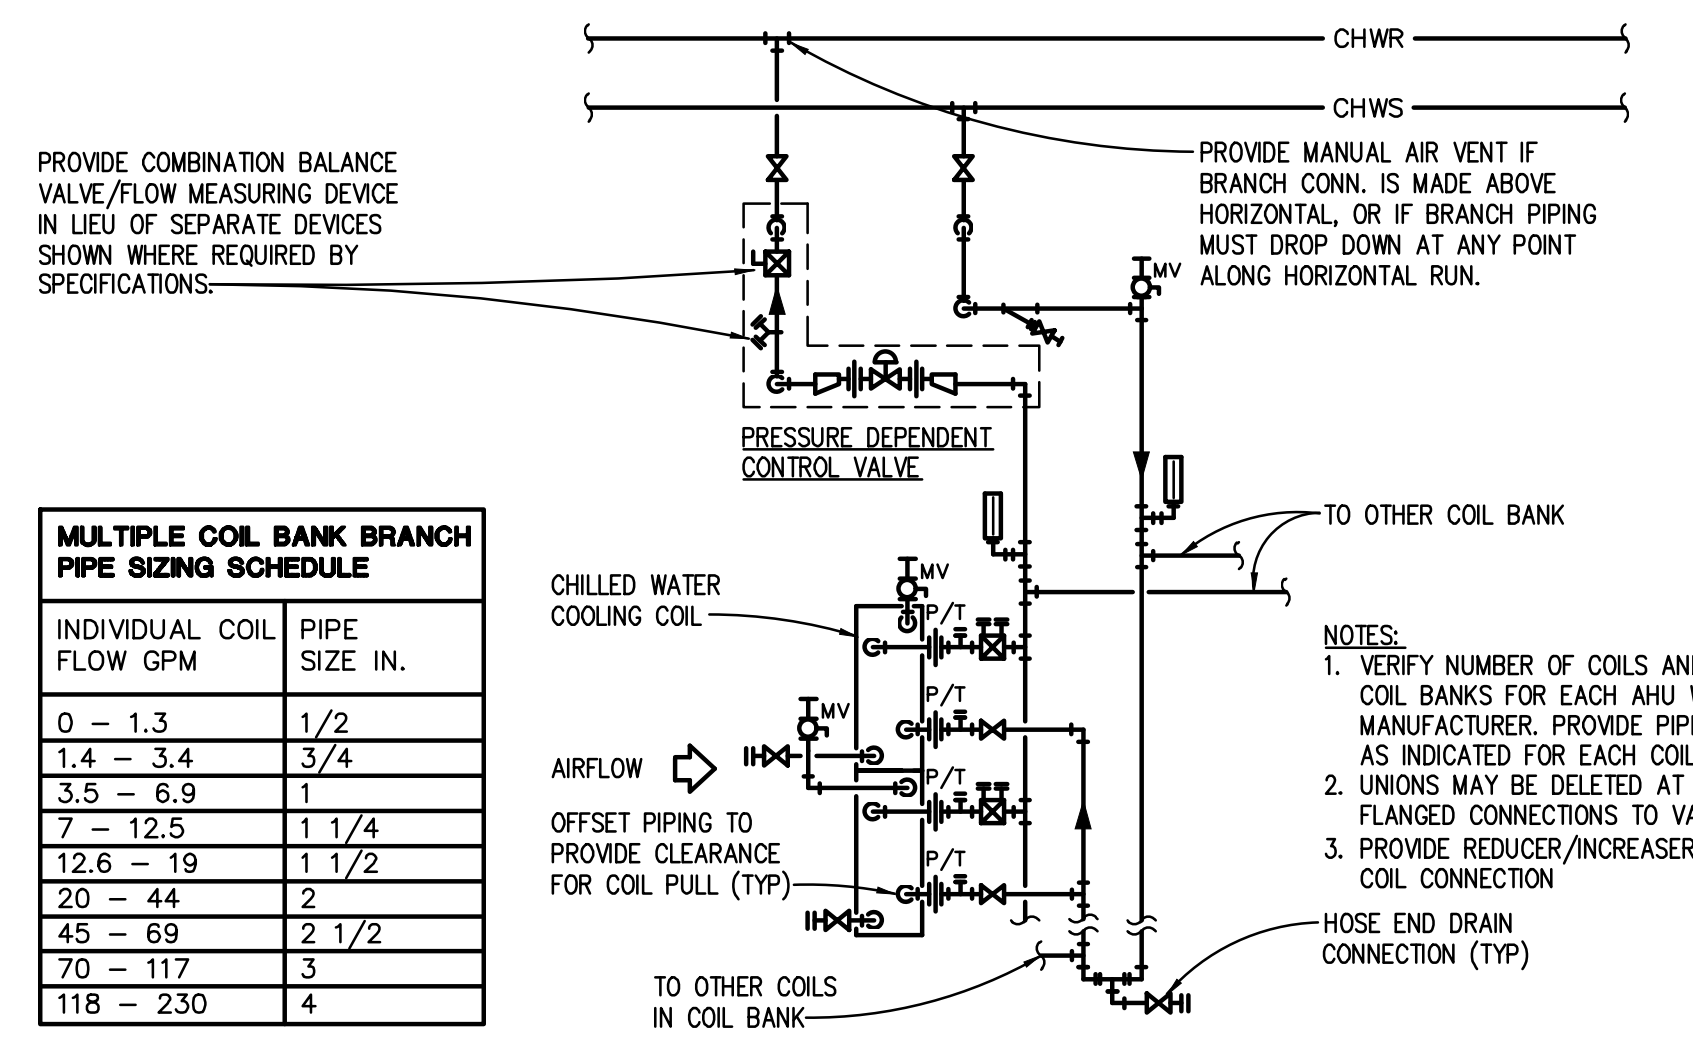


AHU CHILLED WATER COOLING COIL WITH TWO-WAY CONTROL VALVE PIPING DIAGRAM
NO SCALE

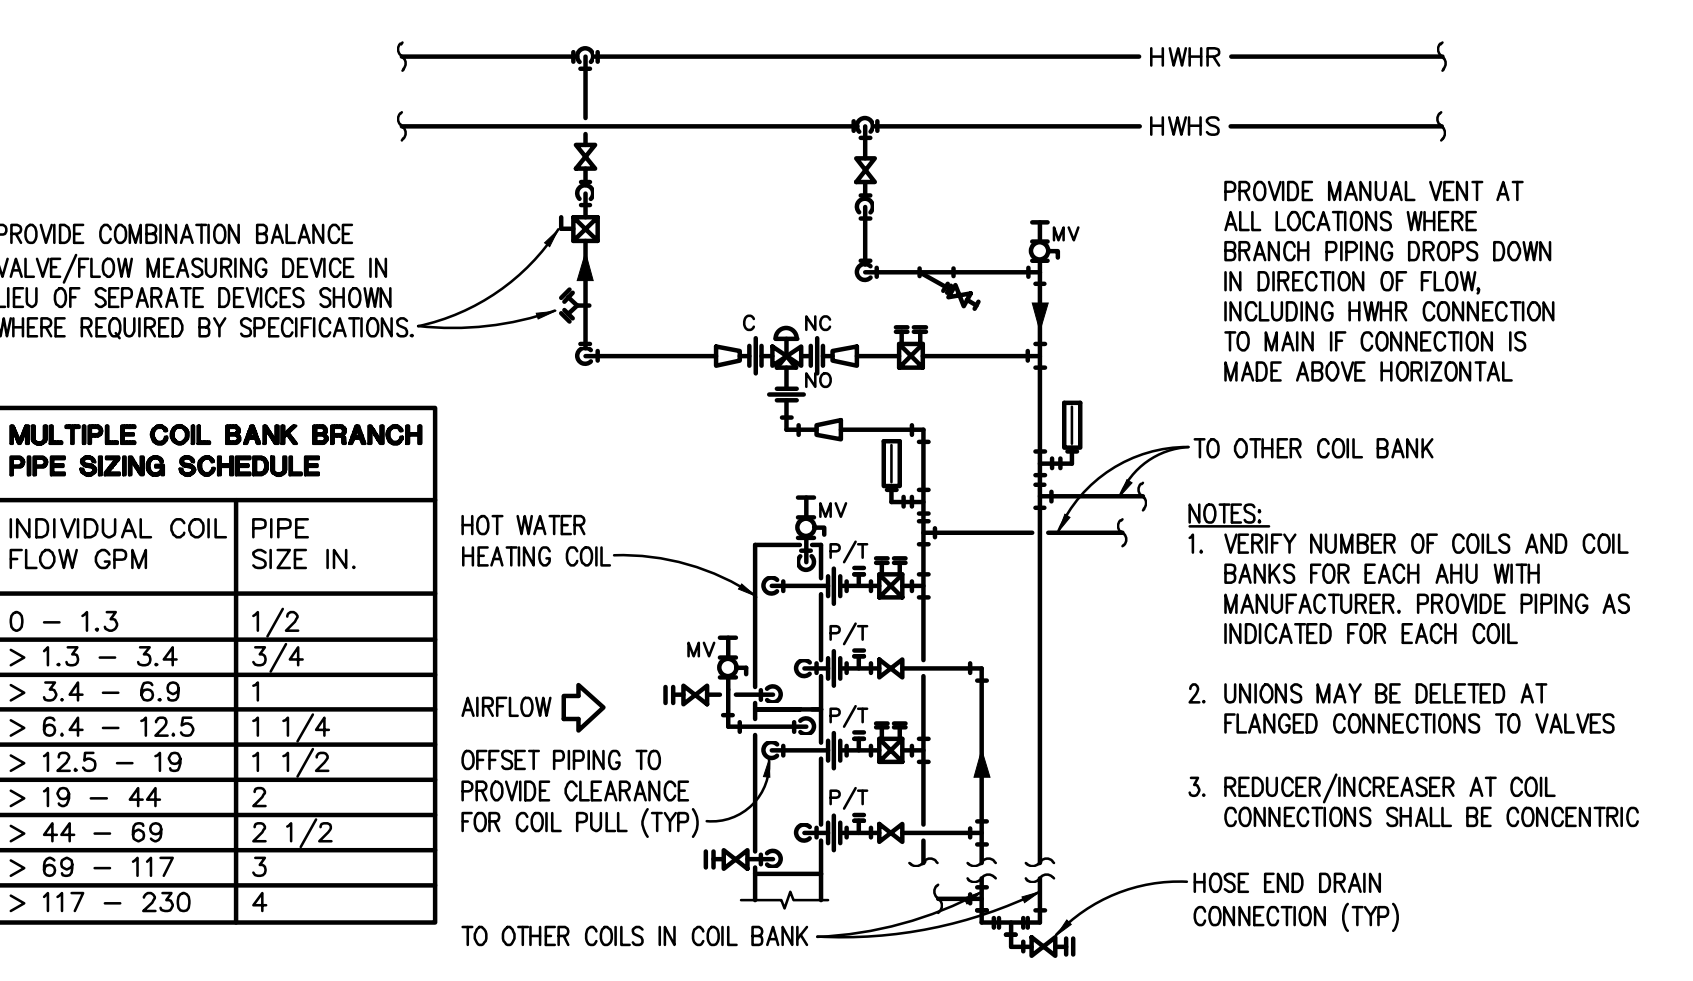


AHU HOT WATER HEATING COIL PIPING DIAGRAM
NO SCALE

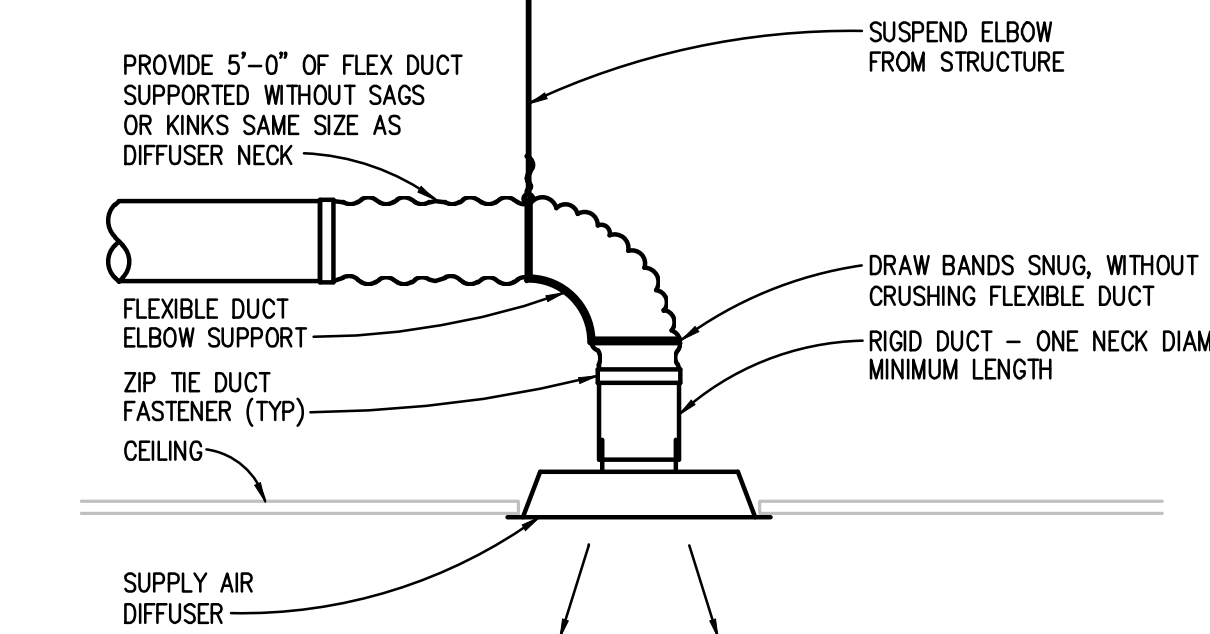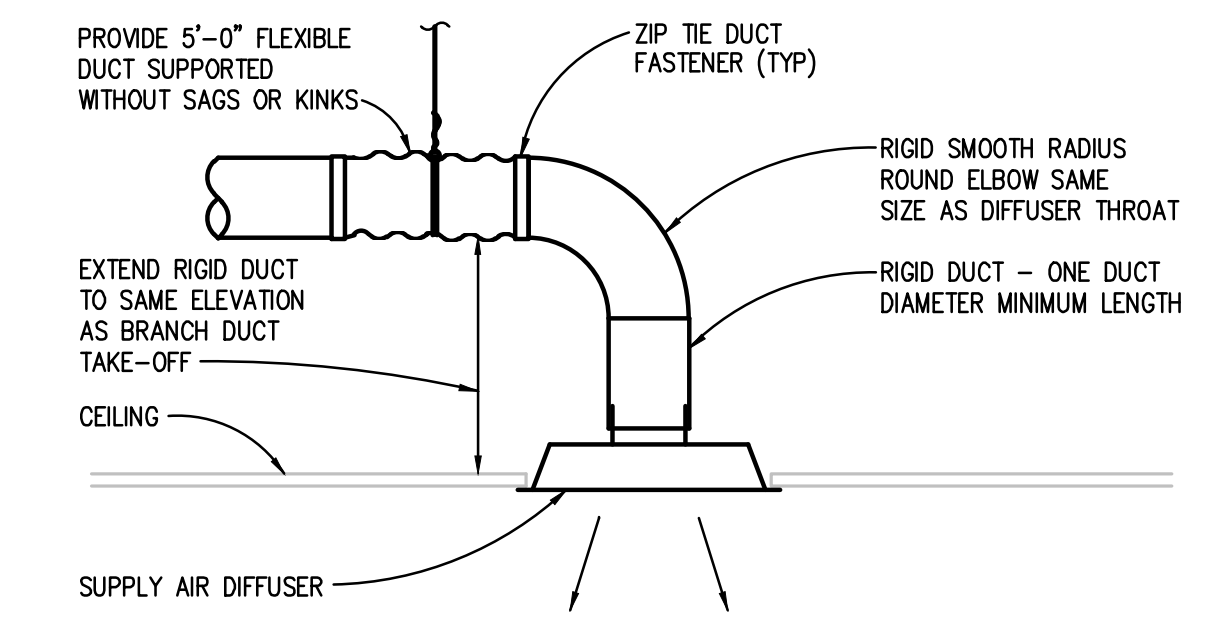


ROUND NECK SUPPLY AIR DIFFUSER DETAIL
NO SCALE

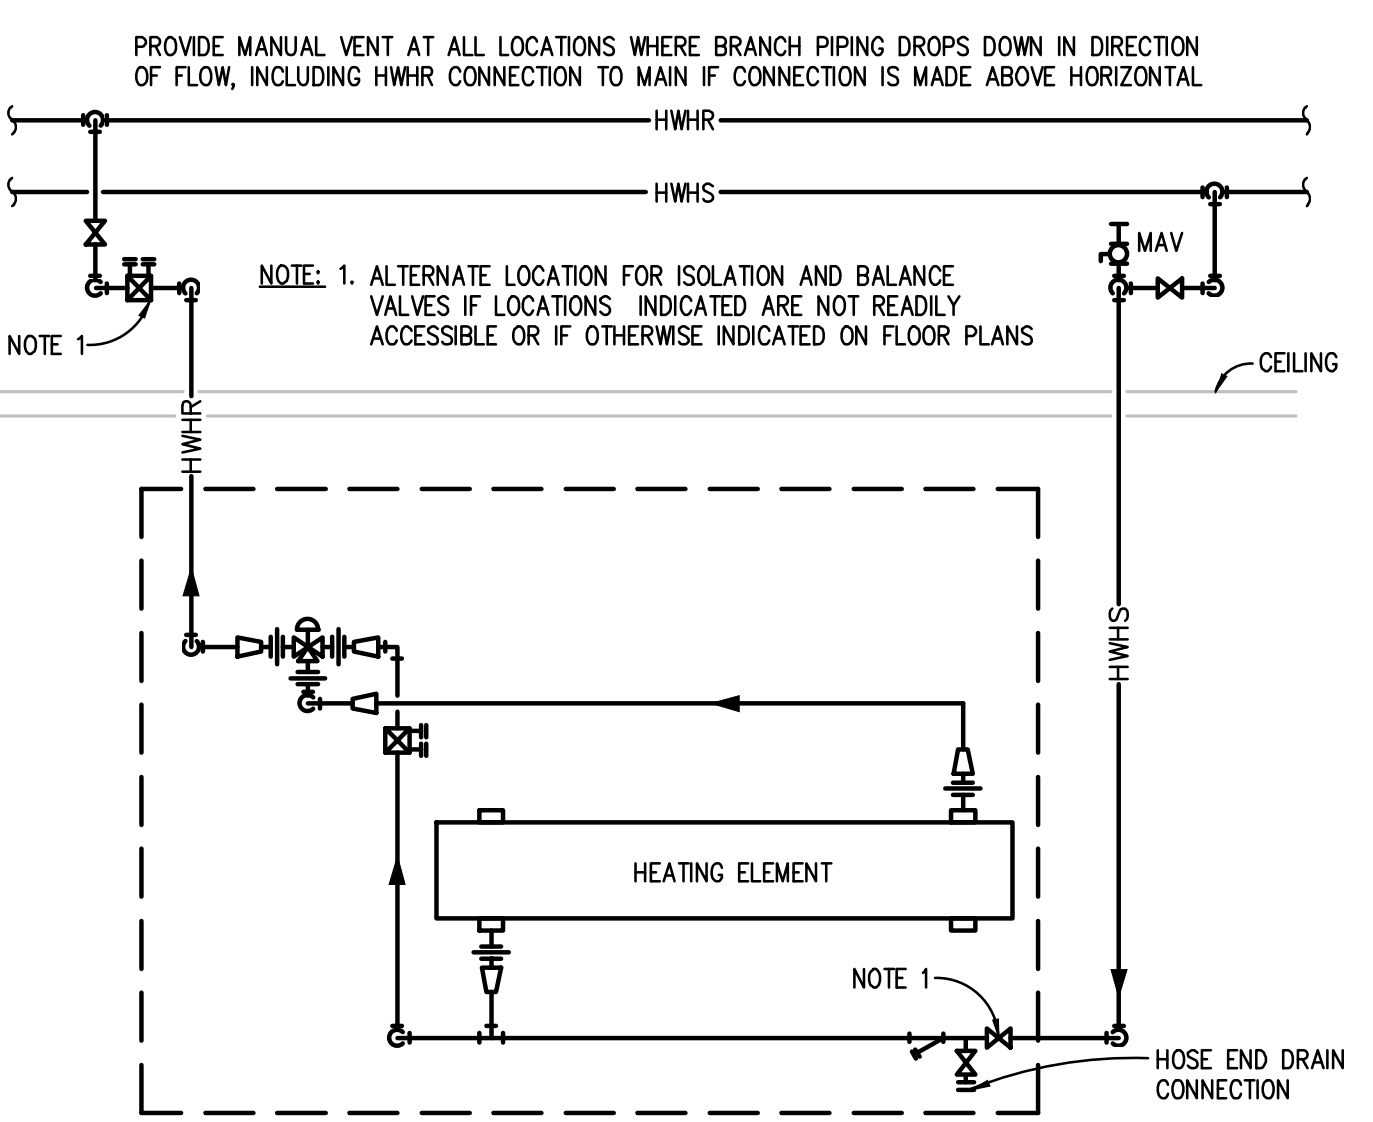


DOWNFEED CONV. OR CUH WITH THREE WAY CONTROL VALVE PIPING DIAGRAM
NO SCALE

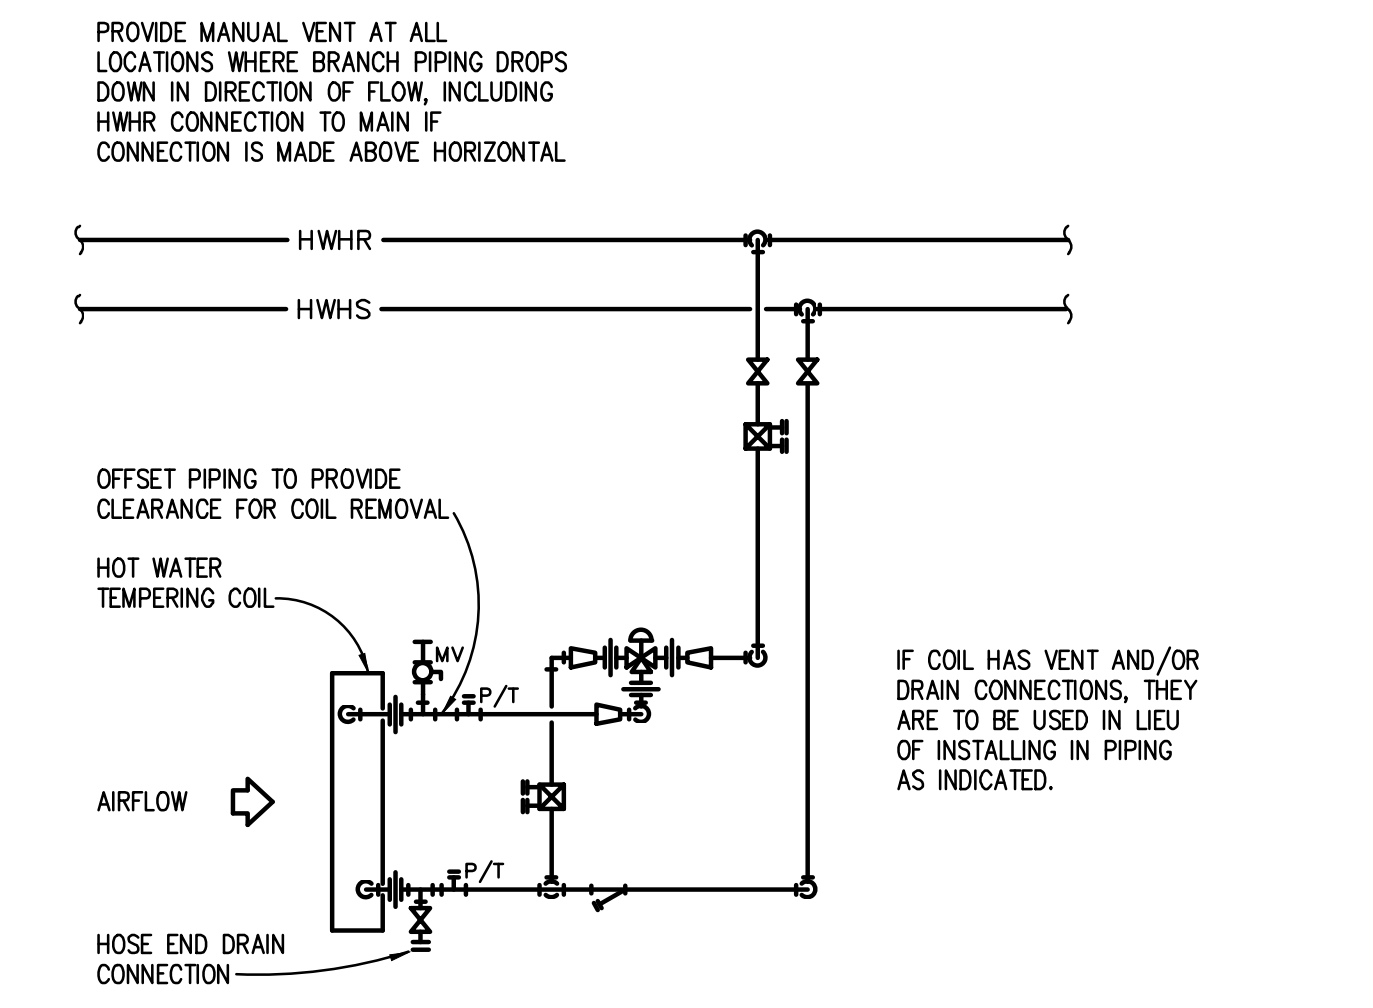


HOT WATER TEMPERING COIL WITH THREE-WAY CONTROL VALVE PIPING DIAGRAM
NO SCALE

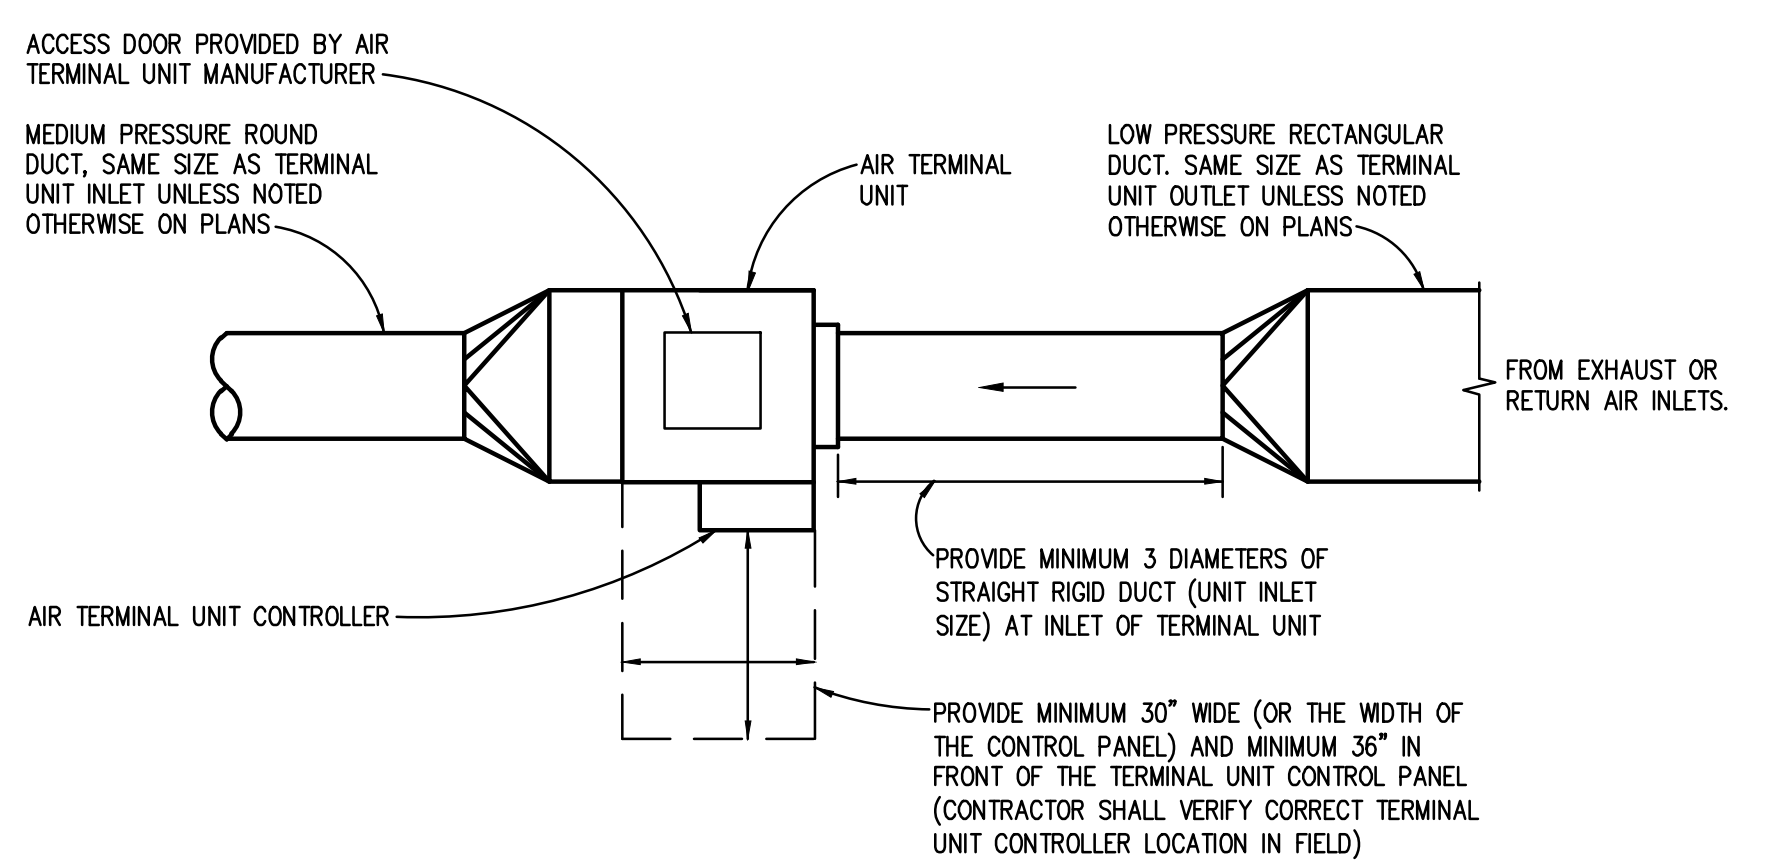

EXHAUST TU CONFIGURATION

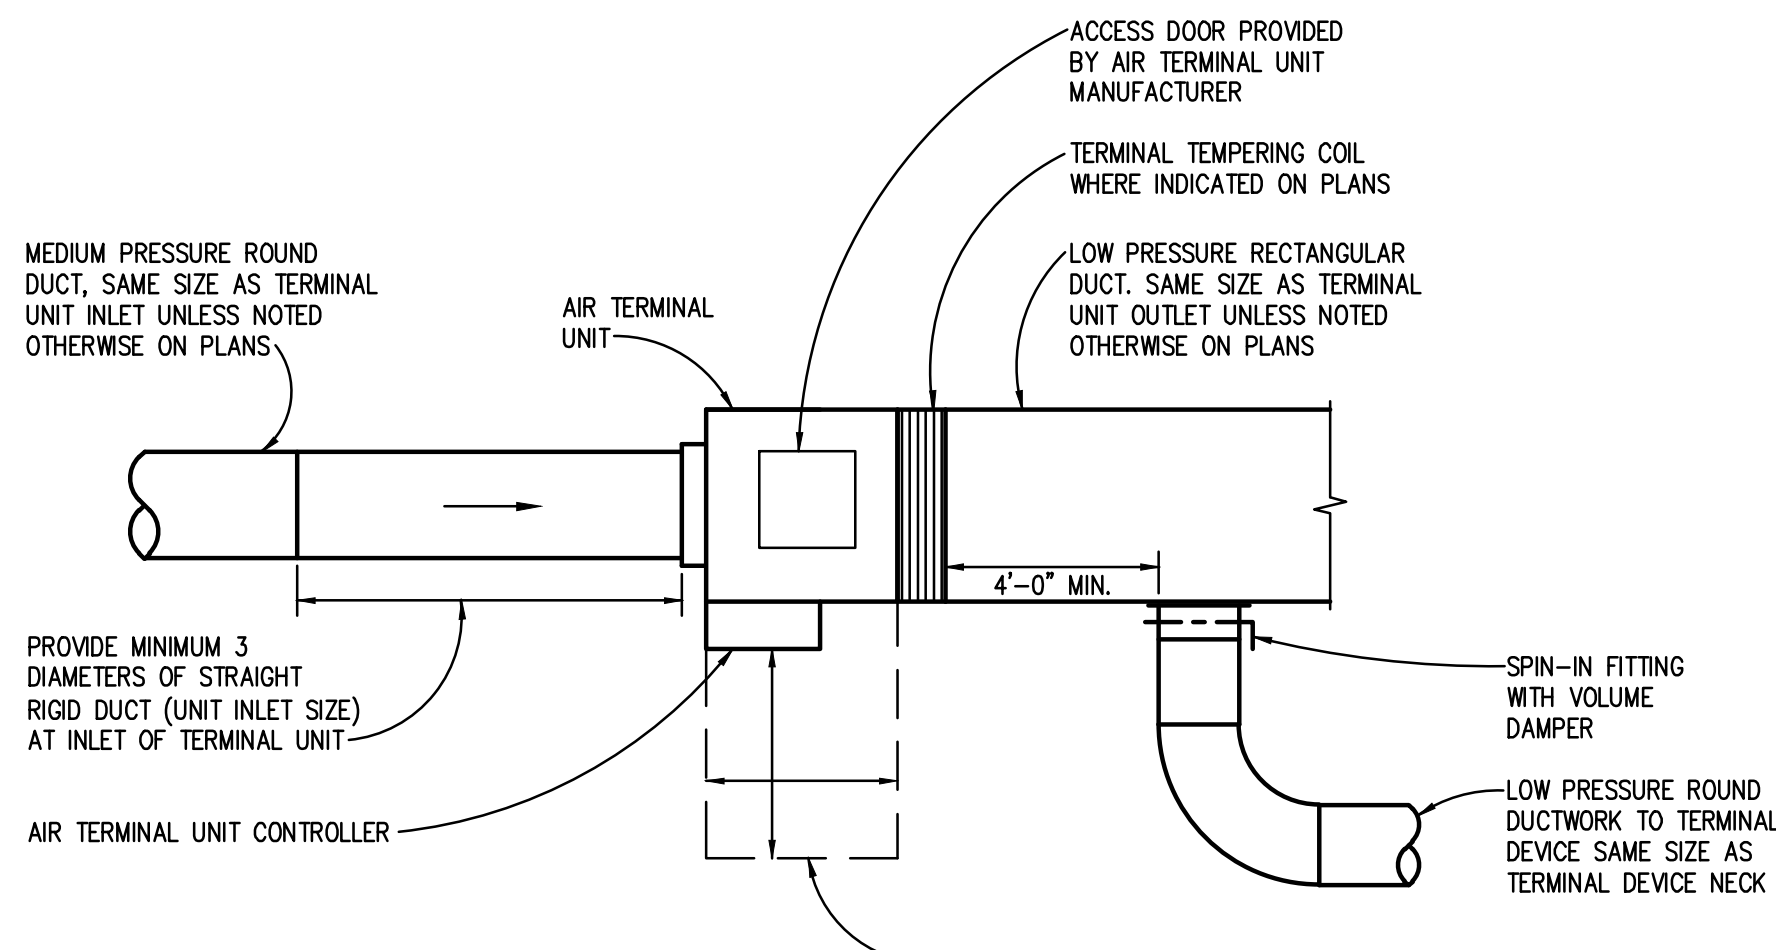


SUPPLY TU CONFIGURATION

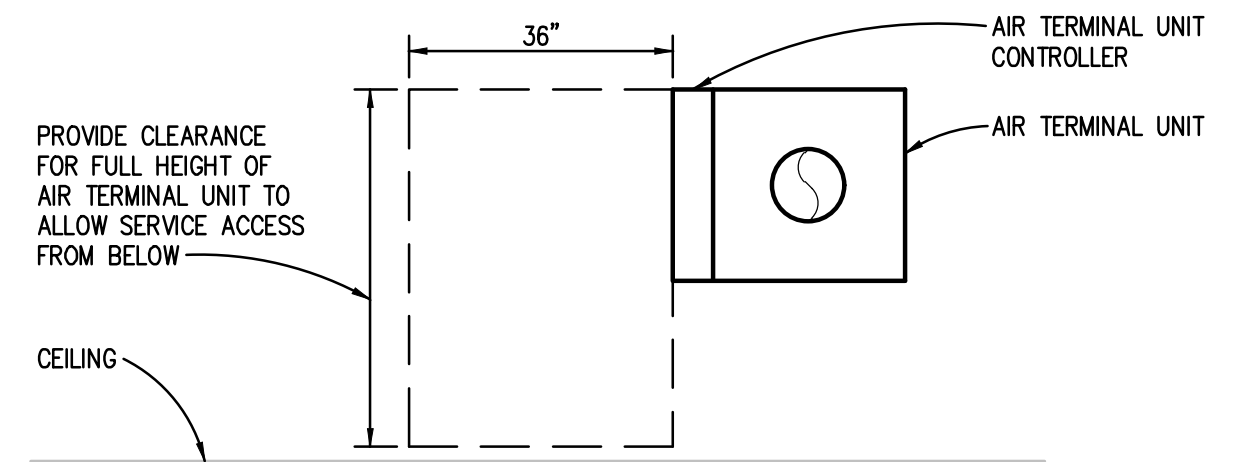


TERMINAL UNIT SECTION


AIR TERMINAL UNIT (TU) DETAIL
NO SCALE

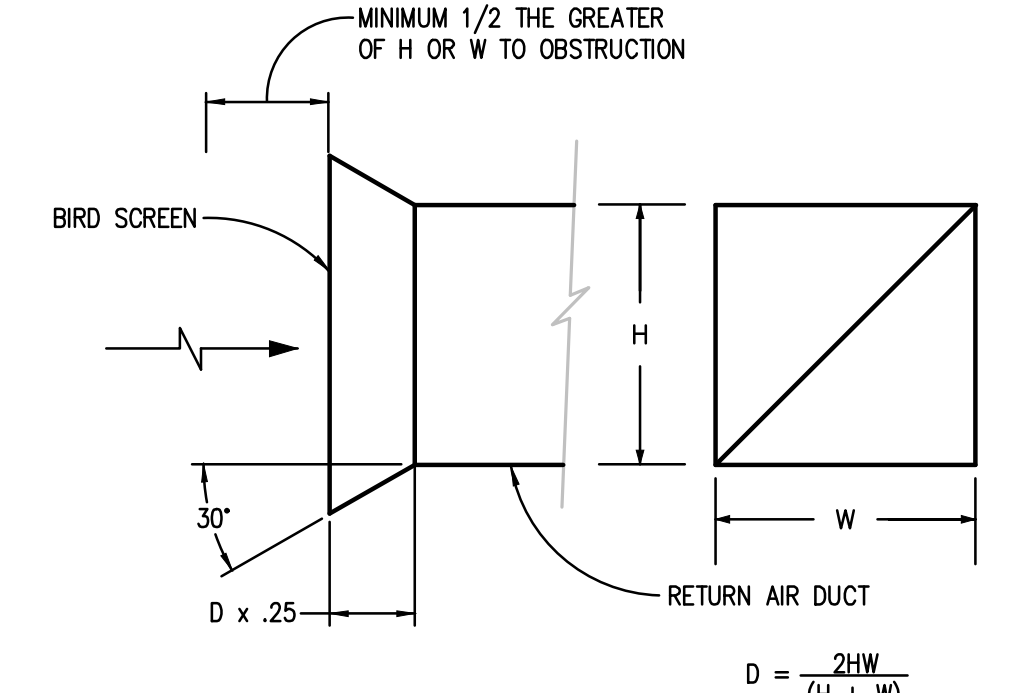

BELLMOUTH DETAIL
NO SCALE

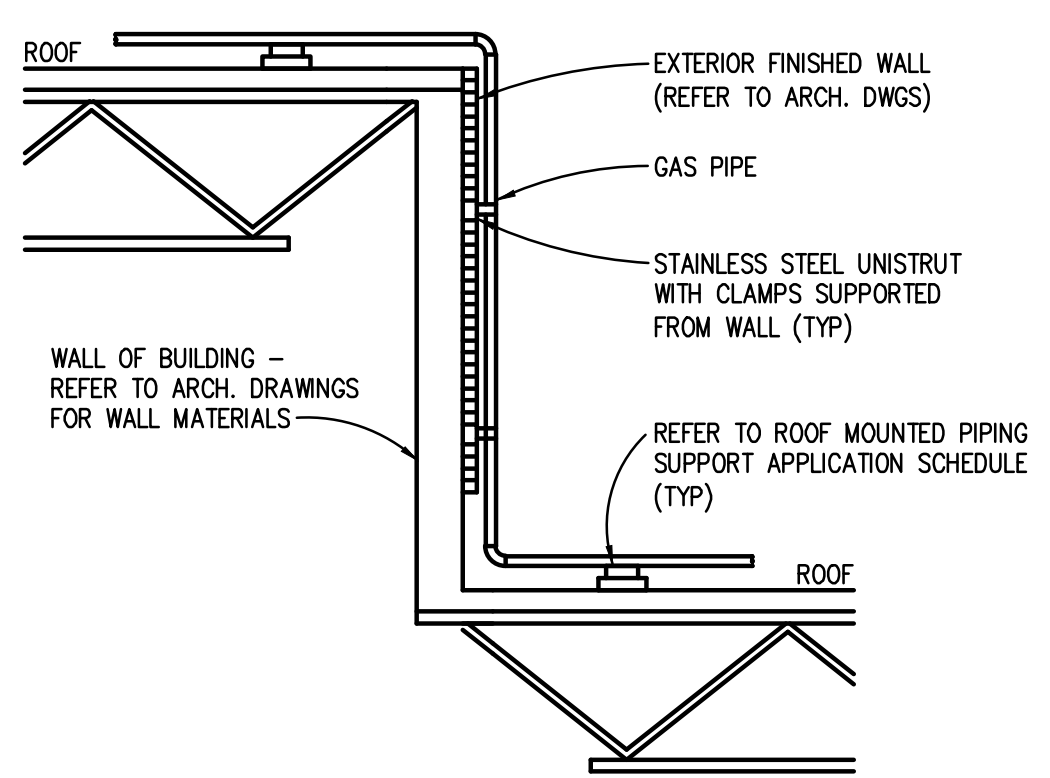

GAS PIPE MOUNTING DETAIL
NO SCALE

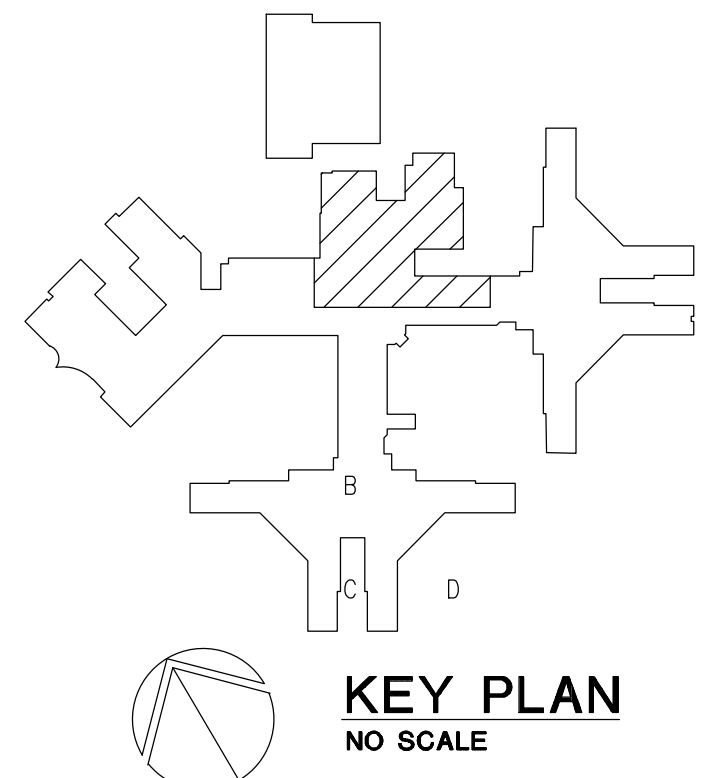

KEY PLAN
NO SCALE


NO.	REVISION	DATE
1	OWNER REVIEW	08/02/23

STATE OF MICHIGAN
DEPARTMENT OF TECHNOLOGY, MANAGEMENT AND BUDGET
FACILITIES AND BUSINESS SERVICES ADMINISTRATION
DESIGN AND CONSTRUCTION DIVISION
ADAM LACH, RA, DIRECTOR

FILE NO.
49120167.SDW

FUNDING CODE
171CODHHS7255

CONTRACT NO.
Y22003

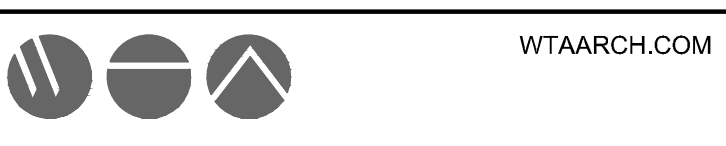

WTA ARCHITECTS

100 S. Jefferson Ave., Suite 601
Saginaw, Michigan 48607
989 752 8107

COPYRIGHT © 2023

PROJECT TITLE
49120167.SDW - PHASE 500:

CENTER FOR FORENSIC PSYCHIATRY - CREATE KITCHEN

SALINE, MICHIGAN

SHEET TITLE
MECHANICAL DETAILS


PROJECT NUMBER
2021094

SHEET NUMBER

PROJECT DATE
AUGUST 23, 2023

M6.03

CHECKED BY
WEK

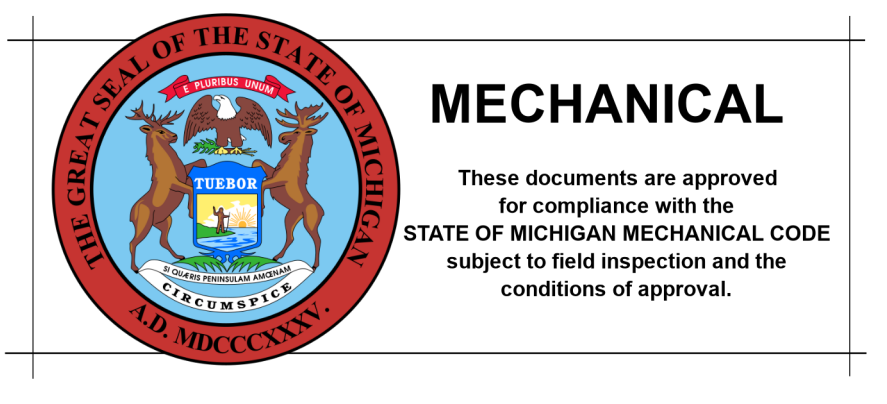


MECHANICAL

These documents are approved for compliance with the STATE OF MICHIGAN MECHANICAL CODE subject to field inspection and the conditions of approval.


Peter Basso Associates Inc.
CONSULTING ENGINEERS
5145 Livernois, Suite 100
Troy, Michigan 48068-3276
Tel: 248-879-5666
Fax: 248-879-0007
www.PeterBassoAssociates.com
PBA Project No.: 2023.0002

en:\2021\2021-0402-00\CA0\2021-0402-M6-DT.dwg, M=603, 9/5/2023, 4:32:48 PM, Gerard Henrich, Peter Basso Associates Inc.


THE FOLLOWING DIMENSION EQUALS ONE INCH WHEN PRINTED TO SCALE.

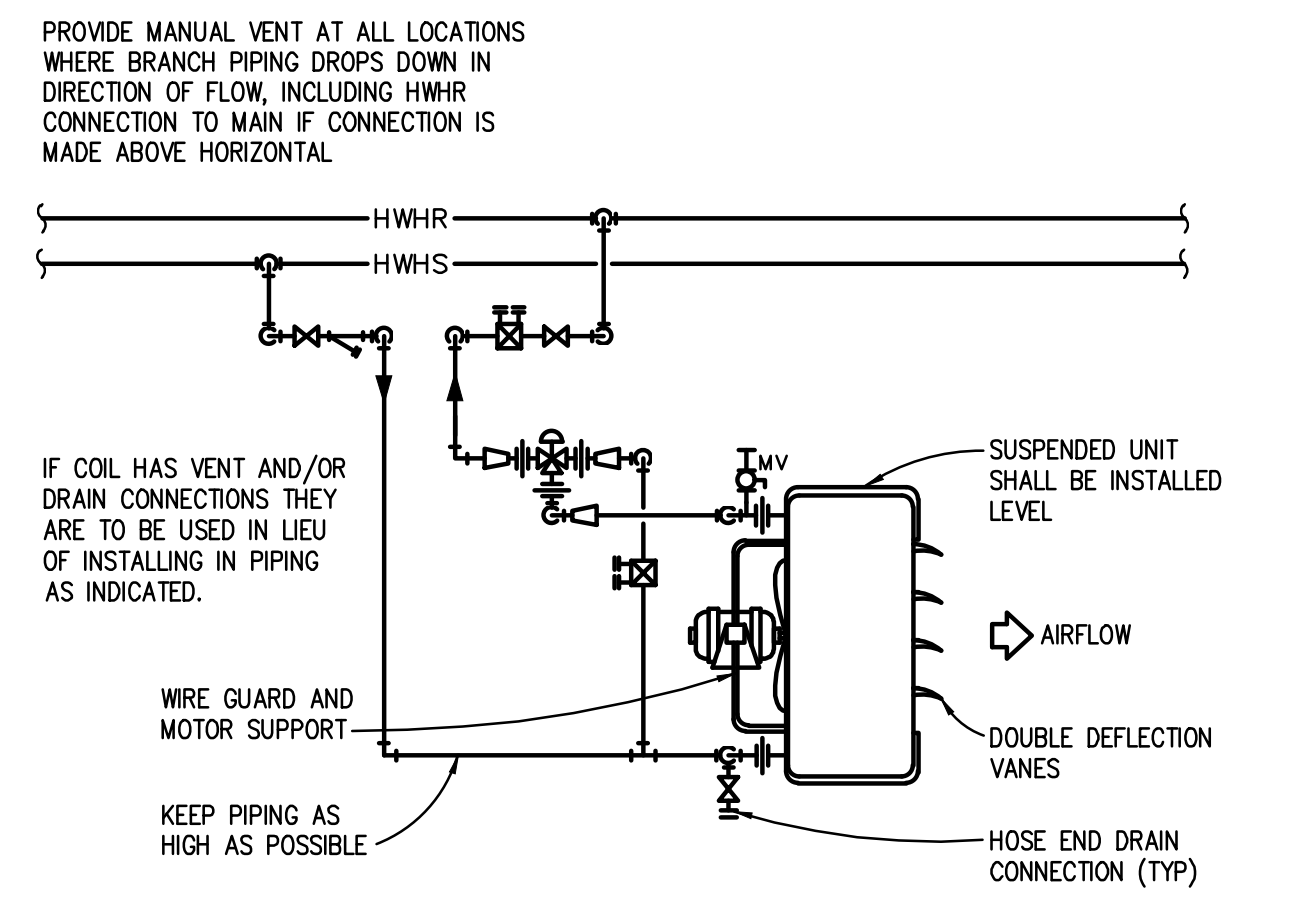


HOT WATER UNIT HEATER WITH THREE-WAY CONTROL VALVE PIPING DIAGRAM
NO SCALE

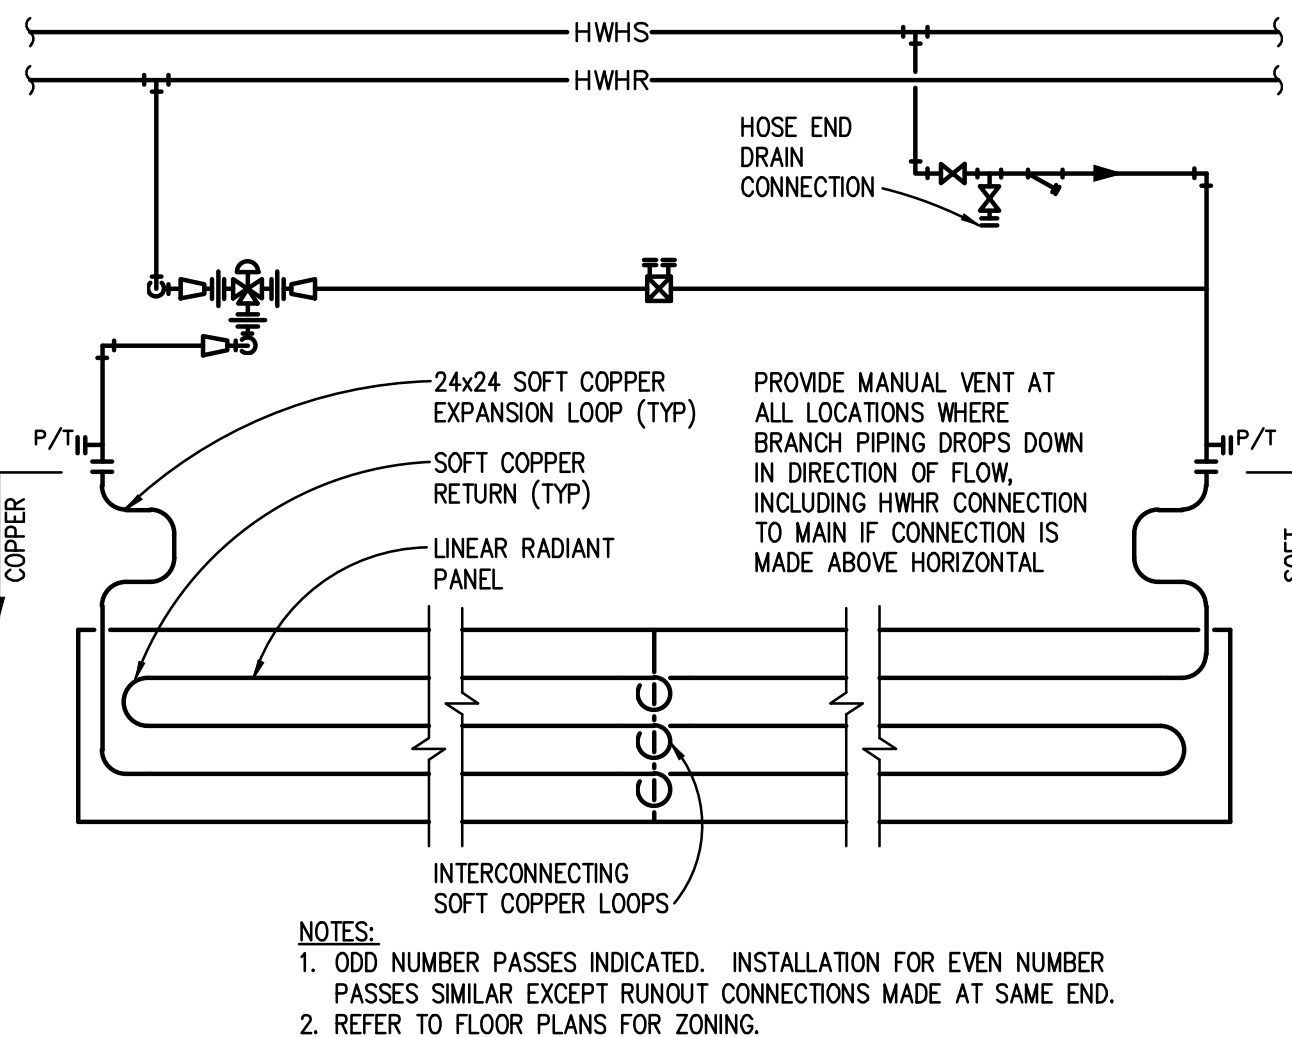


END FEED LINEAR RADIANT CEILING PANEL WITH THREE-WAY CONTROL VALVE PIPING DIAGRAM
NO SCALE

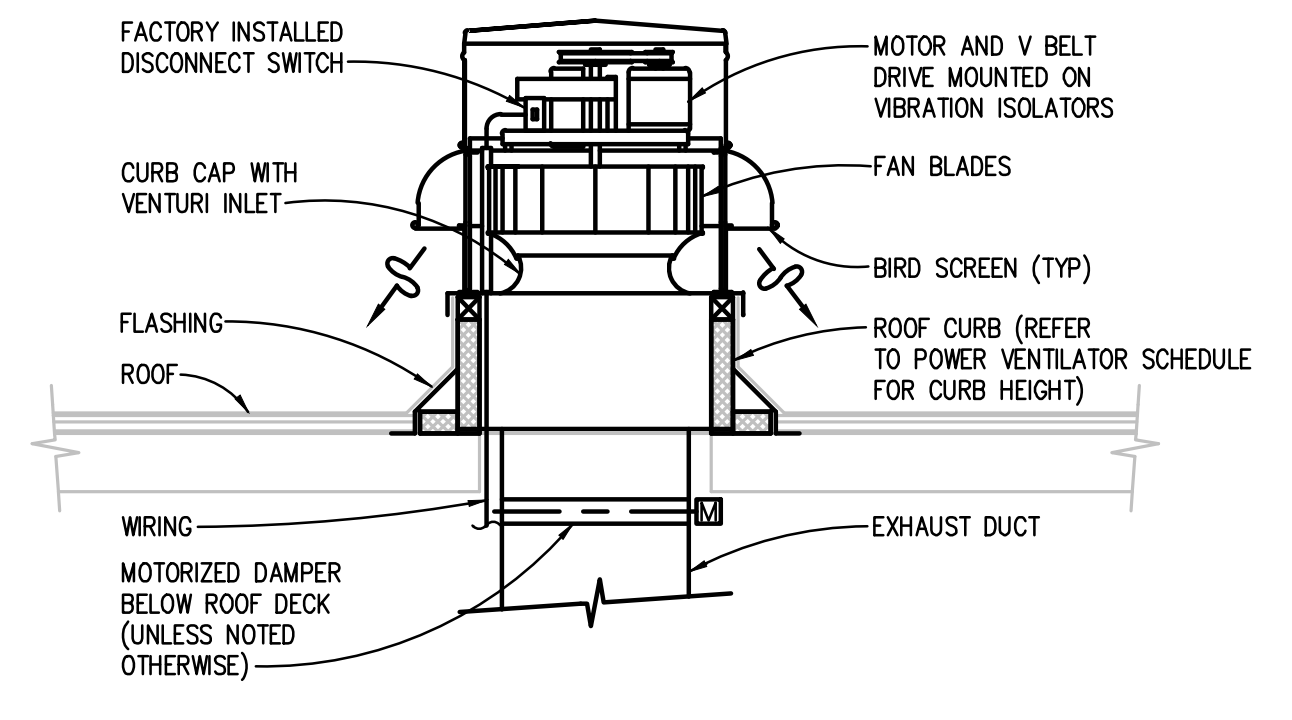


ROOF MOUNTED POWER VENTILATOR EXHAUST FAN DETAIL
NO SCALE

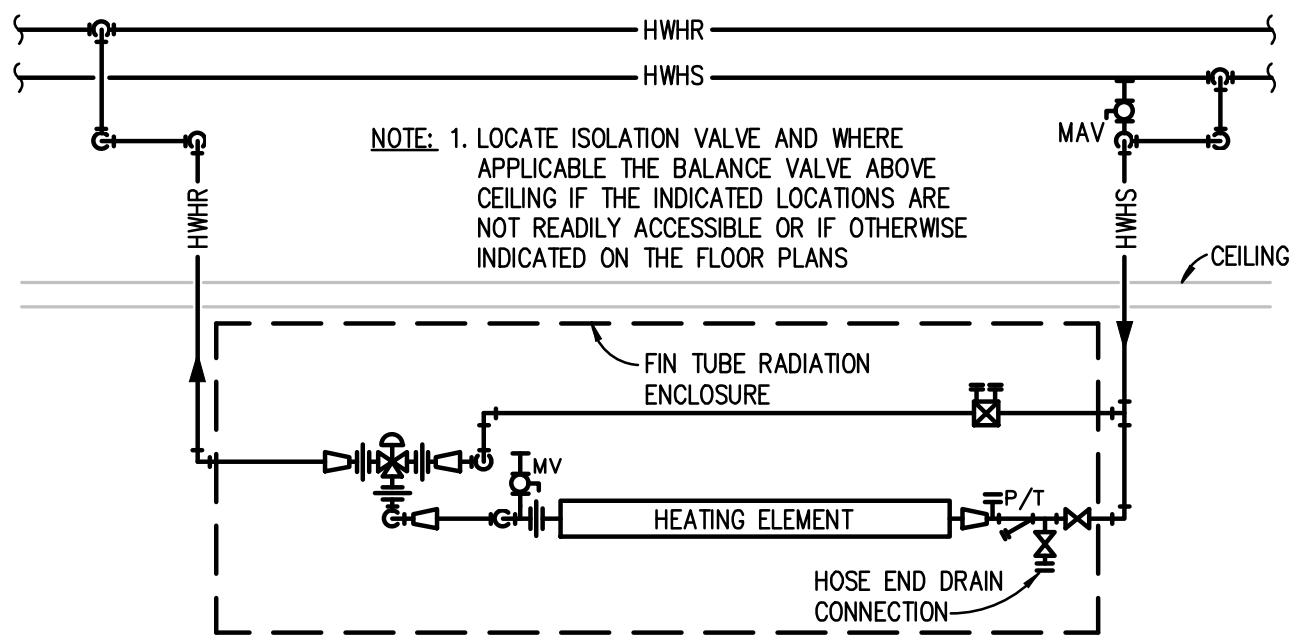


FIN TUBE RADIATION WITH THREE-WAY CONTROL VALVE PIPING DIAGRAM
NO SCALE

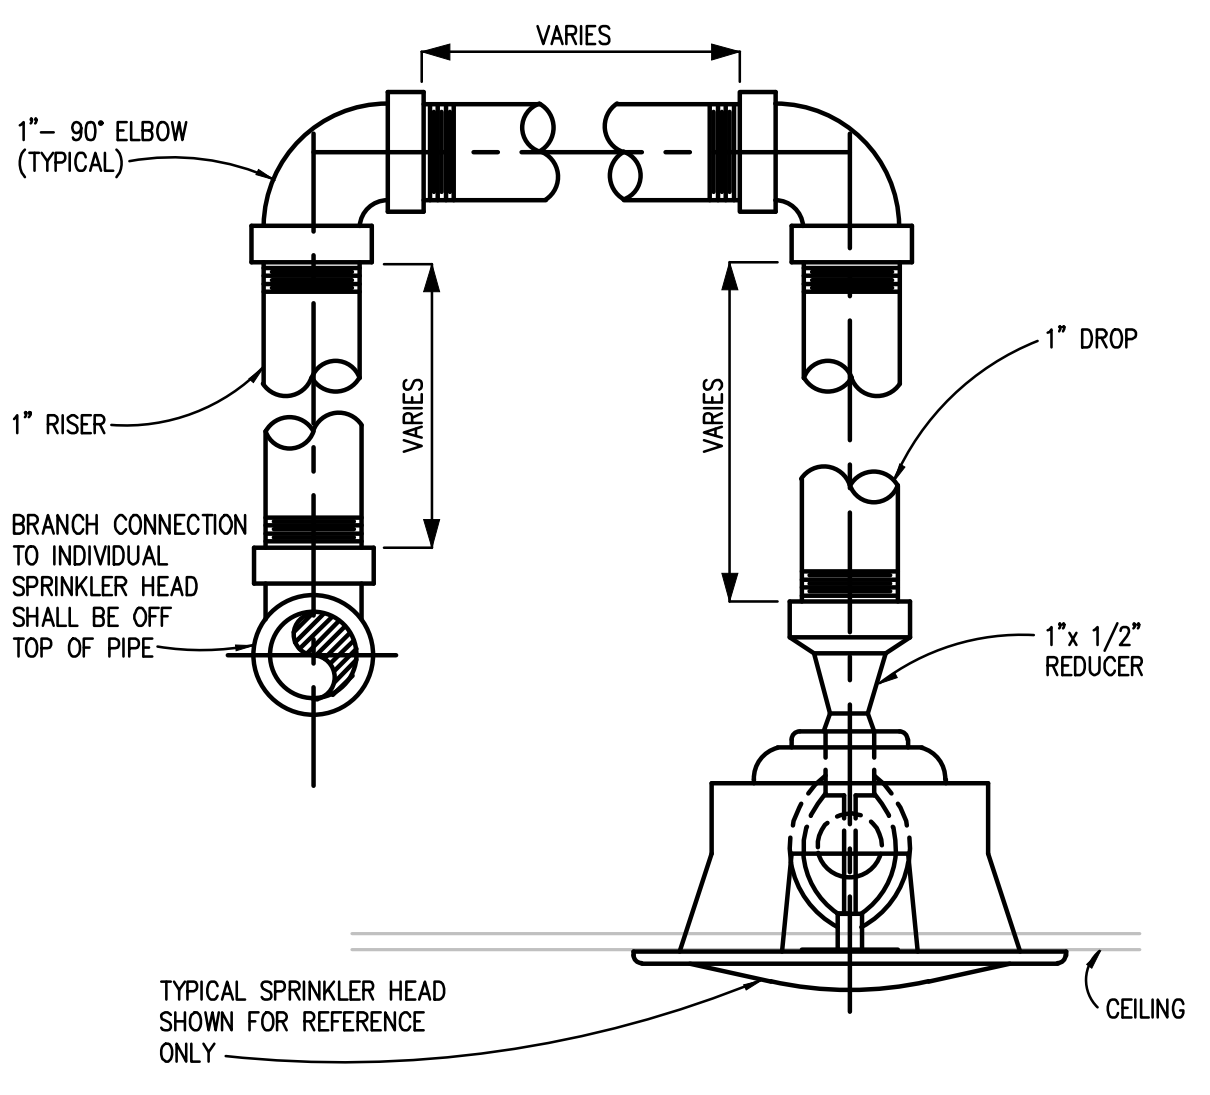

TYPICAL SPRINKLER PIPING DETAIL
NO SCALE

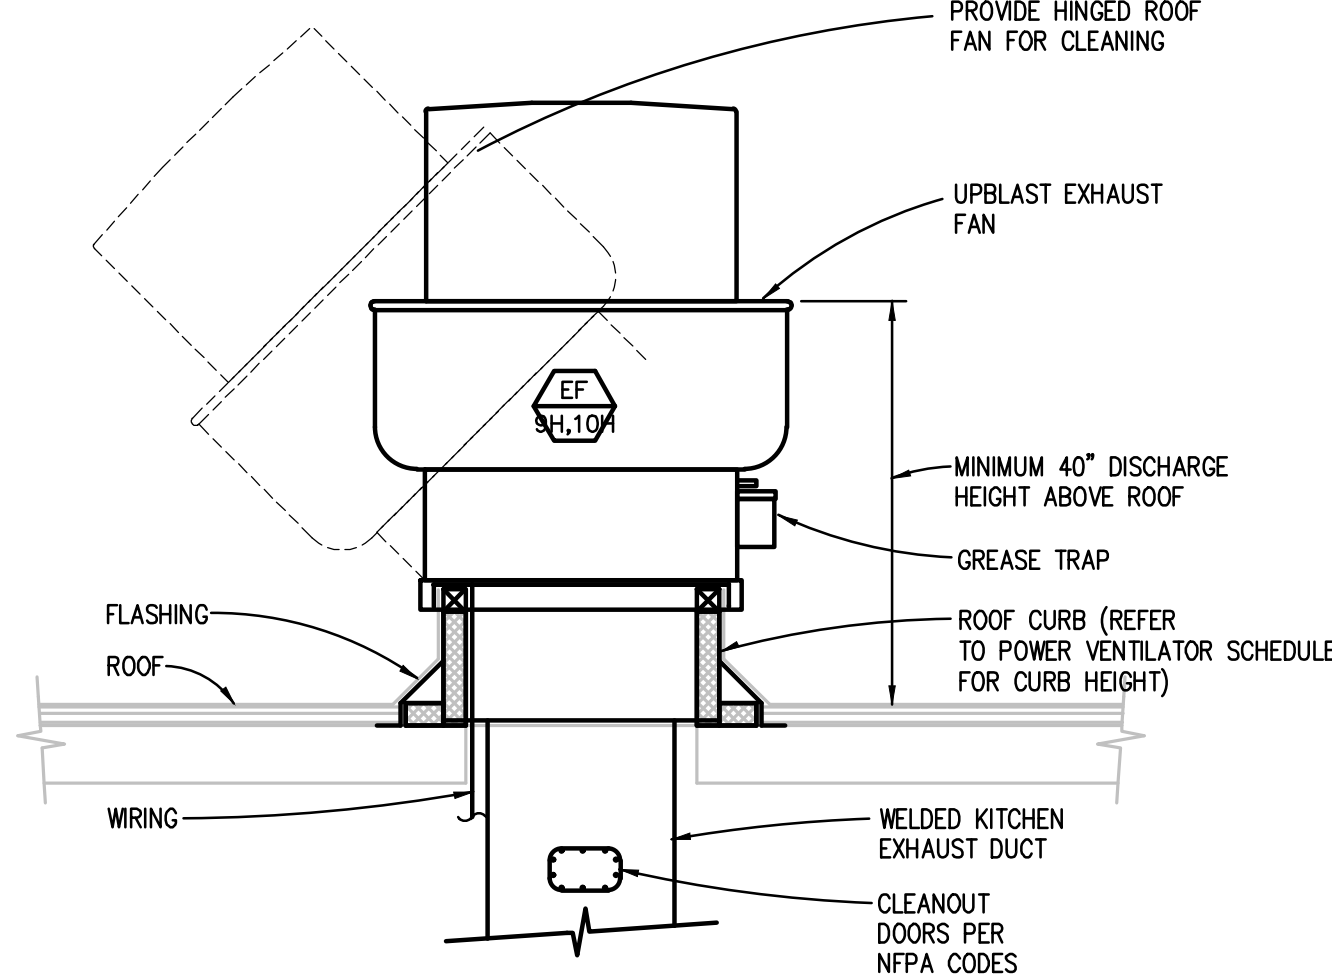

ROOF MOUNTED UPBLAST KITCHEN EXHAUST FAN DETAIL
NO SCALE

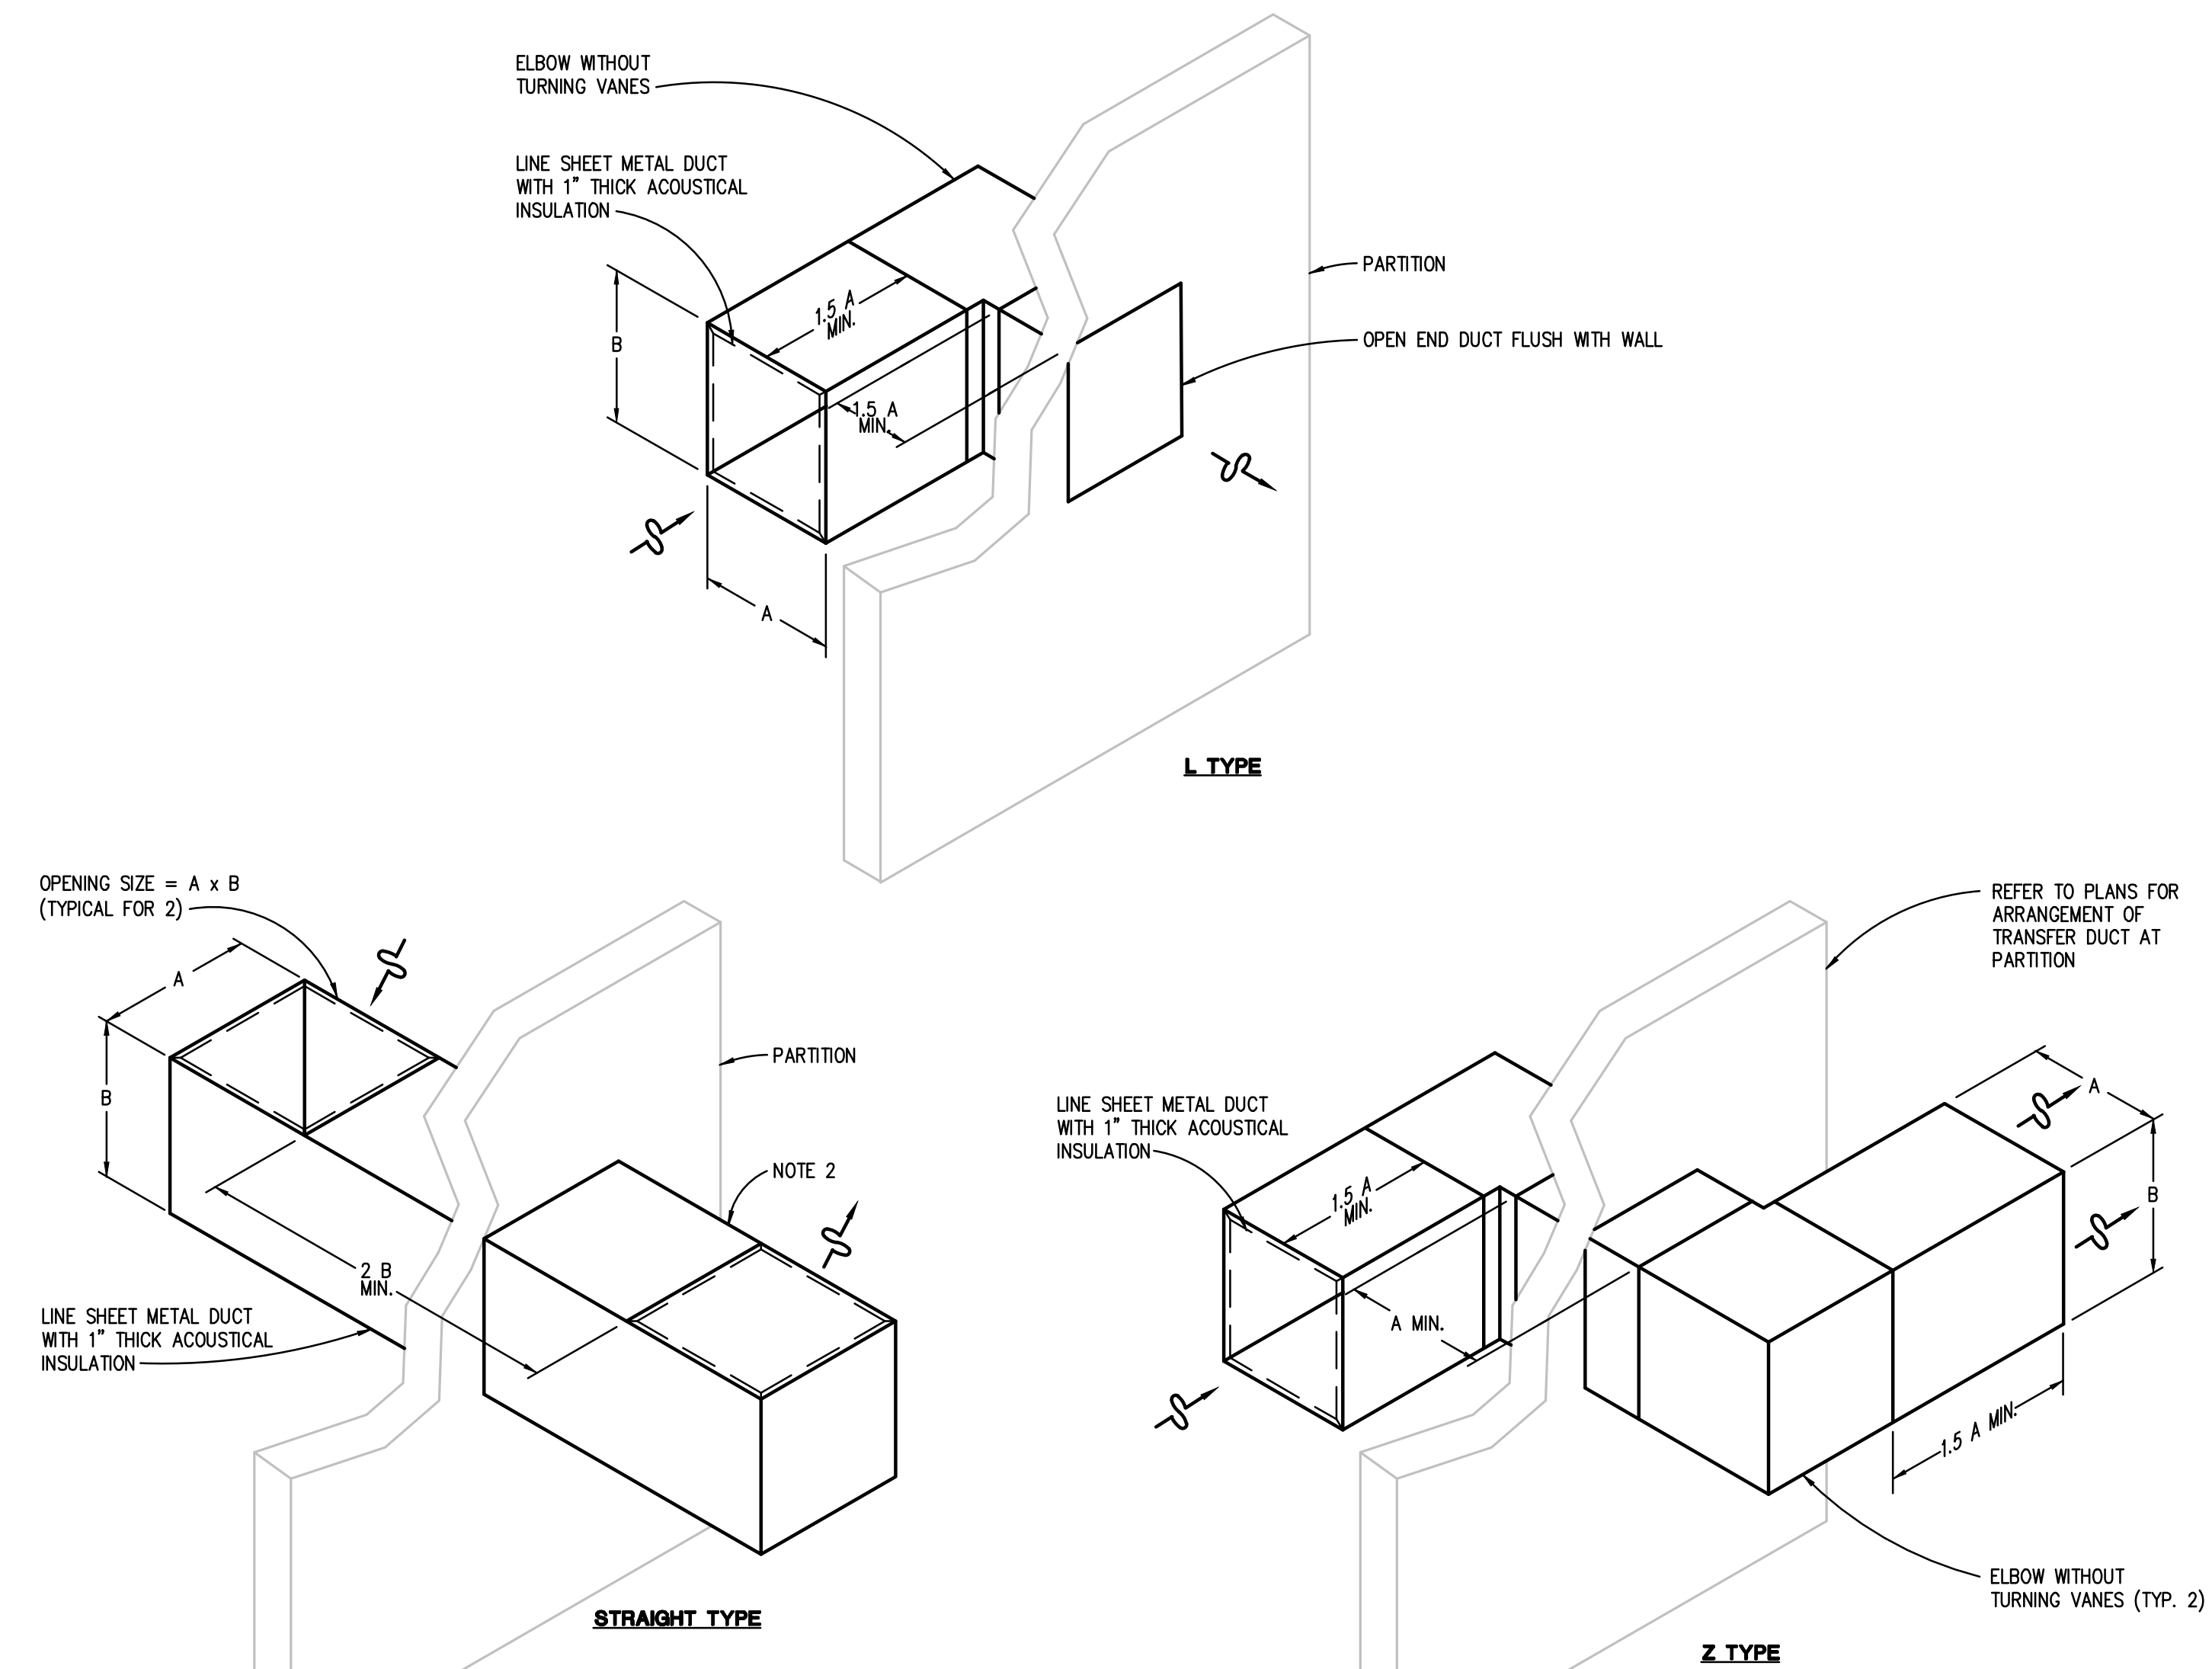


- NOTES:
1. WHERE INDICATED ON DRAWING OR WHERE DISTANCE FROM TOP OF DUCT TO SLAB/DECK IS LESS THAN .5B INSTALL Z TYPE DETAIL.
2. SIZE DUCTS FOR 400 FPM MAX BASED ON CLEAR INSIDE DIMENSIONS AND 100% OF THE SUPPLY AIR TO THE SPACE UNLESS OTHERWISE NOTED.
3. ROTATE DETAILS 90° WHERE VERTICAL INSTALLATION IS INDICATED.
4. DIMENSIONS ARE INSIDE CLEAR.
- OPTIONS:
1. RIGID FIBER BOARD MAY BE USED IN LIEU OF LINED SHEET METAL DUCT.

AIR TRANSFER DUCT DETAILS
NO SCALE


TRAP DIMENSION TABLE

TYPE OF SYSTEM	S.P. AT DRAIN PAN (IN.) (NOTE A)	DIMENSION "A" (INCHES) MIN.	DIMENSION "B" (INCHES)	DIMENSION "C" (INCHES) (TRAP SEAL)	DIMENSION "D" (INCHES)	DIMENSION "E" (INCHES)	DIMENSION "F" (INCHES)			
							DRAIN PIPE SIZE (INCHES)			
							1 1/2	2	2 1/2	3
DRAW THROUGH	-5.1 TO -6	5.0	5.0	2	6	2	13.0	14.0	15.0	16.0
	-4.1 TO -5	4.5	4.5	2	5	2	12.0	13.0	14.0	15.0
	-3.1 TO -4	4.0	4.0	2	4	2	11.0	12.0	13.0	14.0
	-2.1 TO -3	3.5	3.5	2	3	2	10.0	11.0	12.0	13.0
BLOW THROUGH	UP TO -2	3.0	3.0	2	2	2	9.0	10.0	11.0	12.0
	UP TO +2	4.0	2.0	2	2	4	9.0	10.0	11.0	12.0
	+2.1 TO +3	5.0	2.0	2	3	5	10.0	11.0	12.0	13.0
	+3.1 TO +4	6.0	2.0	2	4	6	11.0	12.0	13.0	14.0
	+4.1 TO +5	7.0	2.0	2	5	7	12.0	13.0	14.0	15.0
+5.1 TO +6	8.0	2.0	2	6	8	13.0	14.0	15.0	16.0	

- NOTES: A. REFER TO AIR HANDLING UNIT SCHEDULE FOR (-) OR (+) STATIC PRESSURE AT DRAIN PAN.
B. DIMENSION "C" IS MIN: 3" FOR UP TO 1 1/2" DRAIN PIPE
4" FOR 2" DRAIN PIPE
5" FOR 2 1/2" OR 3" DRAIN PIPE
6" FOR 4" DRAIN PIPE

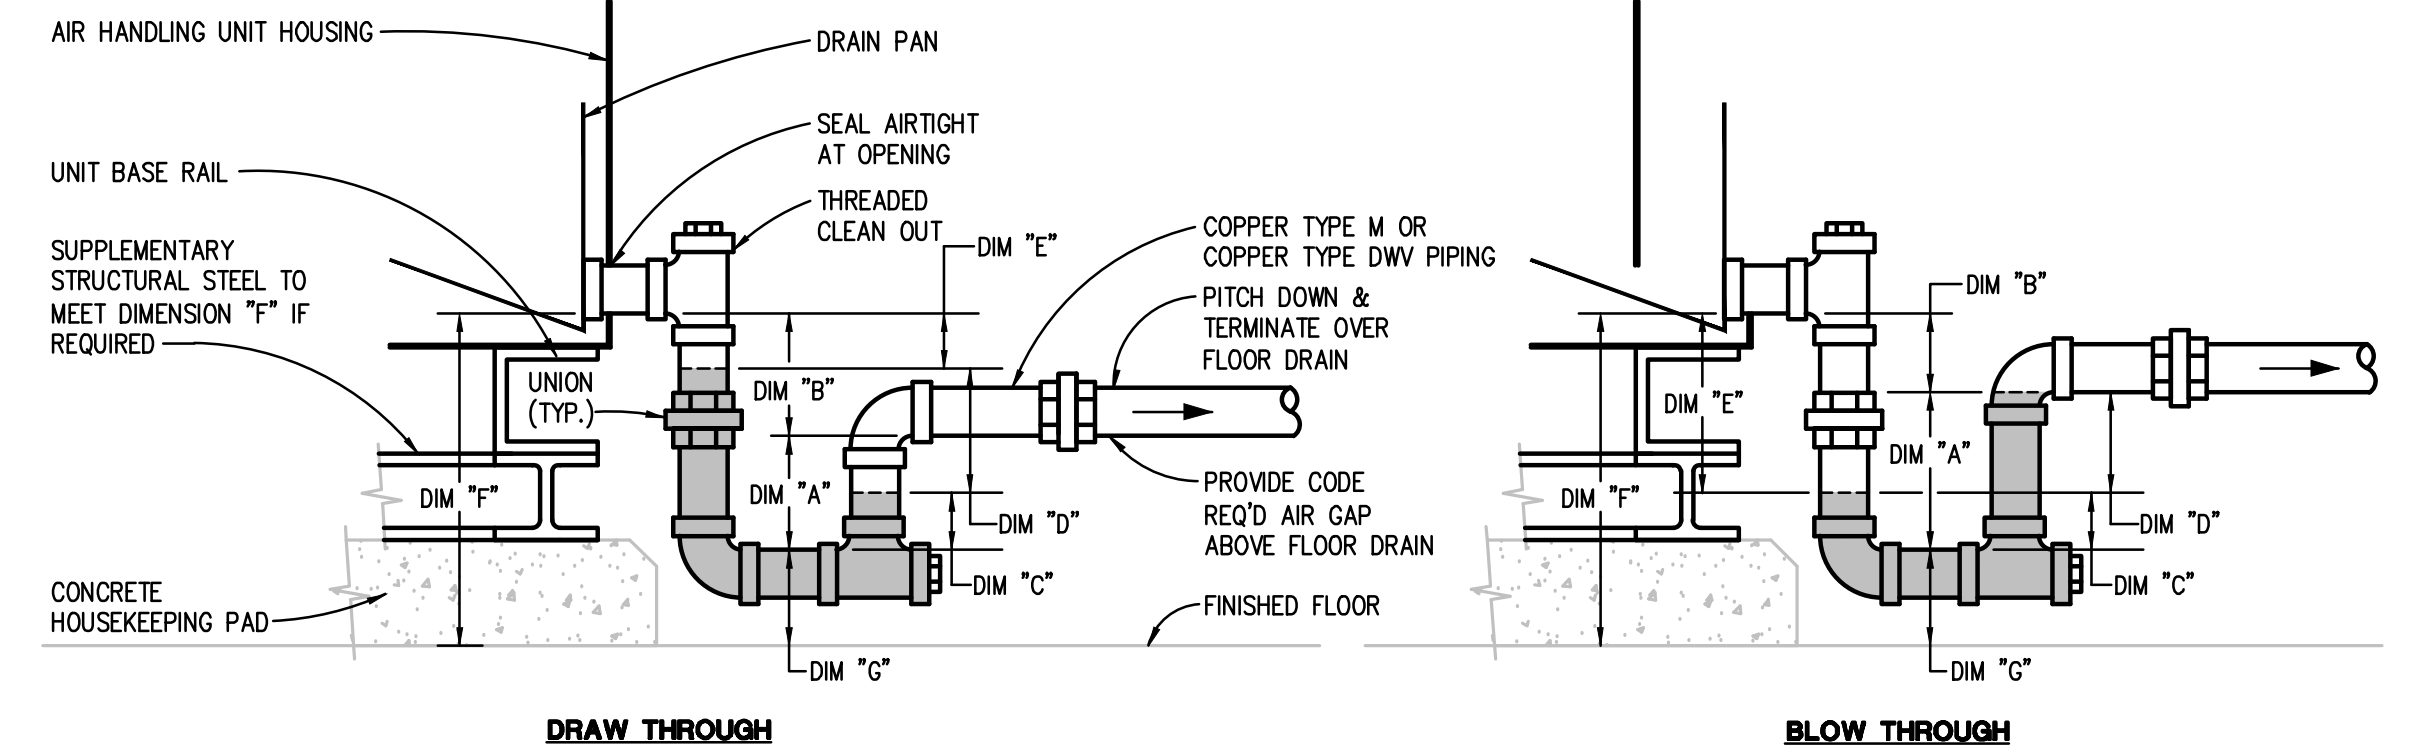

INDOOR AIR HANDLING UNIT CONDENSATE DRAIN PAN TRAP DETAIL
NO SCALE

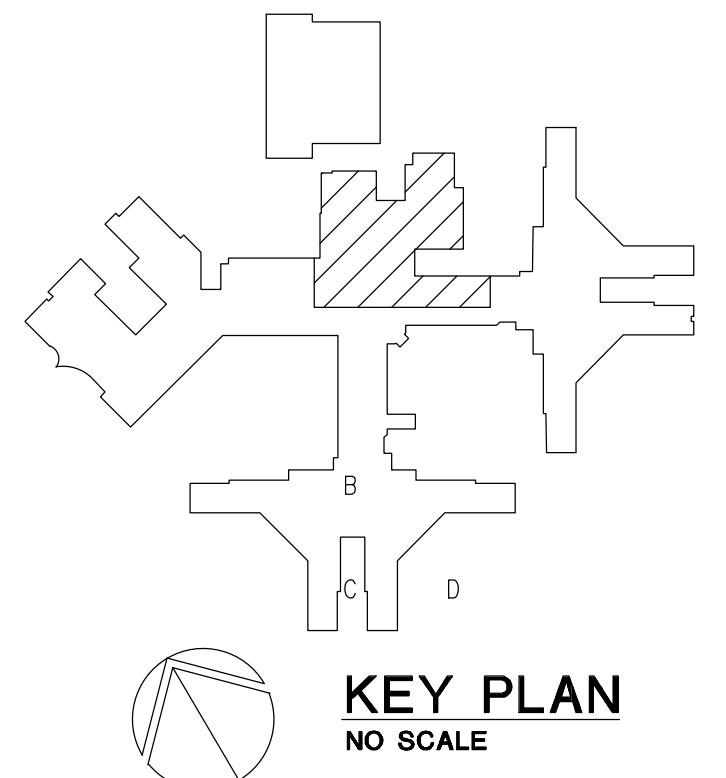

1	OWNER REVIEW	08/02/23
NO.	REVISION	DATE

STATE OF MICHIGAN
DEPARTMENT OF TECHNOLOGY, MANAGEMENT AND BUDGET
FACILITIES AND BUSINESS SERVICES ADMINISTRATION
DESIGN AND CONSTRUCTION DIVISION
ADAM LACHT, RA, DIRECTOR

FILE NO.
49120167.SDW

FUNDING CODE
171CODHST255

CONTRACT NO.
Y22003

WTAARCH.COM

WTA ARCHITECTS

100 S. Jefferson Ave., Suite 601
Saginaw, Michigan 48607
989 752 8107

COPYRIGHT © 2023

PROJECT TITLE
49120167.SDW - PHASE 500:
CENTER FOR FORENSIC
PSYCHIATRY - CREATE
KITCHEN

SALINE, MICHIGAN

SHEET TITLE
MECHANICAL DETAILS


PROJECT NUMBER
2021094

SHEET NUMBER

PROJECT DATE
AUGUST 23, 2023

M6.04

CHECKED BY
WEK

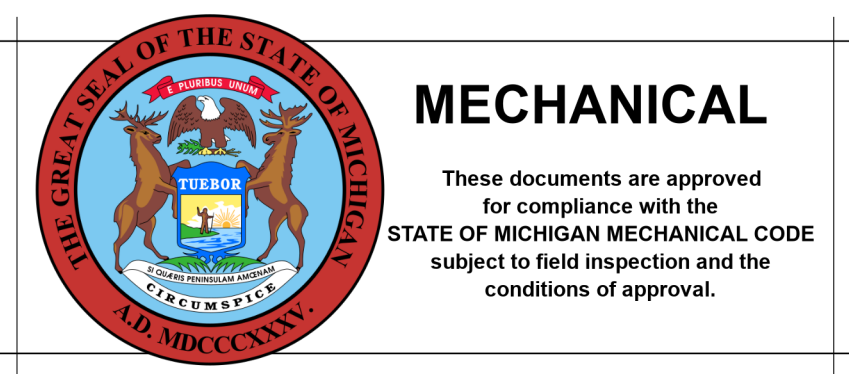

Peter Basso Associates Inc
CONSULTING ENGINEERS

5145 Livernois, Suite 100
Troy, Michigan 48068-3276
Tel: 248-879-5666
Fax: 248-879-0007
www.PeterBassoAssociates.com
PBA Project No. 2021094

en:\2021\2021-0402-00\CA0\2021-0402-M6-DT.dwg, M-604, 9/5/2023 4:32:49 PM, Gerard Henrich, Peter Basso Associates Inc.

ABOVEGROUND HVAC PIPE & ACCESSORY INSULATION APPLICATION SCHEDULE														
	INSULATION MATERIAL & THICKNESS (INCHES)					FIELD-APPLIED JACKET MATERIAL								
	FLEXIBLE ELASTOMERIC	FIBERGLASS	MINERAL WOOL	POLYISOCYANURATE	PHENOLIC	CELLULAR GLASS	CALCIUM SILICATE	ALUMINUM	STAINLESS STEEL	PVC	SELF-ADHESIVE (FOR OUTDOOR APPLICATIONS)	PWOC (INDOOR)	PWOC (OUTDOOR)	KEYED NOTES
INDOOR PIPE SYSTEM AND SIZE (INCHES)														
CHILLED WATER & BRINE BELOW 40 DEG F:														
NPS 6 AND SMALLER		1						X	X					A
NPS 8 AND LARGER		1.5						X	X					A
CHILLED WATER & BRINE 40 DEG F TO 60 DEG F:														
NPS 1-1/2 AND LARGER	1	1						X	X					A
HEATING HOT WATER SUPPLY & RETURN 200 DEG F AND LOWER:														
NPS 1-1/4 AND SMALLER		1.5						X	X					A
NPS 1-1/2 AND LARGER		2						X	X					A
LOW PRESS. STEAM, CONDENSATE & PUMPED CONDENSATE:														
NPS 1-1/4 AND SMALLER		2.5	2.5					3	X					A
NPS 1-1/2 AND LARGER		3	3					3	X					A
MED. & HIGH PRESS. STEAM, CONDENSATE & PUMPED CONDENSATE:														
NPS 3/4 AND SMALLER		3	3					5	X					A
NPS 1 TO 1-1/4		4	4					5	X					A
NPS 1-1/2 AND LARGER		4.5	4.5					5	X					A
REFRIGERANT SUCTION & HOT GAS (RIGID COPPER)														
NPS 6 AND SMALLER	1	1						X	X					
NPS 8 AND LARGER	1.5	1.5						X	X					
REFRIGERANT SUCTION & HOT GAS (SOFT COPPER)														
NPS 1-1/2 AND LARGER	1	1						X	X					

UNLESS OTHERWISE INDICATED OR SCHEDULED, THE FOLLOWING DO NOT REQUIRE INSULATION:
 DIRECT BURIED COOLING SYSTEM PIPING
 PIPING THAT CONVEYS FLUIDS HAVING DESIGN OPERATING TEMPERATURE RANGE BETWEEN 60 DEG F. AND 105 DEG F., INCLUSIVE.

GENERAL NOTES

- "X" OR THICKNESS IN INCHES INDICATES ACCEPTABLE SELECTION. IF MORE THAN ONE SELECTION IS INDICATED, CONTRACTOR MAY SELECT FROM THOSE INDICATED SELECTIONS.
- INSULATE PIPING WITHIN AIR HANDLING EQUIPMENT THE SAME AS INDOOR PIPING. PROVIDE ALUMINUM OR STAINLESS STEEL JACKET.
- FOR PIPING NPS 1-1/4 AND SMALLER WITHIN PARTITIONS IN CONDITIONED SPACES INSULATION MAY BE REDUCED BY ONE-INCH THICKNESS, BUT NOT TO LESS THAN ONE-INCH THICKNESS.
- FOR PIPING NPS 1 AND SMALLER, INSULATION IS NOT REQUIRED FOR STRAINERS, CONTROL VALVES, AND BALANCING VALVES.

KEYED NOTES

- PROVIDE FIELD APPLIED JACKET FOR PIPING EXPOSED IN EQUIPMENT ROOMS, STORAGE ROOMS, JANITORS CLOSETS, RECEIVING ROOMS, TEST AREAS, CIRCULATION AREAS AND SUCH AREAS SUBJECT TO DAMAGE WITHIN 10 FEET (3 METERS) OF FINISHED FLOOR.
- PROVIDE MANUFACTURER'S RECOMMENDED PROTECTIVE COATING FOR FLEXIBLE ELASTOMERIC THERMAL INSULATION.
- STEAM AND CONDENSATE PIPING JACKET SHALL BE STUCCO EMBOSSED.
- PIPING WITHIN ENERGY RECOVERY UNITS SHALL BE TYPE 304 STAINLESS STEEL, SMOOTH; 0.010 INCH THICK. SEAMS AND JOINTS CAULKED WITH CHEMICALLY RESISTANT SEALER.

DUCT SYSTEM INSULATION APPLICATION SCHEDULE										
	INSULATION MATERIAL & THICKNESS (INCHES)					FIELD-APPLIED JACKET MATERIAL				
	FIBERGLASS BLANKET 0.75 LB/QU FT	FIBERGLASS BLANKET 1.0 LB/QU FT	FIBERGLASS BOARD 2.25 LB/QU FT	FIBERGLASS BOARD 4.0 LB/QU FT	FLEXIBLE ELASTOMERIC	ASTM E2306 2-HOUR FIRE RATED BLANKET	2-HOUR FIRE RATED BLANKET	ALUMINUM	SELF-ADHESIVE (FOR OUTDOOR APPLICATIONS)	KEYED NOTES
DUCT SYSTEMS LOCATED INDOORS										
SUPPLY AIR, EXCEPT AS NOTED BELOW										
RECTANGULAR SUPPLY AIR IN MECHANICAL ROOMS		1.5								A, E
ROUND & FLAT OVAL SUPPLY AIR IN MECHANICAL ROOMS		1.5								
RECTANGULAR RETURN AIR IN MECHANICAL EQUIPMENT ROOMS		1.5								
ROUND RETURN AIR IN MECHANICAL ROOMS		1.5								
OUTSIDE AIR AND MIXED AIR, EXCEPT AS NOTED BELOW										
RECTANGULAR OUTSIDE AIR AND MIXED AIR IN MECHANICAL ROOMS		1.5								
ROUND OUTSIDE AIR AND MIXED AIR IN MECHANICAL ROOMS		1.5								
EXHAUST AND RELIEF AIR BETWEEN ISOLATION DAMPER AND PENETRATION OF BUILDING EXTERIOR, EXCEPT AS NOTED BELOW										
RECTANGULAR EXHAUST AND RELIEF AIR BETWEEN ISOLATION DAMPER AND PENETRATION OF BUILDING EXTERIOR, IN MECHANICAL ROOMS		1.5								
ROUND & FLAT OVAL EXHAUST AND RELIEF AIR BETWEEN ISOLATION DAMPER AND PENETRATION OF BUILDING EXTERIOR, IN MECHANICAL ROOMS		1.5								
DUCT SYSTEMS LOCATED IN ATTICS, CRAWL SPACES, OR PARKING GARAGES HAVING NATURAL OR MECHANICAL VENTILATION										
RECTANGULAR DUCTS AND AIR PLENUMS, ALL TYPES		3		2						
ROUND & FLAT OVAL SUPPLY AIR		3								
ROUND & FLAT OVAL RETURN & EXHAUST AIR		3								

PLENUMS, DUCTS, AND DUCT ACCESSORIES NOT REQUIRING INSULATION:
 FIBROUS-GLASS DUCTS
 DOUBLE-WALL METAL DUCTS WITH INSULATION OF SUFFICIENT THICKNESS TO COMPLY WITH ENERGY CODE AND ASHRAE/IESNA 90.1 - 2013
 METAL DUCTS WITH DUCT LINER OF SUFFICIENT THICKNESS TO COMPLY WITH ENERGY CODE AND ASHRAE/IESNA 90.1 - 2013
 FABRIC SUPPLY DUCTS
 FACTORY-INSULATED FLEXIBLE DUCTS
 FACTORY-INSULATED PLENUMS AND CASINGS
 FLEXIBLE CONNECTORS
 VIBRATION-CONTROL DEVICES
 FACTORY-INSULATED ACCESS PANELS AND DOORS

GENERAL NOTES

- "X" OR THICKNESS IN INCHES INDICATES ACCEPTABLE SELECTION. IF MORE THAN ONE SELECTION IS INDICATED FOR A DUCT SYSTEM, CONTRACTOR MAY SELECT FROM THOSE INDICATED SELECTIONS.
- REFER TO METAL DUCT SECTION OF SPECIFICATIONS FOR DUCT LINING AND DOUBLE-WALL INSULATED DUCT.
- REFER TO HVAC CASINGS SECTION OF SPECIFICATIONS FOR DOUBLE-WALL INSULATED PLENUMS.

KEYED NOTES

- INCLUDE INSULATION AROUND DUCT MOUNTED COILS AND AIR TERMINAL UNIT COILS.
- NUMBER OF LAYERS AND TOTAL INSULATION THICKNESS AS RECOMMENDED BY SELECTED MANUFACTURER.
- DOES NOT APPLY TO PREFABRICATED, ZERO-CLEARANCE GREASE DUCT.
- PROVIDE MANUFACTURER'S RECOMMENDED PROTECTIVE COATING FOR FLEXIBLE ELASTOMERIC THERMAL DUCT INSULATION.
- EXPOSED SUPPLY DUCTWORK LOCATED IN CONDITIONED SPACE SERVED BY THAT SYSTEM IS NOT REQUIRED TO BE INSULATED.


HORIZONTAL PIPING AND SUPPORT APPLICATION SCHEDULE										
	HANGER OR SUPPORT TYPE					SHIELD TYPE				
	MSS TYPE 1 CLEVIS HANGER	MSS TYPE 10 SWIVEL RING BAND HANGER	MSS TYPE 41 DOUBLE ROD PIPE ROLLER	MSS TYPE 43 SINGLE ROD ROLLER HANGER	MSS TYPE 44 PIPE ROLLER & STAND	MSS TYPE 46 ADJUSTABLE PIPE ROLL STAND	MSS TYPE 39 PROTECTION SADDLE	MSS TYPE 40 INSULATION PROTECTION SHIELD	THERMAL-HANGER SHIELD	KEYED NOTES
METAL PIPE TYPE & SIZE										
UNINSULATED SINGLE PIPE										
UP TO 2 INCH	X	X								
2-1/2 INCH TO 4 INCH	X	X								
6 INCH TO 8 INCH	X									
10 INCH	X									
12 INCH			X							
14 INCH AND LARGER			X							
INSULATED SINGLE COLD PIPES										
UP TO 2 INCH	X	X					X	X	A	
2-1/2 INCH TO 4 INCH	X								X	
6 INCH TO 8 INCH	X								X	
10 INCH	X								X	
12 INCH	X								X	
14 INCH AND LARGER	X								X	
INSULATED SINGLE HOT PIPES										
UP TO 2 INCH	X	X					X	X	A, C	
2-1/2 INCH TO 4 INCH			X	X	X	X	X	X	B, C	
6 INCH TO 8 INCH			X	X	X	X	X	X	B, C	
10 INCH			X	X	X	X	X	X	B, C	
12 INCH			X	X	X	X	X	X	B, C	
14 INCH AND LARGER			X	X	X	X	X	X	B, C	

GENERAL NOTES

- "X" INDICATES APPROVED HANGER OR SUPPORT ELEMENTS. IF MORE THAN ONE HANGER OR SUPPORT ELEMENT IS INDICATED, SELECTION FROM APPROVED ELEMENTS IS CONTRACTOR'S OPTION.
- REFER TO HANGER AND SUPPORT SECTION FOR APPROVED MANUFACTURERS.
- HANGERS AND SUPPORTS USED FOR FIRE PROTECTION SERVICES SHALL BE UL LISTED OR FMG APPROVED.
- HANGER ELEMENTS IN CONTACT WITH BARE COPPER PIPE SHALL BE COPPER PLATED, PLASTIC COATED, FELT LINED, OR USE MANUFACTURED COPPER TUBE ISOLATORS.
- REFER TO INDIVIDUAL PIPING SPECIFICATION SECTIONS FOR HANGER SPACING.
- MULTIPLE PARALLEL COLD PIPES MAY BE TRAPEZE SUPPORTED FROM BELOW USING U-BOLTS OR STRUT CLAMPS AND THERMAL HANGER SHIELDS. REFER TO KEYED NOTE A.
- MULTIPLE PARALLEL COLD PIPES MAY BE TRAPEZE SUPPORTED FROM ABOVE USING STANDARD HANGER ELEMENTS INDICATED FOR SINGLE COLD PIPES.
- MULTIPLE PARALLEL HOT PIPES MAY BE TRAPEZE SUPPORTED FROM BELOW USING ROLLER ELEMENTS AND THERMAL HANGER SHIELD OR INSULATION PROTECTION SADDLE. REFER TO KEYED NOTES B AND C.
- MULTIPLE PARALLEL HOT PIPES MAY BE TRAPEZE SUPPORTED FROM ABOVE USING STANDARD ROLLER HANGERS INDICATED AND THERMAL HANGER SHIELD OR INSULATION PROTECTION SADDLE. REFER TO KEY NOTES B AND C.
- REFER TO INDIVIDUAL PIPING SPECIFICATION SECTIONS FOR ADDITIONAL SYSTEM SPECIFIC HANGER APPLICATIONS.

KEYED NOTES

- USE THERMAL HANGER SHIELD ON TRAPEZE SUPPORTED INSULATED PIPE TO PREVENT CRUSHING OF INSULATION.
- USE THERMAL HANGER SHIELD DESIGNED FOR USE ON ROLLER SUPPORTS FOR INSULATED HOT PIPE.
- USE TYPE 39 PROTECTION SADDLES IF INSULATION WITHOUT VAPOR BARRIER IS INDICATED. FILL INTERIOR VOIDS WITH INSULATION MATCHING ADJOINING INSULATION.

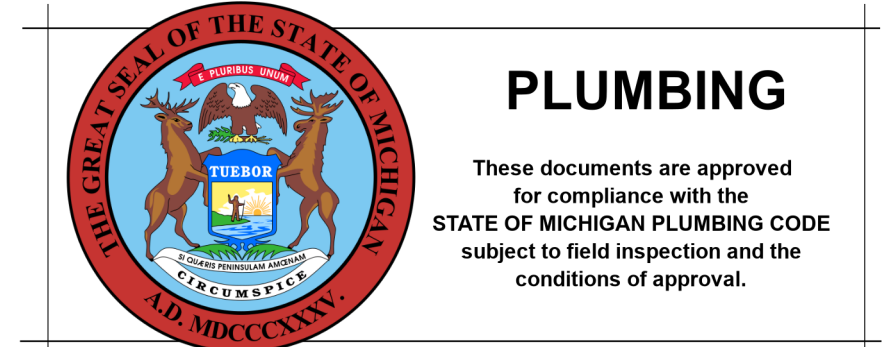

ABOVEGROUND PLUMBING PIPE & ACCESSORY INSULATION APPLICATION SCHEDULE														
	INSULATION MATERIAL & THICKNESS (INCHES)					FIELD-APPLIED JACKET MATERIAL								
	FLEXIBLE ELASTOMERIC	FIBERGLASS	MINERAL WOOL	POLYISOCYANURATE	PHENOLIC	CELLULAR GLASS	CALCIUM SILICATE	ALUMINUM	STAINLESS STEEL	PVC	SELF-ADHESIVE (FOR OUTDOOR APPLICATIONS)	PWOC (INDOOR)	PWOC (OUTDOOR)	KEYED NOTES
INDOOR PIPE SYSTEM AND SIZE (INCHES)														
DOMESTIC COLD WATER														
NPS 1-1/4 AND SMALLER	1	1						X	X					A
NPS 1-1/2 AND LARGER	1.5	1.5						X	X					A
DOMESTIC HOT WATER SUPPLY & RETURN 140 DEG F AND LESS:														
NPS 1-1/4 AND SMALLER	1	1						X	X					A
NPS 1-1/2 AND LARGER	1.5	1.5						X	X					A
STORM WATER & OVERFLOW														
NPS 1-1/4 AND SMALLER	1	1						X	X					A
ROOF DRAIN AND OVERFLOW DRAIN BODIES														
NPS 1-1/4 AND SMALLER	1	1						X	X					A
CONDENSATE AND EQUIPMENT DRAIN PIPING BELOW 60 DEG F														
NPS 1-1/4 AND SMALLER	0.75	1						X	X					A
FLOOR DRAINS, TRAPS AND SANITARY DRAIN PIPING WITHIN 10 FEET OF DRAIN RECEIVING CONDENSATE AND EQUIPMENT DRAIN WATER BELOW 60 DEG F														
NPS 1-1/4 AND SMALLER	0.75	1						X	X					A
OUTDOOR (ABOVEGROUND) AND TUNNEL PIPE SYSTEM AND SIZE (INCHES)														
DOMESTIC COLD WATER														
NPS 1-1/4 AND SMALLER	2	2						X	X	X				B
NPS 1-1/2 AND LARGER	2	2						X	X	X				B
DOMESTIC HOT WATER SUPPLY & RETURN														
NPS 1-1/4 AND SMALLER	2	2						X	X	X				B
NPS 1-1/2 AND LARGER	2	2						X	X	X				B
SANITARY WHERE HEAT TRACING IS INSTALLED														
NPS 1-1/4 AND SMALLER	2	2						X	X	X				B
NPS 1-1/2 AND LARGER	2	2						X	X	X				B

UNLESS OTHERWISE INDICATED OR SCHEDULED, DO NOT INSULATE THE FOLLOWING:
 FIRE SUPPRESSION PIPING
 UNDERGROUND PIPING
 LABORATORY GAS AND VACUUM PIPING
 MEDICAL GAS AND VACUUM PIPING
 FUEL GAS PIPING
 FUEL OIL PIPING

GENERAL NOTES

- "X" OR THICKNESS IN INCHES INDICATES ACCEPTABLE SELECTION. IF MORE THAN ONE SELECTION IS INDICATED FOR A SYSTEM, CONTRACTOR MAY SELECT FROM THOSE INDICATED SELECTIONS.
- INSULATE PIPING WITHIN AIR HANDLING EQUIPMENT THE SAME AS INDOOR PIPING. PROVIDE ALUMINUM OR STAINLESS STEEL JACKET.

KEYED NOTES

- PROVIDE FIELD APPLIED JACKET FOR PIPING EXPOSED IN EQUIPMENT ROOMS, STORAGE ROOMS, JANITORS CLOSETS, RECEIVING ROOMS, TEST AREAS, CIRCULATION AREAS AND SUCH AREAS SUBJECT TO DAMAGE, WITHIN 10 FEET (3 METERS) OF FINISHED FLOOR.
- PROVIDE MANUFACTURER'S RECOMMENDED PROTECTIVE COATING FOR FLEXIBLE ELASTOMERIC THERMAL INSULATION.


ABOVEGROUND HVAC PIPING & VALVE APPLICATION SCHEDULE																
PIPE SIZE (INCHES)	MATERIAL					CONNECTION			ISOLATION VALVES	KEYED NOTES						
	SOFT COPPER TYPE K	HARD COPPER TYPE L	HARD COPPER TYPE M	CARBON STEEL (SCHED. 40)	CARBON STEEL (SCHED. 80)	CARBON STEEL (STD.)	COPPER TYPE DWV	SOLDERED	WELDED		MECHANICALLY FORMED TEE	MECHANICALLY FORMED TEE	BALL	GENERAL SERVICE BUTTERFLY	IN-PIPE BUTTERFLY	GATE
CHILLED WATER SUPPLY & RETURN - MIN. WORKING PRESS. & TEMP., 125 PSIG AT 200 DEG F																
UP TO 2			X						X			X				
UP TO 2	X							X	X			X	X	X		
2-1/2 TO 4			X						X	X			X		A	
2-1/2 TO 4	X							X	X	X		X	X	X		A
HEATING HOT WATER SUPPLY & RETURN - MIN. WORKING PRESS. & TEMP., 125 PSIG AT 200 DEG F																
UP TO 2			X						X			X				
UP TO 2	X							X	X			X	X	X		
2-1/2 TO 4			X					X	X	X			X		A	
2-1/2 TO 4	X							X	X	X		X	X	X		A
LOW PRESSURE STEAM - MAX. 15 PSIG STEAM WORKING PRESSURE																
UP TO 2-1/2			X						X	X			X			C
3 TO 4			X						X	X			X		A	

GENERAL NOTES

- "X" INDICATES ACCEPTABLE SELECTION. IF MORE THAN ONE SELECTION IS INDICATED FOR A PIPING SYSTEM, CONTRACTOR MAY SELECT FROM THOSE INDICATED SELECTIONS.
- DISSIMILAR-METAL PIPING JOINTS: CONSTRUCT JOINTS USING DIELECTRIC FITTINGS COMPATIBLE WITH BOTH PIPING MATERIALS. IF A BRONZE VALVE CONNECTS THE DISSIMILAR METALS NO FURTHER DIELECTRIC ISOLATION IS REQUIRED.
 - NPS 2 AND SMALLER: USE BRASS COUPLING, NIPPLE, OR UNION.
 - NPS 2-1/2 AND LARGER: USE DIELECTRIC FLANGE KITS.
- USE UNIONS OR FLANGES AT VALVE AND EQUIPMENT CONNECTIONS.
- DISSIMILAR-METAL PIPING JOINTS, VENTS, SAFETY VALVE PIPING, BLOWDOWN PIPING AND THE LIKE SHALL BE SAME PIPING MATERIAL AS ASSOCIATED PIPING SYSTEM.
- GROOVED END VALVES MAY BE USED WITH GROOVED PIPING.

KEYED NOTES

- GROOVED AND FLANGED FITTINGS, JOINTS, AND COUPLINGS, IF INDICATED AS AN ACCEPTABLE SELECTION, MAY BE USED IN ACCESSIBLE LOCATIONS FOR THIS PIPING SYSTEM ONLY. ACCESSIBLE LOCATIONS ARE DEFINED AS EXPOSED CONSTRUCTION OR ABOVE LAY-IN CEILINGS.
- BALL VALVE WITH 250 PSIG STEAM TRIM.
- BALL VALVE WITH 150 PSIG STEAM TRIM.

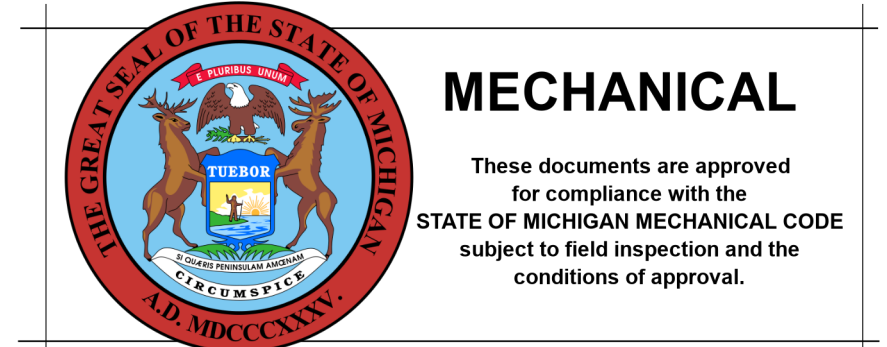

1	OWNER REVIEW	08/02/23
NO.	REVISION	DATE
STATE OF MICHIGAN DEPARTMENT OF TECHNOLOGY, MANAGEMENT AND BUDGET FACILITIES AND BUSINESS SERVICES ADMINISTRATION DESIGN AND CONSTRUCTION DIVISION ADAM LACH, R.A. DIRECTOR		
FILE NO. 491/20167.SDW		
FUNDING CODE 171CODHHS7255		CONTRACT NO. Y22003
WTA ARCHITECTS 100 S. Jefferson Ave, Suite 601 Saginaw, Michigan 48607 989 752 8107 COPYRIGHT © 2023		
PROJECT TITLE 491/20167.SDW - PHASE 500: CENTER FOR FORENSIC PSYCHIATRY - CREATE KITCHEN SALINE, MICHIGAN		
SHEET TITLE MECHANICAL SCHEDULES		
PROJECT NUMBER 2021094	SHEET NUMBER	
PROJECT DATE AUGUST 23, 2023	M7.02	
CHECKED BY WEK		



AIR HANDLING UNIT SUPPLY AIR FAN SCHEDULE																			
UNIT IDENTIFICATION	SYSTEM SERVED	TYPE	AIRFLOW CFM	E.S.P. IN. W.G.	T.S.P. IN. W.G.	MINIMUM WHEEL DIAMETER INCHES	RPM	FAN CLASS	MOTOR				MODULATION/CONTROL TYPE	ELECTRICAL				MODEL NUMBER	KEYED NOTES
									BHP	HP	RPM	DRIVE TYPE		VOLTS	PHASE	SCCR KA (NOTE 5)	OPTIONS/ACCESSORIES		
RF-1	AHU-21H	CENTRIFUGAL	10,000	1.0	1.19	22.25	2403	2	5.12	7.5	1750	DIRECT	VFD	460	3			CAH021GDGC	

- GENERAL NOTES:**
- REFER TO SCHEDULES GENERAL NOTES.
 - MODEL NUMBERS ARE DAIKIN UNLESS OTHERWISE NOTED.
 - DESIGN MINIMUM OUTSIDE AIRFLOW CFM (VENTILATION) LISTED IS BASED ON THE ESTIMATED MAXIMUM OCCUPANT LOAD. REFER TO TEMPERATURE CONTROL DRAWINGS FOR OUTSIDE AIR CONTROL SEQUENCE.
 - REFER TO AIR HANDLING UNIT FILTER SCHEDULE FOR AIR PRESSURE DROP TO BE USED FOR TOTAL STATIC PRESSURE CALCULATIONS.
 - CONTROLLER (E.G. VARIABLE FREQUENCY CONTROLLER, MOTOR STARTER) FOR SPECIFIED EQUIPMENT SHALL BE MANUFACTURED AND MARKED PER NEC WITH A MINIMUM SHORT CIRCUIT CURRENT RATING AS INDICATED.

- KEYED NOTES:**
- PROVIDE BUNNY CORD MAINTENANCE LED LIGHT 235" LONG, WITH MAGNETIC BASE AND FLEXIBLE CORD
 - PROVIDE TWO BLANK OFF SHEETS FOR SUPPLY FAN

MODULAR AIR HANDLING UNIT DIMENSIONS							
UNIT IDENTIFICATION	MAXIMUM UNIT LENGTH	MAXIMUM UNIT WIDTH	MAXIMUM UNIT HEIGHT	MAXIMUM UNIT WEIGHT POUNDS	MANUFACTURER LEAD TIME	MANUFACTURER	KEYED NOTES
AHU-21H	310"	90"	58"	5504	---	DAIKIN	1
AHU-22H	166"	80"	52"	2877	---	DAIKIN	1

- GENERAL NOTES:**
- FOR REFERENCE ONLY

- KEYED NOTES:**
- AHU TO BE SHIPPED IN SECTIONS AND THEN BROKEN DOWN TO FIT THROUGH DOORWAYS. CONTRACTOR TO REASSEMBLE AHU IN ROOM UNDER DIRECTION FROM MANUFACTURER

MODULAR AIR HANDLING UNIT COMPONENT SCHEDULE										
UNIT IDENTIFICATION	POSITION NUMBER 1	POSITION NUMBER 2	POSITION NUMBER 3	POSITION NUMBER 4	POSITION NUMBER 5	POSITION NUMBER 6	POSITION NUMBER 7	POSITION NUMBER 8	POSITION NUMBER 9	KEYED NOTES
AHU-21H	PLENUM	ACCESS	RF-1	ECONOMIZER	AF-1	HC-1	CC-1	ACCESS	SF-1	1
AHU-22H	PLENUM	AF-2	HC-2	ACCESS	SF-2	---	---	---	---	1

- GENERAL NOTES:**
- MODULES SELECTED BASED ON DAIKIN INDOOR MODULAR CLIMATE CHANGER AIR HANDLING UNIT.
 - POSITION NUMBERS ARE INDICATED IN THE DIRECTION OF AIRFLOW FROM RETURN AIR INLET TO SUPPLY AIR DISCHARGE.

- KEYED NOTES:**
- AHU TO BE SHIPPED IN SECTIONS AND THEN BROKEN DOWN TO FIT THROUGH EXISTING DOORWAYS. CONTRACTOR TO REASSEMBLE AHU IN ROOM UNDER DIRECTION FROM MANUFACTURER
 - AHU IS PRE-PURCHASED AND ASSIGNED TO THE CONTRACTOR FOR DELIVERY AND INSTALLATION

AIR HANDLING UNIT FILTER SCHEDULE																
UNIT I.D.	SYSTEM SERVED	TYPE	AIRFLOW CFM	AIR PRESS. DROP			EFFICIENCY	FILTER MEDIA				HOUSING		MODEL NO.	KEYED NOTES	
				INITIAL IN. W.G.	DIRTY IN. W.G.	MERV		QUAN.	WIDTH IN.	DEPTH IN.	MIN. MEDIA FACE AREA SQ. FT.	ACCESS TYPE	WIDTH IN.			HEIGHT IN.
AF-1	AHU-21H	PLEATED	10,000	0.22	1.0	8	3/3	24/24	24/20	2	20	SIDE	18	48	CAH021GDGC	
AF-1	AHU-21H	VARICEL SH CARTRIDGE	10,000	0.53	1.5	13	3/3	24/24	24/20	12	20	SIDE	18	48	CAH021GDGC	
AF-2	AHU-22H	PLEATED	8700	0.08	1.0	8	3/6/3	24/20/12	24/24/24	2/2/2	12/20/6	SIDE	26	42	CAH018GDGM	

- GENERAL NOTES:**
- MODEL NUMBERS ARE FAIR UNLESS OTHERWISE NOTED.
 - PROVIDE 25% TO 30% EFFICIENT 2 INCH THROW AWAY PREFILTERS
 - MERV DESIGNATES THE "MINIMUM EFFICIENCY REPORTING VALUE" AS EVALUATED UNDER ASHRAE STANDARD 52.2 1999.
 - AIR HANDLING UNIT TOTAL STATIC PRESSURE FOR VARIABLE AIR VOLUME SYSTEMS IS BASED ON THE FILTER DIRTY AIR PRESSURE DROP AND AVERAGE/MOULFE FILTER AIR PRESSURE DROP FOR CONSTANT VOLUME SYSTEMS UNLESS NOTED OTHERWISE.

- KEYED NOTES:**
- PROVIDE THREE SETS OF EACH TYPE OF FILTER

AIR HANDLING UNIT SUPPLY AIR FAN SCHEDULE																				
UNIT IDENTIFICATION	SYSTEM SERVED	TYPE	AIRFLOW CFM	OUTSIDE AIR FLOW CFM	E.S.P. IN. W.G.	T.S.P. IN. W.G.	MINIMUM WHEEL DIAMETER INCHES	RPM	FAN CLASS	MOTOR				MODULATION/CONTROL TYPE	ELECTRICAL				MODEL NUMBER	KEYED NOTES
										BHP	HP	RPM	DRIVE TYPE		VOLTS	PHASE	SCCR KA (NOTE 5)	OPTIONS/ACCESSORIES		
SF-1	AHU-21H	CENTRIFUGAL	10,000	3000	2.0	4.89	24.5	1796	2	11.29	15.0	1750	DIRECT	VFD	460	3		CAH021GDGC		
SF-2	AHU-22H	CENTRIFUGAL	8700	8700	1.5	3.51	18.25	3650	2	7.9	10	3500	DIRECT	VFD	460	3				

- GENERAL NOTES:**
- REFER TO SCHEDULES GENERAL NOTES.
 - MODEL NUMBERS ARE DAIKIN UNLESS OTHERWISE NOTED.
 - DESIGN MINIMUM OUTSIDE AIRFLOW CFM (VENTILATION) LISTED IS BASED ON THE ESTIMATED MAXIMUM OCCUPANT LOAD. REFER TO TEMPERATURE CONTROL DRAWINGS FOR OUTSIDE AIR CONTROL SEQUENCE.
 - REFER TO AIR HANDLING UNIT FILTER SCHEDULE FOR AIR PRESSURE DROP TO BE USED FOR TOTAL STATIC PRESSURE CALCULATIONS.
 - CONTROLLER (E.G. VARIABLE FREQUENCY CONTROLLER, MOTOR STARTER) FOR SPECIFIED EQUIPMENT SHALL BE MANUFACTURED AND MARKED PER NEC WITH A MINIMUM SHORT CIRCUIT CURRENT RATING AS INDICATED.

- KEYED NOTES:**
- PROVIDE BUNNY CORD MAINTENANCE LED LIGHT 235" LONG, WITH MAGNETIC BASE AND FLEXIBLE CORD
 - PROVIDE TWO BLANK OFF SHEETS FOR SUPPLY FAN

CHILLED WATER COOLING COIL SCHEDULE																			
UNIT IDENTIFICATION	SYSTEM SERVED	MAXIMUM NUMBER ROWS	MAXIMUM FIN DENSITY FINS/INCH	TOTAL CAPACITY MBH	AIRFLOW CFM	AIR					MINIMUM FACE AREA SQ. FT.	WATER			CONTROL VALVE W.P.D. FT. HEAD	MODEL NUMBER	KEYED NOTES		
						E.D.B. °F	E.W.B. °F	L.D.B. °F	L.W.B. °F	MAXIMUM A.P.D. IN. W.G.		FLOW GPM	FLUID TYPE	E.W.T. °F				L.W.T. °F	MAXIMUM W.P.D. FT. HEAD
CC-1	AHU-21H	6	9	388.6	10000	79.7	65.9	53.9	53.0	0.69	20.1	63.7	W	44.0	56.2	16.0	15	SWL0906B	#

- GENERAL NOTES:**
- MODEL NUMBERS ARE DAIKIN UNLESS OTHERWISE NOTED.
 - COIL SELECTIONS BASED ON .0025 FOULING FACTOR.
 - FLUID TYPE: W = WATER, PGXX = PROPYLENE GLYCOL SOLUTION XX PERCENTAGE OF GLYCOL, EGXX = ETHYLENE GLYCOL SOLUTION XX PERCENTAGE OF GLYCOL.

HOT WATER HEATING COIL SCHEDULE																	
UNIT IDENTIFICATION	SYSTEM SERVED	MAXIMUM NUMBER ROWS	MAXIMUM FIN DENSITY FINS/INCH	CAPACITY MBH	AIRFLOW CFM	AIR					MINIMUM FACE AREA SQ. FT.	WATER			CONTROL VALVE W.P.D. FT. HD.	MODEL NUMBER	KEYED NOTES
						E.D.B. °F	E.W.B. °F	MAXIMUM A.P.D. IN. W.G.	FLOW GPM	FLUID TYPE		E.W.T. °F	L.W.T. °F	MAXIMUM W.P.D. FT. HEAD			
HC-1	AHU-21H	2	10	305.5	10000	43.0	70.9	0.30	15.1	19.7	PG35	130	99	2.00	15	5WH1002B	
HC-2	AHU-22H	2	10	804.5	8700	-10.0	82.0	0.33	16.0	42.2	PG35	130	94	8.6	15	5WH1002C	

- GENERAL NOTES:**
- MODEL NUMBERS ARE DAIKIN UNLESS OTHERWISE NOTED.
 - COIL SELECTION BASED ON .0025 FOULING FACTOR.
 - FLUID TYPE: W = WATER, PGXX = PROPYLENE GLYCOL SOLUTION XX PERCENTAGE OF GLYCOL, EGXX = ETHYLENE GLYCOL SOLUTION XX PERCENTAGE OF GLYCOL.

AIR TERMINAL TYPE											
DUCT CONNECTIONS		DISCHARGE SOUND POWER/RADIATED SOUND POWER - dB					DIMENSIONS		MODEL NUMBER	KEYED NOTES	
INLET SIZE INCHES	OUTLET SIZE INCHES	125 Hz	250 Hz	500 Hz	1000 Hz	2000 Hz	4000 Hz	LENGTH INCHES			HEIGHT INCHES
6e	12x8	73/66	69/63	62/52	56/42	53/40	49/36			ESV	1
8e	12x10	72/68	70/59	66/53	63/47	57/46	53/46			ESV	2
10e	14x12-1/2	78/71	70/61	65/56	61/50	58/47	53/45			ESV	3
12e	16x15	76/72	73/63	69/59	65/53	61/48	57/46			ESV	4
16e	24x18	78/70	73/63	70/58	68/53	64/52	59/50			ESV	5
24x16	38x18	83/74	81/69	76/63	74/54	73/48	68/41			ESV	6

- GENERAL NOTES:**
- MODEL NUMBERS ARE TITUS UNLESS OTHERWISE NOTED.
 - MAXIMUM SOUND POWER LEVEL BASED ON 2" PRESSURE DROP ACROSS UNIT WITH NO ALLOWANCE FOR EXTERNAL ATTENUATION.

- KEYED NOTES:**
- BASED ON 350 CFM
 - BASED ON 650 CFM
 - BASED ON 900 CFM
 - BASED ON 1500 CFM
 - BASED ON 2500 CFM
 - BASED ON 5300 CFM

AIR TERMINAL UNIT WITH HOT WATER COIL SCHEDULE																			
UNIT IDENTIFICATION	INLET SIZE	AREA SERVED	UNIT SERVED FROM	AIR FLOW					HEATING COIL (NOTE 3)										KEYED NOTES
				COOLING MAX CFM	COOLING MIN. CFM	HEATING MIN. CFM	HEATING MAX CFM	MAXIMUM A.P.D. W/COL IN. W.G.	CAPACITY MBH	NUMBER ROWS	AIR		WATER			CONTROL VALVE			
				E.D.B. °F	L.D.B. °F	FLOW GPM	FLUID TYPE	E.W.T. °F	L.W.T. °F	MAXIMUM W.P.D. FT. HEAD	CONTROL VALVE W.P.D. FT. HEAD	CONTROL VALVE TYPE							
VBR-H108	6	H132,H119, H133	AHU-21H	260	80	80	260	0.11	5.0	2	55.0	90.0	0.5	PG35	130	100	0.29	15	3-WAY
VBR-H109	12	DINING H131	AHU-21H	1080	325	325	1080	0.16	20.6	2	55.0	90.0	1.2	PG35	130	100	1.41	15	3-WAY
VBR-H110	12	DINING H131	AHU-21H	1080	325	325	1080	0.16	20.6	2	55.0	90.0	1.2	PG35	130	100	1.41	15	3-WAY
VBR-H111	12	DINING H131/SERVERY H130	AHU-21H	1280	325	325	1280	0.22	24.4	2	55.0	90.0	1.5	PG35	130	100	2.77	15	3-WAY
VBR-H112	12	DINING H131/SERVERY H130	AHU-21H	1280	325	325	1280	0.22	24.4	2	55.0	90.0	1.5	PG35	130	100	2.77	15	3-WAY
VBR-H113	12	KITCHEN H123	AHU-21H	1260	325	325	1260	0.21	24.0	2	55.0	90.0	1.4	PG35	130	100	2.63	15	3-WAY
VBR-H114	12	KITCHEN H123	AHU-21H	1375	325	325	1375	0.22	24.3	2	55.0	90.0	1.5	PG35	130	100	2.74	15	3-WAY
VBR-H115	6	BREAK ROOM H127	AHU-21H	205	80	80	205	0.08	4.0	2	55.0	90.0	0.5	PG35	130	100	0.11	15	3-WAY
VBR-H116	12	KITCHEN H123	AHU-21H	1330	325	325	1330	0.30	25.3	2	55.0	90.0	1.5	PG35	130	100	1.78	15	3-WAY
VBR-H117	6	OFFICE H125	AHU-21H	200	80	80	200	0.07	3.9	2	55.0	90.0	0.5	PG35	130	100	0.10	15	3-WAY
VBR-H118	8	CORRIDOR H122	AHU-21H	600	145	145	600	0.34	11.5	2	55.0	90.0	0.7	PG35	130	100	4.95	15	3-WAY
VBR-H119	6	STORAGE H124	AHU-21H	150	80	80	150	0.03	3.1	1	55.0	90.0	0.5	PG35	130	100	0.05	15	3-WAY

- GENERAL NOTES:**
- MODEL NUMBERS ARE TITUS UNLESS OTHERWISE NOTED.
 - MAXIMUM PRESSURE DROP SCHEDULED SHALL BE THE MAXIMUM ALLOWABLE STATIC PRESSURE FOR BOX AND COIL AT THE MAXIMUM CFM.
 - HEATING COIL SELECTION BASED ON HEATING MAXIMUM AIR FLOW.
 - FLUID TYPE: W = WATER, PGXX = PROPYLENE GLYCOL SOLUTION XX PERCENTAGE OF GLYCOL, EGXX = ETHYLENE GLYCOL SOLUTION XX PERCENTAGE OF GLYCOL.

KITCHEN EXHAUST DUCT REQUIREMENT SCHEDULE							
EXHAUST SYSTEM	MINIMUM DESIGN PRESSURE	MINIMUM DESIGN TEMPERATURE (DEG. F)	WORKING PRESSURE	TEST PRESSURE	LIGHT TEST	TEST TIME	ALLOWABLE LEAKAGE
GREASE DUCT	20 PSIG	>200	-5" PSIG	20 PSIG	TEST ALL JOINTS PER NFPA 96	2 HOURS	NONE

- NOTES:**
- CONTRACTOR TO TEST ALL JOINT PER NFPA 96
 - CAP END OF GREASE DUCTS AND TEST WITH COMPRESSED AIR, REDD JOIST THAT DO NOT PASS, HOLD TEST FOR MINIMUM 2 HOURS

PUMP SCHEDULE																				
UNIT IDENTIFICATION	SYSTEM SERVED	LOCATION	TYPE	COUPLING TYPE	WATERFLOW GPM	FLUID TYPE	COLDEST SYSTEM OPERATING TEMP. °F FOR PUMP SELECTION	PUMP HEAD FT.	OVERLOAD GPM	MINIMUM EFFICIENCY %	MOTOR			MODULATION/CONTROL TYPE	ELECTRICAL				MODEL NUMBER	KEYED NOTES
											BHP	HP	RPM		VOLTS	PHASE	SCCR KA (NOTE 4)	OPTIONS/ACCESSORIES		
P-54	HWH	PENTHOUSE	IN-LINE	CLOSE	140	PG35	70 °F	20	NON-OVERLOADING	74.3	0.85	1	1800	AUTO	480	3	5	---	E-90-3AAB	
P-55	HWH	PENTHOUSE	IN-LINE	CLOSE	140	PG35	70 °F	20	NON-OVERLOADING	74.3	0.85	1	1800	AUTO	480	3	5	---	E-90-3AAB	

- GENERAL NOTES:**
- REFER TO SCHEDULES GENERAL NOTES.
 - MODEL NUMBER ARE BELL & GOSSETT UNLESS OTHERWISE NOTED.
 - FLUID TYPE: W = WATER, PGXX = PROPYLENE GLYCOL SOLUTION XX PERCENTAGE OF GLYCOL, EGXX = ETHYLENE GLYCOL SOLUTION XX PERCENTAGE OF GLYCOL.
 - CONTROLLER (E.G. VARIABLE FREQUENCY CONTROLLER, MOTOR STARTER) FOR SPECIFIED EQUIPMENT SHALL BE MANUFACTURED AND MARKED PER NEC WITH A MINIMUM SHORT CIRCUIT CURRENT RATING AS INDICATED.

- KEYED NOTES:**
- PUMPS SIZED FOR CURRENT CONNECTED LOAD, PIPING SIZE FOR WEST BUILDING FUTURE CONNECTED LOAD

1	OWNER REVIEW	08/02/23
NO.	REVISION	DATE

STATE OF MICHIGAN
DEPARTMENT OF TECHNOLOGY, MANAGEMENT AND BUDGET
FACILITIES AND BUSINESS SERVICES ADMINISTRATION
DESIGN AND CONSTRUCTION DIVISION
ADAM LACH, RA, DIRECTOR

FILE NO.
491/20167.SDW

FUNDING CODE
171CODHHS7255

CONTRACT NO.
Y22003

WTAARCH.COM

WTA ARCHITECTS

100 S. Jefferson Ave, Suite 601
Saginaw, Michigan 48607
989 752 8107

COPYRIGHT © 2023

PROJECT TITLE
491/20167.SDW - PHASE 500:

CENTER FOR FORENSIC PSYCHIATRY - CREATE KITCHEN

SALINE, MICHIGAN

SHEET TITLE
MECHANICAL SCHEDULES

PROJECT NUMBER
2021094

PROJECT DATE
AUGUST 23, 2023

CHECKED BY
WEK

SHEET NUMBER
M7.03

PBA

Peter Basso Associates Inc
CONSULTING ENGINEERS

5145 Livernois, Suite 100
Troy, Michigan 48068-3276
Tel: 248-879-5666
Fax: 248-879-0007
www.PeterBassoAssociates.com
PBA Project No. 2021094

POWER VENTILATOR SCHEDULE																																			
UNIT IDENTIFICATION	SYSTEM SERVED	TYPE	AIRFLOW CFM	T.S.P. IN. W.G.	TIP SPEED FPM	FAN RPM	MOTOR				CURB HEIGHT INCHES	MODULATION/CONTROL TYPE	ELECTRICAL				MAXIMUM SOUND POWER LEVELS												MODEL NUMBER	KEYED NOTES					
							BHP	HP	RPM	DRIVE TYPE			VOLTS	PHASE	SCCR KA	OPTIONS/ACCESSORIES	UNIT DISCHARGE Lw BY OCTAVE BAND						UNIT INLET Lw BY OCTAVE BAND												
																	63 HZ (DB)	125 HZ (DB)	250 HZ (DB)	500 HZ (DB)	1000 HZ (DB)	2000 HZ (DB)	4000 HZ (DB)	8000 HZ (DB)	63 HZ (DB)	125 HZ (DB)	250 HZ (DB)	500 HZ (DB)			1000 HZ (DB)	2000 HZ (DB)	4000 HZ (DB)	8000 HZ (DB)	
EF-6H	TOILET H126	CENTRIFUGAL	100	0.25	3161	1486	0.01	1/10	1725	DIRECT	18	AUTO	120	1	5	8	----	----	----	----	----	----	----	----	----	57	61	58	48	47	48	39	32	G-060-VG	
EF-7H	CHEMICAL STORAGE H129	CENTRIFUGAL	200	0.5	3669	1725	0.03	1/15	1725	DIRECT	18	AUTO	120	1	5	8	----	----	----	----	----	----	----	----	----	68	71	69	54	49	47	43	38	G-070-VG	
EF-8H	DISHWASHER HOOD	CENTRIFUGAL	200	0.5	3669	1725	0.03	1/15	1725	DIRECT	18	AUTO	120	1	5	8	----	----	----	----	----	----	----	----	----	68	71	69	54	49	47	43	38	G-070-VG	
EF-9H	KITCHEN HOOD	CENTRIFUGAL	3600	1.0	6693	1538	1.39	2	1725	DIRECT	18	AUTO	208	1	5	8	----	----	----	----	----	----	----	----	----	78	85	86	84	78	74	71	68	CUE-160-VG	
EF-10H	KITCHEN HOOD	CENTRIFUGAL	5100	1.5	7299	1304	2.53	3	1360	DIRECT	18	AUTO	208	3	5	8	----	----	----	----	----	----	----	----	----	93	81	88	74	70	69	67	62	CUE-200-VG	

GENERAL NOTES:
1. REFER TO SCHEDULES GENERAL NOTES.
2. MODEL NUMBERS ARE GREENHECK UNLESS OTHERWISE NOTED.

STEAM HUMIDIFIER SCHEDULE											
UNIT IDENTIFICATION	SYSTEM SERVED	AHU DISTRIBUTION TUBE BANK							MODULATION/CONTROL TYPE	REMARKS	
		QUANTITY REQUIRED	TYPE	MODEL LBS/HR	AHU AIR TEMPERATURE °F	AHU WIDTH INCHES	AHU HEIGHT INCHES	MAXIMUM ABSORPTION DISTANCE INCHES			MODEL
H-1	AHU-21H	1	INSULATED MULTIPLE TUBES	62.8	88.9	78	48	26"	DRISTEEM	AUTO	

NOTE:
1. REFER TO SCHEDULES GENERAL NOTES.
2. MODEL NUMBERS ARE DRISTEEM UNLESS OTHERWISE NOTED.
3. PROVIDE STEAM DISTRIBUTION ASSEMBLY TO AHU MANUFACTURE FOR MOUNTING IN AHU HUMIDIFIER SECTION.

GAS FIRED CONDENSING BOILER SCHEDULE																				
UNIT IDENTIFICATION	TURNDOWN	FUEL		AGA INPUT MBH	AGA OUTPUT MBH	MINIMUM EFFICIENCY (%)	DIMENSIONS			WATER			UNIT CONTROL TYPE	ELECTRICAL				MODEL NUMBER	KEYED NOTES	
		TYPE	MAXIMUM ALLOWABLE OUTPUT AT MINIMUM FIRING RATE (MBH)				DEPTH (IN.)	WIDTH (IN.)	HEIGHT (IN.)	E.W.T. °F	L.W.T. °F	FLOW GPM		MAXIMUM W.P.D. FT. HD.	VOLTS	PHASE	FLA			OPTIONS/ACCESSORIES
B-11	20:1	NAT GAS	100	2000	1800	90	43.6	28	78	90	130	140	7	AUTO	120	1	16	B	BMK2000	
B-12	20:1	NAT GAS	100	2000	1800	90	43.6	28	78	90	130	140	7	AUTO	120	1	16	B	BMK2000	

GENERAL NOTES:
1. REFER TO SCHEDULES GENERAL NOTES.
2. MODEL NUMBERS ARE AERCO UNLESS OTHERWISE NOTED.
3. PROVIDE BOILER WITH CONDENSATE NEUTRALIZATION TANK ASSEMBLY.
4. MINIMUM PRESSURE RATING OF 125 PSIG.

GRILLE, REGISTER, AND DIFFUSER SCHEDULE									
UNIT IDENTIFICATION	TYPE	FACE SIZE	NECK SIZE	FRAME TYPE	ACCESSORY	CONSTRUCTION	FINISH	MODEL NUMBER	KEYED NOTES
S-1	DIFFUSER	24x24	SEE PLANS	LAY-IN	NONE	STEEL	WHITE	500	
R-1	GRILLE	24x24	SEE PLANS	LAY-IN	NONE	ALUMINUM	WHITE	80	
R-2	GRILLE	24x12	SEE PLANS	LAY-IN	NONE	ALUMINUM	WHITE	80	
E-1	GRILLE	12x12	SEE PLAN	LAY-IN	NONE	ALUMINUM	WHITE	80	
E-2	GRILLE	24x24	SEE PLAN	LAY-IN	NONE	ALUMINUM	WHITE	80	
L-1	LOUVER	72x78	SEE PLAN	FLANGED	NONE	ALUMINUM	MILL	ESD-635	1
L-2	LOUVER	66x78	SEE PLAN	FLANGED	NONE	ALUMINUM	MILL	ESD-635	1

GENERAL NOTES:
1. MODEL NUMBERS ARE PRICE UNLESS OTHERWISE NOTED.

KEYED NOTES:
1. MODEL NUMBERS ARE GREENHECK.

HOT WATER CABINET UNIT HEATER SCHEDULE																									
UNIT IDENTIFICATION	CAPACITY MBH	AIR			FAN		WATER				CONTROL VALVE W.P.D. FT. HEAD	DIMENSIONS			RECESS DEPTH INCHES	FILTER TYPE	AREA SQ. FT.	MODULATION/CONTROL TYPE	ELECTRICAL				MODEL NUMBER	KEYED NOTES	
		AREFLOW CFM	E.D.B. °F	L.D.B. °F	HP	RPM	FLOW GPM	FLUID TYPE	E.W.T. °F	L.W.T. °F		MAXIMUM W.P.D. FT. HEAD	LENGTH INCHES	HEIGHT INCHES					DEPTH INCHES	VOLTS	PHASE	SCCR KA			OPTIONS/ACCESSORIES
CUH-3H	19.0	860	60	80.4	1/10	1050	2.8	PG35	130	100	1.5	15	61	44	9.5	9	WASHABLE	3.5	AUTO	120	1	5	B	RC-1200-08	
CUH-4H	19.0	860	60	80.4	1/10	1050	2.8	PG35	130	100	1.5	15	61	44	9.5	9	WASHABLE	3.5	AUTO	120	1	5	B	RC-1200-08	
CUH-5H	30.4	1040	60	86.9	1/10	1050	4.4	PG35	130	100	1.5	15	66	49	9.5	9	WASHABLE	3.5	AUTO	120	1	5	B	RC-1200-10	1
CUH-6H	28.2	845	60	90.8	1/10	1050	4.1	PG35	130	100	1.5	15	61	44	9.5	0	WASHABLE	3.5	AUTO	120	1	5	B	W-1110-08	1

GENERAL NOTES:
1. REFER TO SCHEDULES GENERAL NOTES.
2. MODEL NUMBERS ARE STERLING UNLESS OTHERWISE NOTED.
3. FLUID TYPE: W = WATER, PGXX = PROPYLENE GLYCOL SOLUTION XX PERCENTAGE OF GLYCOL, EDGX = ETHYLENE GLYCOL SOLUTION XX PERCENTAGE OF GLYCOL.

KEYED NOTES:
1. HIGH CAPACITY COIL

HOT WATER PROPELLER FAN UNIT HEATER SCHEDULE																		
UNIT IDENTIFICATION	CAPACITY MBH	AIRFLOW CFM	LEAVING AIR TEMPERATURE °F	FAN		WATER				CONTROL VALVE W.P.D. FT. HEAD	MODULATION/CONTROL TYPE	ELECTRICAL				MODEL NUMBER	KEYED NOTES	
				HP	RPM	FLOW GPM	FLUID TYPE	E.W.T. °F	L.W.T. °F			MAXIMUM W.P.D. FT. HEAD	VOLTS	PHASE	SCCR KA			OPTIONS/ACCESSORIES
UH-8H	12.7	750	104	1/20	1000	1.8	PG35	130	100	0.12	15	AUTO	120	1	----	B	HS-48	
UH-9H	53.0	1800	103	1/12	1000	3.9	PG35	130	100	0.36	15	AUTO	120	1	----	B	HS-108	
UH-10H	53.0	1800	103	1/12	1000	3.9	PG35	130	100	0.36	15	AUTO	120	1	----	B	HS-108	
UH-11H	12.7	750	104	1/20	1000	1.8	PG35	130	100	0.12	15	AUTO	120	1	----	B	HS-48	

GENERAL NOTES:
1. REFER TO SCHEDULES GENERAL NOTES.
2. MODEL NUMBERS ARE STERLING UNLESS OTHERWISE NOTED.
3. FLUID TYPE: W = WATER, PGXX = PROPYLENE GLYCOL SOLUTION XX PERCENTAGE OF GLYCOL, EDGX = ETHYLENE GLYCOL SOLUTION XX PERCENTAGE OF GLYCOL.

HOT WATER FINNED TUBE RADIATION SCHEDULE															
UNIT IDENTIFICATION	CAPACITY BTUH / LINEAR FT.	ENTERING AIR TEMP °F	FLUID TYPE	WATER TEMP.		ENCLOSURE		ELEMENT				CONTROL VALVE W.P.D. FT. HEAD	MODEL NUMBER	KEYED NOTES	
				E.W.T. °F	AVERAGE °F	TYPE	LENGTH INCHES	HEIGHT INCHES	TUBE DIAMETER INCHES	WIDTH INCHES	HEIGHT INCHES				NUMBER OF TIERS
FTR-1	300	65	W	130	110	SLOPE TOP (LWB-S-LT)	SEE PLAN	14	0.75	4.25	3.63	1	15	C3/4-433-14B	

GENERAL NOTES:
1. MODEL NUMBERS ARE STERLING UNLESS OTHERWISE NOTED.
2. FLUID TYPE: W = WATER, PGXX = PROPYLENE GLYCOL SOLUTION XX PERCENTAGE OF GLYCOL, EDGX = ETHYLENE GLYCOL SOLUTION XX PERCENTAGE OF GLYCOL.

HOT WATER RADIANT CEILING PANEL SCHEDULE											
UNIT IDENTIFICATION	CAPACITY BTUH / LINEAR FT.	FLUID TYPE	WATER TEMP.		DIMENSIONS		FINISH	CONSTRUCTION	CONTROL VALVE W.P.D. FT. HEAD	MODEL NUMBER	KEYED NOTES
			E.W.T. °F	L.W.T. °F	LENGTH INCHES	WIDTH INCHES					
ROP-1	142	PG35	130	100	SEE PLANS	12	WHITE	STEEL	15	RC-4	

GENERAL NOTES:
1. MODEL NUMBERS ARE RENTAL UNLESS OTHERWISE NOTED.
2. EXTRUDED ARCHITECTURAL SPACE MASTERY SERIES HEF-2 FLUTED.
3. FLUID TYPE: W = WATER, PGXX = PROPYLENE GLYCOL SOLUTION XX PERCENTAGE OF GLYCOL, EDGX = ETHYLENE GLYCOL SOLUTION XX PERCENTAGE OF GLYCOL.

VARIABLE FREQUENCY CONTROLLER SCHEDULE					
UNIT IDENTIFICATION	SYSTEM SERVED	LOCATION	RATED HORSEPOWER	OPERATING HORSEPOWER	REMARKS
VFC-AHU-21H-SF	SF-1	SEE DRAWINGS	15	11.3	PRIMARY
VFC-AHU-21H-RF	RF-1	SEE DRAWINGS	7.5	5.1	PRIMARY
VFC-AHU-22H-SF	SF-2	SEE DRAWINGS	10	7.9	PRIMARY
VFC-EF-9H	EF-9H	SEE DRAWINGS	2	1.4	PRIMARY
VFC-EF-10H	EF-10H	SEE DRAWINGS	3	2.5	BACKUP

NOTE:
1. REFER TO SPECIFICATIONS FOR APPROVED MANUFACTURERS.
2. REFER TO ELECTRICAL WIRING DIAGRAM FOR CONNECTION REQUIREMENTS.

g:\2021\2021-0402-00\CA0\2021-0402-07-SH4.dwg, M-704, 9/5/2023 4:33:11 PM, Gerard Heinrich, Peter Basso Associates Inc.

1	OWNER REVIEW	08/02/23
NO.	REVISION	DATE

STATE OF MICHIGAN
DEPARTMENT OF TECHNOLOGY, MANAGEMENT AND BUDGET
FACILITIES AND BUSINESS SERVICES ADMINISTRATION
DESIGN AND CONSTRUCTION DIVISION
ADAM LACH, R.A. DIRECTOR

FILE NO.
491/20167.SDW

FUNDING CODE
171CODHHS7255

CONTRACT NO.
Y22003



WTA ARCHITECTS

100 S. Jefferson Ave, Suite 601
Saginaw, Michigan 48607
989 752 8107

WTAARCH.COM


COPYRIGHT © 2023

PROJECT TITLE
491/20167.SDW - PHASE 500:
CENTER FOR FORENSIC
PSYCHIATRY - CREATE
KITCHEN
SALINE, MICHIGAN

SHEET TITLE
MECHANICAL SCHEDULES

PROJECT NUMBER 2021094	SHEET NUMBER M7.04
PROJECT DATE AUGUST 23, 2023	
CHECKED BY WEK	

Peter Basso Associates Inc
CONSULTING ENGINEERS
5145 Livernois, Suite 100
Troy, Michigan 48068-3276
Tel: 248-879-5666
Fax: 248-879-0007
www.PeterBassoAssociates.com
PBA Project No. 2021-0942

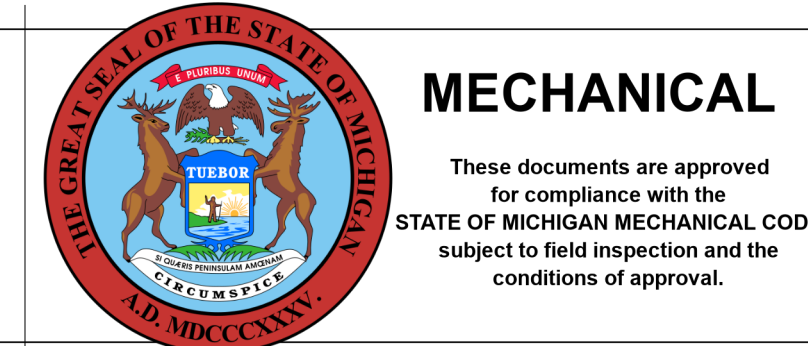

MECHANICAL

These documents are approved for compliance with the STATE OF MICHIGAN MECHANICAL CODE subject to field inspection and the conditions of approval.

SEQUENCE OF OPERATION


AIR HANDLING UNIT AHU-21H CONTROL:
 NOTE: ALL SETPOINTS DESCRIBED IN SEQUENCE SHALL BE ADJUSTABLE BY SYSTEM OPERATORS (CREATE REQUIRED VIRTUAL POINTS). APPROPRIATE DEADBANDS SHALL BE USED TO PREVENT SHORT CYCLING SITUATIONS. ALL FAN MOTOR CONTROL SWITCHES SHALL BE IN 'AUTO' POSITION.

- SUPPLY SHALL HAVE START/STOP CAPABILITY FROM THE DDC SYSTEM. AHU SHALL OPERATE BASED ON TIME SCHEDULED OCCUPIED MODE COMPENSATED BY OPTIMUM START PROGRAM AND UNOCCUPIED CYCLE MODE. OPTIMUM START PROGRAM SHALL DETERMINE REQUIRED LEAD TIME TO ACHIEVE DESIRED SPACE TEMP AT BUILDING OCCUPANCY (BASED ON TRENDED DATA).
 - RETURN FAN SHALL BE ACTIVATED WITH SUPPLY FAN DURING OCCUPIED MODE.
 - EACH SF AND RF STATUS SHALL BE MONITORED BY DDC THRU RESPECTIVE FAN AUX CONTACT SWITCH. ABNORMAL STATUS CONDITION SHALL ACTIVATE ALARM.
 - VFC COMMON FAILURE ALARM FOR EACH FAN OR FAN WALL SYSTEM SHALL BE MONITORED BY DDC THRU FAULT STATUS AT RESPECTIVE FAN VFC.
 - WHEN AHU IS ACTIVATED DURING OCCUPIED MODE, OUTSIDE & RETURN AIR (MIXED AIR) DAMPERS SHALL BE ALLOWED TO MODULATE, AS DESCRIBED. WHEN AHU IS DEACTIVATED OR OPERATING IN UNOCCUPIED CYCLE MODE OR MORNING WARM-UP MODE, DAMPERS SHALL REMAIN IN NORMAL POSITIONS (FULL CLOSED TO OA).
 - DURING THE OCCUPIED PERIOD, THE OUTSIDE AIR FLOW MEASURING DEVICE THROUGH DDC SHALL MODULATE THE OUTSIDE AIR DAMPER (D-1) AND RECIRCULATION DAMPER (D-2) TO MAINTAIN A MINIMUM OUTSIDE AIR FLOW VOLUME RANGE BETWEEN OA MINIMUM AND OA MAXIMUM BASED ON DEMAND VENTILATION RESET CONTROL. THE DEMAND VENTILATION CONTROL THROUGH DDC SHALL MONITOR THE AHU'S RESPECTIVE RETURN AIR CO2 SENSOR. IF ALL THE ASSOCIATED AHU'S RETURN CO2 SENSOR IS READING 800 PPM OR BELOW, THE AHU'S OA MINIMUM SHALL BE MAINTAINED. IF THE ASSOCIATED AHU'S RETURN CO2 SENSOR IS READING ABOVE 800 PPM, THE AHU'S OUTSIDE AIR DAMPER SHALL BE MODULATED TOWARD THE OA MINIMUM MAXIMUM POSITION TO PREVENT CO2 LEVELS FROM RISING ABOVE 1,100 PPM. IF THE RETURN CO2 LEVEL RISES ABOVE 1,100 PPM, THE ASSOCIATED AHU'S OUTSIDE AIR DAMPERS SHALL BE CONTROLLED TO THE MINIMUM MAXIMUM POSITION. ALL SETPOINTS SHALL BE ADJUSTABLE THROUGH THE DDC SYSTEM.
 - WHEN DISCHARGE AIR TEMP IS BELOW HEATING SETPOINT, DDC SHALL KEEP MIXED AIR DAMPERS AT MINIMUM OA POSITION AND MODULATE HEATING COIL VALVE TO ACHIEVE DISCHARGE AIR SETPOINT.
 - DURING MORNING WARM-UP OR UNOCCUPIED MODE HEATING CYCLE, DAT SETPOINT SHALL BE 95F UNTIL BUILDING OCCUPANCY TIME OR WHEN SPACE TEMPERATURE SETPOINT IS REACHED.
 - WHEN SPACE TEMP IS ABOVE COOLING SETPOINT AND OUTDOOR AIR TEMPERATURE IS GREATER THAN 70F, DDC SHALL KEEP MIXED AIR DAMPERS AT MINIMUM OA POSITION AND THE COOLING COIL CONTROL VALVE SHALL BE MODULATED TO MAINTAIN DISCHARGE AIR TEMP SETPOINT.
 - WHEN DISCHARGE TEMP IS ABOVE COOLING SETPOINT AND OUTDOOR AIR TEMP SETPOINT BASED ON THE FOLLOWING OUTDOOR AIR TEMP RESET SCHEDULE:
- | | |
|-------|-----|
| OA1 | OA1 |
| ≤ 25F | 60F |
| 2 55F | 55F |
- SF VFC SHALL BE MODULATED BY DDC TO MAINTAIN REMOTE SYSTEM SUPPLY AIR STATIC PRESSURE SETPOINT OF .75" W.G. (TO BE ADJUSTED BY THE AIR BALANCE CONTRACTOR). (REFER TO PLANS FOR LOCATION OF REMOTE STATIC PRESSURE SENSOR).
 - DISCHARGE STATIC PRESSURE HIGH LIMIT AT ERU WITH SETPOINT OF 5.0" W.G. SHALL PROVIDE OVERRIDE CONTROL OF SUPPLY FAN SPEED AND HIGH LIMIT SWITCH WITH SETPOINT OF 5.5" W.G. SHALL PROVIDE HARDWIRED SAFETY. DDC SHALL ACTIVATE ALARM IF OPERATING IN OVERRIDE CONDITION.
 - RF VFC SHALL BE MODULATED TO MAINTAIN A CFM DIFFERENTIAL SETPOINT BETWEEN SUPPLY AIRFLOW AND EXHAUST AIRFLOW. REFER TO CFM OFFSET SCHEDULES THIS SHEET FOR SUPPLY AND EXHAUST AIRFLOW DIFFERENTIAL.
 - FREESTAT(S) SHALL DEACTIVATE SF & INTERLOCKED EF WHEN TEMPERATURE IS 35F OR BELOW. DDC SHALL MONITOR FREESTAT STATUS AND ACTIVATE ALARM IF CONDITION OCCURS.
 - DUCT SMOKE DETECTOR(S) SHALL DEACTIVATE SF & EF WHEN PRODUCTS OF COMBUSTION ARE DETECTED.
 - IF AHU IS DEACTIVATED, OUTDOOR AIR DAMPER SHALL CLOSE, CHILLED WATER COOLING COIL VALVE SHALL REMAIN CLOSED AND HEATING COIL VALVE SHALL BE MODULATED TO MAINTAIN A LOW LIMIT PLENUM TEMPERATURE SETPOINT OF 50F (BASED ON READING AT NEAREST TEMP SENSOR).

SUPPLY AND EXHAUST FAN OFFSET SCHEDULE


UNIT ID	SF/RF OFFSET
AHU-21H	300

NOTE: ALL SETPOINTS SHALL BE ADJUSTABLE THROUGH DDC

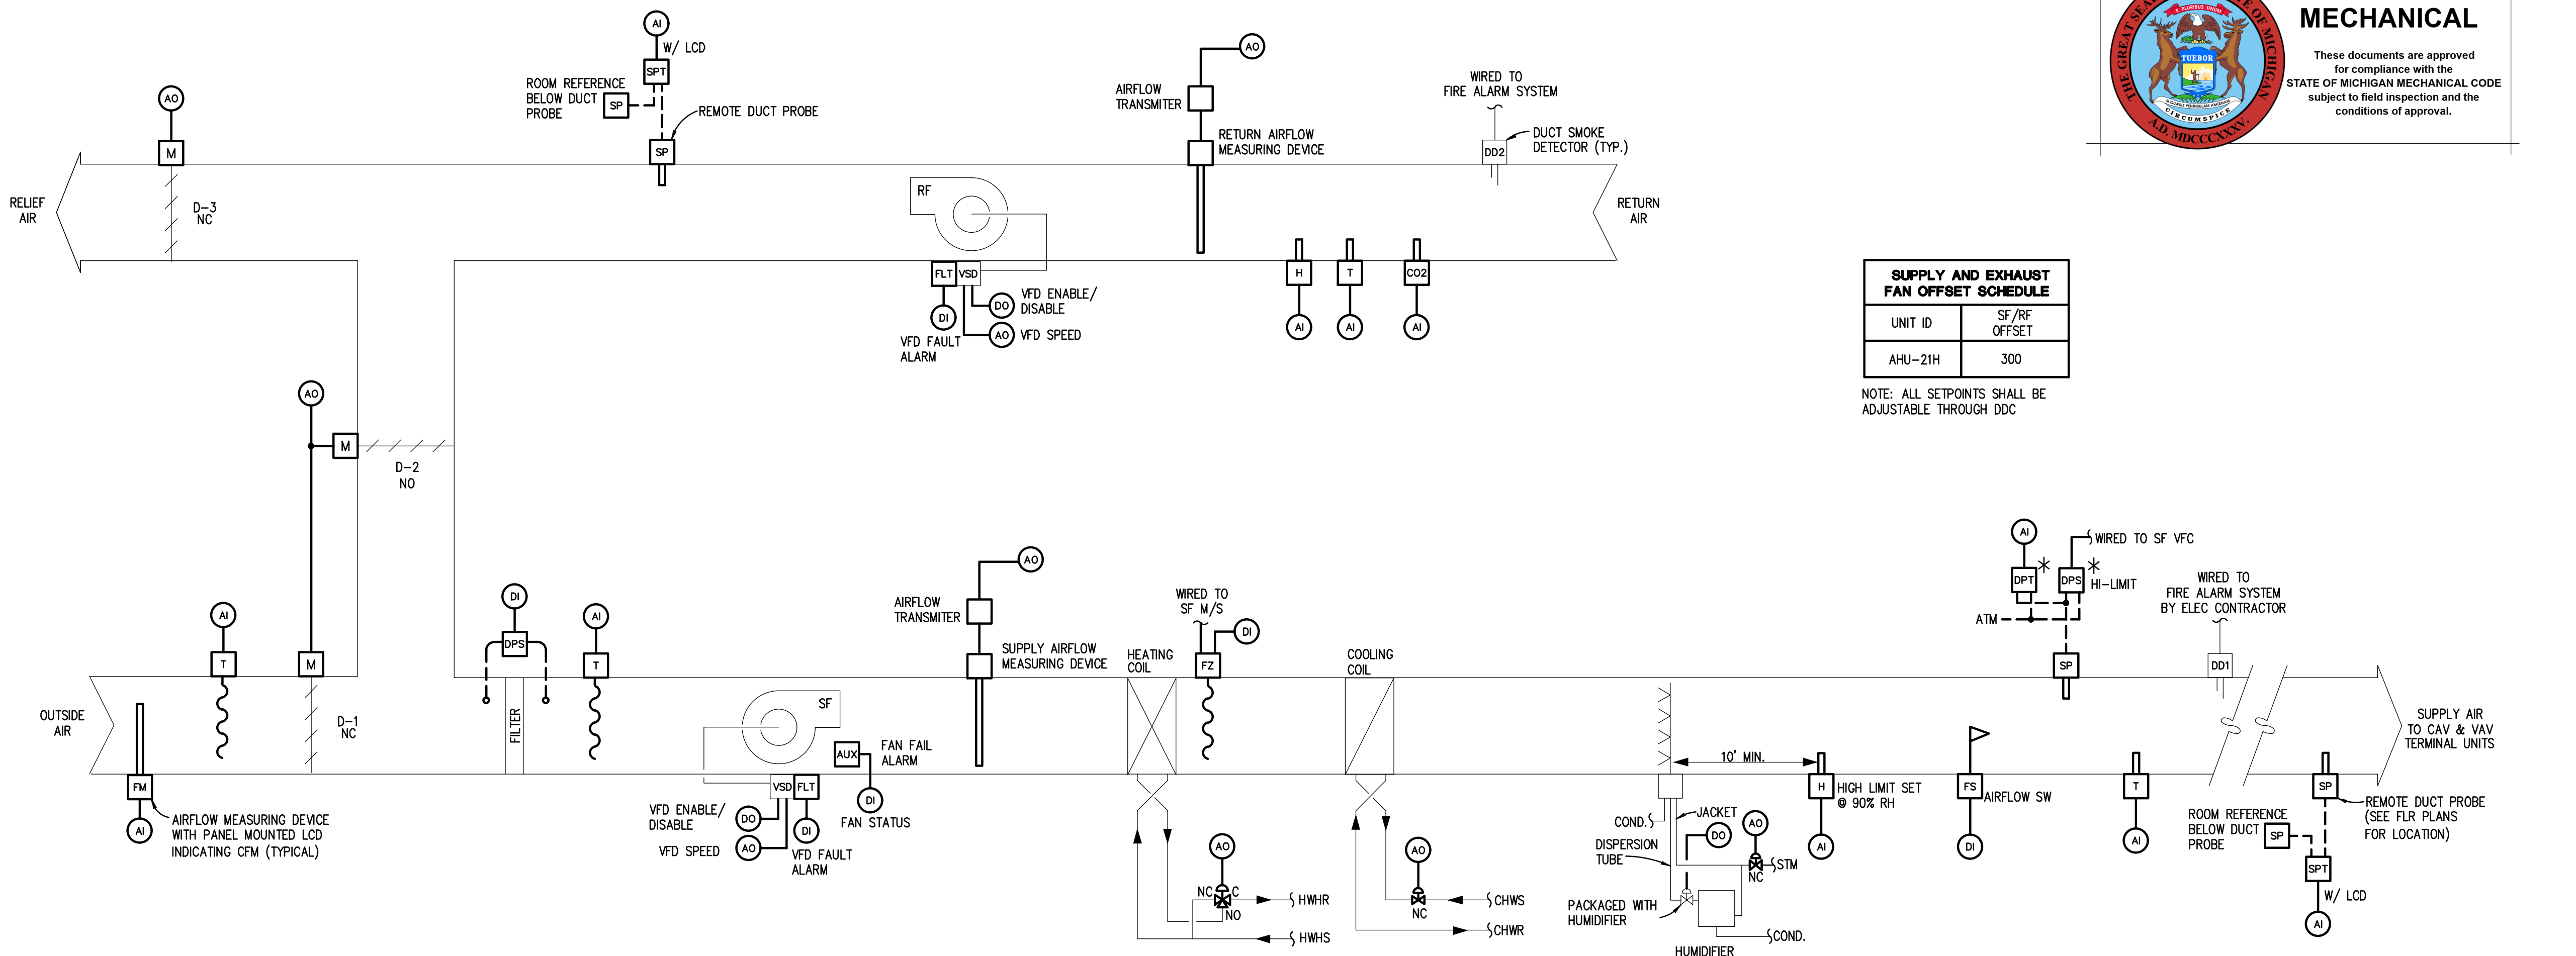


AIR HANDLING UNIT AHU-21H CONTROL SCHEMATIC

- NO SCALE SERVES DINING ROOM AND KITCHEN
- NOTES:
- DAMPERS SHALL BE FURNISHED AND FACTORY INSTALLED BY AHU MANUFACTURER. TO CONTRACTOR SHALL PROVIDE DAMPER ACTUATORS.
 - ELECTRICAL CONTRACTOR SHALL PROVIDE FIRE ALARM SYSTEM COMPONENTS AND WIRING FROM FIRE ALARM PANEL TO CONTROL MODULE. TO CONTRACTOR SHALL PROVIDE WIRING FROM CONTROL MODULE TO VFC SAFETY CIRCUIT.
 - COORDINATE EXACT CONTROL, WIRING, AND INTERFACE REQUIREMENTS WITH EQUIPMENT SUPPLIER. REQUIREMENTS MAY VARY DEPENDING ON MANUFACTURER.

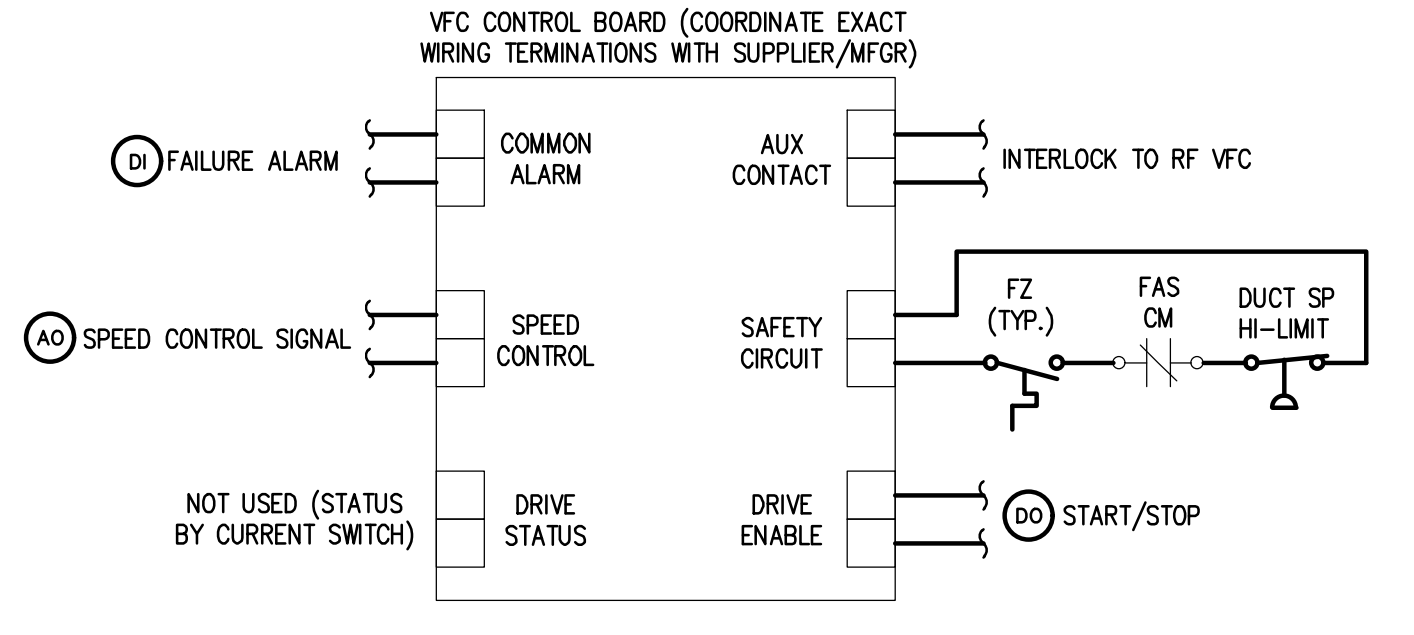


AHU-21H SF VFC WIRING

NOTE:
 1. WIRING DETAIL IDENTIFIES INTENT AND DOES NOT INDICATE ACTUAL WIRING REQUIREMENTS. CONSULT WITH VFC SUPPLIER FOR THE ACTUAL WIRING REQUIREMENTS.

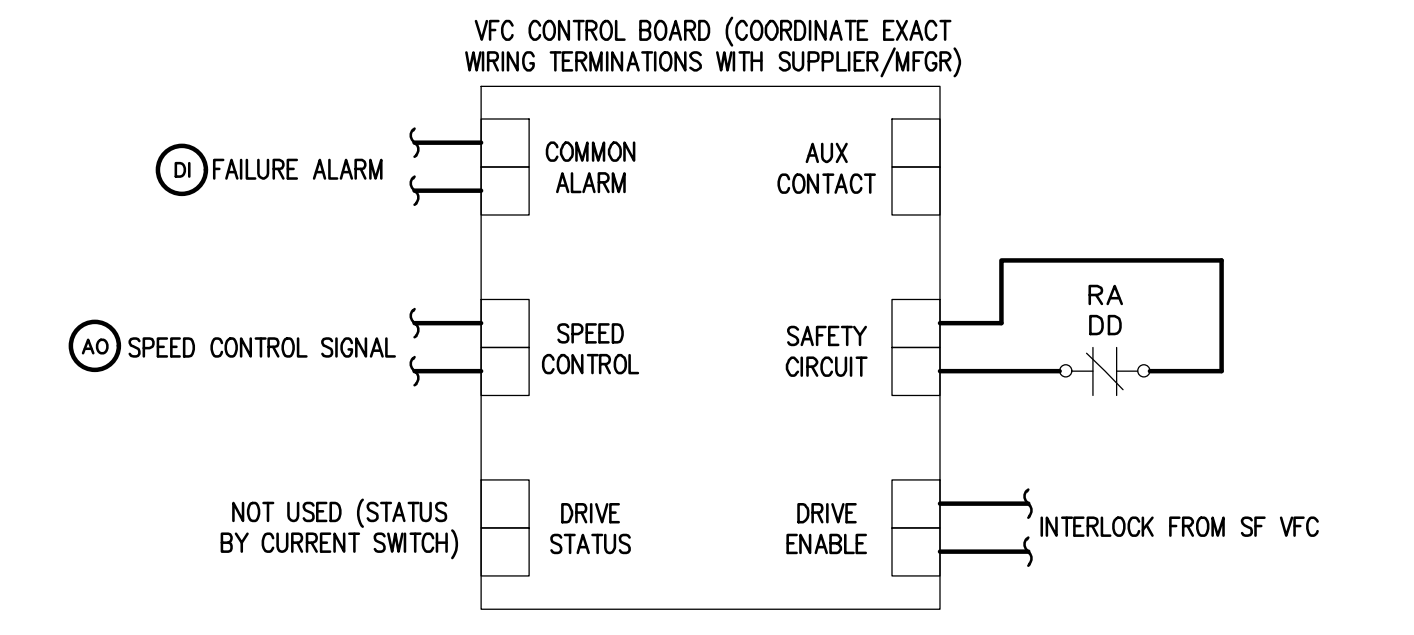

AHU-21H RF VFC WIRING

NOTE:
 1. WIRING DETAIL IDENTIFIES INTENT AND DOES NOT INDICATE ACTUAL WIRING REQUIREMENTS. CONSULT WITH VFC SUPPLIER FOR THE ACTUAL WIRING REQUIREMENTS.

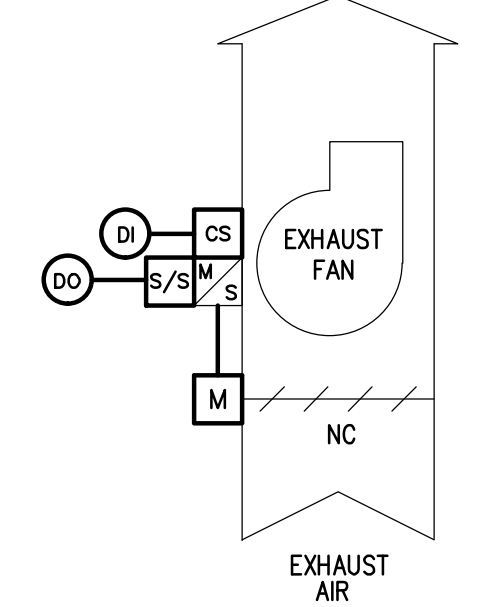

TYPICAL EXHAUST FAN CONTROL

TYPICAL STAFF TOILET EF-6H, CHEMICAL STORAGE EF-7H AND DISH WASH AREA EF-8H.

NOTES:

- REFER TO FLOOR PLANS FOR QUANTITIES AND LOCATIONS.

SEQUENCE OF OPERATION

- EXHAUST FAN SHALL BE STARTED AND STOPPED BY DDC BASED ON TIME SCHEDULE. WIRING INTERLOCK SHALL OPEN DAMPERS.
- DDC SHALL MONITOR EF RUN STATUS THRU CURRENT SWITCH. ABNORMAL STATUS CONDITION SHALL ACTIVATE ALARM.


SEQUENCE OF OPERATION

AIR TERMINAL UNIT WITH PERIMETER HEATING:
 NOTE: ALL SETPOINTS DESCRIBED IN SEQUENCE SHALL BE ADJUSTABLE BY SYSTEM OPERATORS (CREATE REQUIRED VIRTUAL POINTS). APPROPRIATE DEADBANDS SHALL BE USED TO PREVENT SHORT CYCLING SITUATIONS.

- ALL TU'S ASSOCIATED WITH A SINGLE SPACE TEMP SENSOR SHALL CONTROL IN UNISON.
- SUPPLY AIR TERMINAL UNITS (TU) VAV MINIMUM AND MAXIMUM AIRFLOW SETTINGS SHALL BE AS INDICATED ON THE MECHANICAL SCHEDULES. WHERE MINIMUM AND MAXIMUM AIRFLOW SETTINGS ARE THE SAME, THE TU CONTROLLER SHALL PERFORM CONSTANT AIR VOLUME CONTROL.
- IN ALL MODES OF HEATING, TU DISCHARGE AIR TEMP SENSOR SHALL PROVIDE HIGH LIMIT SETPOINT CONTROL AT 90F DAT.
- WHEN ROOM TEMPERATURE RISES ABOVE THE SETPOINT, THE SUPPLY AIR TERMINAL UNIT CONTROLLER SHALL KEEP THE TEMPERING COIL VALVE AND PERIMETER HEATING CONTROL VALVE CLOSED AND SHALL MODULATE THE SUPPLY AIRFLOW BETWEEN ITS MINIMUM AND MAXIMUM SETTING TO MAINTAIN ROOM TEMPERATURE.
- WHEN OA TEMP IS 60 DEG F OR BELOW AND ROOM TEMPERATURE FALLS BELOW SETPOINT, THE SUPPLY TERMINAL UNIT CONTROLLER SHALL KEEP THE SUPPLY AIRFLOW AT ITS MINIMUM SETTING AND SHALL FIRST MODULATE THE PERIMETER HEATING CONTROL VALVE FOLLOWED BY TEMPERING COIL CONTROL VALVE (WHEN PERIMETER HEATING CONTROL VALVE IS FULL OPEN) TO MAINTAIN THE ROOM TEMPERATURE SETPOINT.
- WHEN OA TEMP IS ABOVE 60 DEG F AND ROOM TEMPERATURE FALLS BELOW SETPOINT, THE SUPPLY TERMINAL UNIT CONTROLLER SHALL KEEP THE SUPPLY AIRFLOW AT ITS MINIMUM SETTING AND SHALL MODULATE THE TEMPERING COIL CONTROL VALVE TO MAINTAIN THE ROOM TEMPERATURE SETPOINT. PERIMETER HEATING CONTROL VALVE SHALL REMAIN CLOSED.
- THE SUPPLY AIR TERMINAL UNIT'S MINIMUM AND MAXIMUM VOLUME AIRFLOW SETTINGS SHALL BE AS INDICATED ON THE SHEET METAL FLOOR PLANS
- WHEN SPACE CARBON DIOXIDE LEVEL RISES ABOVE 1100 PPM SETPOINT, THE SUPPLY AIR TU CONTROLLER SHALL OVERRIDE TEMPERATURE CONTROL, AND MODULATE DAMPER OPEN TO INCREASE SUPPLY AIRFLOW UNTIL CO2 SETPOINT IS SATISFIED. THE TEMPERING COIL VALVE SHALL BE MODULATED TO MAINTAIN SPACE TEMP SETPOINT. [NOTE: THERE IS NOT A REQUIREMENT TO INCREASE OUTSIDE AIRFLOW AT RELATED RTU IF CO2 LEVEL IS ABOVE SETPOINT WHEN TU DAMPER IS AT MAX POSITION].
- WHEN SPACE CARBON DIOXIDE LEVEL FALLS BELOW 800 PPM SETPOINT AFTER BEING IN VENTILATION OVERRIDE MODE, THE TU DAMPER SHALL BE MODULATED CLOSED TOWARDS MINIMUM POSITION. THE TEMPERING COIL VALVE SHALL BE MODULATED TO MAINTAIN SPACE TEMP SETPOINT.
- SPACE TEMPERATURE SETPOINTS SHALL BE AS FOLLOWS:
 HEATING UNOCCUPIED SETPOINT = 62F
 HEATING TEMPORARY UNOCCUPIED SETPOINT = 68F
 HEATING OCCUPIED SETPOINT = 70F
 COOLING OCCUPIED SETPOINT = 75F
 COOLING TEMPORARY UNOCCUPIED SETPOINT = 77F
 COOLING UNOCCUPIED SETPOINT = 80F
- DURING BUILDING UNOCCUPANCY, RELATED AHU (RTU OR ERU) SHALL CYCLE AS REQUIRED TO MAINTAIN BUILDING SETBACK AND SETUP TEMP SETPOINTS.
- WHEN RESPECTIVE AHU (RTU OR ERU) IS DEACTIVATED, THE AIR TERMINAL UNIT DAMPER SHALL REMAIN IN MINIMUM POSITION AND THE TEMPERING COIL VALVE SHALL REMAIN CLOSED. THE PERIMETER HEATING VALVE SHALL BE MODULATED TO MAINTAIN HEATING UNOCCUPIED SETPOINT.
- THE DDC TERMINAL UNIT CONTROLLER SHALL RE-CALIBRATE THE AIRFLOW SENSOR ONCE A WEEK MINIMUM. THE RE-CALIBRATION PROCESS SHALL BE STAGGERED AMONGST THE TERMINAL UNITS SO THE DUCT STATIC PRESSURE DOES NOT EXCEED LIMITS.
- CONTROL SIGNALS FOR AIR TERMINAL UNIT DAMPER ACTUATOR AND HEATING CONTROL OUTPUT(S) SHALL BE DISPLAYED WITH SYSTEM GRAPHICS.

AIR TERMINAL UNIT WITH PERIMETER HTG CONTROL

- NOTES:
- REFER TO PIPING & SHEET METAL PLANS FOR LOCATIONS AND QUANTITY OF UNITS AND LOCATIONS OF ROOM TEMP SENSORS.
 - WHERE INDICATED ON FLOOR PLANS, SPACE TEMPERATURE SHALL BE REFERENCED TO MULTIPLE AIR TERMINAL UNIT CONTROLLERS VIA DDC NETWORK.
 - PERIMETER HEATING CONTROL VALVE SHALL BE CONTROLLED FROM THE ASSOCIATED TERMINAL UNIT CONTROLLER AS SHOWN ON HVAC PIPING PLANS.
 - TO CONTRACTOR SHALL PROVIDE 24V POWER SUPPLY TO TERMINAL UNIT CONTROLLER.
 - TERMINAL UNIT MANUFACTURER SHALL PROVIDE DAMPER AND TO CONTRACTOR SHALL PROVIDE DAMPER ACTUATOR.
 - TERMINAL UNIT MANUFACTURER SHALL PROVIDE VELOCITY SENSOR FOR SYSTEM CONTROL. TO CONTRACTOR SHALL COORDINATE WITH TAB CONTRACTOR TO DETERMINE DAMPER CONTROL SETTINGS TO ACHIEVE SCHEDULED MINIMUM AND MAXIMUM CFM.
 - TO CONTRACTOR SHALL FURNISH CONTROL VALVES FOR HEATING ELEMENTS PER THE MECHANICAL DETAILS. SELECT CONTROL VALVES TO ACHIEVE THE SCHEDULED FLOW RATES.

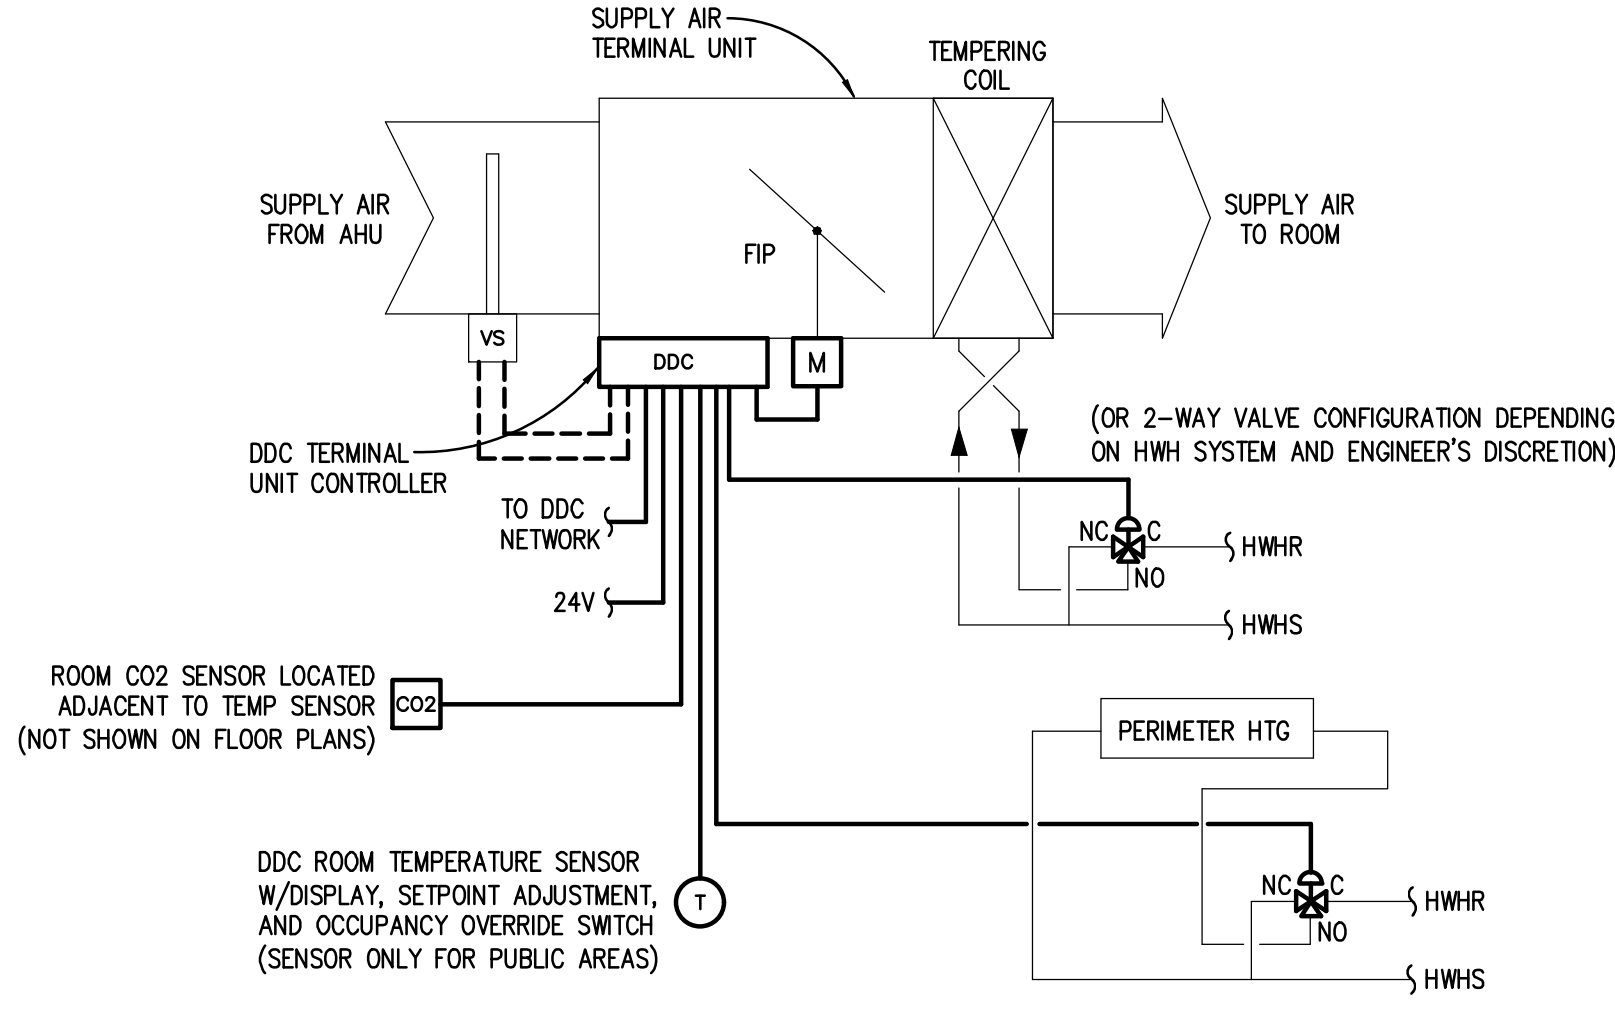


1	OWNER REVIEW	08/02/23
---	--------------	----------

STATE OF MICHIGAN
 DEPARTMENT OF TECHNOLOGY, MANAGEMENT AND BUDGET
 FACILITIES AND BUSINESS SERVICES ADMINISTRATION
 DESIGN AND CONSTRUCTION DIVISION
 ADAM LACHT, RA, DIRECTOR

FILE NO.
 49120167.SDW

FUNDING CODE
 171CODHHS7255

CONTRACT NO.
 Y22003

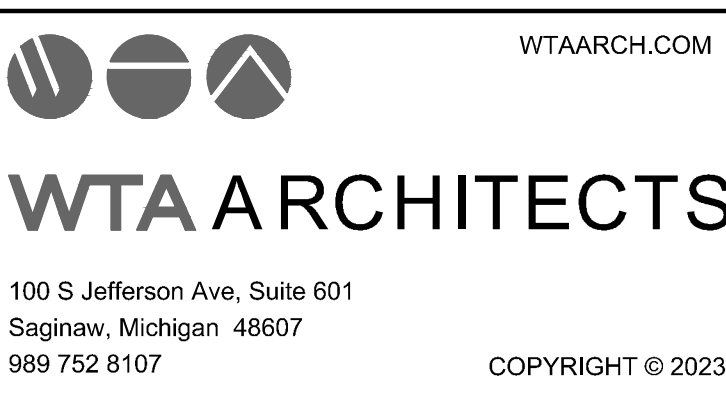

PROJECT TITLE
 49120167.SDW - PHASE 500:
 CENTER FOR FORENSIC
 PSYCHIATRY - CREATE
 KITCHEN
 SALINE, MICHIGAN

SHEET TITLE
 TEMPERATURE CONTROLS

PROJECT NUMBER
 2021094


PROJECT DATE
 AUGUST 23, 2023

CHECKED BY
 WEK




REFER TO SHEET N801 FOR T.C. (TEMPERATURE CONTROL) GENERAL NOTES.


en:\2021\2021-0402-00\CA0\2021-0402-0402-M8-CP.dwg, M-802, 9/5/2023, 4:33:19 PM, Gerard Henrich, Peter Basso Associates Inc.

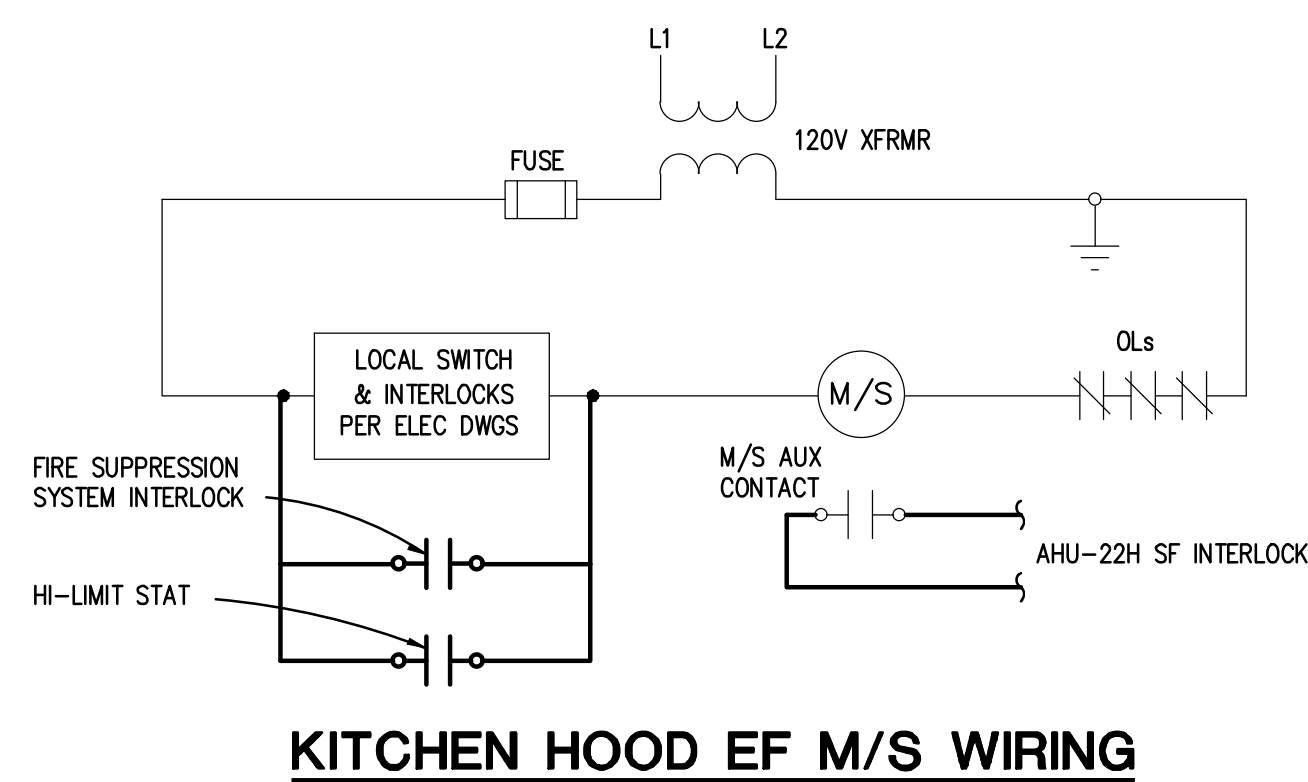

KITCHEN HOOD EF M/S WIRING

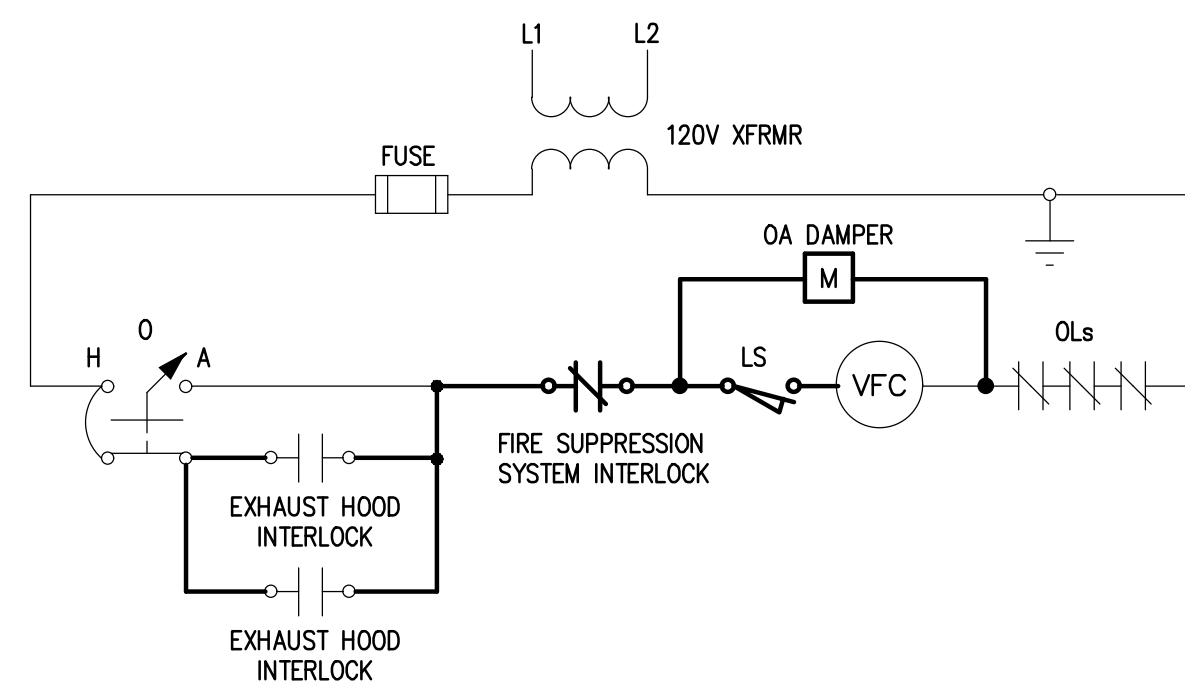


AHU-22H SF M/S WIRING

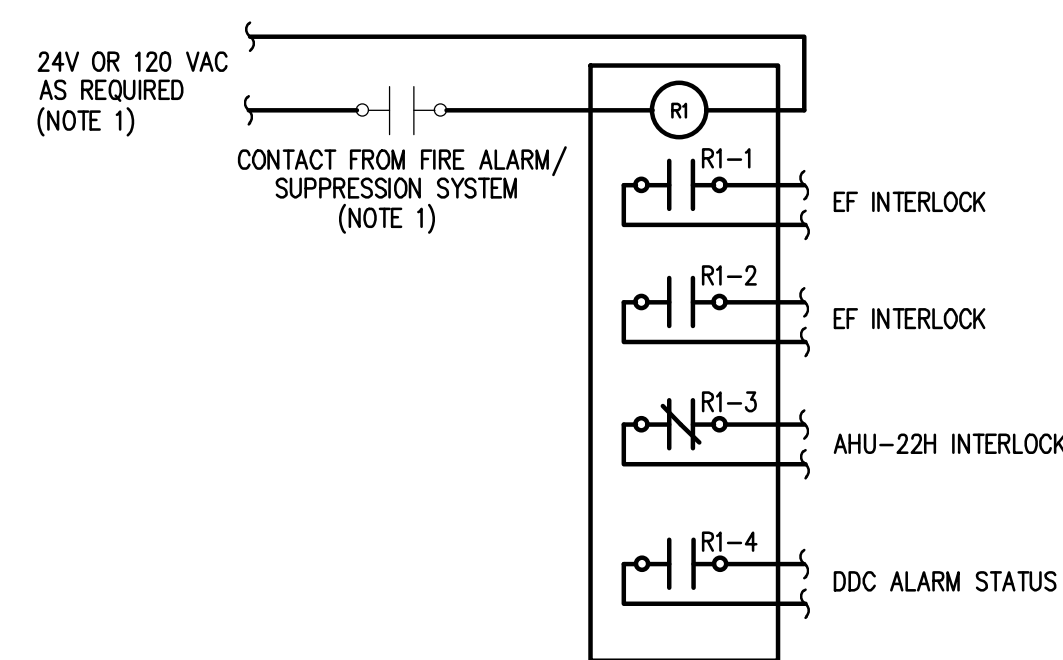

KEF'S AND AHU-22H CONTROL

- NOTE:
- FIRE SUPPRESSION SYSTEM IS NEW. COORDINATE VOLTAGE REQUIREMENTS, WIRING, ETC. WITH FIRE SUPPRESSION SYSTEM MANUFACTURER.

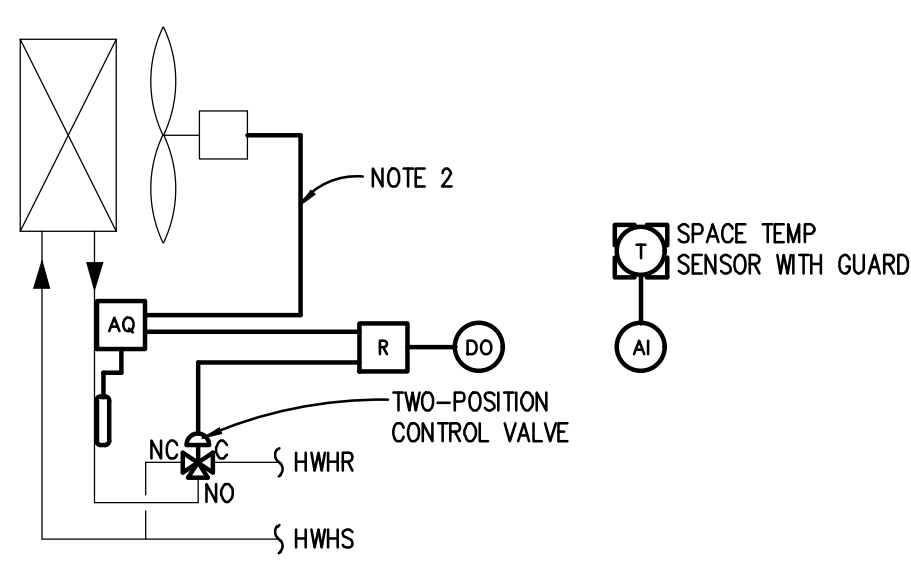


HWH UH & CUH CONTROL - NEW WORK

- TYPICAL
- NOTES:
- REFER TO FLOOR PLANS FOR QUANTITY AND LOCATION OF UNITS.
 - AQUASTAT SHALL BE WIRED IN SERIES WITH FAN CONTROL WIRING CIRCUIT.


SEQUENCE OF OPERATION:

DDC SHALL ENABLE/DISABLE FAN CIRCUIT AND OPEN/CLOSE HEATING VALVE AS REQUIRED TO MAINTAIN SPACE TEMP SETPOINT OF 68F DURING BLDG OCCUPANCY AND 55 F DURING BLDG UNOCCUPANCY. FAN SHALL ACTIVATE UPON PROOF OF HWHR FLOW BY AQ.

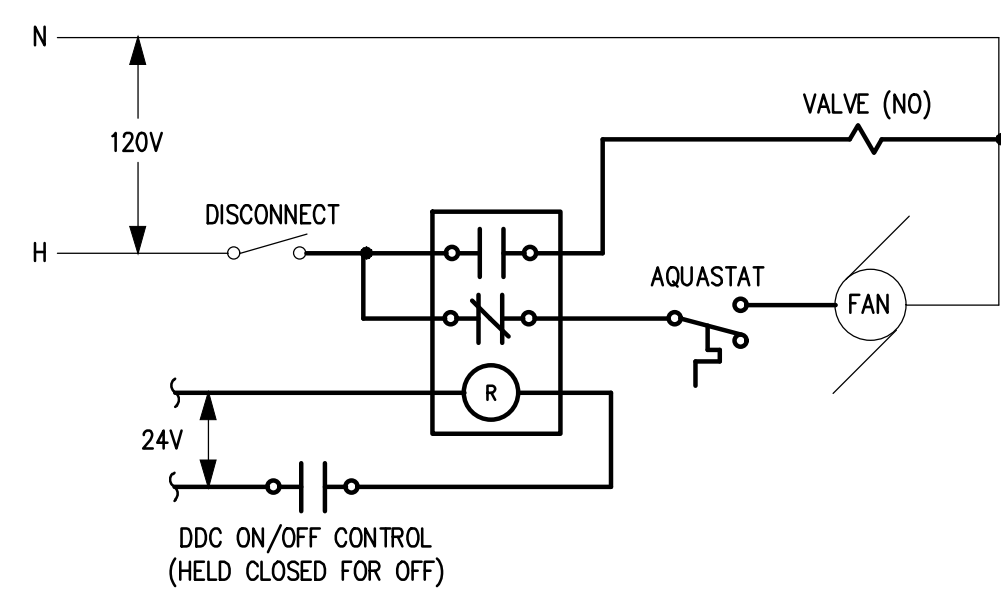

HWH UH & CUH WIRING

TYPICAL

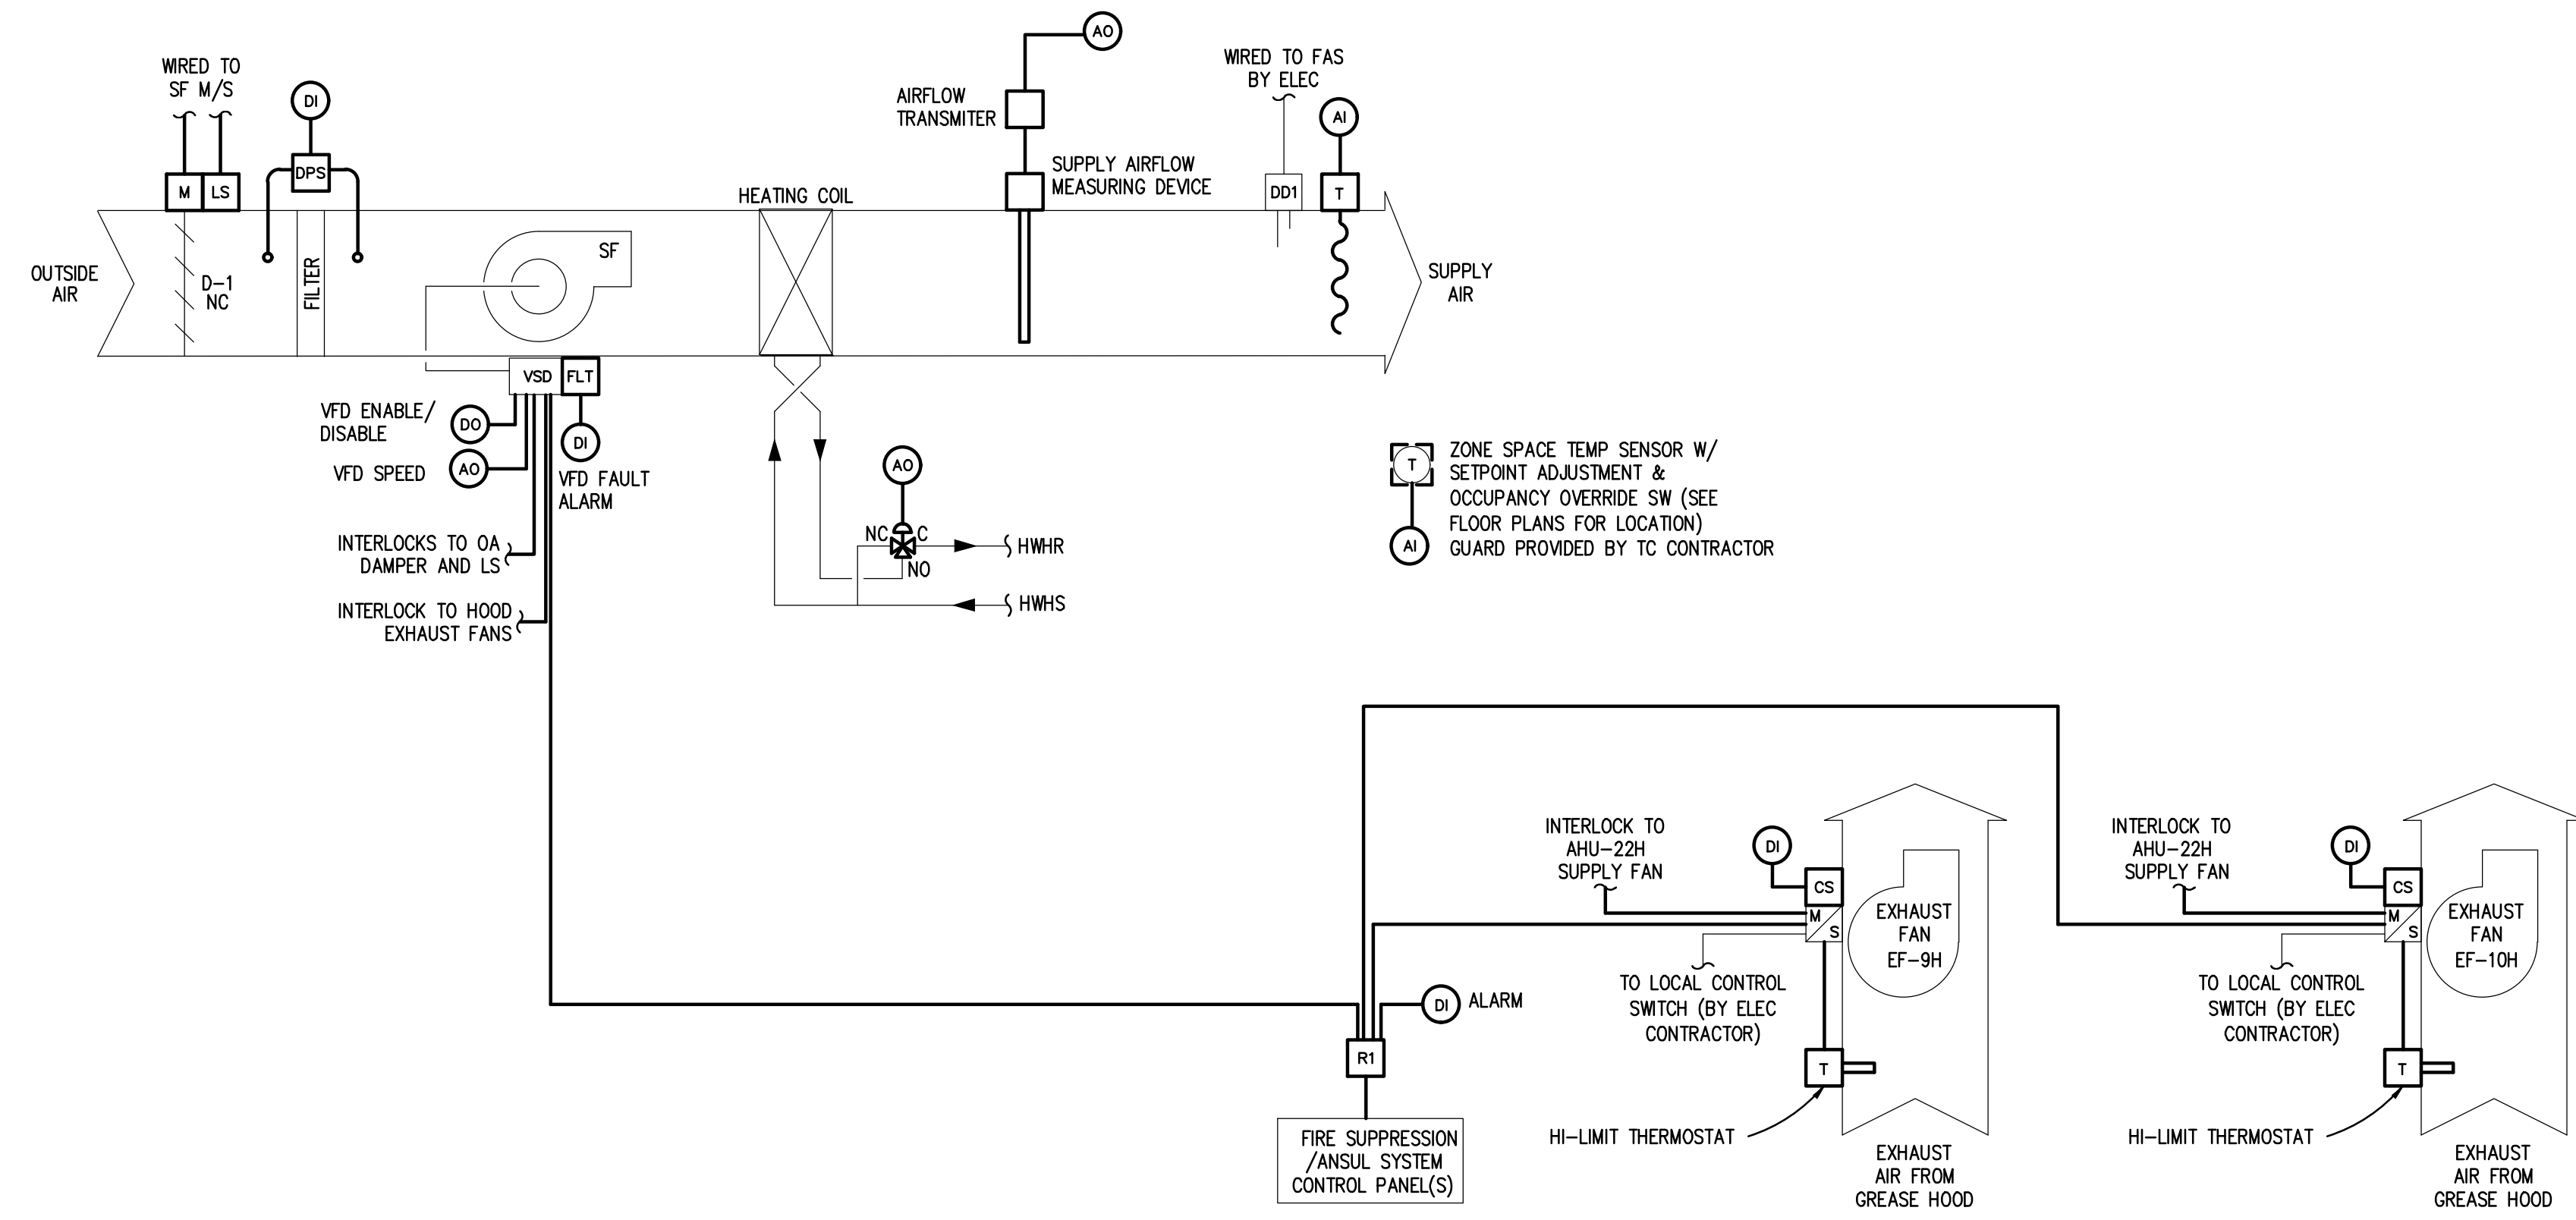

KITCHEN EXHAUST HOODS (EF-9H & EF-10H) AND MAKE-UP AIR UNIT (AHU-22H) CONTROL


- NOTES:
- COORDINATE WIRING WITH EQUIPMENT SUPPLIERS.

SEQUENCE OF OPERATION

- KITCHEN EXHAUST HOOD AND MAKE-UP AIR UNIT CONTROL:
- AHU-22H/EF-9H/EF-10H SHALL BE CAPABLE OF BEING CONTROLLED INDIVIDUALLY.
 - EF-9H AND EF-10H SHALL BE STARTED AND STOPPED MANUALLY BY ITS ON/OFF SWITCH LOCATED NEAR THE KITCHEN EXHAUST HOOD.
 - WITH THE SUPPLY FAN VFC HAND/OFF/AUTO SWITCH AND EXHAUST MOTOR STARTER HAND/OFF/AUTO SWITCH(S) IN THE "AUTO" POSITION, THE SUPPLY FAN SHALL BE INTERLOCKED WITH THE KITCHEN HOOD EXHAUST FANS. WHENEVER THE KITCHEN HOOD EXHAUST FAN IS ENERGIZED, THE MAKE UP AIR UNIT SHALL BE ENERGIZED. WHENEVER THE KITCHEN HOOD EXHAUST FAN IS DE-ENERGIZED, THE MAKE UP AIR UNIT SHALL BE DE-ENERGIZED.
 - WHEN THE CONTROL CIRCUIT OF THE SUPPLY FAN IS ENERGIZED TO START, ITS OUTSIDE AIR DAMPER SHALL FULLY OPEN FIRST. AFTER THE DAMPER IS FULLY OPEN, THE OUTSIDE AIR DAMPER LIMIT SWITCH SHALL COMPLETE. THE CONTROL CIRCUITS TO START THE SUPPLY FAN.
 - PROOF OF FLOW STATUS FOR THE SUPPLY FAN AND EXHAUST SHALL BE PROVEN TO THE DDC SYSTEM BY MEANS OF THE FAN MOTOR CURRENT SWITCH.
 - THE SUPPLY FAN VARIABLE FREQUENCY CONTROLLER SHALL BE MODULATED BASED ASSOCIATED KITCHEN HOOD EXHAUST FAN OPERATION. WHEN AN ASSOCIATED KITCHEN HOOD EXHAUST FAN IS ENERGIZED AS SENSED BY DDC THRU THE FAN MOTOR CURRENT SWITCH THE SUPPLY FAN VFC SHALL BE MODULATED TO THE EF CFM RATE.
 - THE DISCHARGE AIR TEMPERATURE SENSOR THROUGH DDC SHALL MODULATE THE UNITS HOT WATER HEATING (G/YOU) COIL CONTROL VALVE TO MAINTAIN DISCHARGE AIR TEMPERATURE SET POINT. THE DISCHARGE AIR SET POINT SHALL BE RESET BY THE SPACE TEMPERATURE BETWEEN 55 DEGREES F AND 95 DEGREES F TO MAINTAIN SPACE TEMPERATURE SET POINT OF 68 DEGREES F (ADJUSTABLE).
 - THE FILTER DIFFERENTIAL PRESSURE SWITCH SHALL ISSUE A DIRTY FILTER ALARM IF IT'S SET POINT IS REACHED.
 - IF THE LOW LIMIT SET POINT (40 DEGREES F ADJUSTABLE) OF THE DISCHARGE AIR SENSOR IS REACHED FOR MORE THAN 1 MINUTE (ADJUSTABLE) THROUGH DDC, THE SUPPLY AND EXHAUST FAN SHALL BE DE-ENERGIZED AND AN ALARM SHALL BE SENT THROUGH THE DDC SYSTEM.
 - WHEN THE SUPPLY FAN IS DE-ENERGIZED, THE OUTSIDE AIR DAMPER (D-1) SHALL CLOSE.
 - WHEN FIRE SUPPRESSION SYSTEM IS ACTIVATED, THE MAU SUPPLY FAN WILL BE DE-ACTIVATED AND THE KITCHEN HOOD EXHAUST FAN SHALL BE ACTIVATED REGARDLESS OF LOCAL CONTROL SWITCH POSITION. THIS CONDITION WILL ACTIVATE A DDC SYSTEM ALARM.
 - KITCHEN HOOD EXHAUST FAN MAY ALSO BE ACTIVATED BY HI-LIMIT THERMOSTAT REGARDLESS OF LOCAL CONTROL SWITCH POSITION, IF HEAT IS DETECTED UNDER THE KITCHEN HOOD.

SEQUENCE OF OPERATION

- AIR TERMINAL UNIT WITH PERIMETER HEATING - DISH WASH AREA:
- NOTE: ALL SETPOINTS DESCRIBED IN SEQUENCE SHALL BE ADJUSTABLE BY SYSTEM OPERATORS (CREATE REQUIRED VIRTUAL POINTS). APPROPRIATE DEADBANDS SHALL BE USED TO PREVENT SHORT CYCLING SITUATIONS.
- ALL TU'S ASSOCIATED WITH A SINGLE SPACE TEMP SENSOR SHALL CONTROL IN UNISON.
 - SUPPLY AIR TERMINAL UNIT'S (TU) VAV MINIMUM AND MAXIMUM AIRFLOW SETTINGS SHALL BE AS INDICATED ON THE MECHANICAL SCHEDULES. WHERE MINIMUM AND MAXIMUM AIRFLOW SETTINGS ARE THE SAME, THE TU CONTROLLER SHALL PERFORM CONSTANT AIR VOLUME CONTROL.
 - IN ALL MODES OF HEATING, TU DISCHARGE AIR TEMP SENSOR SHALL PROVIDE HIGH LIMIT SETPOINT CONTROL AT 90° DAT.
 - WHEN ROOM TEMPERATURE RISES ABOVE THE SETPOINT, THE SUPPLY AIR TERMINAL UNIT CONTROLLER SHALL KEEP THE TEMPERING COIL VALVE AND PERIMETER HEATING CONTROL VALVE CLOSED AND SHALL MODULATE THE SUPPLY AIRFLOW BETWEEN ITS MINIMUM AND MAXIMUM SETTING TO MAINTAIN ROOM TEMPERATURE.
 - WHEN OA TEMP IS 60 DEG F OR BELOW AND ROOM TEMPERATURE FALLS BELOW SETPOINT, THE SUPPLY TERMINAL UNIT CONTROLLER SHALL KEEP THE SUPPLY AIRFLOW AT ITS MINIMUM SETTING AND SHALL FIRST MODULATE THE PERIMETER HEATING CONTROL VALVE FOLLOWED BY TEMPERING COIL CONTROL VALVE (WHEN PERIMETER HEATING CONTROL VALVE IS FULL OPEN) TO MAINTAIN THE ROOM TEMPERATURE SETPOINT.
 - WHEN OA TEMP IS ABOVE 60 DEG F AND ROOM TEMPERATURE FALLS BELOW SETPOINT, THE SUPPLY TERMINAL UNIT CONTROLLER SHALL KEEP THE SUPPLY AIRFLOW AT ITS MINIMUM SETTING AND SHALL MODULATE THE TEMPERING COIL CONTROL VALVE TO MAINTAIN THE ROOM TEMPERATURE SETPOINT. PERIMETER HEATING CONTROL VALVE SHALL REMAIN CLOSED.
 - WHENEVER THE DISH WASH EXHAUST FAN IS ENERGIZED THE VAV TERMINAL UNITS AIR FLOW SHALL INCREASE TO MAKE UP EXHAUST AIR 100 CFM LESS THE EXHAUST AIR FLOW (ADJUSTABLE).
 - THE SUPPLY AIR TERMINAL UNIT'S MINIMUM AND MAXIMUM VOLUME AIRFLOW SETTINGS SHALL BE AS INDICATED ON THE SHEET METAL FLOOR PLANS.
 - WHEN SPACE CARBON DIOXIDE LEVEL RISES ABOVE 1100 PPM SETPOINT, THE SUPPLY AIR TU CONTROLLER SHALL OVERRIDE TEMPERATURE CONTROL AND MODULATE DAMPER OPEN TO INCREASE SUPPLY AIRFLOW UNTIL CO2 SETPOINT IS SATISFIED. THE TEMPERING COIL VALVE SHALL BE MODULATED TO MAINTAIN SPACE TEMP SETPOINT. (NOTE: THERE IS NOT A REQUIREMENT TO INCREASE OUTSIDE AIRFLOW AT RELATED RTU IF CO2 LEVEL IS ABOVE SETPOINT WHEN TU DAMPER IS AT MAX POSITION).
 - WHEN SPACE CARBON DIOXIDE LEVEL FALLS BELOW 800 PPM SETPOINT AFTER BEING IN VENTILATION OVERRIDE MODE, THE TU DAMPER SHALL BE MODULATED CLOSED TOWARDS MINIMUM POSITION. THE TEMPERING COIL VALVE SHALL BE MODULATED TO MAINTAIN SPACE TEMP SETPOINT.
 - SPACE TEMPERATURE SETPOINTS SHALL BE AS FOLLOWS:
HEATING UNOCCUPIED SETPOINT = 62F
HEATING TEMPORARY UNOCCUPIED SETPOINT = 68F
HEATING OCCUPIED SETPOINT = 70F
COOLING OCCUPIED SETPOINT = 75F
COOLING TEMPORARY UNOCCUPIED SETPOINT = 77F
COOLING UNOCCUPIED SETPOINT = 80F
 - DURING BUILDING UNOCCUPANCY, RELATED AHU (RTU OR ERU) SHALL CYCLE AS REQUIRED TO MAINTAIN BUILDING SETBACK AND SETUP TEMP SETPOINTS.
 - WHEN RESPECTIVE AHU (RTU OR ERU) IS DEACTIVATED, THE AIR TERMINAL UNIT DAMPER SHALL REMAIN IN MINIMUM POSITION AND THE TEMPERING COIL VALVE SHALL REMAIN CLOSED. THE PERIMETER HEATING VALVE SHALL BE MODULATED TO MAINTAIN HEATING UNOCCUPIED SETPOINT.
 - THE DDC TERMINAL UNIT CONTROLLER SHALL RE-CALIBRATE THE AIRFLOW SENSOR ONCE A WEEK MINIMUM. THE RE-CALIBRATION PROCESS SHALL BE STAGGERED AMONGST THE TERMINAL UNITS SO THE DUCT STATIC PRESSURE DOES NOT EXCEED LIMITS.
 - CONTROL SIGNALS FOR AIR TERMINAL UNIT DAMPER ACTUATOR AND HEATING CONTROL OUTPUT(S) SHALL BE DISPLAYED WITH SYSTEM GRAPHICS.

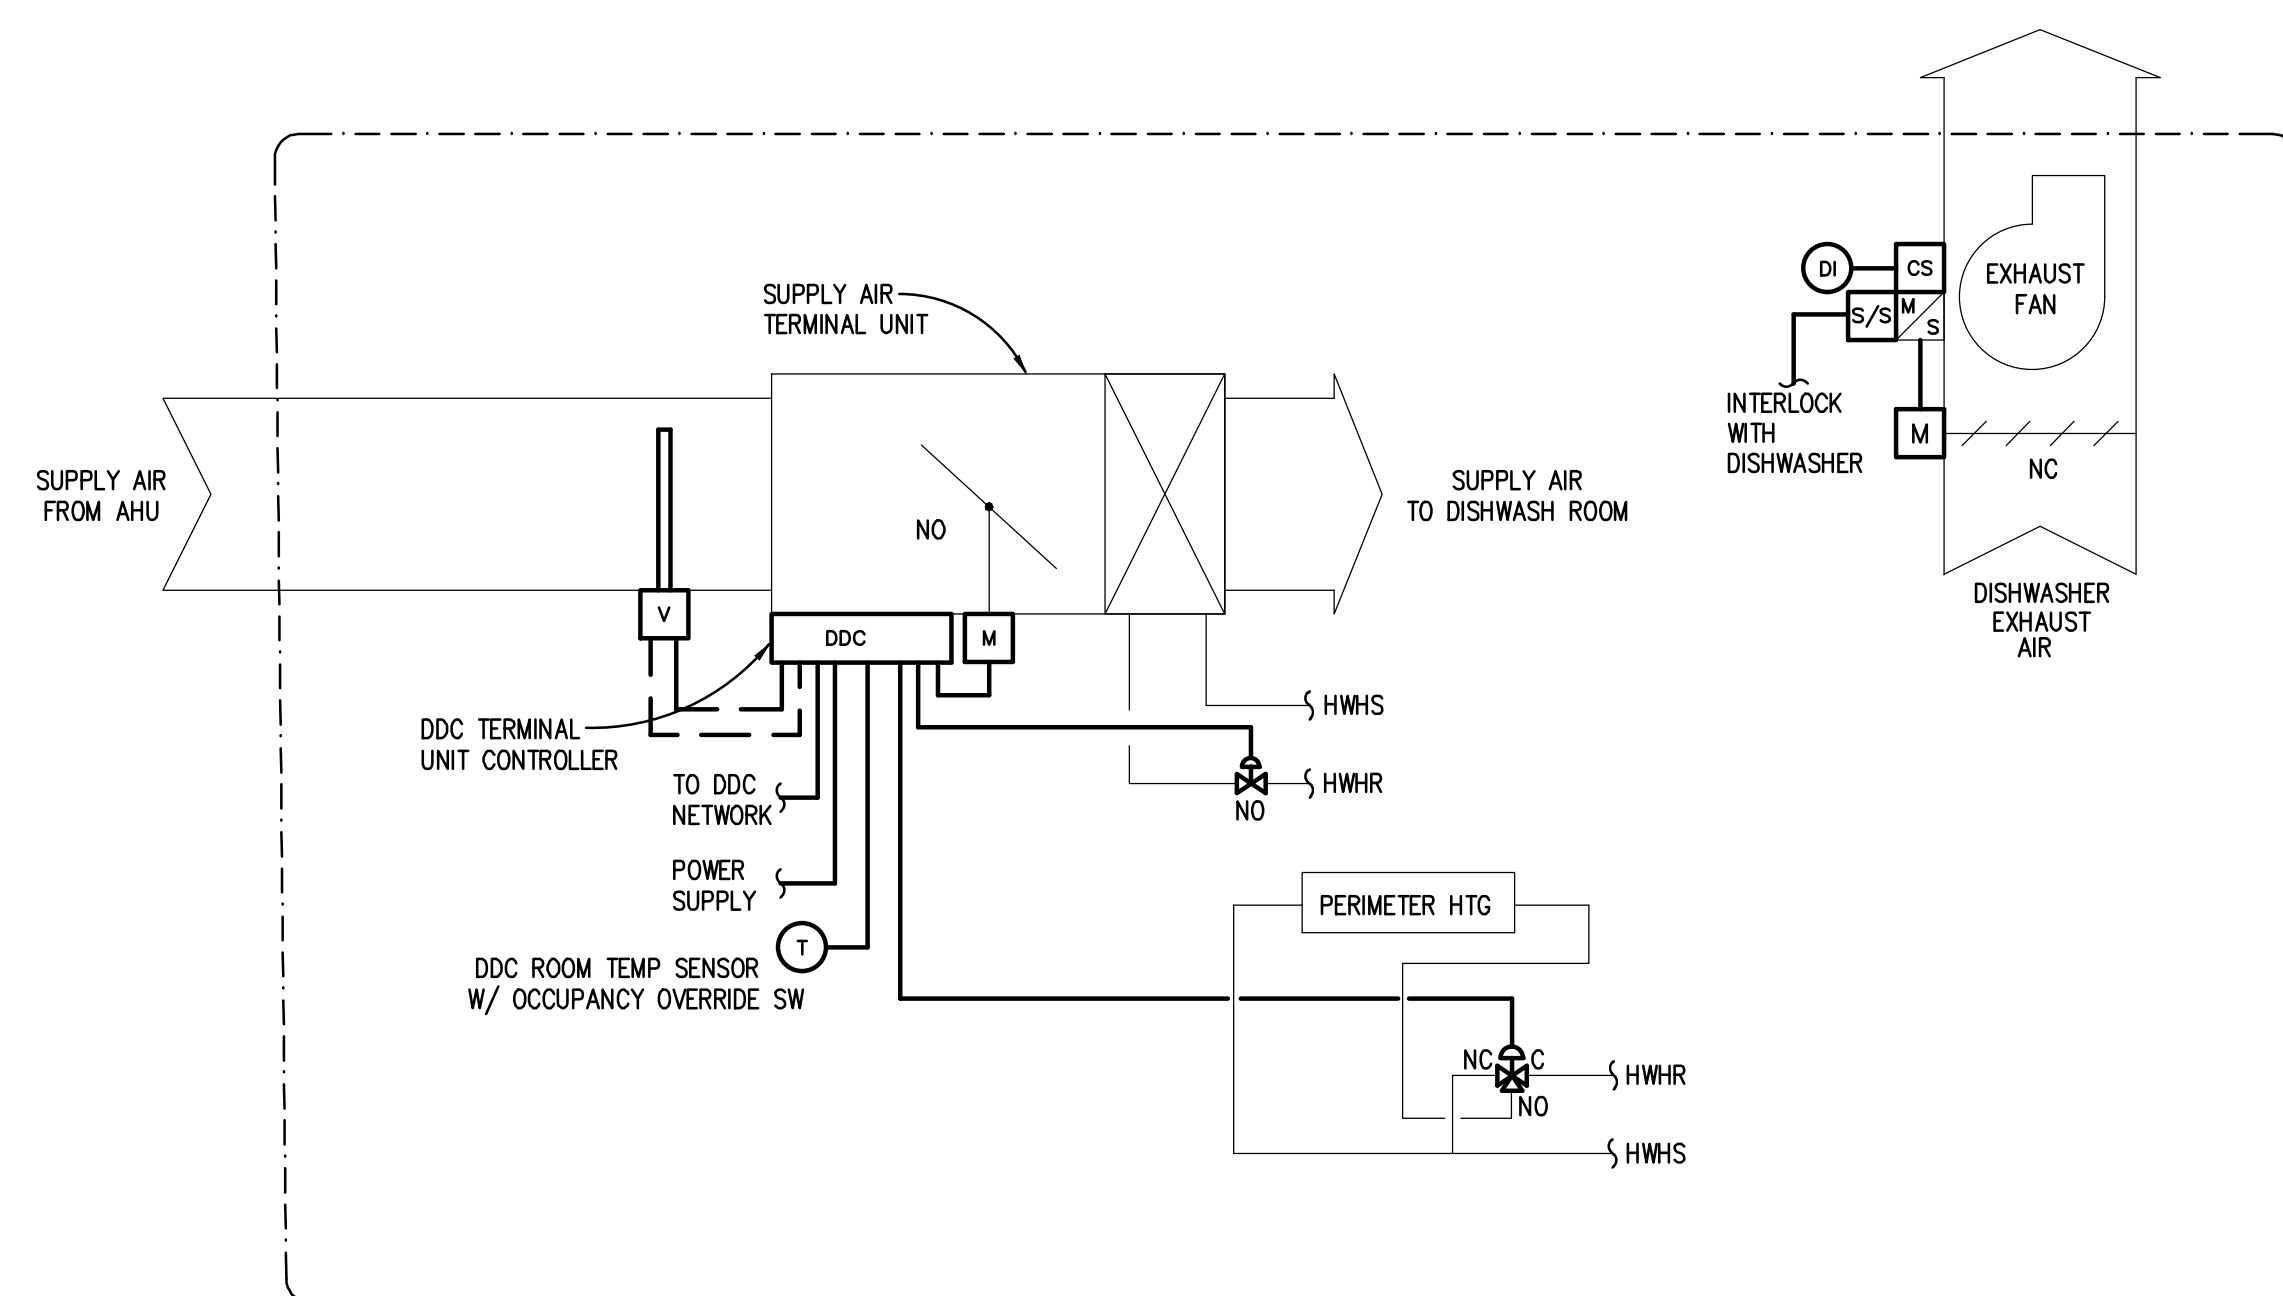

DISHWASH AREA TERMINAL UNIT CONTROL WITH PERIMETER HEAT CONTROL DIAGRAM

- NOTES:
- REFER TO SHEET METAL PLANS FOR LOCATIONS AND QUANTITY OF UNITS. REFER TO HVAC PIPING PLANS FOR LOCATIONS OF ROOM TEMP SENSORS.

REFER TO SHEET M801 FOR T.C. (TEMPERATURE CONTROL) GENERAL NOTES.

1	OWNER REVIEW	08/02/23
---	--------------	----------

STATE OF MICHIGAN
DEPARTMENT OF TECHNOLOGY, MANAGEMENT AND BUDGET
FACILITIES AND BUSINESS SERVICES ADMINISTRATION
DESIGN AND CONSTRUCTION DIVISION
ADAM LACH, R. DIRECTOR

FILE NO:
491/20167.SDW

FUNDING CODE: 171CODHS7255 CONTRACT NO.: Y22003

WTA ARCHITECTS
100 S. Jefferson Ave, Suite 601
Saginaw, Michigan 48607
989 752 8107
COPYRIGHT © 2023

PROJECT TITLE
491/20167.SDW - PHASE 500:
CENTER FOR FORENSIC PSYCHIATRY - CREATE KITCHEN
SALINE, MICHIGAN

SHEET TITLE
TEMPERATURE CONTROLS

PROJECT NUMBER: 2021094 SHEET NUMBER

PROJECT DATE: AUGUST 23, 2023 M8.03

CHECKED BY: WEK

Peter Basso Associates Inc
CONSULTING ENGINEERS
5145 Livernois, Suite 100
Troy, Michigan 48068-3276
Tel: 248-879-5666
Fax: 248-879-0007
www.PeterBassoAssociates.com
PBA-Project No. 2021094

ELECTRICAL SYMBOL LIST (NOTE: SOME SYMBOLS AND ABBREVIATIONS SHOWN MAY NOT APPLY TO THIS PROJECT.)

SYMBOL	DESCRIPTION	SYMBOL	DESCRIPTION	SYMBOL	DESCRIPTION	SYMBOL	DESCRIPTION	SYMBOL	DESCRIPTION
FX (NL)	FIXTURE TYPE (NL INDICATES NIGHT LIGHT)	TWC	TWO-WAY COMMUNICATION SYSTEM CALL STATION	CP	CONTROL PANEL	SC	SECURITY CAMERA	E	MANUAL FIRE ALARM BOX
[]	LIGHTING FIXTURE	TWCD	TWO-WAY COMMUNICATION SYSTEM AUTO DIALER	M	MOTOR	MD	MOTION DETECTOR	SD	SMOKE DETECTOR
[]	DIRECT/INDIRECT LIGHTING FIXTURE	TWCA	TWO-WAY COMMUNICATION SYSTEM ANNUNCIATOR & COMMUNICATION PANEL	VFC	VARIABLE FREQUENCY CONTROLLER	DK	SECURITY KEY SWITCH	DD	DUCT SMOKE DETECTOR
[]	EMERGENCY LIGHTING FIXTURE	TWCP	TWO-WAY COMMUNICATION SYSTEM POWER SUPPLY WITH BATTERY BACK-UP	MC	MANUAL CONTROLLER	DC	DOOR CONTACT	CO	CARBON MONOXIDE DETECTOR
[]	LIGHTING FIXTURE	TWCDP	TWO-WAY COMMUNICATION SYSTEM AUTO DIALER POWER SUPPLY WITH BATTERY BACK-UP	MC	MAGNETIC CONTROLLER	RT	REMOTE TEST STATION (FOR DUCT DETECTOR)	TD	THERMAL DETECTOR
[]	WALL MOUNTED LIGHTING FIXTURE	RGP	REMOTE GENERATOR ANNUNCIATOR PANEL	MC	COMBINATION MAGNETIC CONTROLLER	BD	BIDIRECTIONAL BEAM DETECTOR	FD	FIRE ALARM BELL
[]	LIGHTING FIXTURE	ATS	AUTOMATIC TRANSFER SWITCH	MC	NON-FUSIBLE DISCONNECT SWITCH	REX	REQUEST TO EXIT STATION	FX	FIRE ALARM AUDIBLE NOTIFICATION APPLIANCE
[]	RECESSED OR SURFACE MOUNTED DIRECTIONAL LIGHTING FIXTURE	UPS	UNINTERRUPTIBLE POWER SUPPLY	MC	FUSIBLE DISCONNECT SWITCH	PP	AUTOMATIC DOOR PUSH PAD OPERATOR	XX	FIRE ALARM VISUAL NOTIFICATION APPLIANCE
[]	PENDANT LIGHTING FIXTURE	CSX	LOW VOLTAGE CONTROL STATION "X" INDICATES TYPE	MC	ENCLOSED CIRCUIT BREAKER	DO	DOOR OPERATOR	XX	FIRE ALARM COMBINATION VISUAL/AUDIBLE
[]	WALL SCONCE	φ / φ _{xx}	SINGLE / DUPLEX RECEPTACLE OUTLET "X" INDICATES TYPE	MC	PUSH BUTTON STATION	DA	DOOR ACTUATOR	XX	FIRE ALARM COMBINATION VISUAL/AUDIBLE
[]	LIGHTING TRACK	φ / φ _{xx}	SINGLE / DUPLEX RECEPTACLE OUTLET CONTROLLED BY AUTOMATIC CONTROL DEVICE / SYSTEM	MC	JUNCTION BOX	ACC	ACCESS CONTROL STATION	XX	FIRE ALARM COMBINATION VISUAL/AUDIBLE
[]	TRACK LIGHTING FIXTURE	φ / φ _{xx}	QUAD RECEPTACLE OUTLET	MC	HARD WIRE POWER CONNECTION	ACCP	ACCESS CONTROL STATION	XX	FIRE ALARM COMBINATION VISUAL/AUDIBLE
[]	POLE MOUNTED LIGHTING FIXTURE	φ / φ _{xx}	ABOVE COUNTER DUPLEX RECEPTACLE (SIMILAR FOR TAMPER RESISTANT, QUADS, EMERGENCY AND GFCI RECEPTACLES)	MC	GROUND ROD	ACPS	ACCESS CONTROL POWER SUPPLY	XX	FIRE ALARM VISUAL NOTIFICATION APPLIANCE
[]	POLE MOUNTED LIGHTING FIXTURE - POST TOP	φ / φ _{xx}	DUPLEX RECEPTACLE-GROUND FAULT CIRCUIT INTERRUPTER	MC	GROUND CONNECTION			XX	FIRE ALARM AUDIBLE NOTIFICATION APPLIANCE - CEILING MOUNTED
[]	BOLLARD LIGHTING FIXTURE	φ / φ _{xx}	DEAD FRONT-GROUND FAULT CIRCUIT INTERRUPTER	MC	HANDHOLE			XX	FIRE ALARM VISUAL NOTIFICATION APPLIANCE - CEILING MOUNTED
[]	EMERGENCY LIGHTING UNIT	φ / φ _{xx}	DUPLEX EMERGENCY RECEPTACLE OUTLET	MC	CONDUIT SLEEVE WITH BUSHINGS (LENGTH AS REQUIRED)			XX	FIRE ALARM VISUAL NOTIFICATION APPLIANCE - CEILING MOUNTED
[]	EXIT LIGHTING FIXTURE WITH DIRECTIONAL ARROWS (SHADED AREA INDICATES FACE)	φ / φ _{xx}	DUPLEX TAMPER RESISTANT RECEPTACLE OUTLET	MC	CONDUIT UP			XX	FIRE ALARM VISUAL NOTIFICATION APPLIANCE - CEILING MOUNTED
[]	EXIT LIGHTING FIXTURE WITH DIRECTIONAL ARROWS (SHADED AREA INDICATES FACE)	φ / φ _{xx}	QUAD TAMPER RESISTANT RECEPTACLE OUTLET	MC	CONDUIT DOWN			XX	FIRE ALARM VISUAL NOTIFICATION APPLIANCE - CEILING MOUNTED
[]	EXIT LIGHTING FIXTURE - WALL MOUNTED	φ / φ _{xx}	ABOVE COUNTER TAMPER RESISTANT RECEPTACLE OUTLET	MC	EMPTY BOX FOR FUTURE TELECOMMUNICATION OUTLET			XX	FIRE ALARM VISUAL NOTIFICATION APPLIANCE - CEILING MOUNTED
[]	EXIT/EMERGENCY LIGHTING COMBO	φ / φ _{xx}	DUPLEX UPS RECEPTACLE	MC	EMPTY BOX FOR FUTURE CEILING MOUNTED TELECOMMUNICATION OUTLET			XX	FIRE ALARM VISUAL NOTIFICATION APPLIANCE - CEILING MOUNTED
[]	AUTOMATIC LOAD CONTROL RELAY	φ / φ _{xx}	DUPLEX RECEPTACLE WITH 2 USB PORTS OUTLET	MC	TELECOMMUNICATION OUTLET "X" INDICATES TYPE			XX	FIRE ALARM VISUAL NOTIFICATION APPLIANCE - CEILING MOUNTED
[]	BRANCH CIRCUIT EMERGENCY LIGHTING TRANSFER SWITCH	φ / φ _{xx}	USB 4 PORT CHARGING STATION	MC	TELECOMMUNICATION OUTLET MOUNTED 8" ABOVE COUNTERTOP "X" INDICATES TYPE			XX	FIRE ALARM VISUAL NOTIFICATION APPLIANCE - CEILING MOUNTED
[]	LIGHTING CONTROL DEVICE - REFER TO LIGHTING CONTROL SCHEDULE	φ / φ _{xx}	CEILING MOUNTED DUPLEX / QUAD RECEPTACLE	MC	TELECOMMUNICATION OUTLET MOUNTED 8" ABOVE COUNTERTOP "X" INDICATES TYPE			XX	FIRE ALARM VISUAL NOTIFICATION APPLIANCE - CEILING MOUNTED
[]	ROOM CONTROL DESIGNATION - REFER TO LIGHTING CONTROL SCHEDULE	φ / φ _{xx}	WALL / CEILING MOUNTED SPECIAL RECEPTACLE - REFER TO ELECTRICAL STANDARD SCHEDULES	MC	TELECOMMUNICATION BACKBOARD			XX	FIRE ALARM VISUAL NOTIFICATION APPLIANCE - CEILING MOUNTED
[]	SINGLE POLE TOGGLE SWITCH	φ / φ _{xx}	MULTI-OUTLET SURFACE RACEWAY	MC	TELECOMMUNICATION GROUNDING BUS BAR			XX	FIRE ALARM VISUAL NOTIFICATION APPLIANCE - CEILING MOUNTED
[]	TWO POLE TOGGLE SWITCH	φ / φ _{xx}	POKE-THROUGH ASSEMBLY "X" INDICATES TYPE	MC	TELECOMMUNICATION MAIN GROUNDING BUS BAR			XX	FIRE ALARM VISUAL NOTIFICATION APPLIANCE - CEILING MOUNTED
[]	3 WAY TOGGLE SWITCH	φ / φ _{xx}	FLOOR SERVICE FITTING "X" INDICATES TYPE	MC	INTERCOM OUTLET			XX	FIRE ALARM VISUAL NOTIFICATION APPLIANCE - CEILING MOUNTED
[]	4 WAY TOGGLE SWITCH	φ / φ _{xx}	ACCESS FLOOR SERVICE FITTING "X" INDICATES TYPE	MC	SPEAKER			XX	FIRE ALARM VISUAL NOTIFICATION APPLIANCE - CEILING MOUNTED
[]	KEY OPERATED SWITCH	φ / φ _{xx}	CORD REEL "X" INDICATES TYPE	MC	SPEAKER - WALL MOUNTED			XX	FIRE ALARM VISUAL NOTIFICATION APPLIANCE - CEILING MOUNTED
[]	3 WAY KEY OPERATED SWITCH	φ / φ _{xx}	DUAL SWITCHING FOR INNER/OUTER LAMPS OF FLUORESCENT LIGHT FIXTURES	MC	MICROPHONE			XX	FIRE ALARM VISUAL NOTIFICATION APPLIANCE - CEILING MOUNTED
[]	4 WAY KEY OPERATED SWITCH	φ / φ _{xx}	3-WAY DUAL SWITCHING FOR INNER/OUTER LAMPS OF FLUORESCENT LIGHT FIXTURES	MC	VOLUME CONTROL			XX	FIRE ALARM VISUAL NOTIFICATION APPLIANCE - CEILING MOUNTED
[]	DIMMER SWITCH	φ / φ _{xx}	4-WAY DUAL SWITCHING FOR INNER/OUTER LAMPS OF FLUORESCENT LIGHT FIXTURES	MC	SIGNALING BELL			XX	FIRE ALARM VISUAL NOTIFICATION APPLIANCE - CEILING MOUNTED
[]	DIMMER OCCUPANCY SENSOR SWITCH	φ / φ _{xx}	DIGITAL TIME SWITCH	MC	SINGLE FACE CLOCK - CEILING MOUNTED			XX	FIRE ALARM VISUAL NOTIFICATION APPLIANCE - CEILING MOUNTED
[]	LOW VOLTAGE DIMMER SWITCH	φ / φ _{xx}	ILLUMINATED TOGGLE SWITCH FOR CONTROL OF LIGHTING ON CRITICAL POWER-ILLUMINATED WHEN SWITCH IS IN 'OFF' POSITION	MC	SINGLE FACE CLOCK - WALL MOUNTED			XX	FIRE ALARM VISUAL NOTIFICATION APPLIANCE - CEILING MOUNTED
[]	PILOT SWITCH	φ / φ _{xx}	LOW VOLTAGE SWITCH	MC	DOUBLE FACE CLOCK - CEILING MOUNTED			XX	FIRE ALARM VISUAL NOTIFICATION APPLIANCE - CEILING MOUNTED
		φ / φ _{xx}	OCCUPANCY SENSOR	MC	DOUBLE FACE COMBINATION CLOCK/SPEAKER CEILING MOUNTED			XX	FIRE ALARM VISUAL NOTIFICATION APPLIANCE - CEILING MOUNTED
		φ / φ _{xx}	OCCUPANCY SENSOR - REFER TO ELECTRICAL STANDARD SCHEDULE	MC	DOUBLE FACE COMBINATION CLOCK/SPEAKER WALL MOUNTED			XX	FIRE ALARM VISUAL NOTIFICATION APPLIANCE - CEILING MOUNTED
		φ / φ _{xx}	OCCUPANCY SENSOR - REFER TO ELECTRICAL STANDARD SCHEDULES - "X" INDICATES TYPE	MC	TIME CLOCK			XX	FIRE ALARM VISUAL NOTIFICATION APPLIANCE - CEILING MOUNTED

REFER TO ELECTRICAL STANDARD SCHEDULES


ELECTRICAL DRAWING INDEX

SHEET NO.	SHEET TITLE
E0.01	ELECTRICAL STANDARDS AND DRAWING INDEX
E0.02	ELECTRICAL STANDARD SCHEDULES
E0.03	ELECTRICAL DEMOLITION SITE PLAN
E0.04	ELECTRICAL NEW WORK SITE PLAN
ED1.01	FIRST FLOOR ELECTRICAL DEMOLITION PLAN
E2.01	FIRST FLOOR LIGHTING PLAN - UNIT H
E3.00	BASEMENT FLOOR POWER PLAN - UNIT H
E3.01	FIRST FLOOR POWER PLAN - UNIT H
E4.01	FIRST FLOOR AUXILIARY SYSTEMS PLAN - UNIT H
E4.04	ELECTRICAL ROOF PLAN
E5.01	ONE LINE DIAGRAM - NEW WORK
E5.02	PANEL SCHEDULES
E6.01	ELECTRICAL ENLARGED PLAN
E6.02	ELECTRICAL ENLARGED PLAN
E7.00	ELECTRICAL DETAILS AND DIAGRAMS
E7.01	ELECTRICAL DETAILS AND DIAGRAMS



ELECTRICAL ABBREVIATION LIST

ABBREVIATION	DESCRIPTION	ABBREVIATION	DESCRIPTION	ABBREVIATION	DESCRIPTION
A	AMPERES	JB	JUNCTION BOX	P	POLE
AER	ARC ENERGY REDUCTION	PB	PUSHBUTTON STATION	PH	PHASE
AF	AMPERES FRAME (BREAKER RATING)	KA	THOUSAND AMP	PT	POTENTIAL TRANSFORMER
AFCI	ARC FAULT CIRCUIT INTERRUPTER	KV	KILOVOLT	PDP	POWER DISTRIBUTION PANEL
A-F-F	AMPS INTERRUPTING CAPACITY	KVA	KILOVOLT - AMPERES		
AIC	AUDIENCE LEFT	KW	KILOWATT		
AL	AUDIENCE LEFT	KWH	KILOWATT - HOURS	RECEPT.	RECEPTACLE
ALOR	AUTOMATIC LOAD CONTROL RELAY			RDP	RECEPTACLE DISTRIBUTION PANEL
AR	AUDIENCE RIGHT	LA	LIGHTING ARRESTOR	RP	RECEPTACLE PANEL
AT	AMPERES TRIP (BREAKER SETTING)	LP	LIGHTING PANEL	RSC	RIGID STEEL CONDUIT
ATS	AUTOMATIC TRANSFER SWITCH	LDP	LIGHTING DISTRIBUTION PANEL	SCCR	SHORT CIRCUIT CURRENT RATING
AUX	AUXILIARY	MAX	MAXIMUM	SCHED	SCHEDULE
BCELT5	BRANCH CIRCUIT EMERGENCY LIGHTING TRANSFER SWITCH	MCA	MINIMUM CIRCUIT AMPACITY	SPD	SURGE PROTECTION DEVICE
BKR	BREAKER	MCB	MAIN CIRCUIT BREAKER	SW	SWITCH
BPS	BOLTED PRESSURE SWITCH	MCC	MOTOR CONTROL CENTER	SWBD	SWITCHBOARD
		MDP	MAIN DISTRIBUTION PANEL	SWGR	SWITCHGEAR
		MECH	MECHANICAL		
		MIN	MINIMUM	TB	TERMINAL BOX
		MISC.	MISCELLANEOUS	TELECOM	TELECOMMUNICATIONS
		MLO	MAIN LUGS ONLY	TR	TAMPER RESISTANT
		MOP	MAXIMUM OVERCURRENT PROTECTION	TTP	TELEPHONE TERMINAL BACKBOARD
		MTD	MOUNTED	TYP	TYPICAL
		MTG	MOUNTING		
		MTR	MOTOR	U.O.N.	UNLESS OTHERWISE NOTED
				US	UPSTAGE
		N	NEUTRAL	V	VOLTS
		NC	NORMALLY CLOSED		
		NEC	NATIONAL ELECTRICAL CODE		
		NF	NON-FUSIBLE	W	WIRE OR WATTS
		NIC	NOT IN CONTRACT	WG	WIRE GUARD
		NL	NIGHT LIGHT	WP	WEATHERPROOF
		NO	NORMALLY OPEN	WR	WEATHER RESISTANT
		NTS	NOT TO SCALE		
		OC	ON CENTER	XFMR	TRANSFORMER
		OFI	OWNER FURNISHED, CONTRACTOR INSTALLED	XP	EXPLOSION PROOF
		OFI	OWNER FURNISHED, OWNER INSTALLED	(E)	EXISTING
				(R)	RELOCATED
FA	FIRE ALARM				
FLA	FULL LOAD AMPS				
FLR	FLOOR				
FOH	FRONT OF HOUSE				
FSEC	FOOD SERVICE EQUIPMENT CONTRACTOR				
FU	FUSE				
G/GR/DEG	GROUND				
GFCI	GROUND FAULT CIRCUIT INTERRUPTER				
GFP	GROUND FAULT PROTECTION				
HOA	HAND-OFF-AUTO				
HP	HORSEPOWER				
HV	HIGH VOLTAGE				
HZ	HERTZ				
IG	ISOLATED GROUND				

STANDARD MOUNTING HEIGHTS

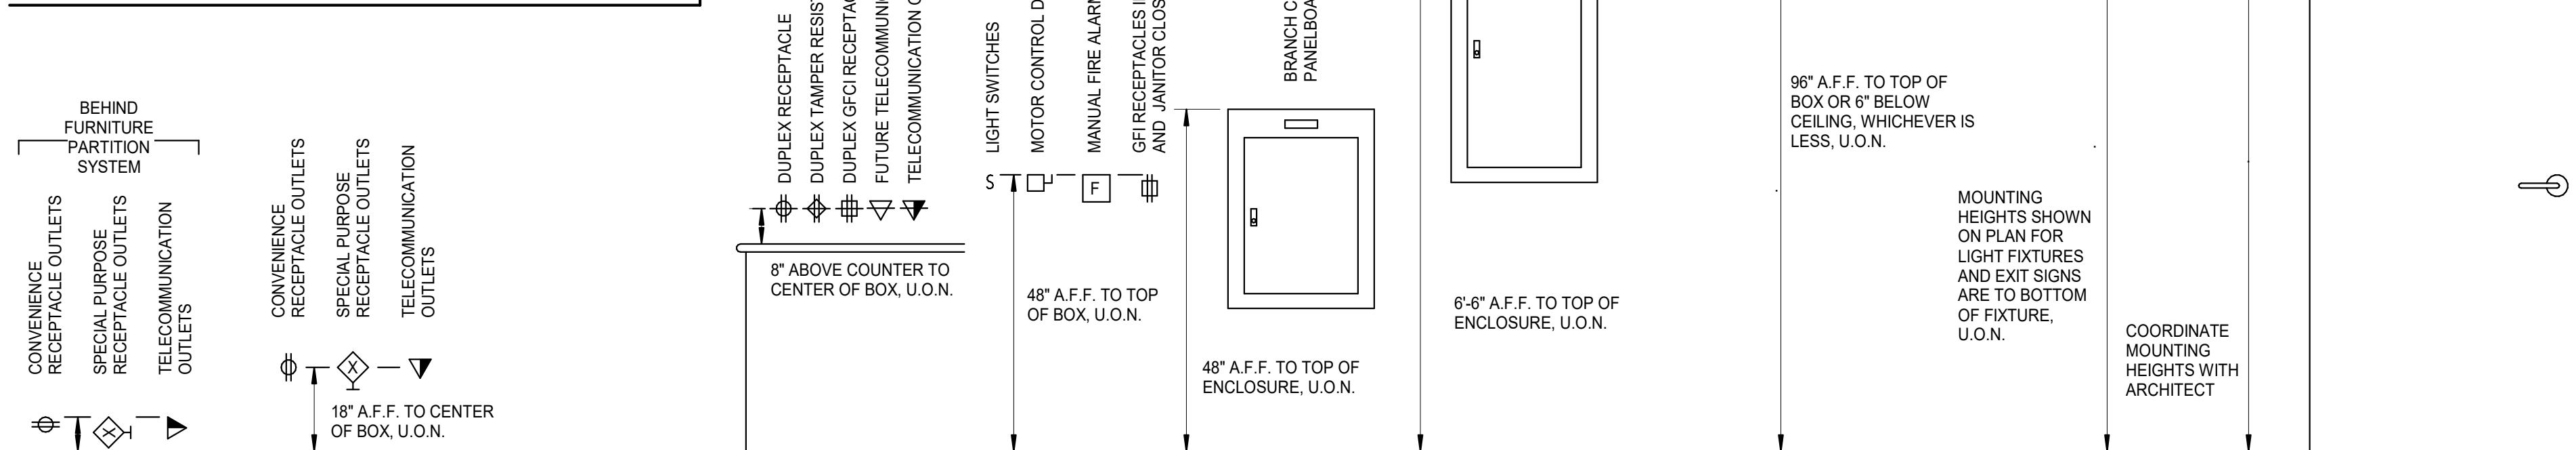

STANDARD METHODS OF NOTATION

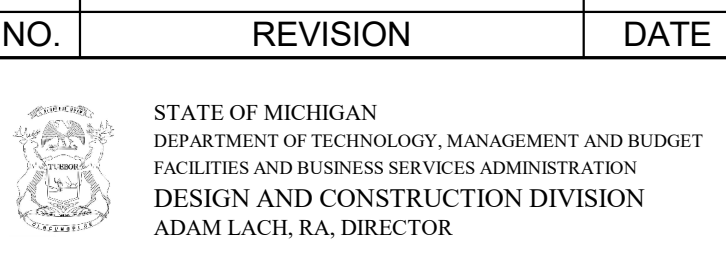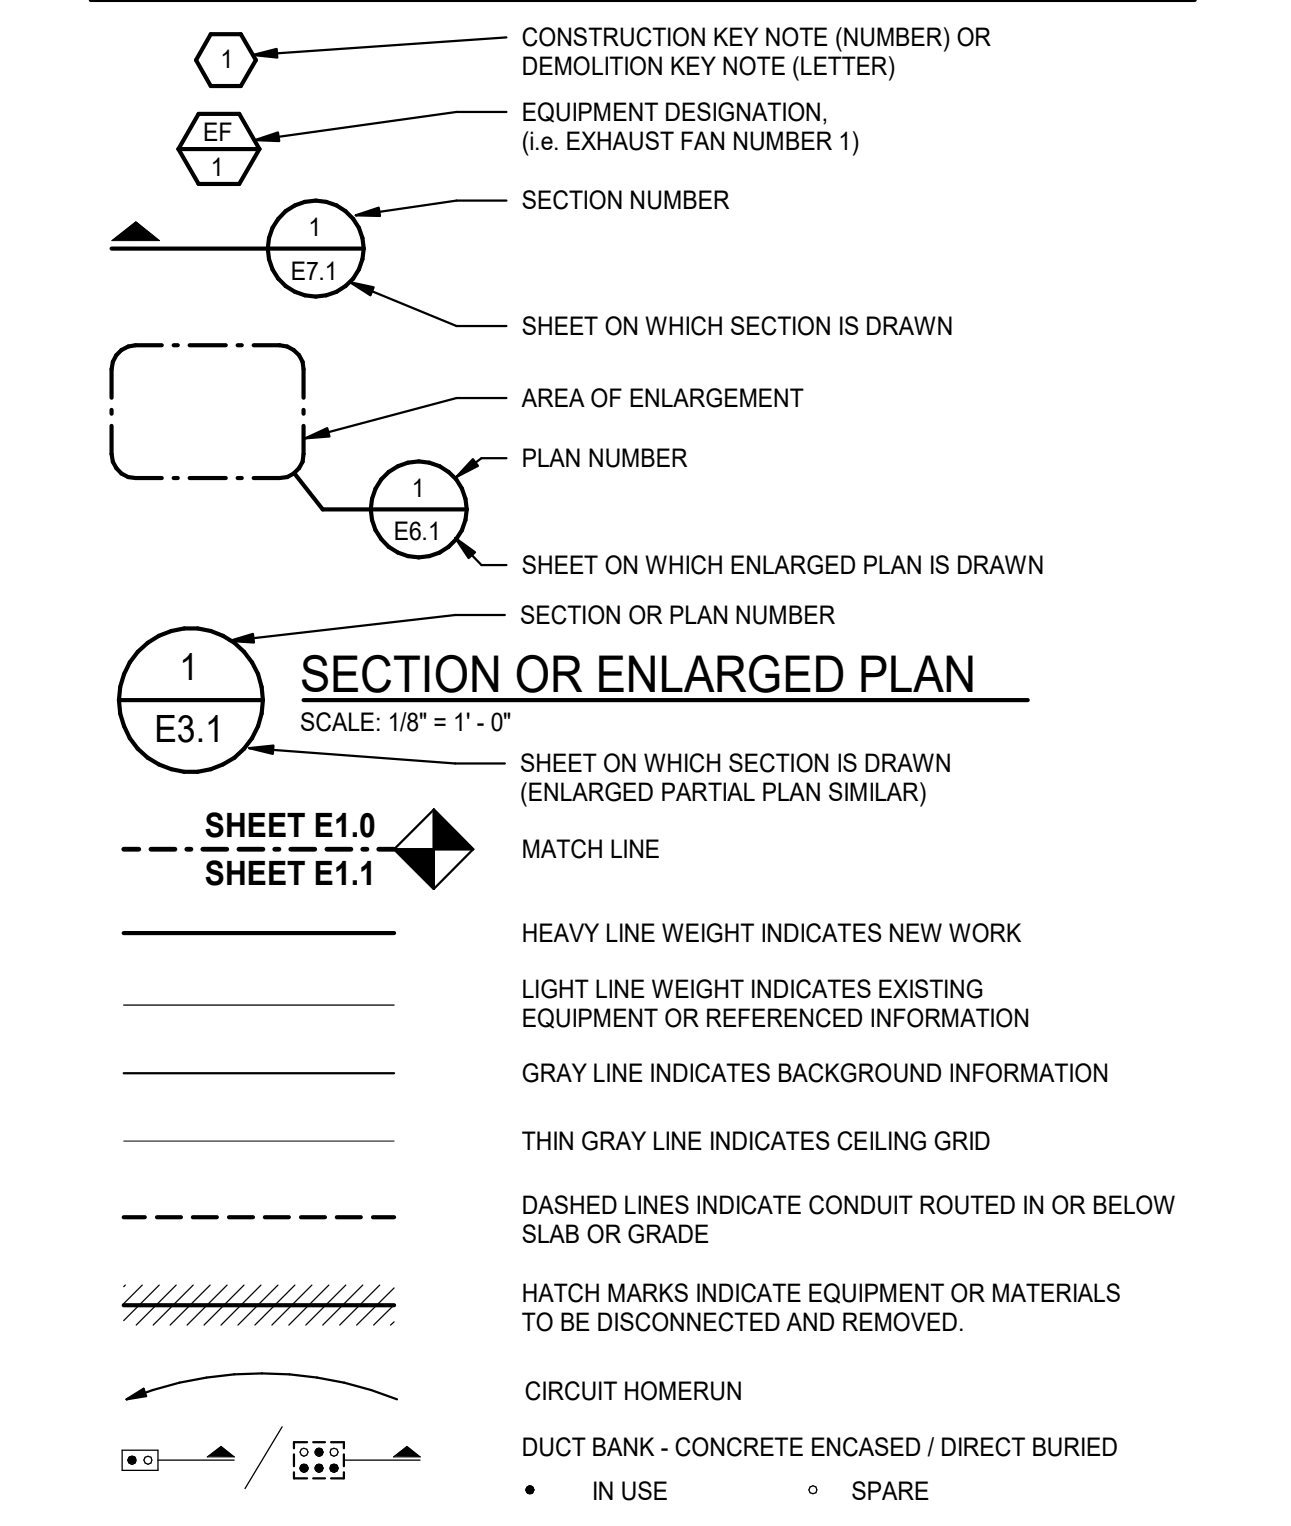

STATE OF MICHIGAN
DEPARTMENT OF TECHNOLOGY, MANAGEMENT AND BUDGET
FACILITIES AND BUSINESS SERVICES ADMINISTRATION
DESIGN AND CONSTRUCTION DIVISION
ADAM LACH, RA, DIRECTOR

FILE NO.
49120167.SDW

FUNDING CODE
171CODHHS7255

CONTRACT NO.
Y22003

NO. REVISION DATE

WTAARCH.COM

WTA ARCHITECTS

100 S. Jefferson Ave., Suite 601
Saginaw, Michigan 48607
989 752 8107

COPYRIGHT © 2023

PROJECT TITLE
49120167.SDW - PHASE 500:
CENTER FOR FORENSIC PSYCHIATRY - CREATE KITCHEN

SALINE, MICHIGAN

SHEET TITLE
ELECTRICAL STANDARDS AND DRAWING INDEX


PROJECT NUMBER
2021094

SHEET NUMBER

PROJECT DATE
SEPTEMBER 6, 2023

E0.01

CHECKED BY
TLC

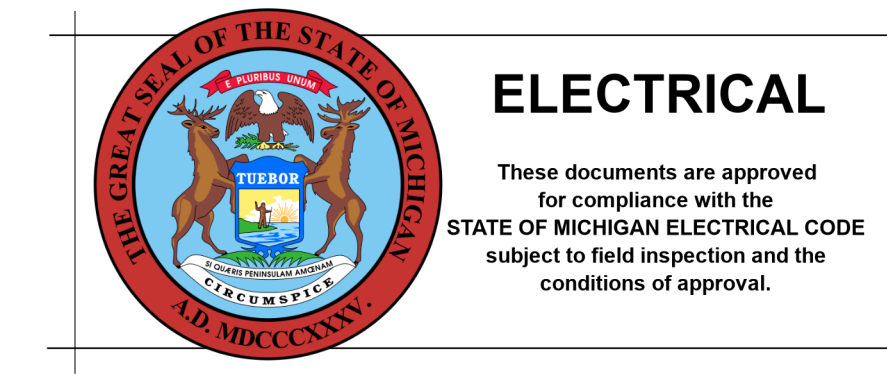



ELECTRICAL

These documents are approved for compliance with the STATE OF MICHIGAN ELECTRICAL CODE subject to field inspection and the conditions of approval.



Peter Basso Associates Inc.
CONSULTING ENGINEERS
5145 Livernois, Suite 100
Troy, Michigan 48068-3276
Tel: 248-879-5666
Fax: 248-879-0007
www.PeterBassoAssociates.com
PBA Project No. 3021-0402

THE FOLLOWING DIMENSION EQUALS ONE INCH WHEN PRINTED TO SCALE.

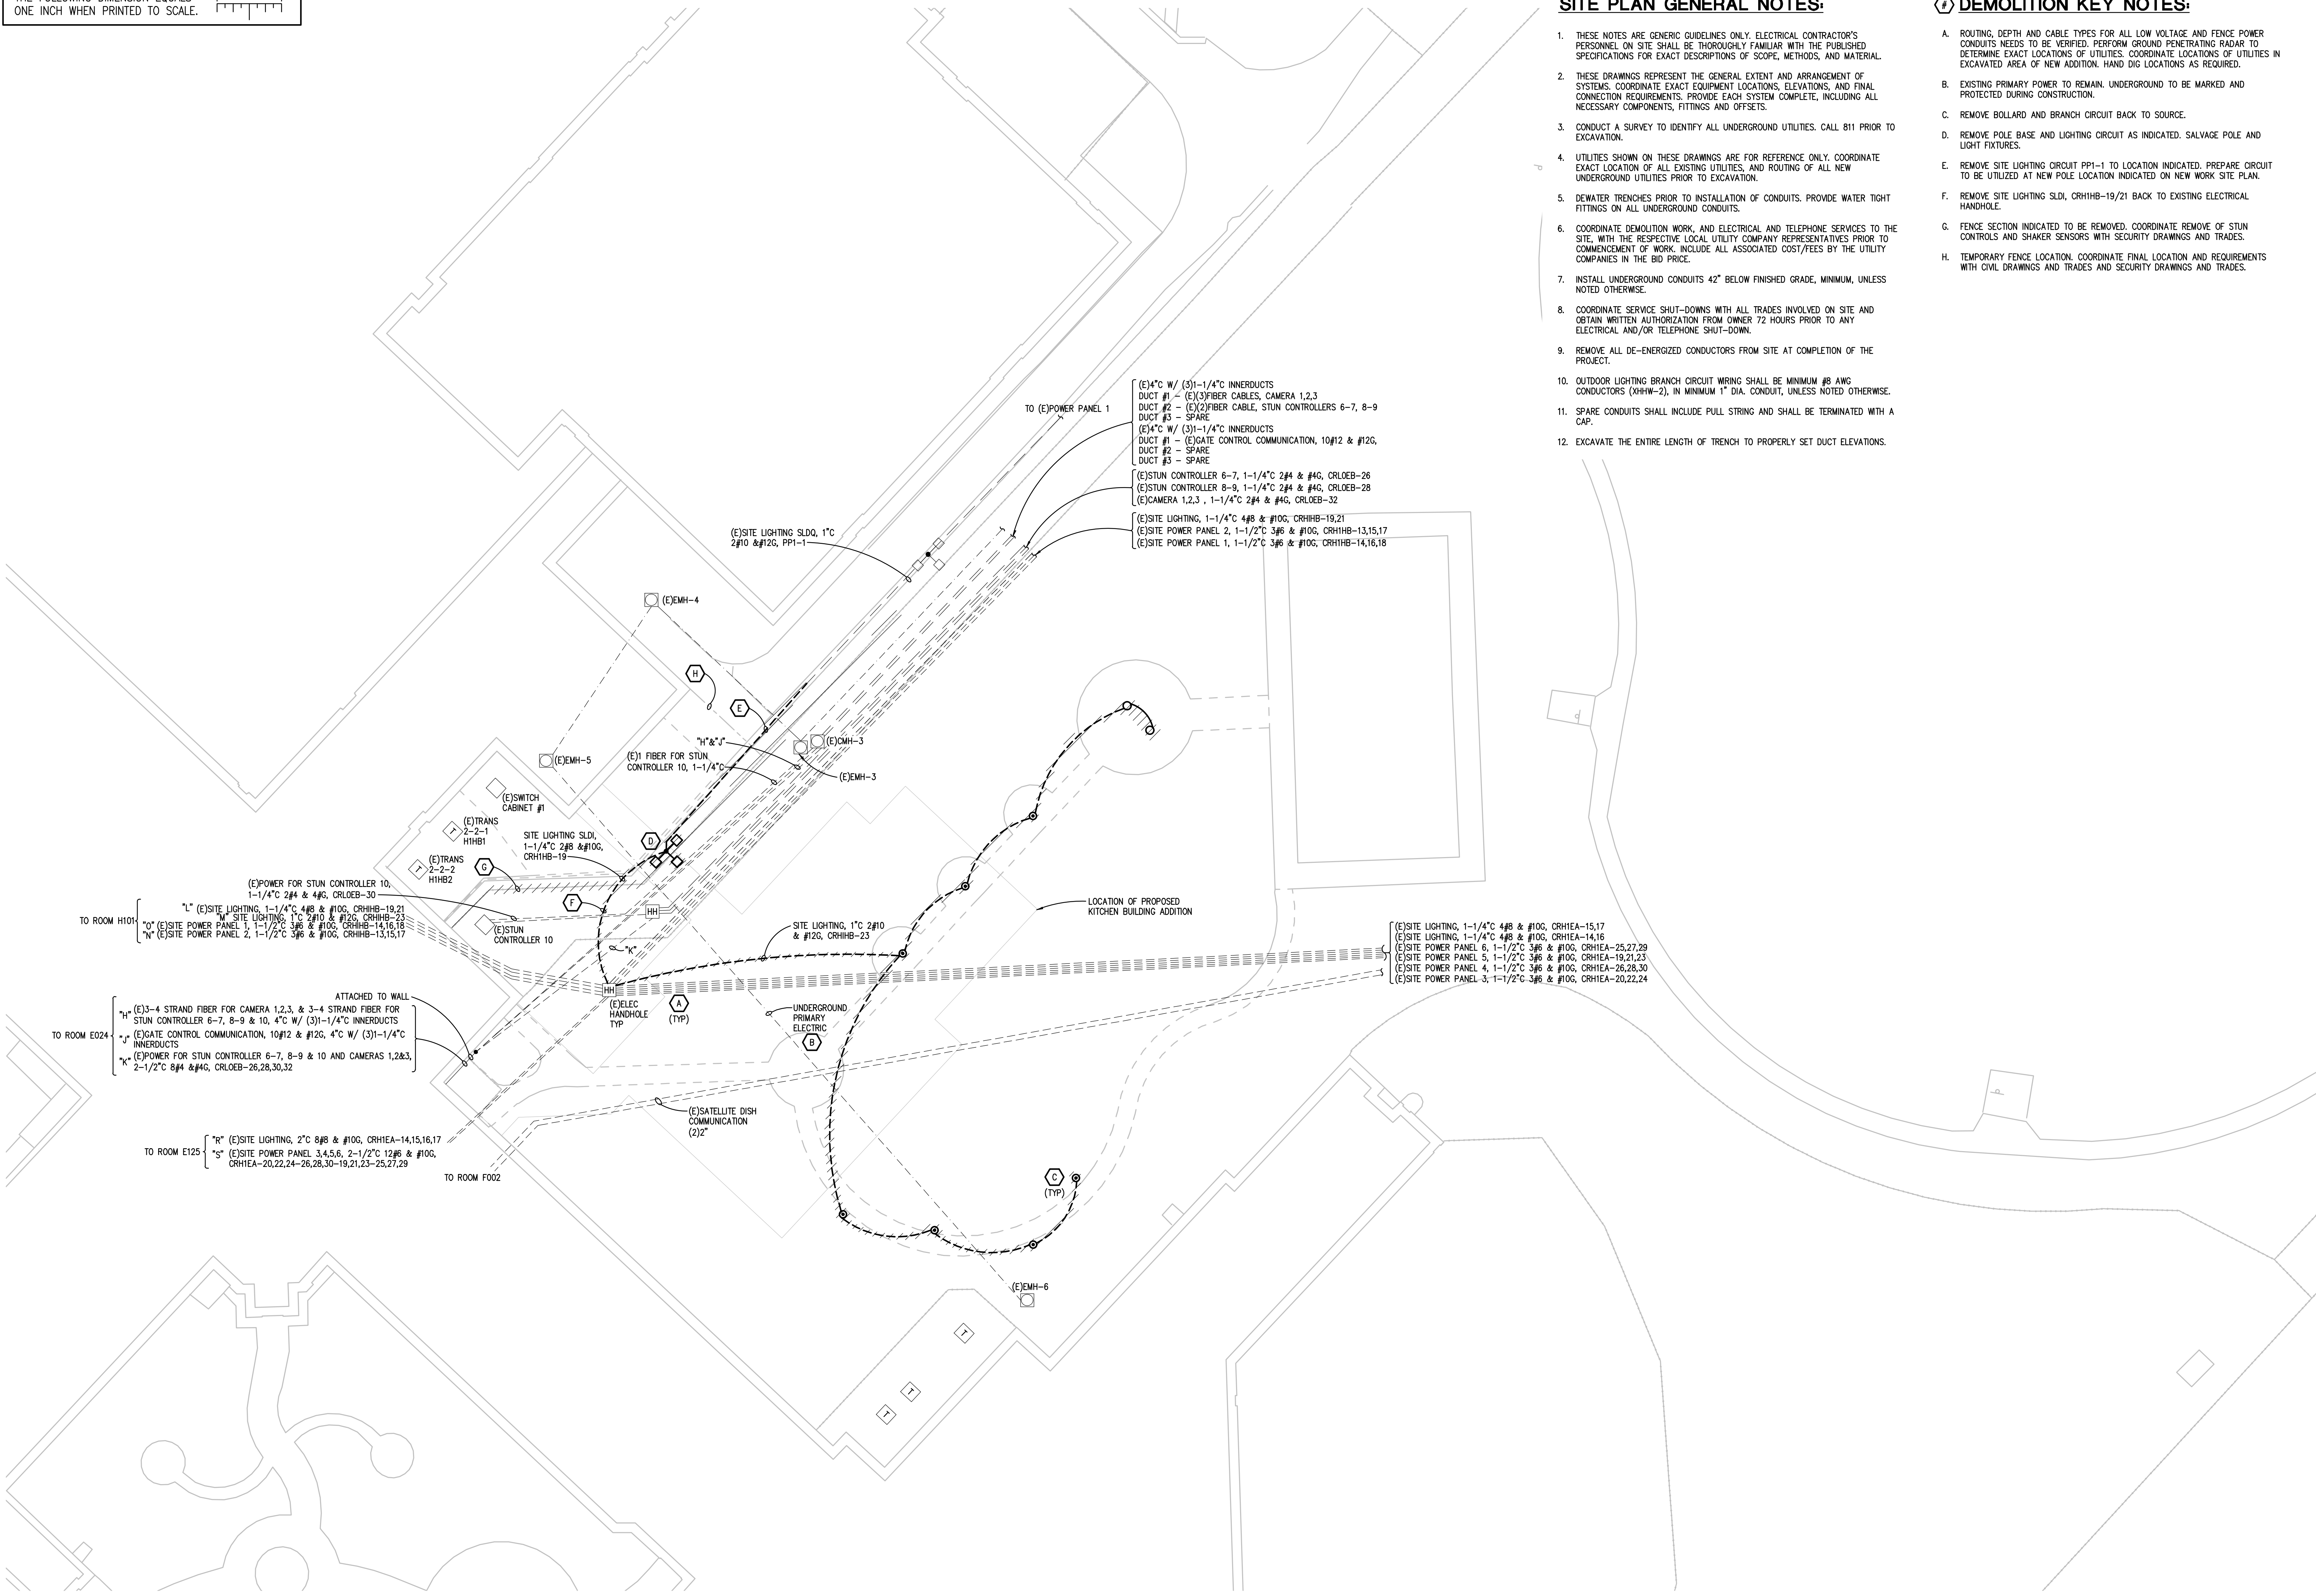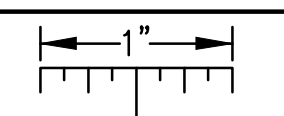

SITE PLAN GENERAL NOTES:

1. THESE NOTES ARE GENERIC GUIDELINES ONLY. ELECTRICAL CONTRACTOR'S PERSONNEL ON SITE SHALL BE THOROUGHLY FAMILIAR WITH THE PUBLISHED SPECIFICATIONS FOR EXACT DESCRIPTIONS OF SCOPE, METHODS, AND MATERIAL.
2. THESE DRAWINGS REPRESENT THE GENERAL EXTENT AND ARRANGEMENT OF SYSTEMS. COORDINATE EXACT EQUIPMENT LOCATIONS, ELEVATIONS, AND FINAL CONNECTION REQUIREMENTS. PROVIDE EACH SYSTEM COMPLETE, INCLUDING ALL NECESSARY COMPONENTS, FITTINGS AND OFFSETS.
3. CONDUCT A SURVEY TO IDENTIFY ALL UNDERGROUND UTILITIES. CALL 811 PRIOR TO EXCAVATION.
4. UTILITIES SHOWN ON THESE DRAWINGS ARE FOR REFERENCE ONLY. COORDINATE EXACT LOCATION OF ALL EXISTING UTILITIES, AND ROUTING OF ALL NEW UNDERGROUND UTILITIES PRIOR TO EXCAVATION.
5. DEWATER TRENCHES PRIOR TO INSTALLATION OF CONDUITS. PROVIDE WATER TIGHT FITTINGS ON ALL UNDERGROUND CONDUITS.
6. COORDINATE DEMOLITION WORK, AND ELECTRICAL AND TELEPHONE SERVICES TO THE SITE, WITH THE RESPECTIVE LOCAL UTILITY COMPANY REPRESENTATIVES PRIOR TO COMMENCEMENT OF WORK. INCLUDE ALL ASSOCIATED COSTS/FEE'S BY THE UTILITY COMPANIES IN THE BID PRICE.
7. INSTALL UNDERGROUND CONDUITS 42" BELOW FINISHED GRADE, MINIMUM, UNLESS NOTED OTHERWISE.
8. COORDINATE SERVICE SHUT-DOWNS WITH ALL TRADES INVOLVED ON SITE AND OBTAIN WRITTEN AUTHORIZATION FROM OWNER 72 HOURS PRIOR TO ANY ELECTRICAL AND/OR TELEPHONE SHUT-DOWN.
9. REMOVE ALL DE-ENERGIZED CONDUCTORS FROM SITE AT COMPLETION OF THE PROJECT.
10. OUTDOOR LIGHTING BRANCH CIRCUIT WIRING SHALL BE MINIMUM #8 AWG CONDUCTORS (XHHW-2), IN MINIMUM 1" DIA. CONDUIT, UNLESS NOTED OTHERWISE.
11. SPARE CONDUITS SHALL INCLUDE PULL STRING AND SHALL BE TERMINATED WITH A CAP.
12. EXCAVATE THE ENTIRE LENGTH OF TRENCH TO PROPERLY SET DUCT ELEVATIONS.

DEMOLITION KEY NOTES:

- A. ROUTING, DEPTH AND CABLE TYPES FOR ALL LOW VOLTAGE AND FENCE POWER CONDUITS NEEDS TO BE VERIFIED. PERFORM GROUND PENETRATING RADAR TO DETERMINE EXACT LOCATIONS OF UTILITIES. COORDINATE LOCATIONS OF UTILITIES IN EXCAVATED AREA OF NEW ADDITION. HAND DIG LOCATIONS AS REQUIRED.
- B. EXISTING PRIMARY POWER TO REMAIN UNDERGROUND TO BE MARKED AND PROTECTED DURING CONSTRUCTION.
- C. REMOVE BOLLARD AND BRANCH CIRCUIT BACK TO SOURCE.
- D. REMOVE POLE BASE AND LIGHTING CIRCUIT AS INDICATED. SALVAGE POLE AND LIGHT FIXTURES.
- E. REMOVE SITE LIGHTING CIRCUIT PP1-1 TO LOCATION INDICATED. PREPARE CIRCUIT TO BE UTILIZED AT NEW POLE LOCATION INDICATED ON NEW WORK SITE PLAN.
- F. REMOVE SITE LIGHTING SLID, CRHHB-19/21 BACK TO EXISTING ELECTRICAL HANDHOLE.
- G. FENCE SECTION INDICATED TO BE REMOVED. COORDINATE REMOVE OF STUN CONTROLS AND SHAKER SENSORS WITH SECURITY DRAWINGS AND TRADES.
- H. TEMPORARY FENCE LOCATION. COORDINATE FINAL LOCATION AND REQUIREMENTS WITH CIVIL DRAWINGS AND TRADES AND SECURITY DRAWINGS AND TRADES.

TO (E)POWER PANEL 1
 (E)4" W / (3)1-1/4" INNERDUCTS
 DUCT #1 - (E)3 FIBER CABLES, CAMERA 1,2,3
 DUCT #2 - (E)3 FIBER CABLE, STUN CONTROLLERS 6-7, 8-9
 DUCT #3 - SPARE
 (E)4" W / (3)1-1/4" INNERDUCTS
 DUCT #1 - (E)GATE CONTROL COMMUNICATION, 10#12 & #12G,
 DUCT #2 - SPARE
 DUCT #3 - SPARE
 (E)STUN CONTROLLER 6-7, 1-1/4" 2#4 & #4G, CRLOBE-26
 (E)STUN CONTROLLER 8-9, 1-1/4" 2#4 & #4G, CRLOBE-28
 (E)CAMERA 1,2,3, 1-1/4" 2#4 & #4G, CRLOBE-32
 (E)SITE LIGHTING, 1-1/4" 4#8 & #10G, CRHHB-19,21
 (E)SITE POWER PANEL 2, 1-1/2" 3#6 & #10G, CRHHB-13,15,17
 (E)SITE POWER PANEL 1, 1-1/2" 3#6 & #10G, CRHHB-14,16,18

(E)SITE LIGHTING, 1-1/4" 4#8 & #10G, CRHEA-15,17
 (E)SITE LIGHTING, 1-1/4" 4#8 & #10G, CRHEA-14,16
 (E)SITE POWER PANEL 6, 1-1/2" 3#6 & #10G, CRHEA-25,27,29
 (E)SITE POWER PANEL 5, 1-1/2" 3#6 & #10G, CRHEA-19,21,23
 (E)SITE POWER PANEL 4, 1-1/2" 3#6 & #10G, CRHEA-26,28,30
 (E)SITE POWER PANEL 3, 1-1/2" 3#6 & #10G, CRHEA-20,22,24

ELECTRICAL DEMOLITION SITE PLAN
 SCALE: 1" = 20'

1	OWNER REVIEW	08/02/23
NO.	REVISION	DATE

STATE OF MICHIGAN
 DEPARTMENT OF TECHNOLOGY, MANAGEMENT AND BUDGET
 FACILITIES AND BUSINESS SERVICES ADMINISTRATION
 DESIGN AND CONSTRUCTION DIVISION
 ADAM LACH, RA, DIRECTOR

FILE NO.
 491/20167.SDW
 FUNDING CODE
 171CODHHS7255
 CONTRACT NO.
 Y22003

WTA ARCHITECTS
 100 S. Jefferson Ave, Suite 601
 Saginaw, Michigan 48607
 989 752 8107
 COPYRIGHT © 2023

PROJECT TITLE
 491/20167.SDW - PHASE 500:
**CENTER FOR FORENSIC
 PSYCHIATRY - CREATE
 KITCHEN**
 SALINE, MICHIGAN
 SHEET TITLE
**ELECTRICAL DEMOLITION
 SITE PLAN**

PROJECT NUMBER 2021094	SHEET NUMBER E0.03
PROJECT DATE AUGUST 23, 2023	
CHECKED BY TLC	



ELECTRICAL
 These documents are approved for compliance with the STATE OF MICHIGAN ELECTRICAL CODE subject to field inspection and the conditions of approval.

811
 Know what's below.
 Call before you dig.

PBA
 Peter Basso Associates Inc
 CONSULTING ENGINEERS
 5145 Livernois, Suite 100
 Troy, Michigan 48068-3276
 Tel: 248-879-5666
 Fax: 248-879-0007
 www.PeterBassoAssociates.com
 PBA Project No. 2023-0002

en:\2021\2021-0402-00\CAD\2021-0402-ED-SPD.dwg, E0.03, 9/5/2023, 4:31:11 PM, Gerard Henrich, Peter Basso Associates Inc.

THE FOLLOWING DIMENSION EQUALS ONE INCH WHEN PRINTED TO SCALE.

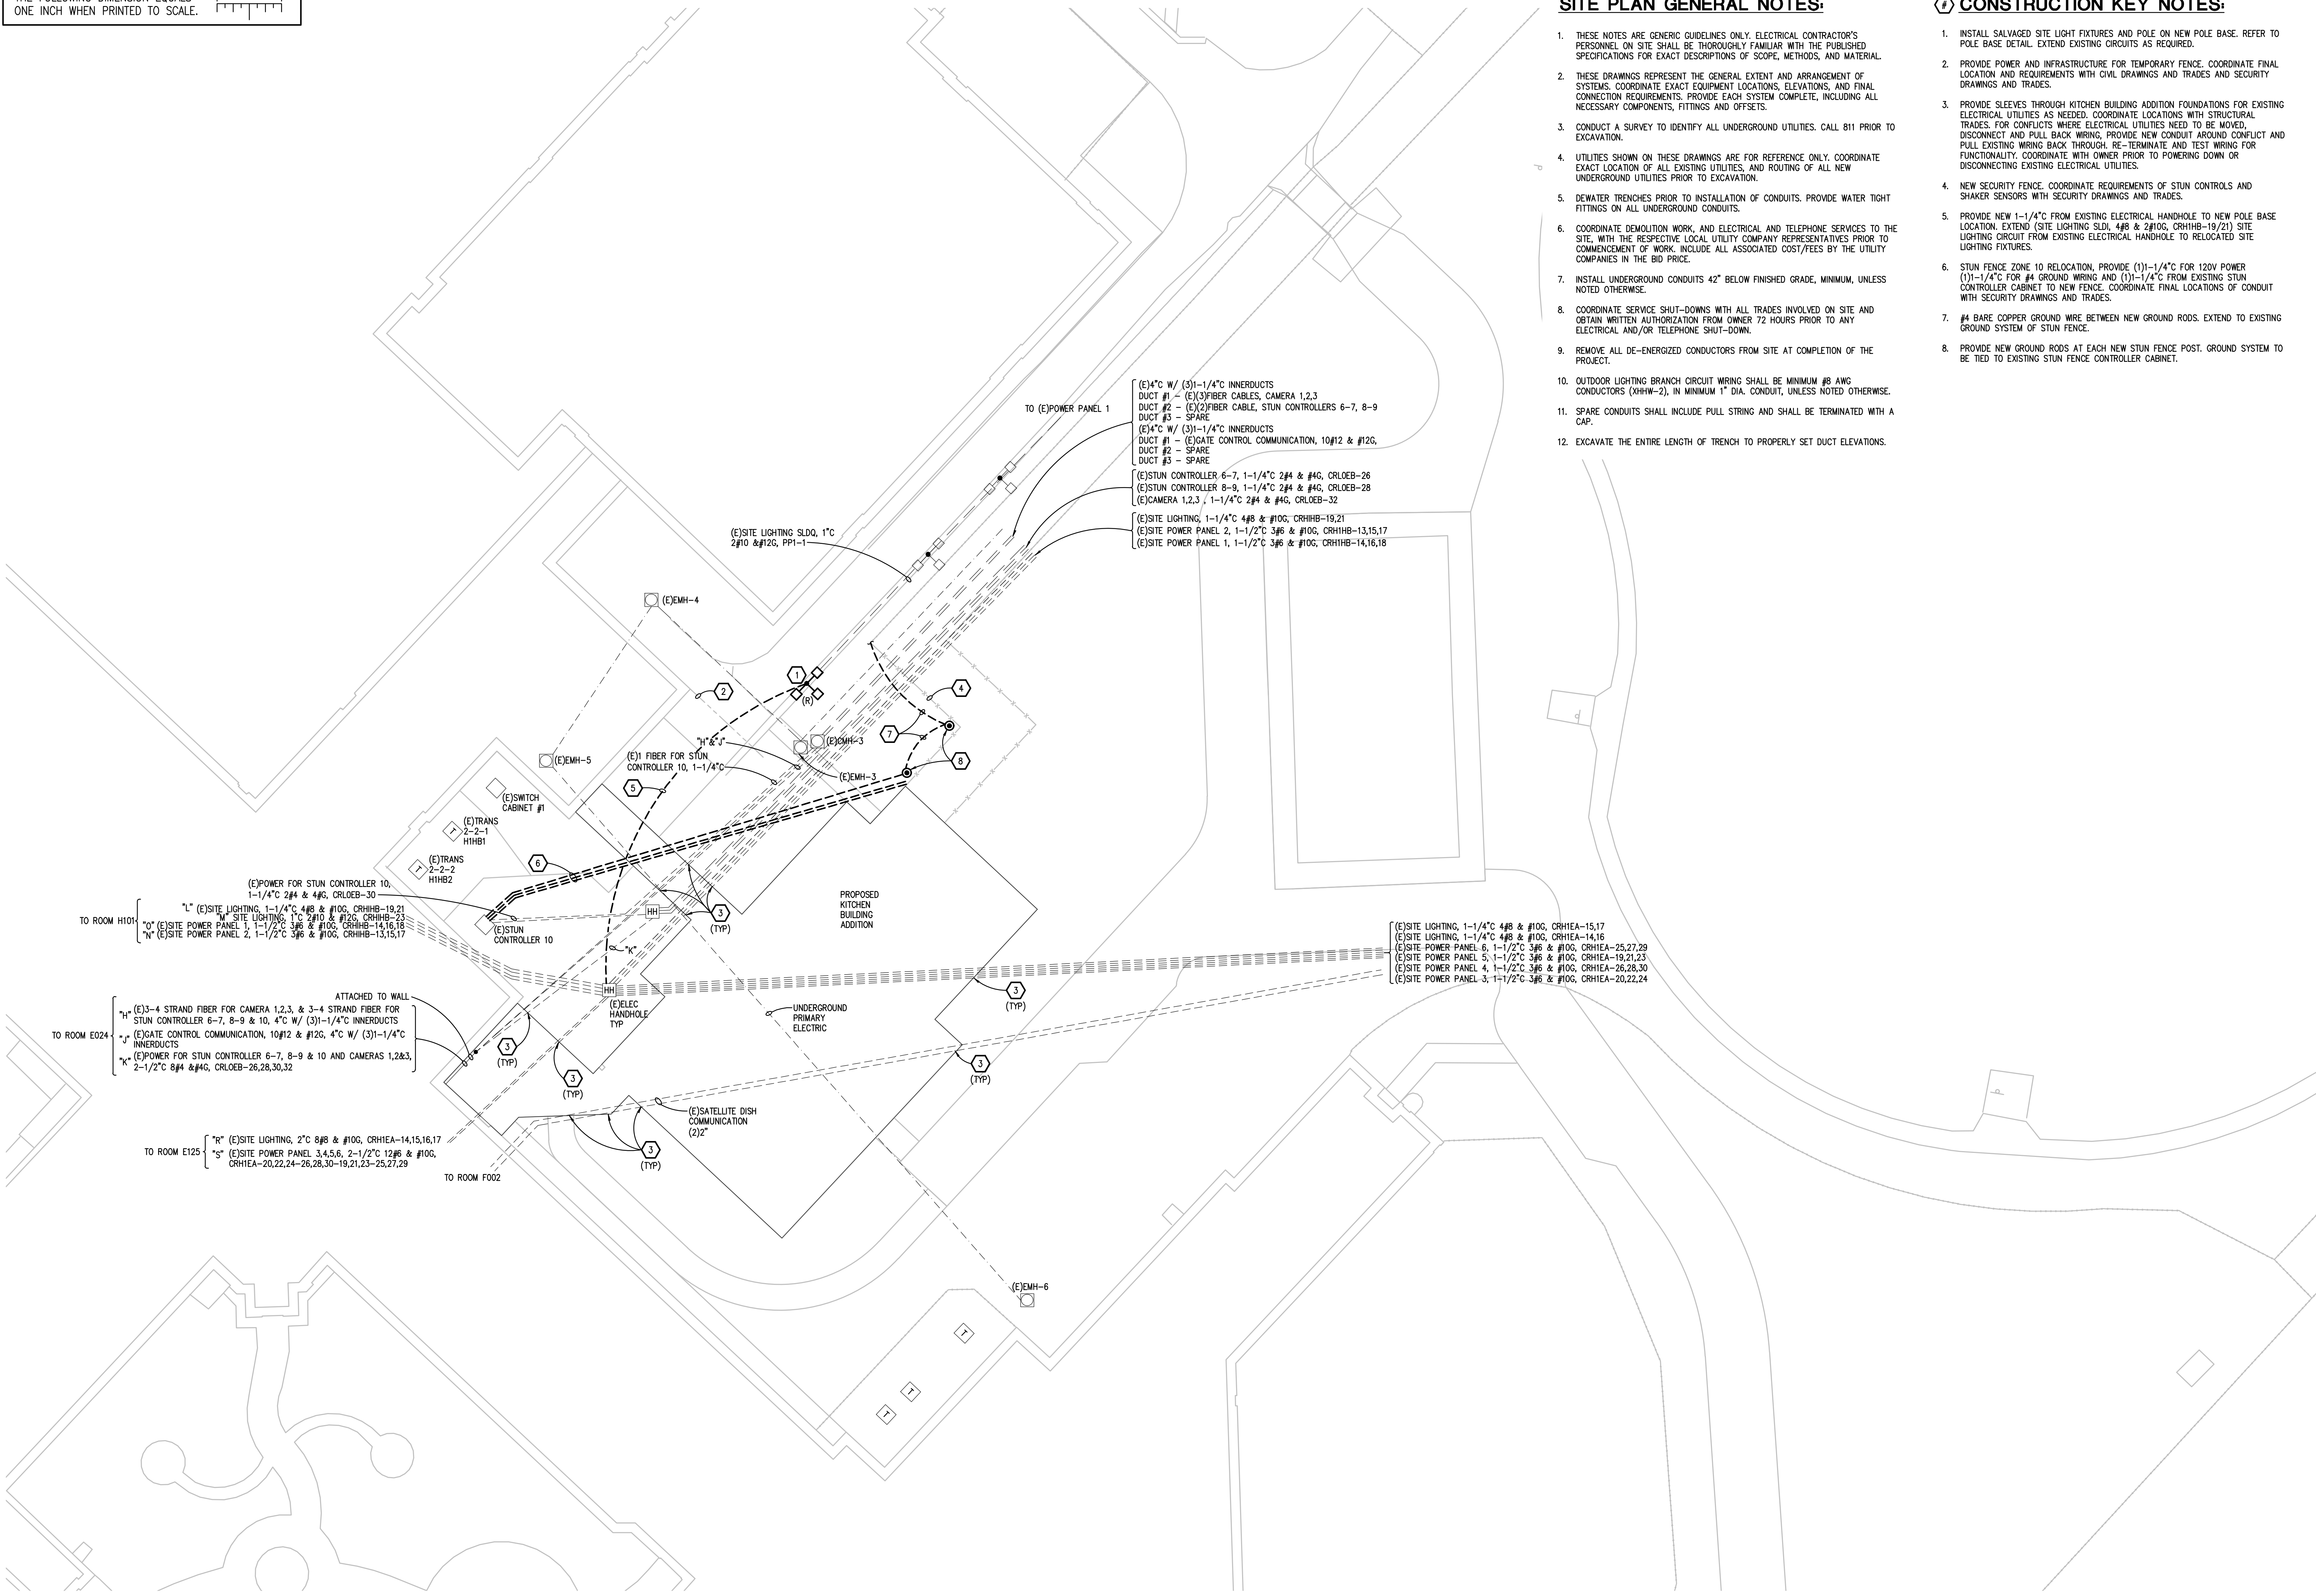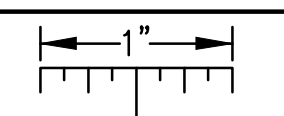

SITE PLAN GENERAL NOTES:

1. THESE NOTES ARE GENERIC GUIDELINES ONLY. ELECTRICAL CONTRACTOR'S PERSONNEL ON SITE SHALL BE THOROUGHLY FAMILIAR WITH THE PUBLISHED SPECIFICATIONS FOR EXACT DESCRIPTIONS OF SCOPE, METHODS, AND MATERIAL.
2. THESE DRAWINGS REPRESENT THE GENERAL EXTENT AND ARRANGEMENT OF SYSTEMS. COORDINATE EXACT EQUIPMENT LOCATIONS, ELEVATIONS, AND FINAL CONNECTION REQUIREMENTS. PROVIDE EACH SYSTEM COMPLETE, INCLUDING ALL NECESSARY COMPONENTS, FITTINGS AND OFFSETS.
3. CONDUCT A SURVEY TO IDENTIFY ALL UNDERGROUND UTILITIES. CALL 811 PRIOR TO EXCAVATION.
4. UTILITIES SHOWN ON THESE DRAWINGS ARE FOR REFERENCE ONLY. COORDINATE EXACT LOCATION OF ALL EXISTING UTILITIES, AND ROUTING OF ALL NEW UNDERGROUND UTILITIES PRIOR TO EXCAVATION.
5. DEWATER TRENCHES PRIOR TO INSTALLATION OF CONDUITS. PROVIDE WATER TIGHT FITTINGS ON ALL UNDERGROUND CONDUITS.
6. COORDINATE DEMOLITION WORK, AND ELECTRICAL AND TELEPHONE SERVICES TO THE SITE, WITH THE RESPECTIVE LOCAL UTILITY COMPANY REPRESENTATIVES PRIOR TO COMMENCEMENT OF WORK. INCLUDE ALL ASSOCIATED COSTS/FEE'S BY THE UTILITY COMPANIES IN THE BID PRICE.
7. INSTALL UNDERGROUND CONDUITS 42" BELOW FINISHED GRADE, MINIMUM, UNLESS NOTED OTHERWISE.
8. COORDINATE SERVICE SHUT-DOWNS WITH ALL TRADES INVOLVED ON SITE AND OBTAIN WRITTEN AUTHORIZATION FROM OWNER 72 HOURS PRIOR TO ANY ELECTRICAL, AND/OR TELEPHONE SHUT-DOWN.
9. REMOVE ALL DE-ENERGIZED CONDUCTORS FROM SITE AT COMPLETION OF THE PROJECT.
10. OUTDOOR LIGHTING BRANCH CIRCUIT WIRING SHALL BE MINIMUM #8 AWG CONDUCTORS (XHHW-2), IN MINIMUM 1" DIA. CONDUIT, UNLESS NOTED OTHERWISE.
11. SPARE CONDUITS SHALL INCLUDE PULL STRING AND SHALL BE TERMINATED WITH A CAP.
12. EXCAVATE THE ENTIRE LENGTH OF TRENCH TO PROPERLY SET DUCT ELEVATIONS.

CONSTRUCTION KEY NOTES:

1. INSTALL SALVAGED SITE LIGHT FIXTURES AND POLE ON NEW POLE BASE. REFER TO POLE BASE DETAIL. EXTEND EXISTING CIRCUITS AS REQUIRED.
2. PROVIDE POWER AND INFRASTRUCTURE FOR TEMPORARY FENCE. COORDINATE FINAL LOCATION AND REQUIREMENTS WITH CIVIL DRAWINGS AND TRADES AND SECURITY DRAWINGS AND TRADES.
3. PROVIDE SLEEVES THROUGH KITCHEN BUILDING ADDITION FOUNDATIONS FOR EXISTING ELECTRICAL UTILITIES AS NEEDED. COORDINATE LOCATIONS WITH STRUCTURAL TRADES. FOR CONDUITS WHERE ELECTRICAL UTILITIES NEED TO BE MOVED, DISCONNECT AND PULL BACK WIRING, PROVIDE NEW CONDUIT AROUND CONFLICT AND PULL EXISTING WIRING BACK THROUGH. RE-TERMINATE AND TEST WIRING FOR FUNCTIONALITY. COORDINATE WITH OWNER PRIOR TO POWERING DOWN OR DISCONNECTING EXISTING ELECTRICAL UTILITIES.
4. NEW SECURITY FENCE. COORDINATE REQUIREMENTS OF STUN CONTROLS AND SHAKER SENSORS WITH SECURITY DRAWINGS AND TRADES.
5. PROVIDE NEW 1-1/4" FROM EXISTING ELECTRICAL HANDHOLE TO NEW POLE BASE LOCATION. EXTEND (SITE LIGHTING SLDL, #8 & #10G, CRHHB-19/21) SITE LIGHTING CIRCUIT FROM EXISTING ELECTRICAL HANDHOLE TO RELOCATED SITE LIGHTING FIXTURES.
6. STUN FENCE ZONE 10 RELOCATION, PROVIDE (1)1-1/4" FOR 120V POWER (1)1-1/4" FOR #4 GROUND WIRING AND (1)1-1/4" FROM EXISTING STUN CONTROLLER CABINET TO NEW FENCE. COORDINATE FINAL LOCATIONS OF CONDUIT WITH SECURITY DRAWINGS AND TRADES.
7. #4 BARE COPPER GROUND WIRE BETWEEN NEW GROUND RODS. EXTEND TO EXISTING GROUND SYSTEM OF STUN FENCE.
8. PROVIDE NEW GROUND RODS AT EACH NEW STUN FENCE POST. GROUND SYSTEM TO BE TIED TO EXISTING STUN FENCE CONTROLLER CABINET.

TO (E)POWER PANEL 1
 (E)4" W / (3)1-1/4" INNERDUCTS
 DUCT #1 - (E)3" FIBER CABLES, CAMERA 1,2,3
 DUCT #2 - (E)2" FIBER CABLE, STUN CONTROLLERS 6-7, 8-9
 DUCT #3 - SPARE
 (E)4" W / (3)1-1/4" INNERDUCTS
 DUCT #1 - (E)GATE CONTROL COMMUNICATION, 10#12 & #12G,
 DUCT #2 - SPARE
 DUCT #3 - SPARE
 (E)STUN CONTROLLER 6-7, 1-1/4" 2#4 & #4G, CRLOEB-26
 (E)STUN CONTROLLER 8-9, 1-1/4" 2#4 & #4G, CRLOEB-28
 (E)CAMERA 1,2,3, 1-1/4" 2#4 & #4G, CRLOEB-32
 (E)SITE LIGHTING, 1-1/4" 4#8 & #10G, CRHHB-19,21
 (E)SITE POWER PANEL 2, 1-1/2" 3#6 & #10G, CRHHB-13,15,17
 (E)SITE POWER PANEL 1, 1-1/2" 3#6 & #10G, CRHHB-14,16,18

(E)SITE LIGHTING, 1-1/4" 4#8 & #10G, CRH1EA-15,17
 (E)SITE LIGHTING, 1-1/4" 4#8 & #10G, CRH1EA-14,16
 (E)SITE POWER PANEL 6, 1-1/2" 3#6 & #10G, CRH1EA-25,27,29
 (E)SITE POWER PANEL 5, 1-1/2" 3#6 & #10G, CRH1EA-19,21,23
 (E)SITE POWER PANEL 4, 1-1/2" 3#6 & #10G, CRH1EA-26,28,30
 (E)SITE POWER PANEL 3, 1-1/2" 3#6 & #10G, CRH1EA-20,22,24

ELECTRICAL NEW WORK SITE PLAN
 SCALE: 1" = 20'

1	OWNER REVIEW	08/02/23
NO.	REVISION	DATE

STATE OF MICHIGAN
 DEPARTMENT OF TECHNOLOGY, MANAGEMENT AND BUDGET
 FACILITIES AND BUSINESS SERVICES ADMINISTRATION
 DESIGN AND CONSTRUCTION DIVISION
 ADAM LACH, RA, DIRECTOR

FILE NO.
 491/20167.SDW
 FUNDING CODE
 171CODHHS7255
 CONTRACT NO.
 Y22003

WTA ARCHITECTS
 100 S. Jefferson Ave, Suite 601
 Saginaw, Michigan 48607
 989 752 8107
 COPYRIGHT © 2023

PROJECT TITLE
 491/20167.SDW - PHASE 500:
**CENTER FOR FORENSIC
 PSYCHIATRY - CREATE
 KITCHEN**
 SALINE, MICHIGAN
 SHEET TITLE
**ELECTRICAL NEW WORK
 SITE PLAN**

PROJECT NUMBER 2021094	SHEET NUMBER
PROJECT DATE AUGUST 23, 2023	E0.04
CHECKED BY TLC	



ELECTRICAL
 These documents are approved for compliance with the STATE OF MICHIGAN ELECTRICAL CODE subject to field inspection and the conditions of approval.

811
 Know what's below.
 Call before you dig.

PBA
 Peter Basso Associates Inc
 CONSULTING ENGINEERS
 5145 Livernois, Suite 100
 Troy, Michigan 48068-3276
 Tel: 248-879-5666
 Fax: 248-879-0007
 www.PeterBassoAssociates.com
 PBA Project No. 2023.0002

en:\2021\2021-0402-00\CAD\2021-0402-ED-SPN.dwg, ED.04, 9/5/2023 4:31:17 PM, Gerard Henrich, Peter Basso Associates Inc.

THE FOLLOWING DIMENSION EQUALS ONE INCH WHEN PRINTED TO SCALE.

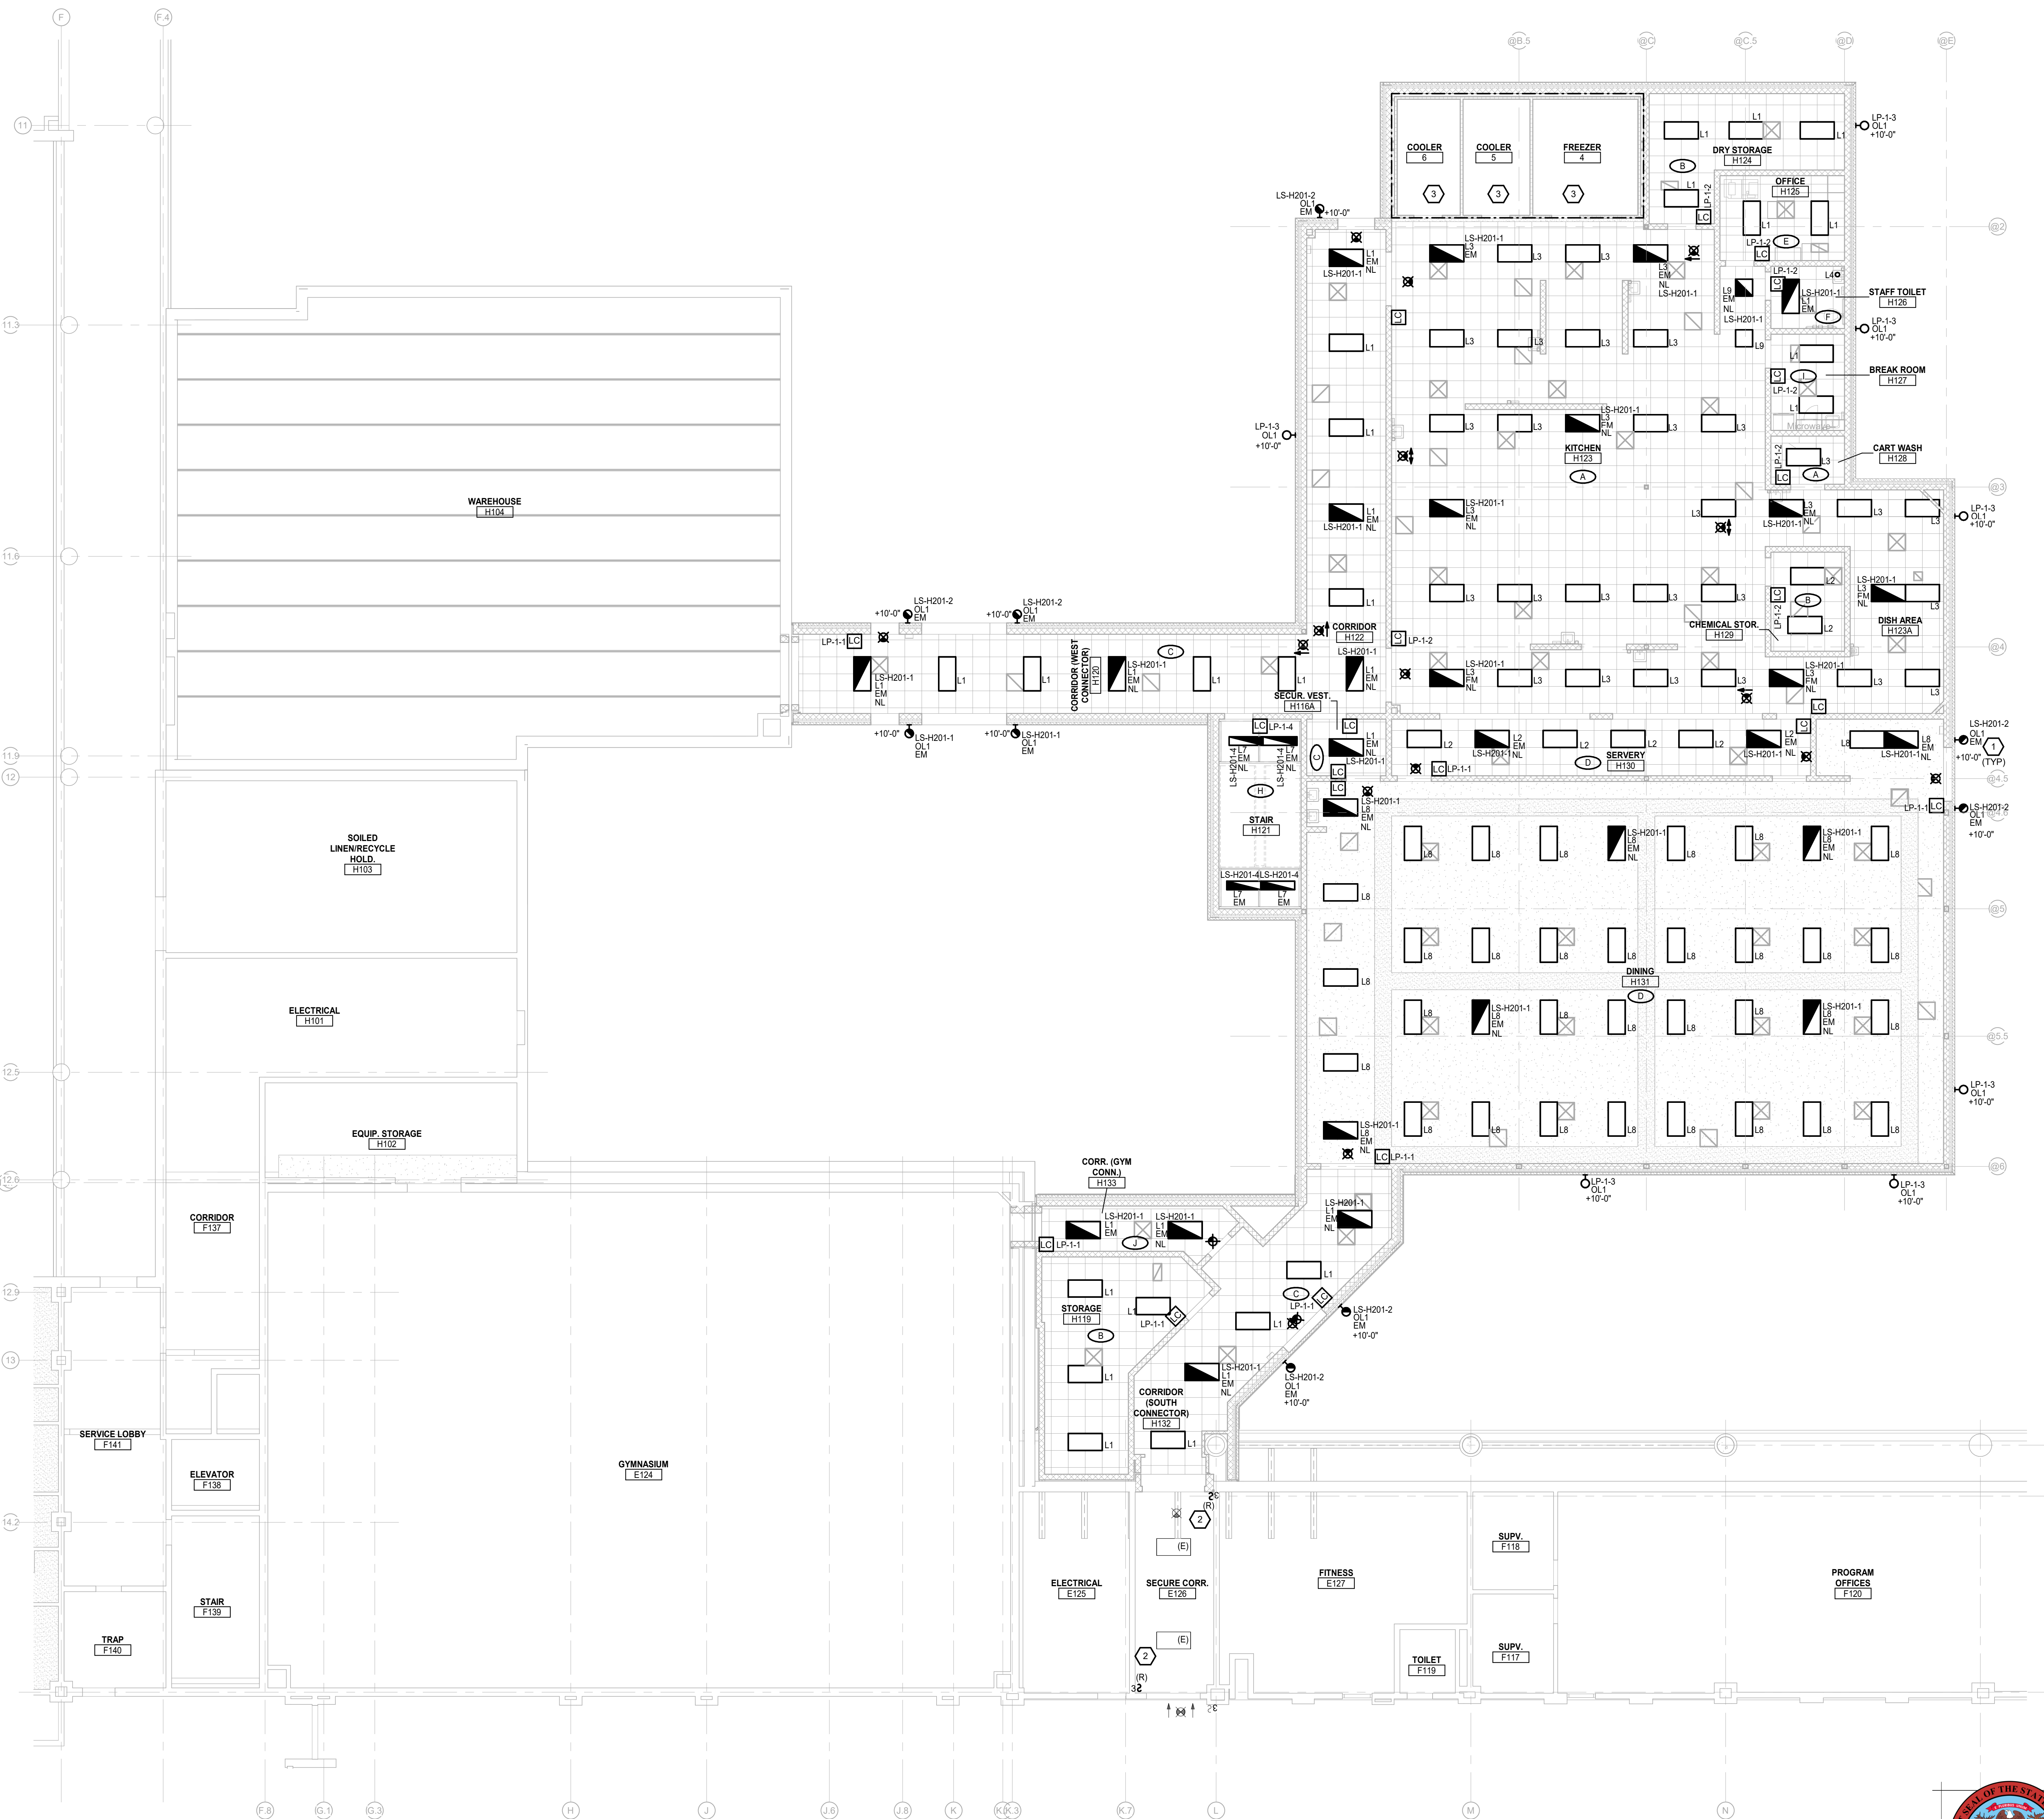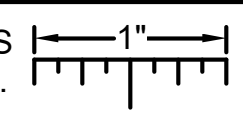

ELECTRICAL GENERAL NOTES:

- THESE DRAWINGS REPRESENT THE GENERAL EXTENT AND ARRANGEMENT OF SYSTEMS. COORDINATE EXACT EQUIPMENT LOCATIONS, ELEVATIONS, AND FINAL CONNECTION REQUIREMENTS. PROVIDE EACH SYSTEM COMPLETE, INCLUDING ALL NECESSARY COMPONENTS, FITTINGS AND OFFSETS.
- INSTALL SYSTEMS SUCH THAT REQUIRED CLEARANCE AND SERVICE ACCESS SPACE IS PROVIDED AROUND ALL MECHANICAL AND ELECTRICAL EQUIPMENT, AND AROUND ANY COMPONENTS WHICH REQUIRE SERVICE ACCESS.
- COORDINATE AND PROVIDE ACCESS DOORS WITHIN INACCESSIBLE CEILING, SHAFT, AND CHASE AREAS FOR ALL COMPONENTS WHICH REQUIRE SERVICE ACCESS. REFER TO ARCHITECTURAL DRAWINGS FOR CEILING TYPES.
- PROVIDE SUPPLEMENTARY STEEL AS REQUIRED FOR THE PROPER SUPPORT OF ALL SYSTEMS.
- TRANSFORMER SECONDARY CONDUCTORS SHALL BE SIZED IN ACCORDANCE WITH TRANSFORMER CIRCUIT SIZING SCHEDULE SHOWN ON "ELECTRICAL STANDARD SCHEDULES DRAWING" UNLESS OTHERWISE NOTED.
- MOTOR CIRCUIT PROTECTION SHALL BE SIZED IN ACCORDANCE WITH MOTOR CIRCUIT SIZING SCHEDULES SHOWN ON "ELECTRICAL STANDARD SCHEDULES DRAWING" UNLESS OTHERWISE NOTED.
- COORDINATE THE MOUNTING HEIGHTS OF DEVICES WITH ARCHITECTURAL ELEVATIONS AND THE TRADES INSTALLING THE WORK.
- REFER TO MECHANICAL SCHEDULE SHEETS FOR ELECTRICAL REQUIREMENTS FOR MECHANICAL EQUIPMENT. PROVIDE ALL CONNECTIONS, STARTERS, DISCONNECTS, ETC. AS REQUIRED BY SCHEDULES AND WHERE NOTED ELSEWHERE. VERIFY REQUIREMENTS OF ALL MECHANICAL EQUIPMENT WITH SHOP DRAWINGS SUBMITTALS. NOTIFY ENGINEER OF ANY CONFLICTS BETWEEN EQUIPMENT SUBMITTALS AND ELECTRICAL DRAWINGS. WHERE CIRCUIT SIZES ARE SHOWN ON THE ELECTRICAL DRAWINGS THAT DIFFER FROM WHAT IS INDICATED ON THE MECHANICAL SCHEDULES, PROVIDE THE CIRCUIT OF HIGHER AMPACITY.
- REFER TO TEMPERATURE CONTROLS SHEETS FOR REQUIRED FIRE ALARM CONTROL MODULES, DUCT SMOKE DETECTORS, AND MOTOR CONTROLLERS. PROVIDE ALL ACCESSORIES INDICATED.
- REFER TO LIGHTING CONTROL SCHEDULE FOR ROOM CONTROL AND EMERGENCY LIGHTING CIRCUIT CONTROL REQUIREMENTS. DESIGNATION FOR ROOM IS INDICATED AS A LETTERED OVAL SYMBOL.
- ALL FIRE ALARM DEVICES SHALL BE COMPATIBLE WITH EXISTING SIMPLEX GRINNEL 4120 FIRE ALARM SYSTEM. PROVIDE NECESSARY COMPONENTS, MODULES, ETC. AS REQUIRED FOR A FULLY FUNCTIONAL SYSTEM. RE-TEST AND CERTIFY EXISTING FIRE ALARM SYSTEM AT COMPLETION OF PROJECT.
- PROVIDE TAMPER RESISTANT COVER PLATE KENALL WPP SERIES OR EQUAL WHERE PATIENTS WILL HAVE ACCESS TO DEVICES.
- REFER TO SECURITY/TELECOMMUNICATION DRAWINGS FOR FINAL DEVICE LOCATIONS AND RACEWAY REQUIREMENTS. COORDINATE WITH SECURITY REQUIREMENTS WITH INSTALLING TRADES.
- COORDINATE ELECTRICAL REQUIREMENTS DEVICE LOCATIONS AND MOUNTING HEIGHTS WITH KITCHEN EQUIPMENT DRAWINGS, SHOP DRAWINGS AND KITCHEN EQUIPMENT INSTALLER.

CONSTRUCTION KEY NOTES:


- EXTERIOR LIGHTING TO BE CONTROLLED VIA LIGHTING CONTACTOR IN H201. REFER TO DETAIL FOR CIRCUITING.
- INSTALL SALVAGED SWITCH IN EXISTING BLOCK WALL. EXTEND EXISTING BRANCH CIRCUIT.
- COOLER AND FREEZER LIGHTING PROVIDED BY ENCLOSURE PACKAGE. REFER TO ENLARGED PLAN FOR CIRCUITING INFORMATION.

NO.	REVISION	DATE

STATE OF MICHIGAN
DEPARTMENT OF TECHNOLOGY, MANAGEMENT AND BUDGET
FACILITIES AND BUSINESS SERVICES ADMINISTRATION
DESIGN AND CONSTRUCTION DIVISION
ADAM LACH, RA, DIRECTOR

FILE NO.
49120167.SDW

FUNDING CODE 171CODHHS7255 CONTRACT NO. Y22003

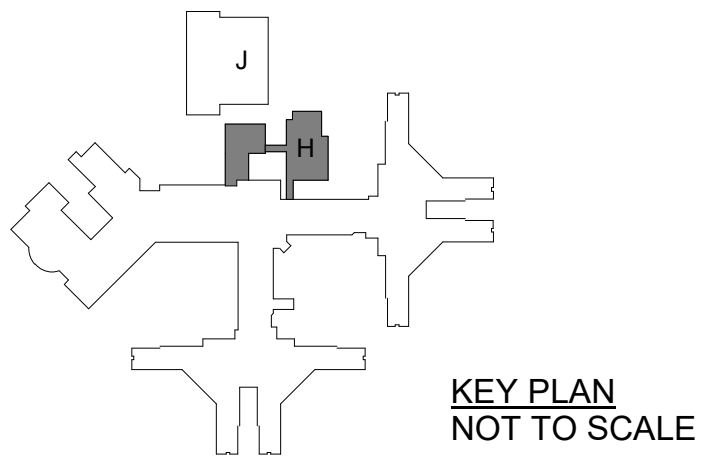


WTA ARCHITECTS
100 S. Jefferson Ave, Suite 601
Saginaw, Michigan 48607
989 752 8107
COPYRIGHT © 2023

PROJECT TITLE
49120167.SDW - PHASE 500:
CENTER FOR FORENSIC
PSYCHIATRY - CREATE
KITCHEN
SALINE, MICHIGAN

SHEET TITLE
FIRST FLOOR LIGHTING
PLAN - UNIT H

PROJECT NUMBER 2021094	SHEET NUMBER E2.01
PROJECT DATE SEPTEMBER 6, 2023	
CHECKED BY TLC	


FIRST FLOOR LIGHTING PLAN - UNIT H
SCALE: 1/8" = 1'-0"

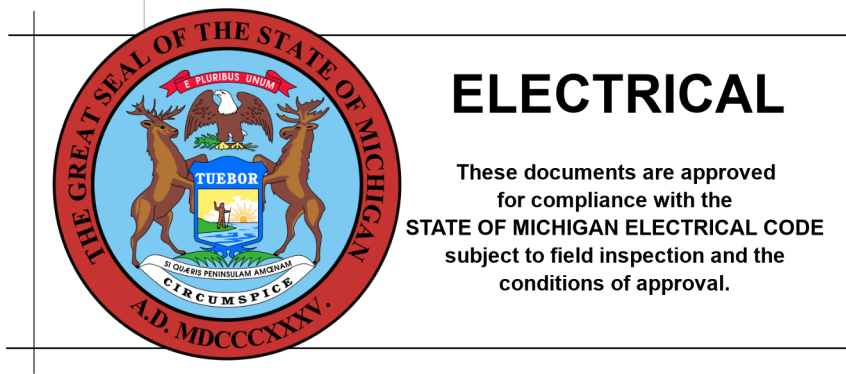

Peter Basso Associates Inc.
CONSULTING ENGINEERS
5145 Livernois, Suite 100
Troy, Michigan 48068-3276
Tel: 248-879-5666
Fax: 248-879-0007
www.PeterBassoAssociates.com
PBA Project No. 303-0402

9/25/2023 4:37:02 PM C:\REVIT LOCAL FILES\2023\0402-ME2_Forensic_Psyeh_v23_Ghentich.rvt

THE FOLLOWING DIMENSION EQUALS ONE INCH WHEN PRINTED TO SCALE.

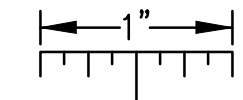


ELECTRICAL GENERAL NOTES:


1. THESE DRAWINGS REPRESENT THE GENERAL EXTENT AND ARRANGEMENT OF SYSTEMS, COORDINATE EXACT EQUIPMENT LOCATIONS, ELEVATIONS, AND FINAL CONNECTION REQUIREMENTS. PROVIDE EACH SYSTEM COMPLETE, INCLUDING ALL NECESSARY COMPONENTS, FITTINGS AND OFFSETS.
2. INSTALL SYSTEMS SUCH THAT REQUIRED CLEARANCE AND SERVICE ACCESS SPACE IS PROVIDED AROUND ALL MECHANICAL AND ELECTRICAL EQUIPMENT, AND AROUND ANY COMPONENTS WHICH REQUIRE SERVICE ACCESS.
3. COORDINATE AND PROVIDE ACCESS DOORS WITHIN INACCESSIBLE CEILING, SHAFT, AND CHASE AREAS FOR ALL COMPONENTS WHICH REQUIRE SERVICE ACCESS. REFER TO ARCHITECTURAL DRAWINGS FOR CEILING TYPES.
4. PROVIDE SUPPLEMENTARY STEEL AS REQUIRED FOR THE PROPER SUPPORT OF ALL SYSTEMS.
5. TRANSFORMER SECONDARY CONDUCTORS SHALL BE SIZED IN ACCORDANCE WITH TRANSFORMER CIRCUIT SIZING SCHEDULE SHOWN ON "ELECTRICAL STANDARD SCHEDULES DRAWING" UNLESS OTHERWISE NOTED.
6. MOTOR CIRCUIT PROTECTION SHALL BE SIZED IN ACCORDANCE WITH MOTOR CIRCUIT SIZING SCHEDULES SHOWN ON "ELECTRICAL STANDARD SCHEDULES DRAWING" UNLESS OTHERWISE NOTED.
7. COORDINATE THE MOUNTING HEIGHTS OF DEVICES WITH ARCHITECTURAL ELEVATIONS AND THE TRADES INSTALLING THE WORK.
8. REFER TO MECHANICAL SCHEDULE SHEETS FOR ELECTRICAL REQUIREMENTS FOR MECHANICAL EQUIPMENT, PROVIDE ALL CONNECTIONS, STARTERS, DISCONNECTS, ETC. AS REQUIRED BY SCHEDULES AND WHERE NOTED ELSEWHERE. VERIFY REQUIREMENTS OF ALL MECHANICAL EQUIPMENT WITH SHOP DRAWINGS SUBMITTALS. NOTIFY ENGINEER OF ANY CONFLICTS BETWEEN EQUIPMENT SUBMITTALS AND ELECTRICAL DRAWINGS. WHERE CIRCUIT SIZES ARE SHOWN ON THE ELECTRICAL DRAWINGS THAT DIFFER FROM WHAT IS INDICATED ON THE MECHANICAL SCHEDULES, PROVIDE THE CIRCUIT OF HIGHER AMPACITY.
9. REFER TO TEMPERATURE CONTROLS SHEETS FOR REQUIRED FIRE ALARM CONTROL MODULES, DUCT SMOKE DETECTORS, AND MOTOR CONTROLLERS. PROVIDE ALL ACCESSORIES INDICATED.
10. REFER TO LIGHTING CONTROL SCHEDULE FOR ROOM CONTROL AND EMERGENCY LIGHTING CIRCUIT CONTROL REQUIREMENTS. DESIGNATION FOR ROOM IS INDICATED AS A LETTERED OVAL SYMBOL.
11. ALL FIRE ALARM DEVICES SHALL BE COMPATIBLE WITH EXISTING SIMPLEX GRINNEL 4120 FIRE ALARM SYSTEMS. PROVIDE NECESSARY COMPONENTS, MODULES, ETC. AS REQUIRED FOR A FULLY FUNCTIONAL SYSTEM. RE-TEST AND CERTIFY EXISTING FIRE ALARM SYSTEM AT COMPLETION OF PROJECT.
12. PROVIDE TAMPER RESISTANT COVER PLATE KENALL WPP SERIES OR EQUAL WHERE PATIENTS WILL HAVE ACCESS TO DEVICES.
13. REFER TO SECURITY/TELECOMMUNICATION DRAWINGS FOR FINAL DEVICE LOCATIONS AND RACEWAY REQUIREMENTS. COORDINATE WITH SECURITY REQUIREMENTS WITH INSTALLING TRADES.
14. COORDINATE ELECTRICAL REQUIREMENTS DEVICE LOCATIONS AND MOUNTING HEIGHTS WITH KITCHEN EQUIPMENT DRAWINGS, SHOP DRAWINGS AND KITCHEN EQUIPMENT INSTALLER.

CONSTRUCTION KEY NOTES:

1. PROVIDE (2) 120V 20A DEDICATED BRANCH CIRCUITS FROM SPARE CIRCUIT BREAKERS IN (E)CRL0EB FOR NEW IT RACK IN SECURITY ELECTRONICS E024.
2. EXISTING LINE VOLTAGE MASTER CLOCK HEAD-END. EXTEND CIRCUITING TO NEW CLOCKS AS REQUIRED.

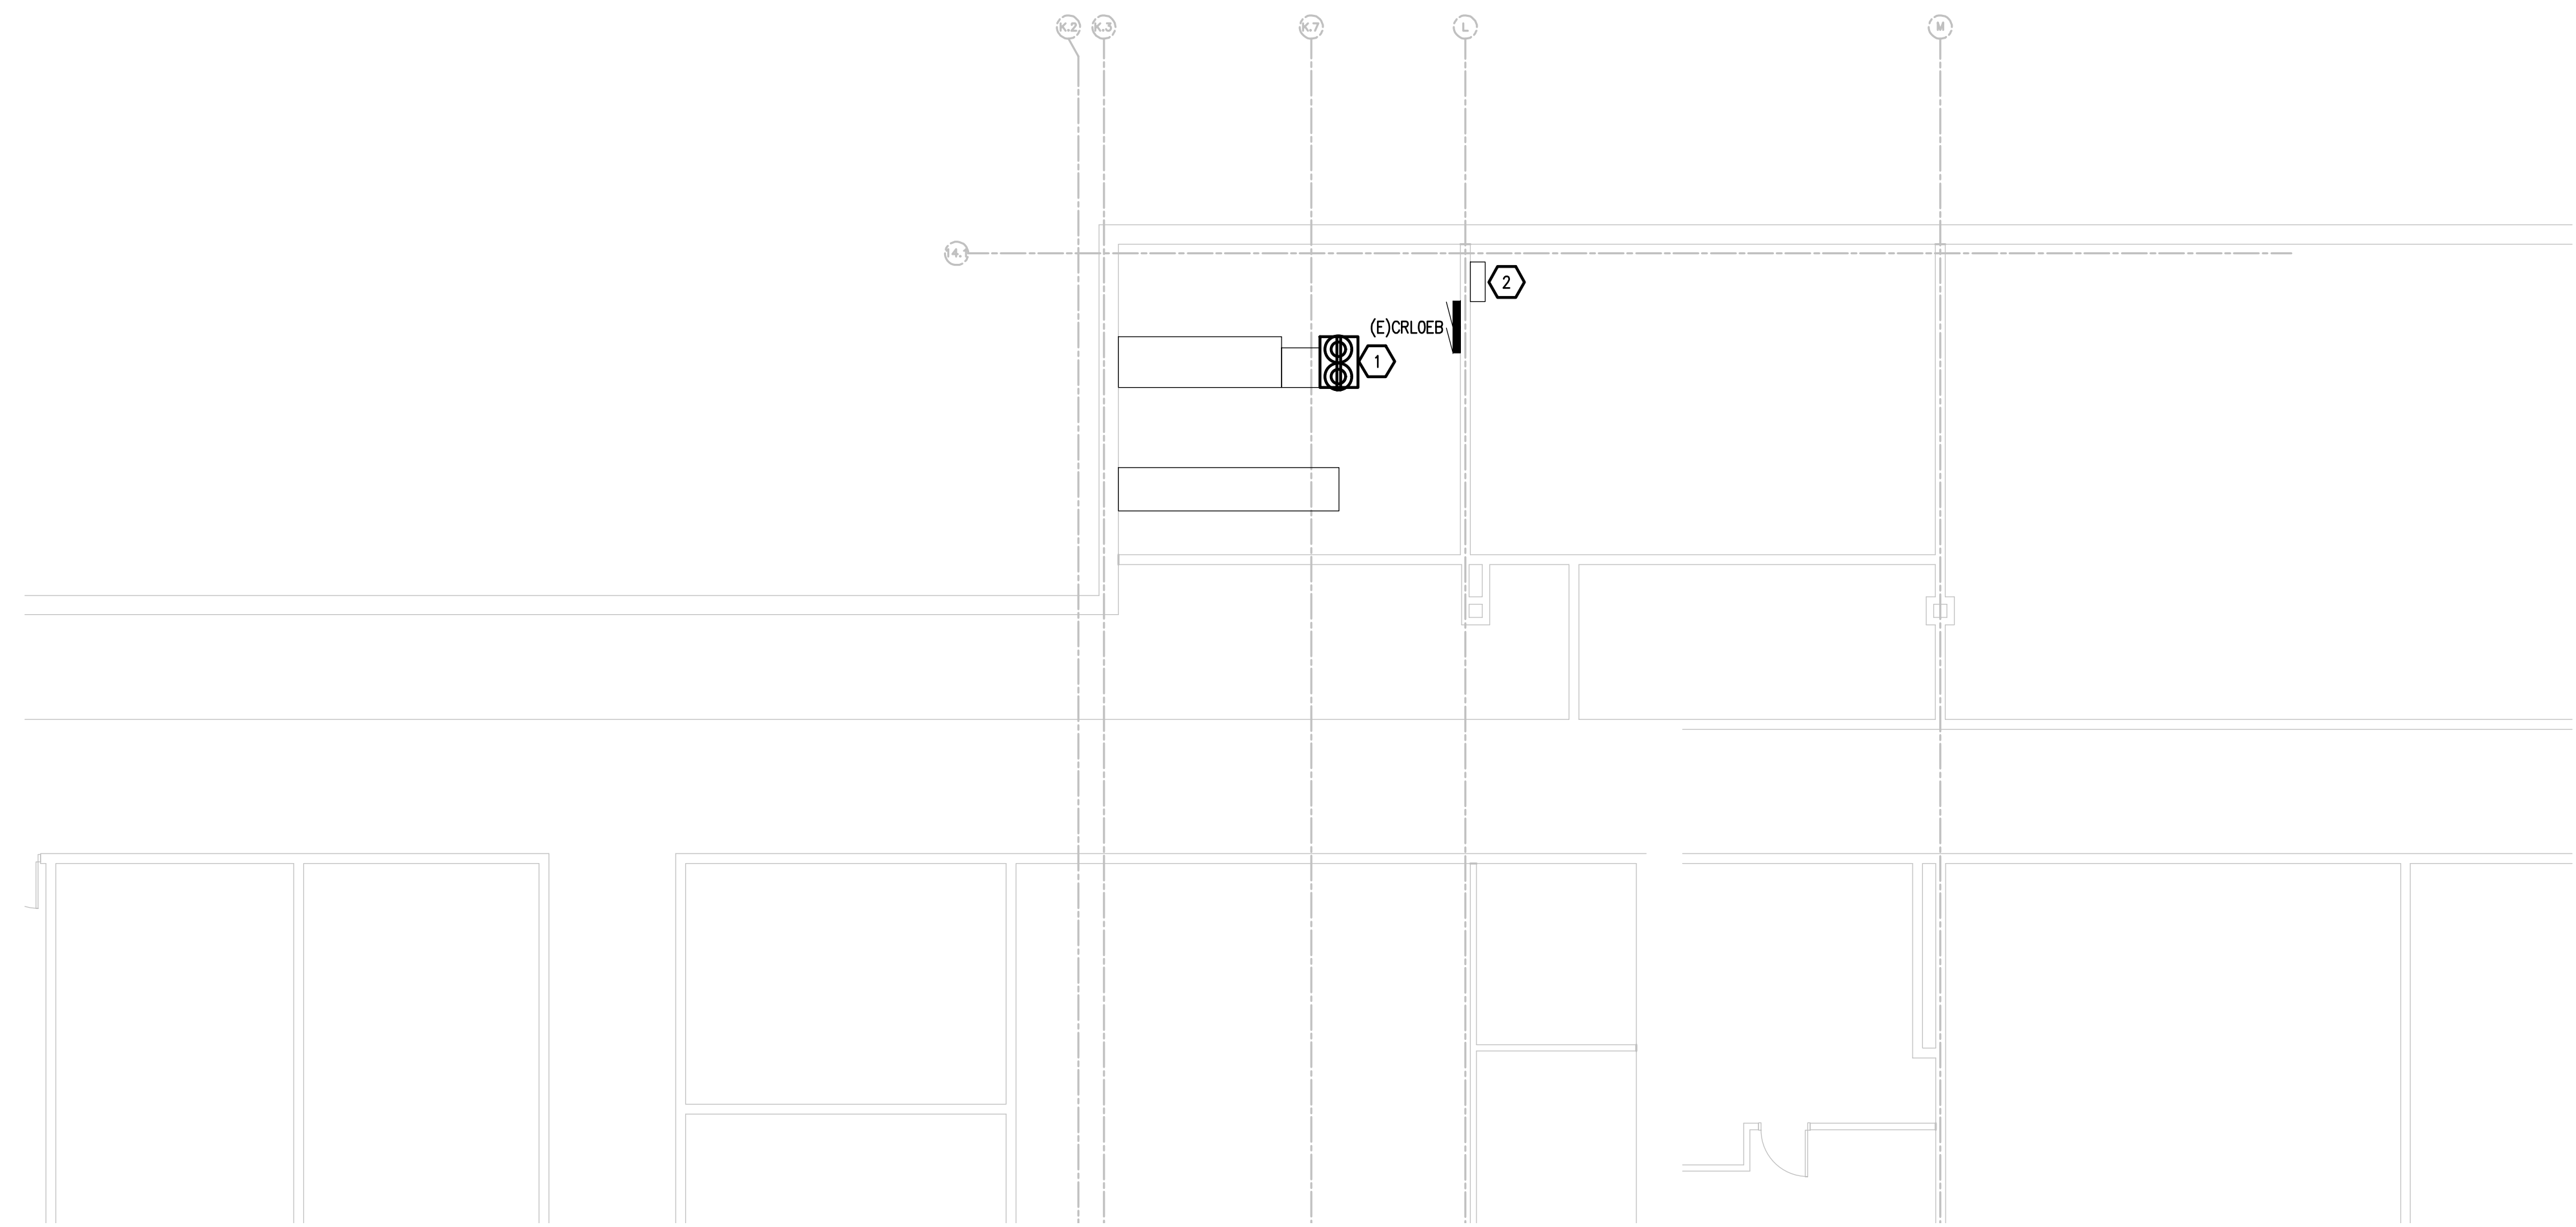

BASEMENT FLOOR POWER PLAN - UNIT H
SCALE: 1" = 20'

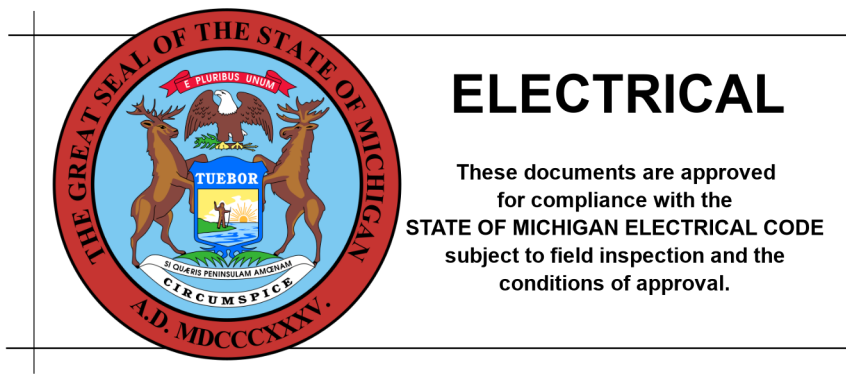


Peter Basso Associates Inc.
CONSULTING ENGINEERS
5145 Livernois, Suite 100
Troy, Michigan 48068-3276
Tel: 248-879-5666
Fax: 248-879-0007
www.PeterBassoAssociates.com
PEA Project No. 2021-0102

1	OWNER REVIEW	08/02/23
NO.	REVISION	DATE

STATE OF MICHIGAN
DEPARTMENT OF TECHNOLOGY, MANAGEMENT AND BUDGET
FACILITIES AND BUSINESS SERVICES ADMINISTRATION
DESIGN AND CONSTRUCTION DIVISION
ADAM LACH, R.A. DIRECTOR

FILE NO.
491/20167.SDW
FUNDING CODE
171CODHHS7255
CONTRACT NO.
Y22003

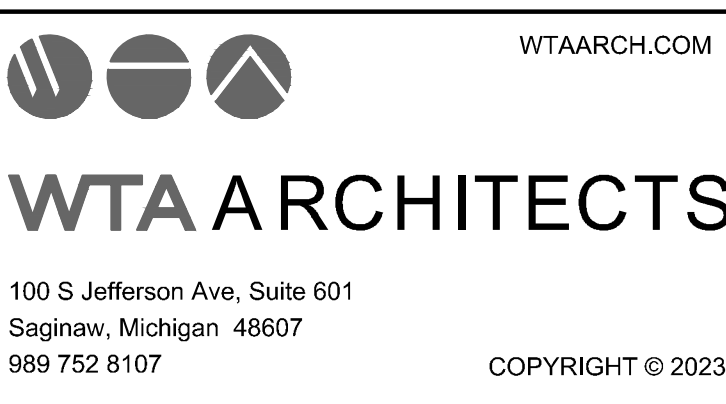


PROJECT TITLE
491/20167.SDW - PHASE 500:
**CENTER FOR FORENSIC
PSYCHIATRY - CREATE
KITCHEN**
SALINE, MICHIGAN
SHEET TITLE
**BASEMENT FLOOR POWER
PLAN - UNIT H**

PROJECT NUMBER 2021094	SHEET NUMBER E3.00
PROJECT DATE AUGUST 23, 2023	CHECKED BY TCL

g:\2021\2021-0402-00\CAD\2021-0402-E300.dwg, E3.00, 9/5/2023 4:32:31 PM, Gerard Henrich, Peter Basso Associates Inc.

THE FOLLOWING DIMENSION EQUALS ONE INCH WHEN PRINTED TO SCALE.

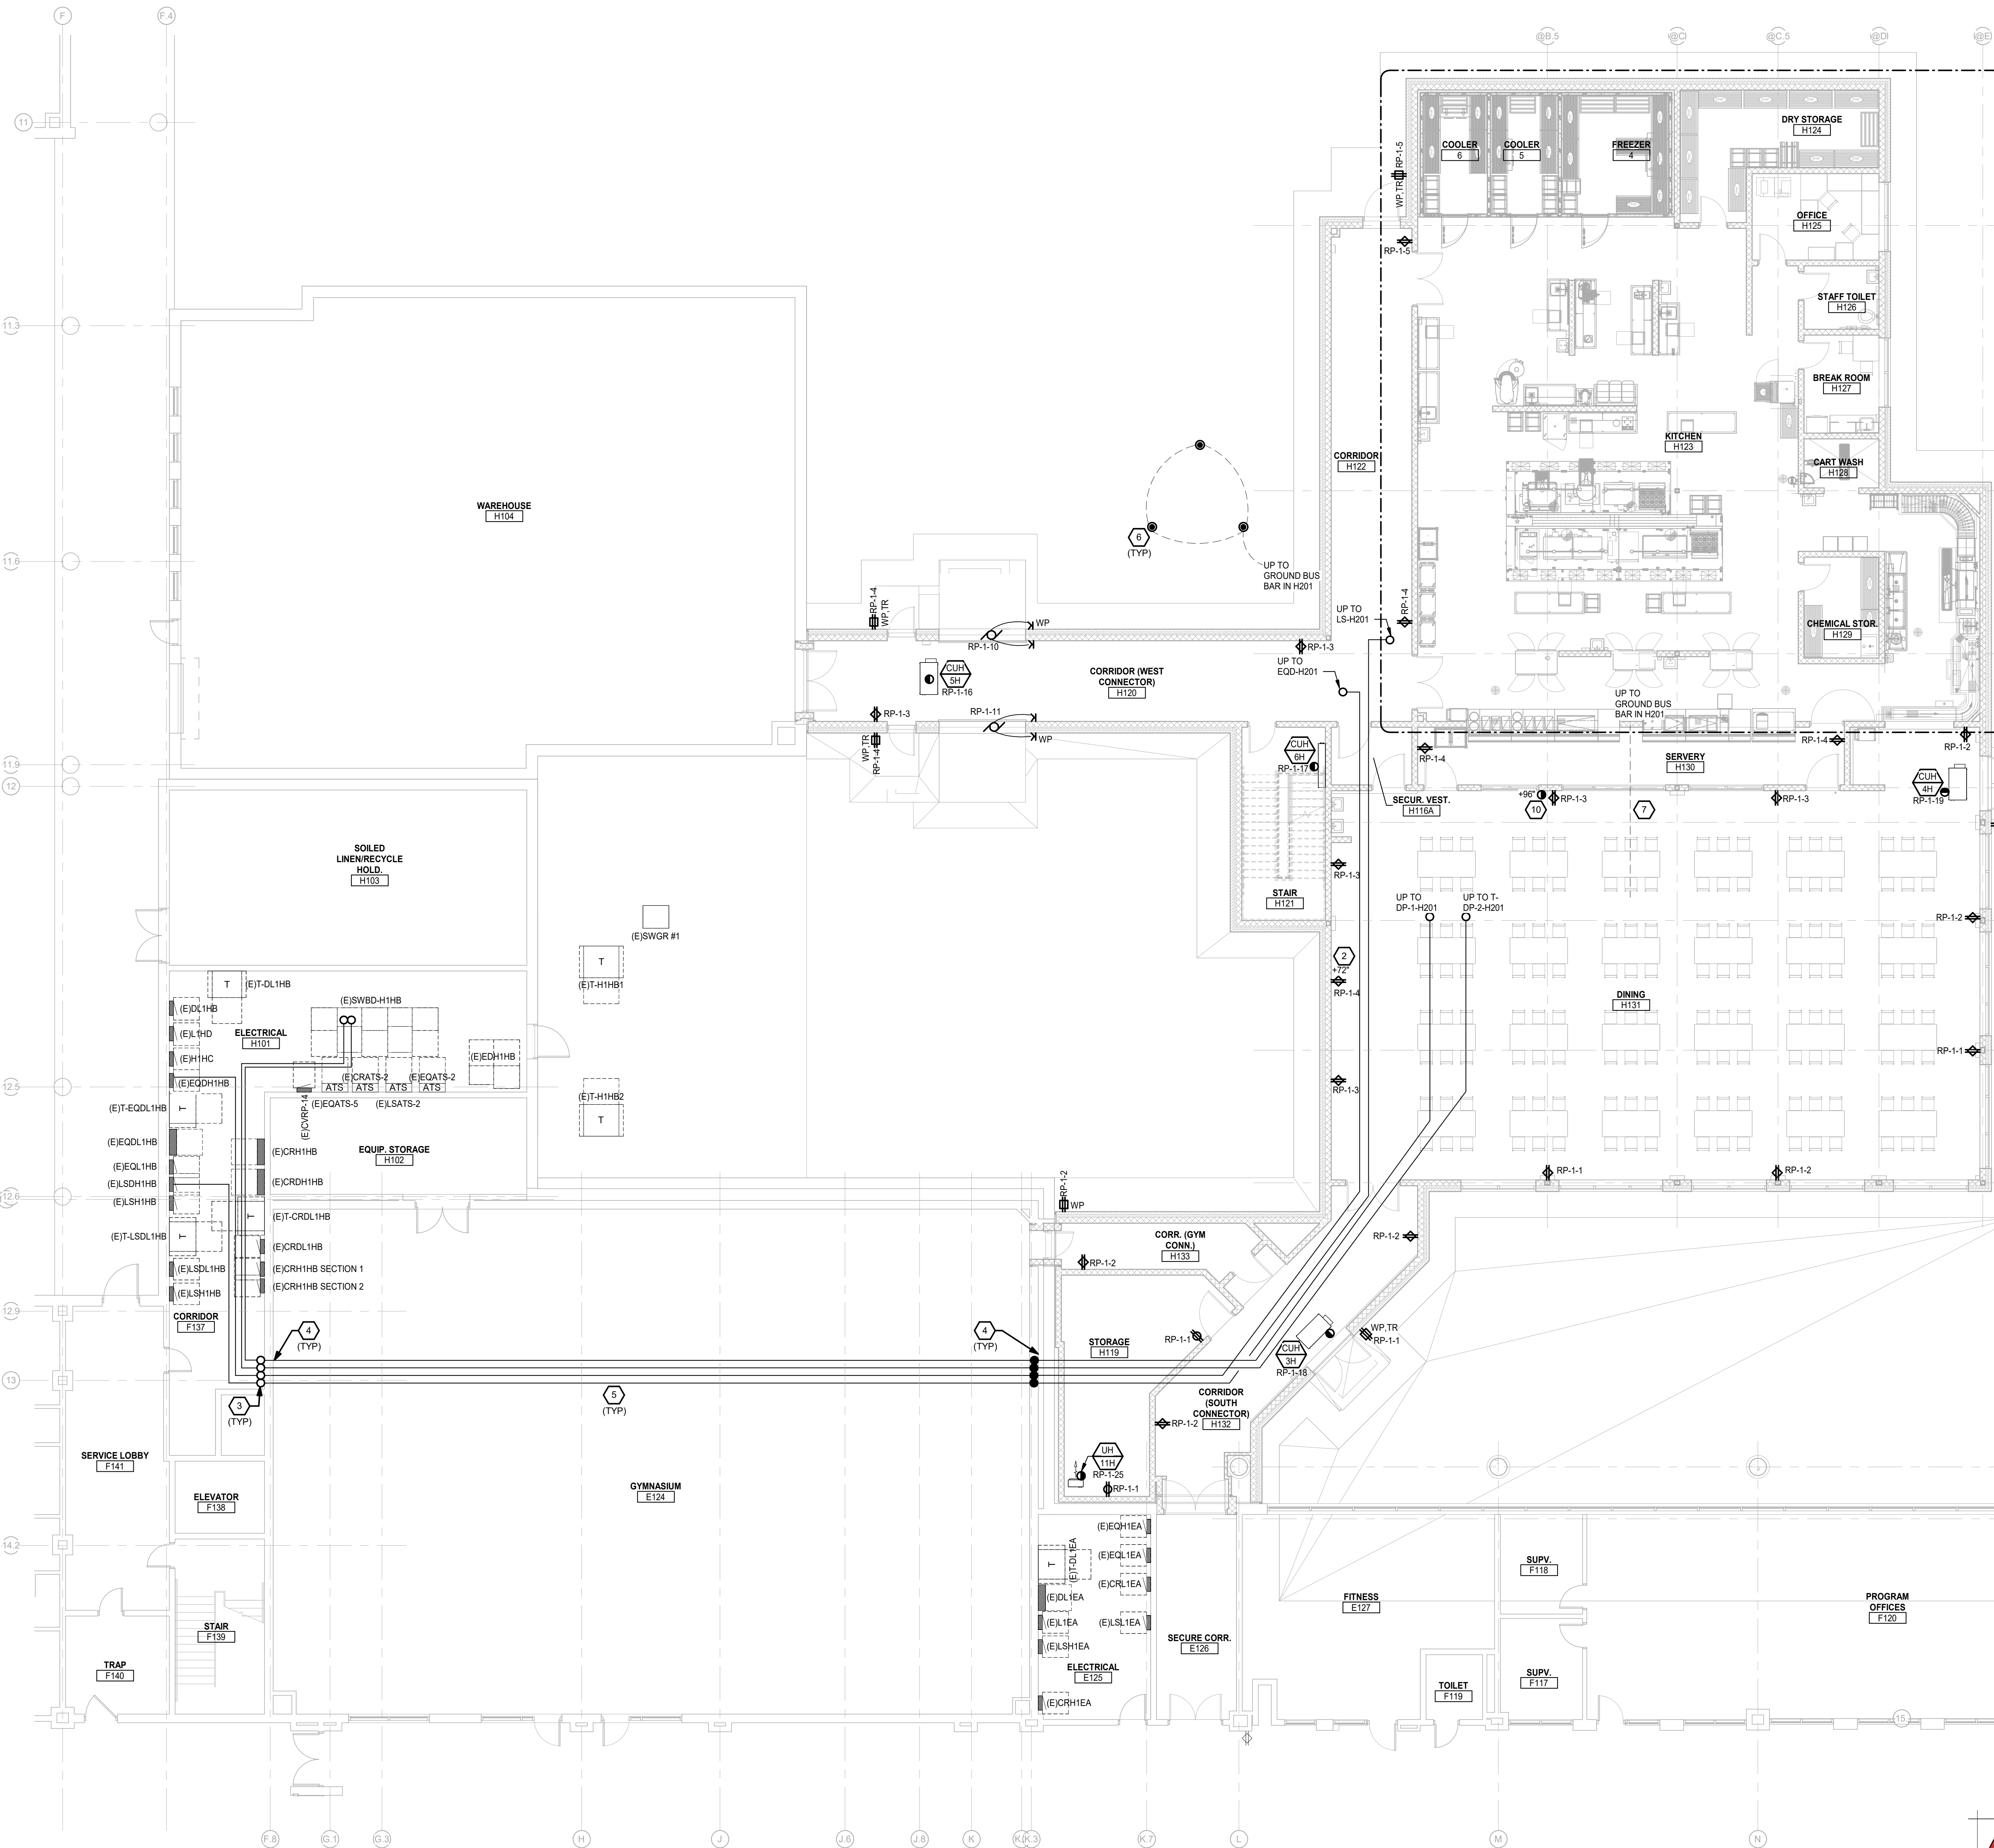

ELECTRICAL GENERAL NOTES:

- THESE DRAWINGS REPRESENT THE GENERAL EXTENT AND ARRANGEMENT OF SYSTEMS. COORDINATE EXACT EQUIPMENT LOCATIONS, ELEVATIONS, AND FINAL CONNECTION REQUIREMENTS. PROVIDE EACH SYSTEM COMPLETE, INCLUDING ALL NECESSARY COMPONENTS, FITTINGS AND OFFSETS.
- INSTALL SYSTEMS SUCH THAT REQUIRED CLEARANCE AND SERVICE ACCESS SPACE IS PROVIDED AROUND ALL MECHANICAL AND ELECTRICAL EQUIPMENT, AND AROUND ANY COMPONENTS WHICH REQUIRE SERVICE ACCESS.
- COORDINATE AND PROVIDE ACCESS DOORS WITH INACCESSIBLE CEILING, SHAFT, AND CHASE AREAS FOR ALL COMPONENTS WHICH REQUIRE SERVICE ACCESS. REFER TO ARCHITECTURAL DRAWINGS FOR CEILING TYPES.
- PROVIDE SUPPLEMENTARY STEEL AS REQUIRED FOR THE PROPER SUPPORT OF ALL SYSTEMS.
- TRANSFORMER SECONDARY CONDUCTORS SHALL BE SIZED IN ACCORDANCE WITH TRANSFORMER CIRCUIT SIZING SCHEDULE SHOWN ON "ELECTRICAL STANDARD SCHEDULES DRAWING" UNLESS OTHERWISE NOTED.
- MOTOR CIRCUIT PROTECTION SHALL BE SIZED IN ACCORDANCE WITH MOTOR CIRCUIT SIZING SCHEDULES SHOWN ON "ELECTRICAL STANDARD SCHEDULES DRAWING" UNLESS OTHERWISE NOTED.
- COORDINATE THE MOUNTING HEIGHTS OF DEVICES WITH ARCHITECTURAL ELEVATIONS AND THE TRADES INSTALLING THE WORK.
- REFER TO MECHANICAL SCHEDULE SHEETS FOR ELECTRICAL REQUIREMENTS FOR MECHANICAL EQUIPMENT. PROVIDE ALL CONNECTIONS, STARTERS, DISCONNECTS, ETC. AS REQUIRED BY SCHEDULES AND WHERE NOTED ELSEWHERE. VERIFY REQUIREMENTS OF ALL MECHANICAL EQUIPMENT WITH SHOP DRAWINGS SUBMITTALS. NOTIFY ENGINEER OF ANY CONFLICTS BETWEEN EQUIPMENT SUBMITTALS AND ELECTRICAL DRAWINGS. WHERE CIRCUIT SIZES ARE SHOWN ON THE ELECTRICAL DRAWINGS THAT DIFFER FROM WHAT IS INDICATED ON THE MECHANICAL SCHEDULES, PROVIDE THE CIRCUIT OF HIGHER AMPACITY.
- REFER TO TEMPERATURE CONTROLS SHEETS FOR REQUIRED FIRE ALARM CONTROL MODULES, DUCT SMOKE DETECTORS, AND MOTOR CONTROLLERS. PROVIDE ALL ACCESSORIES INDICATED.
- REFER TO LIGHTING CONTROL SCHEDULE FOR ROOM CONTROL AND EMERGENCY LIGHTING CIRCUIT CONTROL REQUIREMENTS. DESIGNATION FOR ROOM IS INDICATED AS A LETTERED OVAL SYMBOL.
- ALL FIRE ALARM DEVICES SHALL BE COMPATIBLE WITH EXISTING SIMPLEX GRINNEL 4120 FIRE ALARM SYSTEM. PROVIDE NECESSARY COMPONENTS, MODULES, ETC. AS REQUIRED FOR A FULLY FUNCTIONAL SYSTEM. RE-TEST AND CERTIFY EXISTING FIRE ALARM SYSTEM AT COMPLETION OF PROJECT.
- PROVIDE TAMPER RESISTANT COVER PLATE KENALL WPP SERIES OR EQUAL WHERE PATIENTS WILL HAVE ACCESS TO DEVICES.
- REFER TO SECURITY/TELECOMMUNICATION DRAWINGS FOR FINAL DEVICE LOCATIONS AND RACEWAY REQUIREMENTS. COORDINATE WITH SECURITY REQUIREMENTS WITH INSTALLING TRADES.
- COORDINATE ELECTRICAL REQUIREMENTS DEVICE LOCATIONS AND MOUNTING HEIGHTS WITH KITCHEN EQUIPMENT DRAWINGS, SHOP DRAWINGS AND KITCHEN EQUIPMENT INSTALLER.

CONSTRUCTION KEY NOTES:

- INSTALL SALVAGED EQUIPMENT ON NEW ROOF. EXTEND EXISTING BRANCH CIRCUITS AS REQUIRED.
- COORDINATE FINAL LOCATION OF TV WITH ARCHITECTURAL DRAWINGS AND TRADES PRIOR TO ROUGH IN.
- UP TO SECOND FLOOR ELECTRICAL ROOM E203 CORE EXISTING FLOOR.
- CORE EXISTING WALL.
- ROUTE IN CEILING SPACE OF GYM. ROUTE ALONG SIDE NEW MECHANICAL PIPING. COORDINATE FINAL ROUTING WITH MECHANICAL TRADES.
- COORDINATE GROUND ROD PLACEMENT WITH EXISTING UTILITIES PRIOR TO DRIVING THEM IN.
- 20'-0" #40 BARE COPPER CONDUCTOR FOR CONCRETE-ENCASED ELECTRODE IN FOUNDATION ENCASED BY AT LEAST 2" OF CONCRETE.
- PROVIDE LIGHTNING PROTECTION FOR WHOLE BUILDING ADDITION. LIGHTNING PROTECTION SYSTEM SHALL BE UL LISTED MASTER LABEL. REFER TO SPECIFICATIONS FOR SYSTEM REQUIREMENTS.
- TIE INTO THE EXISTING LIGHTNING PROTECTION ON EXISTING BUILDING AS REQUIRED.
- LINE VOLTAGE CLOCK STANDARD ELECTRIC TIME FARADAY 2384 OR OTHER CLOCK COMPATIBLE WITH EXISTING SYSTEM. EXTEND WIRING FROM EXISTING CLOCK HEAD END SYSTEM AS REQUIRED.


NO.	REVISION	DATE

STATE OF MICHIGAN
DEPARTMENT OF TECHNOLOGY, MANAGEMENT AND BUDGET
FACILITIES AND BUSINESS SERVICES ADMINISTRATION
DESIGN AND CONSTRUCTION DIVISION
ADAM LACH, RA, DIRECTOR

FILE NO.
49120167.SDW

FUNDING CODE
171CODHHS7255

CONTRACT NO.
Y22003

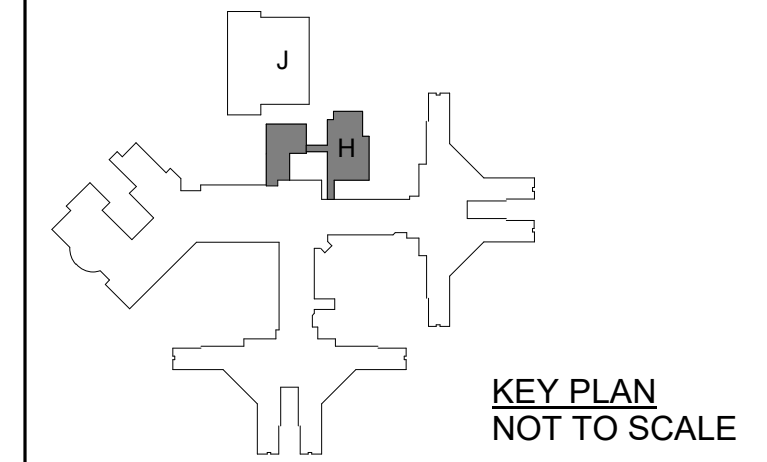

WTA ARCHITECTS

100 S. Jefferson Ave., Suite 601
Saginaw, Michigan 48607
989 752 8107

COPYRIGHT © 2023


PROJECT TITLE
49120167.SDW - PHASE 500:
CENTER FOR FORENSIC
PSYCHIATRY - CREATE
KITCHEN

SALINE, MICHIGAN

SHEET TITLE
FIRST FLOOR POWER PLAN
- UNIT H

PROJECT NUMBER 2021094	SHEET NUMBER
PROJECT DATE SEPTEMBER 6, 2023	E3.01
CHECKED BY TLC	



FIRST FLOOR POWER PLAN - UNIT H
SCALE: 1/8" = 1'-0"

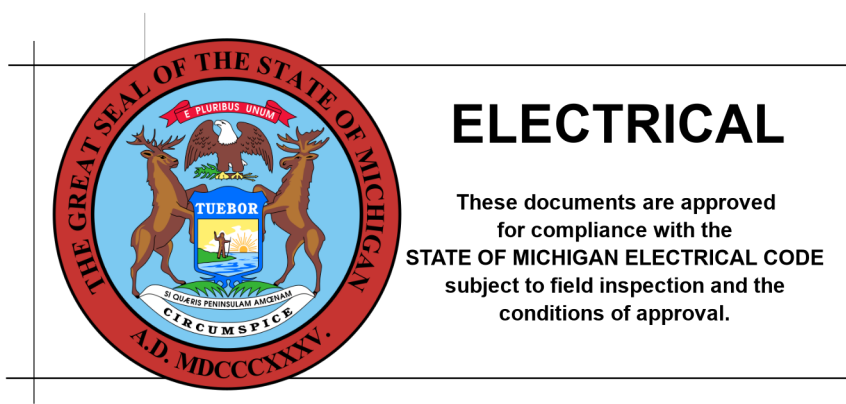

Peter Basso Associates Inc
CONSULTING ENGINEERS
5445 Livernois, Suite 100
Troy, Michigan 48068-3276
Tel: 248-879-5666
Fax: 248-879-0007
www.PeterBassoAssociates.com
PBA Project No. 2023-0002

9/25/2023 4:37:06 PM C:\REVIT LOCAL FILES\2023-0402-ME2_Forensic_Psyeh_v23_Ghienhich.rvt

THE FOLLOWING DIMENSION EQUALS ONE INCH WHEN PRINTED TO SCALE.

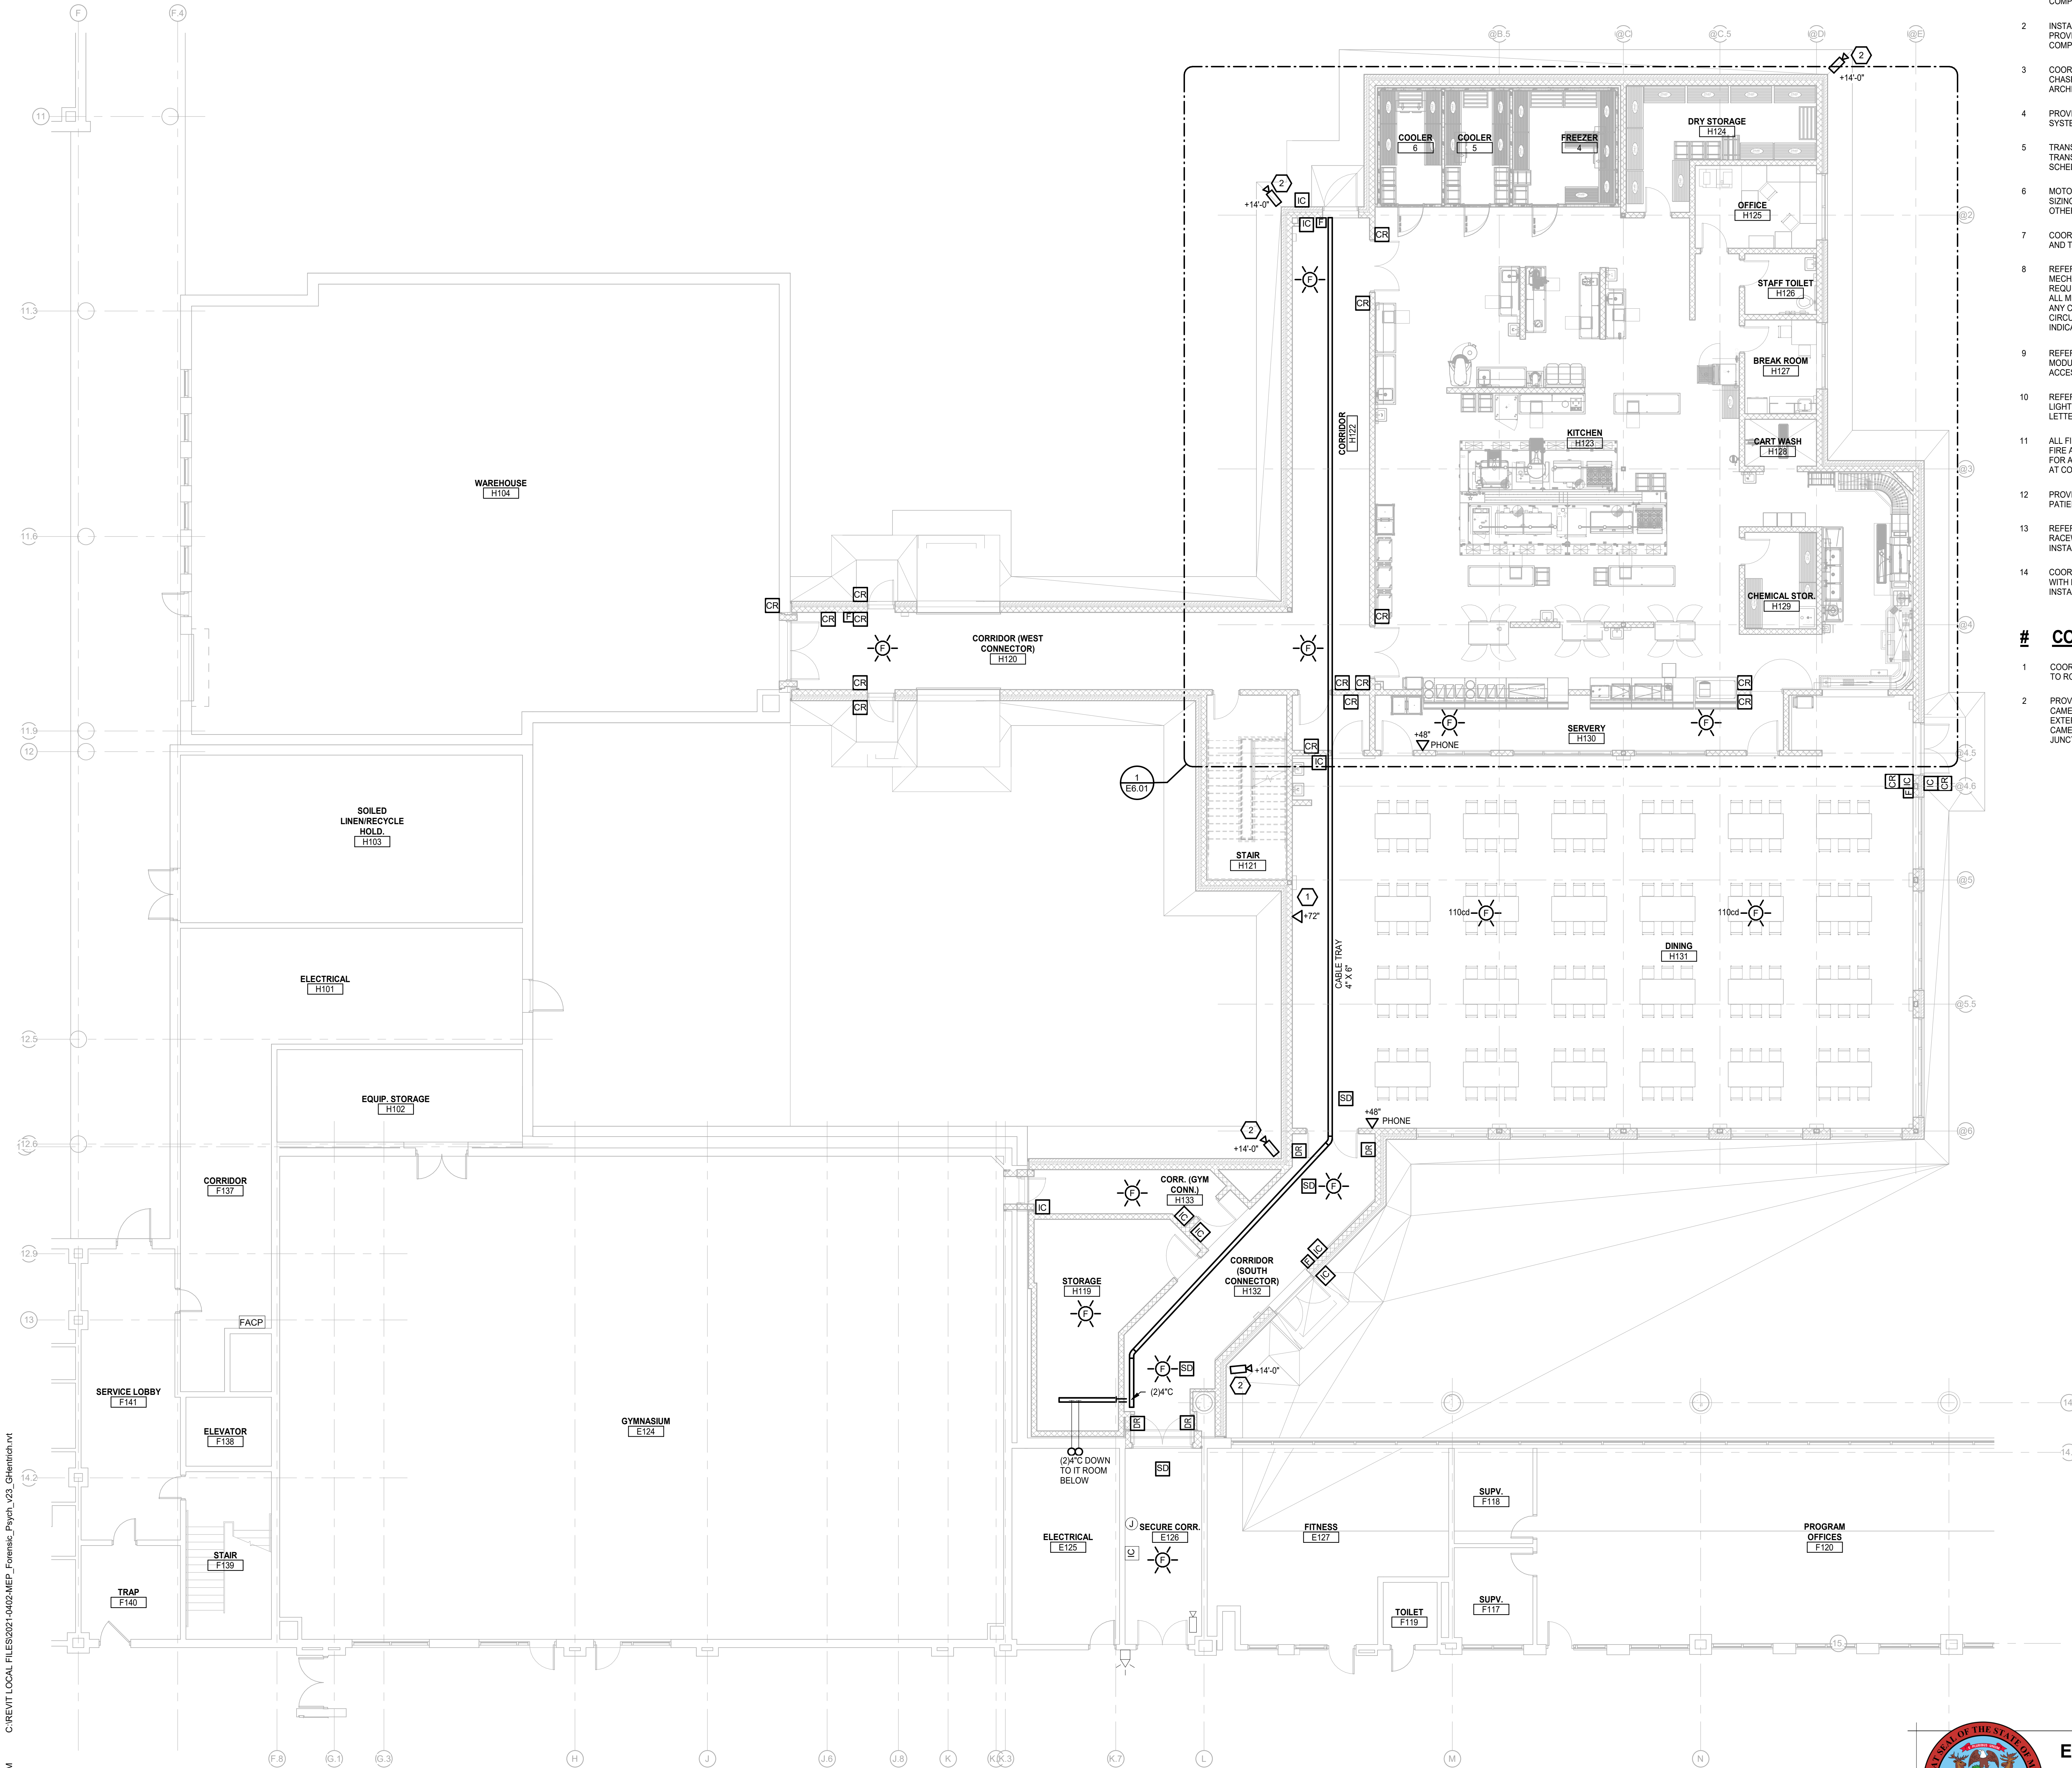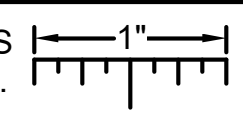

ELECTRICAL GENERAL NOTES:

- THESE DRAWINGS REPRESENT THE GENERAL EXTENT AND ARRANGEMENT OF SYSTEMS. COORDINATE EXACT EQUIPMENT LOCATIONS, ELEVATIONS, AND FINAL CONNECTION REQUIREMENTS. PROVIDE EACH SYSTEM COMPLETE, INCLUDING ALL NECESSARY COMPONENTS, FITTINGS AND OFFSETS.
- INSTALL SYSTEMS SUCH THAT REQUIRED CLEARANCE AND SERVICE ACCESS SPACE IS PROVIDED AROUND ALL MECHANICAL AND ELECTRICAL EQUIPMENT, AND AROUND ANY COMPONENTS WHICH REQUIRE SERVICE ACCESS.
- COORDINATE AND PROVIDE ACCESS DOORS WITHIN INACCESSIBLE CEILING, SHAFT, AND CHASE AREAS FOR ALL COMPONENTS WHICH REQUIRE SERVICE ACCESS. REFER TO ARCHITECTURAL DRAWINGS FOR CEILING TYPES.
- PROVIDE SUPPLEMENTARY STEEL AS REQUIRED FOR THE PROPER SUPPORT OF ALL SYSTEMS.
- TRANSFORMER SECONDARY CONDUCTORS SHALL BE SIZED IN ACCORDANCE WITH TRANSFORMER CIRCUIT SIZING SCHEDULE SHOWN ON "ELECTRICAL STANDARD SCHEDULES DRAWING" UNLESS OTHERWISE NOTED.
- MOTOR CIRCUIT PROTECTION SHALL BE SIZED IN ACCORDANCE WITH MOTOR CIRCUIT SIZING SCHEDULES SHOWN ON "ELECTRICAL STANDARD SCHEDULES DRAWING" UNLESS OTHERWISE NOTED.
- COORDINATE THE MOUNTING HEIGHTS OF DEVICES WITH ARCHITECTURAL ELEVATIONS AND THE TRADES INSTALLING THE WORK.
- REFER TO MECHANICAL SCHEDULE SHEETS FOR ELECTRICAL REQUIREMENTS FOR MECHANICAL EQUIPMENT. PROVIDE ALL CONNECTIONS, STARTERS, DISCONNECTS, ETC. AS REQUIRED BY SCHEDULES AND WHERE NOTED ELSEWHERE. VERIFY REQUIREMENTS OF ALL MECHANICAL EQUIPMENT WITH SHOP DRAWINGS SUBMITTALS. NOTIFY ENGINEER OF ANY CONFLICTS BETWEEN EQUIPMENT SUBMITTALS AND ELECTRICAL DRAWINGS. WHERE CIRCUIT SIZES ARE SHOWN ON THE ELECTRICAL DRAWINGS THAT DIFFER FROM WHAT IS INDICATED ON THE MECHANICAL SCHEDULES, PROVIDE THE CIRCUIT OF HIGHER AMPACITY.
- REFER TO TEMPERATURE CONTROLS SHEETS FOR REQUIRED FIRE ALARM CONTROL MODULES, DUCT SMOKE DETECTORS, AND MOTOR CONTROLLERS. PROVIDE ALL ACCESSORIES INDICATED.
- REFER TO LIGHTING CONTROL SCHEDULE FOR ROOM CONTROL AND EMERGENCY LIGHTING CIRCUIT CONTROL REQUIREMENTS. DESIGNATION FOR ROOM IS INDICATED AS A LETTERED OVAL SYMBOL.
- ALL FIRE ALARM DEVICES SHALL BE COMPATIBLE WITH EXISTING SIMPLEX GRINNEL 4120 FIRE ALARM SYSTEM. PROVIDE NECESSARY COMPONENTS, MODULES, ETC. AS REQUIRED FOR A FULLY FUNCTIONAL SYSTEM. RE-TEST AND CERTIFY EXISTING FIRE ALARM SYSTEM AT COMPLETION OF PROJECT.
- PROVIDE TAMPER RESISTANT COVER PLATE KENALL WPP SERIES OR EQUAL WHERE PATIENTS WILL HAVE ACCESS TO DEVICES.
- REFER TO SECURITY/TELECOMMUNICATION DRAWINGS FOR FINAL DEVICE LOCATIONS AND RACEWAY REQUIREMENTS. COORDINATE WITH SECURITY REQUIREMENTS WITH INSTALLING TRADES.
- COORDINATE ELECTRICAL REQUIREMENTS DEVICE LOCATIONS AND MOUNTING HEIGHTS WITH KITCHEN EQUIPMENT DRAWINGS, SHOP DRAWINGS AND KITCHEN EQUIPMENT INSTALLER.

CONSTRUCTION KEY NOTES:

- COORDINATE FINAL LOCATION OF TV WITH ARCHITECTURAL DRAWINGS AND TRADES PRIOR TO ROUGH IN.
- PROVIDE SINGLE GANG JUNCTION BOX AT 14'-0" ADJACENT TO EXTERIOR MOUNTED CAMERA. PROVIDE SEAL TIGHT CONDUIT AND ASSOCIATED FITTINGS/SEALS FROM EXTERIOR BOX TO CAMERA HOUSING. COORDINATE FINAL MOUNTING LOCATION WITH CAMERA INSTALLER AND DRAWINGS. PROVIDE 1/4" CONDUIT FROM SINGLE GANG JUNCTION BOX TO CAMERA TRAY.


NO.	REVISION	DATE

STATE OF MICHIGAN
DEPARTMENT OF TECHNOLOGY, MANAGEMENT AND BUDGET
FACILITIES AND BUSINESS SERVICES ADMINISTRATION
DESIGN AND CONSTRUCTION DIVISION
ADAM LACH, RA, DIRECTOR

FILE NO.
491/20167.SDW

FUNDING CODE
171CODHHS7255

CONTRACT NO.
Y22003

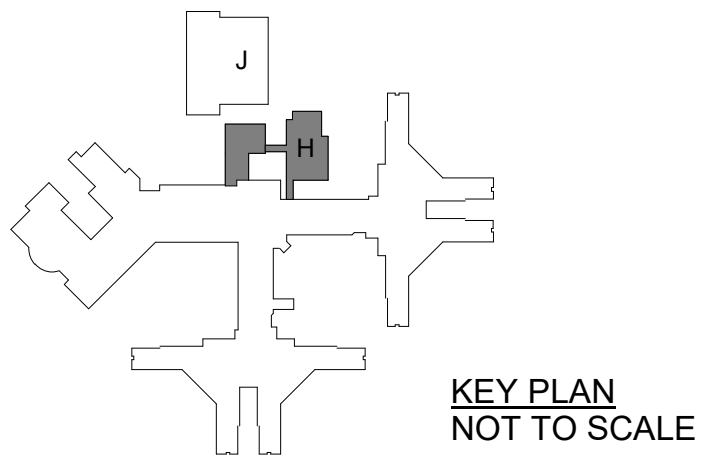

WTA ARCHITECTS

100 S. Jefferson Ave, Suite 601
Saginaw, Michigan 48607
989 752 8107

COPYRIGHT © 2023

PROJECT TITLE
491/20167.SDW - PHASE 500:
CENTER FOR FORENSIC PSYCHIATRY - CREATE KITCHEN
SALINE, MICHIGAN

SHEET TITLE
FIRST FLOOR AUXILIARY SYSTEMS PLAN - UNIT H


PROJECT NUMBER
2021094

SHEET NUMBER
E4.01

PROJECT DATE
SEPTEMBER 6, 2023

CHECKED BY
TLC

FIRST FLOOR AUXILIARY SYSTEMS PLAN - UNIT H
SCALE: 1/8" = 1'-0"

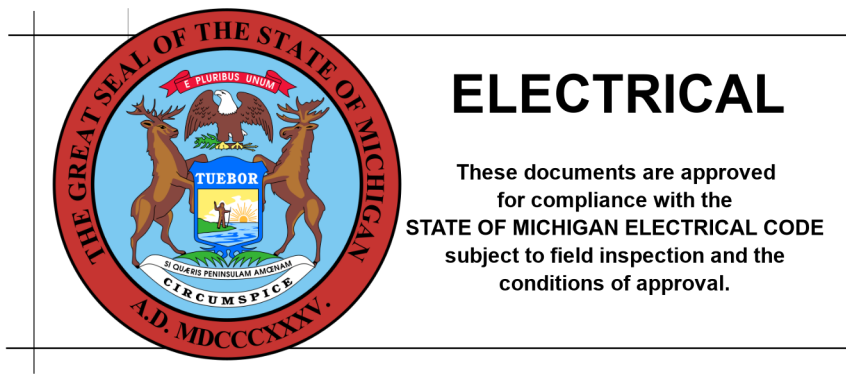



PBA
Peter Basso Associates Inc
CONSULTING ENGINEERS
5145 Livernois, Suite 100
Troy, Michigan 48068-3276
Tel: 248-879-5666
Fax: 248-879-0007
www.PeterBassoAssociates.com
PBA Project No. 303-0492

ELECTRICAL

These documents are approved for compliance with the STATE OF MICHIGAN ELECTRICAL CODE subject to field inspection and the conditions of approval.

9/25/2023 4:37:10 PM C:\REVIT LOCAL FILES\2023-0402-MELZ_Forensic_Psyeh_v23_Ghent.dwg

THE FOLLOWING DIMENSION EQUALS ONE INCH WHEN PRINTED TO SCALE.

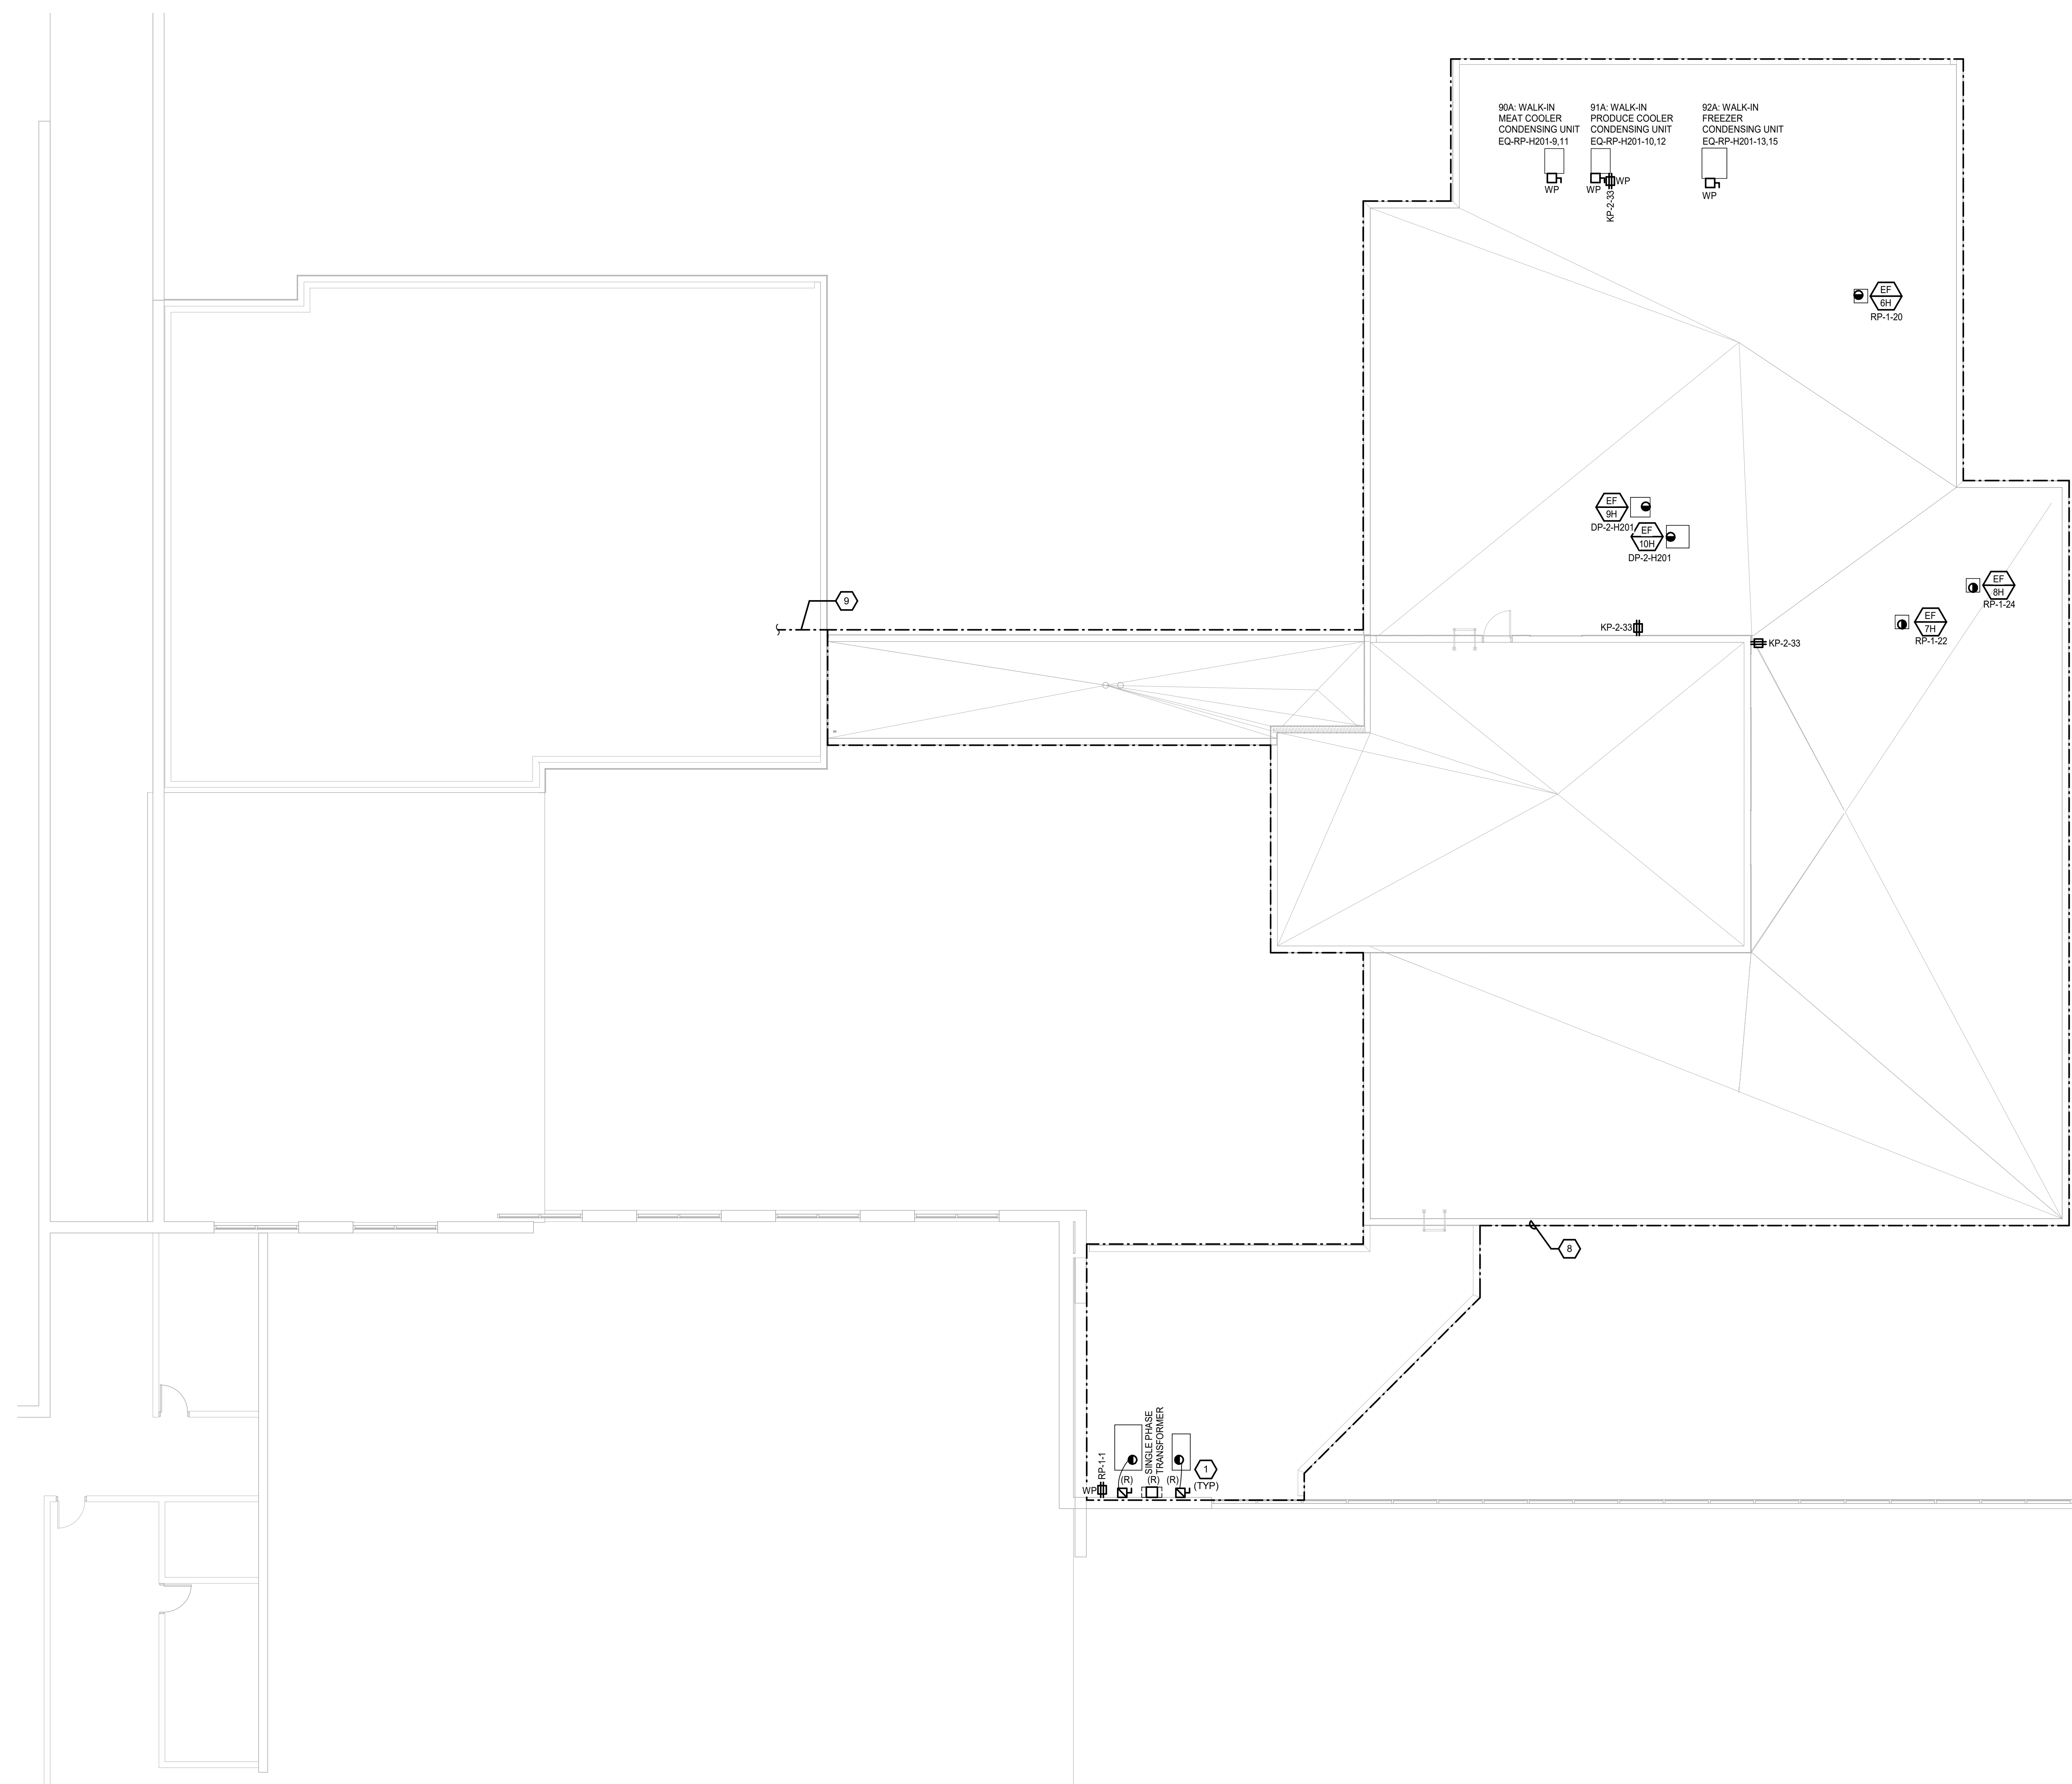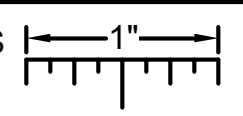

ELECTRICAL GENERAL NOTES:

- 1 THESE DRAWINGS REPRESENT THE GENERAL EXTENT AND ARRANGEMENT OF SYSTEMS. COORDINATE EXACT EQUIPMENT LOCATIONS, ELEVATIONS, AND FINAL CONNECTION REQUIREMENTS. PROVIDE EACH SYSTEM COMPLETE, INCLUDING ALL NECESSARY COMPONENTS, FITTINGS AND OFFSETS.
- 2 INSTALL SYSTEMS SUCH THAT REQUIRED CLEARANCE AND SERVICE ACCESS SPACE IS PROVIDED AROUND ALL MECHANICAL AND ELECTRICAL EQUIPMENT, AND AROUND ANY COMPONENTS WHICH REQUIRE SERVICE ACCESS.
- 3 COORDINATE AND PROVIDE ACCESS DOORS WITHIN INACCESSIBLE CEILING, SHAFT, AND CHASE AREAS FOR ALL COMPONENTS WHICH REQUIRE SERVICE ACCESS. REFER TO ARCHITECTURAL DRAWINGS FOR CEILING TYPES.
- 4 PROVIDE SUPPLEMENTARY STEEL AS REQUIRED FOR THE PROPER SUPPORT OF ALL SYSTEMS.
- 5 TRANSFORMER SECONDARY CONDUCTORS SHALL BE SIZED IN ACCORDANCE WITH TRANSFORMER CIRCUIT SIZING SCHEDULE SHOWN ON "ELECTRICAL STANDARD SCHEDULES DRAWING" UNLESS OTHERWISE NOTED.
- 6 MOTOR CIRCUIT PROTECTION SHALL BE SIZED IN ACCORDANCE WITH MOTOR CIRCUIT SIZING SCHEDULES SHOWN ON "ELECTRICAL STANDARD SCHEDULES DRAWING" UNLESS OTHERWISE NOTED.
- 7 COORDINATE THE MOUNTING HEIGHTS OF DEVICES WITH ARCHITECTURAL ELEVATIONS AND THE TRADES INSTALLING THE WORK.
- 8 REFER TO MECHANICAL SCHEDULE SHEETS FOR ELECTRICAL REQUIREMENTS FOR MECHANICAL EQUIPMENT. PROVIDE ALL CONNECTIONS, STARTERS, DISCONNECTS, ETC. AS REQUIRED BY SCHEDULES AND WHERE NOTED ELSEWHERE. VERIFY REQUIREMENTS OF ALL MECHANICAL EQUIPMENT WITH SHOP DRAWINGS SUBMITTALS. NOTIFY ENGINEER OF ANY CONFLICTS BETWEEN EQUIPMENT SUBMITTALS AND ELECTRICAL DRAWINGS. WHERE CIRCUIT SIZES ARE SHOWN ON THE ELECTRICAL DRAWINGS THAT DIFFER FROM WHAT IS INDICATED ON THE MECHANICAL SCHEDULES, PROVIDE THE CIRCUIT OF HIGHER AMPACITY.
- 9 REFER TO TEMPERATURE CONTROLS SHEETS FOR REQUIRED FIRE ALARM CONTROL MODULES, DUCT SMOKE DETECTORS, AND MOTOR CONTROLLERS. PROVIDE ALL ACCESSORIES INDICATED.
- 10 REFER TO LIGHTING CONTROL SCHEDULE FOR ROOM CONTROL AND EMERGENCY LIGHTING CIRCUIT CONTROL REQUIREMENTS. DESIGNATION FOR ROOM IS INDICATED AS A LETTERED OVAL SYMBOL.
- 11 ALL FIRE ALARM DEVICES SHALL BE COMPATIBLE WITH EXISTING SIMPLEX GRINNEL 4120 FIRE ALARM SYSTEM. PROVIDE NECESSARY COMPONENTS, MODULES, ETC. AS REQUIRED FOR A FULLY FUNCTIONAL SYSTEM. RE-TEST AND CERTIFY EXISTING FIRE ALARM SYSTEM AT COMPLETION OF PROJECT.
- 12 PROVIDE TAMPER RESISTANT COVER PLATE KENALL WPP SERIES OR EQUAL WHERE PATIENTS WILL HAVE ACCESS TO DEVICES.
- 13 REFER TO SECURITY/TELECOMMUNICATION DRAWINGS FOR FINAL DEVICE LOCATIONS AND RACEWAY REQUIREMENTS. COORDINATE WITH SECURITY REQUIREMENTS WITH INSTALLING TRADES.
- 14 COORDINATE ELECTRICAL REQUIREMENTS DEVICE LOCATIONS AND MOUNTING HEIGHTS WITH KITCHEN EQUIPMENT DRAWINGS, SHOP DRAWINGS AND KITCHEN EQUIPMENT INSTALLER.

CONSTRUCTION KEY NOTES:

- 1 INSTALL SALVAGED EQUIPMENT ON NEW ROOF. EXTEND EXISTING BRANCH CIRCUITS AS REQUIRED.
- 2 COORDINATE FINAL LOCATION OF TV WITH ARCHITECTURAL DRAWINGS AND TRADES PRIOR TO ROUGH IN.
- 3 UP TO SECOND FLOOR ELECTRICAL ROOM E203. CORE EXISTING FLOOR.
- 4 CORE EXISTING WALL.
- 5 ROUTE IN CEILING SPACE OF GYM. ROUTE ALONG SIDE NEW MECHANICAL PIPING. COORDINATE FINAL ROUTING WITH MECHANICAL TRADES.
- 6 COORDINATE GROUND ROD PLACEMENT WITH EXISTING UTILITIES PRIOR TO DRIVING THEM IN.
- 7 20'-0" #40 BARE COPPER CONDUCTOR FOR CONCRETE-ENCASED ELECTRODE IN FOUNDATION. ENCASED BY AT LEAST 2" OF CONCRETE.
- 8 PROVIDE LIGHTNING PROTECTION FOR WHOLE BUILDING ADDITION. LIGHTNING PROTECTION SYSTEM SHALL BE UL LISTED MASTER LABEL. REFER TO SPECIFICATIONS FOR SYSTEM REQUIREMENTS.
- 9 TIE INTO THE EXISTING LIGHTNING PROTECTION ON EXISTING BUILDING AS REQUIRED.
- 10 LINE VOLTAGE CLOCK STANDARD ELECTRIC TIME FARADAY 2364 OR OTHER CLOCK COMPATIBLE WITH EXISTING SYSTEM. EXTEND WIRING FROM EXISTING CLOCK HEAD END SYSTEM AS REQUIRED.


NO.	REVISION	DATE

STATE OF MICHIGAN
 DEPARTMENT OF TECHNOLOGY, MANAGEMENT AND BUDGET
 FACILITIES AND BUSINESS SERVICES ADMINISTRATION
 DESIGN AND CONSTRUCTION DIVISION
 ADAM LACH, RA, DIRECTOR

FILE NO.
 491/20167.SDW

FUNDING CODE
 171CODHHS7255

CONTRACT NO.
 Y22003

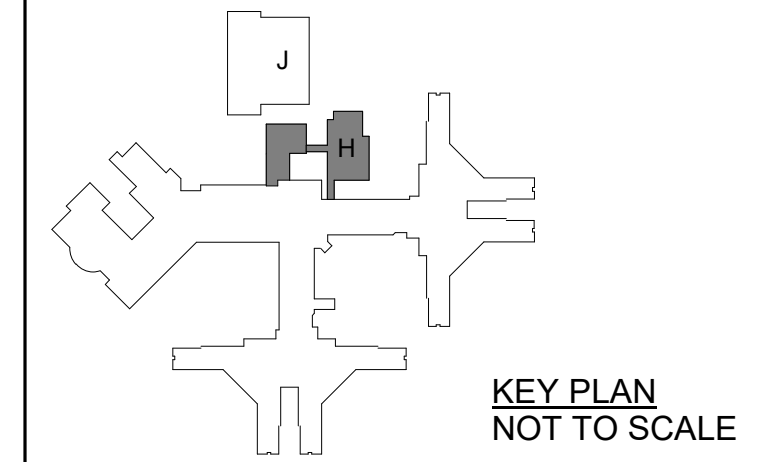

WTA ARCHITECTS
 100 S. Jefferson Ave., Suite 601
 Saginaw, Michigan 48607
 989 752 8107
 COPYRIGHT © 2023

PROJECT TITLE
 491/20167.SDW - PHASE 500:
**CENTER FOR FORENSIC
 PSYCHIATRY - CREATE
 KITCHEN**
 SALINE, MICHIGAN

SHEET TITLE
ELECTRICAL ROOF PLAN

PROJECT NUMBER 2021094	SHEET NUMBER
PROJECT DATE SEPTEMBER 6, 2023	E4.04
CHECKED BY TLC	

ELECTRICAL ROOF PLAN
 SCALE: 1/8" = 1'-0"

ELECTRICAL
 These documents are approved for compliance with the STATE OF MICHIGAN ELECTRICAL CODE subject to field inspection and the conditions of approval.

PBA
 Peter Basso Associates Inc
 CONSULTING ENGINEERS
 5145 Livernois, Suite 100
 Troy, Michigan 48068-3276
 Tel: 248-879-5666
 Fax: 248-879-0007
 www.PeterBassoAssociates.com
 PBA Project No. 303-0492

9/25/2023 4:37:11 PM C:\REVIT LOCAL FILES\2023-09-25\MEP_Forensic_Psyeh_v23_Ghent.rvt

PANELBOARD KP-1																																																																																											
#	LOAD TYPE	DESCRIPTION	CB TYPE	CB	A	B	C	CB	CB TYPE	DESCRIPTION	LOAD TYPE	#																																																																															
1	K	86: FOOD PROCESSOR		20	1200	960		20		85: FOOD PROCESSOR	K	2																																																																															
3	K	84: SLICER		20		672	180	20		69: MIXER, COUNTER	K	4																																																																															
5				20			1439	1199				6																																																																															
7	K	66: MIXER, FLOOR		20	1439	1199		20	GFCI	65: CHILLER/FREEZER, BLAST	K	8																																																																															
9				20		1439	1199	2233				10																																																																															
11				20				2233		41: UDS SYSTEM	K	12																																																																															
13	K	61: INDUCTION CHARGER	GFCI	20	2233	4798		50			K	14																																																																															
15				20		2233	4798					16																																																																															
17	K	40: FIRE SUPPRESSION...		20			1500	1500	20	40: FIRE SUPPRESSION...	K	18																																																																															
19	K	39: HOOD		20	1500	1500		20		39: HOOD	K	20																																																																															
21				20		396	1428			20: ICE MAKER/BIN	K	22																																																																															
23	K	26: DISPOSER, GARBAGE		15			396	720	15	12: DISPOSER, GARBAGE	K	24																																																																															
25				20		396	720					26																																																																															
27	K	6: COFFEE MAKER		20		1440	720					28																																																																															
29	K	5: CABINET, HEATED PASS-THRU	GFCI	20	1612	1272		20	GFCI	4: DISPLAY, CASE REFRIGERATED	K	30																																																																															
31				20				20	GFCI	4: DISPLAY, CASE REFRIGERATED	K	32																																																																															
33	K	65A: CHILLER/FREEZER, BLAST, EVAP	GFCI	20		240	1800	1799	420	41: UDS SYSTEM FUEL/SHUNT...	K	34																																																																															
35				20				1799	420			36																																																																															
37	K	8: SOILED DISHWASHABLE TRAY CONVEYOR		20	1799	420		20	GFCI	1C: SERVING LINE - COLD FOOD	K	38																																																																															
39				20		1799	420		20	GFCI	1C: SERVING LINE - COLD FOOD	K	40																																																																														
41				20			0	0	20			42																																																																															
					21049	18765		18889																																																																																			
					0A	0B	0C																																																																																				
<table border="0"> <tr> <td>PANELBOARD INFORMATION</td> <td>BRANCH CIRCUIT CONNECTED LOAD</td> <td>DEMAND FACTOR</td> <td>CALCULATED LOAD</td> <td>FEEDER AND OVERCURRENT...</td> <td>NOTES</td> </tr> <tr> <td>VOLTAGE: 208Y/120V</td> <td>CONTINUOUS LOAD (C):</td> <td>0</td> <td>100% 0</td> <td>125% 0</td> <td></td> </tr> <tr> <td>BUS AMPACITY: 225A</td> <td>ELECTRIC HEAT (E)</td> <td>0</td> <td>100% 0</td> <td>125% 0</td> <td></td> </tr> <tr> <td>MAIN TYPE: MLO</td> <td>NON-CONTINUOUS LOAD (NC):</td> <td>0</td> <td>100% 0</td> <td>100% 0</td> <td></td> </tr> <tr> <td>MINIMUM A.I.C.: 10,000</td> <td>KITCHEN LOAD (K):</td> <td>58702.19</td> <td>65.00% 38156.42</td> <td>100% 38156.42</td> <td></td> </tr> <tr> <td>MOUNTING: SURFACE</td> <td>RECEPT BASE LOAD (R):</td> <td>0</td> <td>100% 0</td> <td>100% 0</td> <td></td> </tr> <tr> <td></td> <td>RECEPT DEMAND LOAD (R):</td> <td>0</td> <td>50% 0</td> <td>100% 0</td> <td></td> </tr> <tr> <td></td> <td>LIGHTING LOAD (L):</td> <td>0</td> <td>100% 0</td> <td>125% 0</td> <td></td> </tr> <tr> <td></td> <td>ADDITIONAL TRACK LIGHTING...</td> <td>0</td> <td>100% 0</td> <td>100% 0</td> <td></td> </tr> <tr> <td></td> <td>MOTORS, HIGHEST LOAD (M):</td> <td>0</td> <td>125% 0</td> <td>100% 0</td> <td></td> </tr> <tr> <td></td> <td>MOTORS, REMAINING</td> <td>0</td> <td>100% 0</td> <td>100% 0</td> <td></td> </tr> <tr> <td>PANELBOARD LOCATION</td> <td colspan="3">NOTE: DEMAND AND SIZING INFORMATION IS CALCULATED...</td> <td></td> <td></td> </tr> <tr> <td></td> <td></td> <td>TOTAL (kVA): 38.16</td> <td>TOTAL... 105.91</td> <td>TOTAL... 105.91</td> <td></td> </tr> </table>														PANELBOARD INFORMATION	BRANCH CIRCUIT CONNECTED LOAD	DEMAND FACTOR	CALCULATED LOAD	FEEDER AND OVERCURRENT...	NOTES	VOLTAGE: 208Y/120V	CONTINUOUS LOAD (C):	0	100% 0	125% 0		BUS AMPACITY: 225A	ELECTRIC HEAT (E)	0	100% 0	125% 0		MAIN TYPE: MLO	NON-CONTINUOUS LOAD (NC):	0	100% 0	100% 0		MINIMUM A.I.C.: 10,000	KITCHEN LOAD (K):	58702.19	65.00% 38156.42	100% 38156.42		MOUNTING: SURFACE	RECEPT BASE LOAD (R):	0	100% 0	100% 0			RECEPT DEMAND LOAD (R):	0	50% 0	100% 0			LIGHTING LOAD (L):	0	100% 0	125% 0			ADDITIONAL TRACK LIGHTING...	0	100% 0	100% 0			MOTORS, HIGHEST LOAD (M):	0	125% 0	100% 0			MOTORS, REMAINING	0	100% 0	100% 0		PANELBOARD LOCATION	NOTE: DEMAND AND SIZING INFORMATION IS CALCULATED...							TOTAL (kVA): 38.16	TOTAL... 105.91	TOTAL... 105.91	
PANELBOARD INFORMATION	BRANCH CIRCUIT CONNECTED LOAD	DEMAND FACTOR	CALCULATED LOAD	FEEDER AND OVERCURRENT...	NOTES																																																																																						
VOLTAGE: 208Y/120V	CONTINUOUS LOAD (C):	0	100% 0	125% 0																																																																																							
BUS AMPACITY: 225A	ELECTRIC HEAT (E)	0	100% 0	125% 0																																																																																							
MAIN TYPE: MLO	NON-CONTINUOUS LOAD (NC):	0	100% 0	100% 0																																																																																							
MINIMUM A.I.C.: 10,000	KITCHEN LOAD (K):	58702.19	65.00% 38156.42	100% 38156.42																																																																																							
MOUNTING: SURFACE	RECEPT BASE LOAD (R):	0	100% 0	100% 0																																																																																							
	RECEPT DEMAND LOAD (R):	0	50% 0	100% 0																																																																																							
	LIGHTING LOAD (L):	0	100% 0	125% 0																																																																																							
	ADDITIONAL TRACK LIGHTING...	0	100% 0	100% 0																																																																																							
	MOTORS, HIGHEST LOAD (M):	0	125% 0	100% 0																																																																																							
	MOTORS, REMAINING	0	100% 0	100% 0																																																																																							
PANELBOARD LOCATION	NOTE: DEMAND AND SIZING INFORMATION IS CALCULATED...																																																																																										
		TOTAL (kVA): 38.16	TOTAL... 105.91	TOTAL... 105.91																																																																																							

© Copr. 2022 by Peter Basso Associates...

PANELBOARD KP-2																																																																																											
#	LOAD TYPE	DESCRIPTION	CB TYPE	CB	A	B	C	CB	CB TYPE	DESCRIPTION	LOAD TYPE	#																																																																															
1				20	0	0		20		SPARE		2																																																																															
3				20	0	0		20		SPARE		4																																																																															
5				20	0	0		20		SPARE		6																																																																															
7				20	0	0		20		SPARE		8																																																																															
9	R	RECEPTS: H123,H125		20		1080	0	20		SPARE		10																																																																															
11	R	RECEPTS: H124,H126,H127		20			1080	1260	20	RECEPTS:H123,H127	R	12																																																																															
13	R	RECEPTS:H123,H124		20	900	900		20		RECEPTS:H123	R	14																																																																															
15	R	RECEPTS:H123,H124		20		720	1272	20		KITCHEN COUNTERTOP	K	16																																																																															
17	C	REFRIGERATOR:H112	GFCI	20			1200	1500	20	COFFEE:H112	NC	18																																																																															
19	NC	MICROWAVE:H112		20	1500	1200		20		GARBAGE DISPOSAL:H112	NC	20																																																																															
21				20		0	0	20		SPARE		22																																																																															
23				20		0	0	20		SPARE		24																																																																															
25				20	0	1654		20	GFCI	1B:SERVING LINE - HOT/COLD FOOD COMBO	K	26																																																																															
27	K	1BA: SERVING LINE - HC FOOD...	GFCI	20		420	1654	20			K	28																																																																															
29	K	1A:SERVING LINE - HOT FOOD	GFCI	20			1654	1654	20	GFCI	1A:SERVING LINE - HOT FOOD	K	30																																																																														
31				20	1654	1654		20				32																																																																															
33	R	ROOF MECH/ELEC ROOM RECEPTS		20		1080	0	20		SPARE		34																																																																															
35				20		0	0	20		SPARE		36																																																																															
37				20	0	0		20		SPARE		38																																																																															
39				20		0	0	20		SPARE		40																																																																															
41				20			0	0	20	SPARE		42																																																																															
					9461	6229		8347																																																																																			
					0A	0B	0C																																																																																				
<table border="0"> <tr> <td>PANELBOARD INFORMATION</td> <td>BRANCH CIRCUIT CONNECTED LOAD</td> <td>DEMAND FACTOR</td> <td>CALCULATED LOAD</td> <td>FEEDER AND OVERCURRENT...</td> <td>NOTES</td> </tr> <tr> <td>VOLTAGE: 208Y/120V</td> <td>CONTINUOUS LOAD (C):</td> <td>0</td> <td>100% 1200</td> <td>125% 1500</td> <td></td> </tr> <tr> <td>BUS AMPACITY: 100A</td> <td>ELECTRIC HEAT (E)</td> <td>0</td> <td>100% 0</td> <td>125% 0</td> <td></td> </tr> <tr> <td>MAIN TYPE: MLO</td> <td>NON-CONTINUOUS LOAD (NC):</td> <td>4200</td> <td>100% 4200</td> <td>100% 4200</td> <td></td> </tr> <tr> <td>MINIMUM A.I.C.: 10,000</td> <td>KITCHEN LOAD (K):</td> <td>11613.6</td> <td>70.00% 8129.52</td> <td>100% 8129.52</td> <td></td> </tr> <tr> <td>MOUNTING: SURFACE</td> <td>RECEPT BASE LOAD (R):</td> <td>7020</td> <td>100% 7020</td> <td>100% 7020</td> <td></td> </tr> <tr> <td></td> <td>RECEPT DEMAND LOAD (R):</td> <td>0</td> <td>50% 0</td> <td>100% 0</td> <td></td> </tr> <tr> <td></td> <td>LIGHTING LOAD (L):</td> <td>0</td> <td>100% 0</td> <td>125% 0</td> <td></td> </tr> <tr> <td></td> <td>ADDITIONAL TRACK LIGHTING...</td> <td>0</td> <td>100% 0</td> <td>100% 0</td> <td></td> </tr> <tr> <td></td> <td>MOTORS, HIGHEST LOAD (M):</td> <td>0</td> <td>125% 0</td> <td>100% 0</td> <td></td> </tr> <tr> <td></td> <td>MOTORS, REMAINING</td> <td>0</td> <td>100% 0</td> <td>100% 0</td> <td></td> </tr> <tr> <td>PANELBOARD LOCATION</td> <td colspan="3">NOTE: DEMAND AND SIZING INFORMATION IS CALCULATED...</td> <td></td> <td></td> </tr> <tr> <td></td> <td></td> <td>TOTAL (kVA): 20.55</td> <td>TOTAL... 67.04</td> <td>TOTAL... 67.87</td> <td></td> </tr> </table>														PANELBOARD INFORMATION	BRANCH CIRCUIT CONNECTED LOAD	DEMAND FACTOR	CALCULATED LOAD	FEEDER AND OVERCURRENT...	NOTES	VOLTAGE: 208Y/120V	CONTINUOUS LOAD (C):	0	100% 1200	125% 1500		BUS AMPACITY: 100A	ELECTRIC HEAT (E)	0	100% 0	125% 0		MAIN TYPE: MLO	NON-CONTINUOUS LOAD (NC):	4200	100% 4200	100% 4200		MINIMUM A.I.C.: 10,000	KITCHEN LOAD (K):	11613.6	70.00% 8129.52	100% 8129.52		MOUNTING: SURFACE	RECEPT BASE LOAD (R):	7020	100% 7020	100% 7020			RECEPT DEMAND LOAD (R):	0	50% 0	100% 0			LIGHTING LOAD (L):	0	100% 0	125% 0			ADDITIONAL TRACK LIGHTING...	0	100% 0	100% 0			MOTORS, HIGHEST LOAD (M):	0	125% 0	100% 0			MOTORS, REMAINING	0	100% 0	100% 0		PANELBOARD LOCATION	NOTE: DEMAND AND SIZING INFORMATION IS CALCULATED...							TOTAL (kVA): 20.55	TOTAL... 67.04	TOTAL... 67.87	
PANELBOARD INFORMATION	BRANCH CIRCUIT CONNECTED LOAD	DEMAND FACTOR	CALCULATED LOAD	FEEDER AND OVERCURRENT...	NOTES																																																																																						
VOLTAGE: 208Y/120V	CONTINUOUS LOAD (C):	0	100% 1200	125% 1500																																																																																							
BUS AMPACITY: 100A	ELECTRIC HEAT (E)	0	100% 0	125% 0																																																																																							
MAIN TYPE: MLO	NON-CONTINUOUS LOAD (NC):	4200	100% 4200	100% 4200																																																																																							
MINIMUM A.I.C.: 10,000	KITCHEN LOAD (K):	11613.6	70.00% 8129.52	100% 8129.52																																																																																							
MOUNTING: SURFACE	RECEPT BASE LOAD (R):	7020	100% 7020	100% 7020																																																																																							
	RECEPT DEMAND LOAD (R):	0	50% 0	100% 0																																																																																							
	LIGHTING LOAD (L):	0	100% 0	125% 0																																																																																							
	ADDITIONAL TRACK LIGHTING...	0	100% 0	100% 0																																																																																							
	MOTORS, HIGHEST LOAD (M):	0	125% 0	100% 0																																																																																							
	MOTORS, REMAINING	0	100% 0	100% 0																																																																																							
PANELBOARD LOCATION	NOTE: DEMAND AND SIZING INFORMATION IS CALCULATED...																																																																																										
		TOTAL (kVA): 20.55	TOTAL... 67.04	TOTAL... 67.87																																																																																							


© Copr. 2022 by Peter Basso Associates...

PANELBOARD RP-1																																																																																											
#	LOAD TYPE	DESCRIPTION	CB TYPE	CB	A	B	C	CB	CB TYPE	DESCRIPTION	LOAD TYPE	#																																																																															
1	R	RECEPTS:H119,H131,EXT. ROOF		20	1260	1260		20		RECEPTS: H131,H132,H133,EXT	R	2																																																																															
3	R	RECEPTS:H131,H120		20		1080	1080	20		RECEPTS: H107,H130,H131,EXT	R	4																																																																															
5				20			360	0	20	SPARE		6																																																																															
7				20	0	0		20		SPARE		8																																																																															
9				20		0	600	20		NORTH OVERHEAD DOOR:H120	M	10																																																																															
11	M	SOUTH OVERHEAD DOOR: H120		20			600	1000	20	FIRE ALARM NAC: H201	C	12																																																																															
13	M	UH-8H: H201		15	528	528		15		UH-9H: H201	M	14																																																																															
15	M	UH-10H: H204		15		528	528	15		CUH-9H: H120	M	16																																																																															
17	M	CUH-9H: H121		15			528	528	15	CUH-3H: H132	M	18																																																																															
19	M	CUH-9H: H131		15	528	528		15		EF-8H: ROOF	M	20																																																																															
21	C	TEMPERATURE CONTROL PANEL		20		1200	528	20		EF-7H: ROOF	M	22																																																																															
23	C	TEMPERATURE CONTROL PANEL		20			1200	528	15	EF-8H: ROOF	M	24																																																																															
25	M	CUH-11H: H119		15	528	0		20		SPARE		26																																																																															
27				20		0	0	20		SPARE		28																																																																															
29				20		0	0	20		SPARE		30																																																																															
31				20	0	0		20		SPARE		32																																																																															
33				20		0	0	20		SPARE		34																																																																															
35				20		0	0	20		SPARE		36																																																																															
37				20	0	0		20		SPARE		38																																																																															
39				20		0	0	20		SPARE		40																																																																															
41				20			0	0	20	SPARE		42																																																																															
					5160	8544		4744																																																																																			
					0A	0B	0C																																																																																				
<table border="0"> <tr> <td>PANELBOARD INFORMATION</td> <td>BRANCH CIRCUIT CONNECTED LOAD</td> <td>DEMAND FACTOR</td> <td>CALCULATED LOAD</td> <td>FEEDER AND OVERCURRENT...</td> <td>NOTES</td> </tr> <tr> <td>VOLTAGE: 208Y/120V</td> <td>CONTINUOUS LOAD (C):</td> <td>0</td> <td>100% 3400</td> <td>125% 4250</td> <td></td> </tr> <tr> <td>BUS AMPACITY: 100A</td> <td>ELECTRIC HEAT (E)</td> <td>0</td> <td>100% 0</td> <td>125% 0</td> <td></td> </tr> <tr> <td>MAIN TYPE: MLO</td> <td>NON-CONTINUOUS LOAD (NC):</td> <td>0</td> <td>100% 0</td> <td>100% 0</td> <td></td> </tr> <tr> <td>MINIMUM A.I.C.: 10,000</td> <td>KITCHEN LOAD (K):</td> <td>0</td> <td>0</td> <td>100% 0</td> <td></td> </tr> <tr> <td>MOUNTING: SURFACE</td> <td>RECEPT BASE LOAD (R):</td> <td>5940</td> <td>100% 5940</td> <td>100% 5940</td> <td></td> </tr> <tr> <td></td> <td>RECEPT DEMAND LOAD (R):</td> <td>0</td> <td>50% 0</td> <td>100% 0</td> <td></td> </tr> <tr> <td></td> <td>LIGHTING LOAD (L):</td> <td>0</td> <td>100% 0</td> <td>125% 0</td> <td></td> </tr> <tr> <td></td> <td>ADDITIONAL TRACK LIGHTING...</td> <td>0</td> <td>100% 0</td> <td>100% 0</td> <td></td> </tr> <tr> <td></td> <td>MOTORS, HIGHEST LOAD (M):</td> <td>600</td> <td>125% 750</td> <td>100% 750</td> <td></td> </tr> <tr> <td></td> <td>MOTORS, REMAINING</td> <td>6408</td> <td>100% 6408</td> <td>100% 6408</td> <td></td> </tr> <tr> <td>PANELBOARD LOCATION</td> <td colspan="3">NOTE: DEMAND AND SIZING INFORMATION IS CALCULATED...</td> <td></td> <td></td> </tr> <tr> <td></td> <td></td> <td>TOTAL (kVA): 15.6</td> <td>TOTAL... 43.30</td> <td>TOTAL... 45.66</td> <td></td> </tr> </table>														PANELBOARD INFORMATION	BRANCH CIRCUIT CONNECTED LOAD	DEMAND FACTOR	CALCULATED LOAD	FEEDER AND OVERCURRENT...	NOTES	VOLTAGE: 208Y/120V	CONTINUOUS LOAD (C):	0	100% 3400	125% 4250		BUS AMPACITY: 100A	ELECTRIC HEAT (E)	0	100% 0	125% 0		MAIN TYPE: MLO	NON-CONTINUOUS LOAD (NC):	0	100% 0	100% 0		MINIMUM A.I.C.: 10,000	KITCHEN LOAD (K):	0	0	100% 0		MOUNTING: SURFACE	RECEPT BASE LOAD (R):	5940	100% 5940	100% 5940			RECEPT DEMAND LOAD (R):	0	50% 0	100% 0			LIGHTING LOAD (L):	0	100% 0	125% 0			ADDITIONAL TRACK LIGHTING...	0	100% 0	100% 0			MOTORS, HIGHEST LOAD (M):	600	125% 750	100% 750			MOTORS, REMAINING	6408	100% 6408	100% 6408		PANELBOARD LOCATION	NOTE: DEMAND AND SIZING INFORMATION IS CALCULATED...							TOTAL (kVA): 15.6	TOTAL... 43.30	TOTAL... 45.66	
PANELBOARD INFORMATION	BRANCH CIRCUIT CONNECTED LOAD	DEMAND FACTOR	CALCULATED LOAD	FEEDER AND OVERCURRENT...	NOTES																																																																																						
VOLTAGE: 208Y/120V	CONTINUOUS LOAD (C):	0	100% 3400	125% 4250																																																																																							
BUS AMPACITY: 100A	ELECTRIC HEAT (E)	0	100% 0	125% 0																																																																																							
MAIN TYPE: MLO	NON-CONTINUOUS LOAD (NC):	0	100% 0	100% 0																																																																																							
MINIMUM A.I.C.: 10,000	KITCHEN LOAD (K):	0	0	100% 0																																																																																							
MOUNTING: SURFACE	RECEPT BASE LOAD (R):	5940	100% 5940	100% 5940																																																																																							
	RECEPT DEMAND LOAD (R):	0	50% 0	100% 0																																																																																							
	LIGHTING LOAD (L):	0	100% 0	125% 0																																																																																							
	ADDITIONAL TRACK LIGHTING...	0	100% 0	100% 0																																																																																							
	MOTORS, HIGHEST LOAD (M):	600	125% 750	100% 750																																																																																							
	MOTORS, REMAINING	6408	100% 6408	100% 6408																																																																																							
PANELBOARD LOCATION	NOTE: DEMAND AND SIZING INFORMATION IS CALCULATED...																																																																																										
		TOTAL (kVA): 15.6	TOTAL... 43.30	TOTAL... 45.66																																																																																							

© Copr. 2022 by Peter Basso Associates...

PANELBOARD LS-H201													
#	LOAD TYPE	DESCRIPTION	CB TYPE	CB	A	B	C	CB	CB TYPE	DESCRIPTION	LOAD TYPE	#	
1	L	LIGHTING EM LIGHTS		20	1924	280		20		EXTERIOR BUILDING MOUNTED...	L	2	
3				20		0	368	20		LIGHTING STAIR H121	L	4	
5				20			0	20		SPARE		6	
7				20	0	0		20		SPARE		8	
9				20		0	0	20		SPARE		10	
11				20			0	0	20	SPARE		12	
13				20	0	0		20		SPARE		14	
15				20		0	0	20		SPARE		16	
17				20			0	0	20	SPARE		18	
19				20	0	0		20		SPARE		20	
21				20		0	0	20		SPARE		22	
23				20			0	0	20	SPARE		24	
25				20	0	0		20		SPARE		26	
27				20		0	0	20		SPARE		28	
29				20			0	0	20	SPARE		30	
31				20	0	0		20		SPARE		32	
33				20		0	0	20		SPARE		34	
35													

THE FOLLOWING DIMENSION EQUALS ONE INCH WHEN PRINTED TO SCALE.

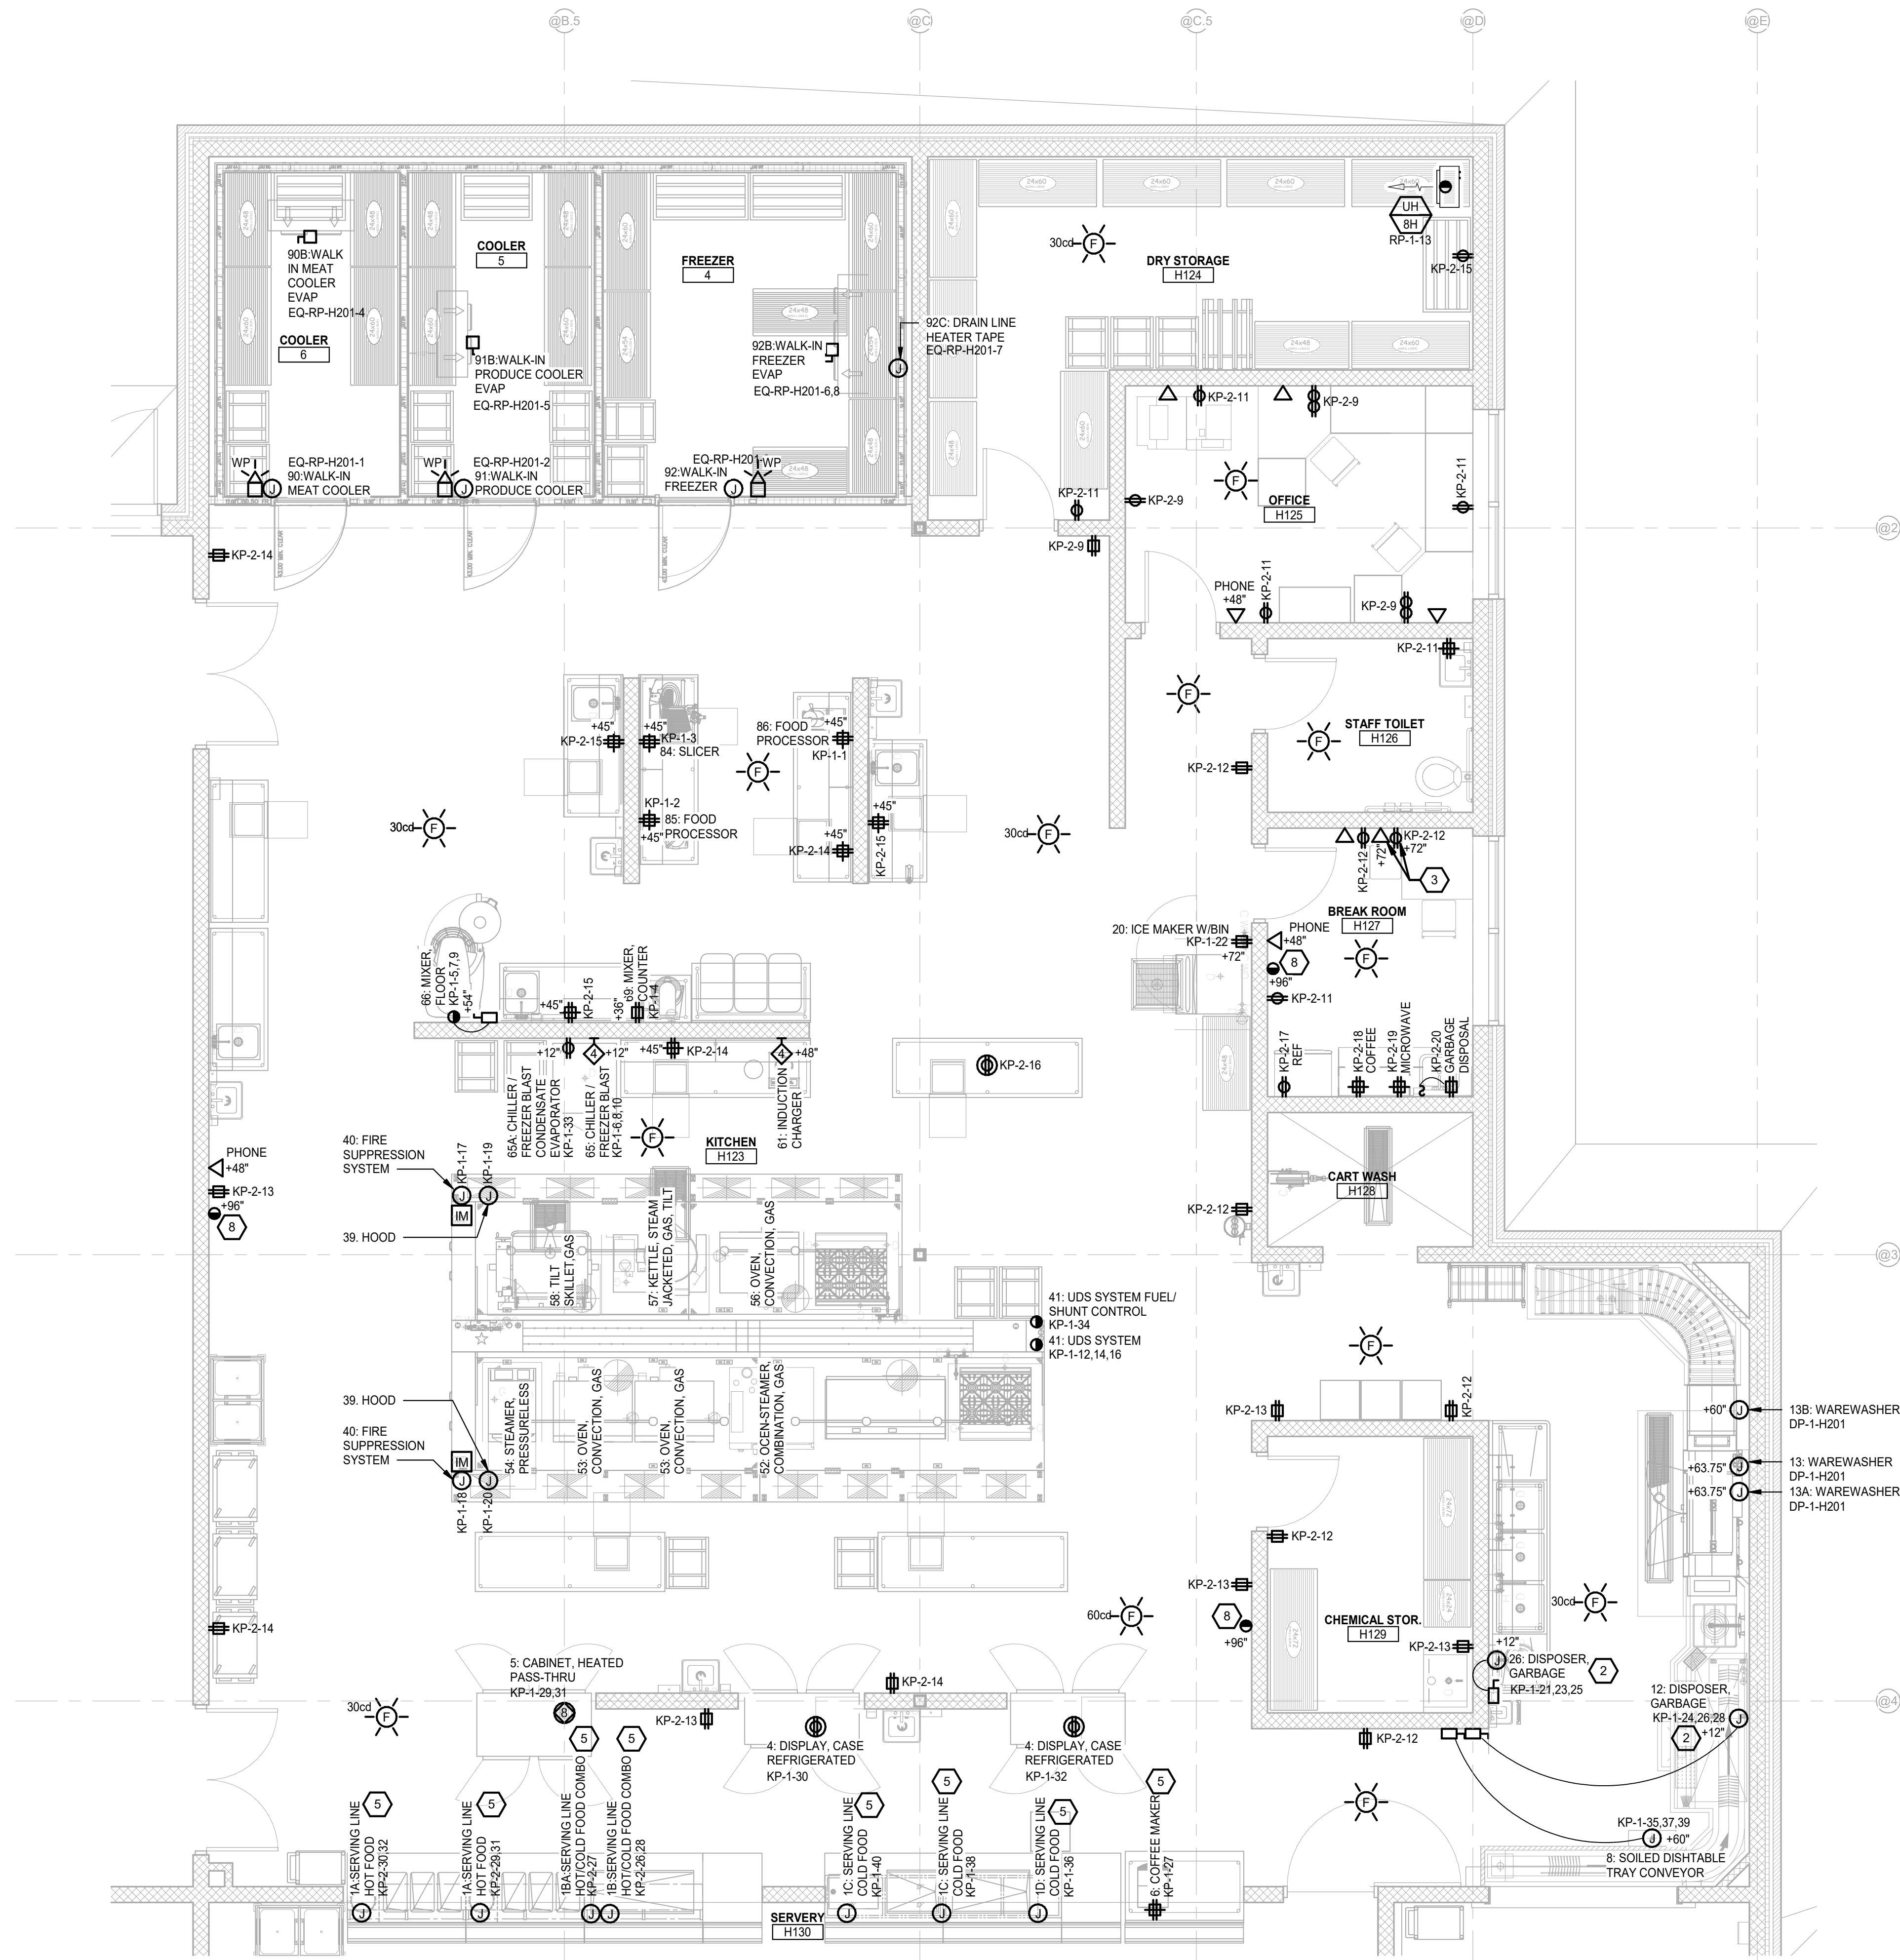

1
E3.01 **FIRST FLOOR ELECTRICAL ENLARGED KITCHEN PLAN**
SCALE: 1/4" = 1'-0"

ELECTRICAL GENERAL NOTES:

- THESE DRAWINGS REPRESENT THE GENERAL EXTENT AND ARRANGEMENT OF SYSTEMS. COORDINATE EXACT EQUIPMENT LOCATIONS, ELEVATIONS, AND FINAL CONNECTION REQUIREMENTS. PROVIDE EACH SYSTEM COMPLETE, INCLUDING ALL NECESSARY COMPONENTS, FITTINGS AND OFFSETS.
- INSTALL SYSTEMS SUCH THAT REQUIRED CLEARANCE AND SERVICE ACCESS SPACE IS PROVIDED AROUND ALL MECHANICAL AND ELECTRICAL EQUIPMENT, AND AROUND ANY COMPONENTS WHICH REQUIRE SERVICE ACCESS.
- COORDINATE AND PROVIDE ACCESS DOORS WITHIN INACCESSIBLE CEILING, SHAFT, AND CHASE AREAS FOR ALL COMPONENTS WHICH REQUIRE SERVICE ACCESS. REFER TO ARCHITECTURAL DRAWINGS FOR CEILING TYPES.
- PROVIDE SUPPLEMENTARY STEEL AS REQUIRED FOR THE PROPER SUPPORT OF ALL SYSTEMS.
- TRANSFORMER SECONDARY CONDUCTORS SHALL BE SIZED IN ACCORDANCE WITH TRANSFORMER CIRCUIT SIZING SCHEDULE SHOWN ON "ELECTRICAL STANDARD SCHEDULES DRAWING" UNLESS OTHERWISE NOTED.
- MOTOR CIRCUIT PROTECTION SHALL BE SIZED IN ACCORDANCE WITH MOTOR CIRCUIT SIZING SCHEDULES SHOWN ON "ELECTRICAL STANDARD SCHEDULES DRAWING" UNLESS OTHERWISE NOTED.
- COORDINATE THE MOUNTING HEIGHTS OF DEVICES WITH ARCHITECTURAL ELEVATIONS AND THE TRADES INSTALLING THE WORK.
- REFER TO MECHANICAL SCHEDULE SHEETS FOR ELECTRICAL REQUIREMENTS FOR MECHANICAL EQUIPMENT. PROVIDE ALL CONNECTIONS, STARTERS, DISCONNECTS, ETC. AS REQUIRED BY SCHEDULES AND WHERE NOTED ELSEWHERE. VERIFY REQUIREMENTS OF ALL MECHANICAL EQUIPMENT WITH SHOP DRAWINGS SUBMITTALS. NOTIFY ENGINEER OF ANY CONFLICTS BETWEEN EQUIPMENT SUBMITTALS AND ELECTRICAL DRAWINGS. WHERE CIRCUIT SIZES ARE SHOWN ON THE ELECTRICAL DRAWINGS THAT DIFFER FROM WHAT IS INDICATED ON THE MECHANICAL SCHEDULES, PROVIDE THE CIRCUIT OF HIGHER AMPACITY.
- REFER TO TEMPERATURE CONTROLS SHEETS FOR REQUIRED FIRE ALARM CONTROL MODULES, DUCT SMOKE DETECTORS, AND MOTOR CONTROLLERS. PROVIDE ALL ACCESSORIES INDICATED.
- REFER TO LIGHTING CONTROL SCHEDULE FOR ROOM CONTROL AND EMERGENCY LIGHTING CIRCUIT CONTROL REQUIREMENTS. DESIGNATION FOR ROOM IS INDICATED AS A LETTERED OVAL SYMBOL.
- ALL FIRE ALARM DEVICES SHALL BE COMPATIBLE WITH EXISTING SIMPLEX GRINNEL 4120 FIRE ALARM SYSTEM. PROVIDE NECESSARY COMPONENTS, MODULES, ETC. AS REQUIRED FOR A FULLY FUNCTIONAL SYSTEM. RE-TEST AND CERTIFY EXISTING FIRE ALARM SYSTEM AT COMPLETION OF PROJECT.
- PROVIDE TAMPER RESISTANT COVER PLATE KENALL WPP SERIES OR EQUAL WHERE PATIENTS WILL HAVE ACCESS TO DEVICES.
- REFER TO SECURITY/TELECOMMUNICATION DRAWINGS FOR FINAL DEVICE LOCATIONS AND RACEWAY REQUIREMENTS. COORDINATE WITH SECURITY REQUIREMENTS WITH INSTALLING TRADES.
- COORDINATE ELECTRICAL REQUIREMENTS DEVICE LOCATIONS AND MOUNTING HEIGHTS WITH KITCHEN EQUIPMENT DRAWINGS, SHOP DRAWINGS AND KITCHEN EQUIPMENT INSTALLER.

CONSTRUCTION KEY NOTES:

- PROVIDE TOGGLE SWITCH LOCK GUARD FOR BOILER DISCONNECT LOCKING MEANS.
- PROVIDE INTERWIRE TO CONTROL PANEL. COORDINATE WITH FOOD SERVICE INSTALLER AND INSTALLATION INSTRUCTIONS.
- COORDINATE FINAL LOCATION OF TV WITH ARCHITECTURAL DRAWINGS AND TRADES PRIOR TO ROUGH IN.
- INSTALL BOTTOM OF LIGHT FIXTURE AT 8'-0" AFF.
- ROUTE BRANCH CIRCUIT IN FLOOR AND STUB UP TO FINAL LOCATION. COORDINATE FINAL LOCATION WITH FOOD SERVICE DRAWINGS AND TRADES.
- MATCH ON-OFF TIMES WITH EXISTING SITE LIGHTING. COORDINATE EXACT TIMES WITH OWNER. CONNECT PHOTO CELL CONTROL TO EXISTING MAIN BUILDING PHOTO CELL WIRING/CONTROL.
- 4" HOUSEKEEPING PAD.
- LINE VOLTAGE CLOCK STANDARD ELECTRIC TIME FARADAY 2384 OR OTHER CLOCK COMPATIBLE WITH EXISTING SYSTEM. EXTEND WIRING FROM EXISTING CLOCK HEAD END SYSTEM AS REQUIRED.


NO.	REVISION	DATE

STATE OF MICHIGAN
DEPARTMENT OF TECHNOLOGY, MANAGEMENT AND BUDGET
FACILITIES AND BUSINESS SERVICES ADMINISTRATION
DESIGN AND CONSTRUCTION DIVISION
ADAM LACHI, RA, DIRECTOR

FILE NO.
491/20167.SDW

FUNDING CODE
171CODHHS7255

CONTRACT NO.
Y22003

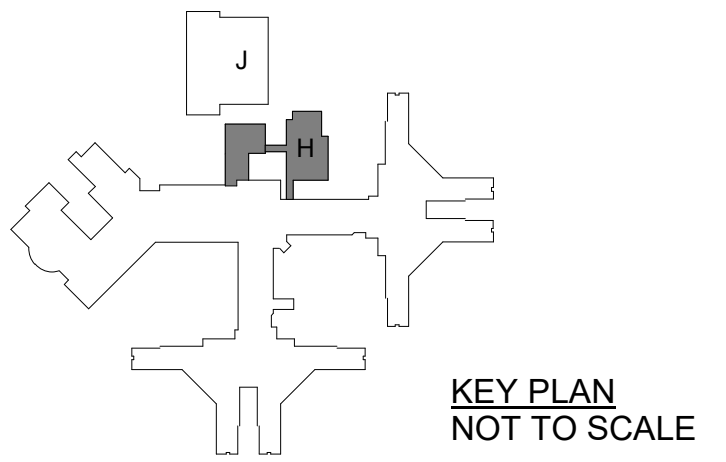

WTA ARCHITECTS
100 S. Jefferson Ave., Suite 601
Saginaw, Michigan 48607
989 752 8107
COPYRIGHT © 2023

PROJECT TITLE
491/20167.SDW - PHASE 500:
**CENTER FOR FORENSIC
PSYCHIATRY - CREATE
KITCHEN**
SALINE, MICHIGAN

SHEET TITLE
**ELECTRICAL ENLARGED
PLAN**

PROJECT NUMBER
2021094

SHEET NUMBER

PROJECT DATE
SEPTEMBER 6, 2023


E6.01

CHECKED BY
TLC

ELECTRICAL
These documents are approved for compliance with the STATE OF MICHIGAN ELECTRICAL CODE subject to field inspection and the conditions of approval.

PBA
Peter Basso Associates Inc
CONSULTING ENGINEERS
5145 Livernois, Suite 100
Troy, Michigan 48068-3276
Tel: 248-879-5666
Fax: 248-879-0007
www.PeterBassoAssociates.com
PBA Project No. 303-0492

THE FOLLOWING DIMENSION EQUALS ONE INCH WHEN PRINTED TO SCALE.

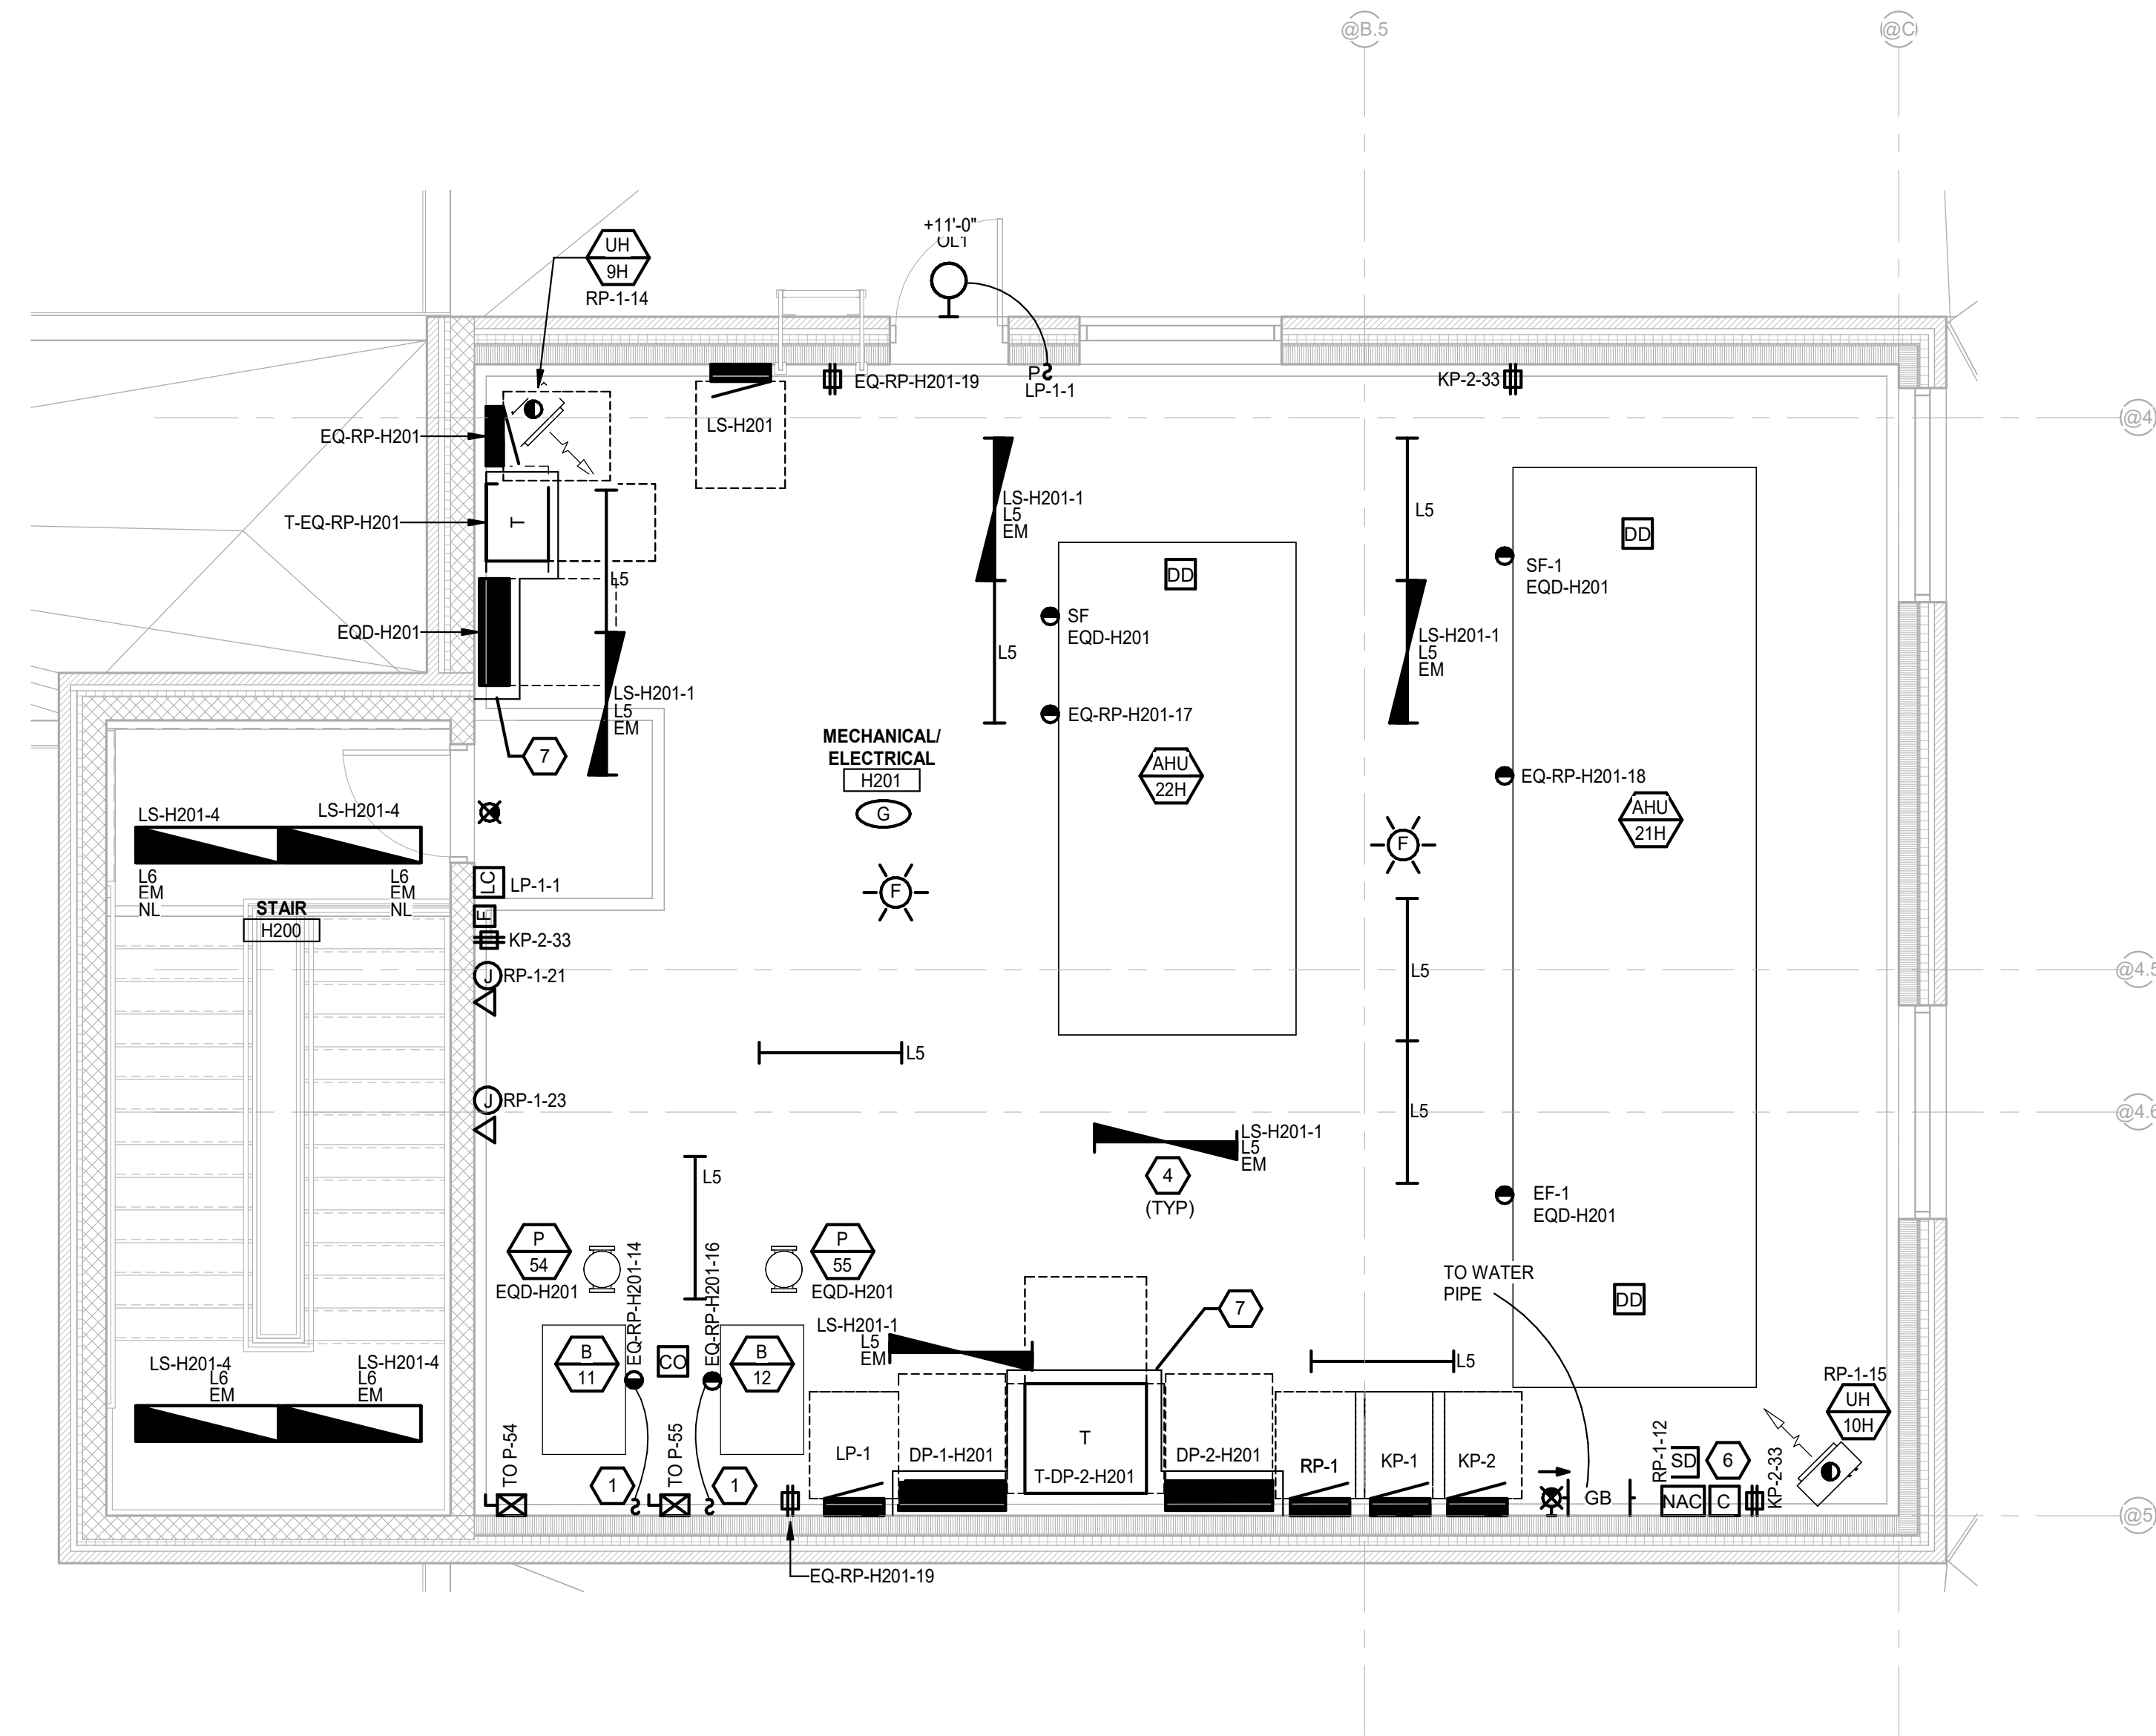

PENTHOUSE ELECTRICAL ENLARGED PLAN
SCALE: 1/4" = 1'-0"

ELECTRICAL GENERAL NOTES:

- 1 THESE DRAWINGS REPRESENT THE GENERAL EXTENT AND ARRANGEMENT OF SYSTEMS. COORDINATE EXACT EQUIPMENT LOCATIONS, ELEVATIONS, AND FINAL CONNECTION REQUIREMENTS. PROVIDE EACH SYSTEM COMPLETE, INCLUDING ALL NECESSARY COMPONENTS, FITTINGS AND OFFSETS.
- 2 INSTALL SYSTEMS SUCH THAT REQUIRED CLEARANCE AND SERVICE ACCESS SPACE IS PROVIDED AROUND ALL MECHANICAL AND ELECTRICAL EQUIPMENT, AND AROUND ANY COMPONENTS WHICH REQUIRE SERVICE ACCESS.
- 3 COORDINATE AND PROVIDE ACCESS DOORS WITHIN INACCESSIBLE CEILING, SHAFT, AND CHASE AREAS FOR ALL COMPONENTS WHICH REQUIRE SERVICE ACCESS. REFER TO ARCHITECTURAL DRAWINGS FOR CEILING TYPES.
- 4 PROVIDE SUPPLEMENTARY STEEL AS REQUIRED FOR THE PROPER SUPPORT OF ALL SYSTEMS.
- 5 TRANSFORMER SECONDARY CONDUCTORS SHALL BE SIZED IN ACCORDANCE WITH TRANSFORMER CIRCUIT SIZING SCHEDULE SHOWN ON "ELECTRICAL STANDARD SCHEDULES DRAWING" UNLESS OTHERWISE NOTED.
- 6 MOTOR CIRCUIT PROTECTION SHALL BE SIZED IN ACCORDANCE WITH MOTOR CIRCUIT SIZING SCHEDULES SHOWN ON "ELECTRICAL STANDARD SCHEDULES DRAWING" UNLESS OTHERWISE NOTED.
- 7 COORDINATE THE MOUNTING HEIGHTS OF DEVICES WITH ARCHITECTURAL ELEVATIONS AND THE TRADES INSTALLING THE WORK.
- 8 REFER TO MECHANICAL SCHEDULE SHEETS FOR ELECTRICAL REQUIREMENTS FOR MECHANICAL EQUIPMENT. PROVIDE ALL CONNECTIONS, STARTERS, DISCONNECTS, ETC. AS REQUIRED BY SCHEDULES AND WHERE NOTED ELSEWHERE. VERIFY REQUIREMENTS OF ALL MECHANICAL EQUIPMENT WITH SHOP DRAWINGS SUBMITTALS. NOTIFY ENGINEER OF ANY CONFLICTS BETWEEN EQUIPMENT SUBMITTALS AND ELECTRICAL DRAWINGS. WHERE CIRCUIT SIZES ARE SHOWN ON THE ELECTRICAL DRAWINGS THAT DIFFER FROM WHAT IS INDICATED ON THE MECHANICAL SCHEDULES, PROVIDE THE CIRCUIT OF HIGHER AMPACITY.
- 9 REFER TO TEMPERATURE CONTROLS SHEETS FOR REQUIRED FIRE ALARM CONTROL MODULES, DUCT SMOKE DETECTORS, AND MOTOR CONTROLLERS. PROVIDE ALL ACCESSORIES INDICATED.
- 10 REFER TO LIGHTING CONTROL SCHEDULE FOR ROOM CONTROL AND EMERGENCY LIGHTING CIRCUIT CONTROL REQUIREMENTS. DESIGNATION FOR ROOM IS INDICATED AS A LETTERED OVAL SYMBOL.
- 11 ALL FIRE ALARM DEVICES SHALL BE COMPATIBLE WITH EXISTING SIMPLEX GRINNEL 4120 FIRE ALARM SYSTEM. PROVIDE NECESSARY COMPONENTS, MODULES, ETC. AS REQUIRED FOR A FULLY FUNCTIONAL SYSTEM. RE-TEST AND CERTIFY EXISTING FIRE ALARM SYSTEM AT COMPLETION OF PROJECT.
- 12 PROVIDE TAMPER RESISTANT COVER PLATE KENALL WPP SERIES OR EQUAL WHERE PATIENTS WILL HAVE ACCESS TO DEVICES.
- 13 REFER TO SECURITY/TELECOMMUNICATION DRAWINGS FOR FINAL DEVICE LOCATIONS AND RACEWAY REQUIREMENTS. COORDINATE WITH SECURITY REQUIREMENTS WITH INSTALLING TRADES.
- 14 COORDINATE ELECTRICAL REQUIREMENTS DEVICE LOCATIONS AND MOUNTING HEIGHTS WITH KITCHEN EQUIPMENT DRAWINGS, SHOP DRAWINGS AND KITCHEN EQUIPMENT INSTALLER.

CONSTRUCTION KEY NOTES:

- 1 PROVIDE TOGGLE SWITCH LOCK GUARD FOR BOILER DISCONNECT LOCKING MEANS.
- 2 PROVIDE INTERWIRE TO CONTROL PANEL. COORDINATE WITH FOOD SERVICE INSTALLER AND INSTALLATION INSTRUCTIONS.
- 3 COORDINATE FINAL LOCATION OF TV WITH ARCHITECTURAL DRAWINGS AND TRADES PRIOR TO ROUGH IN.
- 4 INSTALL BOTTOM OF LIGHT FIXTURE AT 8'-0" AFF.
- 5 ROUTE BRANCH CIRCUIT IN FLOOR AND STUB UP TO FINAL LOCATION. COORDINATE FINAL LOCATION WITH FOOD SERVICE DRAWINGS AND TRADES.
- 6 MATCH ON-OFF TIMES WITH EXISTING SITE LIGHTING. COORDINATE EXACT TIMES WITH OWNER. CONNECT PHOTO CELL CONTROL TO EXISTING MAIN BUILDING PHOTO CELL WIRING/CONTROL.
- 7 4" HOUSEKEEPING PAD.
- 8 LINE VOLTAGE CLOCK STANDARD ELECTRIC TIME FARADAY 2384 OR OTHER CLOCK COMPATABLE WITH EXISTING SYSTEM. EXTEND WIRING FROM EXISTING CLOCK HEAD END SYSTEM AS REQUIRED.


NO.	REVISION	DATE

STATE OF MICHIGAN
DEPARTMENT OF TECHNOLOGY, MANAGEMENT AND BUDGET
FACILITIES AND BUSINESS SERVICES ADMINISTRATION
DESIGN AND CONSTRUCTION DIVISION
ADAM LACH, RA, DIRECTOR

FILE NO.
491/20167.SDW

FUNDING CODE
171CODHHS7255

CONTRACT NO.
Y22003

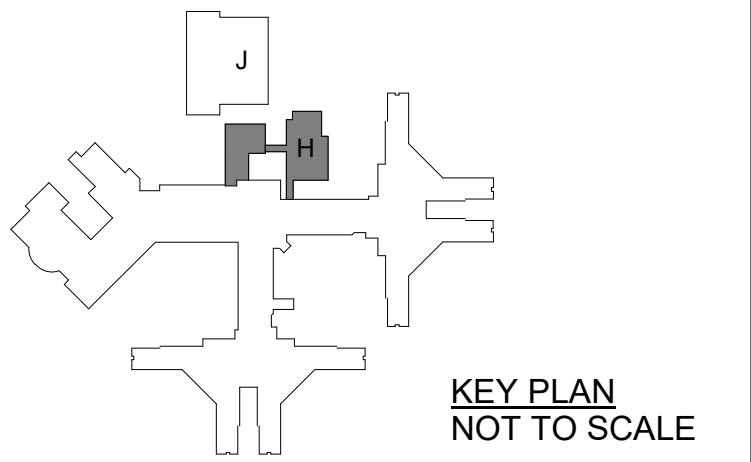

WTA ARCHITECTS

100 S. Jefferson Ave, Suite 601
Saginaw, Michigan 48607
989 752 8107


WTAARCH.COM

COPYRIGHT © 2023


PROJECT TITLE
491/20167.SDW - PHASE 500:
CENTER FOR FORENSIC PSYCHIATRY - CREATE KITCHEN
SALINE, MICHIGAN

SHEET TITLE
ELECTRICAL ENLARGED PLAN


PROJECT NUMBER 2021094	SHEET NUMBER E6.02
PROJECT DATE SEPTEMBER 6, 2023	CHECKED BY TLC

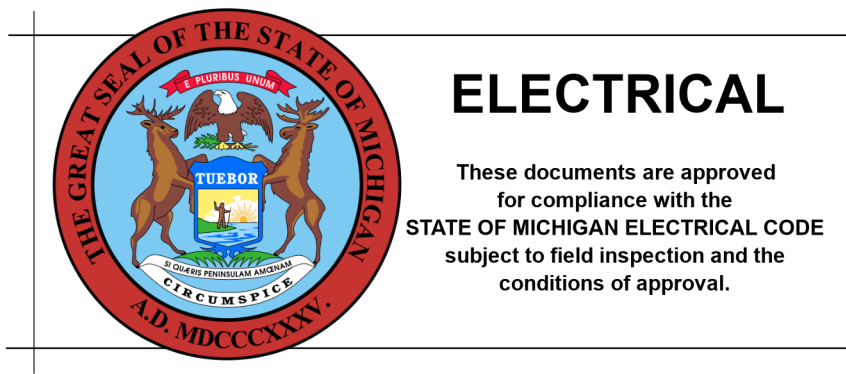

PBA
Peter Basso Associates Inc
CONSULTING ENGINEERS
5145 Livernois, Suite 100
Troy, Michigan 48068-3276
Tel: 248-879-5666
Fax: 248-879-0007
www.PeterBassoAssociates.com
PBA Project No. 3031-0492

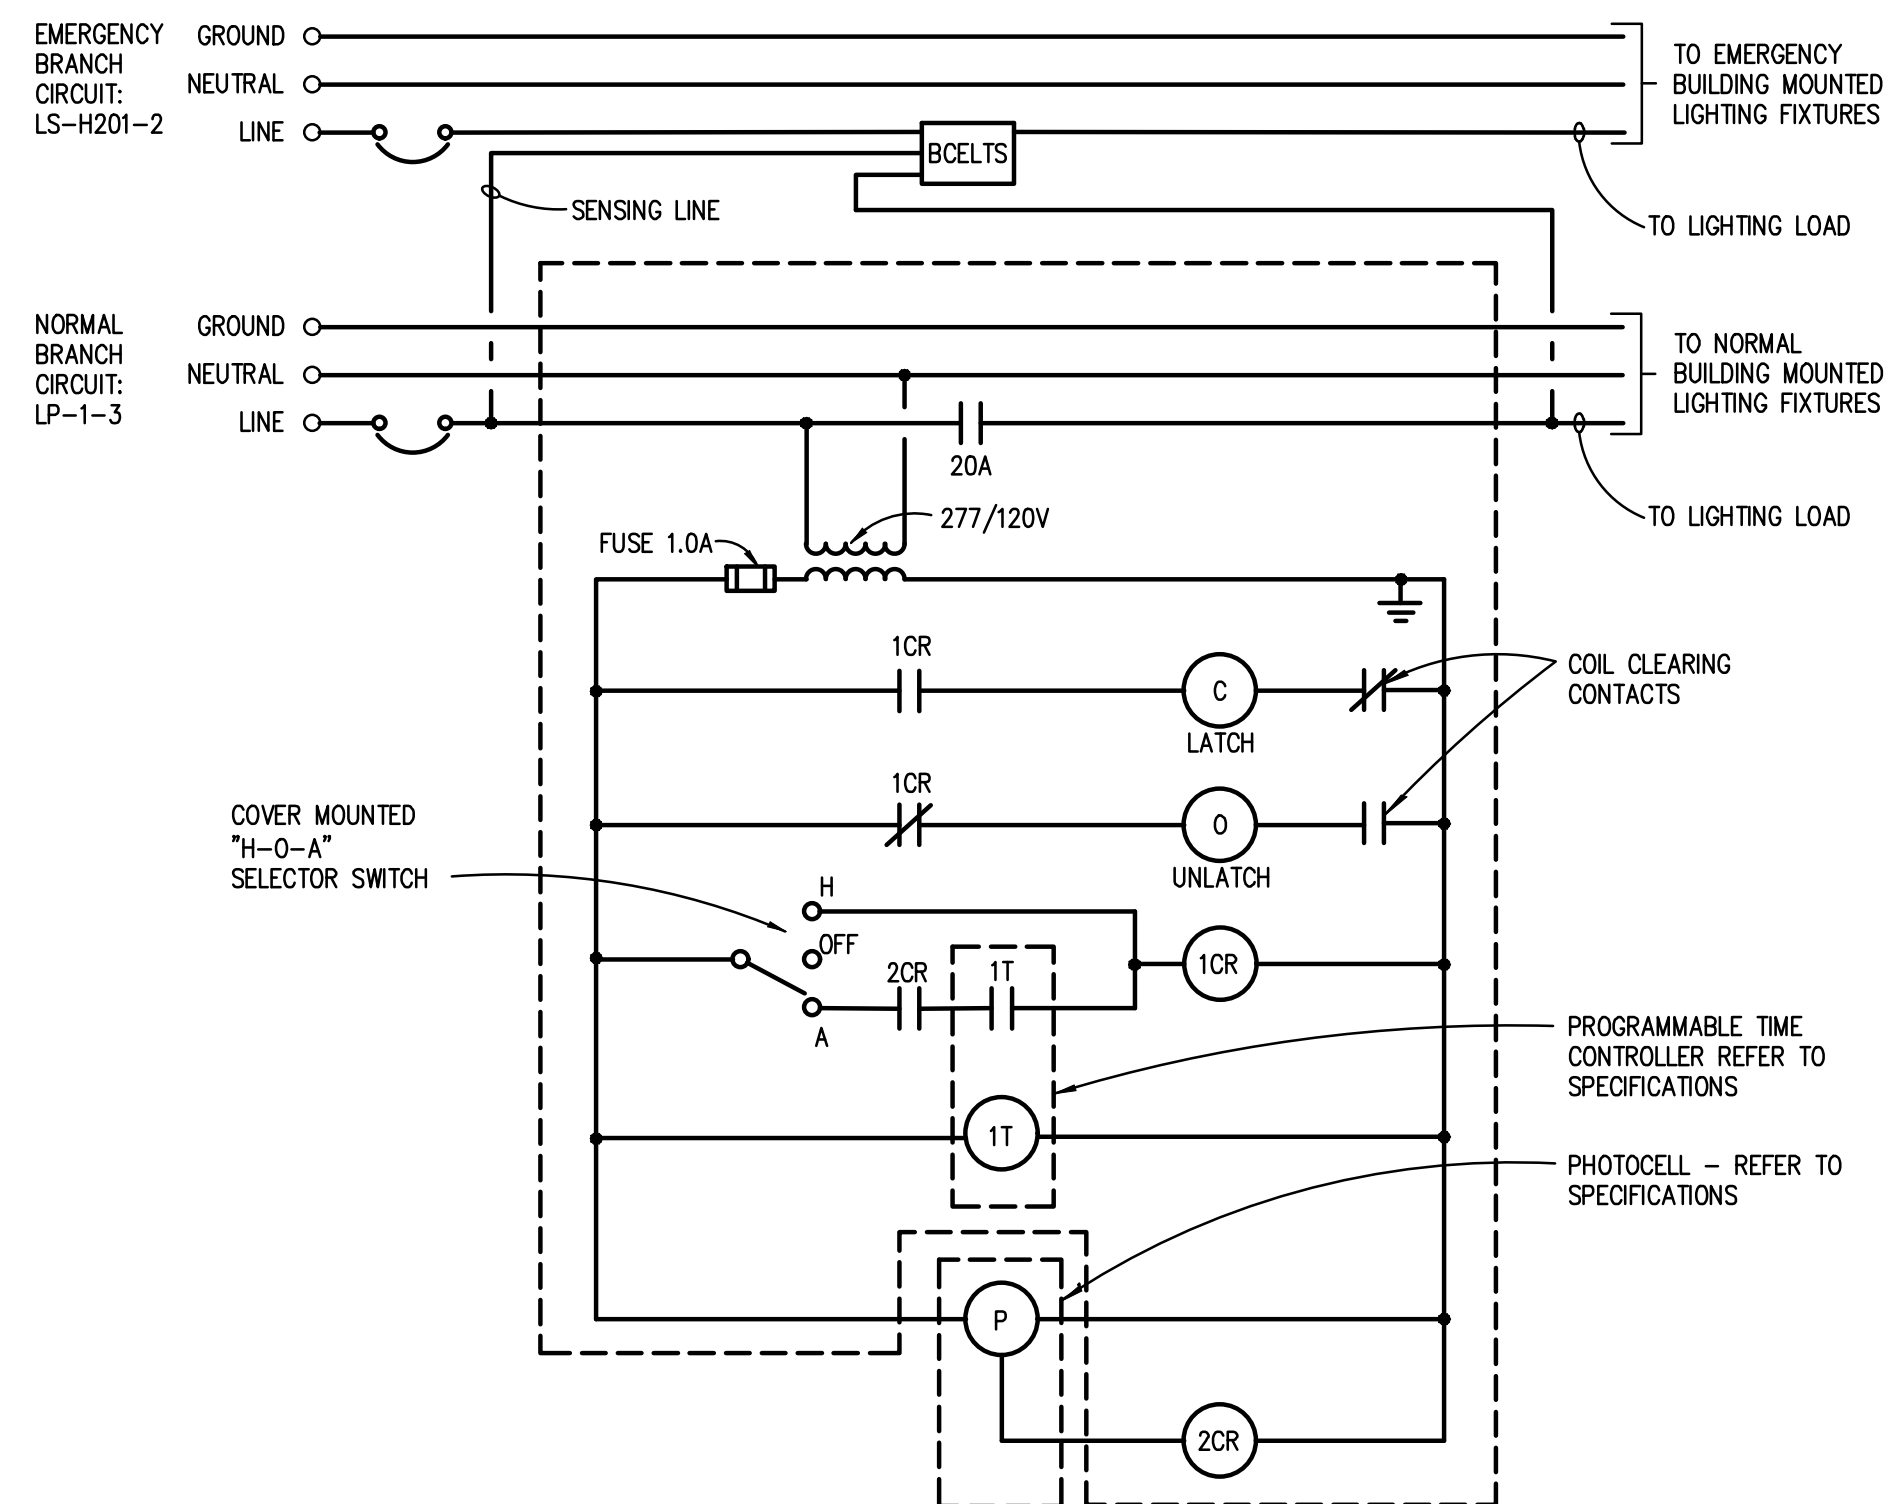


LIGHTING CONTACTOR WITH TIME CLOCK CONTROL AND BCELTS WIRING DIAGRAM
NO SCALE

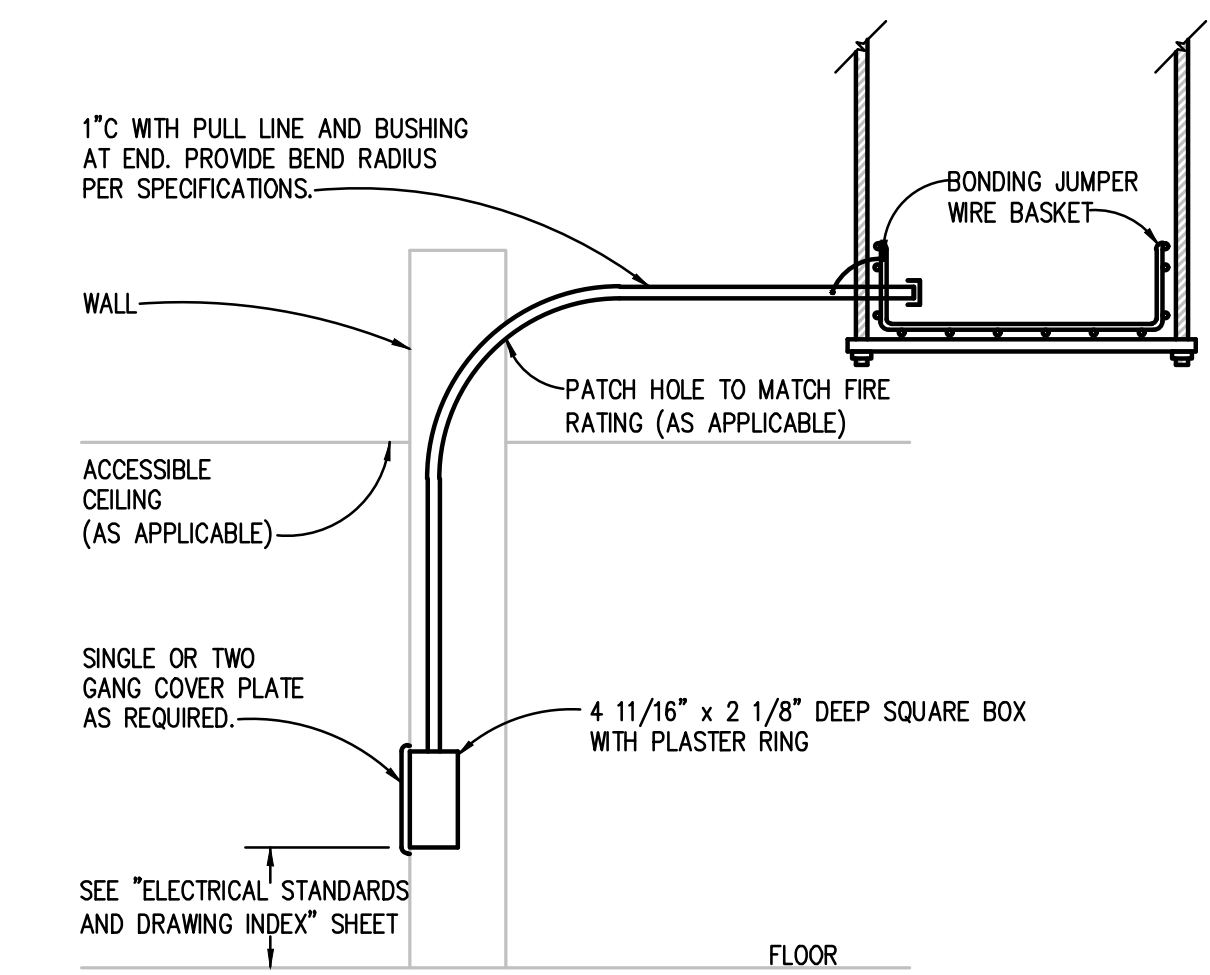


TELECOMMUNICATION OUTLET DETAIL

- NOTES:
1. IF CEILING IN ROOM IS NOT ACCESSIBLE, ROUTE CONDUIT THROUGH NEAREST ACCESSIBLE CEILING TO CABLE/WIRE BASKET TRAY.

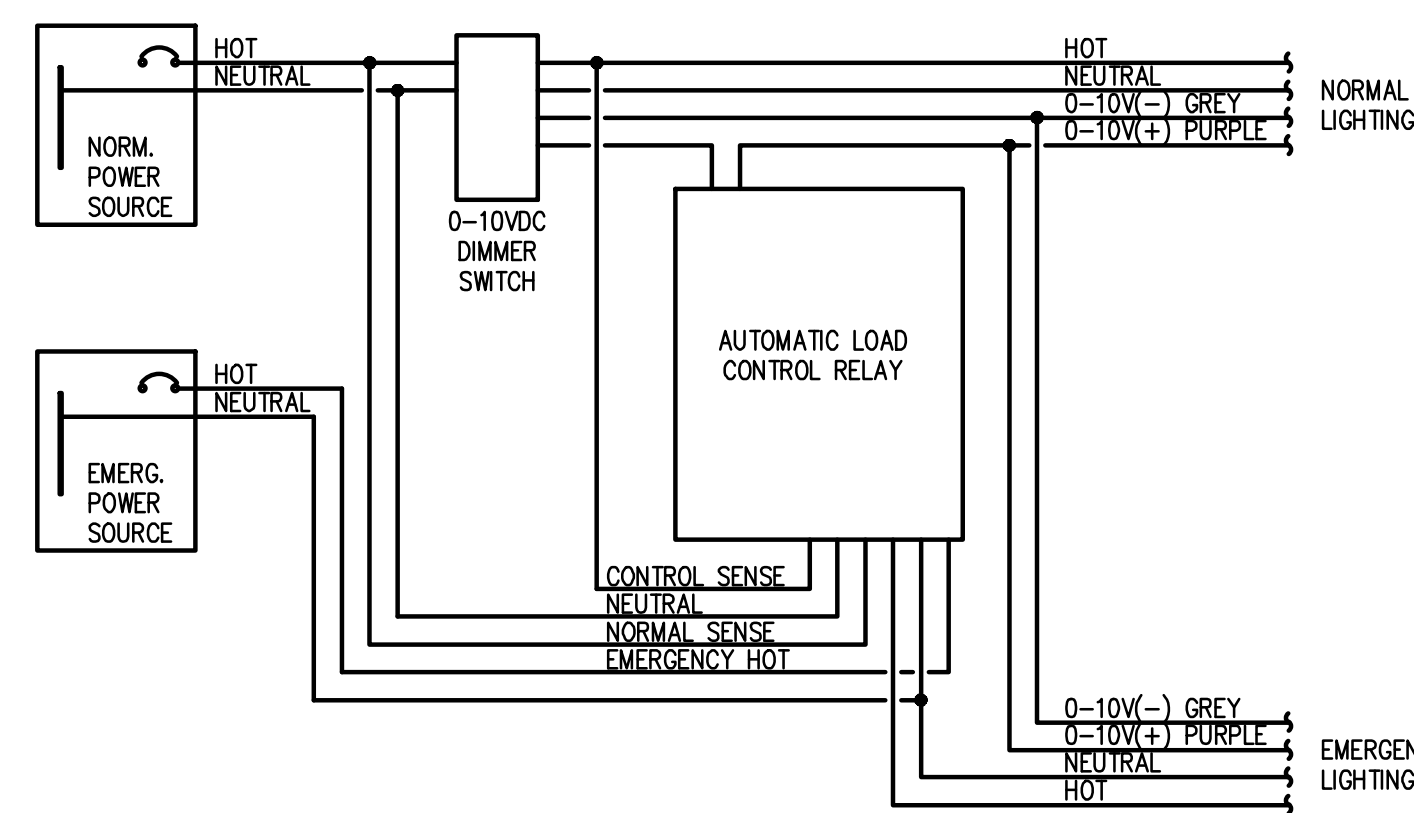

AUTOMATIC LOAD CONTROL RELAY FOR 0-10V DIMMING
NO SCALE

- NOTES:
1. BASIS OF DESIGN IS LVS CONTROLS EPC-2-D. REFER TO SPECIFICATIONS FOR APPROVED MANUFACTURERS. ADJUST WIRING AS NECESSARY FOR OTHER APPROVED MANUFACTURERS.
2. PROVIDE ONE AUTOMATIC LOAD CONTROL RELAY PER SWITCHING CIRCUIT.

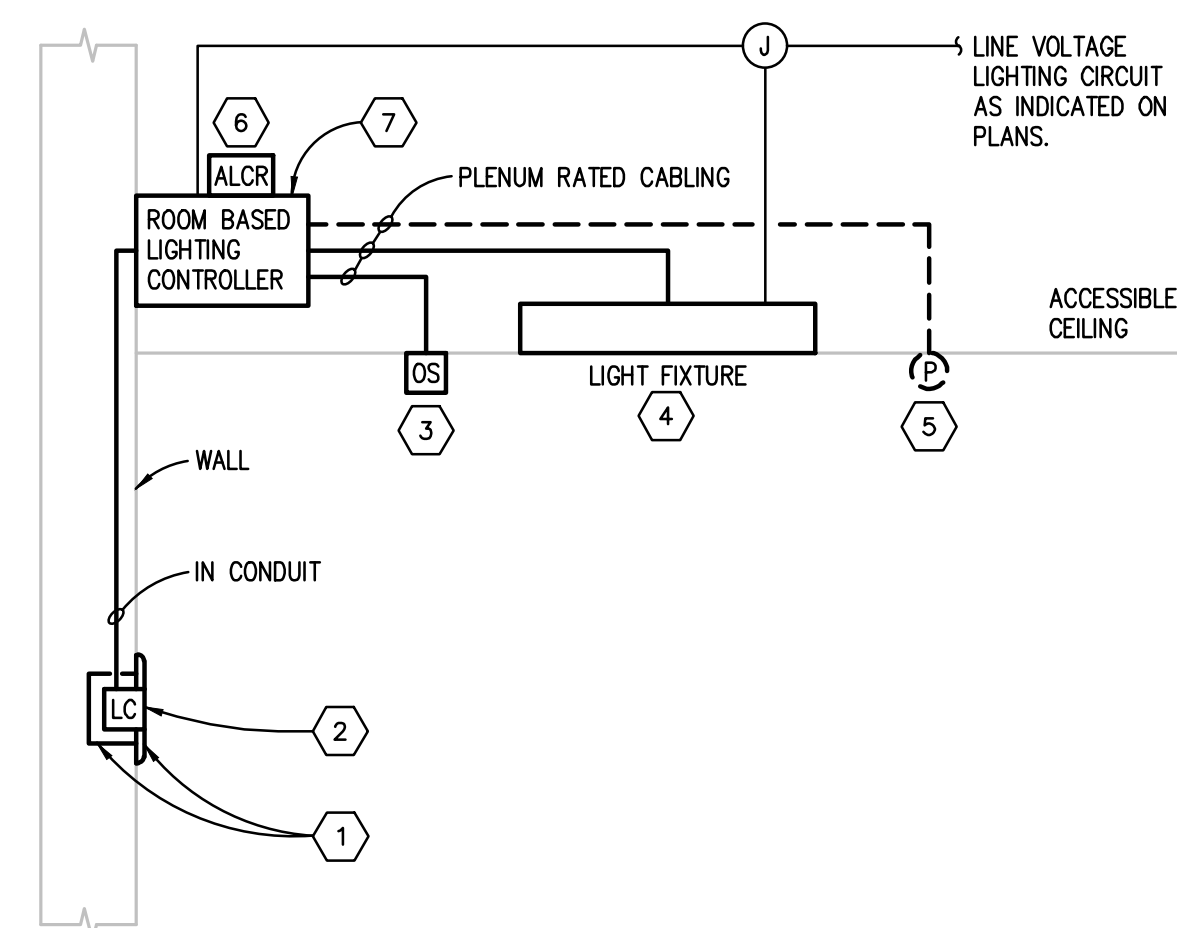


ROOM BASED LIGHTING CONTROL SYSTEM DIAGRAM WIRED - LOW VOLTAGE
NO SCALE


- GENERAL NOTES:
1. REFER TO SPECIFICATIONS FOR ACCEPTED MANUFACTURERS.
2. PROVIDE QUANTITY OF ROOM BASED LIGHTING CONTROLLERS AS REQUIRED TO MEET FUNCTIONALITY INDICATED ON PLAN.
3. REFER TO MANUFACTURER'S INSTALLATION GUIDE FOR EXACT WIRING METHOD, WIRING METHOD AND CONFIGURATION TO BE PER MANUFACTURER'S RECOMMENDATIONS.
4. LOCATE SENSORS IN CENTER OF A FULL CEILING TILE, WHERE APPLICABLE.
5. MOUNTING LOCATION OF SENSORS PER MANUFACTURER'S RECOMMENDATION.
6. REFER TO INTERIOR LIGHTING CONTROL SCHEDULE FOR SYSTEM CONFIGURATIONS SETTINGS. SENSOR ADJUSTMENT: BEFORE MAKING ADJUSTMENTS, MAKE SURE ROOM FURNITURE IS INSTALLED, LIGHTING CIRCUITS ARE TURNED ON, AND THE HVAC SYSTEMS ARE IN THE ON POSITION. VAV SYSTEMS SHOULD BE SET TO THEIR HIGHEST AIRFLOW.

KEYED NOTES:


1. GANG LIGHTING CONTROL DEVICES IN COMMON GANGED BOX. PROVIDE SAME SIZE GANG COVER PLATE FROM THE SAME MANUFACTURER AS THE LIGHTING CONTROL DEVICE AS REQUIRED.
2. LIGHTING CONTROL DEVICE(SWITCH). REFER TO LIGHTING CONTROL DEVICE BUTTON LAYOUT DETAIL FOR ENGRAVING REQUIREMENTS AND PLANS FOR LOCATIONS.
3. CEILING MOUNTED SENSOR. MANUFACTURE TO PROVIDE LAYOUT AND QUANTITIES FOR FULL COVERAGE OF SPACE.
4. REFER TO LIGHTING FIXTURE SCHEDULE. REFER TO PLANS FOR LAYOUT AND QUANTITIES.
5. CEILING MOUNTED PHOTOCELL (AS REQUIRED). REFER TO PLANS FOR PRIMARY AND SECONDARY ZONE CONTROL.
6. PROVIDE ONE AUTOMATIC LOAD CONTROL RELAY PER SWITCHING CIRCUIT WHERE EMERGENCY LIGHTING FROM A GENERATOR OR LIGHTING INVERTER IS INDICATED ON PLANS. REFER TO AUTOMATIC LIGHTING RELAY CONTROL DETAIL.
7. ROOM BASED LIGHTING CONTROLLER TO BE LOCATED IN ACCESSIBLE CEILING ADJACENT TO DOOR DIRECTLY ABOVE LIGHTING CONTROL DEVICE. IF ACCESSIBLE CEILING SPACE IS NOT ACCESSIBLE, AN ACCESS HATCH SHALL BE PROVIDED.

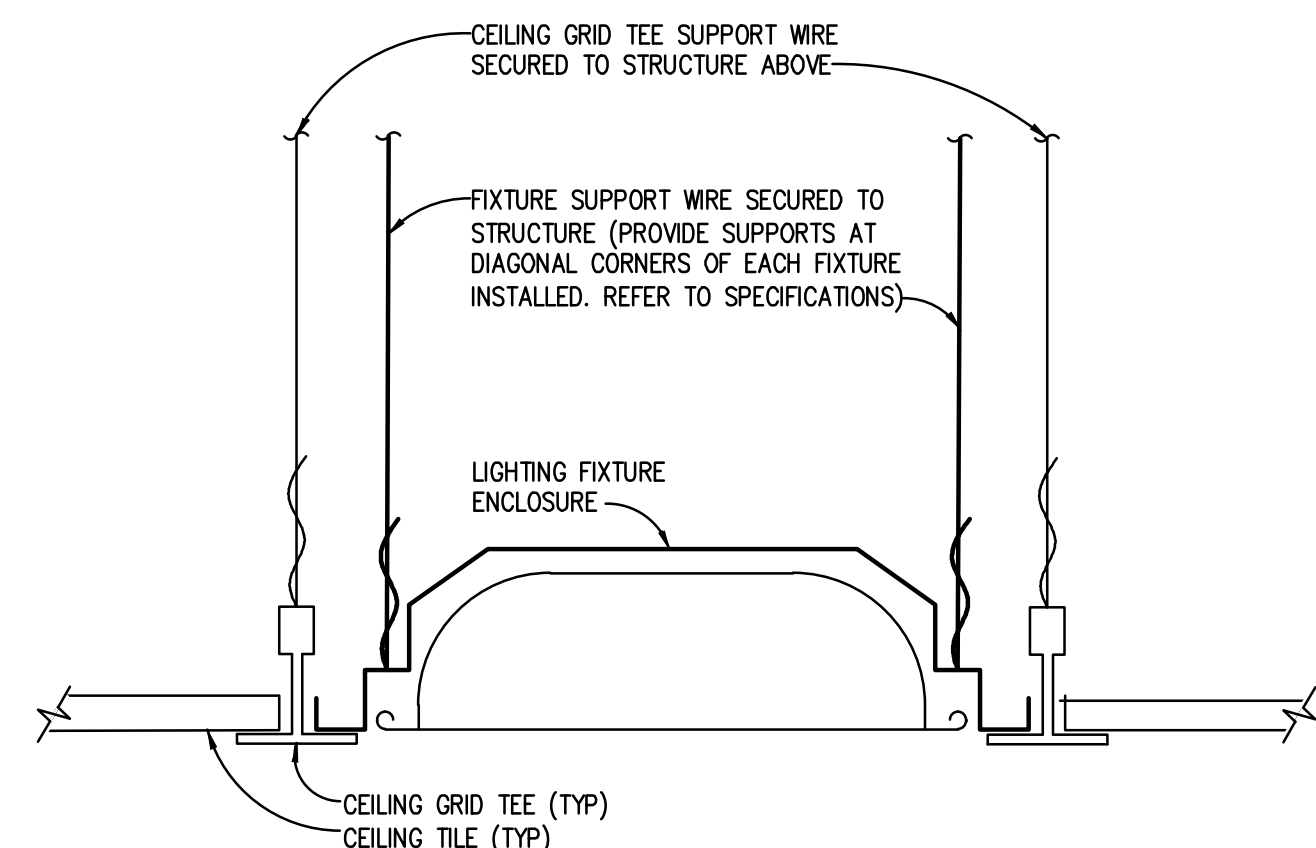

RECESSED LIGHTING FIXTURE INSTALLATION DETAIL
NO SCALE

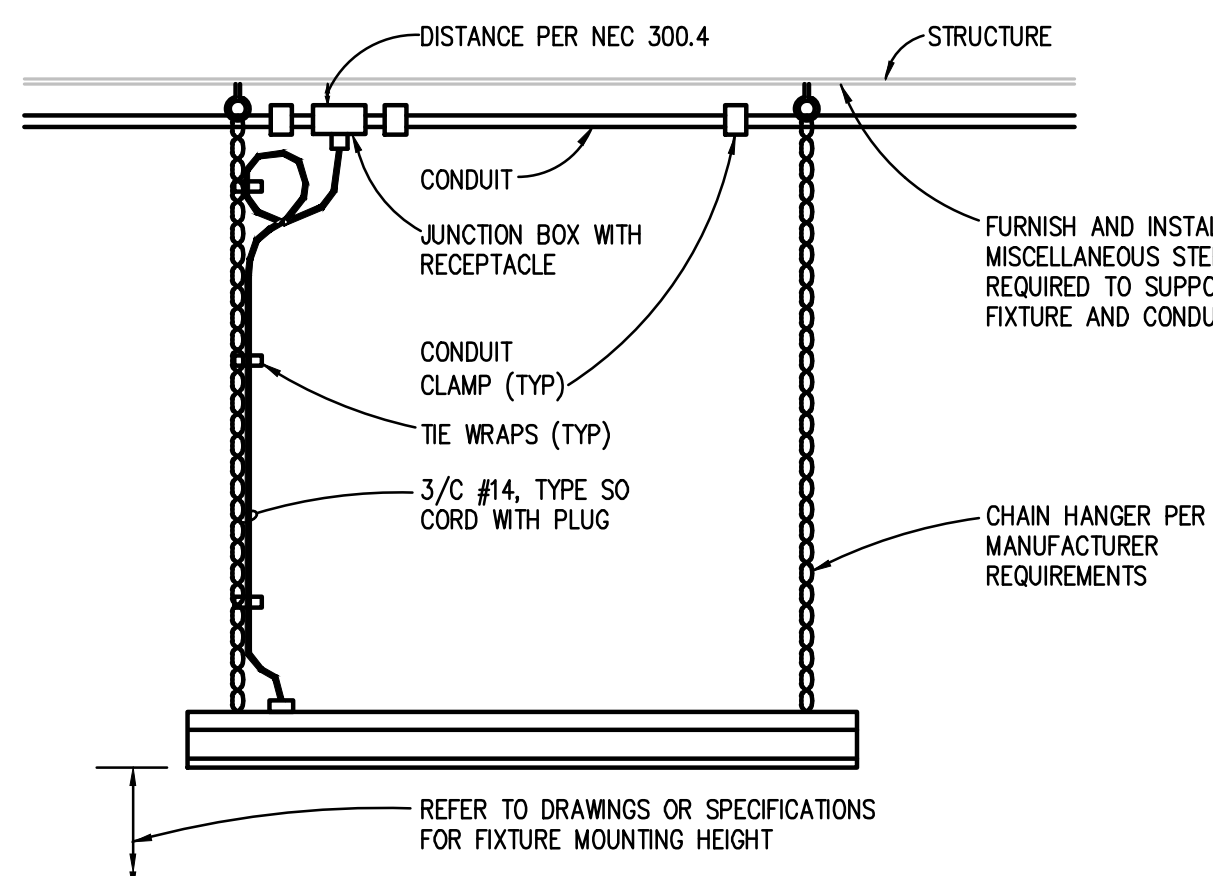


TYPICAL MOUNTING DETAIL FOR CHAIN HUNG LIGHTING FIXTURES
NO SCALE

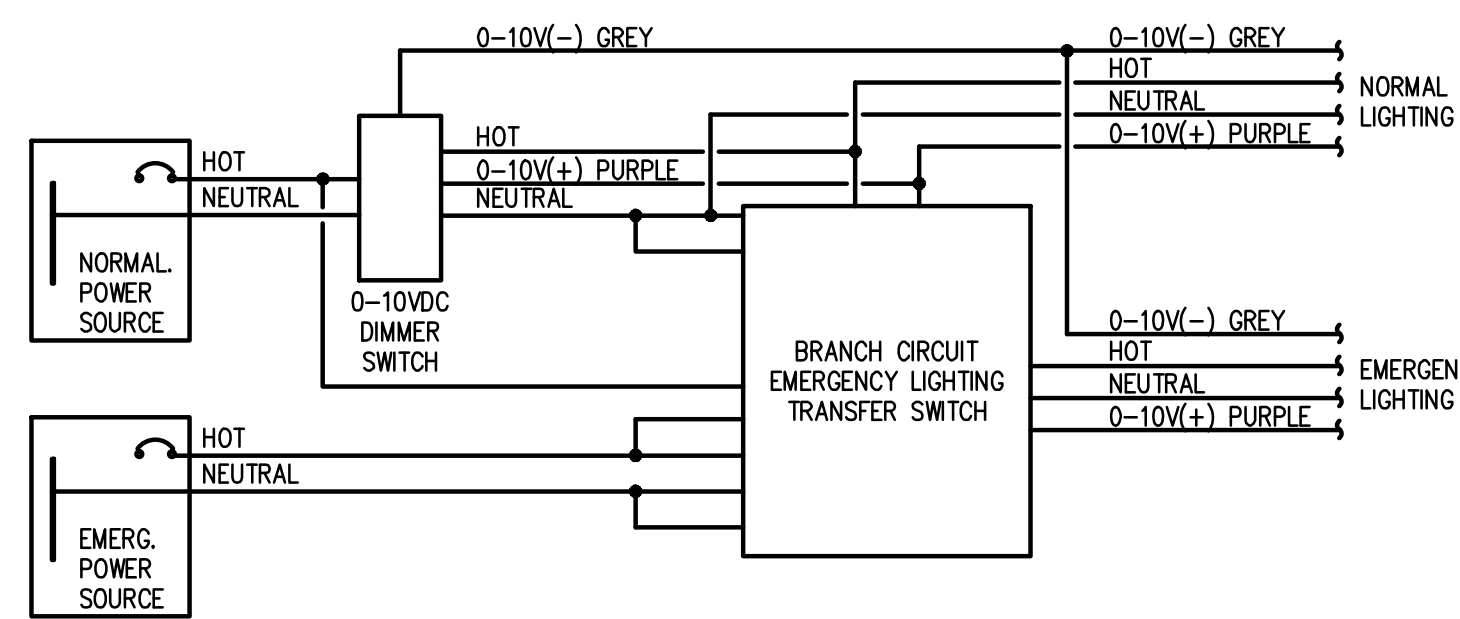

BRANCH CIRCUIT EMERGENCY LIGHTING TRANSFER SWITCH FOR 0-10V DIMMING
NO SCALE

- NOTES:
1. BASIS OF DESIGN IS LVS CONTROLS EPC-D-F-A-TS. REFER TO SPECIFICATIONS FOR APPROVED MANUFACTURERS. ADJUST WIRING AS NECESSARY FOR OTHER APPROVED MANUFACTURERS.
2. PROVIDE ONE BRANCH CIRCUIT EMERGENCY LIGHTING TRANSFER SWITCH PER SWITCHING CIRCUIT.

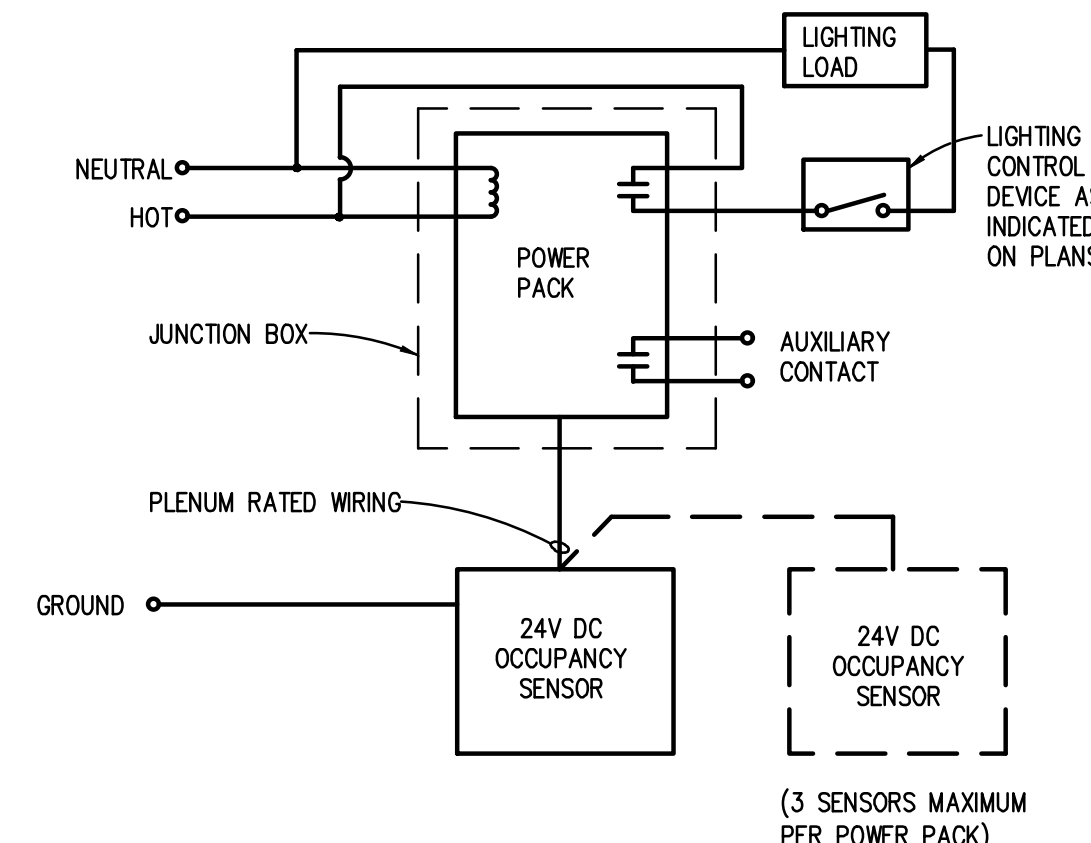

OCCUPANCY SENSOR WIRING DIAGRAM
NO SCALE

- NOTES:
1. REFER TO SPECIFICATIONS FOR ACCEPTED MANUFACTURERS.
2. PROVIDE POWER PACKS AND SLAVE PACKS AS REQUIRED FOR SWITCHING AS INDICATED ON PLAN. REVISE DETAIL AS REQUIRED BY MANUFACTURER.
3. MOUNTING LOCATION PER MANUFACTURER'S RECOMMENDATION.
4. ADJUST SENSITIVITY LEVELS PER THE OWNER REQUIREMENTS.
5. PROVIDE FACTORY SUPPORT FOR AIMING/ADJUSTING OF SENSORS.
6. PLACE CEILING MOUNTED OCCUPANCY SENSORS IN CENTER OF A FULL CEILING TILE, WHERE APPLICABLE.
7. SENSOR ADJUSTMENT: BEFORE MAKING ADJUSTMENTS, MAKE SURE ROOM FURNITURE IS INSTALLED, LIGHTING CIRCUITS ARE TURNED ON, AND THE HVAC SYSTEMS ARE IN THE ON POSITION. VAV SYSTEMS SHOULD BE SET TO THEIR HIGHEST AIRFLOW. SET THE LOGIC CONFIGURATION OF SWITCHES TO EITHER OTHER REQUIRES MOTION DETECTION BY ONLY ONE TECHNOLOGY. SET THE TIME DELAY PER OWNERS DIRECTION.


PLAN REFERENCE	ROOM TYPE	INTERIOR LIGHTING CONTROL SCHEDULE														NOTES		
		LOCAL CONTROL			CONTROL ON / OFF	SENSOR TYPE	TURN ON LIGHTING TO %	BI-LEVEL CONTROL	DAYLIGHT			NO DETECTION PARTIAL OFF (NOTE 10) REDUCE TO (%) AT(MIN)	NO DETECTION FULL OFF (MIN)	TIME-CLOCK SCHEDULE	RECEPTACLE CONTROL		EMERGENCY LIGHTING CIRCUIT CONTROL	CONTACT FOR HVAC CONTROL
		SWITCH TYPE	SWITCH CONTROL	SCENE CONTROL					SIDE LIGHT	TOP LIGHT	MAINTAIN FC LEVEL							
A	FOOD PREPARATION AREA	LOW VOLTAGE	ON-OFF-DIM	NA	MANUAL ON / MANUAL OFF	DUAL TECHNOLOGY	FULL 100%	CONTINUOUS DM	NA	NA	NA	NA	NA	NA	NA	ALCR	NA	
B	STORAGE ROOM (≥50 SQFT AND ≤ 1000 SQFT)	LINE VOLTAGE	ON-OFF	NA	MANUAL ON / SENSOR OFF	DUAL TECHNOLOGY	FULL 100%	NA	NA	NA	NA	NA	20	NA	NA	ALCR	YES	
C	CORRIDOR (IN A HOSPITAL)	LINE VOLTAGE	ON-OFF (KEYED)	NA	SENSOR ON / SENSOR OFF	ULTRASONIC	FULL 100%	NA	NA	NA	NA	NA	20	NA	NA	ALCR	NA	NEW CORRIDOR SHALL BE CONTROLLED SIMILARLY TO EXISTING CORRIDORS
D	DINING AREA (IN CAFETERIA OR FAST FOOD DINING)	LOW VOLTAGE	ON-OFF-DIM	NA	MANUAL ON / SENSOR OFF	DUAL TECHNOLOGY	FULL 100%	CONTINUOUS DM	YES	NA	NA	NA	20	NA	NA	ALCR	YES	
E	OFFICE (ENCLOSED AND ≤ 250 SQFT)	LOW VOLTAGE	ON-OFF-DIM	NA	MANUAL ON / SENSOR OFF	DUAL TECHNOLOGY	FULL 100%	CONTINUOUS DM	NA	NA	NA	NA	20	NA	NA	NA	YES	
F	RESTROOM (ALL OTHER RESTROOMS)	LINE VOLTAGE	ON-OFF	NA	SENSOR ON / SENSOR OFF	ULTRASONIC	FULL 100%	NA	NA	NA	NA	NA	20	NA	NA	ALCR	NA	
G	ELECTRICAL/MECHANICAL ROOM	LINE VOLTAGE	ON-OFF	NA	MANUAL ON / MANUAL OFF	NA	FULL 100%	NA	NA	NA	NA	NA	NA	NA	NA	ALCR	NA	
H	STAIRWELL	LINE VOLTAGE	ON-OFF (KEYED)	NA	SENSOR ON / SENSOR OFF	ULTRASONIC	FULL 100%	NA	NA	NA	NA	NA	20	NA	NA	BCELTS	NA	
I	LOUNGE/BREAKROOM (ALL OTHER LOUNGES/BREAKROOMS)	LOW VOLTAGE	ON-OFF-DIM	NA	MANUAL ON / SENSOR OFF	DUAL TECHNOLOGY	FULL 100%	CONTINUOUS DM	NA	NA	NA	NA	20	NA	NA	NA	NA	
J	CORRIDOR (IN A HOSPITAL)	LINE VOLTAGE	ON-OFF (KEYED)	NA	SENSOR ON / SENSOR OFF	ULTRASONIC	FULL 100%	NA	NA	NA	NA	NA	20	NA	NA	BCELTS	NA	NEW CORRIDOR SHALL BE CONTROLLED SIMILARLY TO EXISTING CORRIDORS

- NOTE:
1. REFER TO PLANS FOR LOCATION OF LOCAL CONTROL.
2. REFER TO PLANS FOR SCENE CONTROL.
3. REFER TO PLANS FOR PRIMARY AND SECONDARY DAYLIGHT ZONES.
4. PROVIDE EMERGENCY LIGHTING CIRCUIT CONTROL (BCELTS OR ALCR) PER SWITCHING CIRCUIT AS REQUIRED.
5. CONTRACTOR SHALL PROVIDE FLOOR PLAN INDICATING SENSOR AND EQUIPMENT LOCATIONS OF CHOSEN CONTROL SYSTEM.

6. REFER TO LUMINAIRE SCHEDULE FOR FIXTURE CHARACTERISTICS.
7. LIGHTING SENSOR SHALL HAVE CONTACT FOR HVAC CONTROL WHEN A "YES" SELECTION IS MADE IN THE HVAC CONTROL COLUMN.
8. REFER TO TEMPERATURE CONTROL DRAWINGS AND DIAGRAMS FOR ADDITIONAL SENSOR REQUIREMENTS.
9. PROVIDE WIRING CONTROL DIAGRAM FOR APPLICABLE CONTROL SYSTEM(S).
10. PERCENTAGE LIGHT OUTPUT REDUCTION IS FOR ALL FIXTURES WITHIN THE DESIGNATED ROOM UNLESS OTHERWISE NOTED.

NA = NOT APPLICABLE


©Copyright 2017 by Peter Basso Associates, Inc.

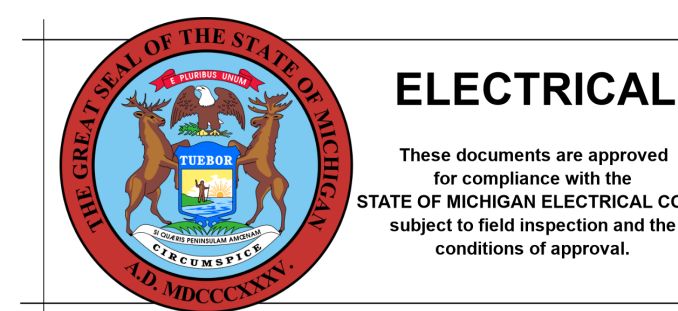

ELECTRICAL

These documents are approved for compliance with the STATE OF MICHIGAN ELECTRICAL CODE subject to field inspection and the conditions of approval.

PANELBOARD FRONT COVER DETAIL
NO SCALE

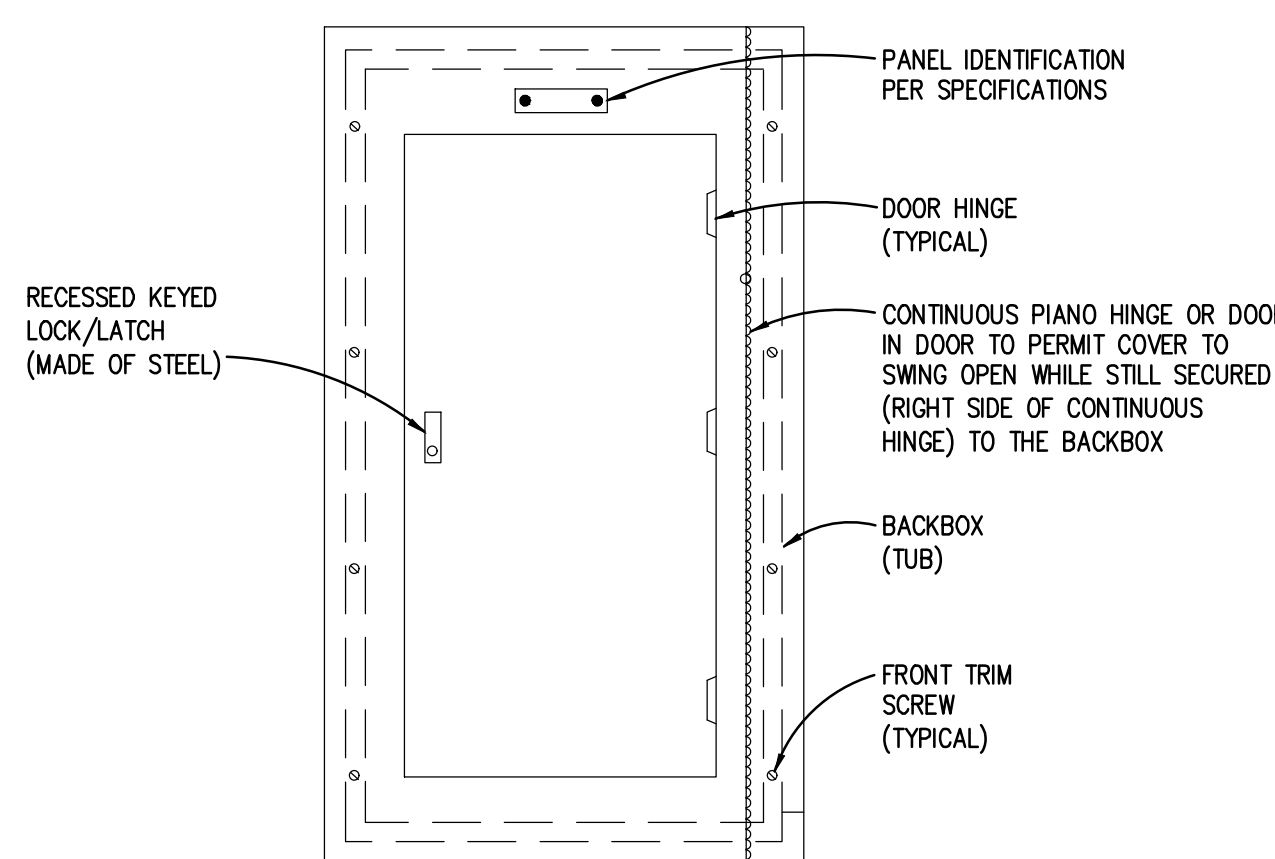

1	OWNER REVIEW	08/02/23
---	--------------	----------

STATE OF MICHIGAN
DEPARTMENT OF TECHNOLOGY, MANAGEMENT AND BUDGET
FACILITIES AND BUSINESS SERVICES ADMINISTRATION
DESIGN AND CONSTRUCTION DIVISION
ADAM LACH, RA, DIRECTOR

FILE NO.
49120167.SDW

FUNDING CODE
171CODHHS7255

CONTRACT NO.
Y22003

WTAARCH.COM
WTA ARCHITECTS
100 S. Jefferson Ave., Suite 601
Saginaw, Michigan 48607
989 752 8107
COPYRIGHT © 2023

PROJECT TITLE
49120167.SDW - PHASE 500:
CENTER FOR FORENSIC
PSYCHIATRY - CREATE
KITCHEN
SALINE, MICHIGAN

SHEET TITLE
**ELECTRICAL DETAILS AND
DIAGRAMS**


PROJECT NUMBER
2021094

PROJECT DATE
AUGUST 23, 2023

SHEET NUMBER
E7.00


CHECKED BY
TLC

PBA
Peter Basso Associates Inc
CONSULTING ENGINEERS
5145 Livernois, Suite 100
Troy, Michigan 48068-3276
Tel: 248-879-5666
Fax: 248-879-0007
www.PeterBassoAssociates.com
PBA-Project No. 2021094

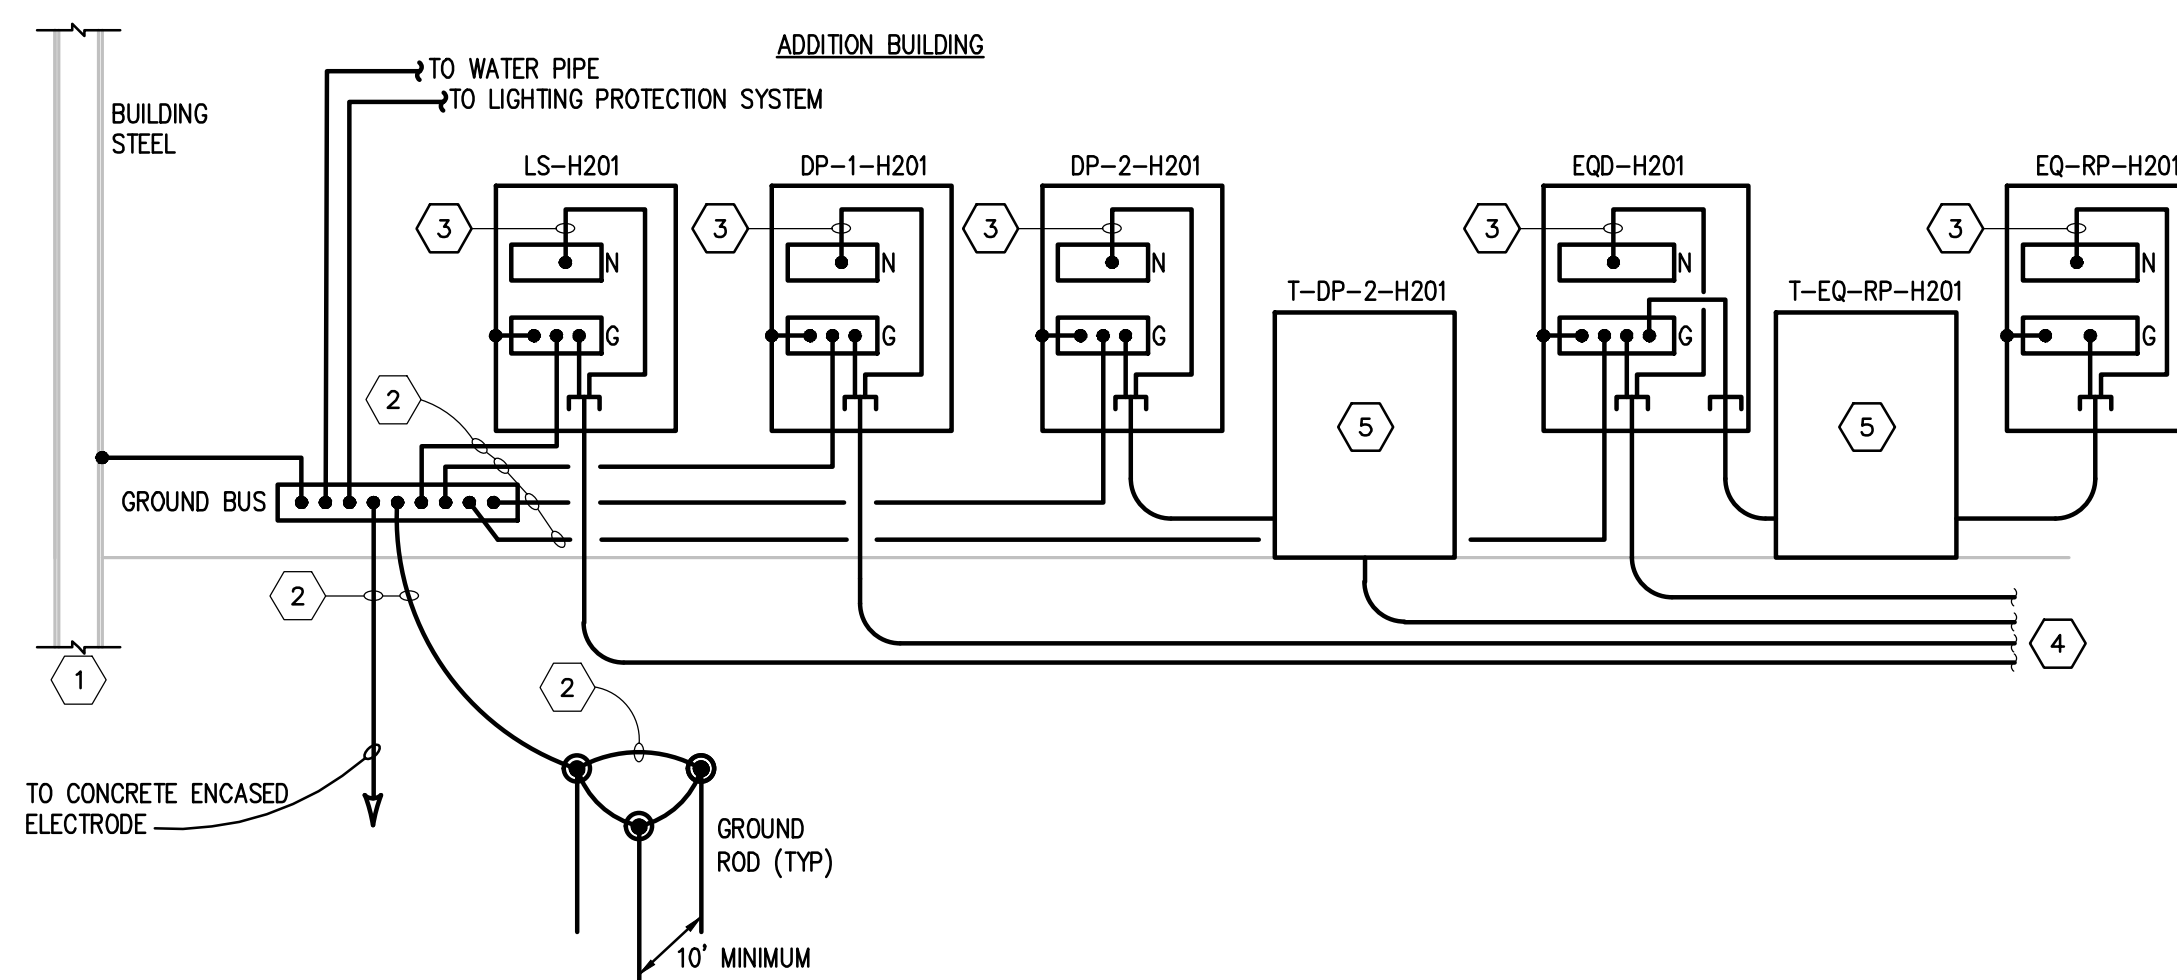


BUILDING GROUNDING
NO SCALE

- KEYED NOTES:**
- METAL IN-GROUND SUPPORT STRUCTURE IN DIRECT CONTACT WITH EARTH VERTICALLY FOR A MINIMUM OF 10FT, WHERE AVAILABLE.
 - GROUNDING ELECTRODE CONDUCTOR, #4/0 COPPER.
 - GROUNDING CONDUCTOR (NEUTRAL), SEE ONE LINE DIAGRAM.
 - PHASE CONDUCTORS, GROUNDING CONDUCTOR (NEUTRAL), AND EQUIPMENT GROUNDING CONDUCTOR IN CONDUIT TO MAIN BUILDING. SEE ONE LINE DIAGRAM.
 - REFER TO DRY TYPE DISTRIBUTION TRANSFORMER GROUNDING ARRANGEMENT.

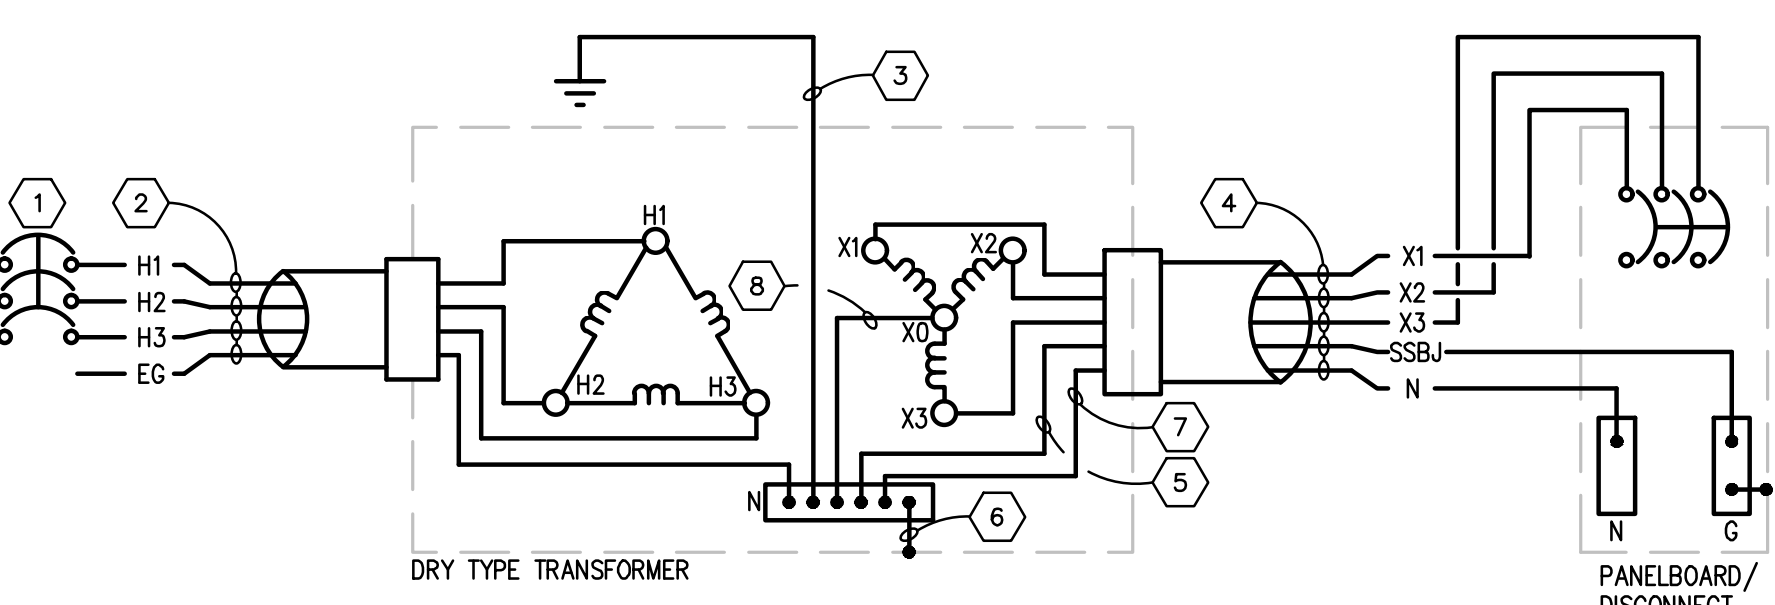


DRY TYPE DISTRIBUTION TRANSFORMER GROUNDING ARRANGEMENT
NO SCALE

- KEYED NOTES:**
- 480V, 3Ø PRIMARY CIRCUIT BREAKER BASED ON DRY TYPE DISTRIBUTION TRANSFORMER CIRCUIT SIZING SCHEDULE ON ELECTRICAL STANDARD SCHEDULE DRAWING UNLESS OTHERWISE NOTED.
 - PRIMARY FEEDER BASED ON FEEDER AND BRANCH CIRCUIT SIZING TABLE ON ELECTRICAL STANDARD SCHEDULE DRAWING UNLESS OTHERWISE NOTED.
 - GROUNDING ELECTRODE CONDUCTOR TO NEAREST GROUNDING ELECTRODE (I.E. BUILDING STEEL, METAL WATER PIPE, GROUND RING, OR GROUND BUS). SEE DRY TYPE DISTRIBUTION TRANSFORMER CIRCUIT SIZING SCHEDULE ON ELECTRICAL STANDARD SCHEDULE DRAWING FOR SIZE UNLESS OTHERWISE NOTED.
 - 208Y/120V, 3Ø, 4W SECONDARY FEEDER BASED ON DRY TYPE DISTRIBUTION TRANSFORMER CIRCUIT SIZING SCHEDULE ON ELECTRICAL STANDARD SCHEDULE DRAWING UNLESS OTHERWISE NOTED.
 - SUPPLY SIDE BONDING JUMPER.
 - SYSTEM BONDING JUMPER.
 - GROUNDING CONDUCTOR (NEUTRAL).
 - NEUTRAL CONDUCTOR PROVIDED WITH EQUIPMENT.

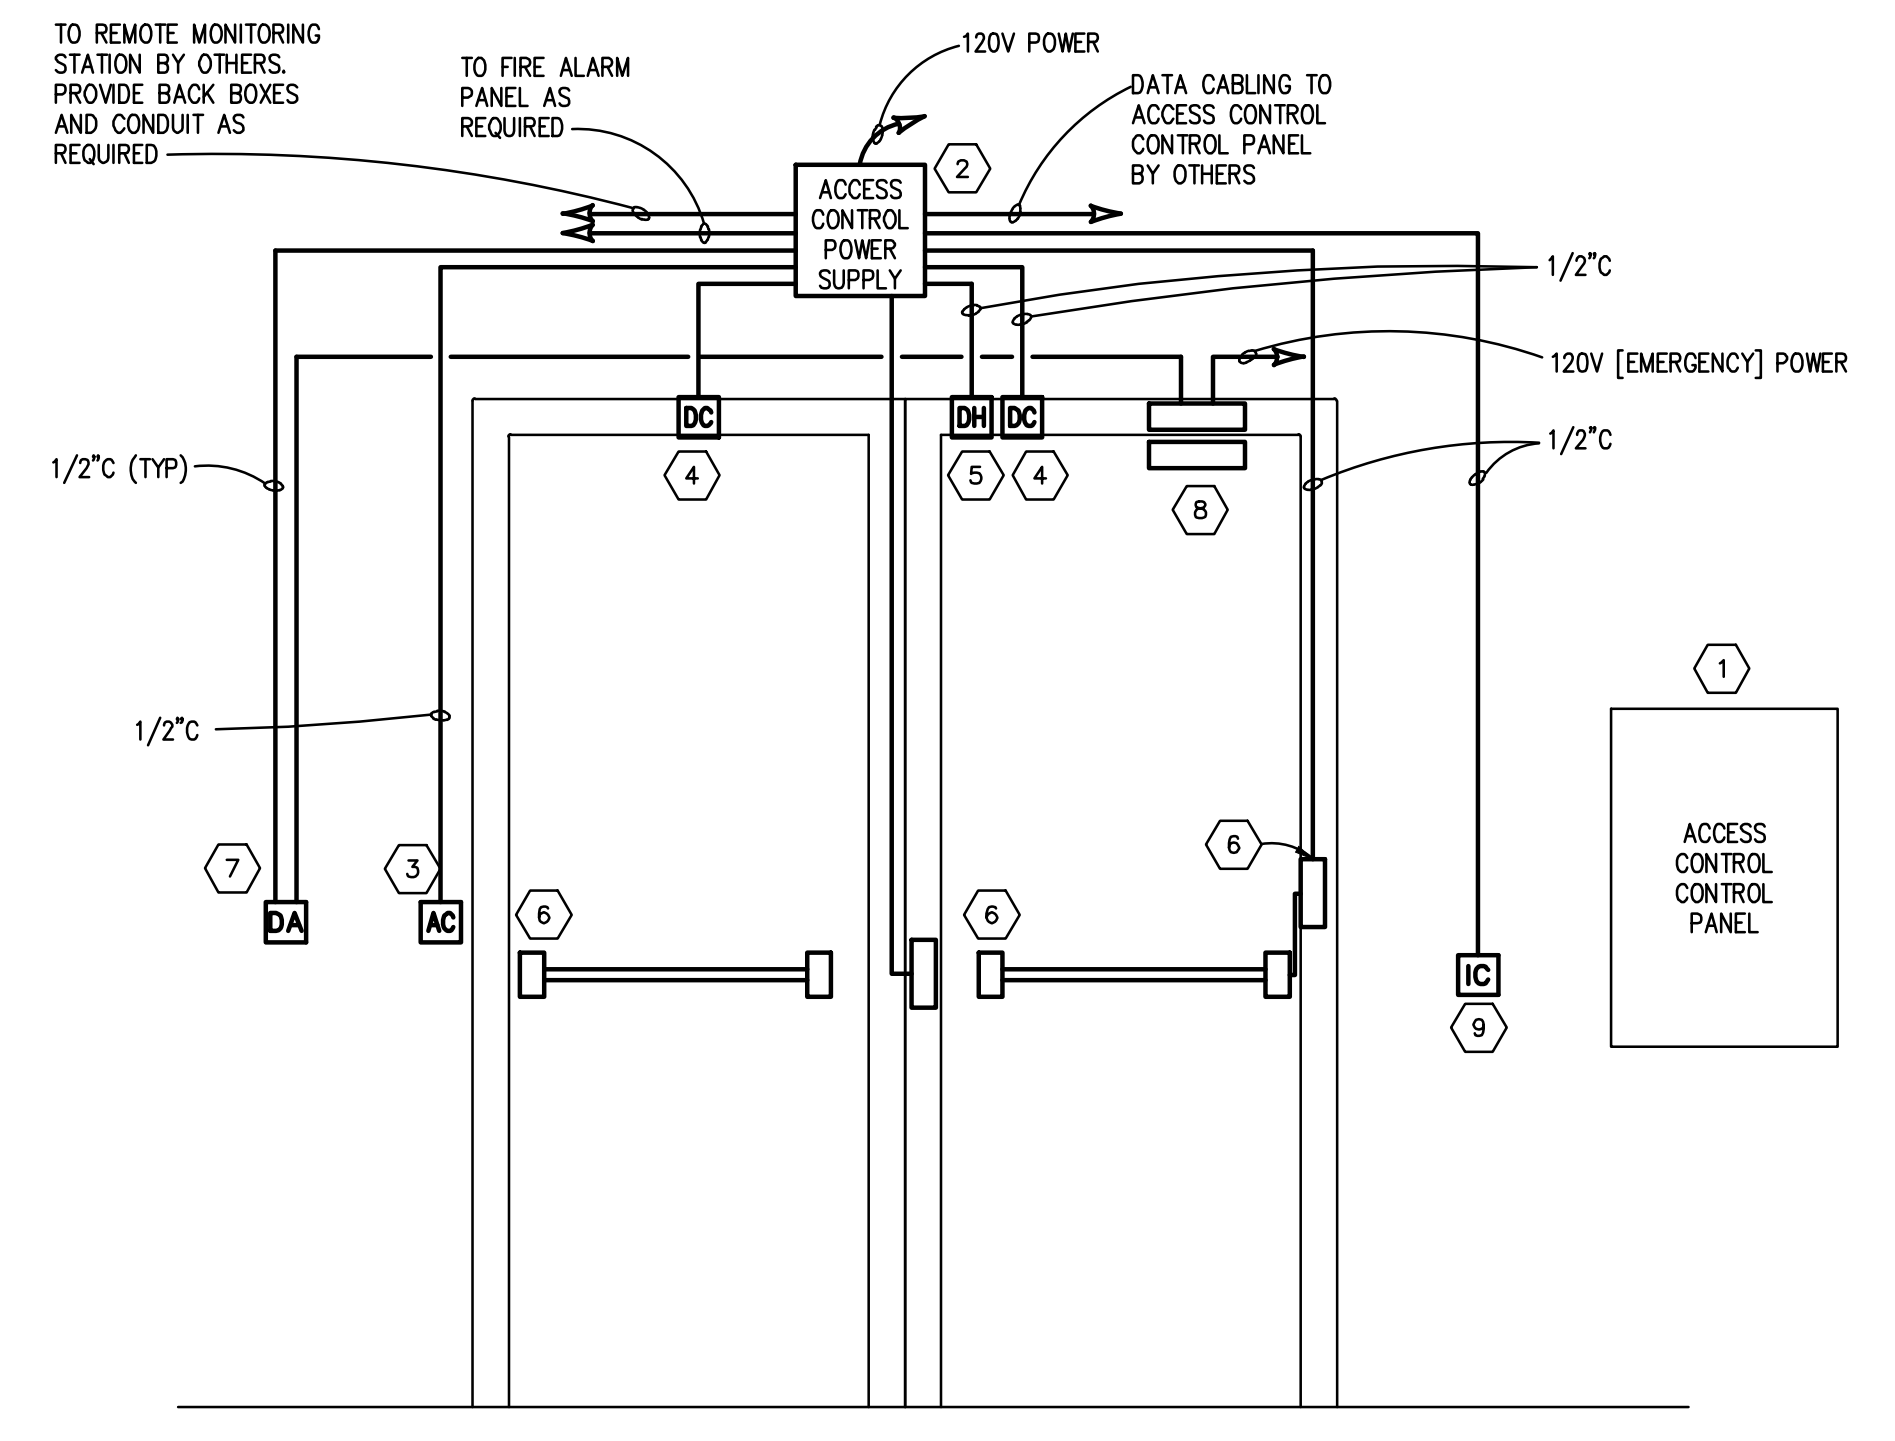


DOOR HARDWARE DOUBLE DOOR CONNECTION DIAGRAM
NO SCALE

- GENERAL NOTES:**
- REFER TO ELECTRICAL FLOOR PLANS FOR DOOR LOCATIONS.
 - ACCESS CONTROL POWER SUPPLY, BY OTHERS.
 - ACCESS CONTROL STATION, BY OTHERS. (EXAMPLE DEVICES: CARD READER, KEYPAD, REQUEST TO EXIT PUSH PAD, MOTION DETECTOR, ETC.)
 - DOOR MONITOR CONTACT SWITCH, BY OTHERS.
 - DOOR HOLDER, BY OTHERS. ELECTROMAGNETIC SWITCH MOUNTED ON/IN DOOR AND FRAME. [FOR DELAYED OPERATION] IN LIEU OF ELECTRIC STRIKE.
 - ELECTRIC STRIKE, PANIC HARDWARE, POWER TRANSFER, BY OTHERS.
 - DOOR OPERATOR ACTUATOR, BY OTHERS.
 - DOOR OPERATOR, BY OTHERS. (EXAMPLE DEVICES: PUSH PAD, TOUCHLESS, ETC.)
 - INTERCOM STATION, BY OTHERS.
- KEYED NOTES:**
- ACCESS CONTROL CONTROL PANEL, BY OTHERS.
 - ACCESS CONTROL POWER SUPPLY, BY OTHERS.
 - ACCESS CONTROL STATION, BY OTHERS. (EXAMPLE DEVICES: CARD READER, KEYPAD, REQUEST TO EXIT PUSH PAD, MOTION DETECTOR, ETC.)
 - DOOR MONITOR CONTACT SWITCH, BY OTHERS.
 - DOOR HOLDER, BY OTHERS. ELECTROMAGNETIC SWITCH MOUNTED ON/IN DOOR AND FRAME. [FOR DELAYED OPERATION] IN LIEU OF ELECTRIC STRIKE.
 - ELECTRIC STRIKE, PANIC HARDWARE, POWER TRANSFER, BY OTHERS.
 - DOOR OPERATOR ACTUATOR, BY OTHERS.
 - DOOR OPERATOR, BY OTHERS. (EXAMPLE DEVICES: PUSH PAD, TOUCHLESS, ETC.)
 - INTERCOM STATION, BY OTHERS.

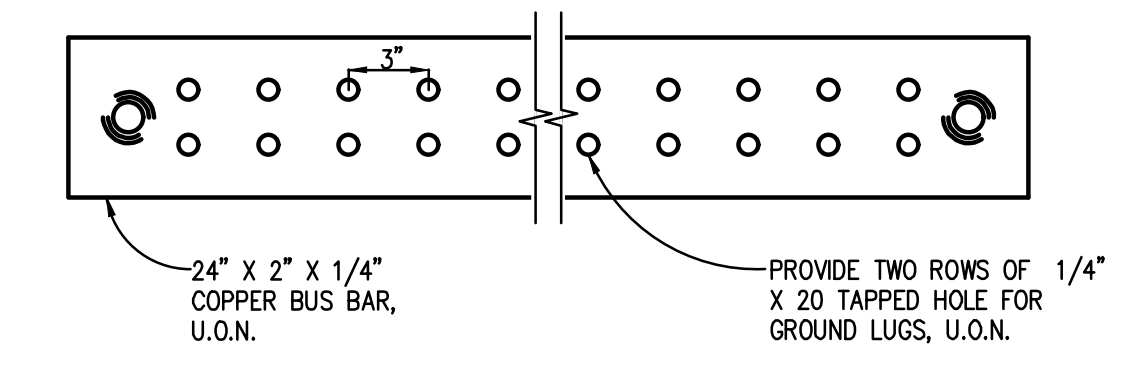


ELECTRICAL GROUND BUS DETAIL
NO SCALE

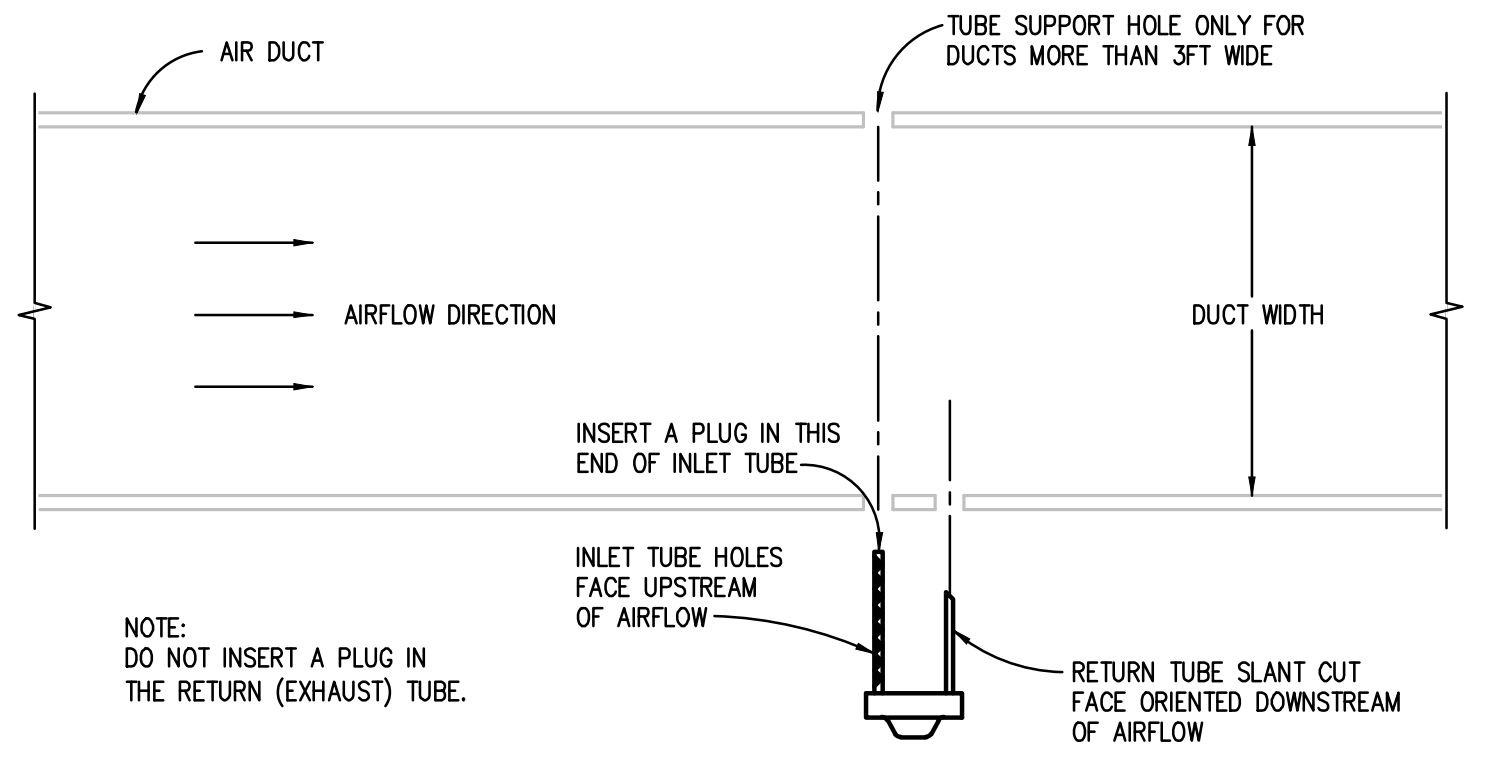


DUCT TYPE DETECTOR INSTALLATION
NO SCALE

- NOTES:**
- PROVIDE SAMPLING TUBE LENGTH AS REQUIRED FOR WIDTH OF DUCT.

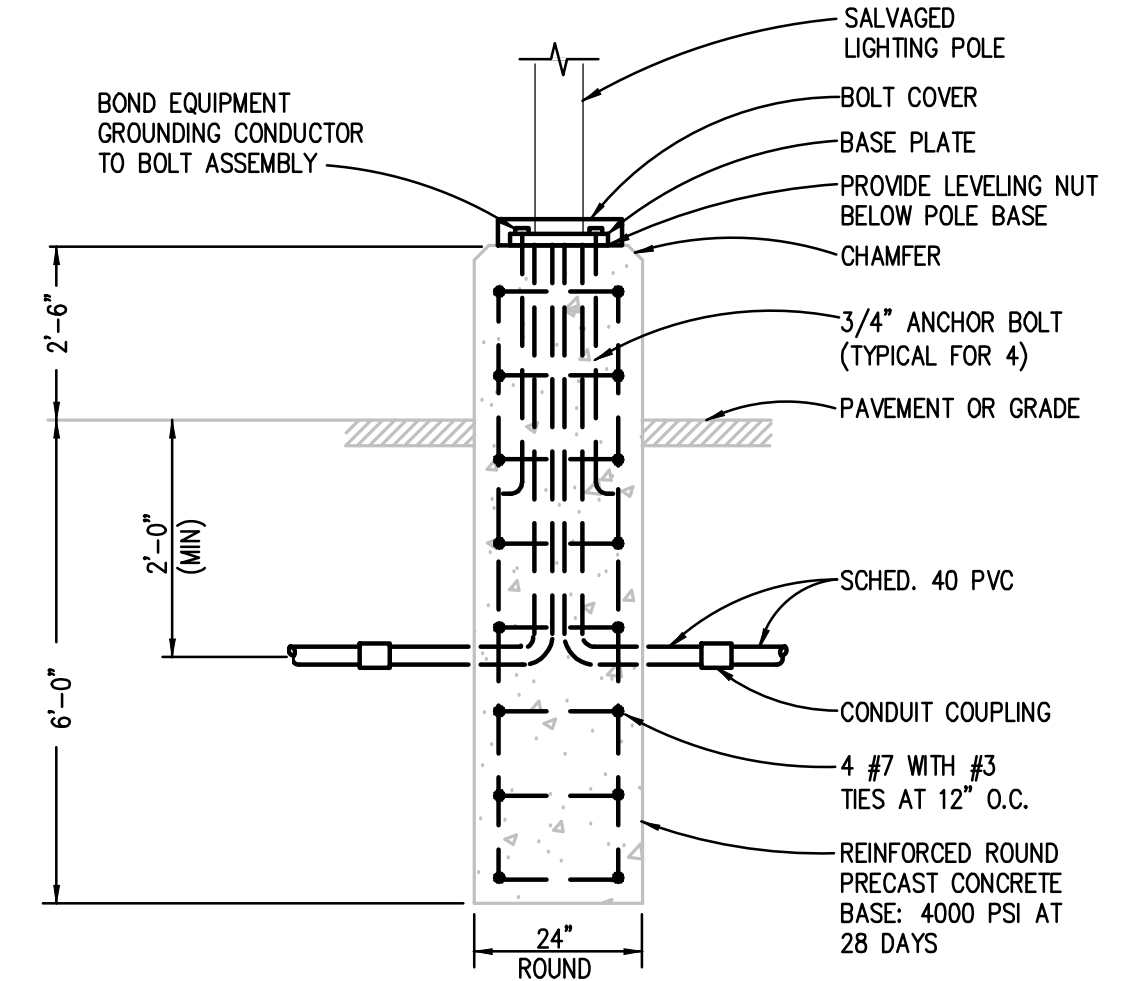

LIGHTING POLE BASE DETAIL
NO SCALE

- NOTE:**
- PROVIDE PRECAST CONCRETE BASE AS MANUFACTURED BY NORTHERN CONCRETE PIPE, INC. OR APPROVED EQUAL.
 - CONCRETE REINFORCEMENTS SHALL BE BARE, ZINC GALVANIZED, OR ELECTRICALLY CONDUCTIVE COATED STEEL. BOND ALL CONCRETE REINFORCEMENTS AND ANCHOR BOLTS TOGETHER SO THAT SYSTEM IS ELECTRICALLY CONTINUOUS.

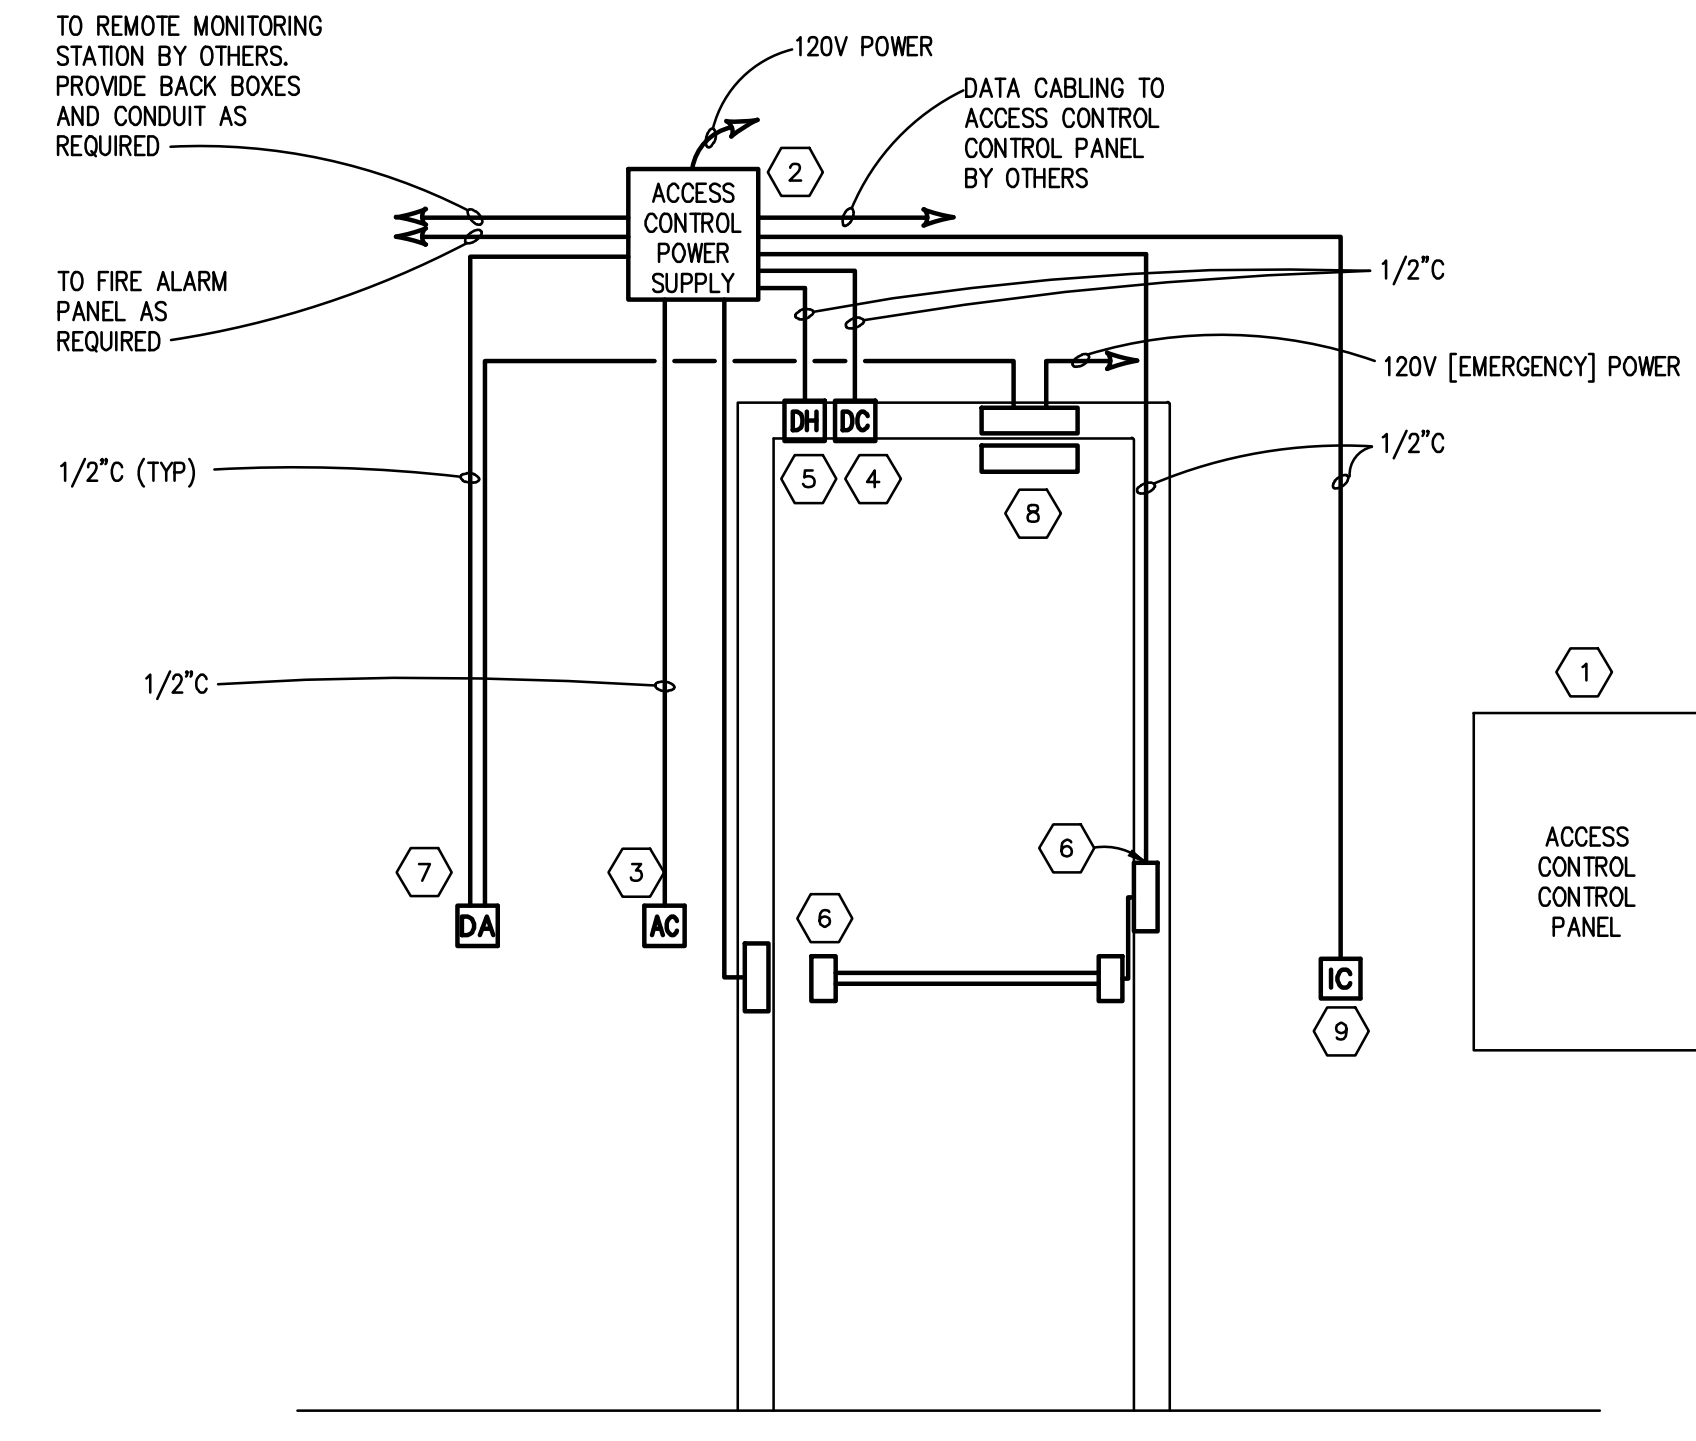


DOOR HARDWARE SINGLE DOOR CONNECTION DIAGRAM
NO SCALE

- GENERAL NOTES:**
- REFER TO ELECTRICAL FLOOR PLANS FOR DOOR LOCATIONS.
 - PROVIDE BACK BOXES, CONDUIT, 120 VOLT WIRING AND TERMINATIONS AS REQUIRED BY MANUFACTURER. COORDINATE EXACT REQUIREMENTS AND SCOPE OF WORK WITH OWNER AND ACCESS CONTROL CONTRACTOR.
 - SOME DEVICES INDICATED MAY NOT APPLY. REFER TO DOOR HARDWARE AND DOOR SCHEDULE. COORDINATE ALL WORK WITH HARDWARE CONTRACTOR.
 - ELECTRICAL CONTRACTOR SHALL PROVIDE INTERCONNECTION WITH FIRE ALARM PANEL TO RELEASE DOORS (I.E. ELECTROMAGNETIC LOCKS) UPON AN ALARM CONDITION, AS REQUIRED.
- KEYED NOTES:**
- ACCESS CONTROL CONTROL PANEL, BY OTHERS.
 - ACCESS CONTROL POWER SUPPLY, BY OTHERS.
 - ACCESS CONTROL STATION, BY OTHERS. (EXAMPLE DEVICES: CARD READER, KEYPAD, REQUEST TO EXIT PUSH PAD, MOTION DETECTOR, ETC.)
 - DOOR MONITOR CONTACT SWITCH, BY OTHERS.
 - DOOR HOLDER, BY OTHERS. ELECTROMAGNETIC SWITCH MOUNTED ON/IN DOOR AND FRAME. [FOR DELAYED OPERATION] IN LIEU OF ELECTRIC STRIKE.
 - ELECTRIC STRIKE, PANIC HARDWARE, POWER TRANSFER, BY OTHERS.
 - DOOR OPERATOR ACTUATOR, BY OTHERS.
 - DOOR OPERATOR, BY OTHERS. (EXAMPLE DEVICES: PUSH PAD, TOUCHLESS, ETC.)
 - INTERCOM STATION, BY OTHERS.


	SYSTEM OUTPUTS										
	ANNUNCIATION			NOTIFICATION				FIRE SAFETY			
IDENTIFY ALARM AT FACP	●	●	●	●	●	●	●	●	●	●	●
ANNUNCIATE SUPERVISORY SIGNAL AT FACP	●	●	●	●	●	●	●	●	●	●	●
ANNUNCIATE SUPERVISORY SIGNAL AT REMOTE ANNUNCIATOR(S)	●	●	●	●	●	●	●	●	●	●	●
ANNUNCIATE TROUBLE SIGNAL AT FACP	●	●	●	●	●	●	●	●	●	●	●
ANNUNCIATE TROUBLE SIGNAL AT REMOTE ANNUNCIATOR(S)	●	●	●	●	●	●	●	●	●	●	●
ACTIVATE ALARM SEQUENCE ON EXISTING FACP	●	●	●	●	●	●	●	●	●	●	●
OPERATE ALARM NOTIFICATION APPLIANCES CONTINUOUSLY	●	●	●	●	●	●	●	●	●	●	●
ACTIVATE VOICE/ALARM COMMUNICATION SYSTEM	●	●	●	●	●	●	●	●	●	●	●
TRANSMIT ALARM SIGNAL TO REMOTE ALARM RECEIVING STATION	●	●	●	●	●	●	●	●	●	●	●
TRANSMIT SUPERVISORY SIGNAL TO REMOTE ALARM RECEIVING STATION	●	●	●	●	●	●	●	●	●	●	●
TRANSMIT TROUBLE SIGNAL TO REMOTE ALARM RECEIVING STATION	●	●	●	●	●	●	●	●	●	●	●
TRANSMIT ALARM SIGNAL TO BUILDING AUTOMATION SYSTEM	●	●	●	●	●	●	●	●	●	●	●
TRANSMIT TROUBLE SIGNAL TO BUILDING AUTOMATION SYSTEM	●	●	●	●	●	●	●	●	●	●	●
RECORD EVENTS IN THE SYSTEM MEMORY	●	●	●	●	●	●	●	●	●	●	●
UNLOCK ELECTRIC DOOR LOCKS IN RESONATED EGRESS PATHS	●	●	●	●	●	●	●	●	●	●	●
DISABLE SOUND MESSAGING, PAGING, OR AUDIO SYSTEMS	●	●	●	●	●	●	●	●	●	●	●
RELEASE FIRE AND SMOKE DOORS	●	●	●	●	●	●	●	●	●	●	●
TURN ON EGRESS LIGHTING TO FULL BRIGHTNESS	●	●	●	●	●	●	●	●	●	●	●
SMITH HVAC EQUIPMENT CONTROLS TO FIRE ALARM MODE	●	●	●	●	●	●	●	●	●	●	●
CLOSE SMOKE DAMPERS IN AIR DUCT SYSTEM SERVING ZONE WHERE ALARM WAS INITIATED	●	●	●	●	●	●	●	●	●	●	●

FIRE ALARM MATRIX
NO SCALE

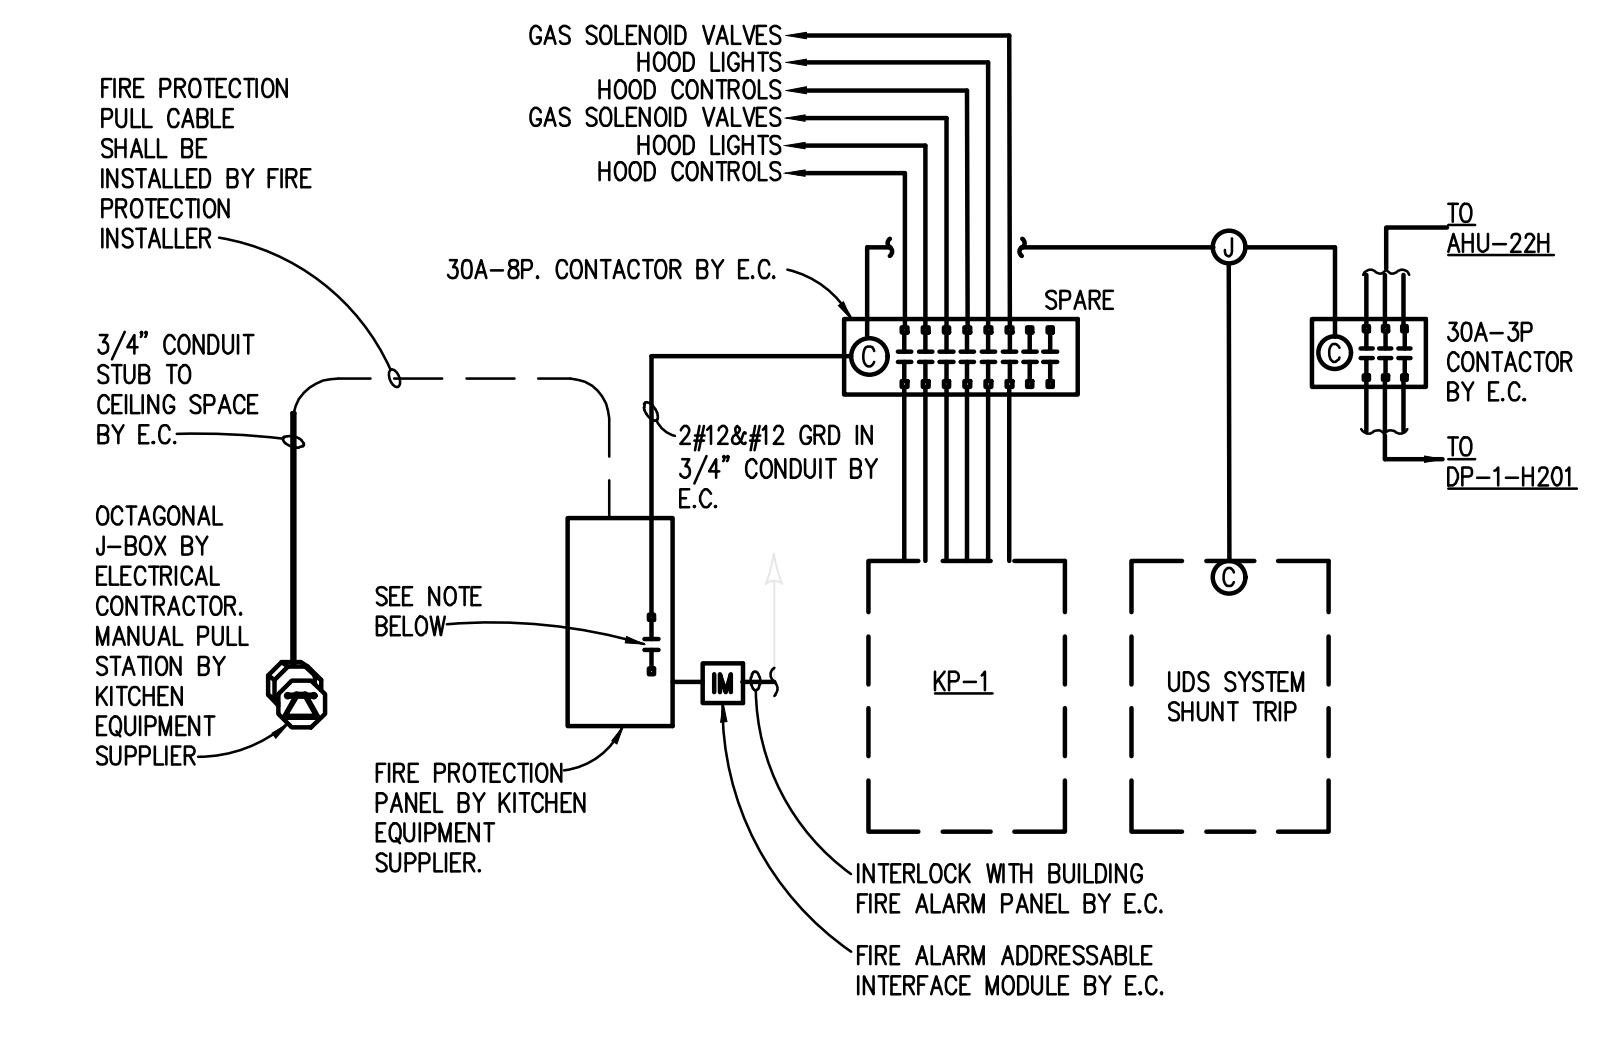

KITCHEN FIRE PROTECTION WIRING DETAIL
NO SCALE

- NOTE:**
- ELECTRICAL CONTRACTOR SHALL FIELD VERIFY VOLTAGE, AND TYPE (NORM. OPEN/CLOSED) CONTACT IN FIRE PROTECTION PANEL, AND PROVIDE CONTRACTOR TO OPERATE ACCORDINGLY. EXHAUST FAN SHALL TURN ON UPON ACTIVATION OF ANSUL SYSTEM.

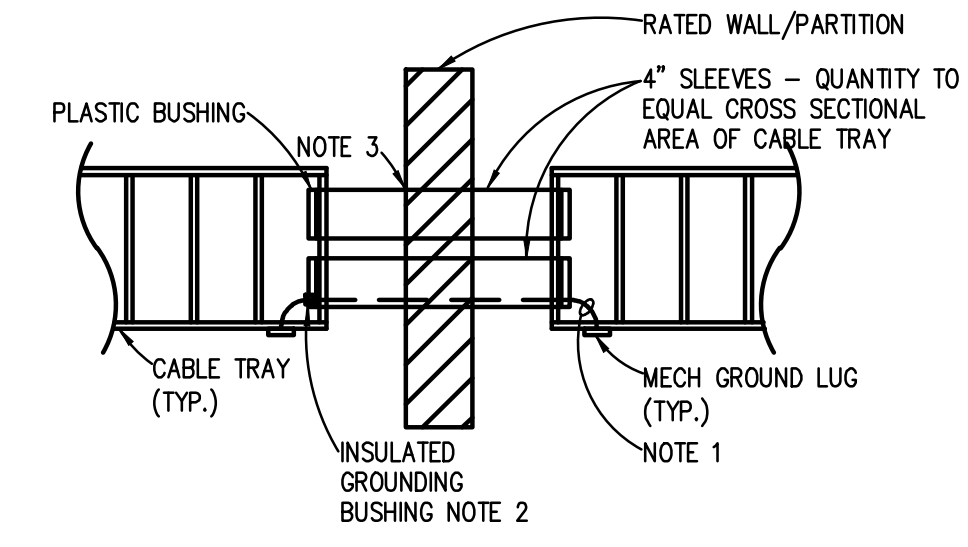

CABLE TRAY TO CONDUIT TRANSITION THROUGH RATED WALL
NO SCALE

- NOTES:**
- BOND TRAY TO CONDUIT WITH A #6 AWG COPPER GREEN INSULATED GROUND WIRE.
 - PROVIDE GROUNDING BUSHINGS ON CONDUIT SLEEVES AND BOND SLEEVES WITH #6 AWG COPPER GREEN INSULATED GROUND WIRE.
 - PROVIDE FIRE-STOPPING IN AND AROUND ALL CONDUITS MAINTAIN FIRE RATING OF PARTITION AND TO MAKE PENETRATION AIR TIGHT.

1	OWNER REVIEW	08/02/23
NO.	REVISION	DATE

STATE OF MICHIGAN
DEPARTMENT OF TECHNOLOGY, MANAGEMENT AND BUDGET
FACILITIES AND BUSINESS SERVICES ADMINISTRATION
DESIGN AND CONSTRUCTION DIVISION
ADAM LACH, RA, DIRECTOR

FILE NO.
491/20167.SDW

FUNDING CODE
171CODHHS7255

CONTRACT NO.
Y22003

WTAARCH.COM

WTA ARCHITECTS

100 S. Jefferson Ave., Suite 601
Saginaw, Michigan 48607
989 752 8107

COPYRIGHT © 2023

PROJECT TITLE
491/20167.SDW - PHASE 500:
CENTER FOR FORENSIC
PSYCHIATRY - CREATE
KITCHEN

SALINE, MICHIGAN

SHEET TITLE
**ELECTRICAL DETAILS AND
DIAGRAMS**

PROJECT NUMBER
2021094

SHEET NUMBER

PROJECT DATE
AUGUST 23, 2023

E7.01

CHECKED BY
TLC

ELECTRICAL

These documents are approved for compliance with the STATE OF MICHIGAN ELECTRICAL CODE subject to field inspection and the conditions of approval.

Peter Basso Associates Inc
CONSULTING ENGINEERS

5145 Livernois, Suite 100
Troy, Michigan 48068-3276
Tel: 248-879-5666
Fax: 248-879-0007
www.PeterBassoAssociates.com
PBA-Project No. 2021094

en:\2021\2021-0402-00\CA0\2021-0402-E7-D1.dwg, E-701, 9/5/2023 4:32:37 PM, Gerard Henrich, Peter Basso Associates Inc.

COMMUNICATION EQUIPMENT SCHEDULE			
MARK	DESCRIPTION	MANUFACTURER	PART NO.
A	TECHNOLOGY CABINET, MATCH EXISTING SIZE AND TYPE, WITH LOUVERED DOORS, C2 FRAME, 40 RACK UNITS, EQUIP WITH CABLE LACING BARS, EQUIP WITH TOP TO CABINET AND ADJUSTABLE CABINET FEET	HAMMOND	C2 FRAME C2RR197031BK1 W/COF-1970LKBK1 DOORS
B	POWER STRIP, RACK MOUNT	HAMMOND	15853HBB1
C	SINGLE RACK UNIT PATCH CORD ORGANIZER (PCO-1) WITH HINGED COVER.	HUBBELL	HS13C
D	PATCH PANEL-24 PORT, EQUIPPED WITH 8-PIN MODULAR JACKS TO MATCH THE CABLE COLOR AND CABLE TYPE BEING TERMINATED. PROVIDE ONE MODULAR JACK FOR EACH CABLE BEING TERMINATED. SEE SPEC AND DRAWINGS FOR COLORS, EQUIP WITH REAR CABLE ORGANIZER	HUBBELL	PANEL-HPJ24 ORGANIZER:ECMBR3

AUDIO EQUIPMENT SCHEDULE			
MARK	DESCRIPTION	MANUFACTURER	PART NO.
WA	AUDIO AMPLIFIER	QSC	SPA OR ISA SERIES
WB	AUDIO LINE LEVEL DISTRIBUTION AMPLIFIER 1 IN, 2-OUT	RDL LABS	ST-DA3
WC	VOLUME CONTROL	ATLAS	AT35

SPEAKER SCHEDULE			
MARK	DESCRIPTION	MANUFACTURER	PART NO.
Ⓢ1	PAGING SYSTEM SPEAKER FOR DROP CEILING INSTALLATION, EQUIP WITH WHITE GRILL AND MULTI TAPS, PROVIDE 1-BAR AND BACKBOX	ATLAS IED	SD72WV
Ⓢ2	PAGING SYSTEM SPEAKER, RECESSED IN DRYWALL CEILING, PROVIDE AND INSTALL BACKBOX INTO THE CEILING PRIOR TO DRYWALL. WIRE TO SPEAKERS PRIOR TO DRYWALL CEILING BEING INSTALLED.	ATLAS IED	SD72WV

CAMERA EQUIPMENT SCHEDULE						
MARK	DESCRIPTION	MANUFACTURER	PART NO.	DROP CEILING	BUILDING EXTERIOR	BUILDING EXTERIOR CORNER
CA	MULTI-HEAD CAMERA, EXTERIOR, 270 DEGREES CORNER MOUNT	BOSCH	NDM-7703		SBP-317HWW, SBP-390MMW2 SBP-300NBW	SBP-300KMW1 SBP-300NBW
CB	EXTERIOR 4K CAMERAS, ARM MOUNT ON WALL	BOSCH	NDE-8504-R			
CC	INDOOR AND OUTDOOR 360 FISHEYE SINGLE IMAGER 12 MEGAPIXEL	BOSCH	NDS-5704-F360LE	SHD-1600FPW	SBP-167HWW, SBP-300MMW1 SBP-300NBW	SBP-300KMW1 SBP-300NBW
CD	INDOOR SHORT DISTANCE CAMERA, 2MP, DROP OR HARD CEILING	BOSCH	NDE-4502-A	SHD-1408FPW		
CE	INDOOR 5 MP DROP OR HARD CEILING OR WALL	BOSCH	NDE-5503-A	SHD-1408FPW		
CF	BOSCH NVR FOR CAMERA STORAGE AND PROCESSING	BOSCH	SEE SPECS			
CG	ETHERNET SWITCH FOR CAMERA SYSTEM	CISCO	9200 SERIES			

CABLE SCHEDULE			
MARK	DESCRIPTION	MANUFACTURER	PART NO.
1	CAT-6 UTP CABLES, BLUE IN COLOR, SEE CONNECTIVITY CODES	MOHAWK	M58281
2	CAT-6 UTP CABLES, GREEN IN COLOR, SEE CONNECTIVITY CODES	MOHAWK	M58286
3	CAT-6 UTP CABLES, YELLOW IN COLOR, SEE CONNECTIVITY CODES	MOHAWK	M58283
4	CAT-6 CABLE UNDERGROUND RATED	MOHAWK	M57622
5	SHAKER FENCE CABLE	JSC	CONTRACTOR
6	STUN FENCE FEEDER WIRE FROM ENERGIZER TO FENCE	CONTRACTOR	CONTRACTOR
7	STUN FENCE CABLE ON FENCE	CONTRACTOR	CONTRACTOR

ACCESS CONTROL EQUIPMENT SCHEDULE			
MARK	DESCRIPTION	MANUFACTURER	PART NO.
XA	INTERCOM AT DOOR-INTERIOR	HARDING	ICE-320-217-000
XB	INTERCOM AT DOOR-EXTERIOR	HARDING	ICE-320-227-000
XC	PLC WITH ETHERNET INTERFACE PROCESSOR	ALLEN BRADLEY	1769-L37ERM
XD	POINT I/O ETHERNET ETHERNET ADAPTER	ALLEN BRADLEY	1769-AENTR
XE	POINT I/O OUTPUT MODULE	ALLEN BRADLEY	1769-OB32
XF	POINT I/O INPUT MODULE	ALLEN BRADLEY	1769-IO32
XD	POWER SUPPLY	EMERSON	SVL-1024100
XH	DN RAIL MOUNTED TERMINAL STRIPS, PROVIDE AS REQUIRED FOR CABLE TYPE AND CONNECTIVITY, MOUNT IN CABINET, PROVIDE SUPPORTS AND PLASTIC FINGER DUCT FOR ROUTING CABLE	CONTRACTOR	CONTRACTOR
XJ	INTERCOM BOARD FOR CONNECTION OF AUDIO ON INTERCOMS	HARDING	QCB-120-1
XK	INTERCOM BOARD FOR CONNECTION OF PUSH BUTTON ON INTERCOMS	HARDING	QCB-120-1
XL	ETHERNET SWITCH FOR ACCESS CONTROL SYSTEM	CONTRACTOR	CONTRACTOR
XM	INTERCOM CONTROLLER IP ATTACHED	HARDING	DCC-5100-3030- S100-00IP


ACCESS CONTROL EQUIPMENT SCHEDULE			
MARK	DESCRIPTION	MANUFACTURER	PART NO.
CA	ACCESS CONTROL SYSTEM, SOFTWARE AND ASSOCIATED/REQUIRED SERVERS	STANLEY	GATEKEEPER
CB	CARD READER SERIAL TO IP DEVICE, SERVES UP TO 16 CARD READERS	MOXA	5650-16
CC	CARD READER, COMPATIBLE WITH STANLEY SYSTEM.	HID	5352AGN00
CD			
CE			
CF			
CG			
CH			

ABBREVIATIONS			
ABBREV.	DESCRIPTION	ABBREV.	DESCRIPTION
2G	TWO-GANG BOX - PROVIDED BY EC	NIC	NOT IN CONTRACT
AC	ABOVE COUNTER - INSTALL BACKBOX SAME HEIGHT AS OTHER ELECTRICAL OUTLETS ABOVE THE COUNTER.	PBO	PROVIDED BY OTHERS
AFF	ABOVE FINISHED FLOOR	PCO-1	PATCH CORD ORGANIZER - 1 UNIT HIGH
AFG	ABOVE FINISHED GROUND	PCO-2	PATCH CORD ORGANIZER - 2 UNITS HIGH
AWG	AMERICAN WIRE GAUGE	PET	PROTECTED ENTRANCE TERMINAL
EMT	EMT TYPE CONDUIT	QTY	QUANTITY
EC	ELECTRICAL CONTRACTOR		

COMMUNICATION SYMBOL LEGEND	
SYMBOL	DESCRIPTION
①	THIS SYMBOL WITH A NUMBER INSIDE REFERS TO KEYNOTES, REFER TO NOTES ON THE SHEET OR WITHIN THE DETAIL FOR ADDITIONAL INFORMATION.
A	EQUIPMENT SCHEDULE. THIS SYMBOL WITH LETTERS INSIDE REFERS EQUIPMENT SCHEDULES, SEE DETAILS AND EQUIPMENT SCHEDULES ON TC101, TC301, TC501 AND TC701.
1	CABLE SCHEDULE. THIS SYMBOL WITH NUMBERS INSIDE REFERS EQUIPMENT SCHEDULES, SEE DETAILS AND EQUIPMENT SCHEDULES ON TC101, TC301, TC501 AND TC701.
XXXX	DATA COMMUNICATIONS OUTLET CONNECTIVITY CODE, X IS A 1 THRU 99, SEE TC1XX SHEETS FOR SPECIFIC REQUIREMENTS. XXXX NOTES THAT THE CABLE IS FOR A SPECIFIC USE.
Ⓢ1	TWO SIDED DIGITAL CLOCK, SEE CONNECTIVITY CODE FOR CLOCK TYPE.
Ⓢ2	SINGLE SIDED DIGITAL CLOCK, SEE CONNECTIVITY CODE FOR CLOCK TYPE.
—	NEW STUN FENCE, INSTALL NEW STUN FENCE WIRING AND DEVICES
—	NEW SHAKER WIRE ON FENCE, INSTALL NEW SHAKER WIRE ON THE FENCE
---	TEMPORARY FEED OF STUN FENCE FROM STUN FENCE CABINET TO EXISTING FENCE
---	EXISTING SHAKER WIRE AND STUN FENCE, REMOVE FROM FENCE

AUDIO VIDEO SYMBOL LEGEND	
SYMBOL	DESCRIPTION
XXXX	AUDIO/VIDEO COMMUNICATIONS OUTLET, REFER TO THE ASSOCIATED AV SYSTEM DETAIL FOR REQUIREMENTS, ZZ REFERS TO HEIGHT OF OUTLET, 18" UNLESS OTHER WISE NOTED.
SEE TC3XX/X	AV SYSTEM DETAIL, REFER TO THIS SHEET AND DETAIL NUMBER FOR THE REQUIREMENTS OF THE AUDIO/VIDEO SYSTEM IN THIS ROOM
Ⓢ X	SPEAKERS, SEE SPEAKER SCHEDULE ON TC301."X" REFERS TO SPEAKER TYPE, "ZZ" REFERS TO SPEAKER ZONE IF THIS IS A PAGING SPEAKER.

SECURITY SYMBOL LEGEND	
SYMBOL	DESCRIPTION
XX	ACCESS CONTROL SYMBOL, "XX" IS LETTERS, SEE DETAILS ON TC5XX SHEETS FOR EQUIPMENT, CABLING AND RACEWAY DETAILS.
XX	ACCESS CONTROL SYMBOL FOR EXISTING DEVICES, "XX" IS LETTERS, SEE DETAILS ON TC5XX SHEETS, LEAVE DEVICES AND CONNECT TO NEW SYSTEM OR LEAVE AS CONNECTED TO EXISTING SYSTEM, SEE NOTES AND DETAILS.
XXX	DOOR NUMBER
SEC.PNL	SECURITY PANEL, PROVIDE PANEL AND CONNECT AS SHOWN ON FLOORPLANS AND IN THE SPECIFICATIONS.
Ⓢ	SECURITY CAMERA, PROVIDE AND INSTALL A NEW SECURITY CAMERA, SEE DETAILS ON TC5XX SHEETS.
Ⓢ	SECURITY CAMERA WITH 180 DEGREE VIEWING, PROVIDE AND INSTALL A NEW SECURITY CAMERA, SEE DETAILS ON TC5XX SHEETS.
Ⓢ	SECURITY CAMERA WITH 360 DEGREE VIEWING, SINGLE-IMAGER, PROVIDE AND INSTALL A NEW SECURITY CAMERA, SEE DETAILS ON TC5XX SHEETS.
Ⓢ	SECURITY CAMERA WITH 270 OR 360 DEGREE VIEWING, MULTI-IMAGER, PROVIDE AND INSTALL A NEW SECURITY CAMERA, SEE DETAILS ON TC5XX SHEETS.
Ⓢ	SECURITY CAMERA, PTZ, SEE SPECIFICATIONS FOR CAMERA REQUIREMENTS AND MOUNTING.

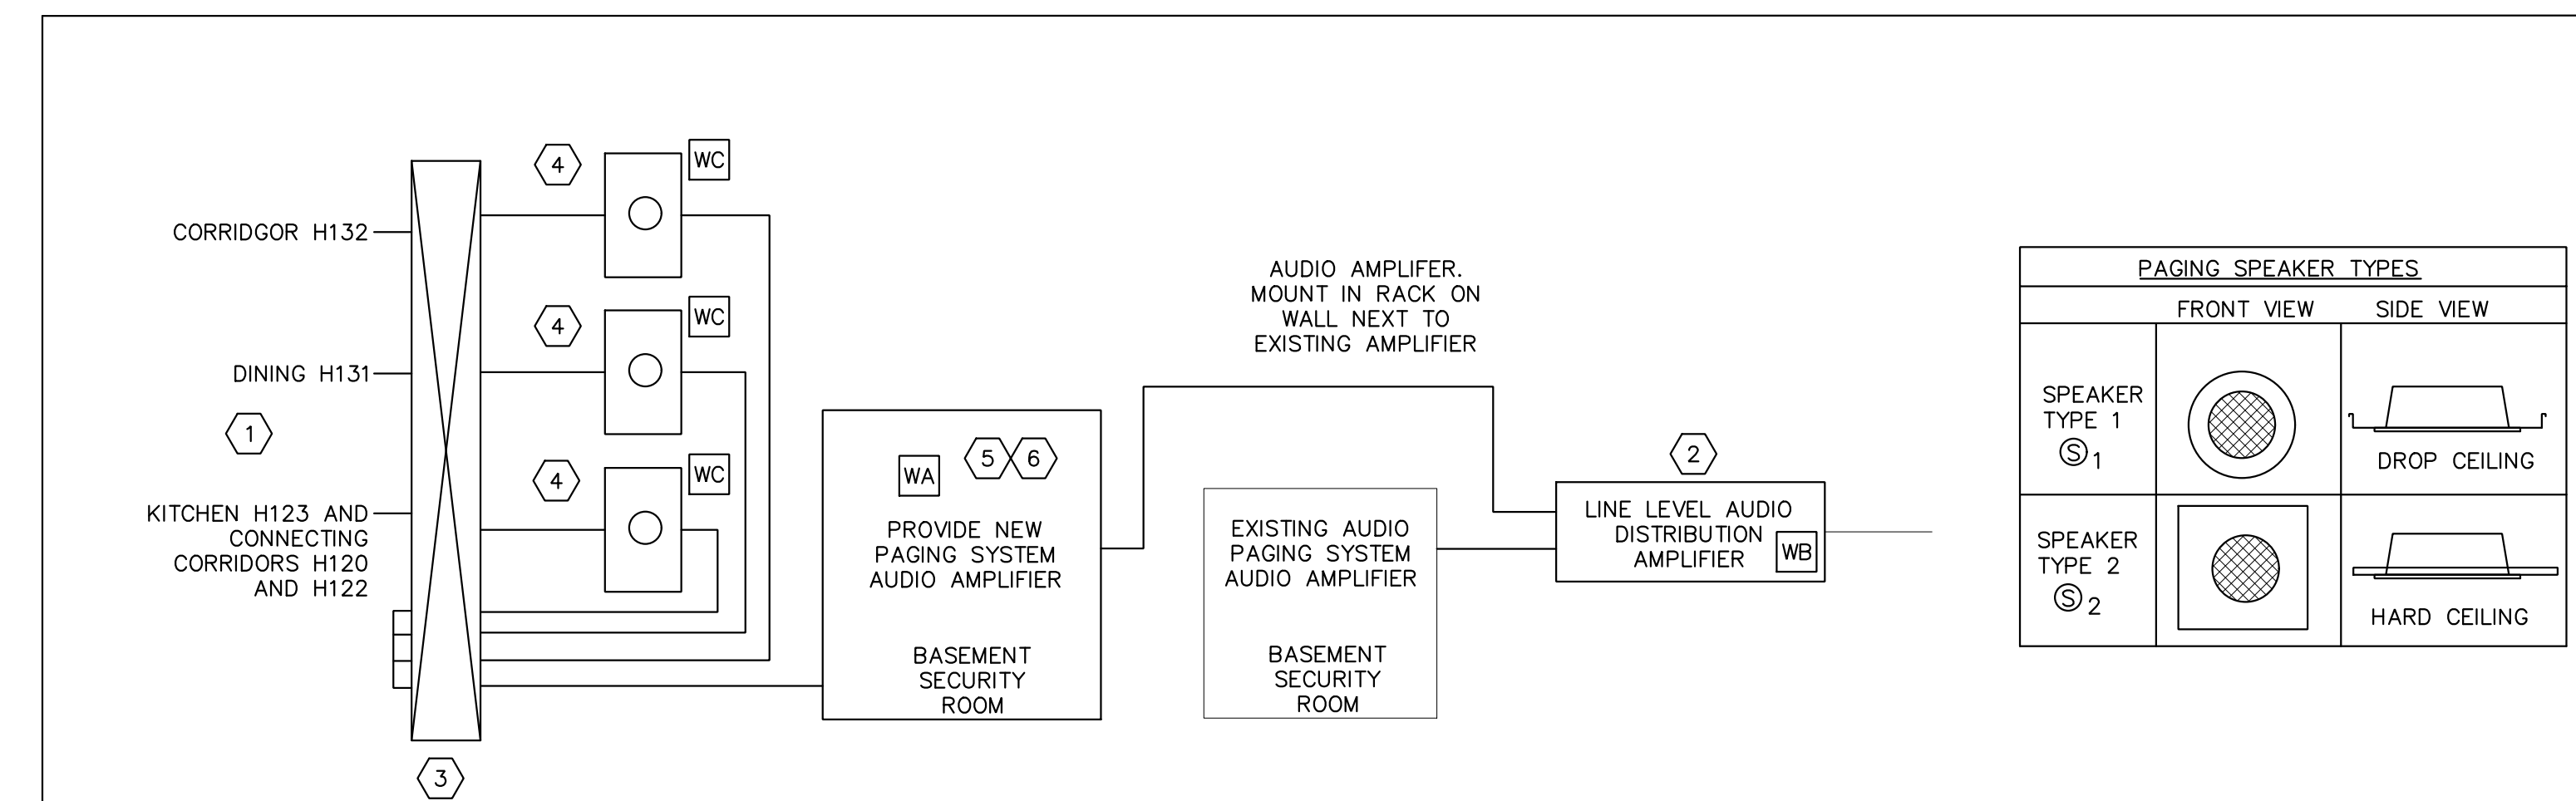

- NOTES:**
- THE SITE CURRENTLY HAS AN EXISTING PAGING AUDIO SYSTEM. THIS SYSTEM SHALL BE EXPANDED TO SUPPORT NEW ZONES AND SPEAKERS IN THE KITCHEN AREA.
 - PROVIDE AN AUDIO SPLITTER AND SPLIT THE EXISTING SIGNAL PRIOR TO CONNECTION TO EXISTING AMPLIFIER.
 - THE PAGING/BELL SYSTEM SHALL BE MOUNTED IN A CABINET IN THE COMM ROOM IN THE BASEMENT.
 - CONTRACTOR SHALL BE RESPONSIBLE FOR ALL CABLES ASSOCIATED WITH THE CONNECTIVITY OF THE PAGING SYSTEM. ALL NEW CABLES SHALL BE PLENUM RATED.
 - CONTRACTOR SHALL LABEL EACH PAGING SYSTEM SPEAKER CABLE. THE LABEL SHALL BE "ZONE XXX" WHERE XXX DESIGNATES THE EXTENSION THAT THE CABLE IS CONNECTED TO. CABLES SHALL BE LABELED AT EACH TERMINATION POINT & AT EACH INTERCONNECTION POINT.
 - PROVIDE INTERCONNECTION CABLES AS REQUIRED FOR ZONES AND POWER DISTRIBUTION TO THE SPEAKERS. CONTRACTOR SHALL VERIFY CONFIGURATION WITH ENGINEER PRIOR TO INSTALLATION.
 - INSTALL VOLUME CONTROLS FOR AUDIO LEVEL CONTROL OF ALL THREE ZONES BEING ADDED.
- KEYED NOTES:**
- INSTALL CABLES FROM SPEAKERS TO THE BASEMENT SECURITY ROOM. PROVIDE ONE CABLE FOR EACH ZONE AS DEPICTED.
 - PROVIDE AND INSTALL AN AUDIO SPLITTER FOR THE SYSTEM. SPLIT EXISTING SIGNAL.
 - INSTALL TERMINAL STRIPS FOR WIRE TERMINATION, LABEL EACH WIRE AND EACH ZONE AT THE TERMINAL STRIPS.
 - INSTALL A VOLUME CONTROL IN A SINGLE-GANG BACKBOX ON THE WALL, LABEL FOR THE ZONE IT CONNECTS TO.
 - TEST SYSTEM, LISTEN AND SET AUDIO LEVEL IN EACH ZONE.
 - PROVIDE AN AMPLIFIER THAT DRIVES ALL SPEAKERS, WITH ADEQUATE AUDIO LEVEL.

1
TC101
AUDIO PAGING SYSTEM
EXPANSION DETAIL

NO.	REVISION	DATE

STATE OF MICHIGAN
DEPARTMENT OF TECHNOLOGY, MANAGEMENT AND BUDGET
FACILITIES AND BUSINESS SERVICES ADMINISTRATION
DESIGN AND CONSTRUCTION DIVISION
ADAM LACH, RA, DIRECTOR

FILE NO.
491/20167.SDW

FUNDING CODE
171CODHHS7255

CONTRACT NO.
Y22003

CommtechDesign
6581 BELDING RD NE STE 101
ROCKFORD, MICHIGAN 49341
WWW.COMMTECHDESIGN.COM

WTAARCH.COM

WTA ARCHITECTS

100 S. Jefferson Ave, Suite 601
Saginaw, Michigan 48607
989 752 8107
COPYRIGHT © 2023

PROJECT TITLE
491/20167.SDW - PHASE 500:
CENTER FOR FORENSIC
PSYCHIATRY - CREATE
KITCHEN
SALINE, MICHIGAN

SHEET TITLE
CABLING
LEGENDS, SCHEDULES
& DETAILS


PROJECT NUMBER
2021094

SHEET NUMBER

PROJECT DATE
SEPTEMBER 6, 2023


TC101

CHECKED BY
BWE

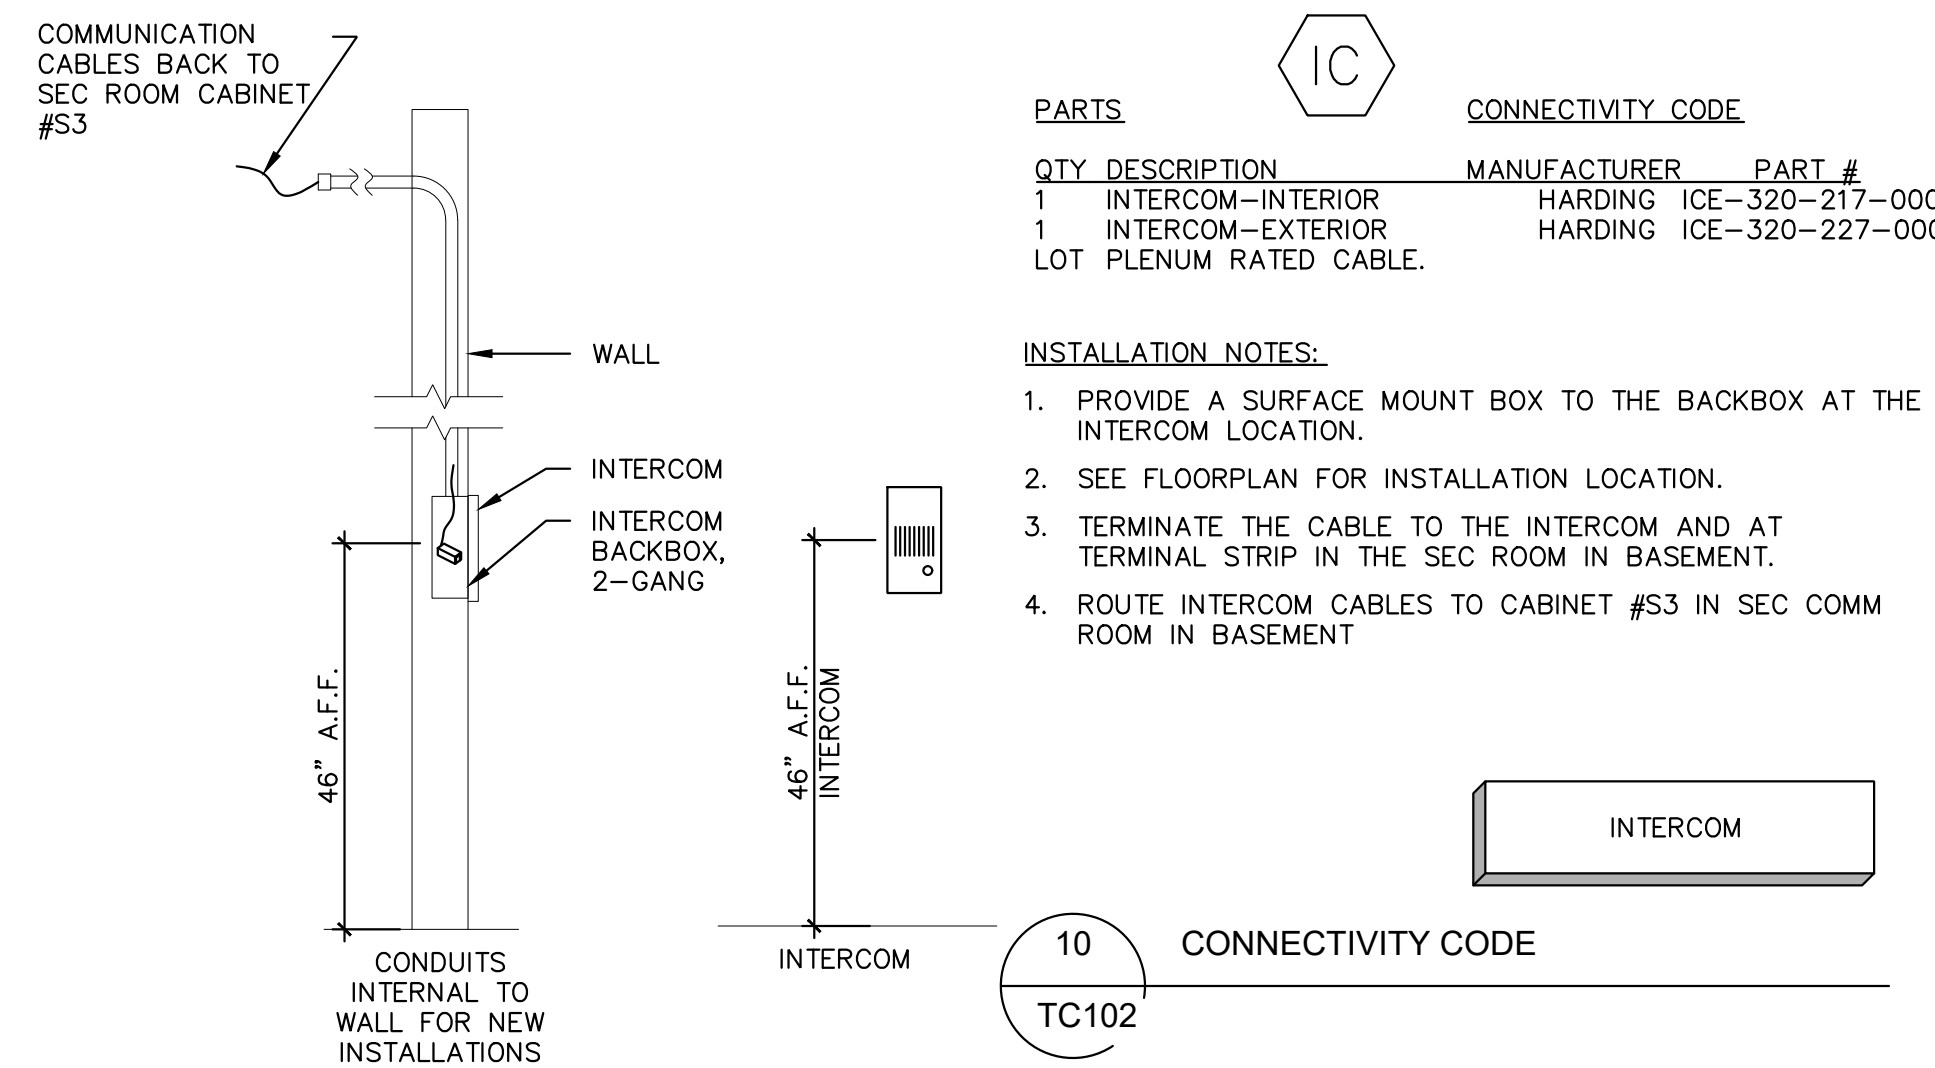


PARTS		CONNECTIVITY CODE	
QTY	DESCRIPTION	MANUFACTURER	PART #
1	INTERCOM-INTERIOR	HARDING	ICE-320-217-000
1	INTERCOM-EXTERIOR	HARDING	ICE-320-227-000
1	LOT PLENUM RATED CABLE.		

- INSTALLATION NOTES:**
1. PROVIDE A SURFACE MOUNT BOX TO THE BACKBOX AT THE INTERCOM LOCATION.
 2. SEE FLOORPLAN FOR INSTALLATION LOCATION.
 3. TERMINATE THE CABLE TO THE INTERCOM AND AT TERMINAL STRIP IN THE SEC ROOM IN BASEMENT.
 4. ROUTE INTERCOM CABLES TO CABINET #53 IN SEC COMM ROOM IN BASEMENT

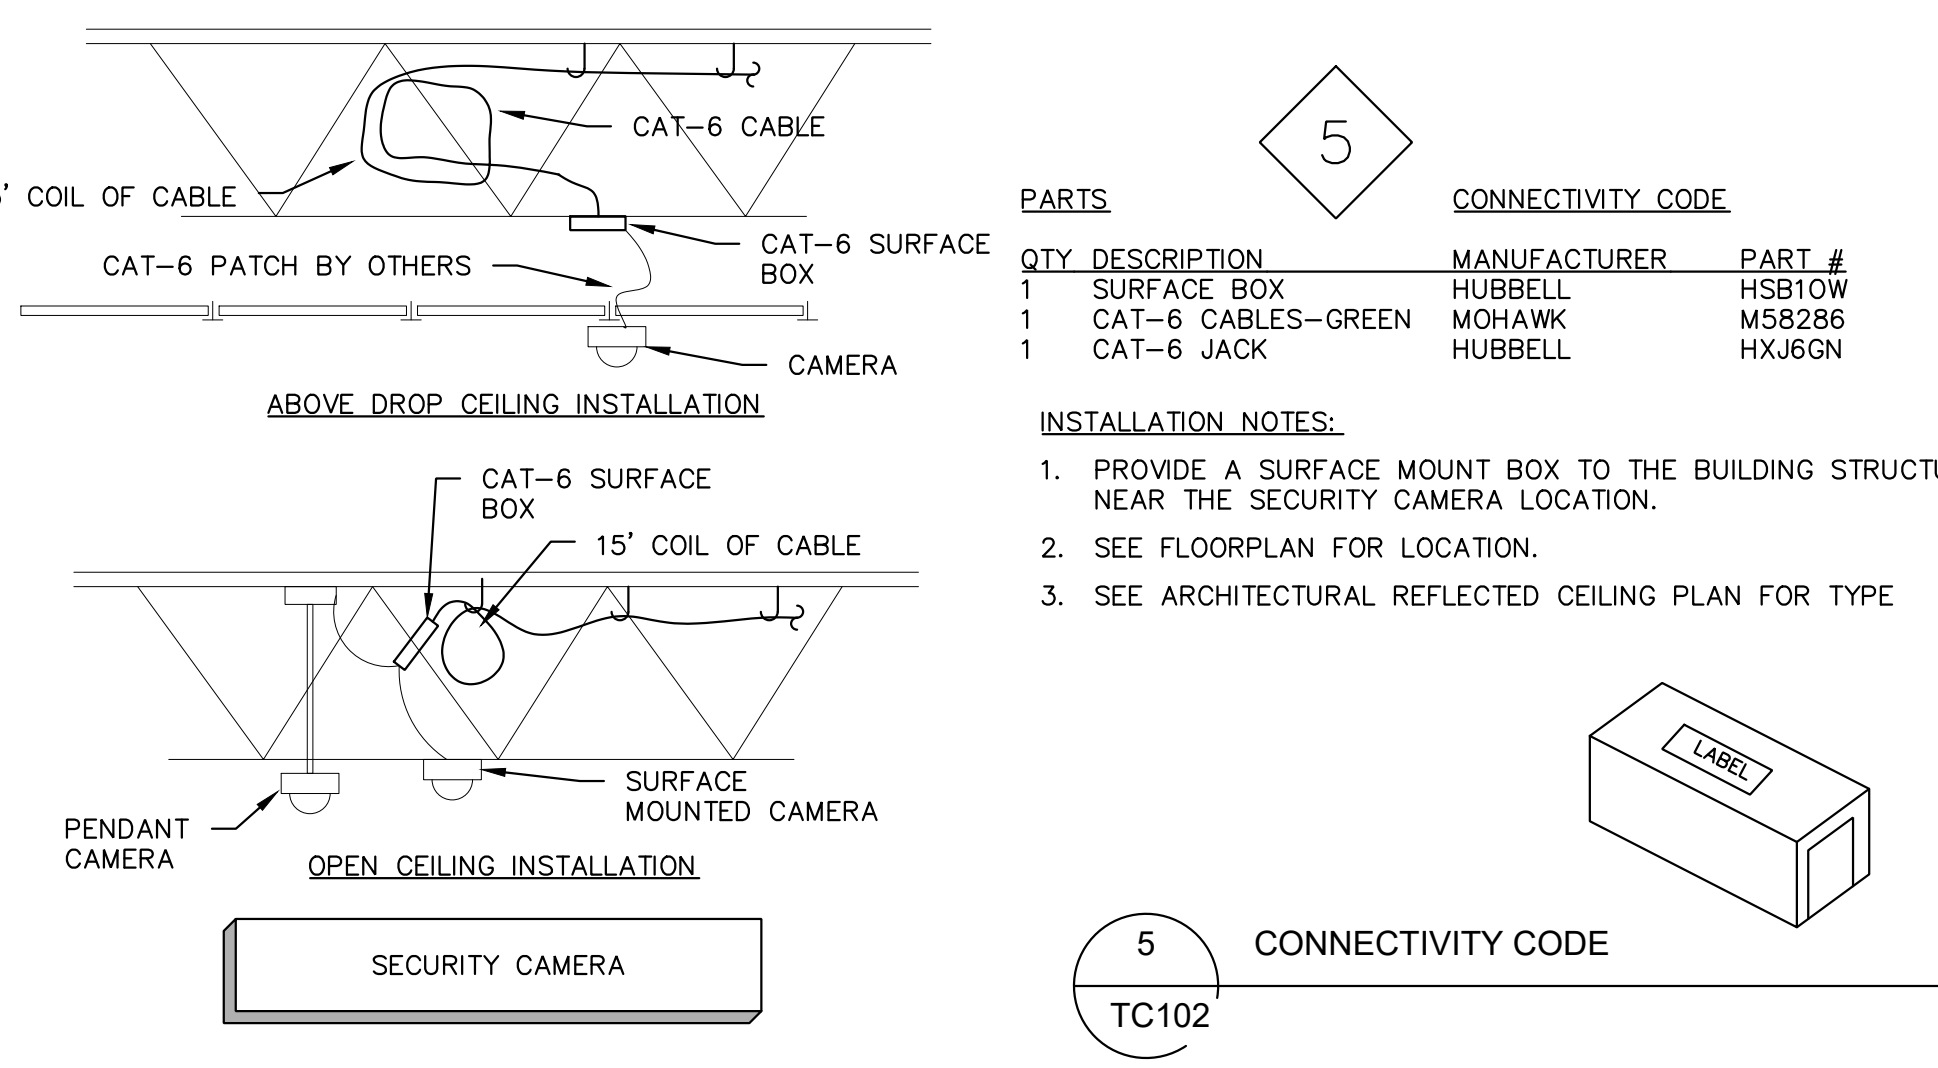


PARTS		CONNECTIVITY CODE	
QTY	DESCRIPTION	MANUFACTURER	PART #
1	SURFACE BOX	HUBBELL	HSB10W
1	CAT-6 CABLES-GREEN	MOHAWK	M58286
1	CAT-6 JACK	HUBBELL	HXJ6GN

- INSTALLATION NOTES:**
1. PROVIDE A SURFACE MOUNT BOX TO THE BUILDING STRUCTURE NEAR THE SECURITY CAMERA LOCATION.
 2. SEE FLOORPLAN FOR LOCATION.
 3. SEE ARCHITECTURAL REFLECTED CEILING PLAN FOR TYPE

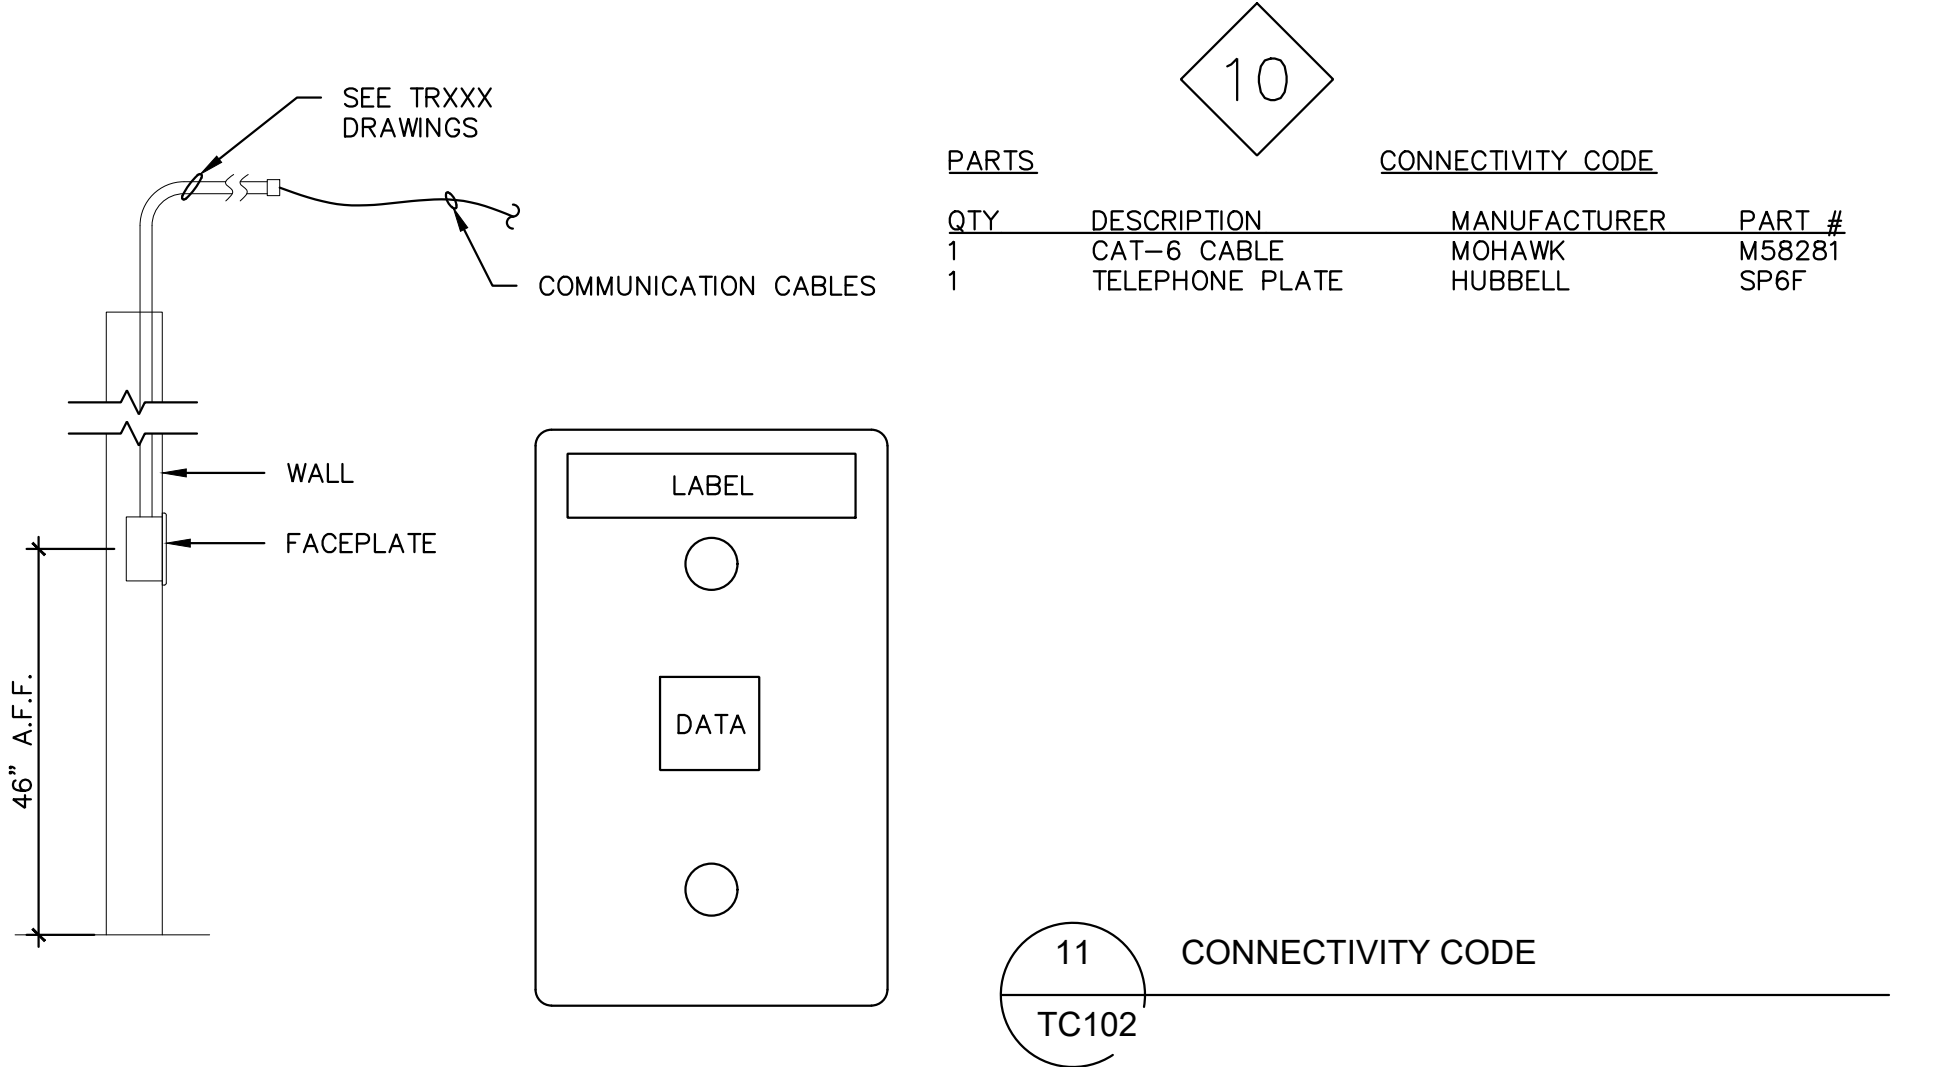


PARTS		CONNECTIVITY CODE	
QTY	DESCRIPTION	MANUFACTURER	PART #
1	CAT-6 CABLE	MOHAWK	M58281
1	TELEPHONE PLATE	HUBBELL	SP6F

- INSTALLATION NOTES:**
1. PROVIDE A SURFACE MOUNT BOX TO THE BACKBOX AT THE SECURITY CAMERA LOCATION.
 2. SEE FLOORPLAN FOR INSTALLATION LOCATION. SEE TR RACEWAY DRAWINGS FOR HEIGHT OF CAMERA AND CABLING.

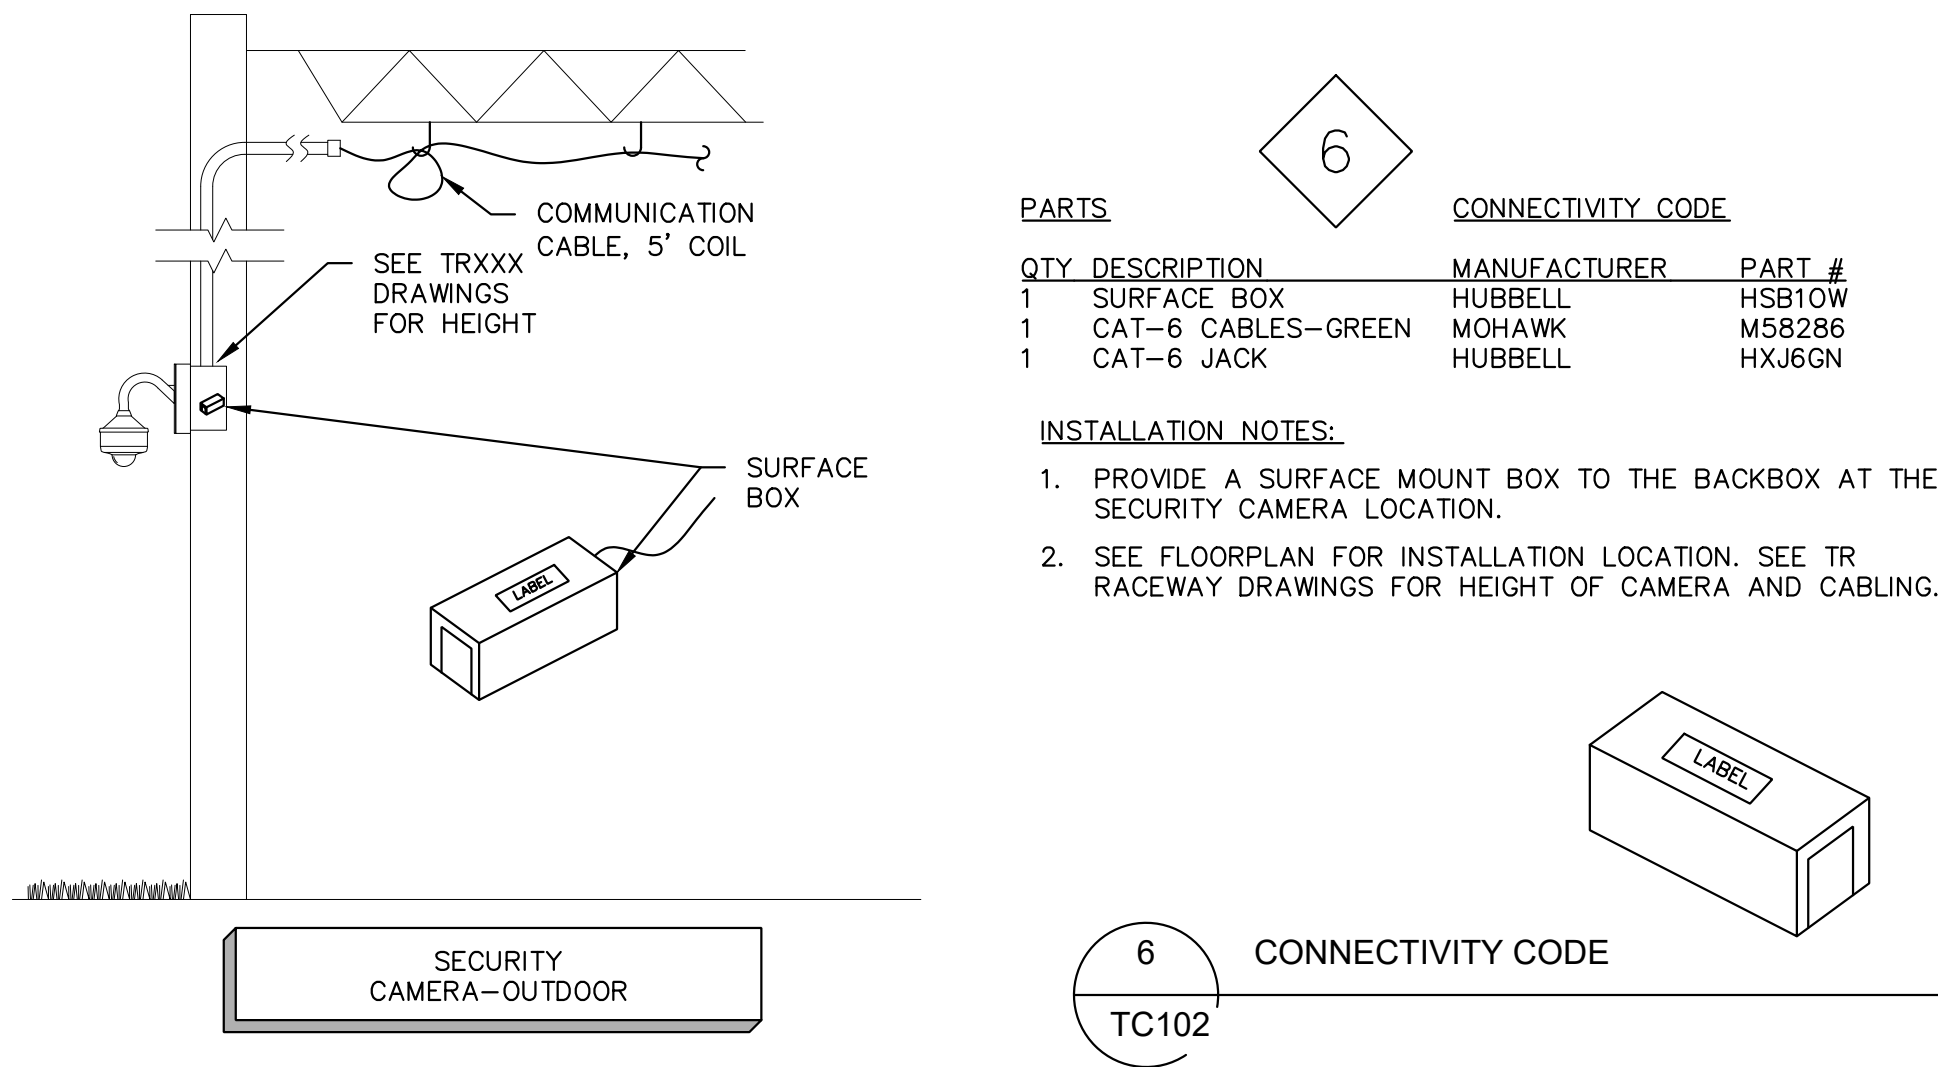


PARTS		CONNECTIVITY CODE	
QTY	DESCRIPTION	MANUFACTURER	PART #
1	SURFACE BOX	HUBBELL	HSB10W
1	CAT-6 CABLES-GREEN	MOHAWK	M58286
1	CAT-6 JACK	HUBBELL	HXJ6GN

- INSTALLATION NOTES:**
1. PROVIDE A SURFACE MOUNT BOX TO THE BACKBOX AT THE SECURITY CAMERA LOCATION.
 2. SEE FLOORPLAN FOR INSTALLATION LOCATION. SEE TR RACEWAY DRAWINGS FOR HEIGHT OF CAMERA AND CABLING.

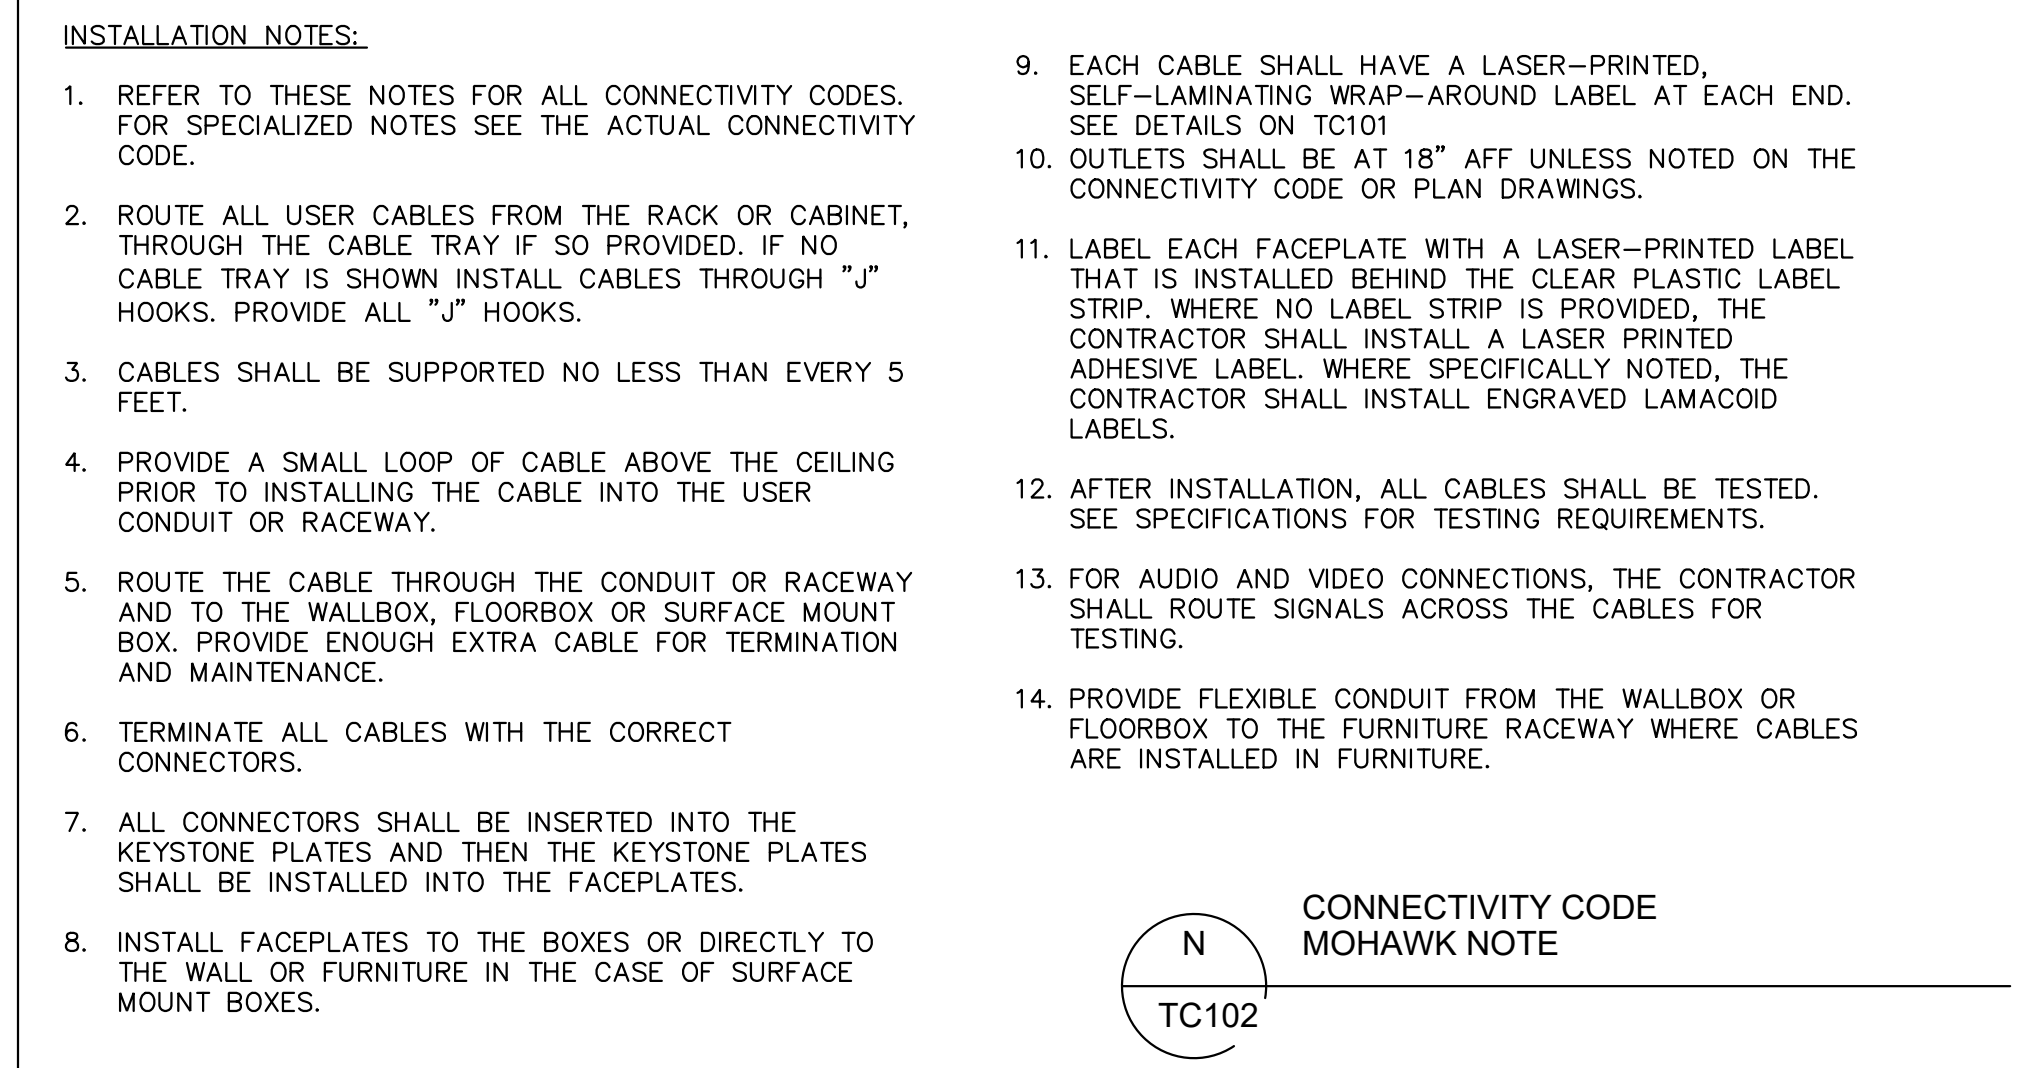


PARTS		CONNECTIVITY CODE	
QTY	DESCRIPTION	MANUFACTURER	PART #
1	GFI PLATE-STAINLESS	HUBBELL	SS26
1	CAT-6 CABLE	MOHAWK	M58281
1	CAT-6 JACK	HUBBELL	HXJ6GN
1	ONE HOLE GFI PLATE	HUBBELL	NS611GY

 - INSTALLATION NOTES:**
1. USE ONLY SECURITY SCREWS WITH THESE PLATES.
 2. WHERE NOTED THE CABLES SHALL BE INSTALLED THRU SURFACE RACEWAY.
 3. LABEL THE FACEPLATE WITH A LASER PRINTED LABEL




PARTS		CONNECTIVITY CODE	
QTY	DESCRIPTION	MANUFACTURER	PART #
1	CAT-6 CABLE	MOHAWK	M58281
1	TELEPHONE PLATE	HUBBELL	SP6F

- INSTALLATION NOTES:**
1. PROVIDE A SURFACE MOUNT BOX TO THE BACKBOX AT THE SECURITY CAMERA LOCATION.
 2. SEE FLOORPLAN FOR INSTALLATION LOCATION. SEE TR RACEWAY DRAWINGS FOR HEIGHT OF CAMERA AND CABLING.

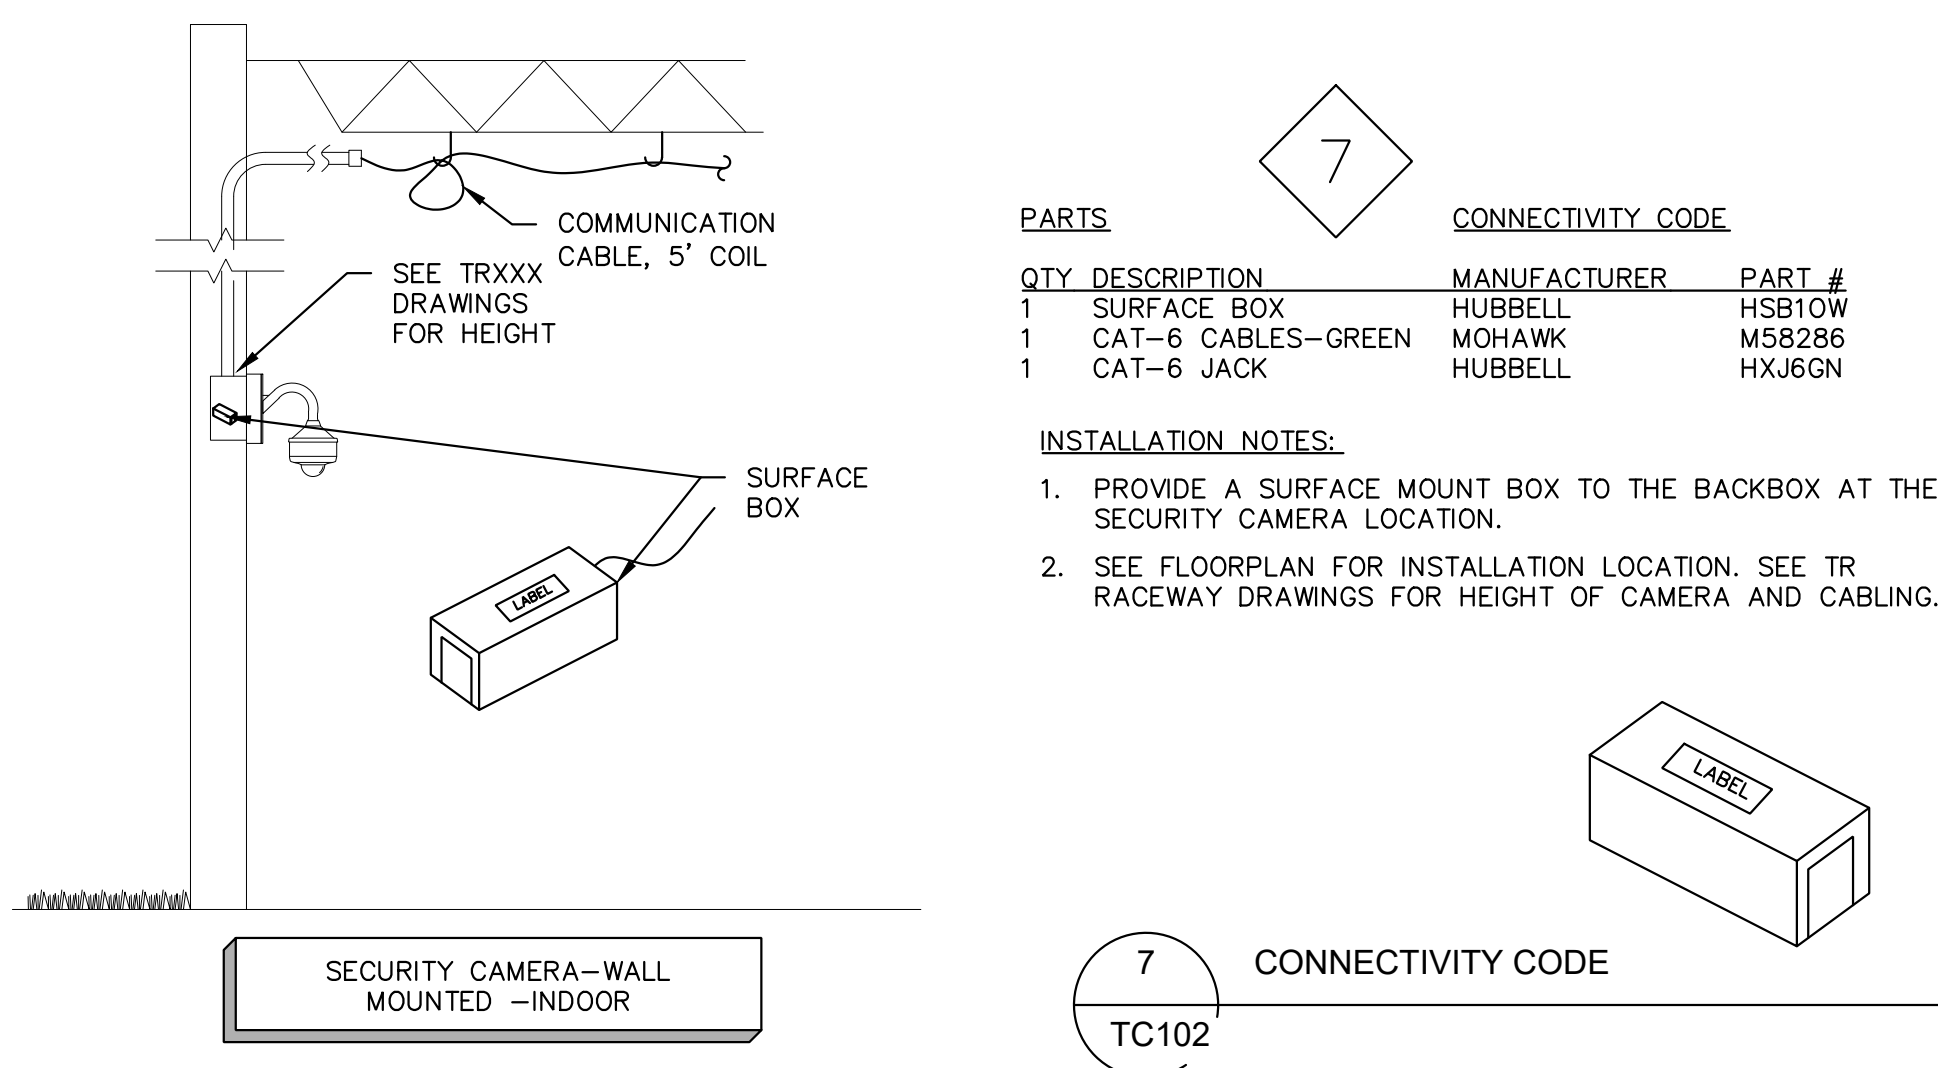


PARTS		CONNECTIVITY CODE	
QTY	DESCRIPTION	MANUFACTURER	PART #
1	SURFACE BOX	HUBBELL	HSB10W
1	CAT-6 CABLES-GREEN	MOHAWK	M58286
1	CAT-6 JACK	HUBBELL	HXJ6GN

- INSTALLATION NOTES:**
1. PROVIDE A SURFACE MOUNT BOX TO THE BACKBOX AT THE SECURITY CAMERA LOCATION.
 2. SEE FLOORPLAN FOR INSTALLATION LOCATION. SEE TR RACEWAY DRAWINGS FOR HEIGHT OF CAMERA AND CABLING.

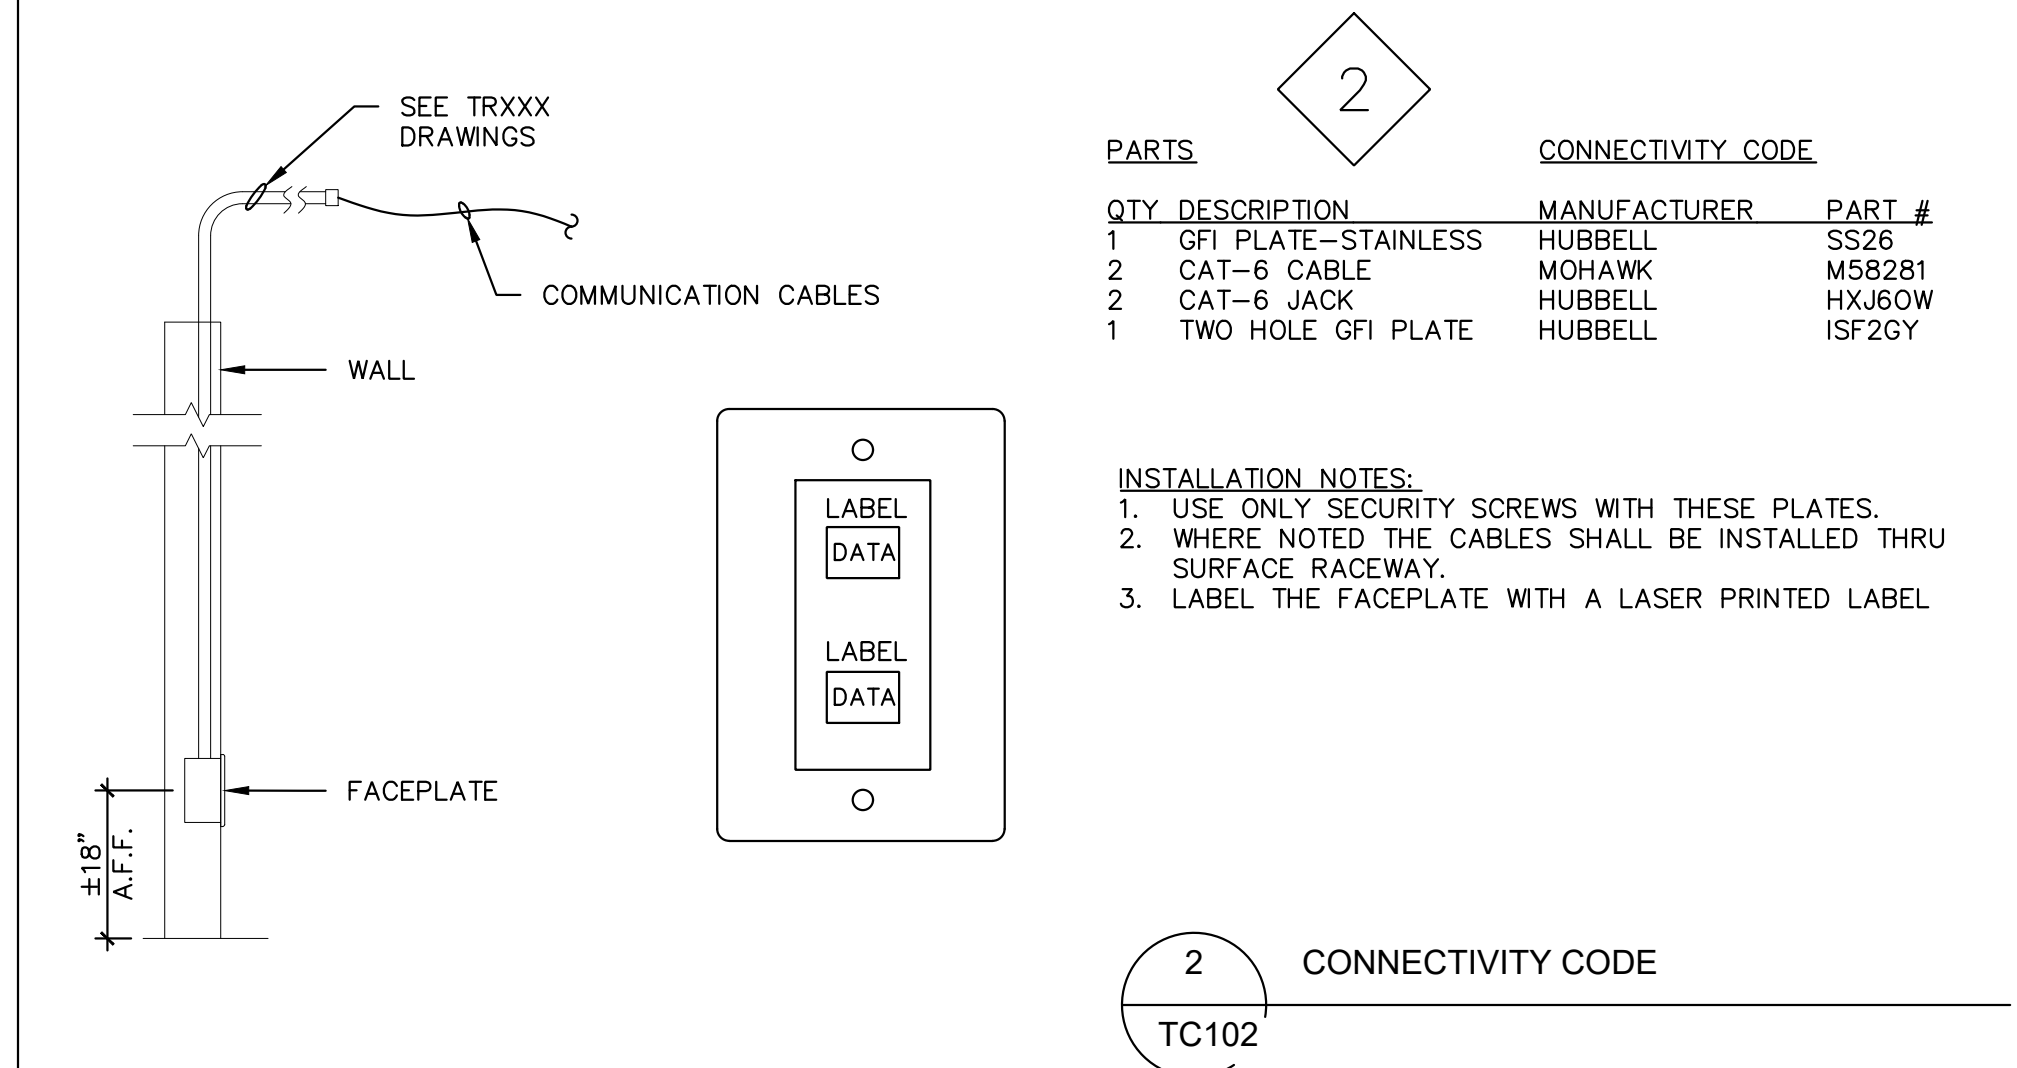


PARTS		CONNECTIVITY CODE	
QTY	DESCRIPTION	MANUFACTURER	PART #
1	GFI PLATE-STAINLESS	HUBBELL	SS26
2	CAT-6 CABLE	MOHAWK	M58281
2	CAT-6 JACK	HUBBELL	HXJ6GN
1	TWO HOLE GFI PLATE	HUBBELL	ISF2GY

- INSTALLATION NOTES:**
1. USE ONLY SECURITY SCREWS WITH THESE PLATES.
 2. WHERE NOTED THE CABLES SHALL BE INSTALLED THRU SURFACE RACEWAY.
 3. LABEL THE FACEPLATE WITH A LASER PRINTED LABEL

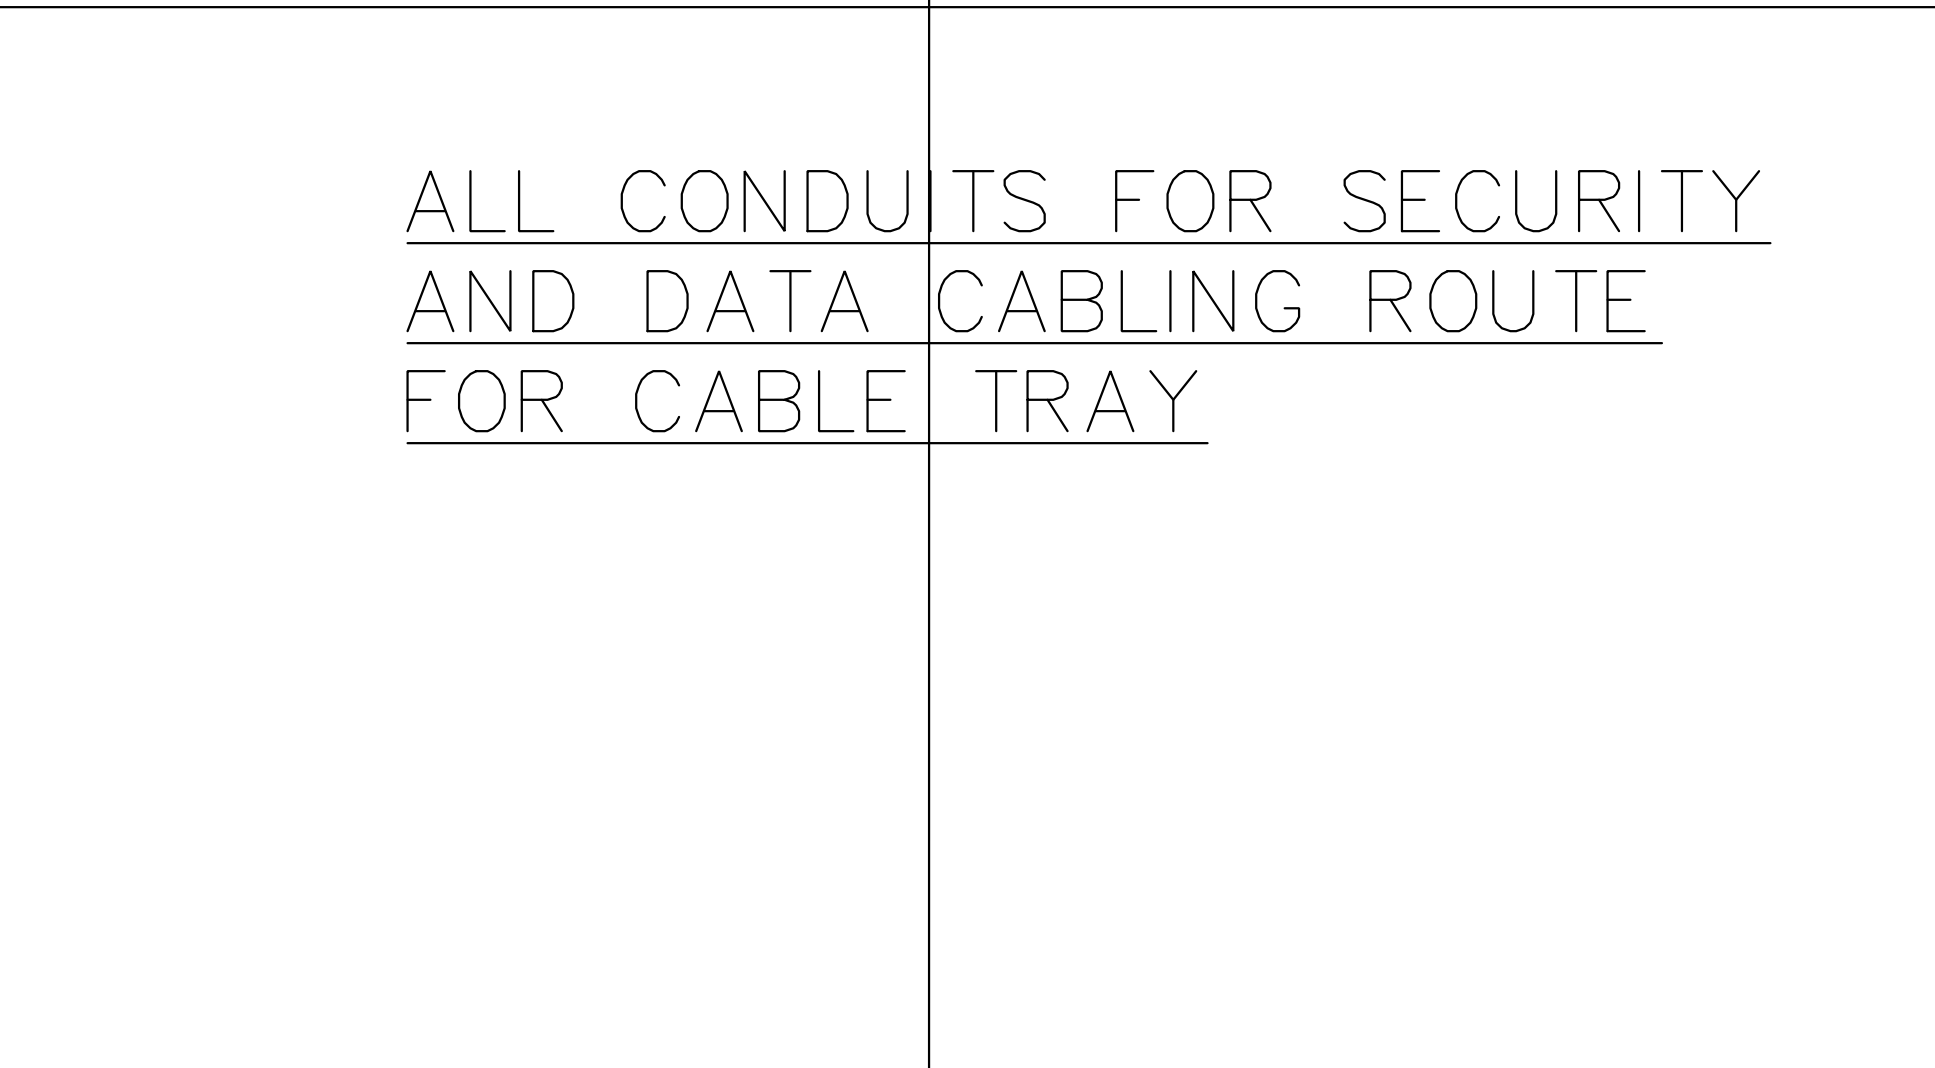


PARTS		CONNECTIVITY CODE	
QTY	DESCRIPTION	MANUFACTURER	PART #
1	SURFACE BOX	HUBBELL	HSB10W
1	CAT-6 CABLES-YELLOW	MOHAWK	M58283
1	CAT-6 JACK	HUBBELL	HXJ6GN

- INSTALLATION NOTES:**
1. PROVIDE A SURFACE MOUNT BOX TO THE BUILDING STRUCTURE NEAR THE ACCESS POINT LOCATION.
 2. SEE FLOORPLAN FOR LOCATION.
 3. SEE ARCHITECTURAL REFLECTED CEILING PLAN FOR TYPE
 4. INSTALL A LASER PRINTED CABLE LABEL ON THE CEILING WHERE THE CABLE TERMINATES. THIS WILL ALLOW THE FUTURE USER TO FIND THE CABLE TO EVENTUALLY INSTALL WIRELESS ACCESS POINT.

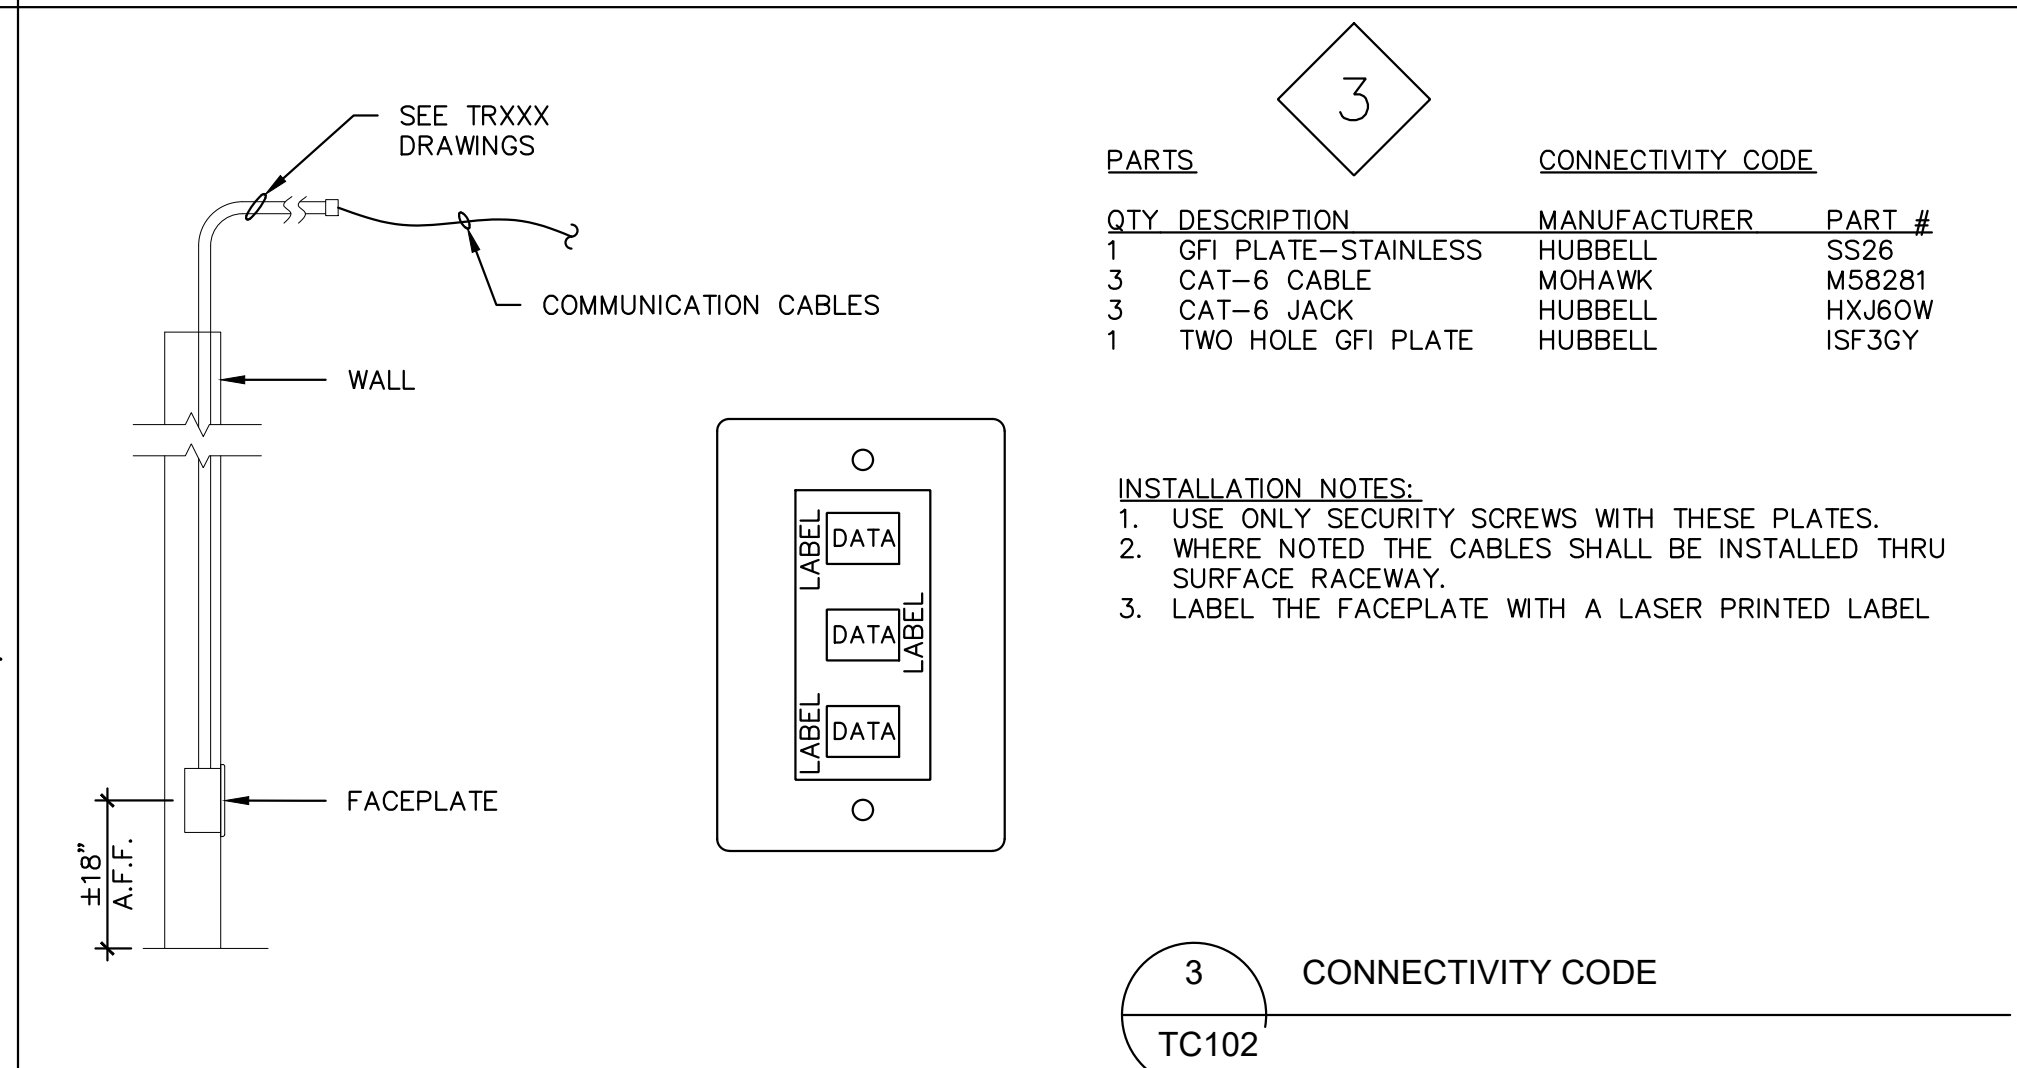


PARTS		CONNECTIVITY CODE	
QTY	DESCRIPTION	MANUFACTURER	PART #
1	GFI PLATE-STAINLESS	HUBBELL	SS26
1	CAT-6 CABLE	MOHAWK	M58281
3	CAT-6 JACK	HUBBELL	HXJ6GN
1	TWO HOLE GFI PLATE	HUBBELL	ISF3GY

 - INSTALLATION NOTES:**
1. USE ONLY SECURITY SCREWS WITH THESE PLATES.
 2. WHERE NOTED THE CABLES SHALL BE INSTALLED THRU SURFACE RACEWAY.
 3. LABEL THE FACEPLATE WITH A LASER PRINTED LABEL



PARTS		CONNECTIVITY CODE	
QTY	DESCRIPTION	MANUFACTURER	PART #
1	SURFACE BOX	HUBBELL	HSB20W
1	CAT-6 CABLES	MOHAWK	M58281
1	CAT-6 JACK	HUBBELL	HXJ6GN
1	RG-6 COAX	SEE SPECS	SEE SPECS
1	F-PASS THRU	CONTRACTOR	CONTRACTOR

- INSTALLATION NOTES:**
1. LABEL CABLE AND SURFACE BOX WITH CABLE NUMBER
 2. COIL DATA CABLE AND MOUNT SURFACE MOUNT BOX TO SIDE OF THE IN-WALL BACKBOX.

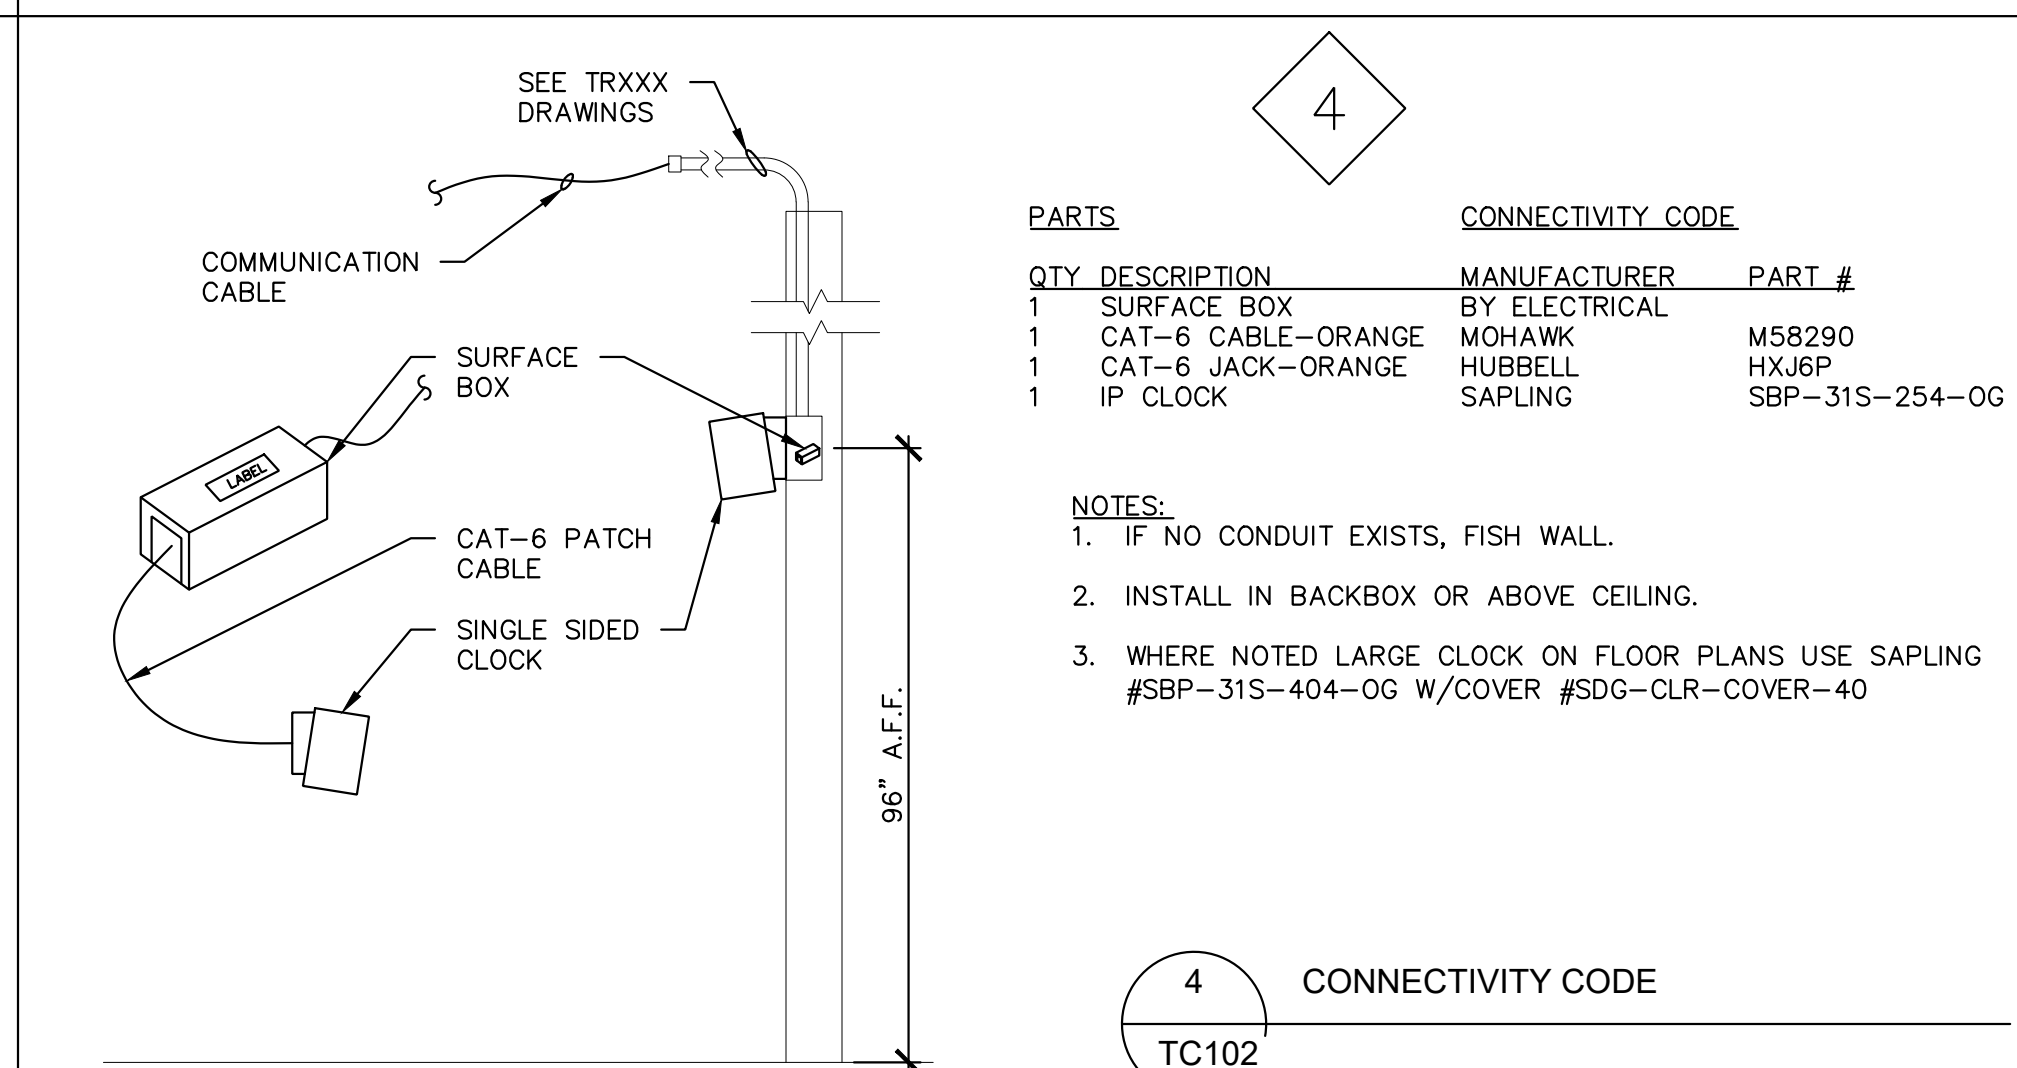

PARTS		CONNECTIVITY CODE	
QTY	DESCRIPTION	MANUFACTURER	PART #
1	SURFACE BOX	BY ELECTRICAL	
1	CAT-6 CABLE-ORANGE	MOHAWK	M58290
1	CAT-6 JACK-ORANGE	HUBBELL	HXJ6P
1	IP CLOCK	SAPLING	SBP-315-254-0G

- NOTES:**
1. IF NO CONDUIT EXISTS, FISH WALL.
 2. INSTALL IN BACKBOX OR ABOVE CEILING.
 3. WHERE NOTED LARGE CLOCK ON FLOOR PLANS USE SAPLING #SBP-315-404-0G W/COVER #SDG-CLR-COVER-40

ALL CONDUITS FOR SECURITY AND DATA CABLING ROUTE FOR CABLE TRAY

NO.	REVISION	DATE

STATE OF MICHIGAN
DEPARTMENT OF TECHNOLOGY, MANAGEMENT AND BUDGET
FACILITIES AND BUSINESS SERVICES ADMINISTRATION
DESIGN AND CONSTRUCTION DIVISION
ADAM LACH, RA, DIRECTOR

FILE NO.
491/20167.SDW

FUNDING CODE
171CODHHS7255

CONTRACT NO.
Y22003

CommtechDesign
6581 BELDING RD NE STE 101
ROCKFORD, MICHIGAN 49341
WWW.COMMTECHDESIGN.COM

WTA ARCHITECTS
100 S. Jefferson Ave, Suite 601
Saginaw, Michigan 48607
989 752 8107
COPYRIGHT © 2023

PROJECT TITLE
491/20167.SDW - PHASE 500:
CENTER FOR FORENSIC
PSYCHIATRY - CREATE
KITCHEN

SALINE, MICHIGAN

SHEET TITLE
CABLING
CONNECTIVITY
CODES

PROJECT NUMBER
2021094

SHEET NUMBER

PROJECT DATE
SEPTEMBER 6, 2023

TC102


CHECKED BY
BWE

GENERAL NOTES:

- CABINETS SHALL BE INSTALLED DIRECTLY BESIDE EACH OTHER & MECHANICALLY TO EACH OTHER.
- CABINETS SHALL BE SECURED TO THE FLOOR WITH ANCHORS. WALL MOUNTED CABINETS SHALL BE MOUNTED TO WALL SO TOP OF RACK IS NO HIGHER THAN 7' AFF.
- ALL USER DATA CABLES SHALL ROUTE IN THE CEILING & THEN ROUTE DOWN VERTICAL CABLE LADDER TO THE RACK. AT THE RACK/CABINET, PROVIDE A "DRIP LOOP" FOR ALL THE CABLES DRIP LOOP SHALL BE A MINIMUM OF ONE FOOT.
- CONNECT ALL NEW CABINETS AND CABLE LADDER TO THE GROUND BAR AS DESCRIBED IN THE GROUNDING DETAIL & THE GROUNDING SPECIFICATIONS.


KEYED NOTES:

- 1 CONTRACTOR SHALL INSTALL 12" CABLE LADDER VERTICALLY FROM TOP OF CABINET OR RACK TO THE CEILING AREA FOR ROUTING USER CABLES TO THE PANELS.
- INSTALL THE RACK WHERE SHOWN ON THE FLOORPLAN. VERIFY MATCHING PART NUMBERS TO EXISTING RACK PRIOR TO ORDERING. EQUIP THE RACK WITH ADJUSTABLE FEET

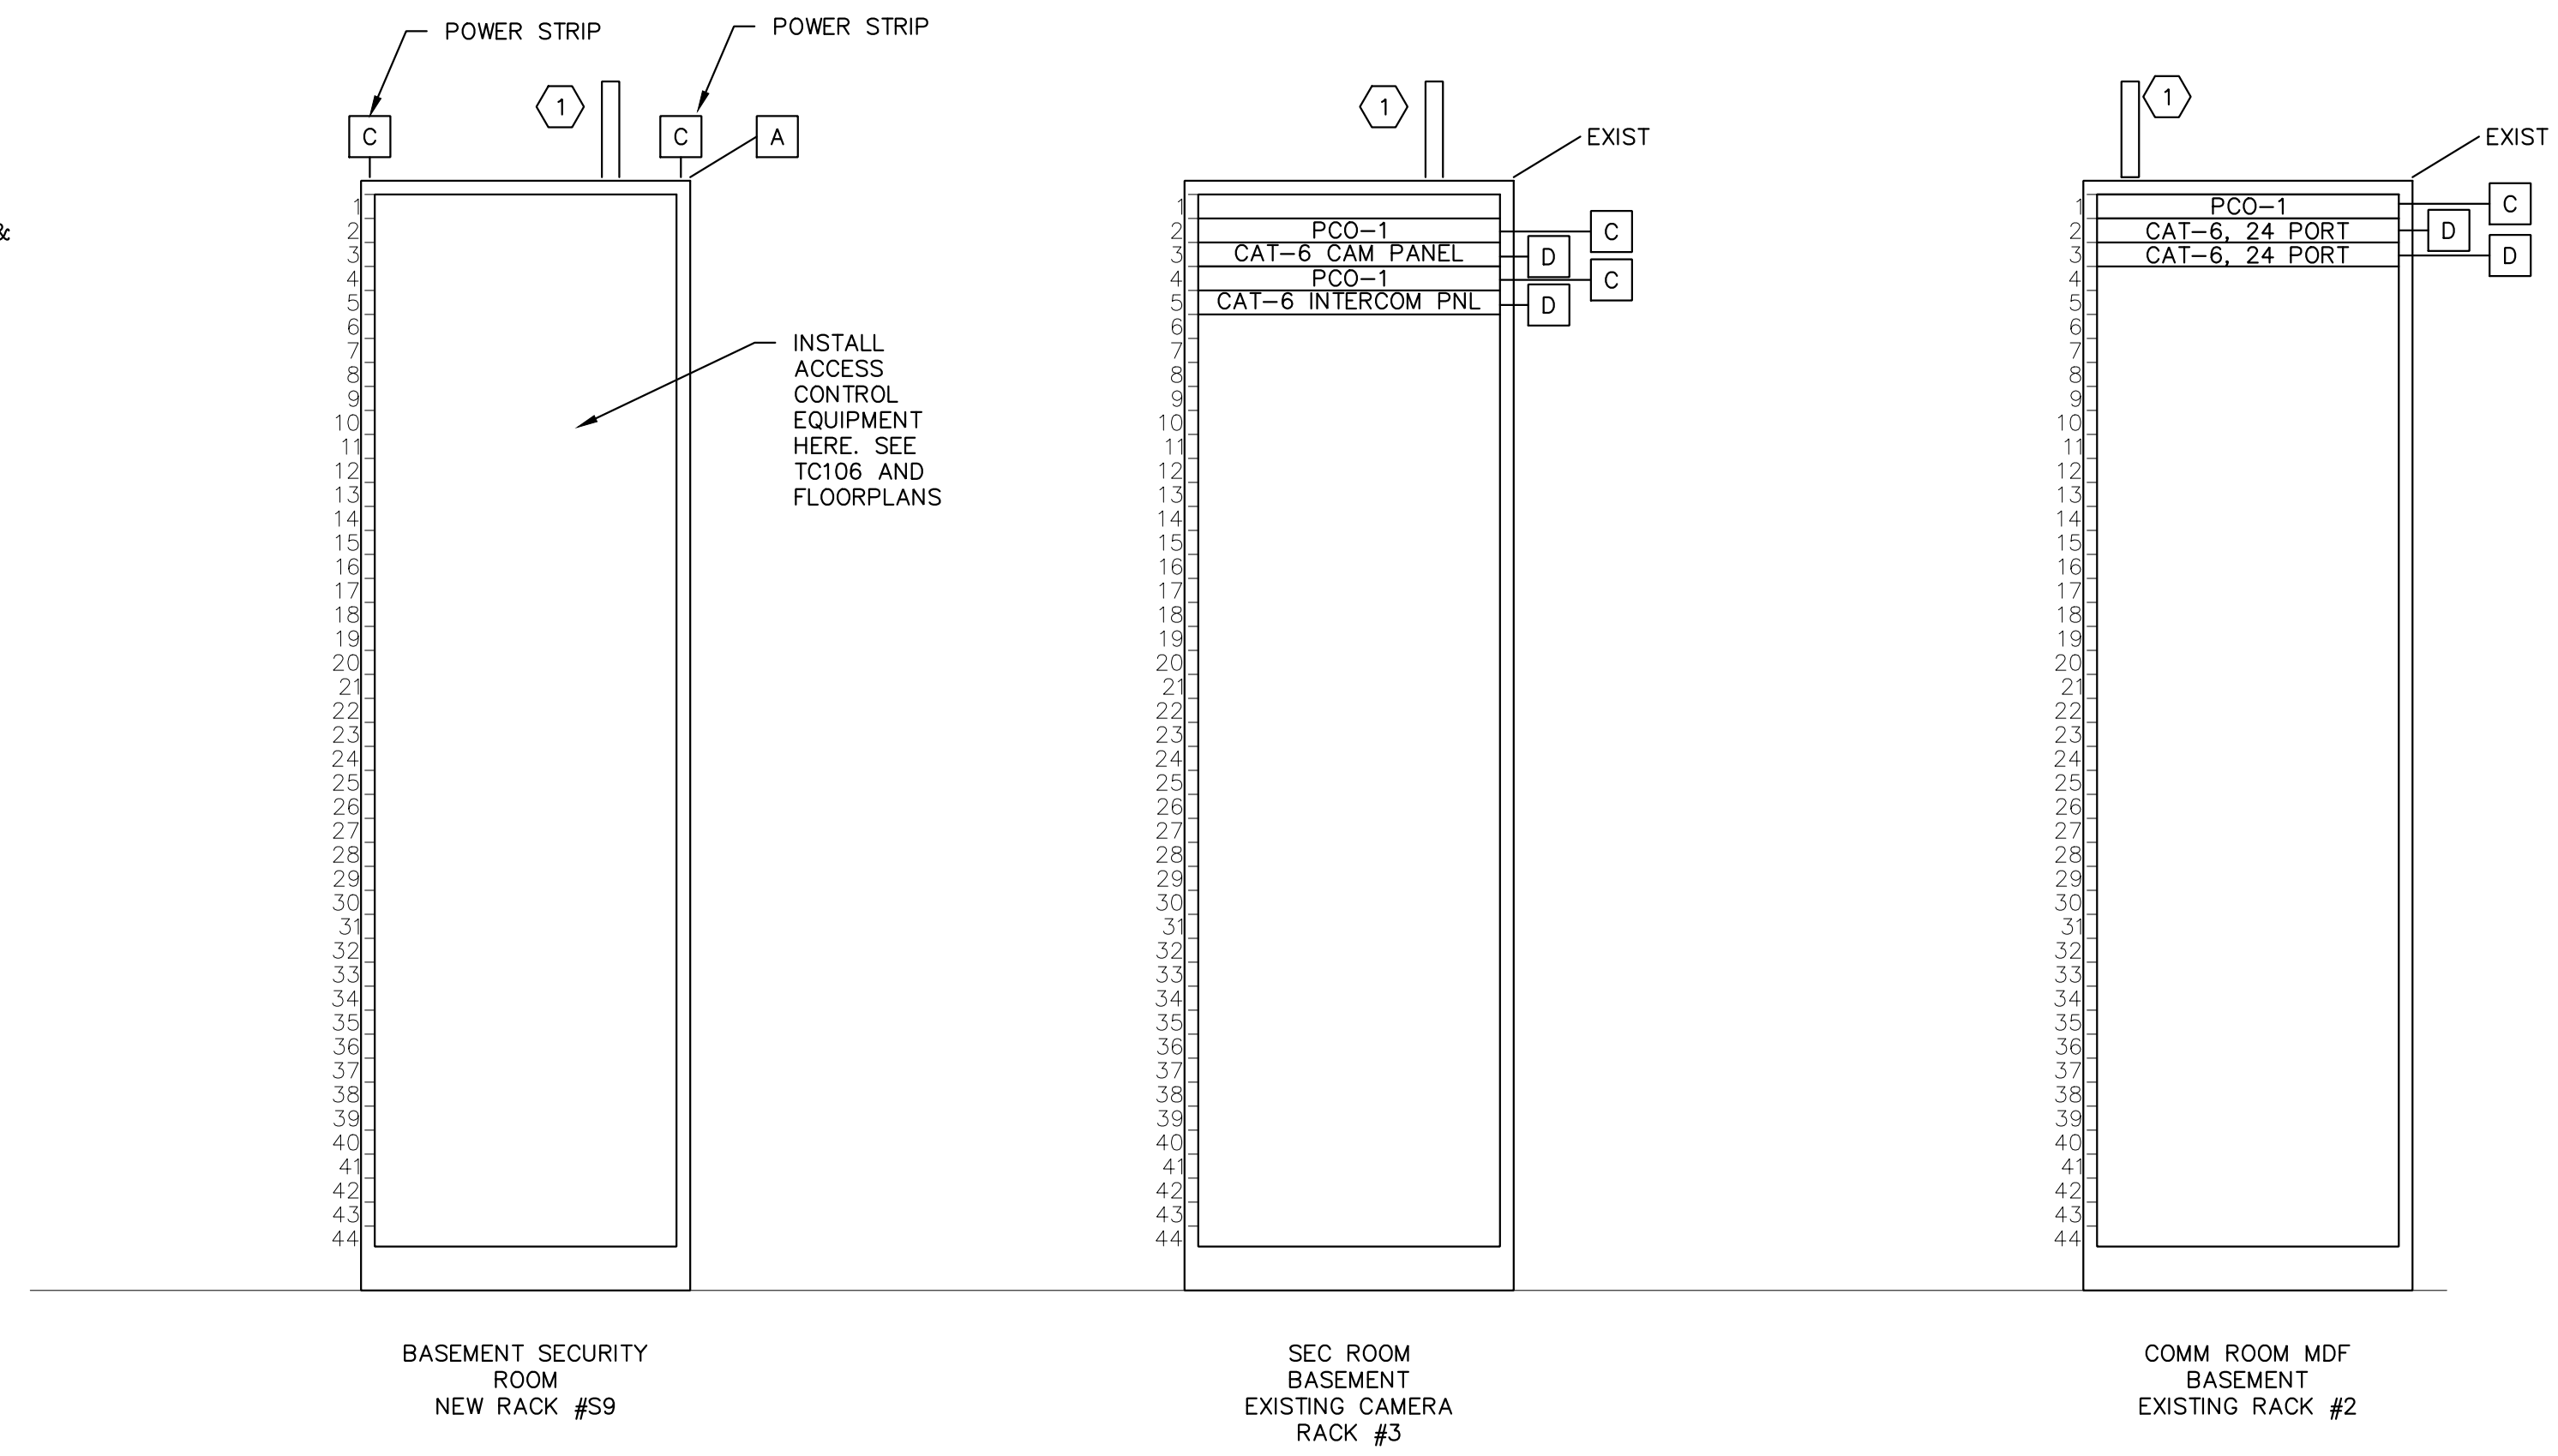

CONTRACTOR SHALL VERIFY EXISTING RACK LAYOUTS AND ADJUST ACCORDINGLY

1 MDF ROOM AND SEC ROOM-BASEMENT RACK LAYOUT
TC103

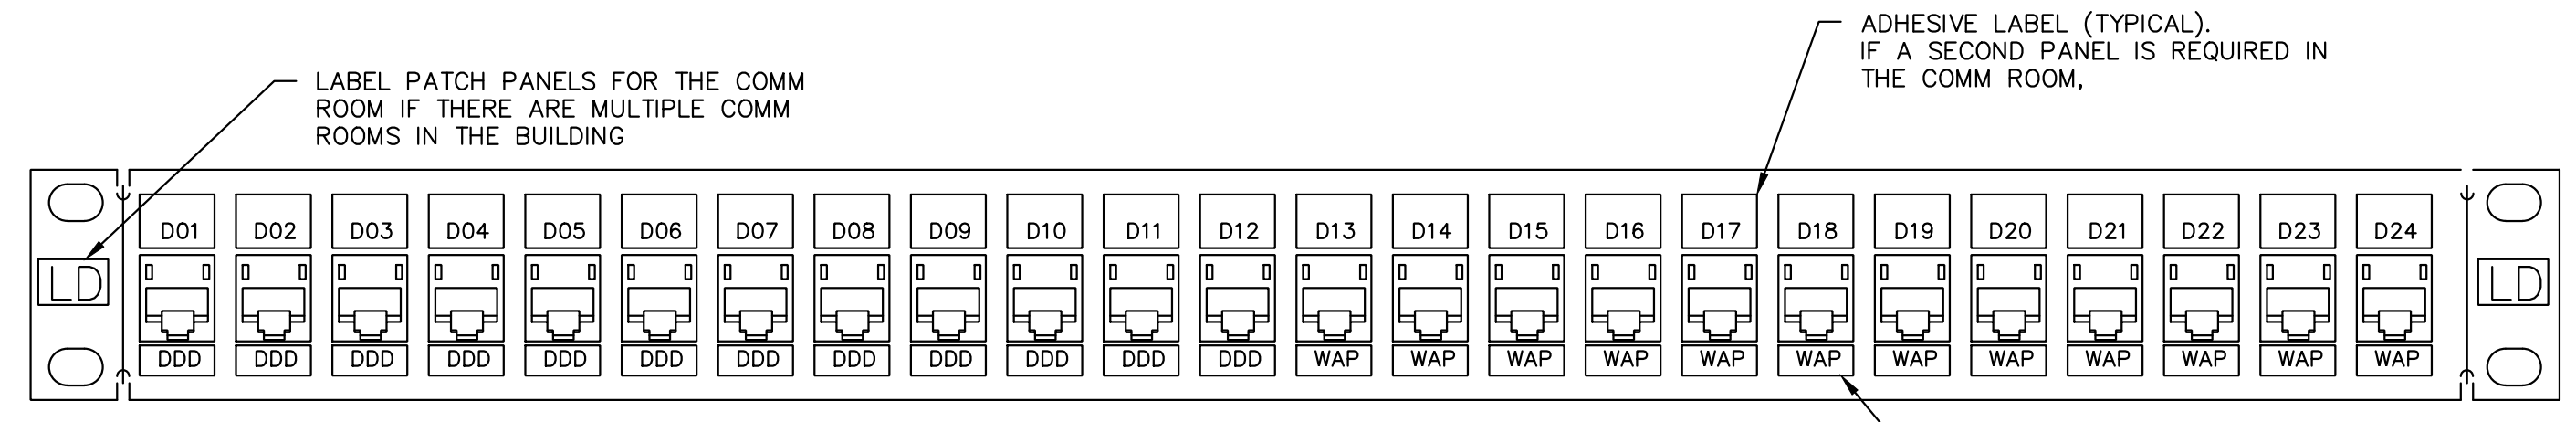

- NOTES:**
- INSTALL A LABEL TO EACH PATCH PANEL DETAILING THE COMM ROOM NUMBER AND PATCH PANEL NUMBER. LABEL EACH PANEL THAT IS FED FROM THAT COMM ROOM CONSECUTIVELY FROM 01-999
 - ALL LABELS ADDED TO THE PANEL SHALL BE LASER PRINTED AND CUT TO FIT. ALL NUMBERS SHALL EXACTLY ALIGN WITH THE LOCATION ON THE PATCH PANEL.
 - THE CABLES SHALL BE TERMINATED ON THE PATCH PANEL IN NUMERICAL ORDER. NO EXCEPTIONS.
 - ADD LABELS FOR CAMERA NUMBERS OR WAP NUMBERS DEPENDING UPON PATCH PANEL. SEE RACK LAYOUTS TO DETERMINE IF CAMERA AND WAP CABLES WILL BE ON SEPARATE OR SHARED PATCHPANELS
 - LABEL ALL PATCH PANEL PORTS EVEN IF NO CABLE IS INSTALLED
 - FILL IN EACH PATCH PANEL WITH CAT-6 MODULAR JACK EVEN IF NO CABLE IS INSTALLED TO THE JACK.


DATA CABLE LABELING A-Y-CC

LD = COMM ROOM DESIGNATION. ONLY USE THIS IF THERE ARE MULTIPLE COMM ROOMS IN THE BUILDING
DXX = DATA CABLE. 01-999. NUMBER PATCH PANELS IN EACH COMM ROOM AND THEN NUMBER CABLE AT PLATE CORRESPONDINGLY

DDD = CAMERA NUMBER. MEET WITH OWNER AND SECURITY CONTRACTOR TO OBTAIN THIS NUMBER

WAP = WAP NUMBER. MEET WITH OWNER TO OBTAIN THIS NUMBER

5 CAMERA OR WIRELESS PANEL LABELING
TC103

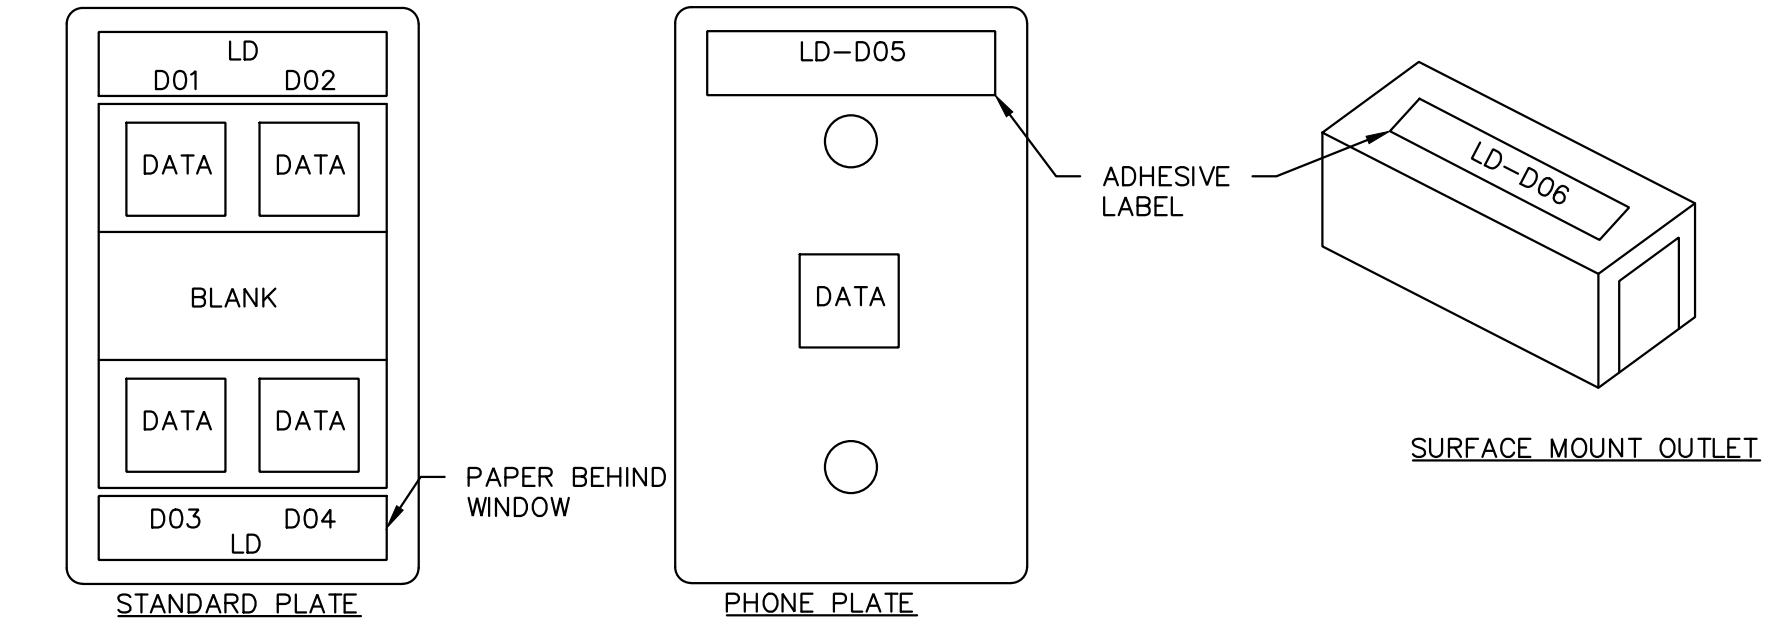


DATA CABLE LABEL:

LD = COMM ROOM DESIGNATION. ONLY USE THIS IF THERE ARE MULTIPLE COMM ROOMS IN EACH BUILDING
DXX = DATA CABLE. 01-999. NUMBER PATCH PANELS IN EACH COMM ROOM AND THEN NUMBER CABLE AT PLATE CORRESPONDINGLY

- NOTES:**
- INSTALL A PAPER LABEL BEHIND THE PLASTIC WINDOW IN STANDARD PLATES THAT ARE EQUIPPED WITH THE WINDOWS.
 - PROVIDE ADHESIVE LABELS ON WALL PHONE PLATES & SURFACE MOUNT OUTLETS & PLATES WITHOUT LABELING WINDOWS.

2 TYPICAL FACEPLATE LABELING
TC103

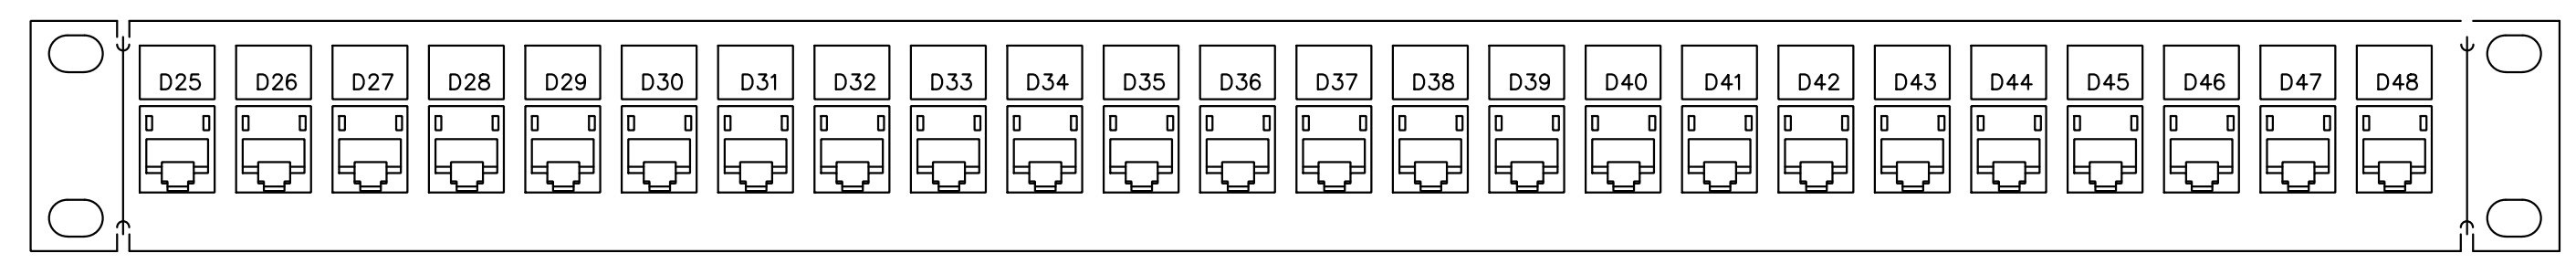


- NOTES:**
- INSTALL A LABEL TO EACH PATCH PANEL DETAILING THE COMM ROOM NUMBER AND PATCH PANEL NUMBER. LABEL EACH PANEL THAT IS FED FROM THAT COMM ROOM CONSECUTIVELY FROM 01-999
 - ALL LABELS ADDED TO THE PANEL SHALL BE LASER PRINTED AND CUT TO FIT. ALL NUMBERS SHALL EXACTLY ALIGN WITH THE LOCATION ON THE PATCH PANEL.
 - THE CONTRACTOR SHALL INSTALL A LABEL FOR EACH PORT.
 - INDIVIDUAL CABLES AT A SINGLE FACEPLATE SHALL BE LABELED IN SEQUENCE AS PER THE PATCH PANEL.
 - THE CABLES SHALL BE TERMINATED ON THE PATCH PANEL IN NUMERICAL ORDER. NO EXCEPTIONS.
 - LABEL ALL PATCH PANEL PORTS EVEN IF NO CABLE IS INSTALLED
 - FILL IN EACH PATCH PANEL WITH CAT-6 MODULAR JACK EVEN IF NO CABLE IS INSTALLED TO THE JACK.

DATA CABLE LABEL:

LD = COMM ROOM DESIGNATION. ONLY USE THIS IF THERE ARE MULTIPLE COMM ROOMS IN THE BUILDING
DXX = DATA CABLE. 01-999. NUMBER PATCH PANELS IN EACH COMM ROOM AND THEN NUMBER CABLE AT PLATE CORRESPONDINGLY

6 CAT-6 DATA PANEL LABELING
TC103

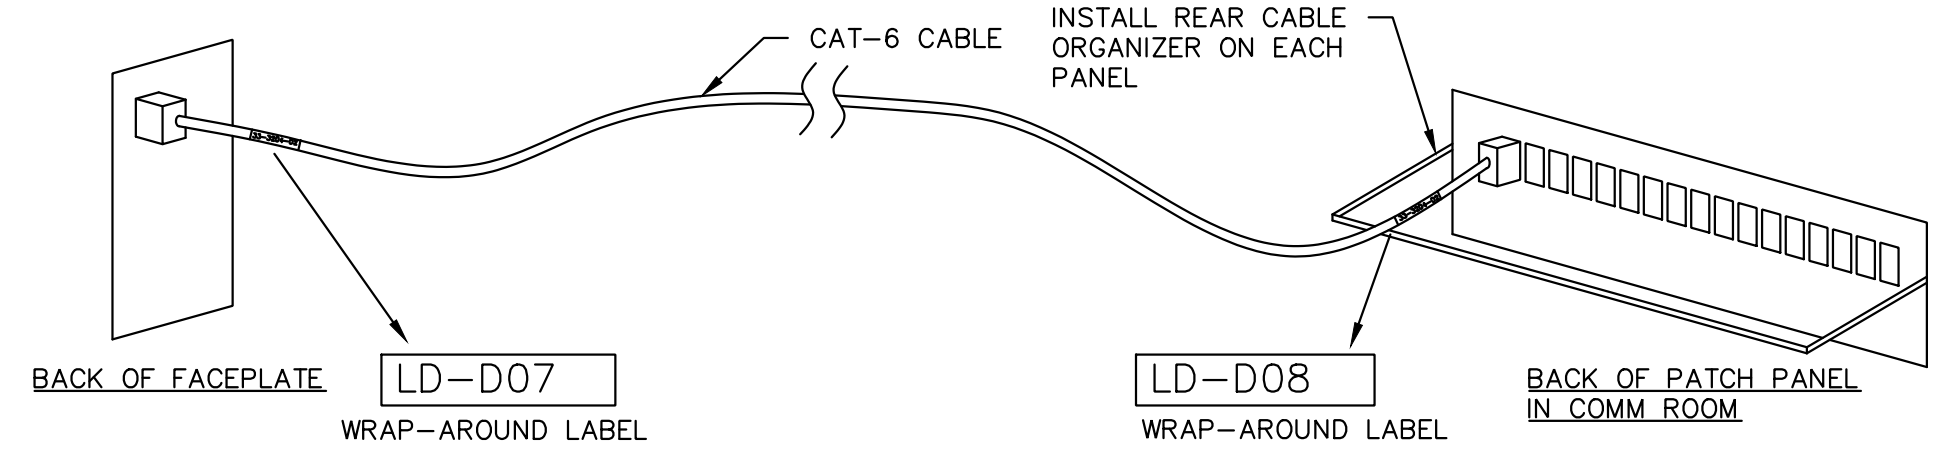


- NOTES:**
- INSTALL A WRAP-AROUND LABEL AT EACH END OF EACH CABLE.
 - WRAP-AROUND LABELS SHALL BE LASER-PRINTED AND SHALL BE SELF-LAMINATING.

DATA CABLE LABEL:


LD = COMM ROOM DESIGNATION. ONLY USE THIS IF THERE ARE MULTIPLE COMM ROOMS IN EACH BUILDING
DXX = DATA CABLE. 01-999. NUMBER PATCH PANELS IN EACH COMM ROOM AND THEN NUMBER CABLE AT PLATE CORRESPONDINGLY

3 TYPICAL CABLE LABELING AT FACEPLATE & PATCH PANEL
TC103

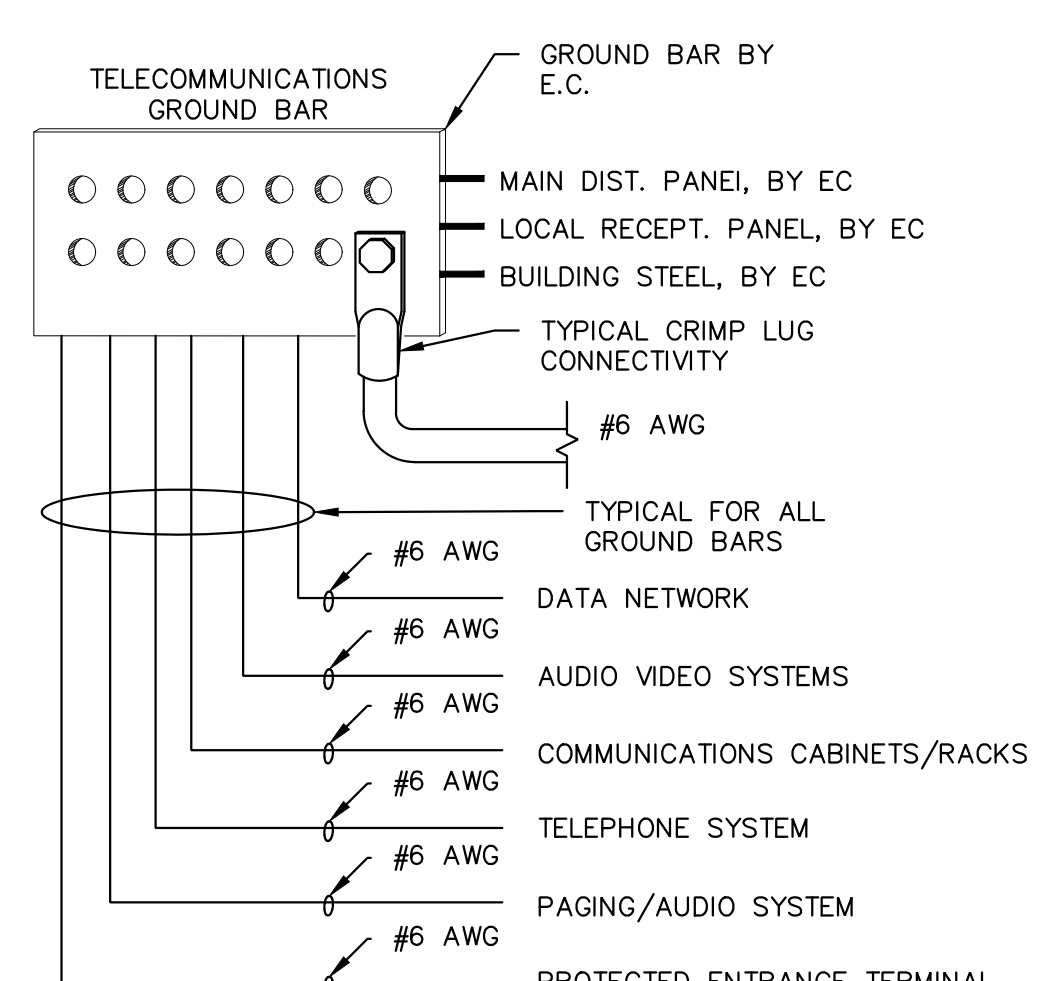

- GROUNDING NOTES:**
- CONNECTIONS TO ALL NEW COMMUNICATIONS EQUIPMENT & PANELS.
 - CONNECT GROUND BAR TO ALL ITEMS SHOWN & AS DIRECTED IN THE GROUNDING SPECIFICATIONS.
 - ALL GROUND CONNECTIONS SHALL BE MADE WITH CRIMP LUGS ONLY. THIS APPLIES TO ALL CONNECTIONS TO THE GROUND BAR & THE CONNECTIONS TO THE ASSOCIATED EQUIPMENT.
 - GROUND CONNECTIONS SHALL BE MADE WITH A MINIMUM OF #6 AWG CABLE.
 - ALL CONNECTIONS TO THE GROUND BAR SHALL BE MADE WITH PHOSPHOR BRONZE BOLTS & NUTS.
 - ALL GROUND WIRES SHALL HAVE GREEN INSULATION UNLESS INSTALLED IN A PLENUM AREA. GROUND CABLES THAT MUST BE INSTALLED IN A PLENUM AREA SHALL BE BARE COPPER WIRE WITH GREEN TAPE AT ENDS.

7 COMMUNICATIONS GROUNDING DETAIL
TC103

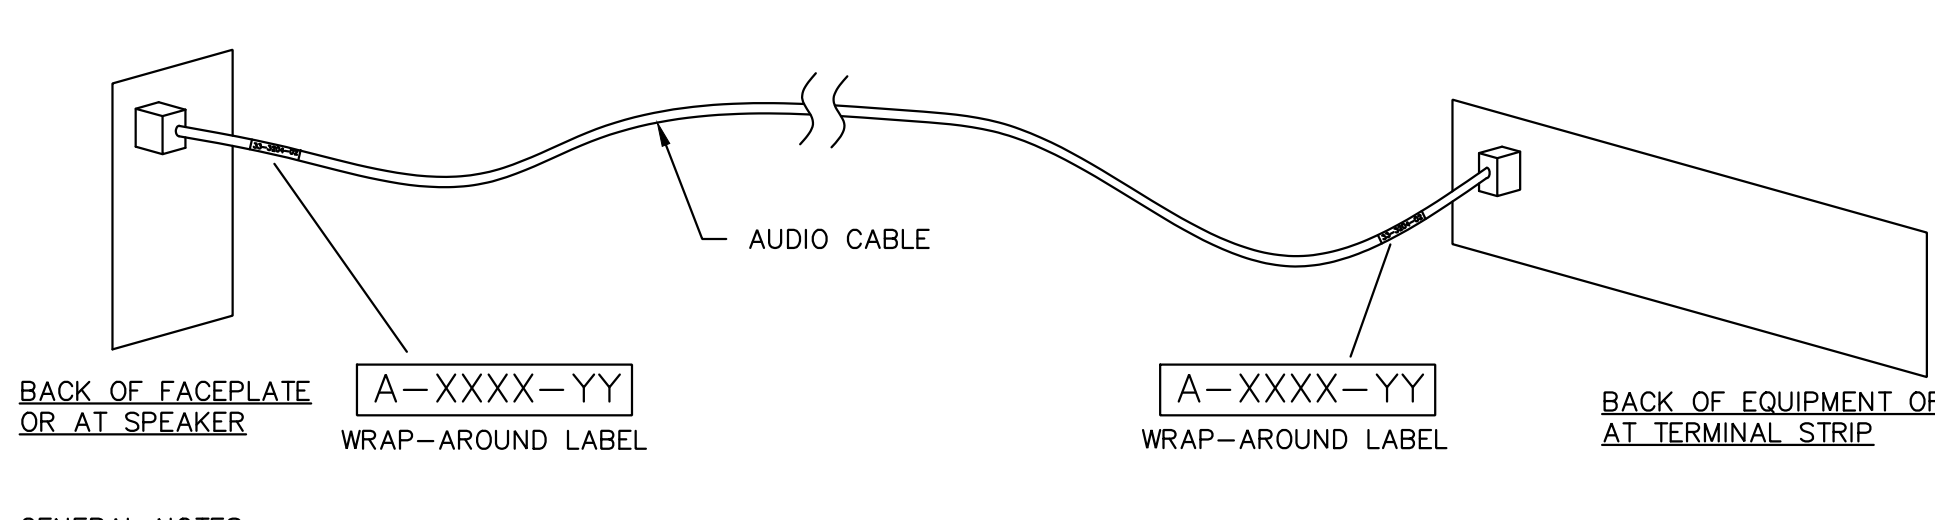

- GENERAL NOTES:**
- INSTALL A WRAP-AROUND LABEL AT EACH END OF EACH CABLE.
 - WRAP-AROUND LABELS SHALL BE LASER-PRINTED AND SHALL BE SELF-LAMINATING.

A = AUDIO/VIDEO CABINET
XXXX = SPK FOR SPEAKER LINE
XXXX = LINE FOR LINE LEVEL
XXXX = MIC FOR MICROPHONE
XXXX = CTRL FOR CONTROL LINE
YY = AUDIO ZONE FOR SPEAKER
YY = FACEPLATE NUMBER FOR LINE AND MIC

4 TYPICAL CABLE LABELING FOR AUDIO CABLES
TC103

NO.	REVISION	DATE

STATE OF MICHIGAN
DEPARTMENT OF TECHNOLOGY, MANAGEMENT AND BUDGET
FACILITIES AND BUSINESS SERVICES ADMINISTRATION
DESIGN AND CONSTRUCTION DIVISION
ADAM LACH, RA, DIRECTOR

FILE NO.
491/20167.SDW

FUNDING CODE
171CODHHS7255

CONTRACT NO.
Y22003

CommtechDesign
6581 BELDING RD NE STE 101
ROCKFORD, MICHIGAN 49341
WWW.COMMTECHDESIGN.COM






WTA ARCHITECTS
100 S. Jefferson Ave. Suite 601
Saginaw, Michigan 48607
989 752 8107
COPYRIGHT © 2023

PROJECT TITLE
491/20167.SDW - PHASE 500:
CENTER FOR FORENSIC
PSYCHIATRY - CREATE
KITCHEN

SALINE, MICHIGAN



SHEET TITLE
CABLING RACK LAYOUTS & DETAILS

PROJECT NUMBER 2021094	SHEET NUMBER TC103
PROJECT DATE SEPTEMBER 6, 2023	
CHECKED BY BWE	

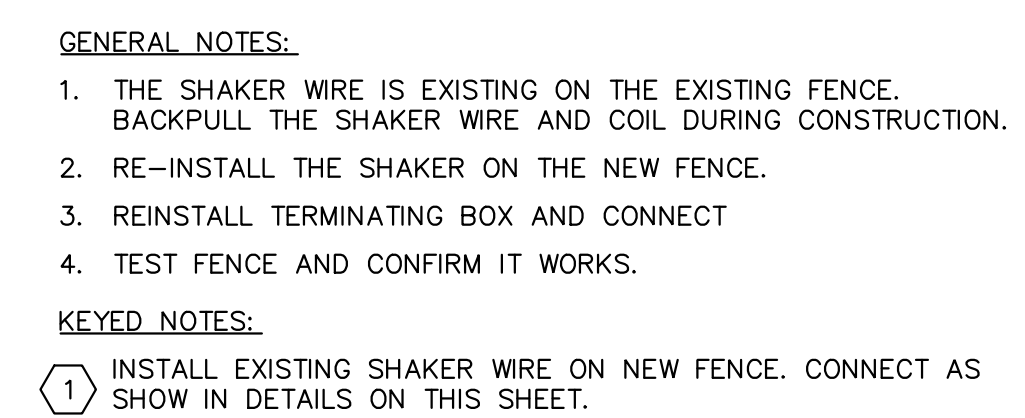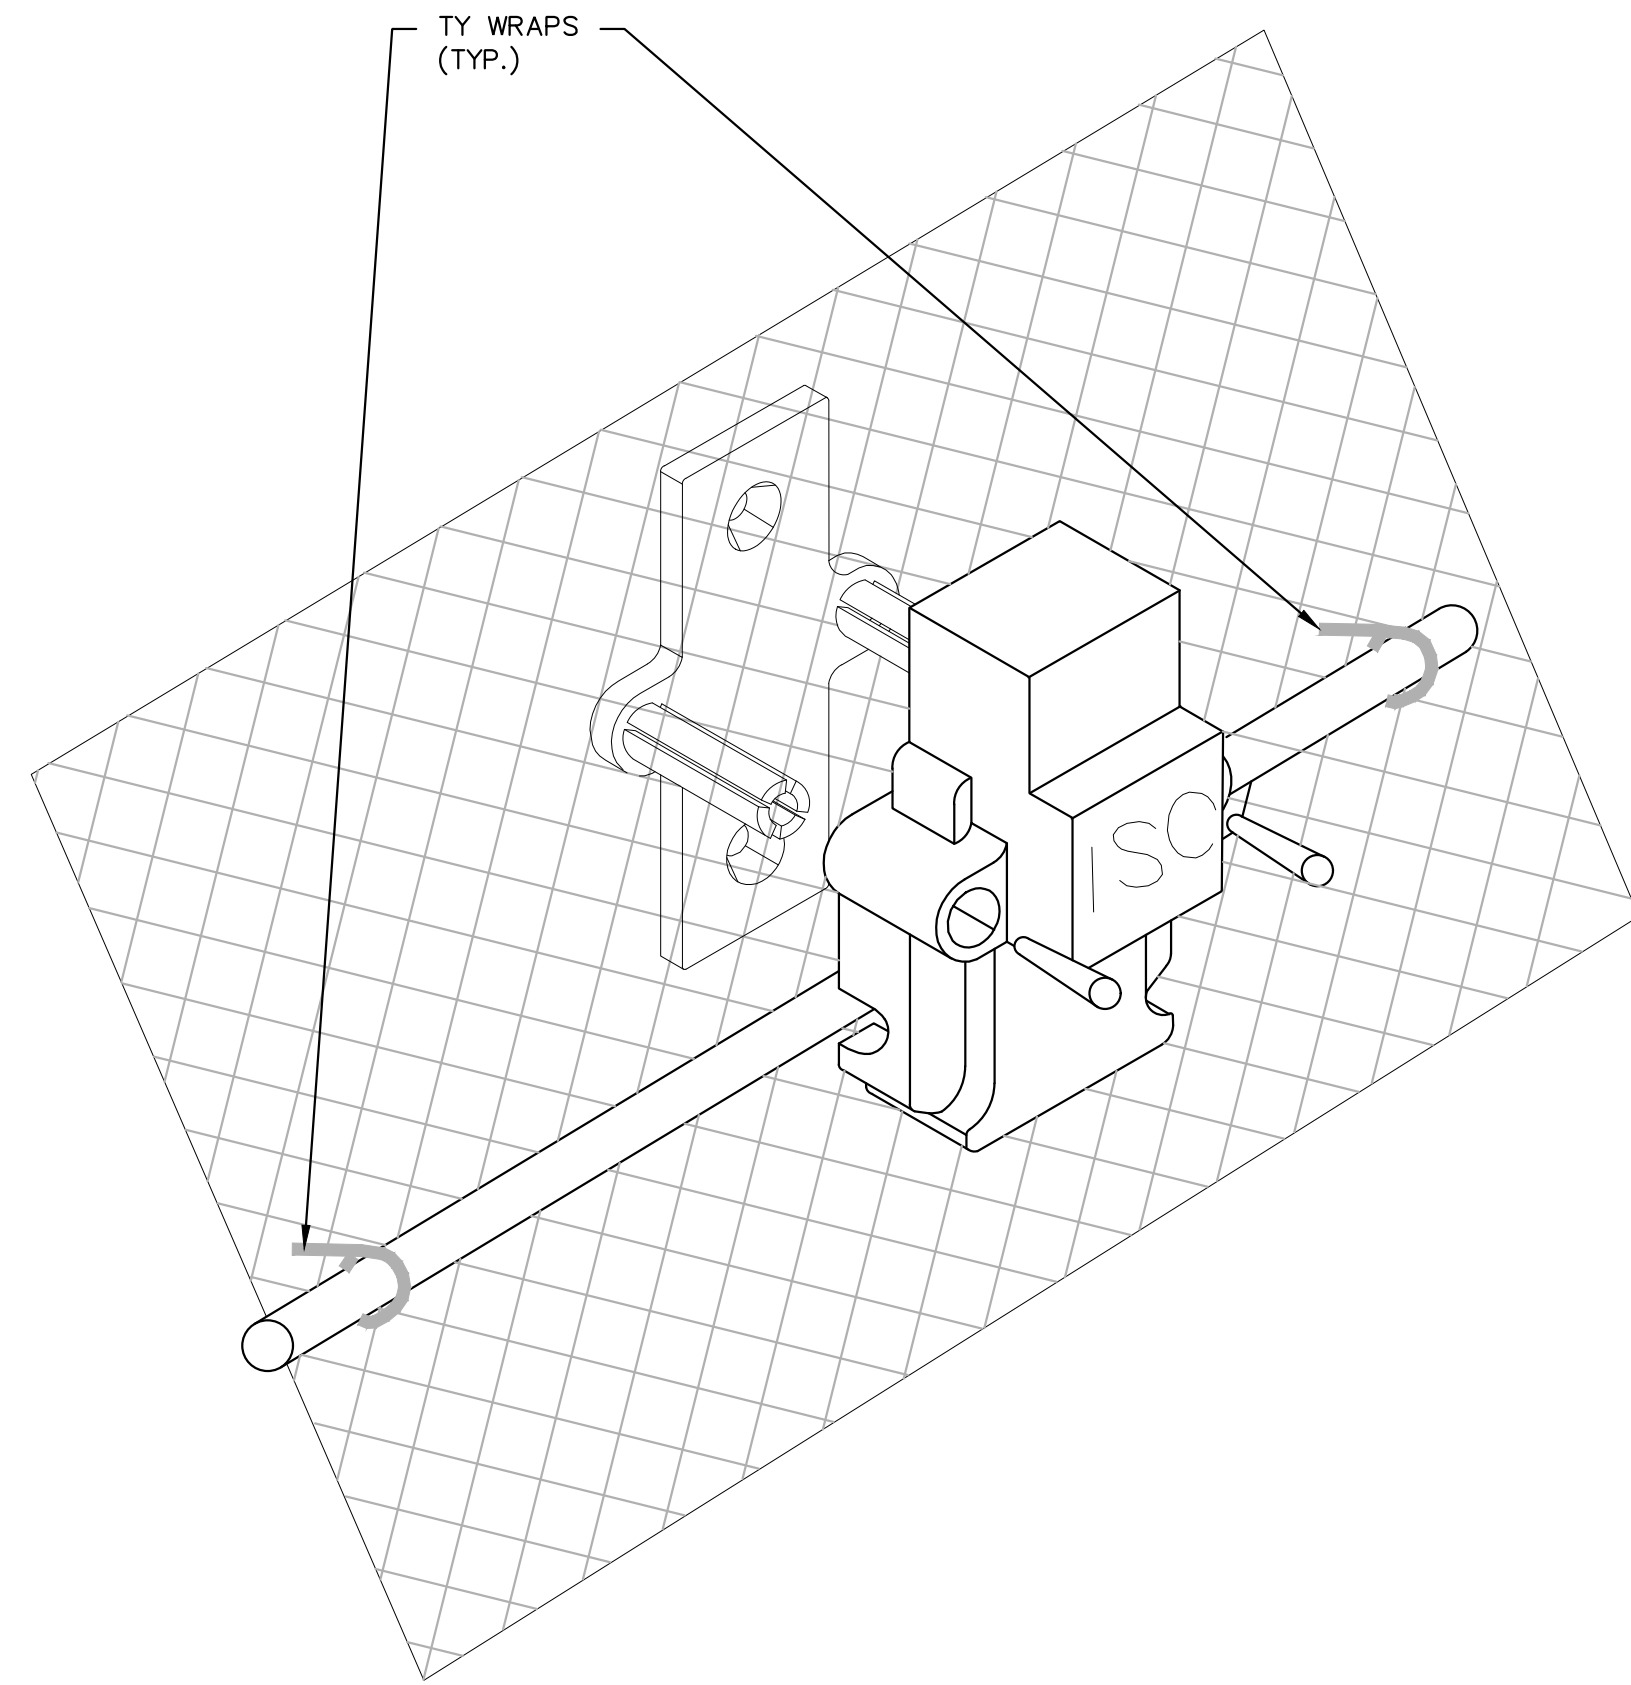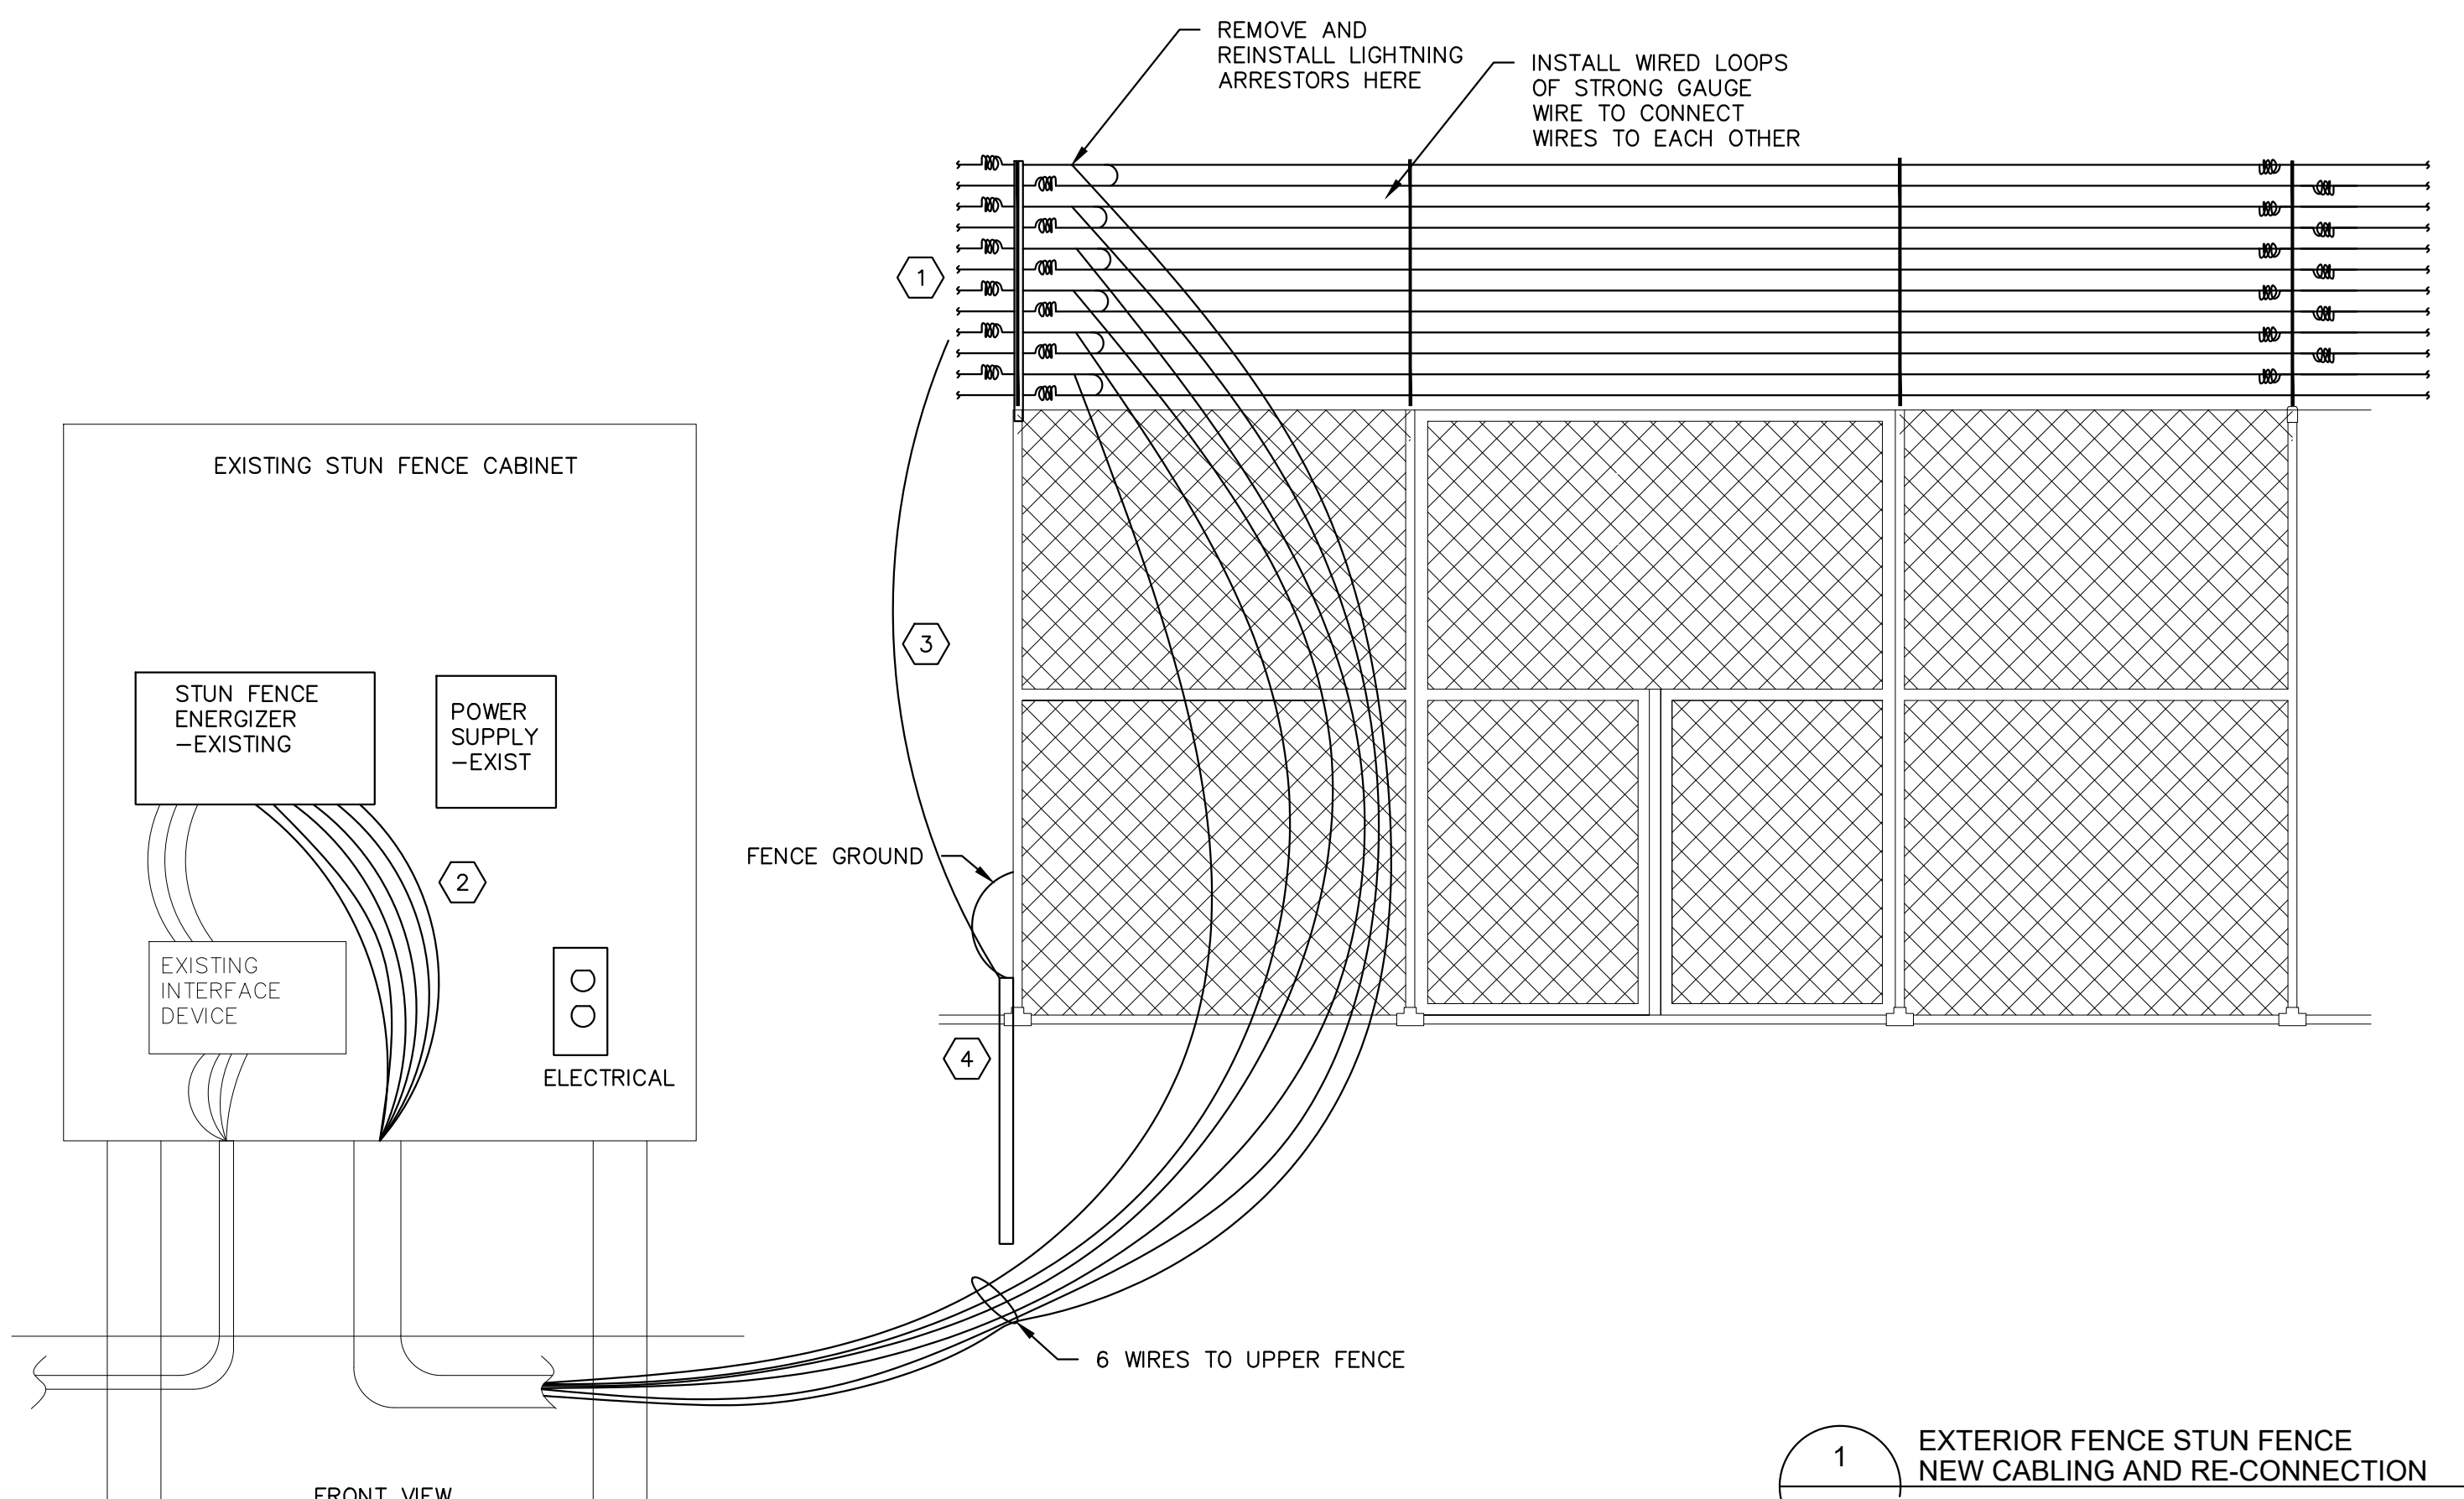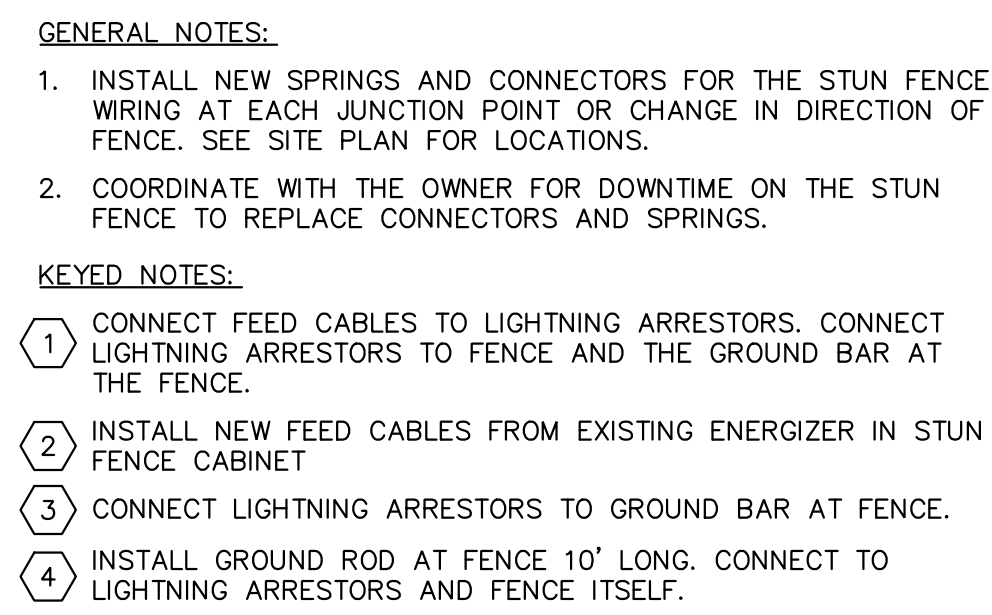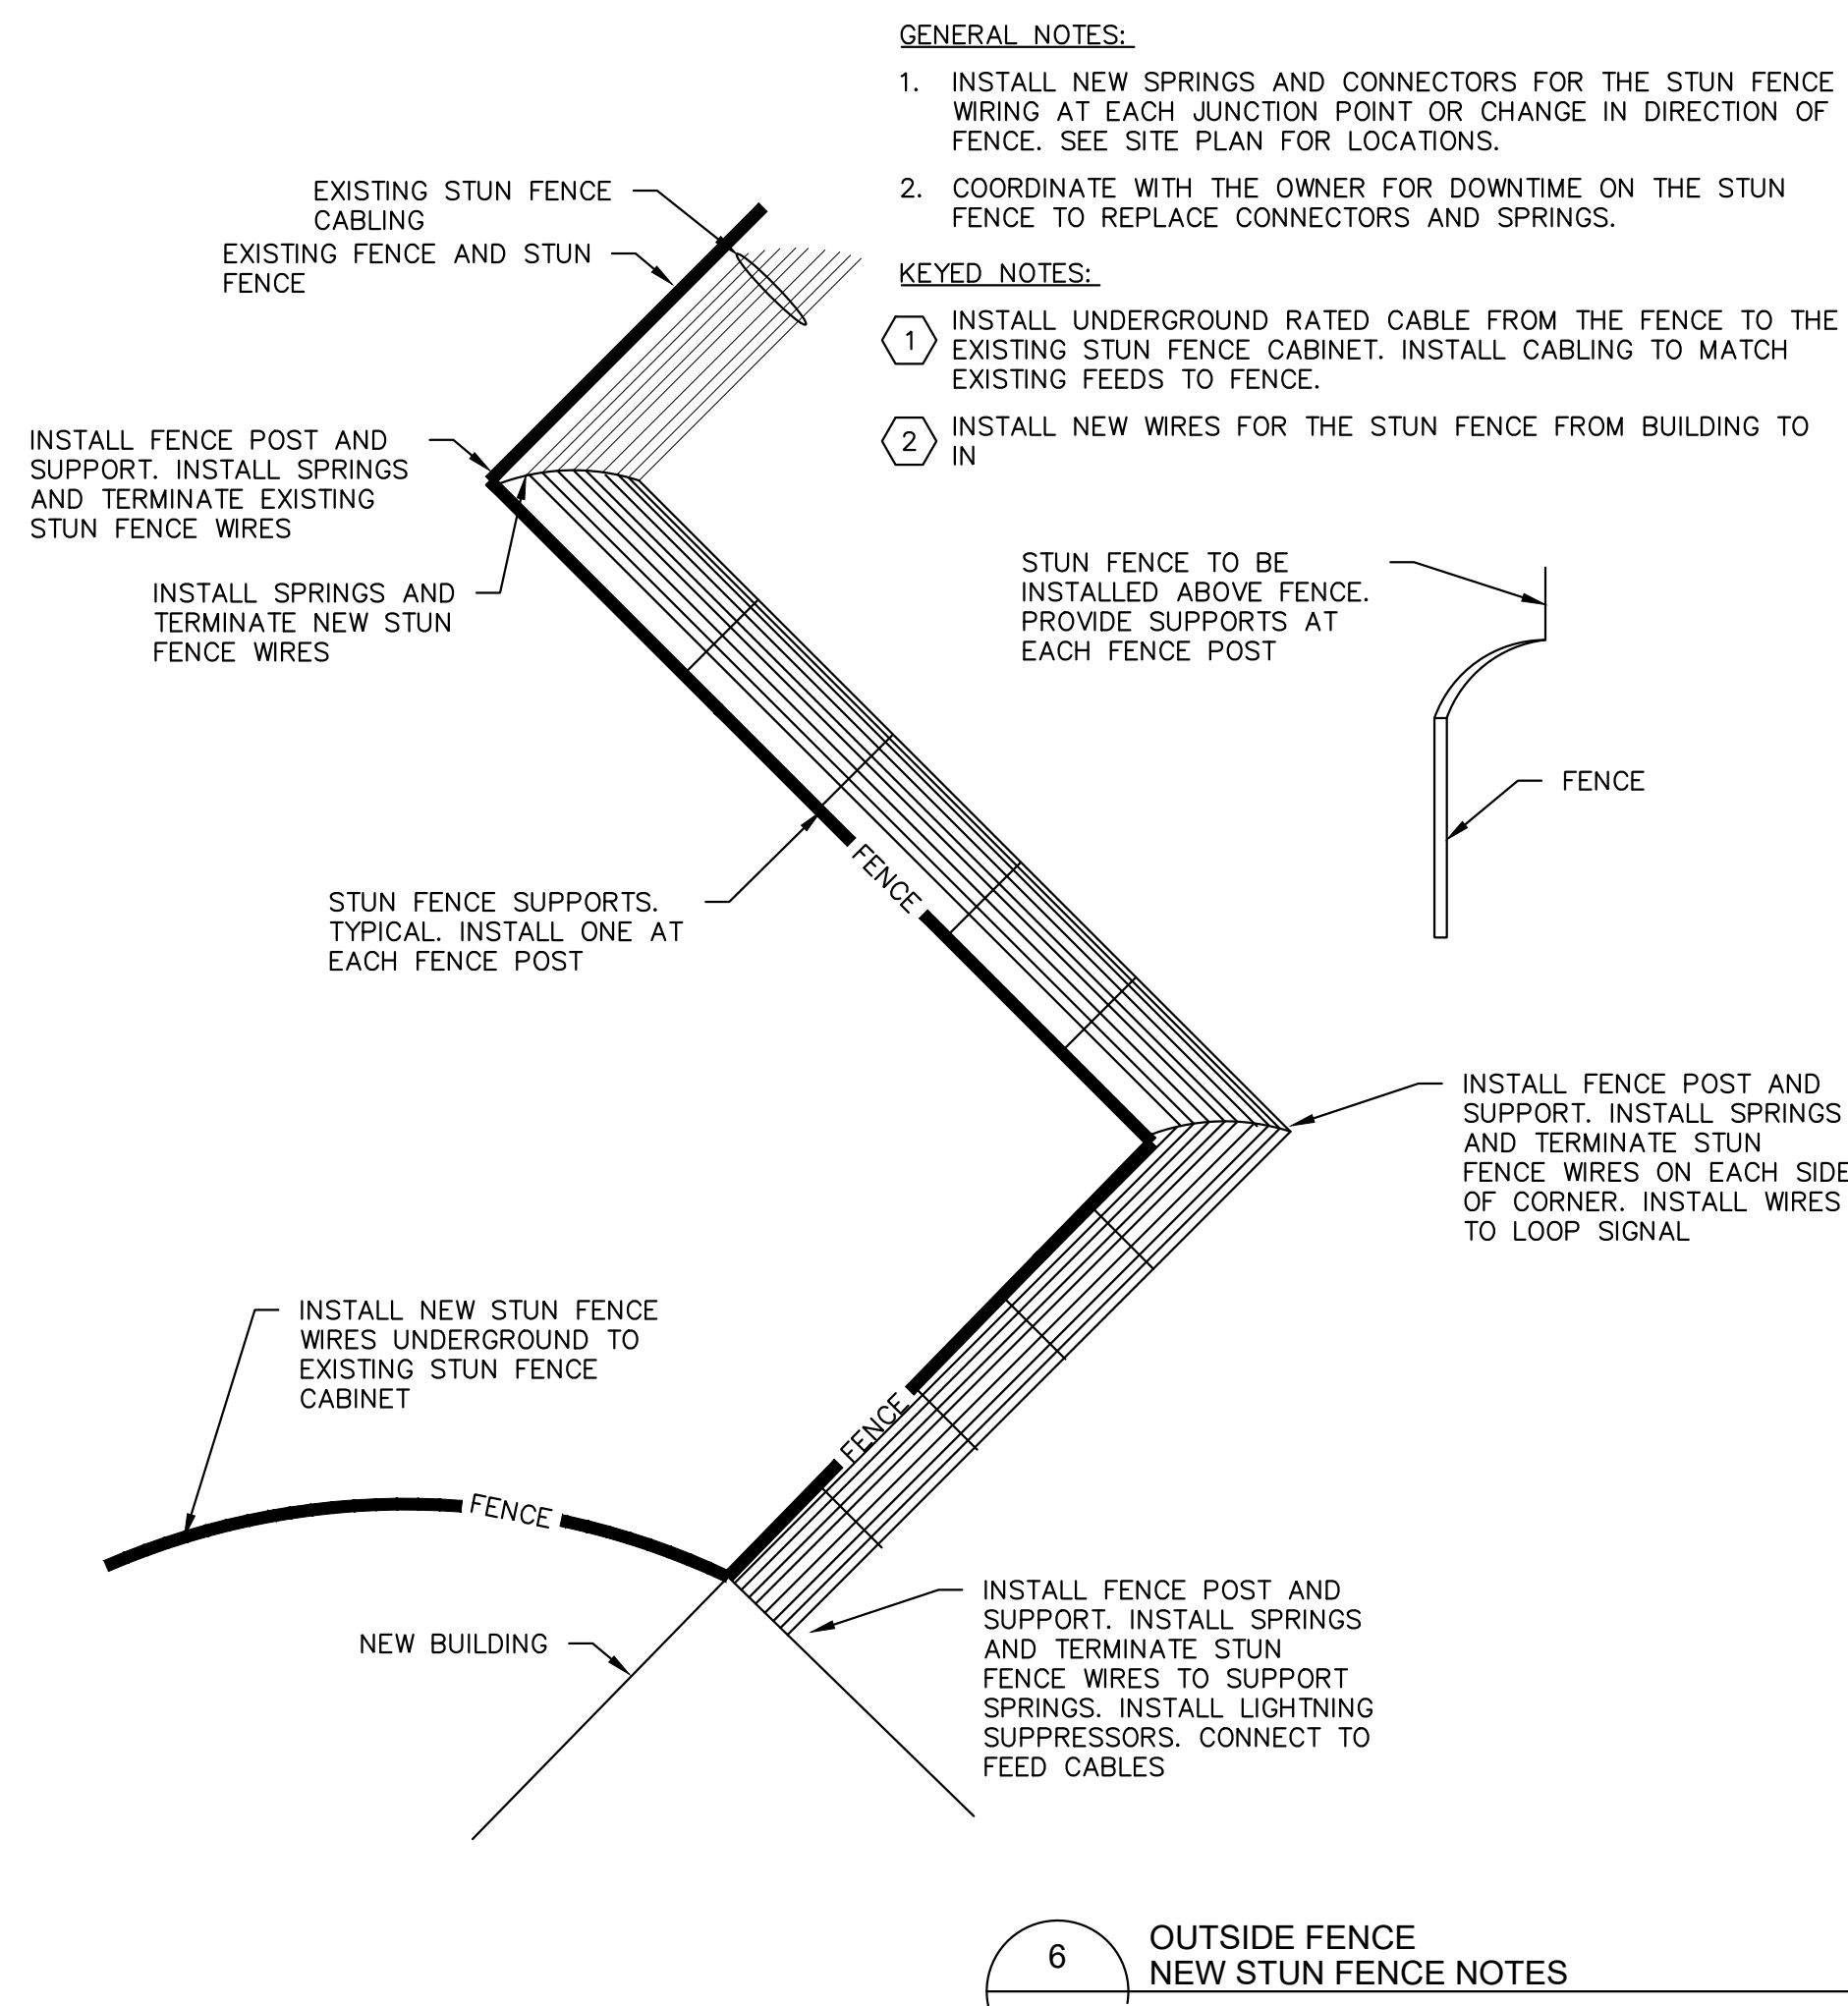

NOTE:

1. TIE SENSOR COIL TO THE FENCE AND OTHER WIRES.

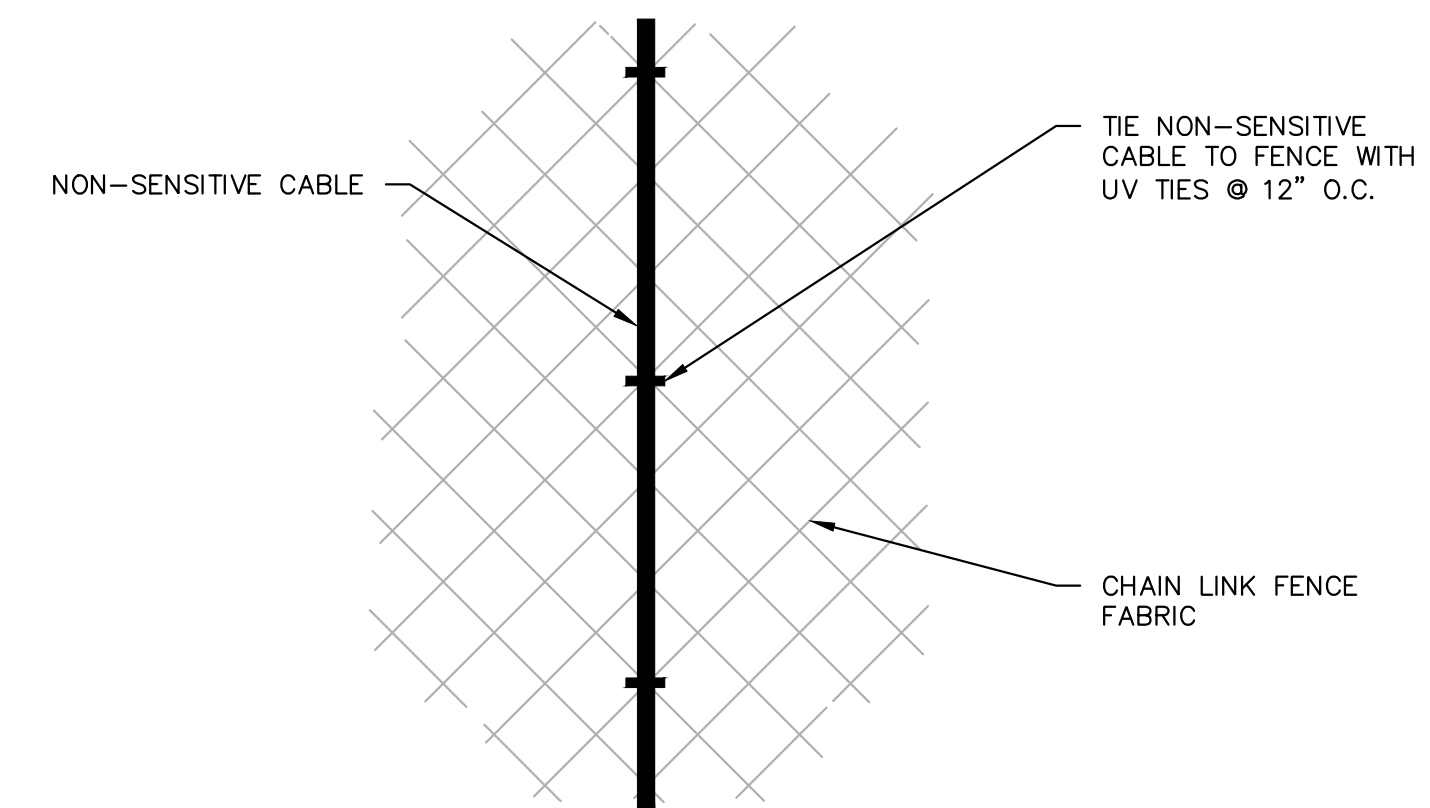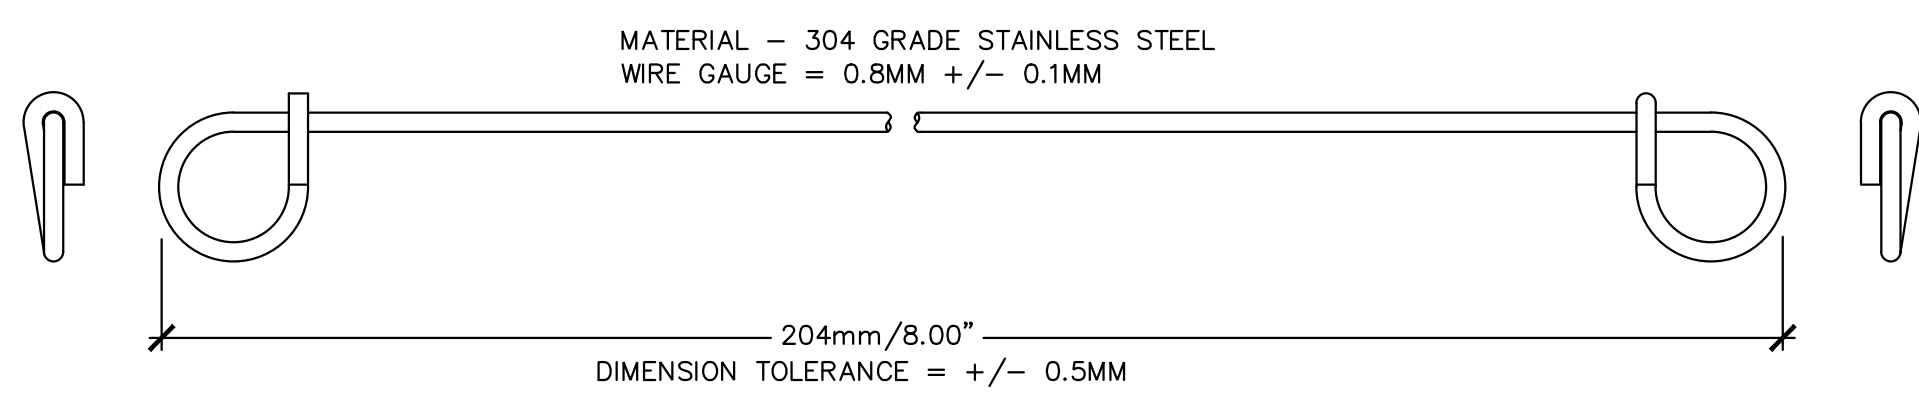

NO.	REVISION	DATE

STATE OF MICHIGAN
DEPARTMENT OF TECHNOLOGY, MANAGEMENT AND BUDGET
FACILITIES AND BUSINESS SERVICES ADMINISTRATION
DESIGN AND CONSTRUCTION DIVISION
ADAM LACH, RA, DIRECTOR

FILE NO.
491/20167.SDW

FUNDING CODE
171CODHHS7255

CONTRACT NO.
Y22003

CommtechDesign
6581 BELDING RD NE STE 101
ROCKFORD, MICHIGAN 49341
WWW.COMMTECHDESIGN.COM

WTAARCH.COM

WTA ARCHITECTS
100 S. Jefferson Ave, Suite 601
Saginaw, Michigan 48607
989 752 8107

COPYRIGHT © 2023

PROJECT TITLE
491/20167.SDW - PHASE 500:
CENTER FOR FORENSIC
PSYCHIATRY - CREATE
KITCHEN

SALINE, MICHIGAN





SHEET TITLE
**FENCE DETECTION
DETAILS**

PROJECT NUMBER
2021094

SHEET NUMBER
TC104

PROJECT DATE
SEPTEMBER 6, 2023

CHECKED BY
BWE

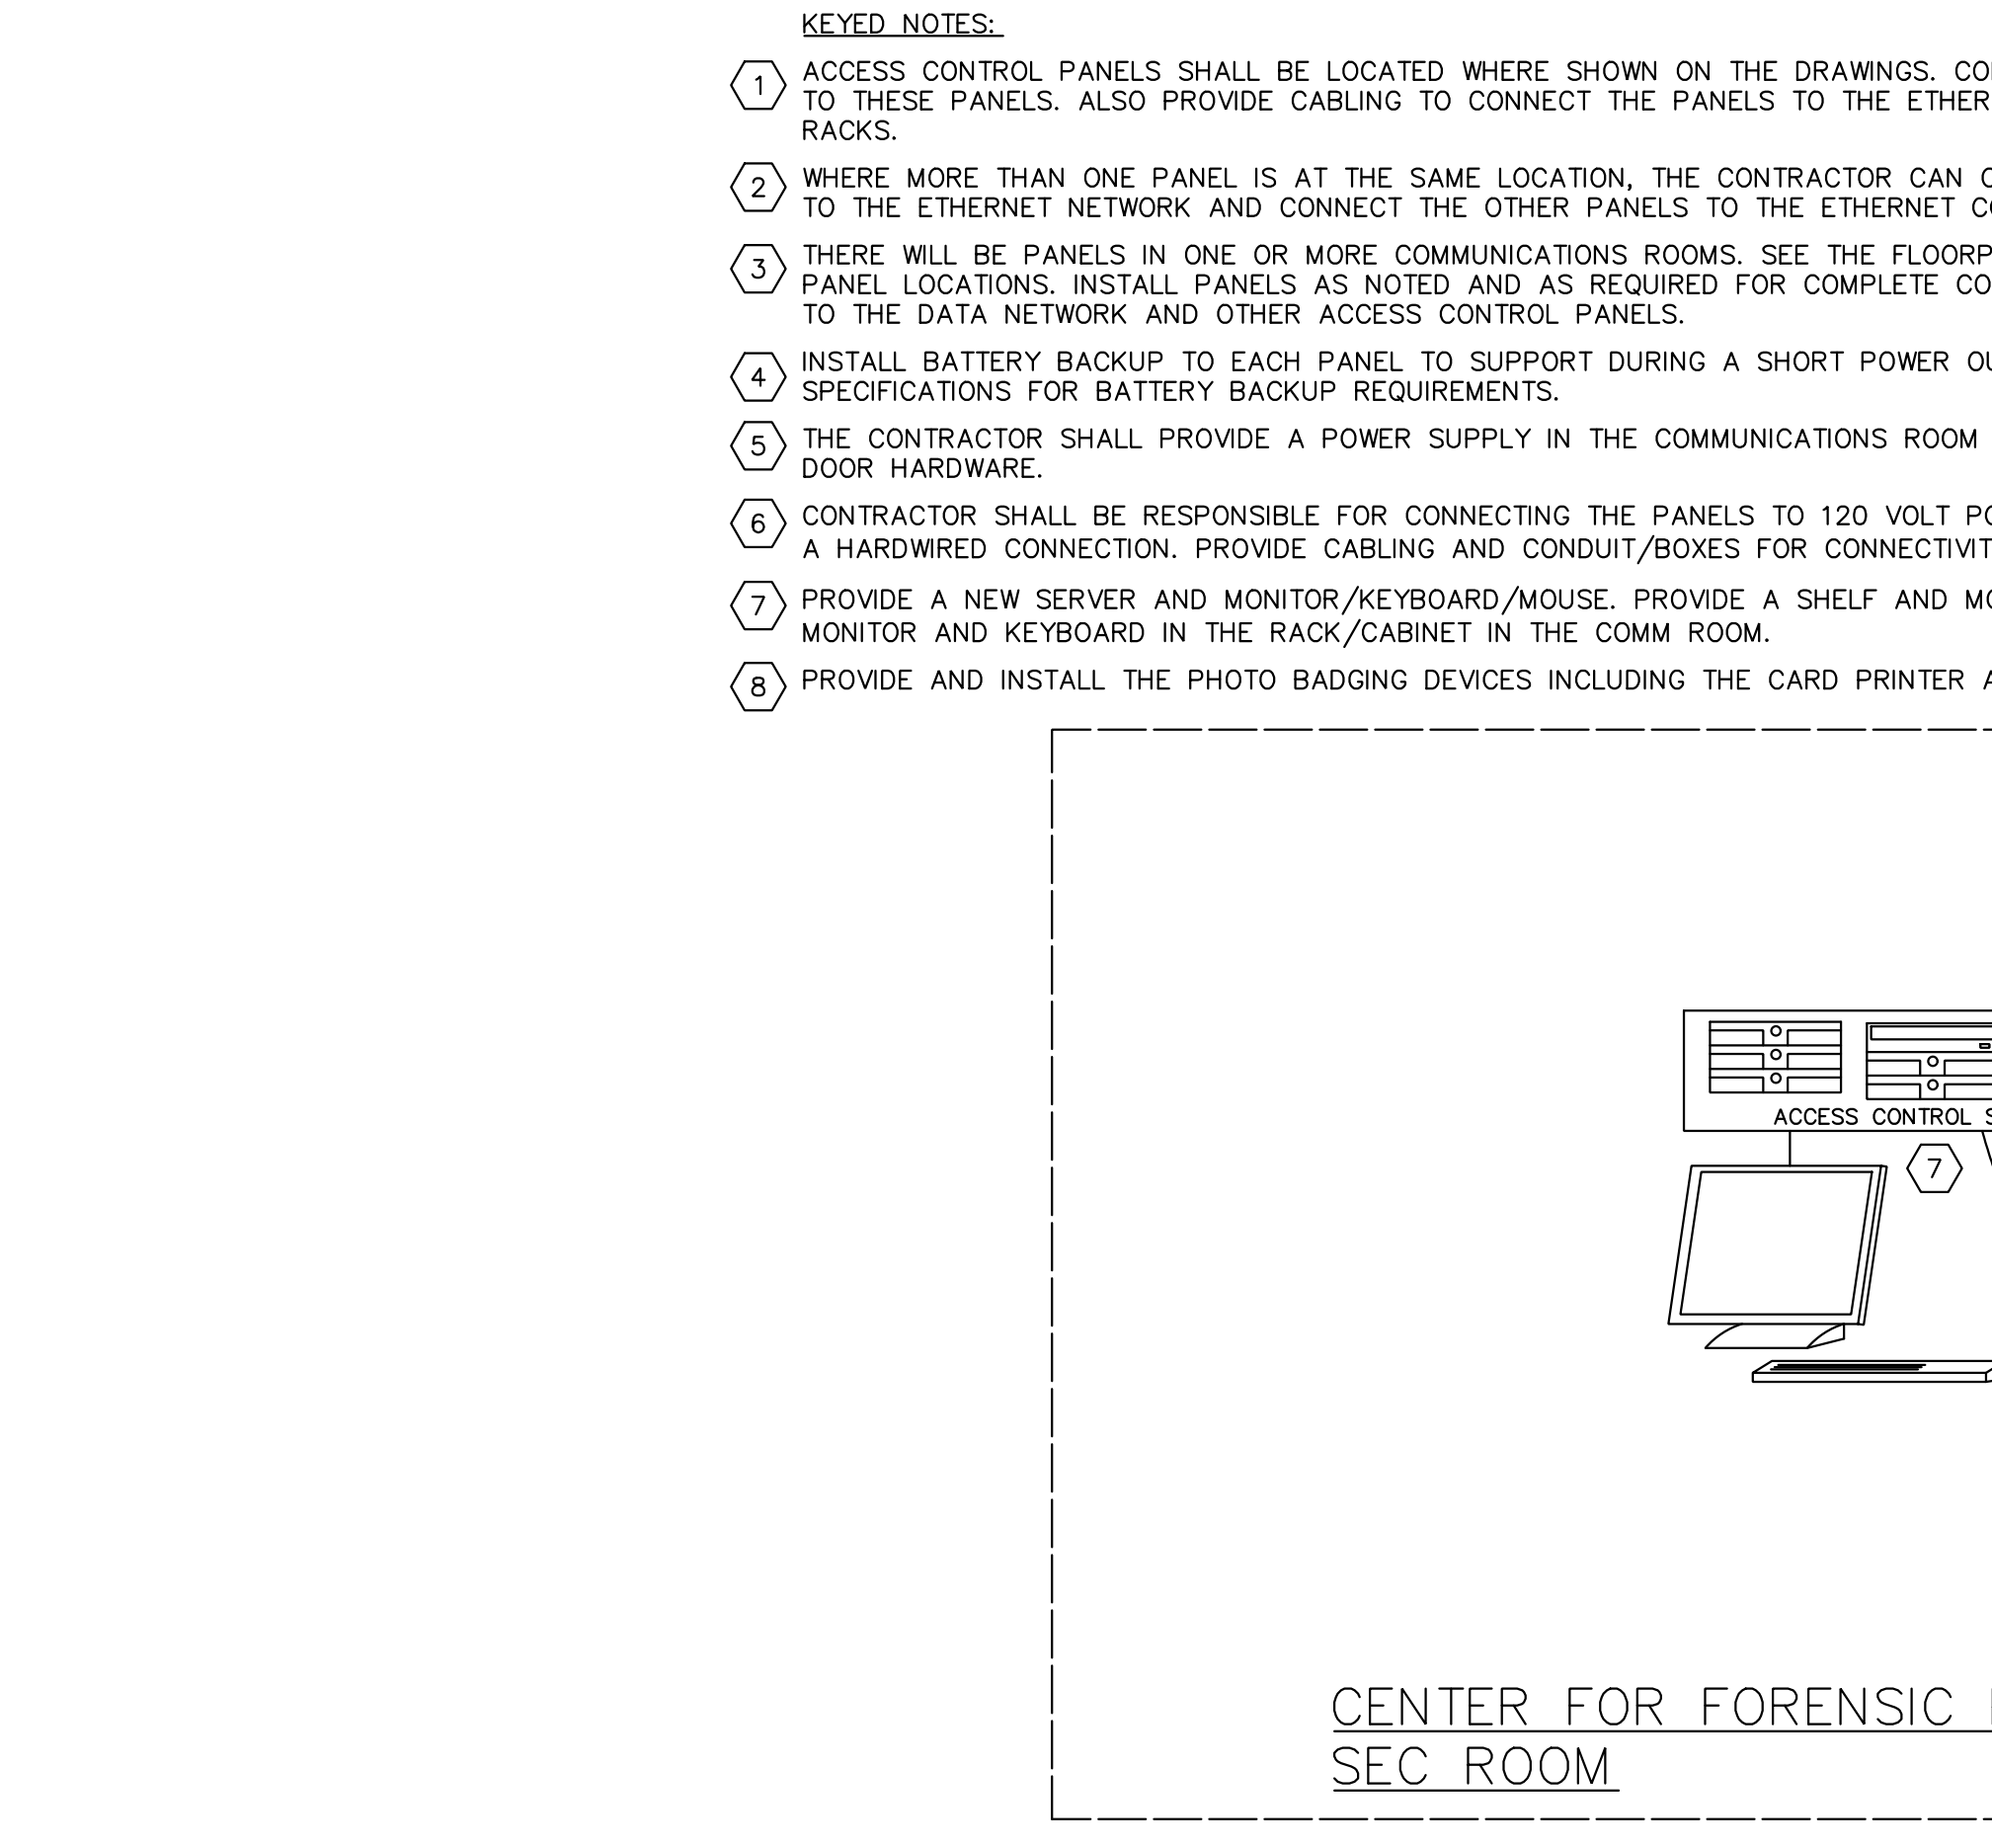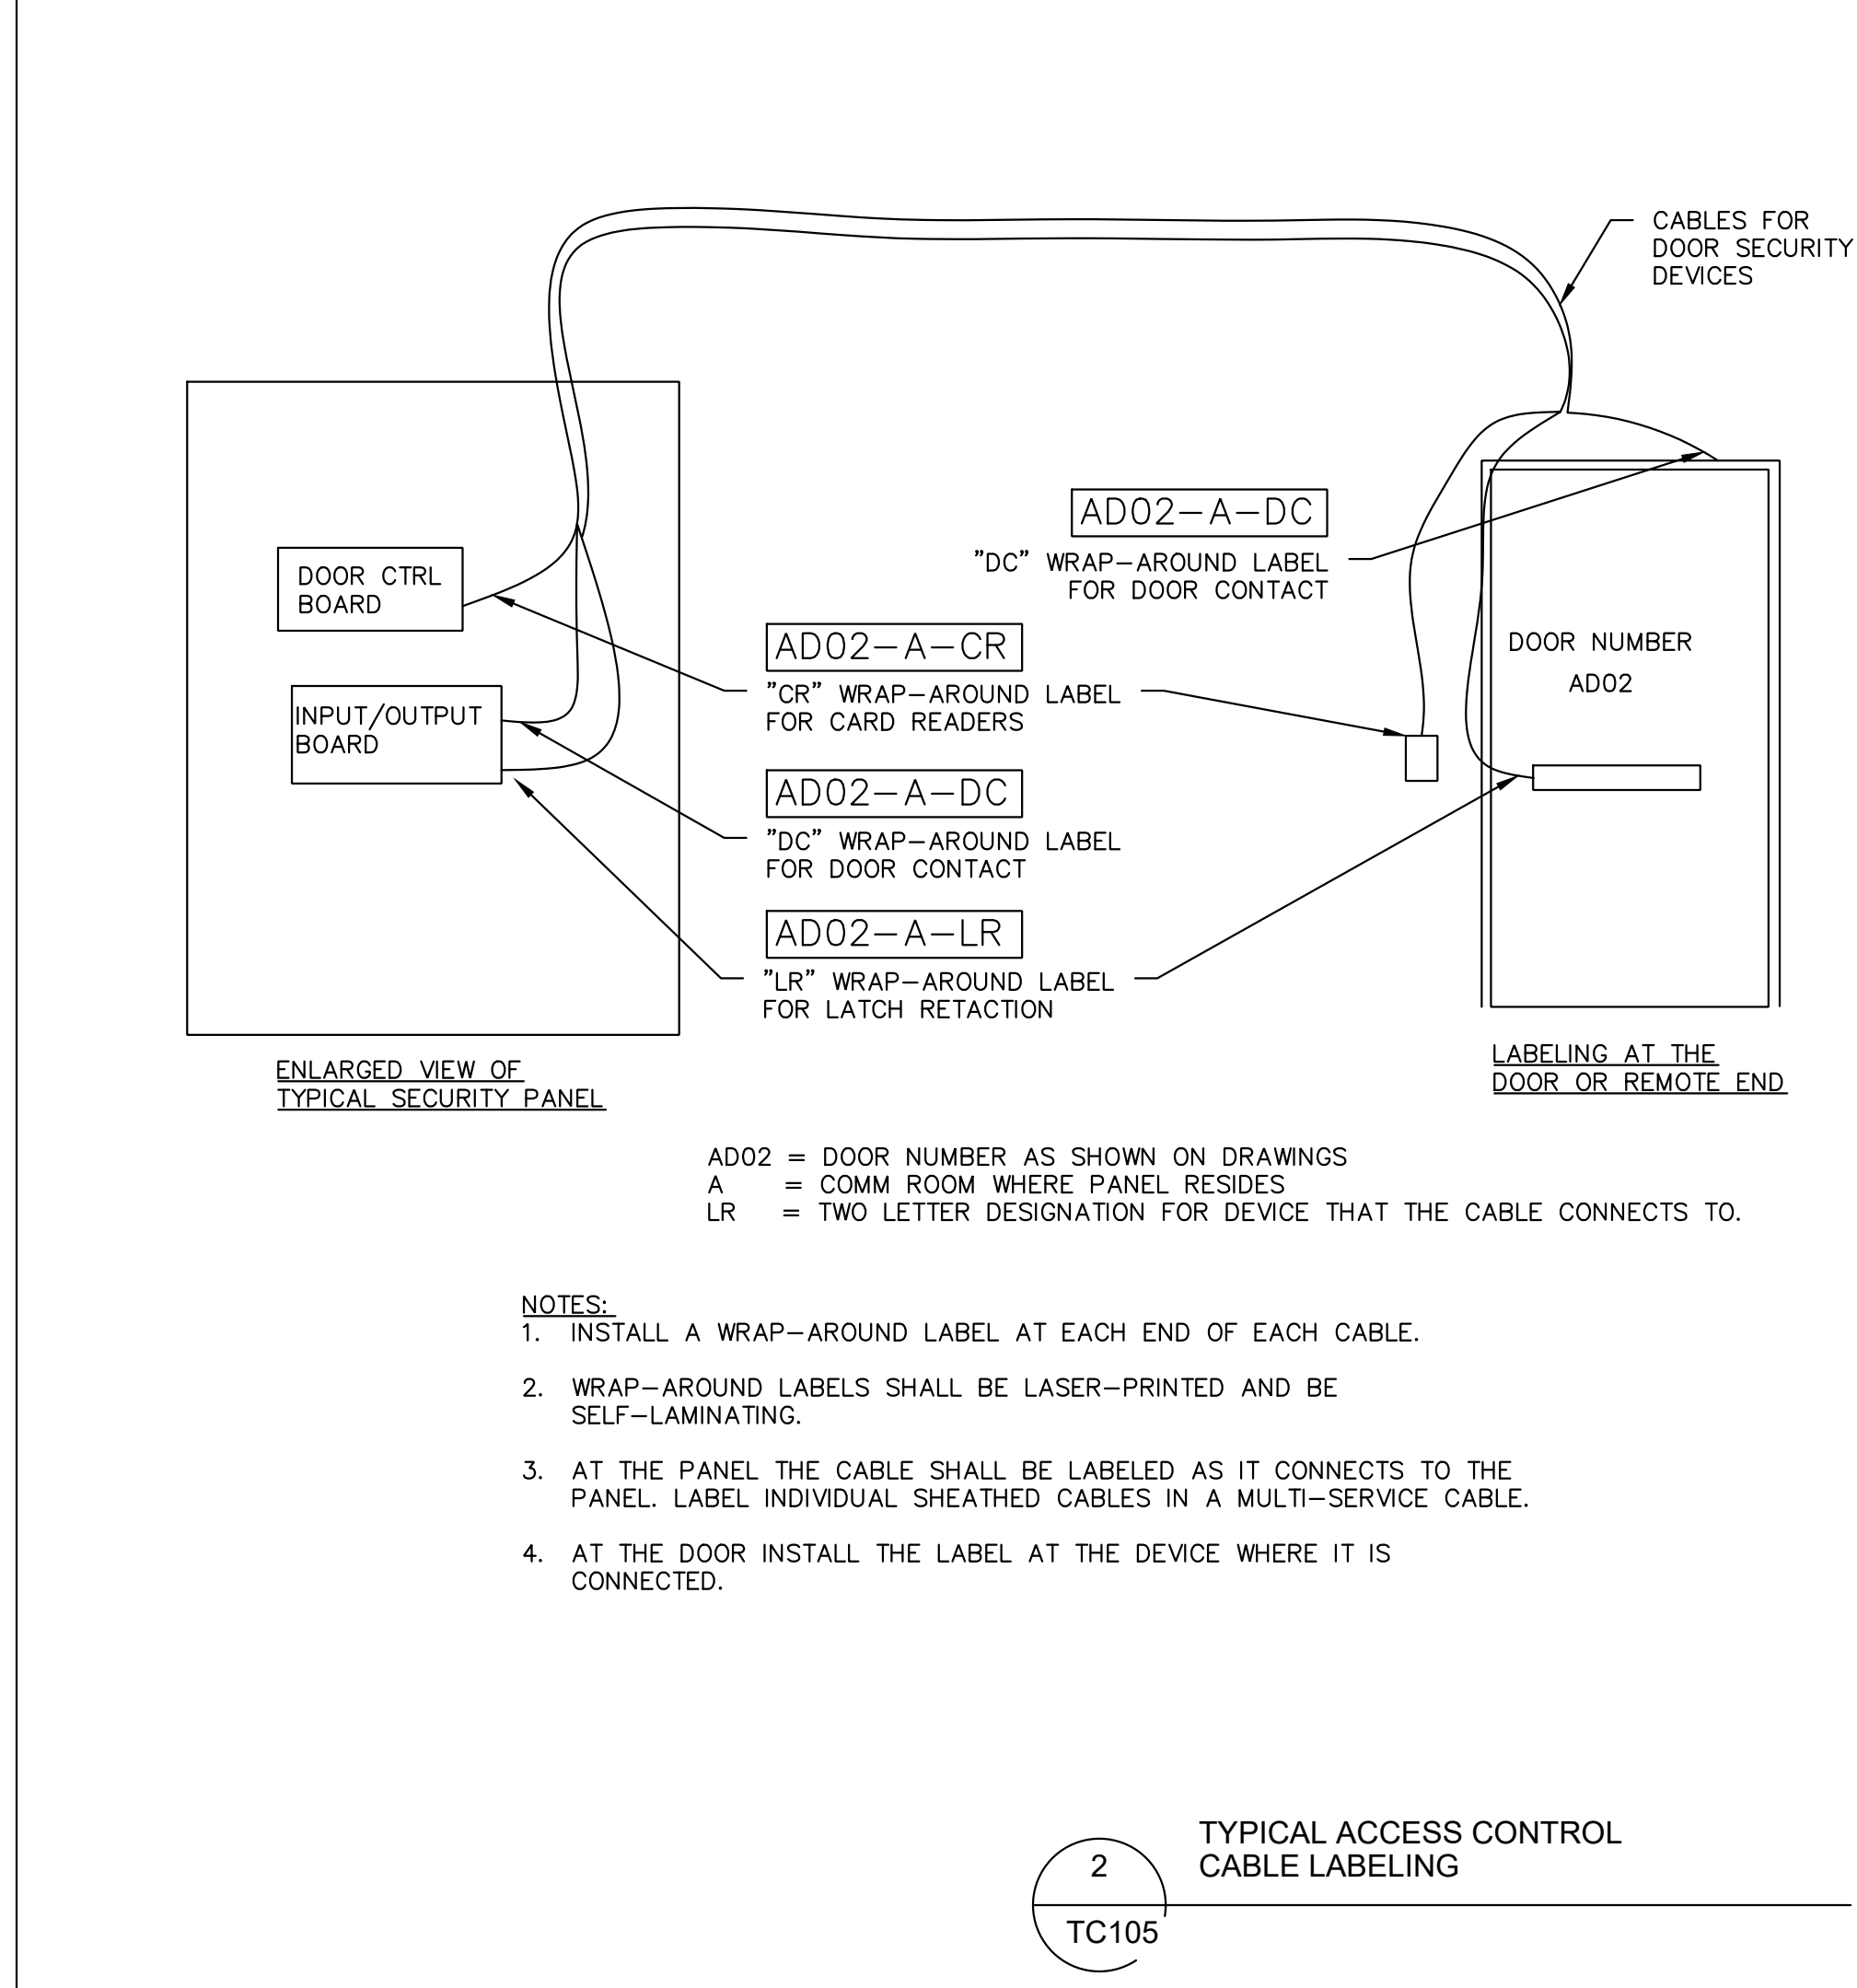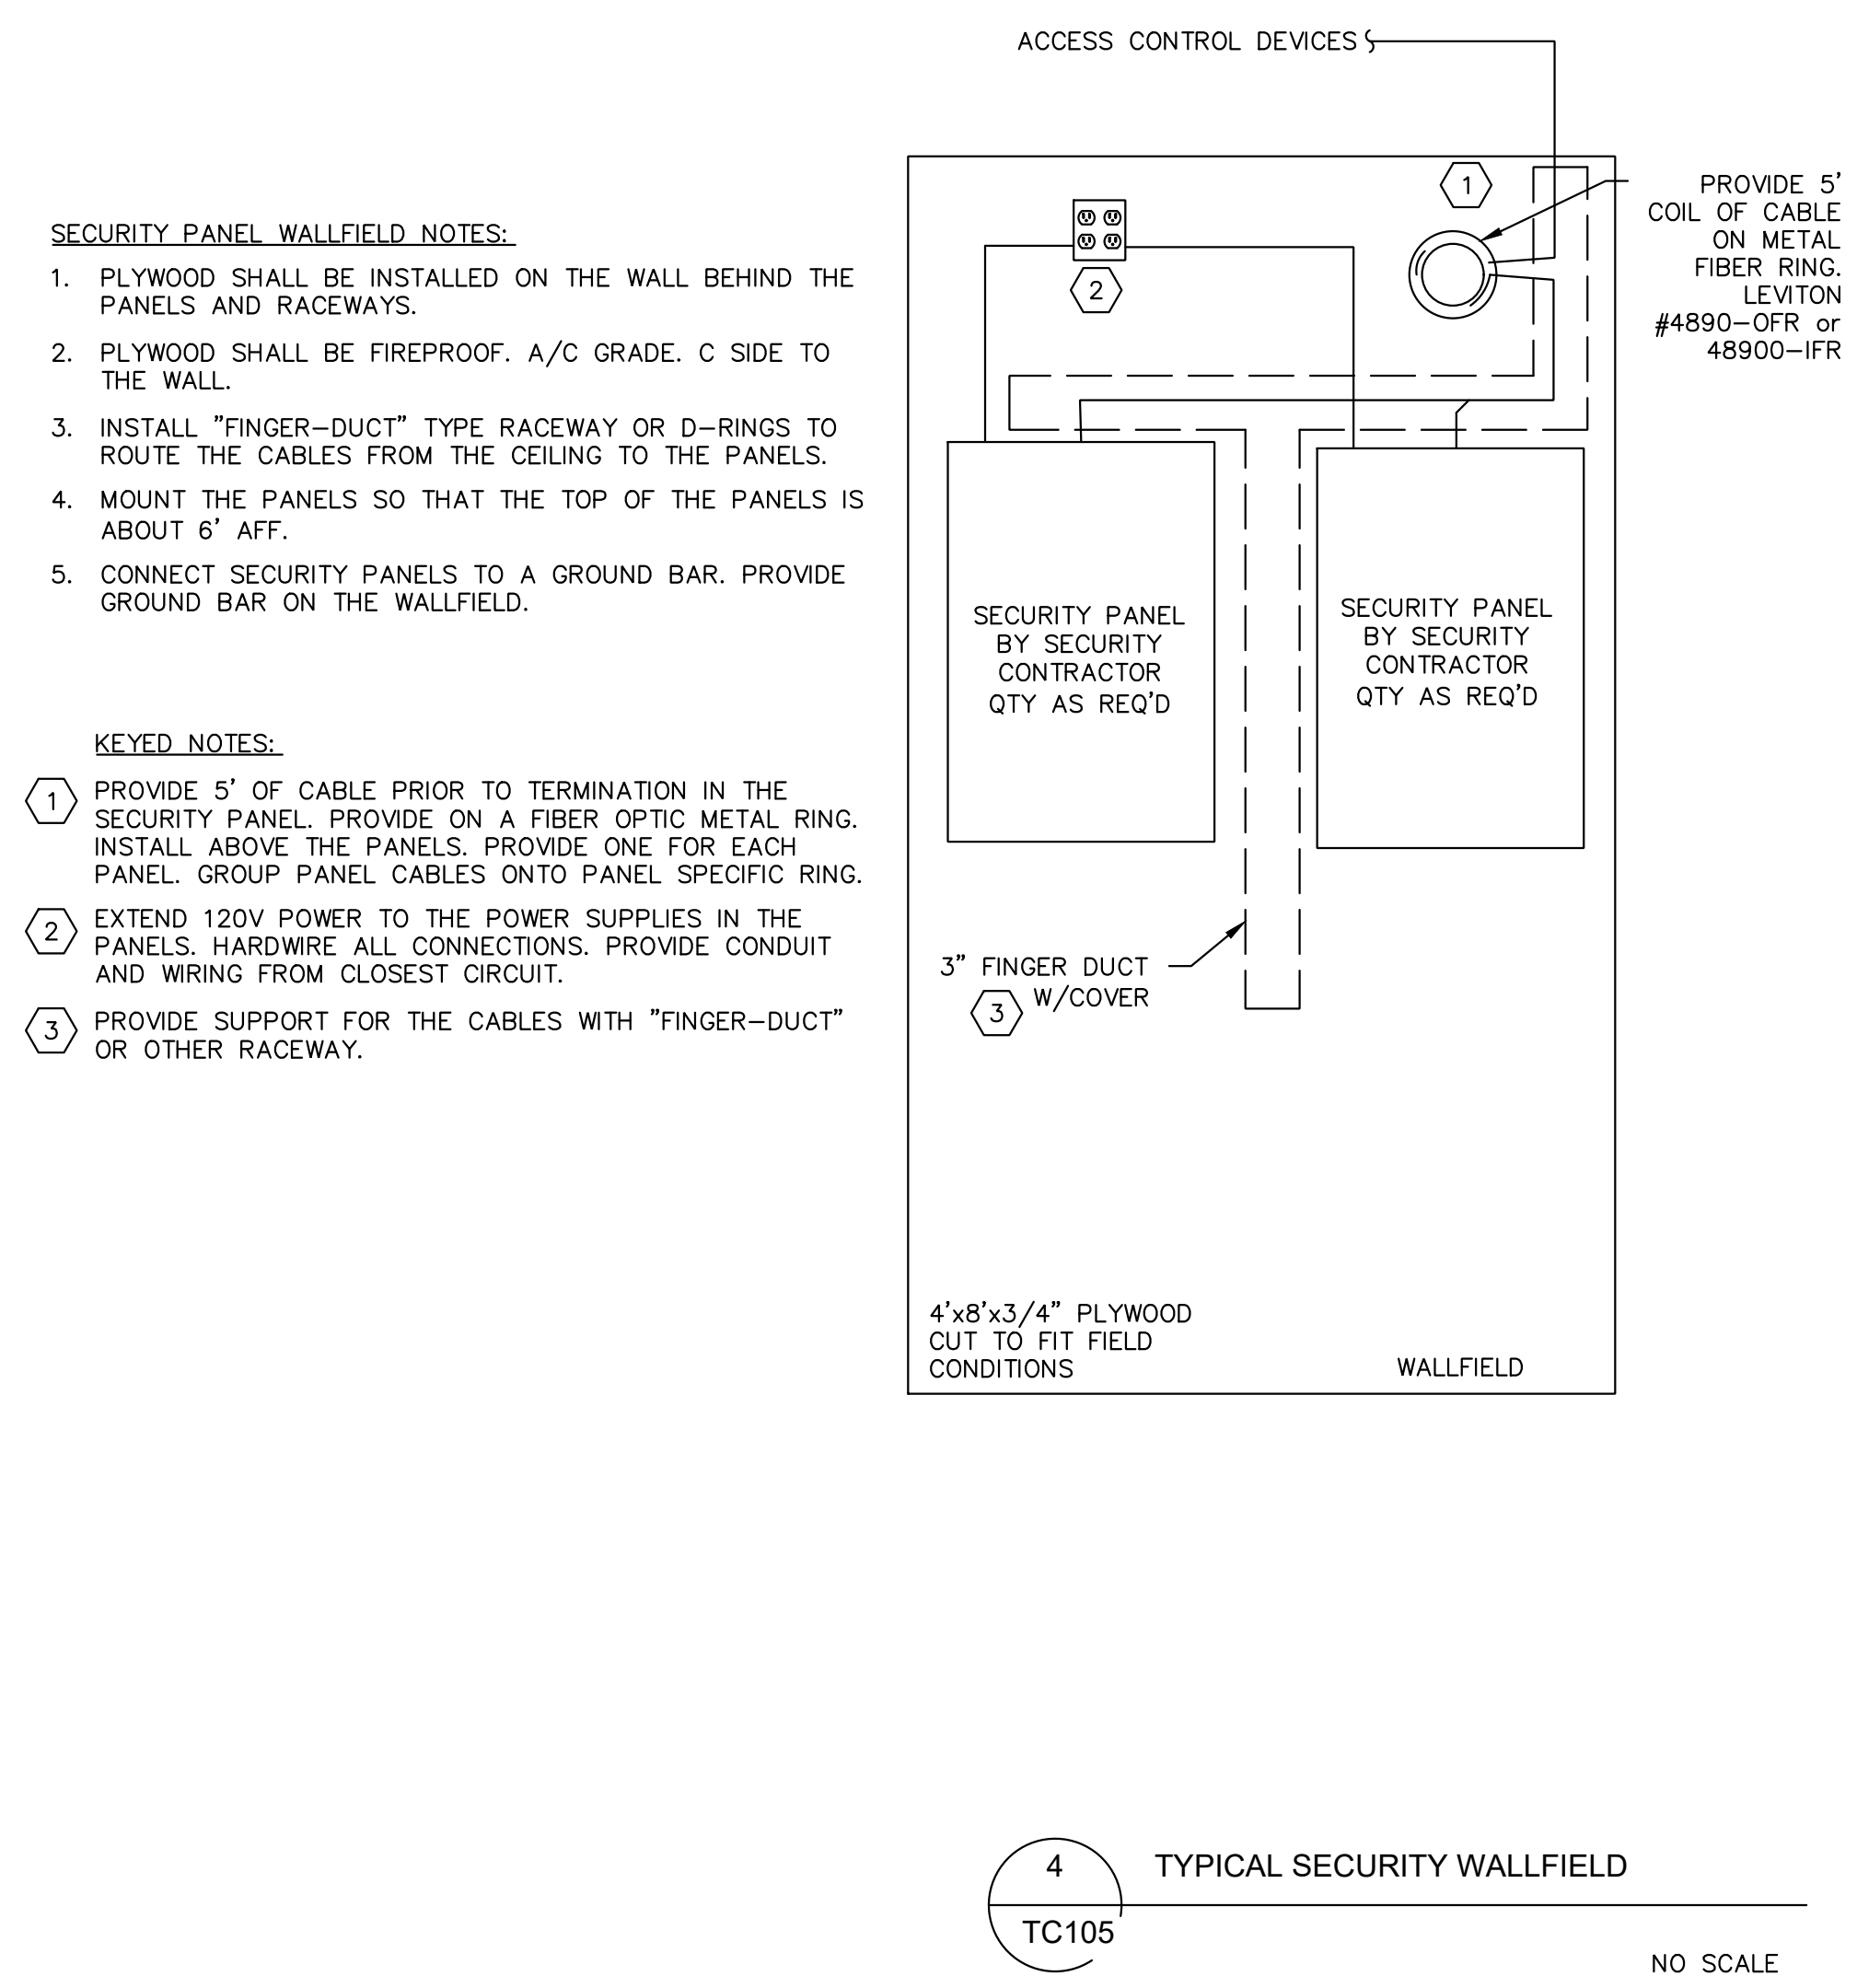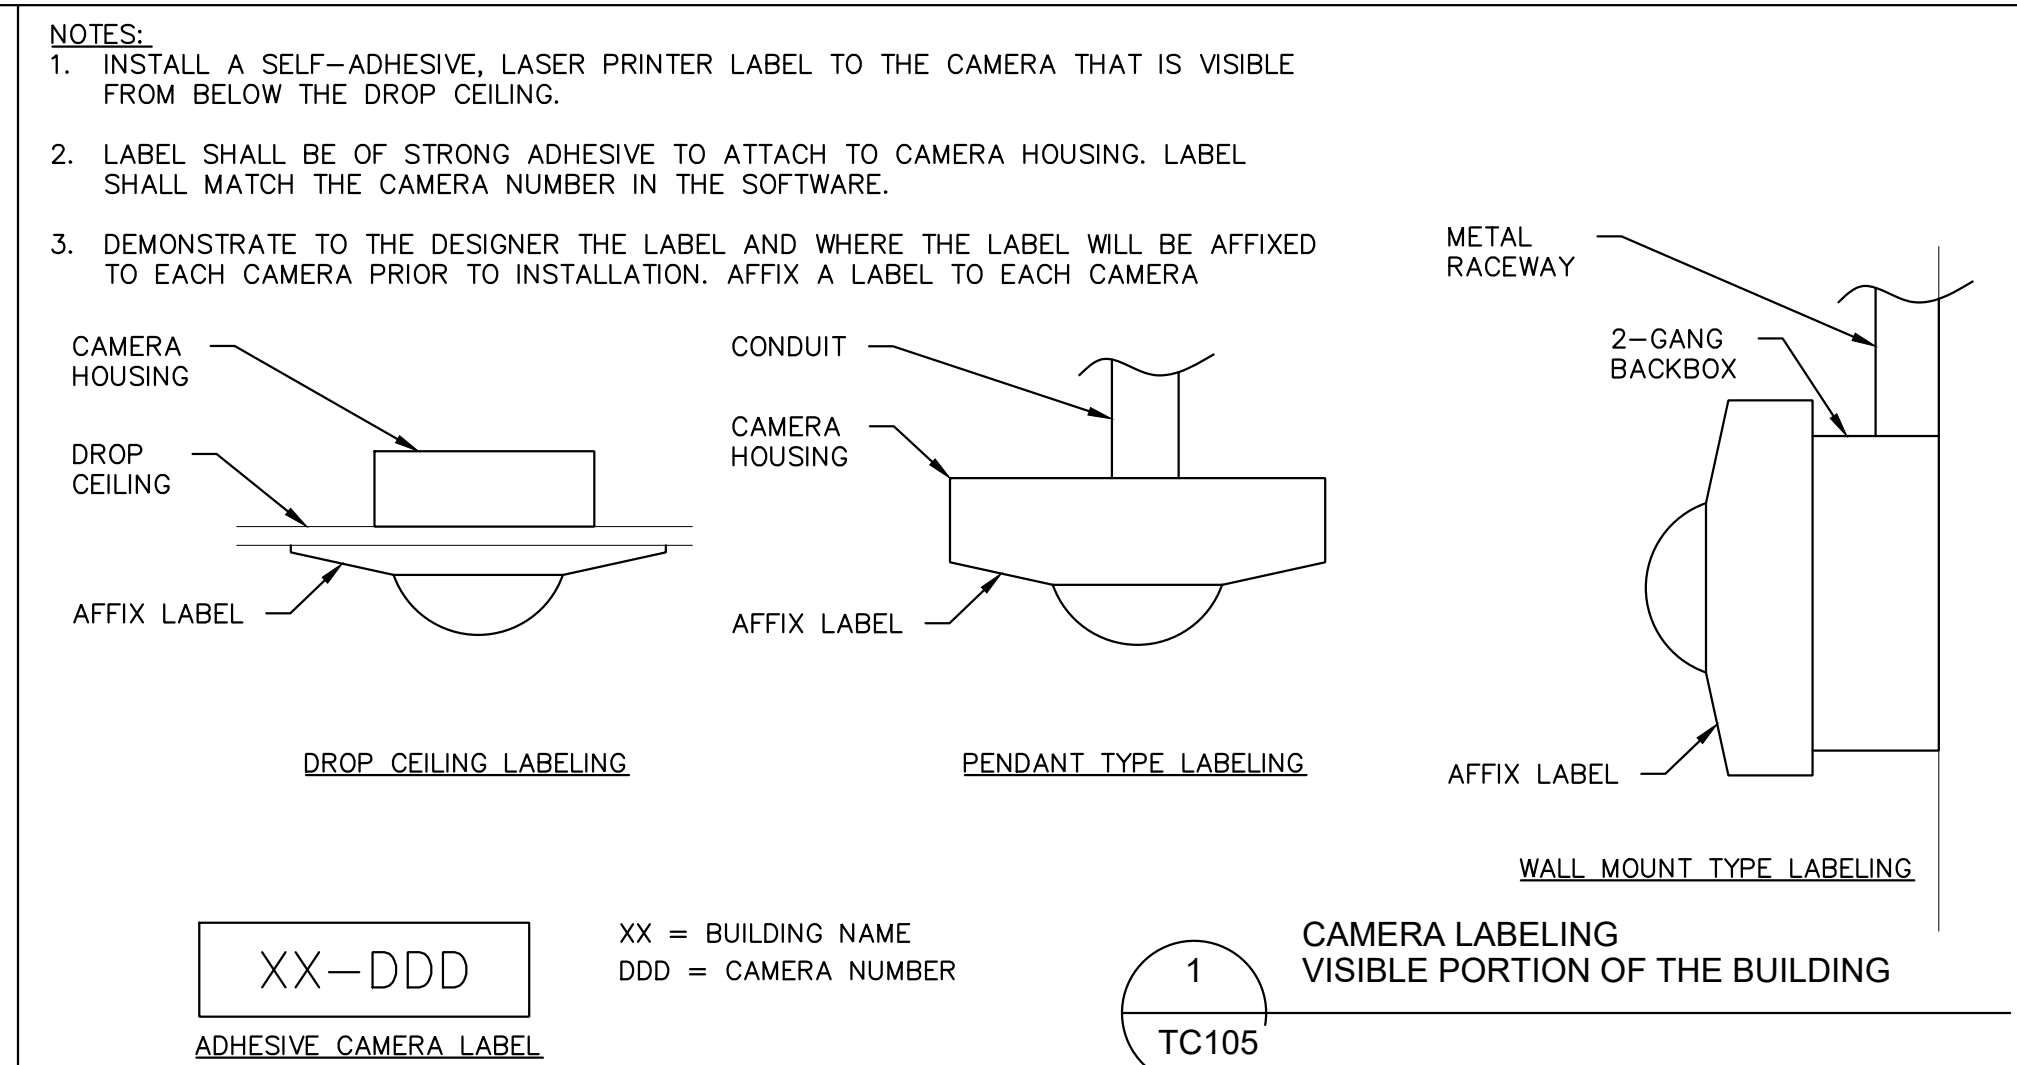


NO.	REVISION	DATE



FILE NO.
491/20167.SDW

FUNDING CODE
171CODHHS7255

CONTRACT NO.
Y22003

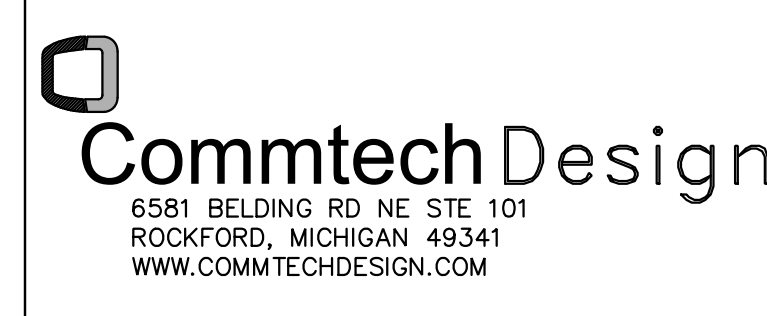

PROJECT TITLE
491/20167.SDW - PHASE 500:
CENTER FOR FORENSIC PSYCHIATRY - CREATE KITCHEN
SALINE, MICHIGAN




SHEET TITLE
ACCESS CONTROL DETAILS

PROJECT NUMBER
2021094




SHEET NUMBER
TC105

PROJECT DATE
SEPTEMBER 6, 2023



CHECKED BY
BWE

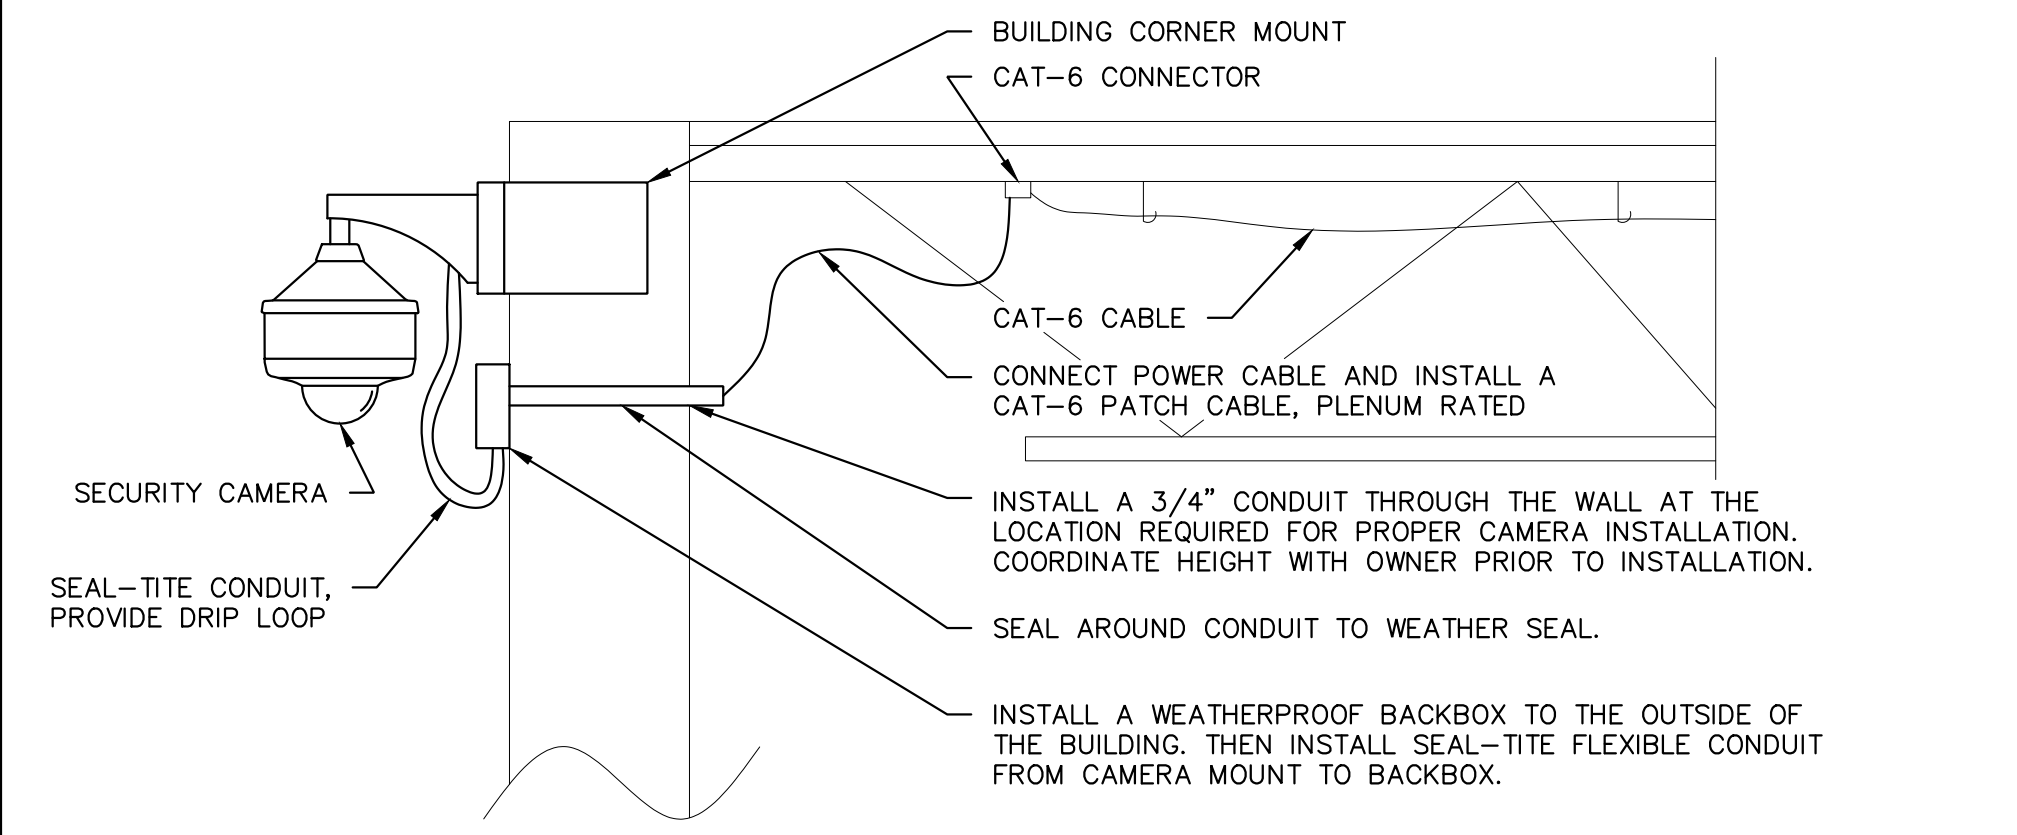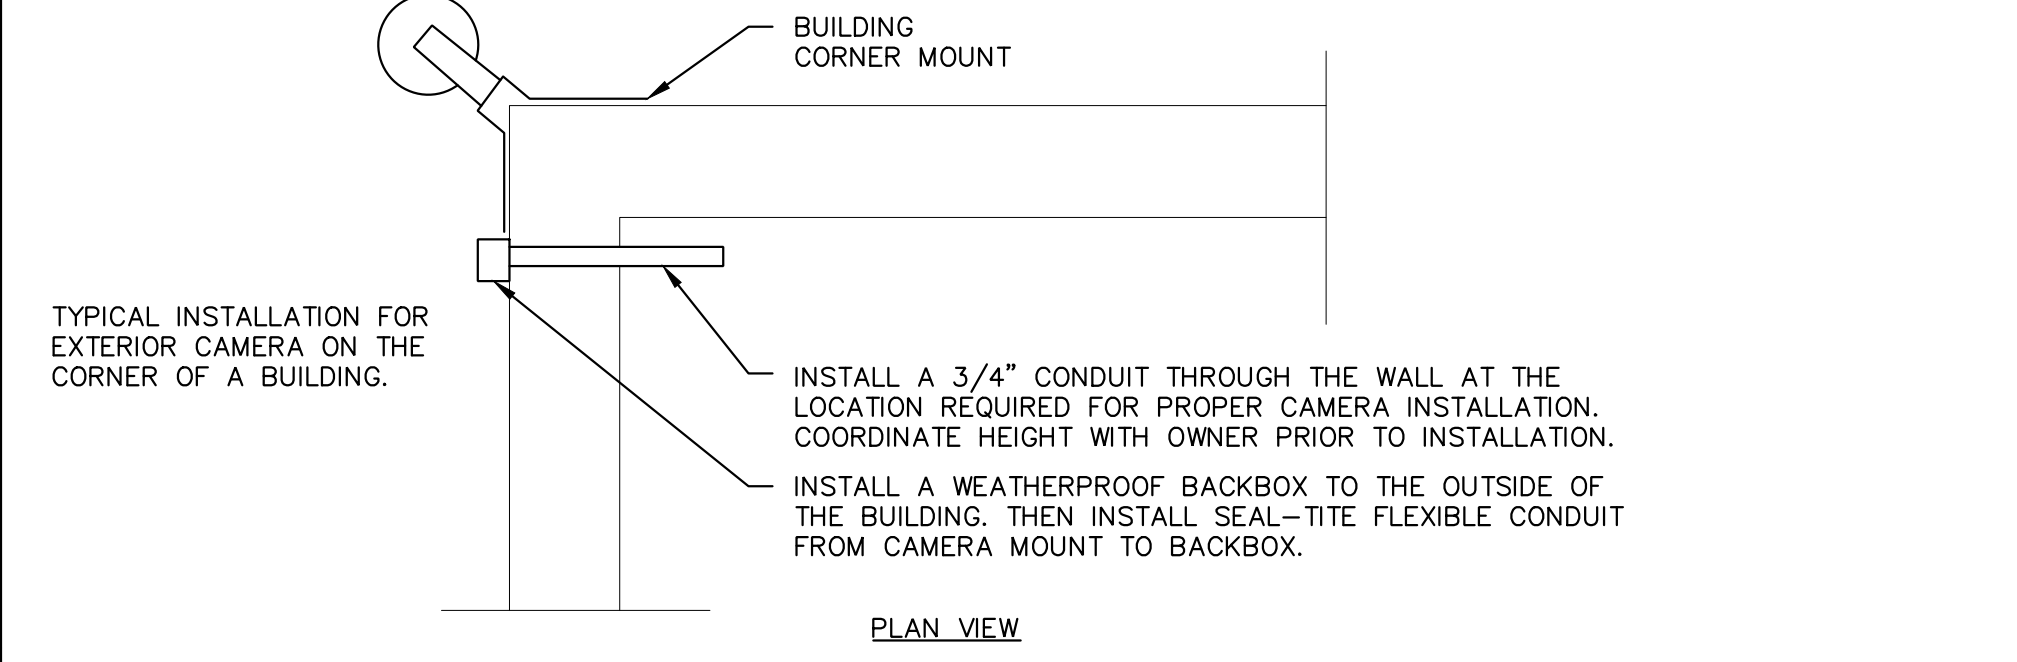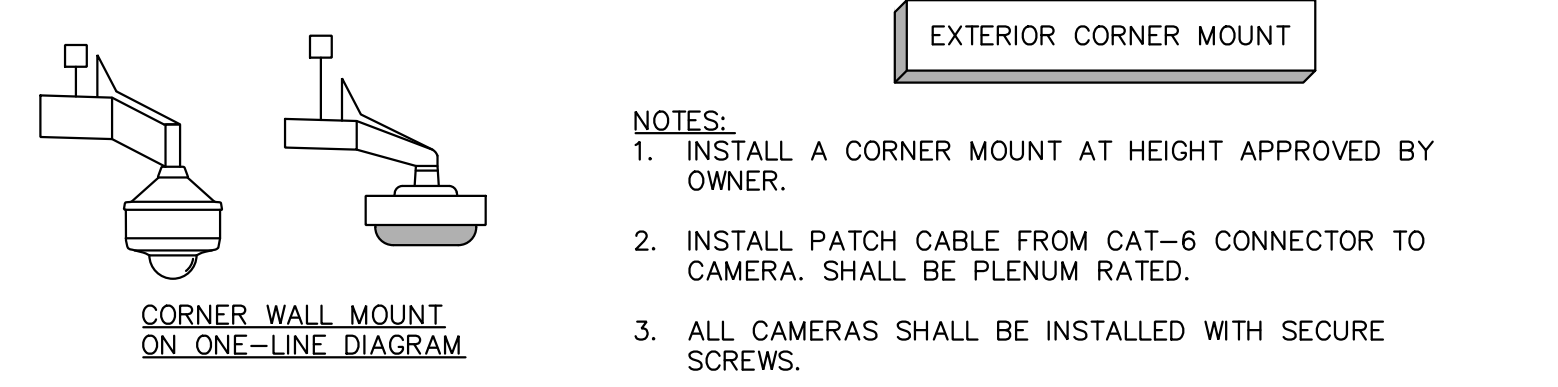



6 EXTERIOR CORNER, WALL MOUNT CAMERA INSTALLATION
TC107 NOT TO SCALE

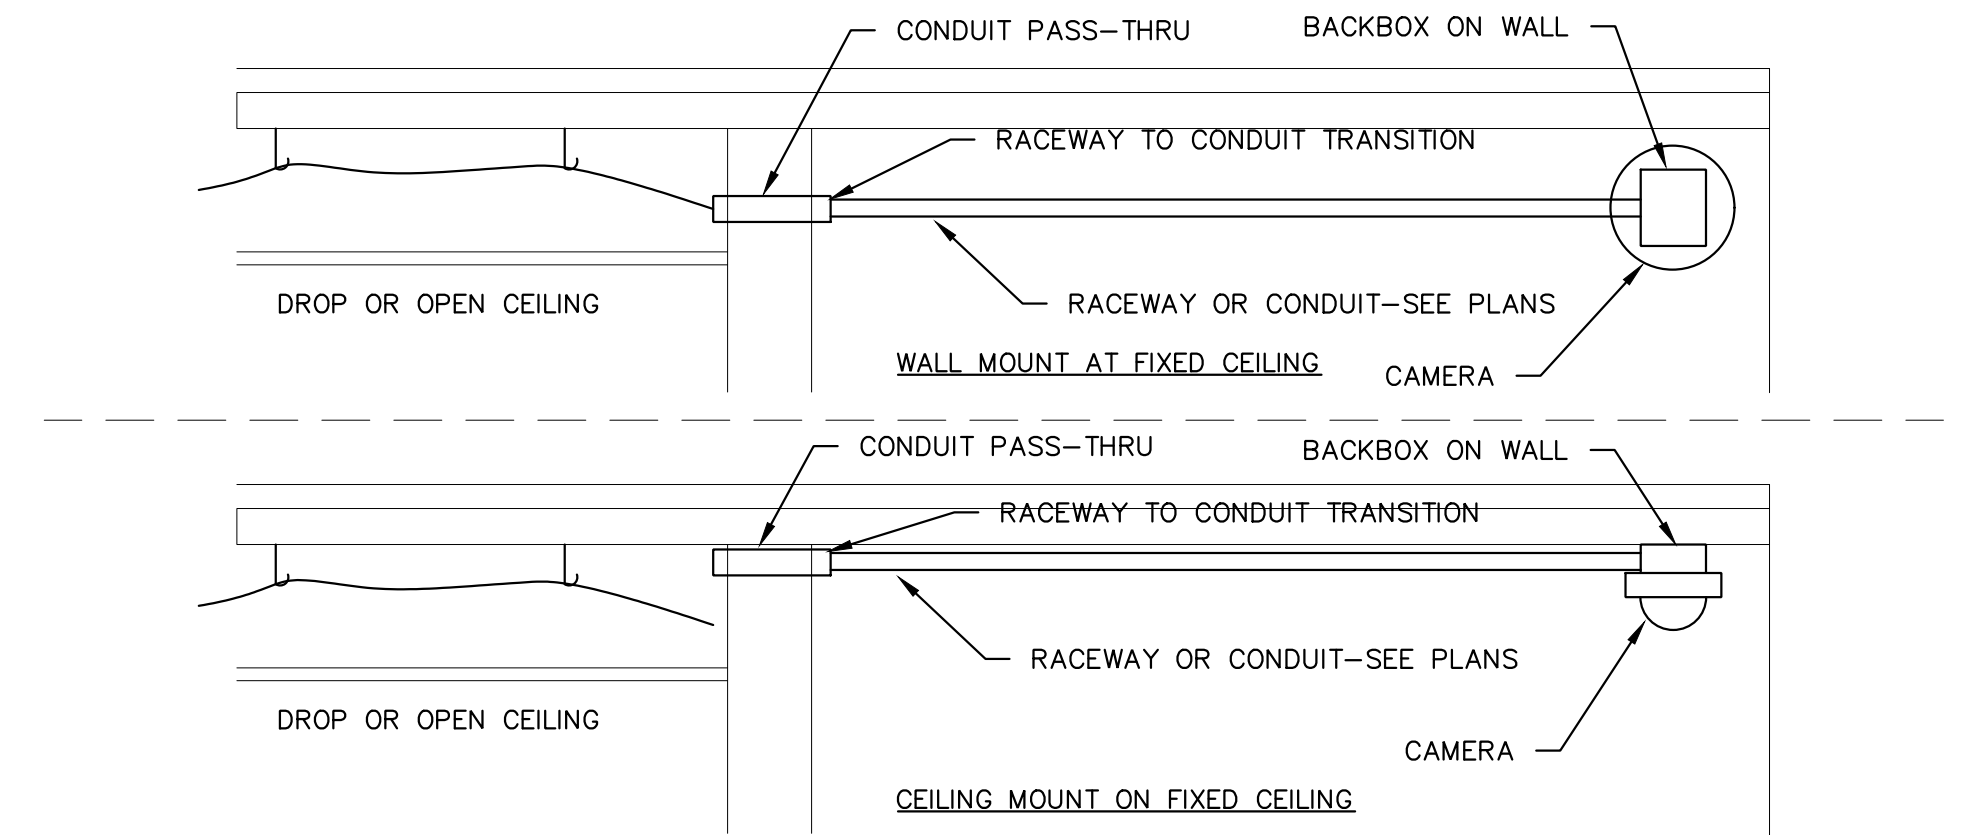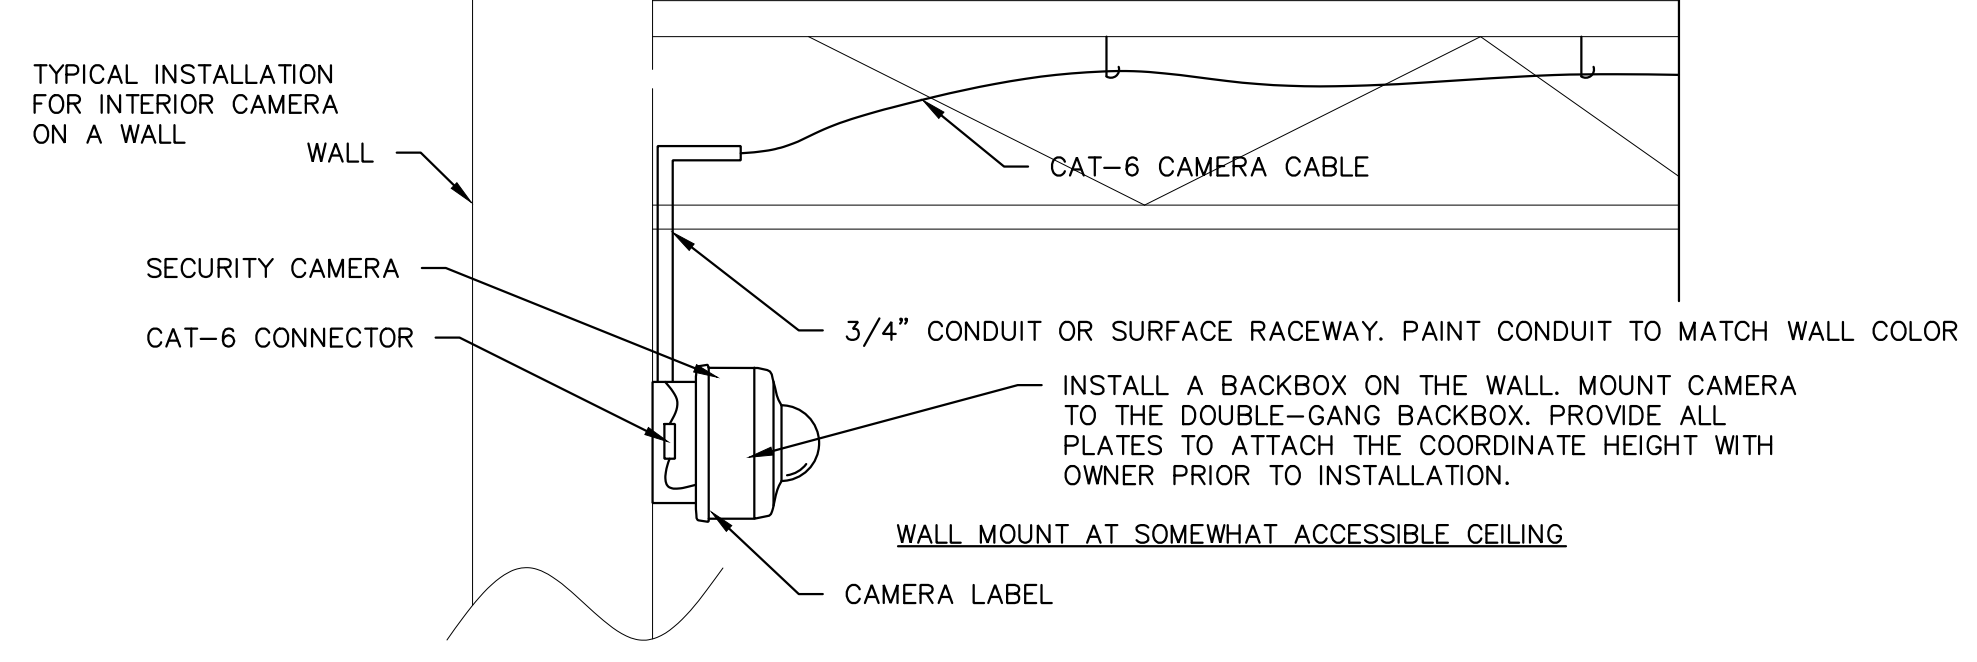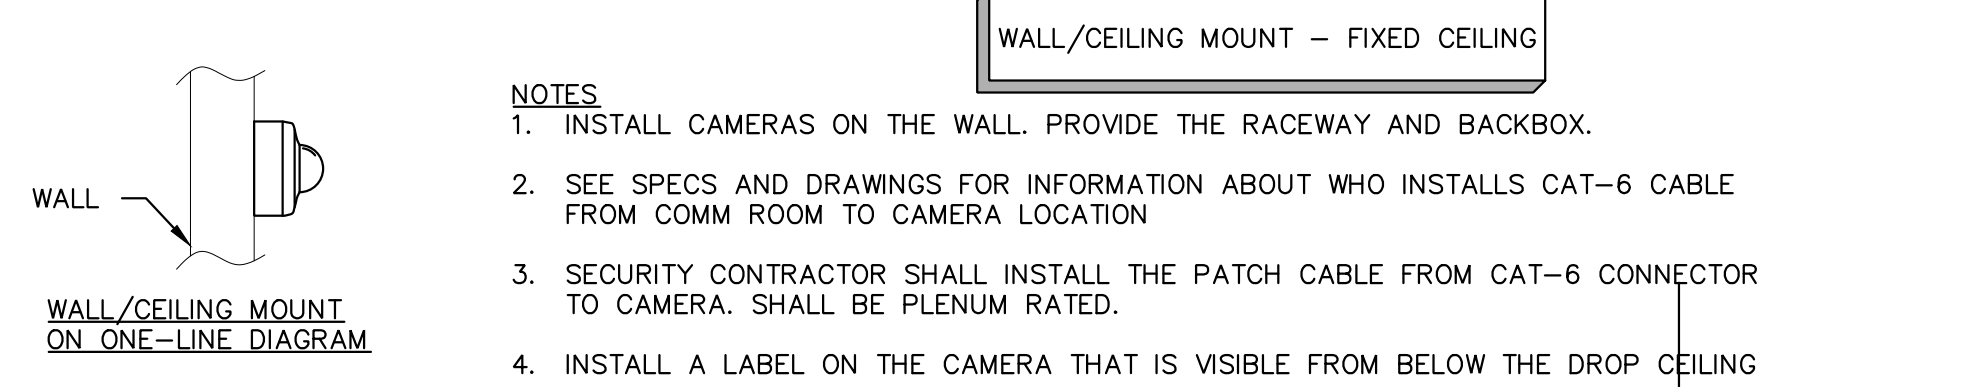

4 TYPICAL INTERIOR WALL/CEILING MOUNT CAMERA INSTALLATION
TC107 NOT TO SCALE

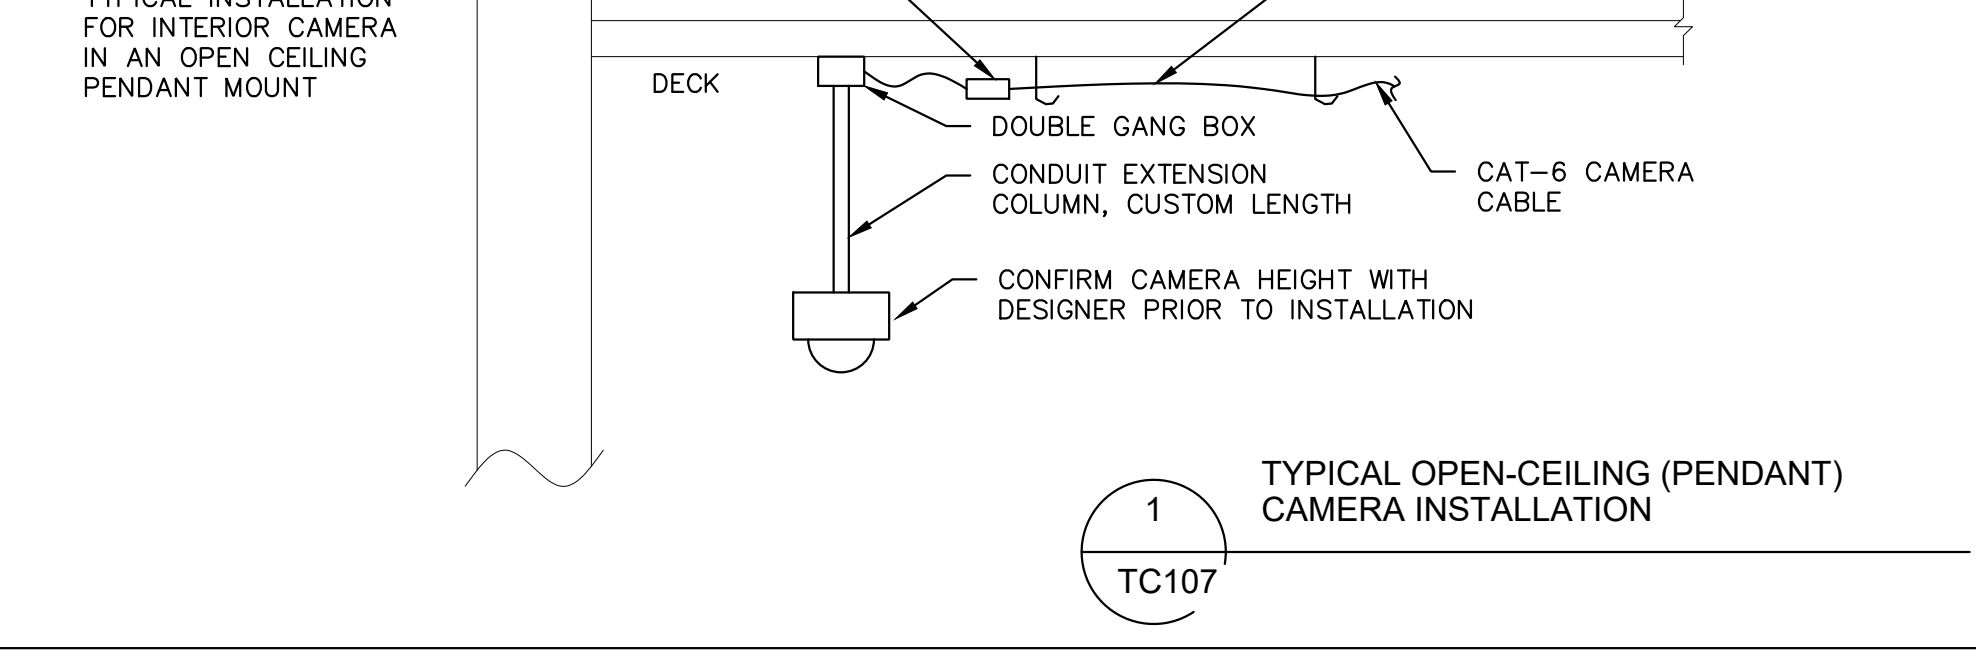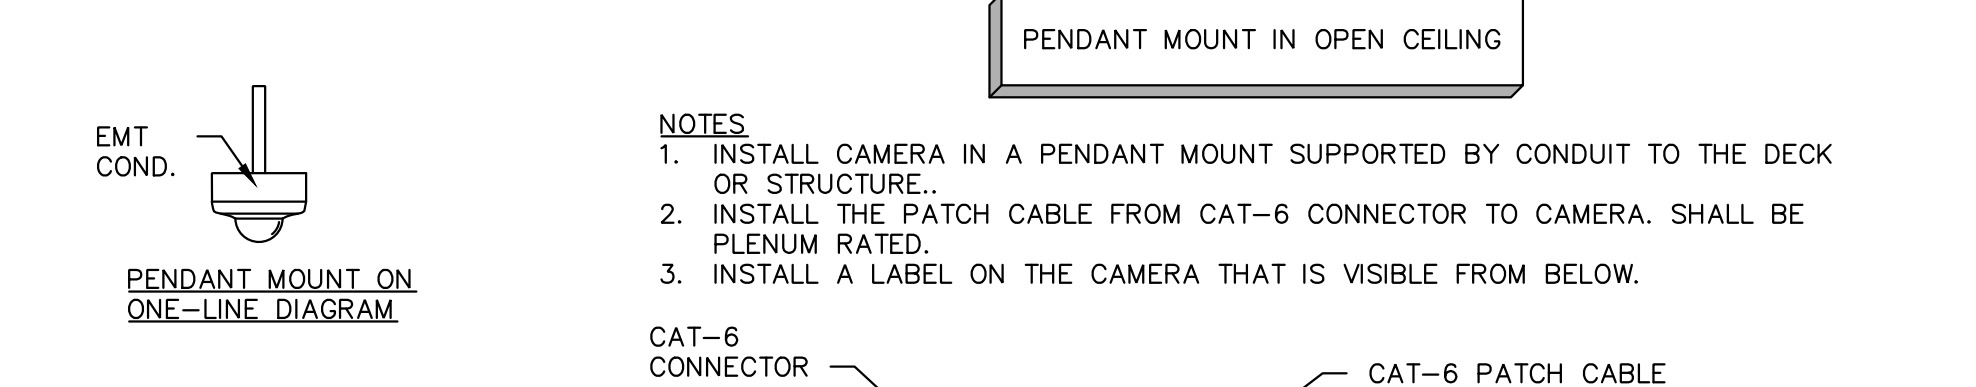

1 TYPICAL OPEN-CEILING (PENDANT) CAMERA INSTALLATION
TC107



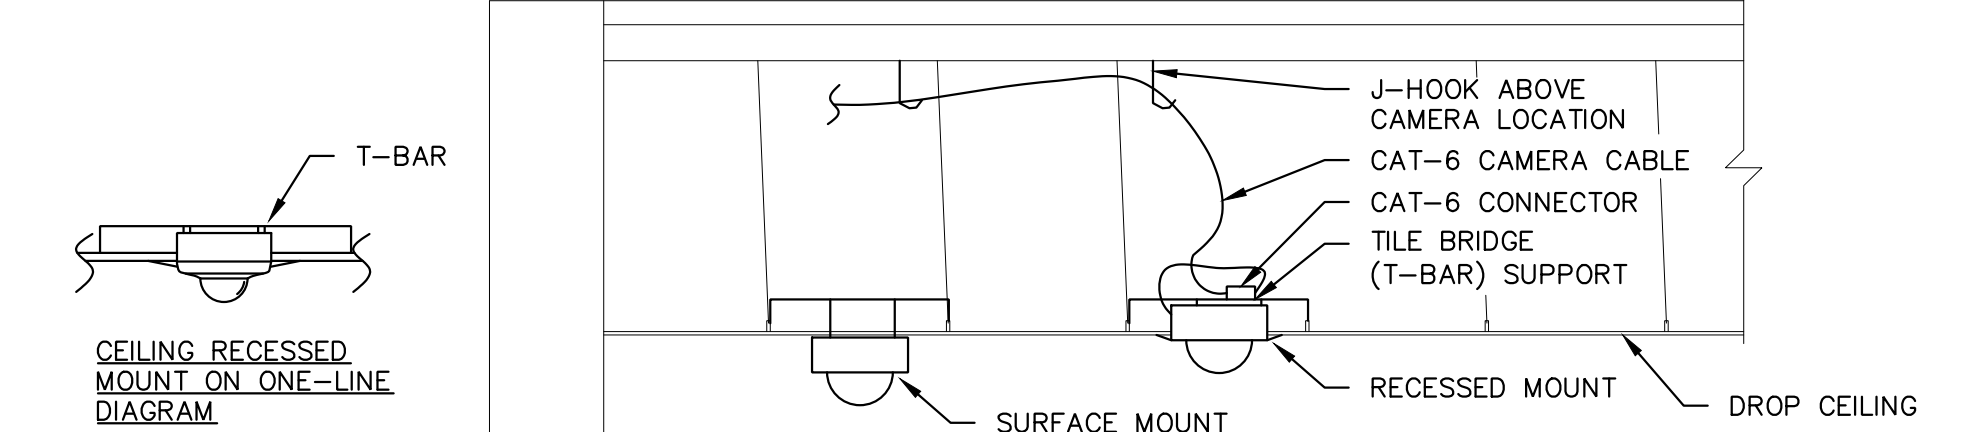
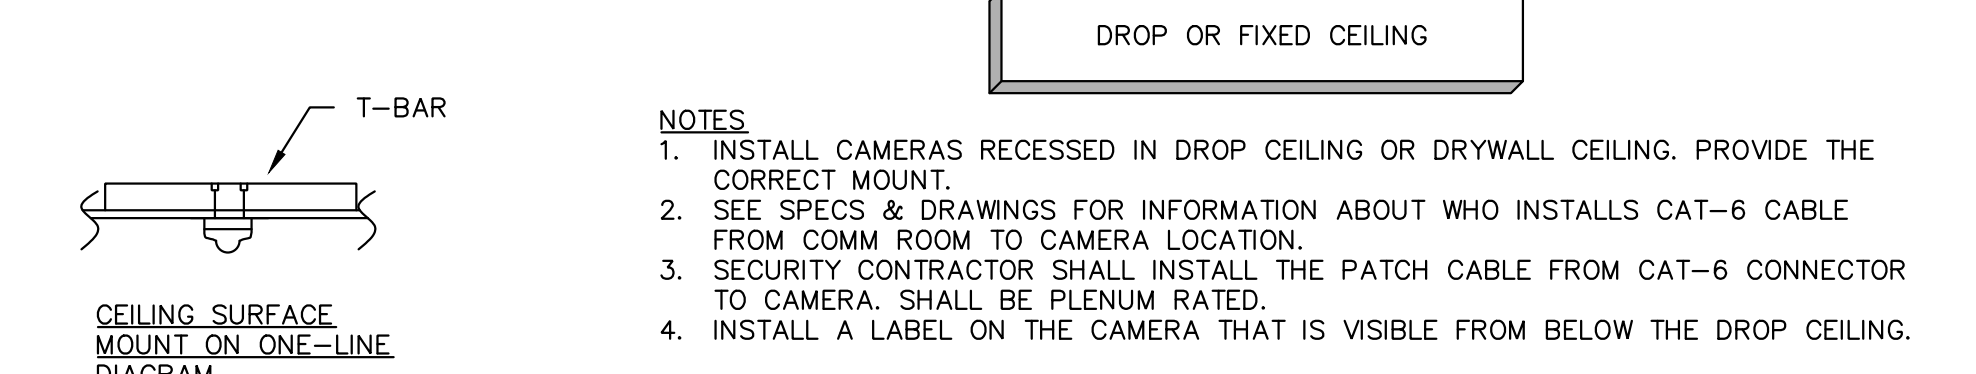


2 TYPICAL DRYWALL OR DROP-CEILING CAMERA INSTALLATION
TC107


- GENERAL VIDEO SECURITY NOTES:**
- CONTRACTOR SHALL PROVIDE ALL PATCH CABLES AT THE CAMERA AND AT THE COMM ROOM. MATCH COLOR OF CAMERA CABLE. 12" LONG AT SWITCH. 10' AT THE CAMERA
 - THE CAMERA CABLES SHALL TRANSPORT ALL VIDEO SIGNALS & CONTROL SIGNALS & POWER SIGNALS.
 - CONTRACTOR SHALL PROVIDE THE CORRECT CAMERA MOUNT BASED ON CAMERA LOCATION AND STRUCTURE AVAILABLE. PROVIDE RECESSED CAMERA MOUNTS IN DROP CEILINGS. REVIEW PLANS AND SITE PRIOR TO ORDERING.
 - CAMERAS IN DROP CEILINGS SHALL BE RECESSED MOUNT. PROVIDE BACKPLATE OR T-BAR FOR SUPPORT FROM GRID, NOT JUST THE TILE.
 - CONTRACTOR SHALL MEET WITH THE OWNER AND DETAIL ALL THE CAPABILITIES OF THE SYSTEM. THE CONFIGURATION OF THE RECORDER AND CAMERAS SHALL BE BASED ON THESE MEETINGS WITH THE OWNER. TAKE NOTES DURING THE MEETINGS. SUBMIT WITH AS-BUILTS
 - WHERE THE CAMERA IS NOT INSTALLED INTO A DROP CEILING THE CONTRACTOR SHALL PROVIDE A MOUNT AND HOUSING. PROVIDE WEATHERPROOF MOUNTS ON EXTERIOR CAMERAS.
 - EXTERIOR CAMERAS SHALL BE RATED FOR OUTDOOR INSTALLATION AND SHALL PROVIDE THEIR OWN HEAT.
 - CONTRACTOR SHALL PROVIDE THE CORRECT LENS TO EACH CAMERA BASED ON THE INSTALLED LOCATION AND THE OWNERS REQUIREMENTS FOR THE FIELD OF VIEW. WORK WITH THE OWNER DURING INSTALLATION.

- ALL CAMERAS SHALL CONNECT TO THE IP NETWORK SWITCH IN THE COMMUNICATIONS ROOM. CONTRACTOR SHALL WORK WITH THE OWNER ON CONFIGURATION OF THE ETHERNET SWITCH.
- CONTRACTOR SHALL MEET WITH THE OWNER AND DETAIL ALL THE CAPABILITIES OF THE SYSTEM. THE CONFIGURATION OF THE RECORDER AND CAMERAS SHALL BE BASED ON THESE MEETINGS WITH THE OWNER. TAKE NOTES DURING THE MEETINGS. SUBMIT WITH AS-BUILTS
- PROVIDE A NEW NETWORK VIDEO RECORDER TO SUPPORT THESE NEW CAMERAS. EXISTING NVR UTILIZE THE BOSCH VIDEO SECURITY SYSTEM.
- INTEGRATE THE EXISTING CAMERAS WITH THE ACCESS CONTROL SYSTEM SO THAT AN INTERCOM CALL BRINGS UP THE CORRESPONDING CAMERA AT THE CENTRAL CONTROL STATION.
- NETWORK VIDEO SECURITY RECORDED SHALL STORE VIDEO FOR 30 DAYS. CONNECT TO THE NETWORK AND CONFIGURE ALL CAMERAS ON THE SERVER. NAME AS PER THE OWNERS STANDARDS.
- INSTALL NVR IN THE BASMENT SECURITY ROOM.

- KEYED VIDEO SECURITYNOTES:**
- PROVIDE ALL PATCH CABLES REQUIRED FOR CONNECTION OF ALL CAMERAS AT THE CAMERA AND AT THE NETWORK SWITCH. ALL PATCH CABLES SHALL BE MATCH CABLE COLOR
 - LABEL THE CAT-6 PATCH PANEL WITH THE CAMERA NUMBER THE CABLE CONNECTS TO. SHALL BE LASER PRINTED. SEE SPECS
 - SEE SPECIFICATIONS AND BID SCOPES TO DETERMINE WHICH CONTRACTOR IS TO INSTALL AND TERMINATE THE CAT-6 CABLES USED FOR SECURITY CAMERAS.
 - THE SERVER WILL BE LOCATED IN THE BASEMENT SECURITY ROOM. CONTRACTOR SHALL LOAD ALL SOFTWARE REQUIRED TO RECORD AND MANAGE ALL NEW CAMERAS. PROVIDE THE QUANTITY OF SERVERS AND STORAGE AS REQUIRED TO RECORD AND VIEW ALL CAMERAS AS PER THE SPECIFICATIONS
 - THE SECURITY CONTRACTOR SHALL MEET WITH THE OWNER TO CONFIRM ALL NETWORK SPECIFICATION REQUIREMENTS FOR A VLAN OR OTHER QUALITY OF SERVICE SETTINGS FOR THE CAMERA SYSTEM. PROVIDE AND INSTALL ETHERNET SWITCH
 - PROVIDE AN SFP MODULE FOR 10 GIGABIT CONNECTIVITY VIA FIBER CABLE INTO THE ETHERNET SWITCH
 - CONFIGURE THE EXISTING CAMERA SYSTEM TO SUPPORT CAMERA CALL UP THRU CONNECTION TO THE AUDIO INTERCOM SYSTEM. PROVIDE ALL EQUIPMENT AND CONFIGURATION REQUIRED. WHEN AN INTERCOM IS PUSHED THE CAMERA ASSOCIATED WITH THAT CAMERA SHALL POP-UP ON THE OPERATOR CONSOLE.

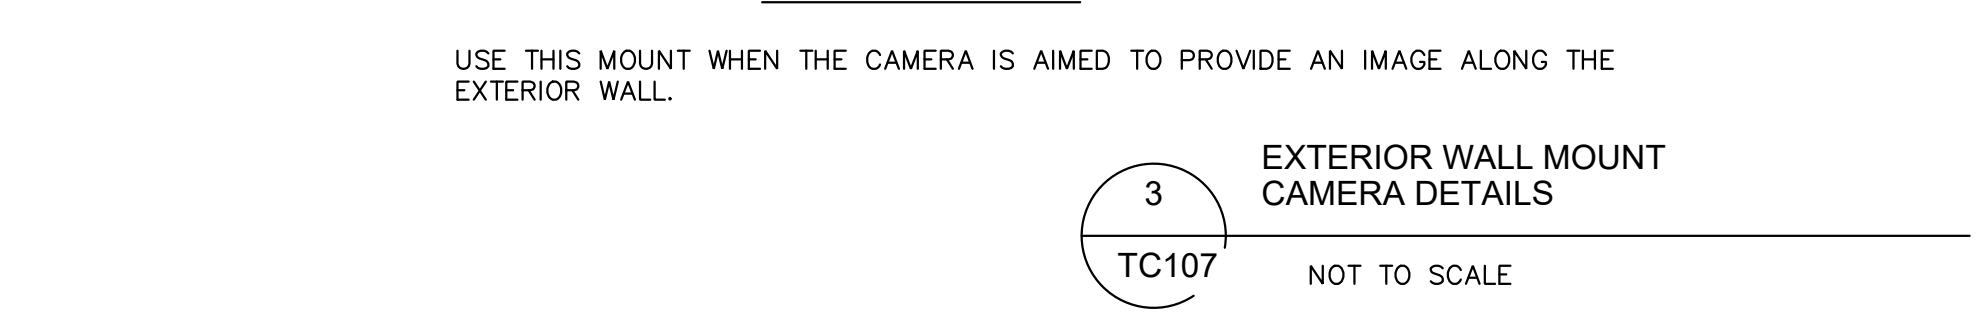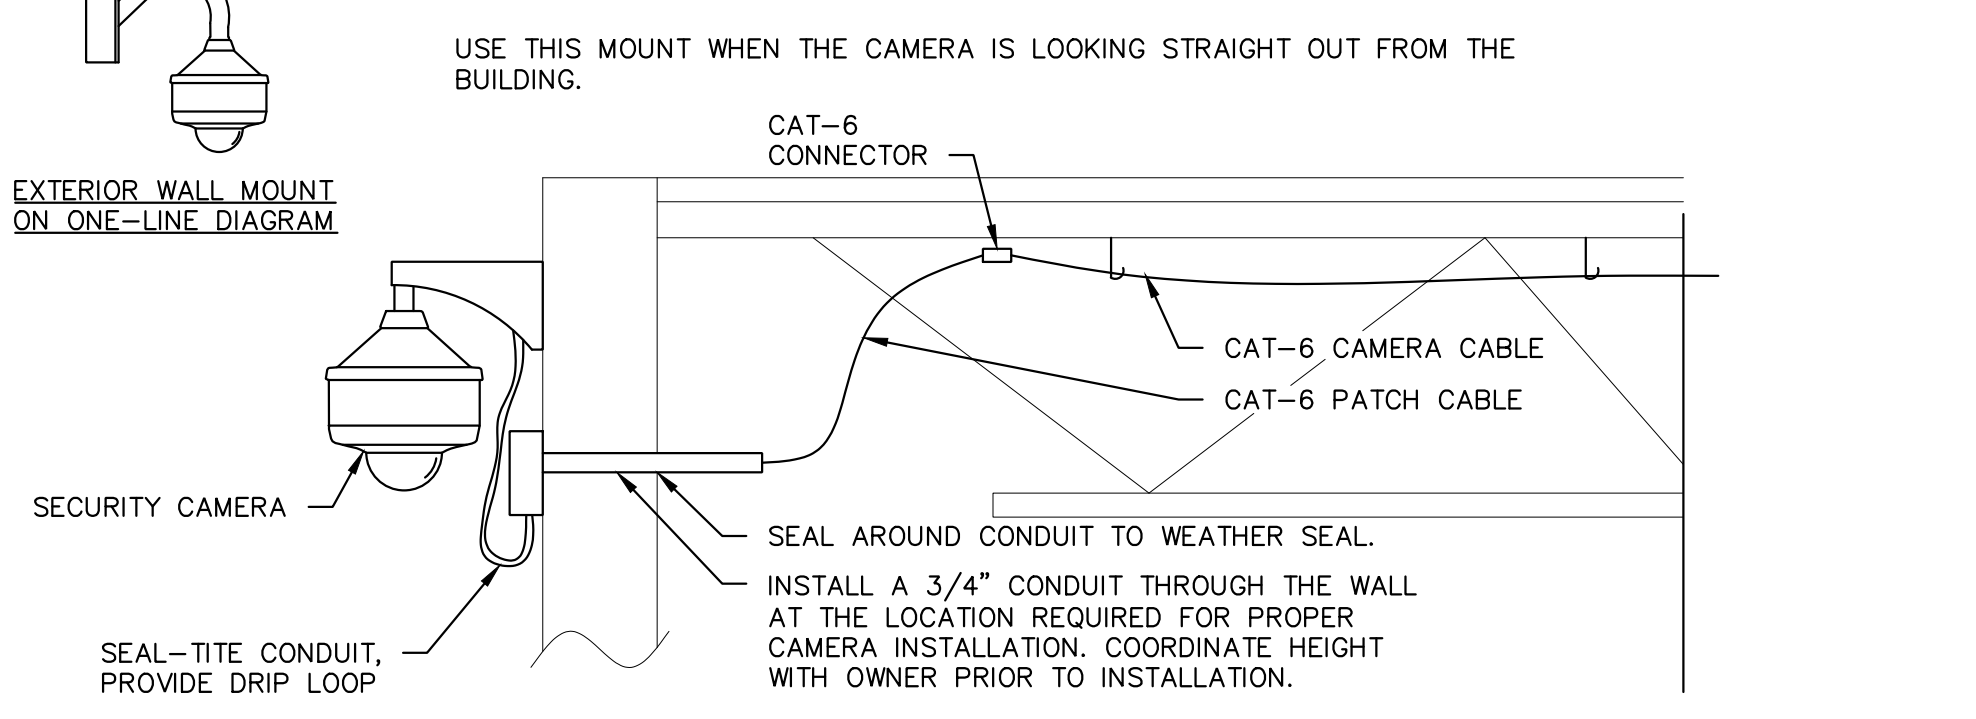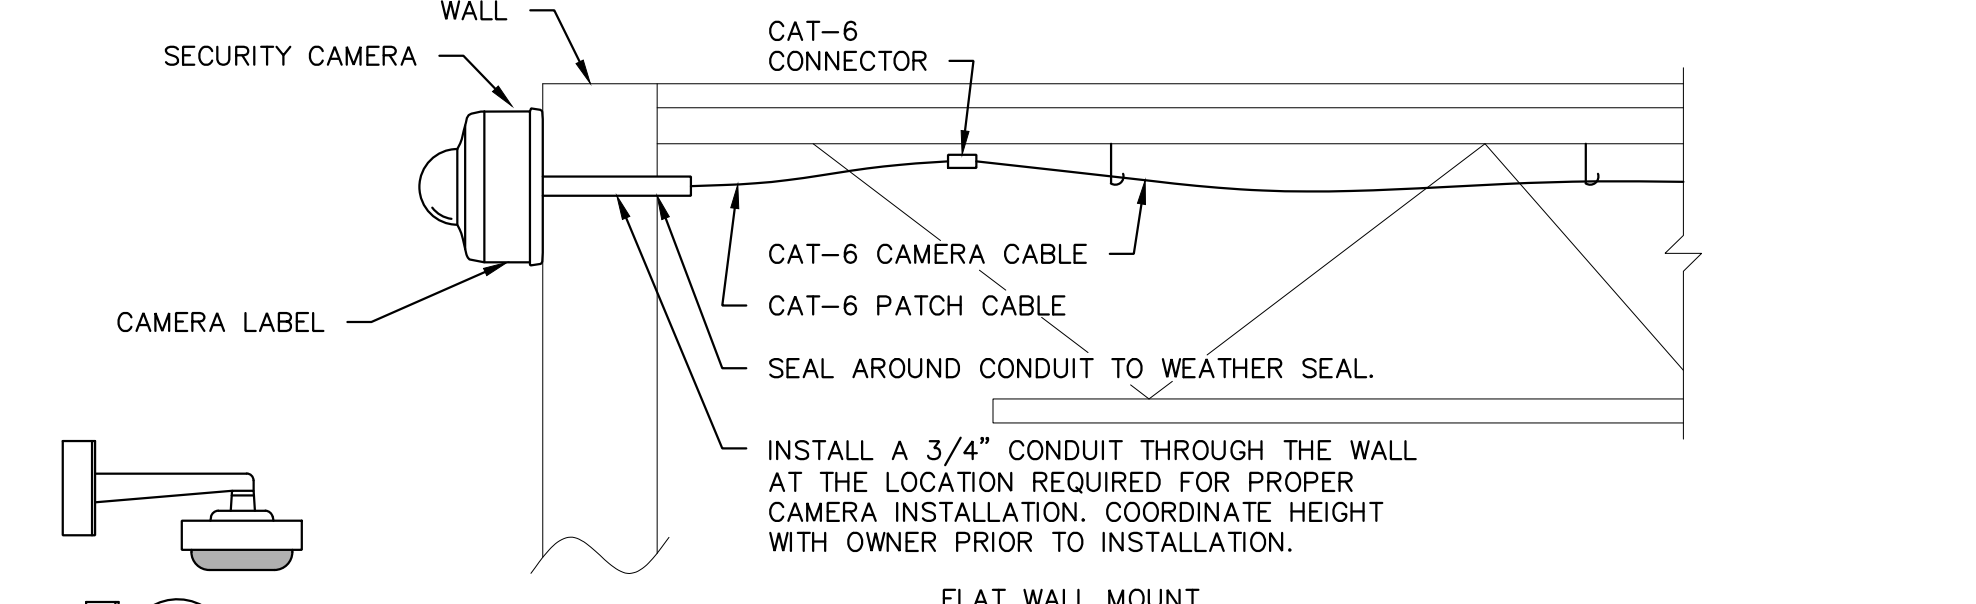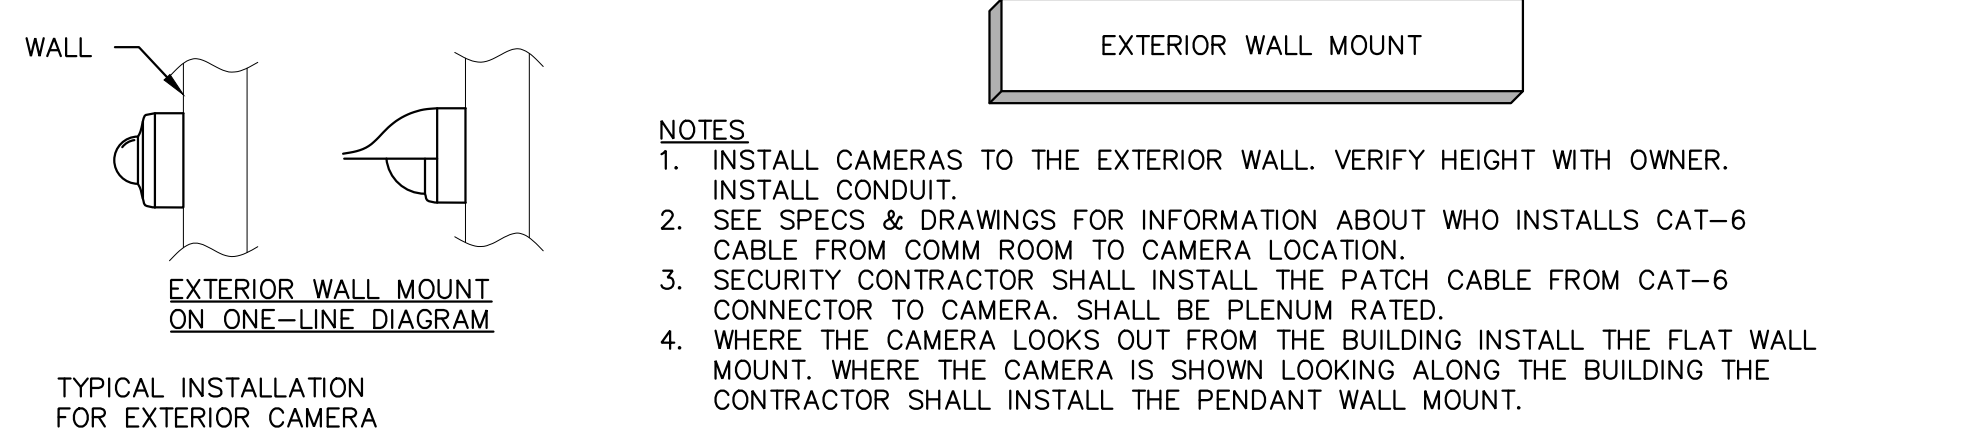

3 EXTERIOR WALL MOUNT CAMERA DETAILS
TC107 NOT TO SCALE

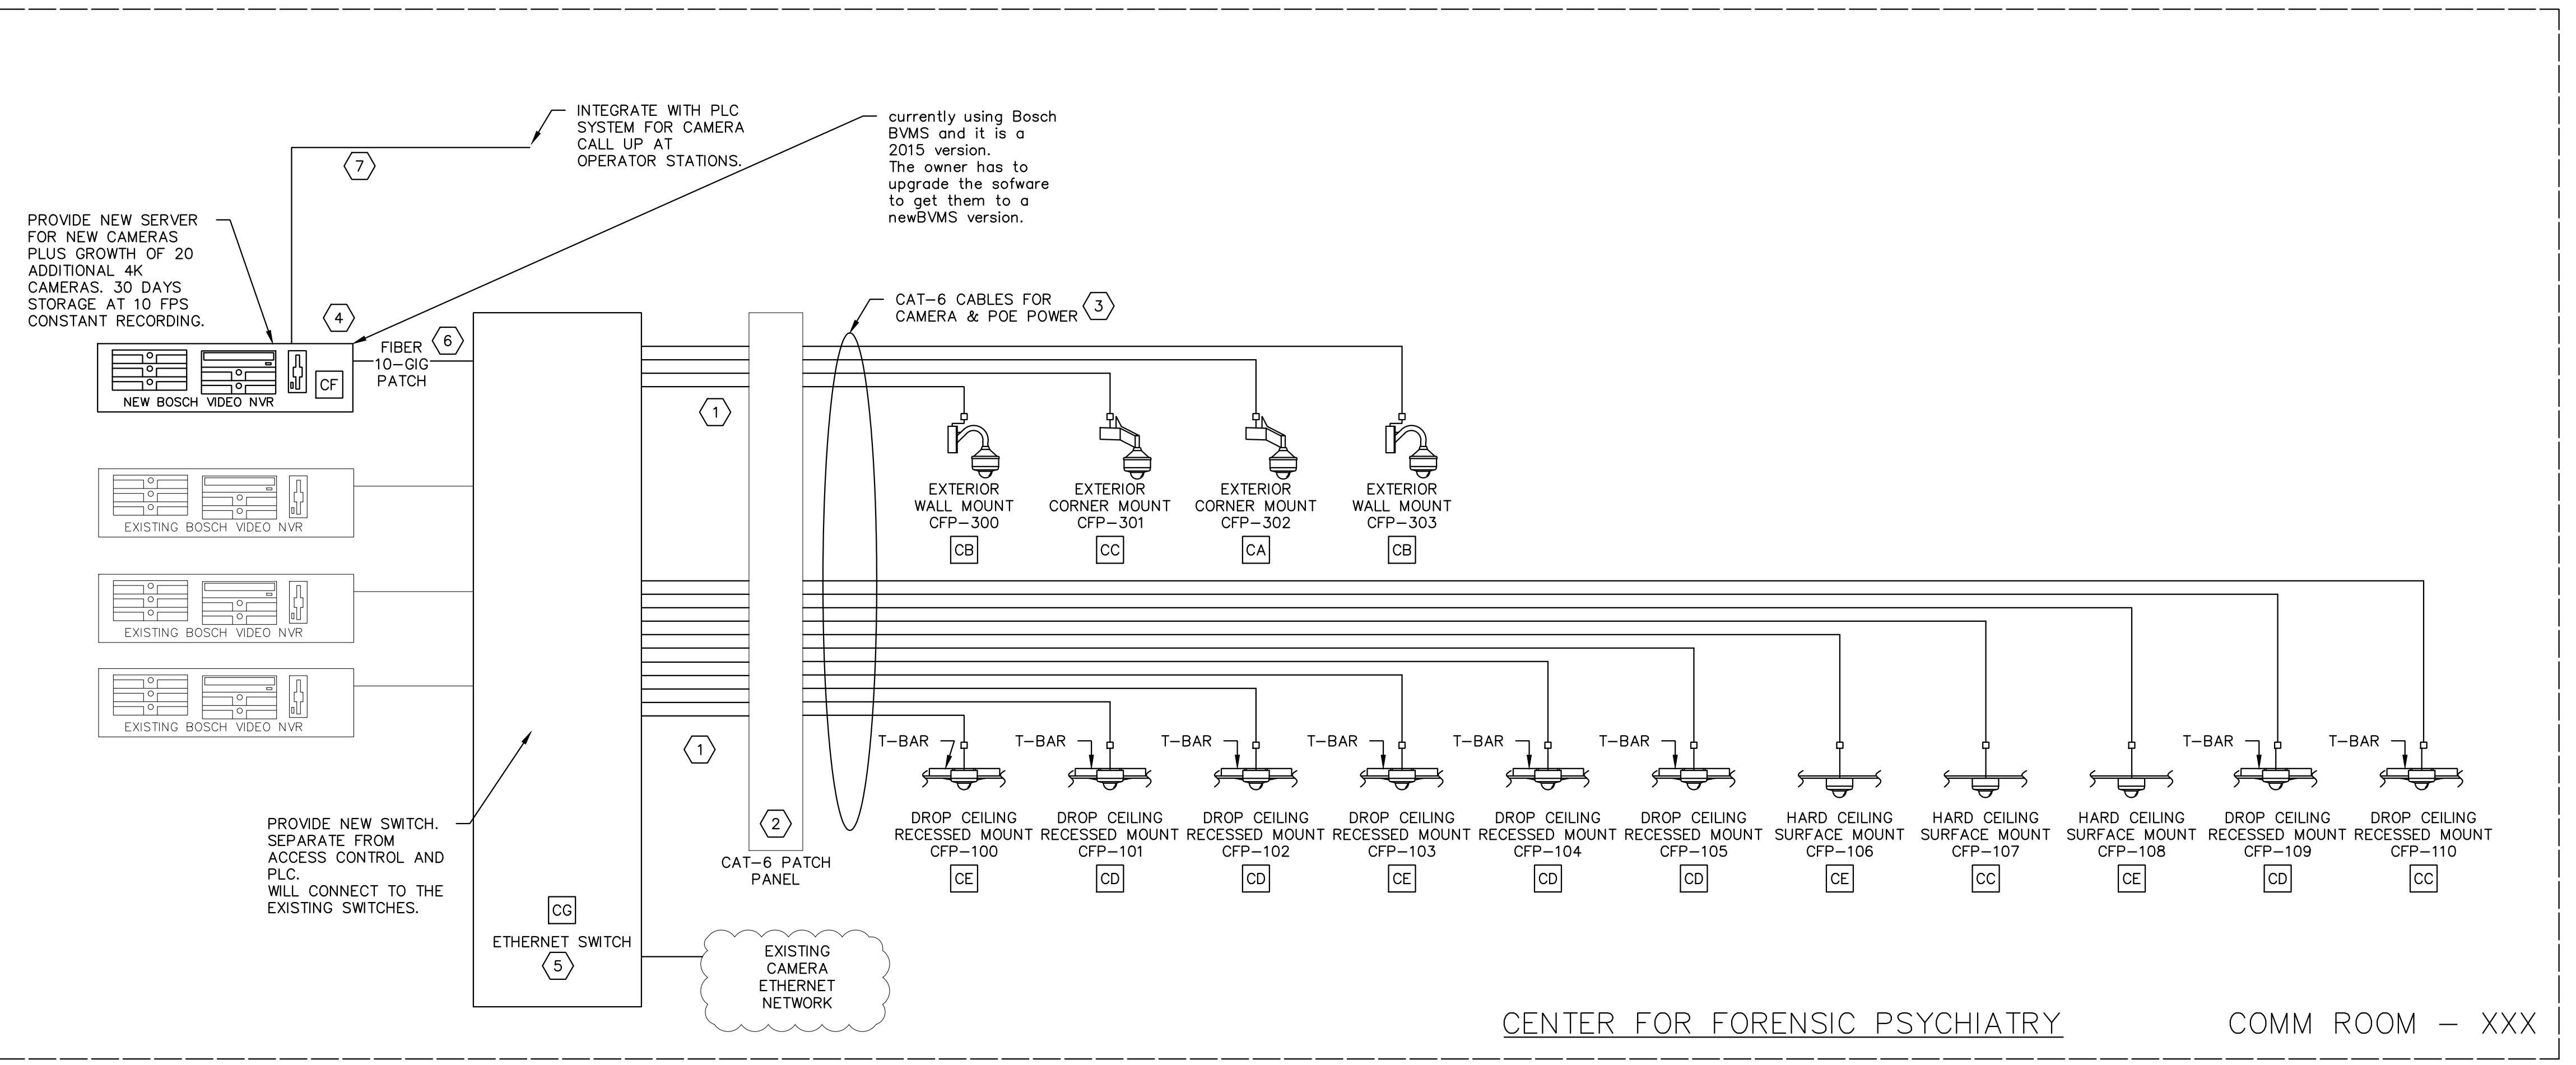

5 CAMERA ONE-LINE CONNECTIVITY
TC107 NOT TO SCALE

NO.	REVISION	DATE

STATE OF MICHIGAN
 DEPARTMENT OF TECHNOLOGY, MANAGEMENT AND BUDGET
 FACILITIES AND BUSINESS SERVICES ADMINISTRATION
 DESIGN AND CONSTRUCTION DIVISION
 ADAM LACH, RA, DIRECTOR

FILE NO.
49120167.SDW

FUNDING CODE
171CODHHS7255

CONTRACT NO.
Y22003

CommtechDesign
 6581 BELDING RD NE STE 101
 ROCKFORD, MICHIGAN 49341
 WWW.COMMTECHDESIGN.COM

WTAARCH.COM
WTA ARCHITECTS

100 S. Jefferson Ave, Suite 601
 Saginaw, Michigan 48607
 989 752 8107
 COPYRIGHT © 2023

PROJECT TITLE
49120167.SDW - PHASE 500:
CENTER FOR FORENSIC PSYCHIATRY - CREATE KITCHEN
 SALINE, MICHIGAN

SHEET TITLE
VIDEO SECURITY SYSTEM DETAILS

PROJECT NUMBER
2021094

SHEET NUMBER
TC107

PROJECT DATE
SEPTEMBER 6, 2023

CHECKED BY
BWE



GENERAL TECH NOTES

1. SECURITY CONTRACTOR SHALL INSTALL ANY CONDUITS & PASS-THRU'S REQUIRED FOR ROUTING CABLES AROUND THE BUILDING IN ADDITION TO THOSE SHOWN.
2. CONTRACTOR SHALL COMPLETE A WALK-THRU PRIOR TO CONSTRUCTION & SHALL VERIFY ALL RACEWAYS & PATHWAYS.
3. ALL CABLES SHALL BE SUPPORTED ABOVE THE DROP CEILING BY J-HOOKS. HOOKS SHALL BE LOCATED NO LESS THAN EVERY 5 FEET.
4. WHERE A CAMERA IS MARKED AS SURFACE MOUNTED ON THE ONE-LINE, THAT CAMERA MAY BE MOUNTED TO THE CEILING OR WALL. PROVIDE A BACKBOX & RACEWAY.

KEYED TECH NOTES

1. BACKPULL EXISTING SHAKER WIRE TO JUNCTION POINT OF NEW AN EXISTING FENCE. DURING CONSTRUCTION, CONFIGURE THE SHAKER WIRE SYSTEM TO END AN NEW EXISTING FENCE JUNCTION LOCATION.
2. REMOVE THE EXISTING STUN FENCE FROM TOP OF EXISTING FENCE.
3. ROUTE NEW STUN FENCE WIRES THRU UNDERGROUND CONDUITS THAT ARE SHOWN ON ELECTRICAL SITE PLAN.
4. MOUNT CAMERA AT 12' AFG
5. MOUNT CAMERA AT 15' AFG
6. TEMPORARILY INSTALL CABLES FROM STUN FENCE CABINET TO EXISTING FENCE TO MAINTAIN STUN FENCE DURING CONSTRUCTION. INSTALL FLEXIBLE CONDUIT AND ATTACH TO THE BUILDING. INSTALL HIGH ENOUGH TO AVOID VEHICLES AND NEW CONSTRUCTION

NO.	REVISION	DATE

STATE OF MICHIGAN
 DEPARTMENT OF TECHNOLOGY, MANAGEMENT AND BUDGET
 FACILITIES AND BUSINESS SERVICES ADMINISTRATION
 DESIGN AND CONSTRUCTION DIVISION
 ADAM LACH, RA, DIRECTOR

FILE NO.
 491/20167.SDW

FUNDING CODE
 171CODHHS7255

CONTRACT NO.
 Y22003

CommtechDesign
 6581 BELDING RD NE STE 101
 ROCKFORD, MICHIGAN 49341
 WWW.COMMTECHDESIGN.COM


WTA ARCHITECTS
 100 S. Jefferson Ave, Suite 601
 Saginaw, Michigan 48607
 989 752 8107
 COPYRIGHT © 2023


PROJECT TITLE
 491/20167.SDW - PHASE 500:
**CENTER FOR FORENSIC
 PSYCHIATRY - CREATE
 KITCHEN**

SALINE, MICHIGAN

SHEET TITLE
**TECHNOLOGY SITE
 PLAN**

PROJECT NUMBER 2021094	SHEET NUMBER TC200
PROJECT DATE SEPTEMBER 6, 2023	CHECKED BY BWE

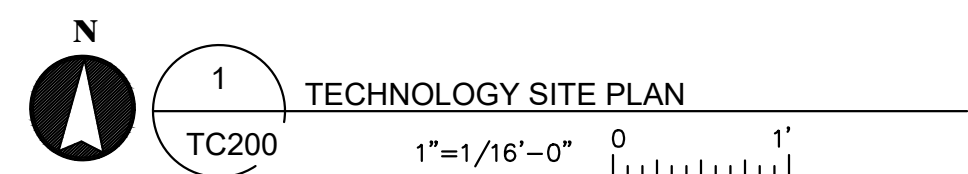

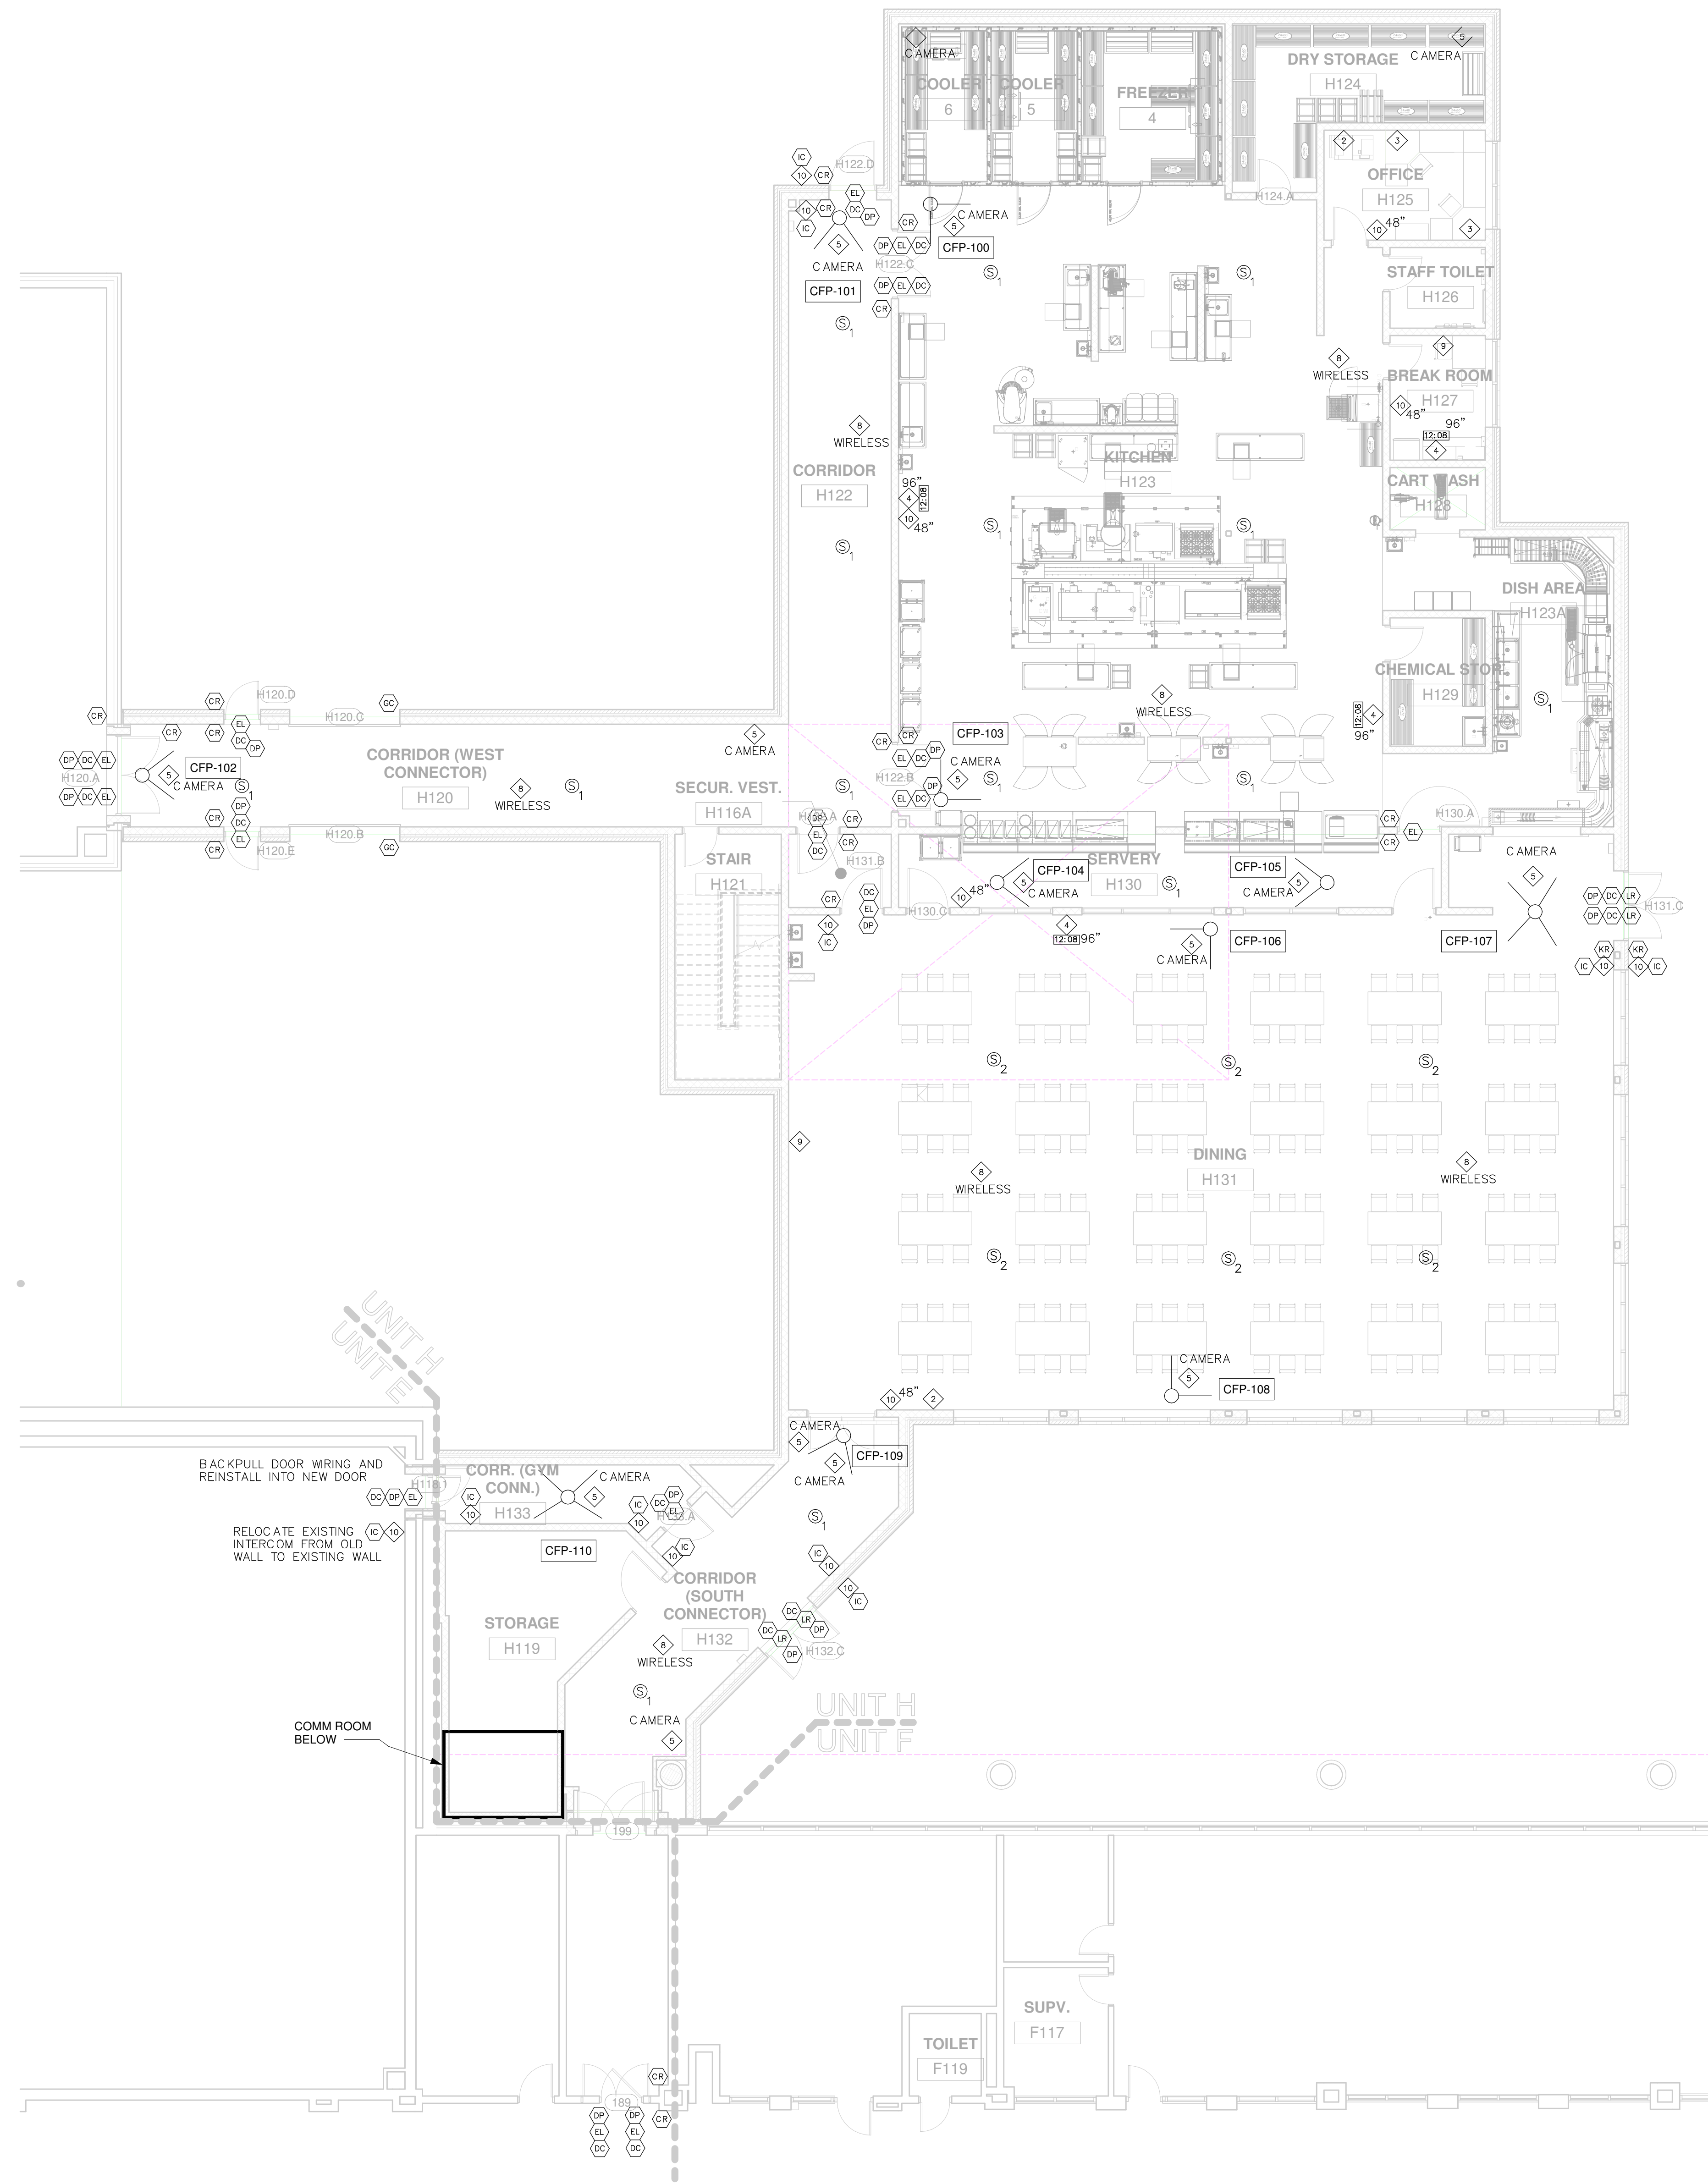

GENERAL TECH NOTES

1. SECURITY CONTRACTOR SHALL INSTALL ANY CONDUITS & PASS-THRU'S REQUIRED FOR ROUTING CABLES AROUND THE BUILDING IN ADDITION TO THOSE SHOWN.
2. CONTRACTOR SHALL COMPLETE A WALK-THRU PRIOR TO CONSTRUCTION & SHALL VERIFY ALL RACEWAYS & PATHWAYS.
3. ALL CABLES SHALL BE SUPPORTED ABOVE THE DROP CEILING BY J-HOOKS. HOOKS SHALL BE LOCATED NO LESS THAN EVERY 5 FEET.
4. WHERE A CAMERA IS MARKED AS SURFACE MOUNTED ON THE ONE-LINE, THAT CAMERA MAY BE MOUNTED TO THE CEILING OR WALL. PROVIDE A BACKBOX & RACEWAY.

KEYED TECH NOTES

1. BACKPULL EXISTING SHAKER WIRE TO JUNCTION POINT OF NEW AN EXISTING FENCE. DURING CONSTRUCTION, CONFIGURE THE SHAKER WIRE SYSTEM TO END AN NEW EXISTING FENCE JUNCTION LOCATION.
2. REMOVE THE EXISTING STUN FENCE FROM TOP OF EXISTING FENCE.
3. ROUTE NEW STUN FENCE WIRES THRU UNDERGROUND CONDUITS THAT ARE SHOWN ON ELECTRICAL SITE PLAN.
4. MOUNT CAMERA AT 12' AFG
5. MOUNT CAMERA AT 15' AFG
6. TEMPORARILY INSTALL CABLES FROM STUN FENCE CABINET TO EXISTING FENCE TO MAINTAIN STUN FENCE DURING CONSTRUCTION. INSTALL FLEXIBLE CONDUIT AND ATTACH TO THE BUILDING. INSTALL HIGH ENOUGH TO AVOID VEHICLES AND NEW CONSTRUCTION


NO.	REVISION	DATE

STATE OF MICHIGAN
 DEPARTMENT OF TECHNOLOGY, MANAGEMENT AND BUDGET
 FACILITIES AND BUSINESS SERVICES ADMINISTRATION
 DESIGN AND CONSTRUCTION DIVISION
 ADAM LACH, RA, DIRECTOR

FILE NO.
 491/20167.SDW

FUNDING CODE
 171CODHS7255

CONTRACT NO.
 Y22003

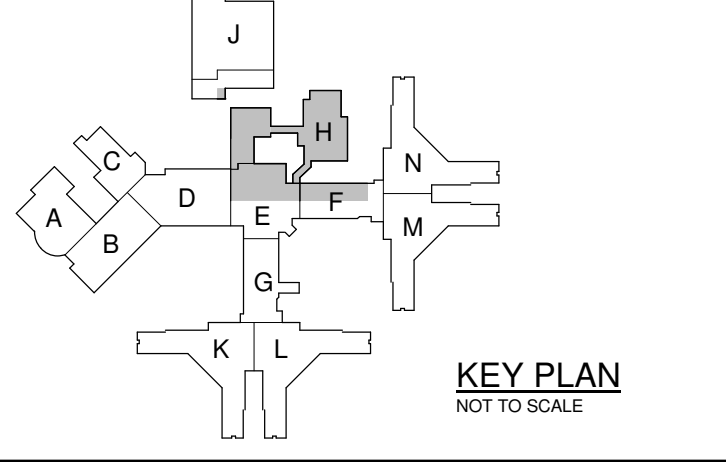


WTA ARCHITECTS

100 S. Jefferson Ave., Suite 601
 Saginaw, Michigan 48607
 989 752 8107

PROJECT TITLE
 491/20167.SDW - PHASE 500:
CENTER FOR FORENSIC PSYCHIATRY - CREATE KITCHEN
 SALINE, MICHIGAN

SHEET TITLE
FIRST FLOOR TECHNOLOGY PLAN

PROJECT NUMBER 2021094	SHEET NUMBER
PROJECT DATE SEPTEMBER 6, 2023	TC201
CHECKED BY BWE	

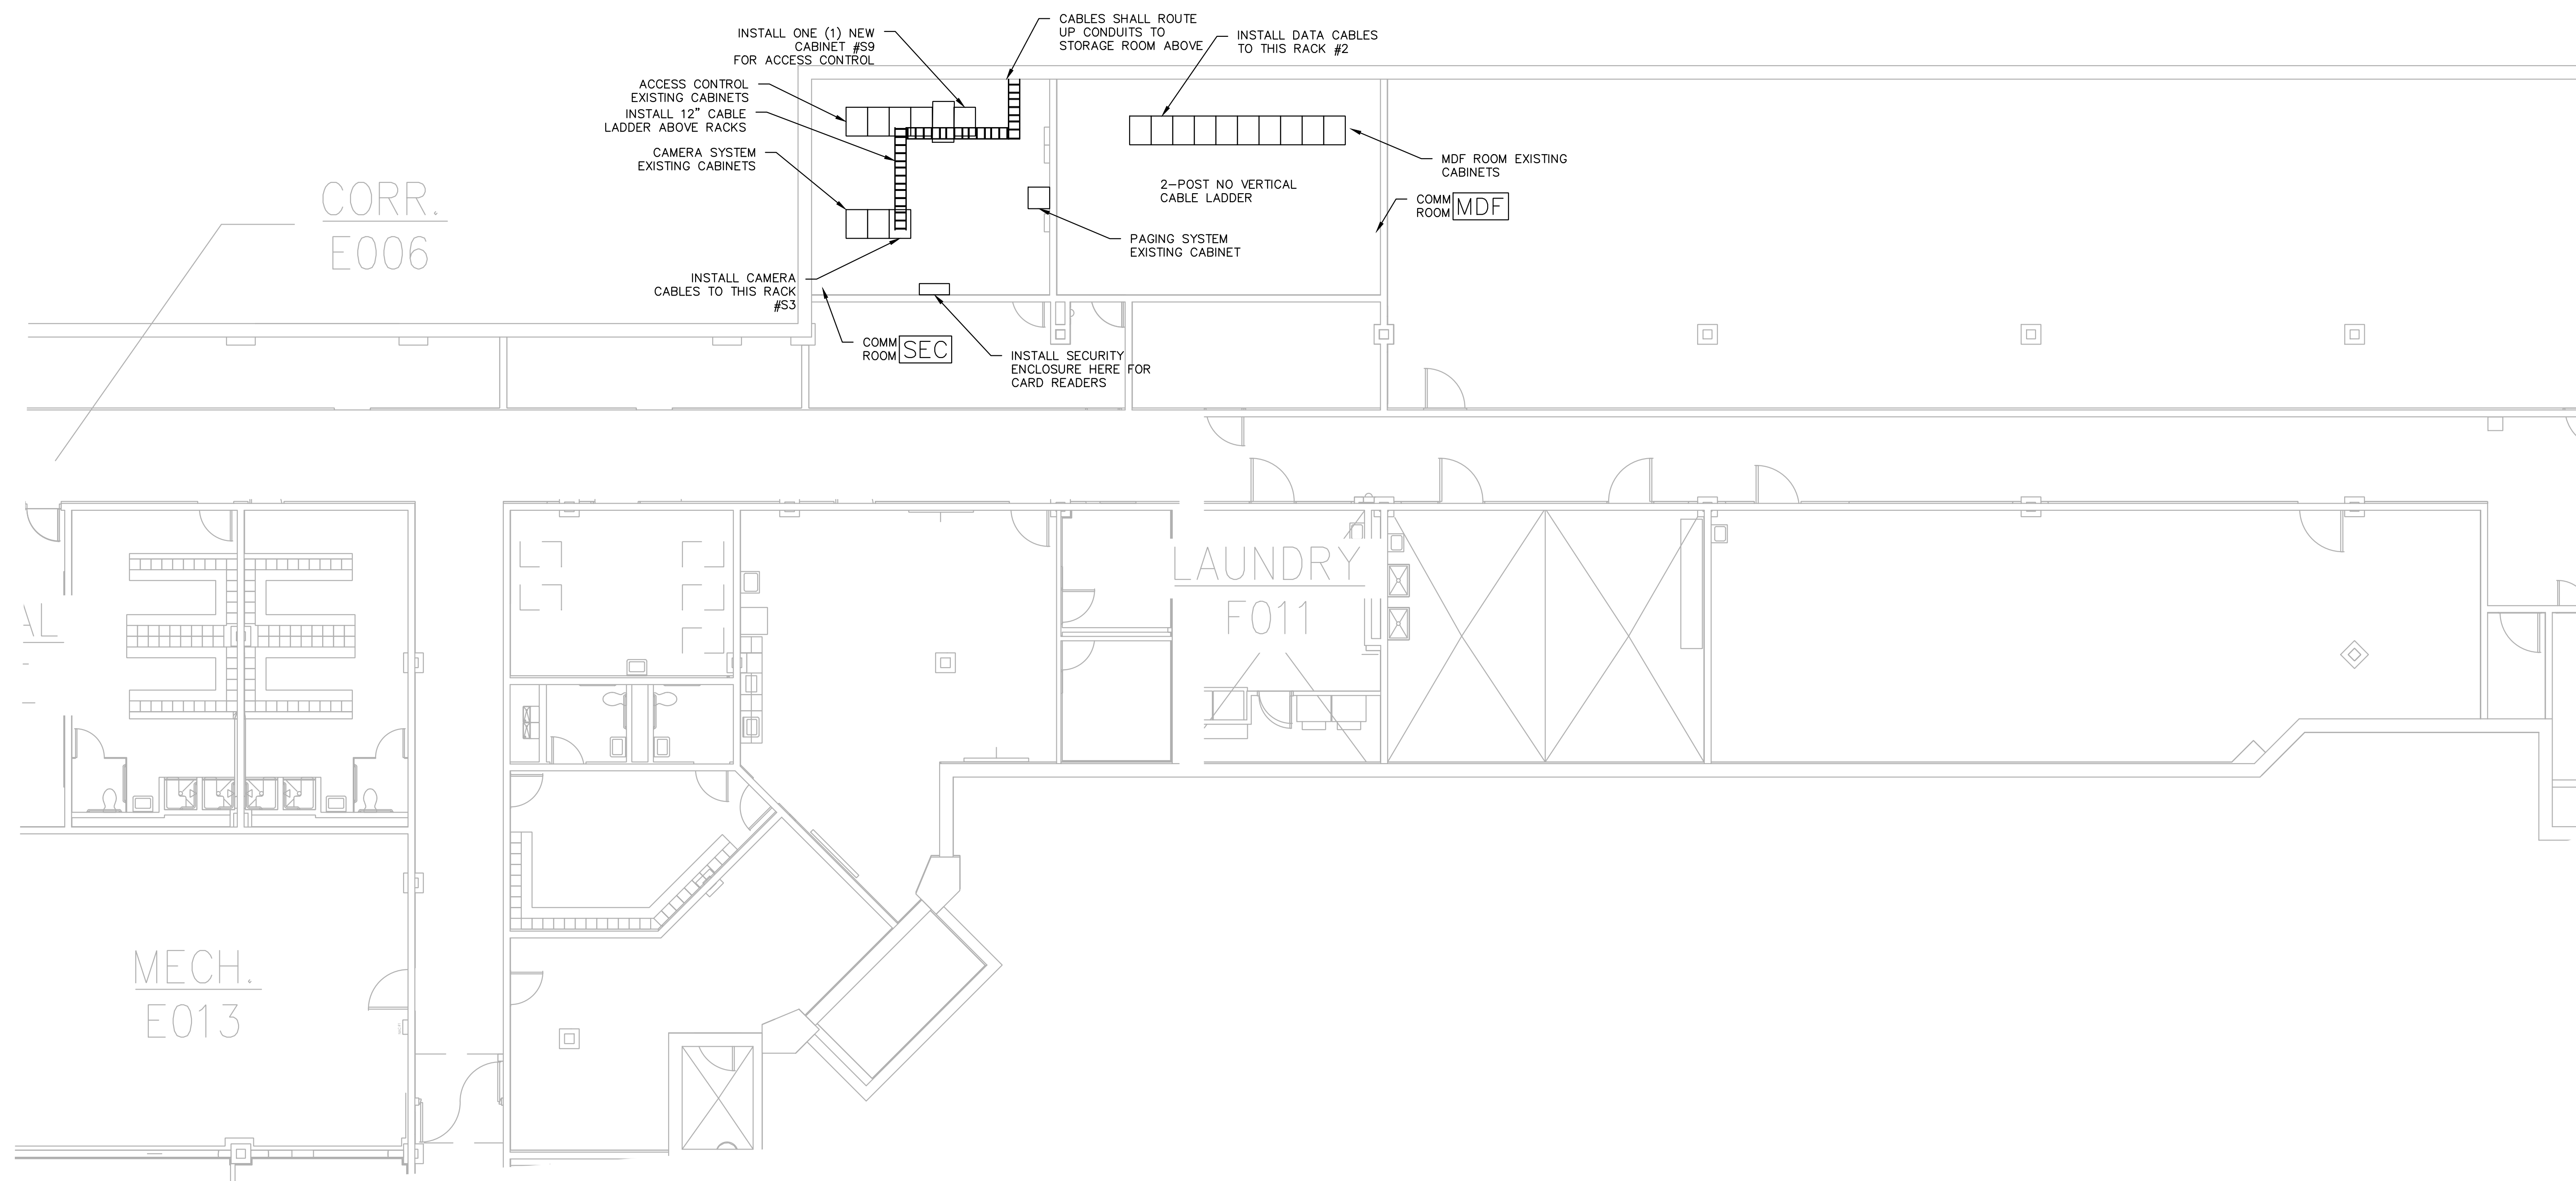

GENERAL TECH NOTES

1. SECURITY CONTRACTOR SHALL INSTALL ANY CONDUITS & PASS-THRU'S REQUIRED FOR ROUTING CABLES AROUND THE BUILDING IN ADDITION TO THOSE SHOWN.
2. CONTRACTOR SHALL COMPLETE A WALK-THRU PRIOR TO CONSTRUCTION & SHALL VERIFY ALL RACEWAYS & PATHWAYS.
3. ALL CABLES SHALL BE SUPPORTED ABOVE THE DROP CEILING BY J-HOOKS. HOOKS SHALL BE LOCATED NO LESS THAN EVERY 5 FEET.
4. WHERE A CAMERA IS MARKED AS SURFACE MOUNTED ON THE ONE-LINE, THAT CAMERA MAY BE MOUNTED TO THE CEILING OR WALL. PROVIDE A BACKBOX & RACEWAY.

KEYED TECH NOTES

1. BACKPULL EXISTING SHAKER WIRE TO JUNCTION POINT OF NEW AN EXISTING FENCE. DURING CONSTRUCTION, CONFIGURE THE SHAKER WIRE SYSTEM TO END AN NEW EXISTING FENCE JUNCTION LOCATION.
2. REMOVE THE EXISTING STUN FENCE FROM TOP OF EXISTING FENCE.
3. ROUTE NEW STUN FENCE WIRES THRU UNDERGROUND CONDUITS THAT ARE SHOWN ON ELECTRICAL SITE PLAN.
4. MOUNT CAMERA AT 12' AFG
5. MOUNT CAMERA AT 15' AFG
6. TEMPORARILY INSTALL CABLES FROM STUN FENCE CABINET TO EXISTING FENCE TO MAINTAIN STUN FENCE DURING CONSTRUCTION. INSTALL FLEXIBLE CONDUIT AND ATTACH TO THE BUILDING. INSTALL HIGH ENOUGH TO AVOID VEHICLES AND NEW CONSTRUCTION

NO.	REVISION	DATE

STATE OF MICHIGAN
 DEPARTMENT OF TECHNOLOGY, MANAGEMENT AND BUDGET
 FACILITIES AND BUSINESS SERVICES ADMINISTRATION
 DESIGN AND CONSTRUCTION DIVISION
 ADAM LACH, RA, DIRECTOR

FILE NO.
 491/20167.SDW

FUNDING CODE CONTRACT NO.
 171CODHHS7255 Y22003


CommtechDesign
 6581 BELDING RD NE STE 101
 ROCKFORD, MICHIGAN 49341
 WWW.COMMTECHDESIGN.COM

WTAARCH.COM
WTA ARCHITECTS
 100 S. Jefferson Ave, Suite 601
 Saginaw, Michigan 48607
 989 752 8107 COPYRIGHT © 2023

PROJECT TITLE
 491/20167.SDW - PHASE 500:
**CENTER FOR FORENSIC
 PSYCHIATRY - CREATE
 KITCHEN**
 SALINE, MICHIGAN

SHEET TITLE
**BASEMENT
 TECHNOLOGY PLAN
 AREA 100**

PROJECT NUMBER 2021094	SHEET NUMBER TC201A
PROJECT DATE SEPTEMBER 6, 2023	
CHECKED BY BWE	

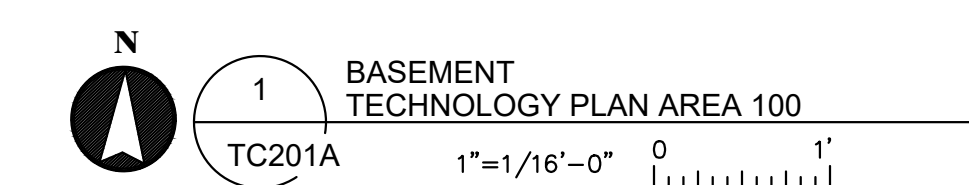

Department of Licensing and Regulatory Affairs

1st Floor Ottawa Building
611 W. Ottawa Street
Lansing, MI 48933



Final Report - Approved

Application Number: PR2023BCC-002591

Report Date: 03/29/2024

Description : New one-story with a penthouse addition to existing structure for commercial kitchen and dining space. Addition totals 11,124 square feet and includes plumbing, HVAC, electrical, food service equipment, communications and IT, and associated site work for new construction.

Address : 8303 PLATT RD, SALINE, MI, 48176

Record Type : Bureau of Construction Codes Plan Review Application

Document Filename : PR2023BCC-002591 - Response_03-19-24.pdf

Reviewer Contact Information:

Reviewer Name	Reviewer Email	Reviewer Phone
Daniel Morris	MorrisD9@michigan.gov	517-927-9734

General Comments

Markups for this Approved Document or Plan



MECHANICAL

These documents are approved for compliance with the STATE OF MICHIGAN MECHANICAL CODE subject to field inspection and the conditions of approval.



WTA ARCHITECTS

100 S Jefferson Ave, Suite 601
Saginaw, Michigan 48607
989 752 8107 : p
989 752 3125 : f

WTAARCH.COM

November 16, 2022

Daniel Morris
Bureau of Construction Codes
517-927-9734
Morrisd9@michigan.gov

RE: PR2023BCC-002591 – Center For Forensic Psychiatry

Dear Mr. Daniel Morris

Please see below for our response to your review comment.

Review Comment:

Describe how the make-up air system is interlocked with the hood exhaust. Hvac-21h needs to be interlocked with the hood or the amount of make up air needs to be available all the time. Mmc 508.1.2 an air table for the kitchen showing what equipment is supplying make up air for exhaust systems, the amount of kitchen ventilation being provided for the space and population density, kitchen exhaust and kitchen positive or negative design .

Response to Comment:

Our Makeup Air Unit (AHU-22H) serving the Kitchen Exhaust Hoods (EF-9H and EF-10H) are interlocked. The kitchen hoods are to be manually turned On/Off, and the Makeup Air will be interlocked with both of these fans, to be enabled when either Exhaust Fan is turned on. See M8.03 Temperature Controls, *'Kitchen Exhaust Hoods (EF-9H & EF-10H) and Make-Up Air Unit (AHU-22H) Control'* Sequence Lines 2, 3, and 6 for more information.

Mechanical Schedules included with this submission, providing the Makeup Air (AHU-22H, using SF-2) at 8700 CFM. This is sized for the total combined rate of Exhaust Hoods, EF-9H at 3600 CFM and EF-10H at 5100 CFM, which is balanced according to 508.1.2 and is available on M7.03 and M7.04.

VFD controls are to be installed so that the Makeup air rate matches the specific fan that is enabled, per Sequence of Operation Line 6.

WIGEN
TINCKNELL
ASSOCIATES
ARCHITECTS

[SPACE SOLVED.](http://SPACE.SOLVED)

Department of Licensing and Regulatory Affairs

1st Floor Ottawa Building
611 W. Ottawa Street
Lansing, MI 48933



Final Report - Approved

Application Number: PR2023BCC-002591

Report Date: 03/29/2024

Description : New one-story with a penthouse addition to existing structure for commercial kitchen and dining space. Addition totals 11,124 square feet and includes plumbing, HVAC, electrical, food service equipment, communications and IT, and associated site work for new construction.

Address : 8303 PLATT RD, SALINE, MI, 48176

Record Type : Bureau of Construction Codes Plan Review Application

Document Filename : FS2.02.pdf


Reviewer Contact Information:

Reviewer Name	Reviewer Email	Reviewer Phone
Daniel Morris	MorrisD9@michigan.gov	517-927-9734


General Comments

Markups for this Approved Document or Plan

Comment ID	Page Ref	Reviewer : Department	Review Comments
27	FS2.02	Daniel Morris : Mechanical	MMC, Section 304.11 - Guards. Guards shall be provided where various components that require service and roof hatch openings are located within 10 feet (3048 mm) of a roof edge or open side of a walking surface and such edge or open side is located more than 30 inches (762 mm) above the floor, roof, or grade below. The guard shall extend not less than 30 inches (762 mm) beyond each end of components that require service. The top of the guard shall be located not less than 42 inches (1067 mm) above the elevated surface adjacent to the guard.

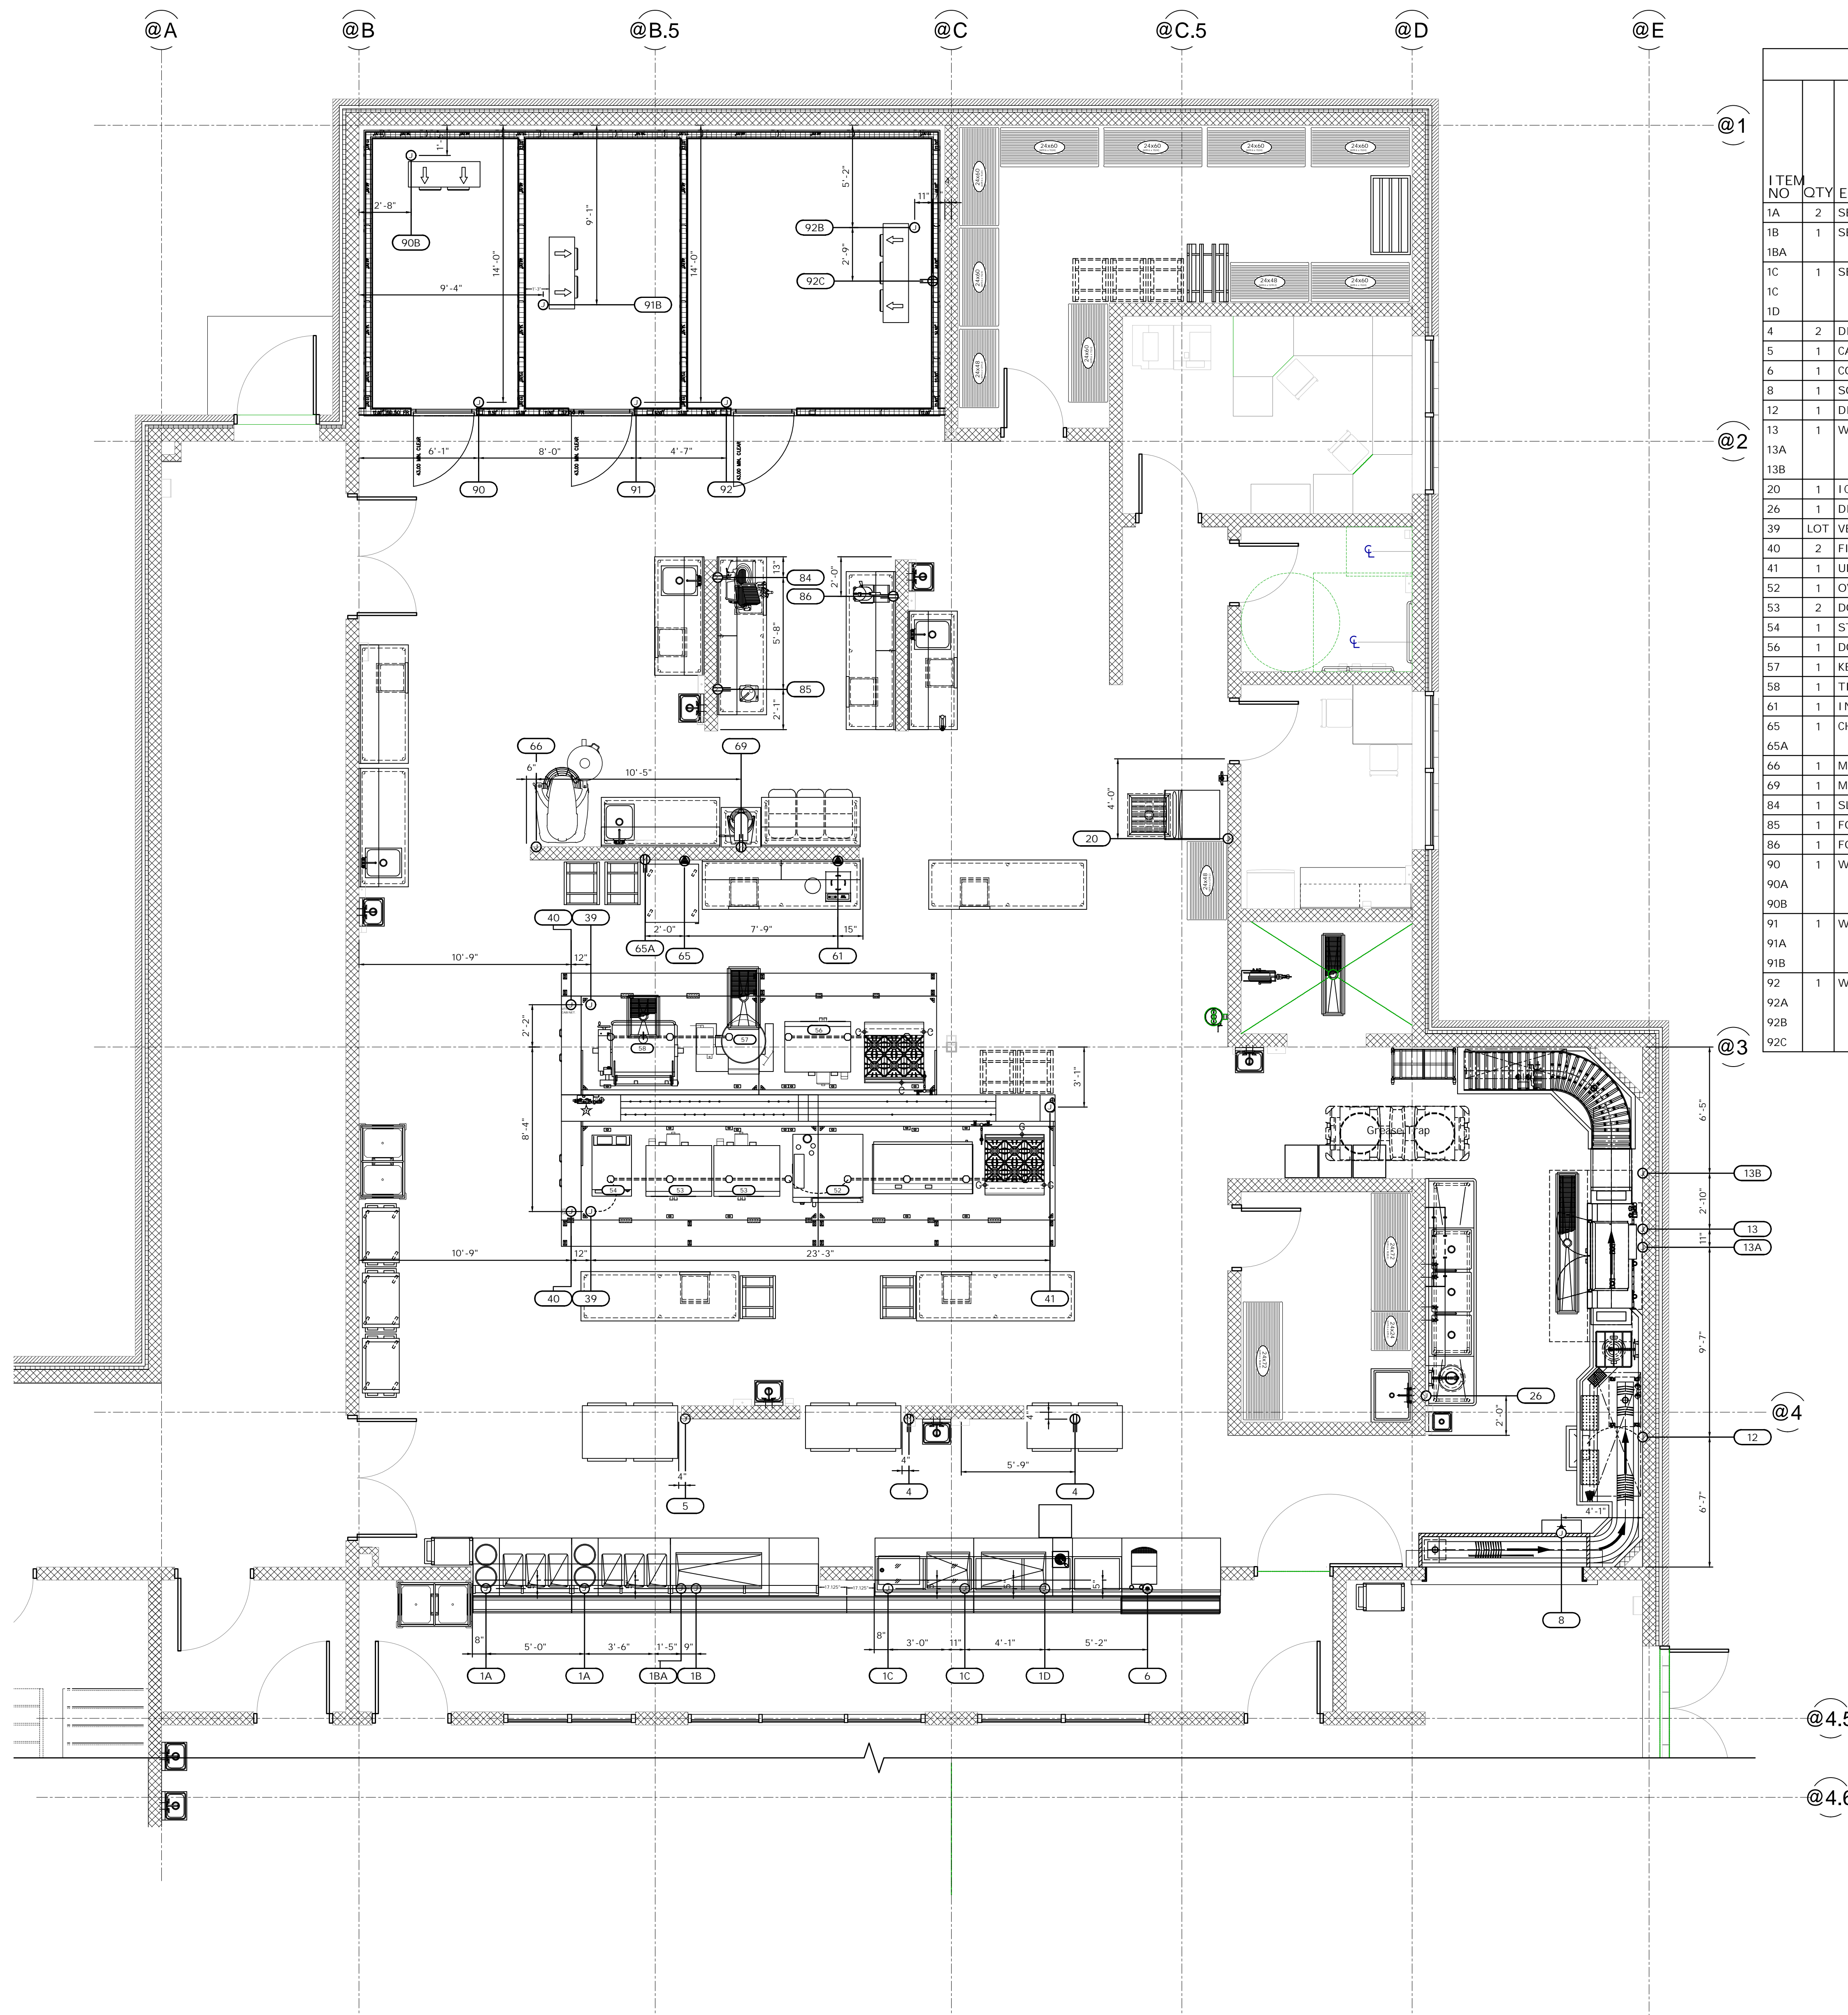

ITEM NO	QTY	EQUIPMENT CATEGORY	AMPS	KW	HP	VOLTS	PHASE	CYCLE	DIRECT	PLUG	NEMA	ELECTRICAL AFF. (N)	ELEC REMARKS
1A	2	SERVING LINE - HOT FOOD	15.9	3.3		208	1		X			SU	'STUB UP' UTILITIES
1B	1	SERVING LINE - HOT/COLD FOOD COMBO	15.9	3.3		208	1		X			SU	'STUB UP' UTILITIES
1BA			3.5			115	1		X			SU	'STUB UP' UTILITIES
1C	1	SERVING LINE - COLD FOOD	3.5			115	1		X			SU	'STUB UP' UTILITIES
1C			3.5			115	1		X			SU	'STUB UP' UTILITIES
1D			3.5			115	1		X			SU	'STUB UP' UTILITIES
4	2	DISPLAY CASE, REFRIGERATED	10.6		0.5	115	1		X	5-20P	86		STUB UP OR BRING DOWN FROM ABOVE FOR UNIT AWAY FROM WALL
5	1	CABINET, HEATED, PASS-THRU	15.5	1.6		115/208	1		X			86	
6	1	COFFEE MAKER, DISPENSER	12.0	1.44		120	1		X	5-15P		SU	
8	1	SOILED DISHTABLE TRAY CONVEYOR	15.0			208	1		X			60	
12	1	DISPOSER, GARBAGE	6.0		3.0	208	3		X			12	E.C. TO INTERWIRE TO CONTROL PANEL
13	1	WAREWASHER, RACK CONVEYOR	44.9	25.0		480	3		X			63.75	FOR MOTORS, CONTROLS & TANK HEAT
13A			40.1	30.0		480	3		X			63.75	FOR BOOSTER HEATER
13B			15.7			480	3		X			60	FOR BLOWER DRYER
20	1	ICE MAKER W/ BIN	11.9			115	1		X			72	
26	1	DISPOSER, GARBAGE	3.3		2.0	208	3		X			12	E.C. TO INTERWIRE TO CONTROL PANEL
39	LOT	VENTILATION SYSTEM	15.0			115	1		X			DFA	SERVICE TO LIGHTS & TEMP SENSORS
40	2	FIRE SUPPRESSION SYSTEM	20.0			120	1		X			DFA	20 AMP, 24-HR DEDICATED CIRCUIT
41	1	UDS SYSTEM	50.0	14.4		120/208	3		X			DFA	UDS SERVES ALL EQUIPMENT UNDER HOODS
52	1	OVEN-STEAMER, COMBINATION, GAS	9.6	2.2		208/240	1		X	6-50P	*		UTILITY SERVICE FROM ITEM 41, UDS SYSTEM
53	2	DOUBLE OVEN, CONVECTION, GAS	(2)7.7		(2)1/2	120	1		X	5-15P	*		UTILITY SERVICE FROM ITEM 41, UDS SYSTEM
54	1	STEAMER, PRESSURELESS	2.0	0.3		120	1		X				UTILITY SERVICE FROM ITEM 41, UDS SYSTEM
56	1	DOUBLE OVEN, CONVECTION, GAS	(2)7.7		(2)1/2	120	1		X	5-15P	*		UTILITY SERVICE FROM ITEM 41, UDS SYSTEM
57	1	KETTLE, STEAM JACKETED, GAS, TILT	5.0			115	1		X			*	UTILITY SERVICE FROM ITEM 41, UDS SYSTEM
58	1	TILT SKILLET, GAS	5.0			115	1		X			*	UTILITY SERVICE FROM ITEM 41, UDS SYSTEM
61	1	INDUCTION CHARGER	20.0	6.7		208	3		X	L15-20P	48		
65	1	CHILLER/FREEZER, BLAST	10.0		3.0	208	3		X	L15-20P	12		MAIN SERVICE TO UNIT
65A			2.0			120	1		X	5-15P	12		SERVICE FOR CONDENSATE EVAPORATOR
66	1	MIXER, FLOOR	12.0		3.0	200-240	3		X		54		CORD & PLUG NOT PROVIDED: L15-20P RECEPTACLE & PLUG CAN BE USED
69	1	MIXER, COUNTER	9.0		0.5	120	1		X	5-15P	36		
84	1	SLICER, FOOD	5.6		0.5	120	1		X	5-15P	45		
85	1	FOOD PROCESSOR	8.0		0.75	120	1		X	5-15P	45		
86	1	FOOD PROCESSOR	10.0		1.0	120	1		X	5-15P	45		
90	1	WALK-IN MEAT COOLER	15.0			120	1		X			DFA	SERVICE TO LIGHTS, ALARMS & HEATERS
90A			7.4		0.75	208-230	1		X			SU	SERVICE TO MEAT COOLER CONDENSING UNIT
90B			1.6			115	1		X			DFA	SERVICE TO MEAT COOLER EVAPORATOR COIL
91	1	WALK-IN PRODUCE COOLER	15.0			120	1		X			DFA	SERVICE TO LIGHTS, ALARMS & HEATERS
91A			7.0		0.75	208-230	1		X			SU	SERVICE TO PRODUCE COOLER CONDENSING UNIT
91B			1.6			115	1		X			DFA	SERVICE TO PRODUCE COOLER EVAPORATOR COIL
92	1	WALK-IN FREEZER	15.0			120	1		X			DFA	SERVICE TO LIGHTS, ALARMS & HEATERS
92A			21.4		3.0	208-230	1		X			SU	SERVICE TO FREEZER CONDENSING UNIT
92B			14.3			208-230	1		X			DFA	SERVICE TO FREEZER EVAPORATOR COIL
92C			15.0			120	1		X	5-15P	84		15 AMP CIRCUIT FOR DRAIN LINE HEAT TAPE

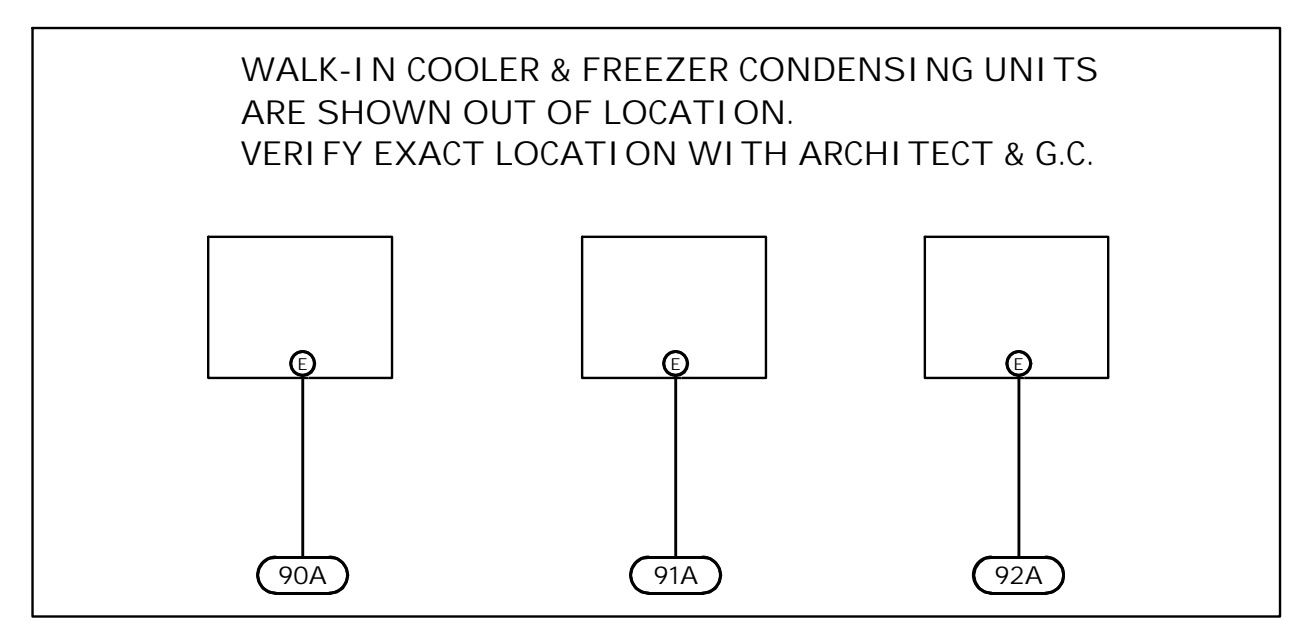


A3	ADDENDUM NO. 3	09/28/23
NO.	REVISION	DATE

STATE OF MICHIGAN
 DEPARTMENT OF TECHNOLOGY, MANAGEMENT AND BUDGET
 FACILITIES AND BUSINESS SERVICES ADMINISTRATION
 DESIGN AND CONSTRUCTION DIVISION
 ADAM LACH, RA, DIRECTOR

FILE NO.
 491/20167.SDW

FUNDING CODE
 171C0DHHS7255

CONTRACT NO.
 Y22003

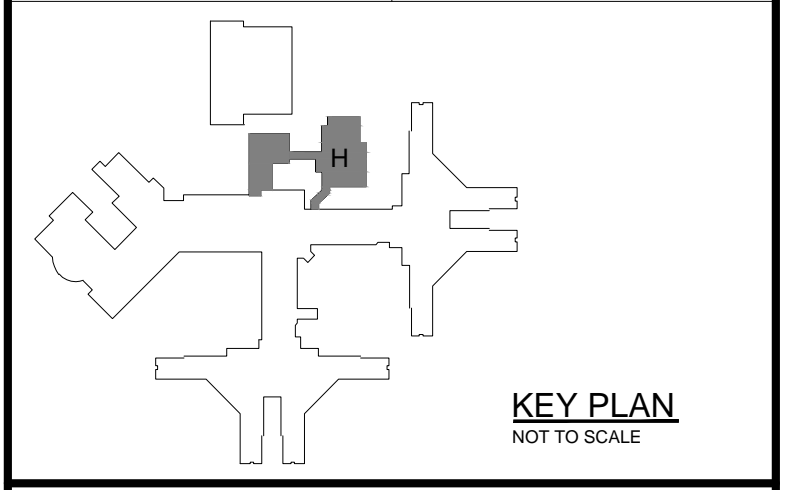

WTA ARCHITECTS
 100 S Jefferson Ave, Suite 601
 Saginaw, Michigan 48607
 989 752 8107
 COPYRIGHT © 2023

STAFFORD-SMITH, Inc.
 COMMERCIAL REFRIGERATION FOOD SERVICE EQUIPMENT
 301 S. BURTON ALAMADO, MICHIGAN 48801
 PH: (989) 251-0271

PROJECT TITLE
 491/20167.SDW CFP - CREATE KITCHEN
 BID AND CONSTRUCTION:
**CENTER FOR FORENSIC
 PSYCHIATRY**
 SALINE, MICHIGAN

SHEET TITLE
KITCHEN ELECTRICAL PLAN

PROJECT NUMBER 2021094	SHEET NUMBER
PROJECT DATE SEPTEMBER 6, 2023	FS2.02
CHECKED BY T.M.M.	

MECHANICAL
 These documents are approved for compliance with the STATE OF MICHIGAN MECHANICAL CODE subject to field inspection and the conditions of approval.

Department of Licensing and Regulatory Affairs

1st Floor Ottawa Building
611 W. Ottawa Street
Lansing, MI 48933



Final Report - Approved

Application Number: PR2023BCC-002591

Report Date: 03/29/2024

Description : New one-story with a penthouse addition to existing structure for commercial kitchen and dining space. Addition totals 11,124 square feet and includes plumbing, HVAC, electrical, food service equipment, communications and IT, and associated site work for new construction.

Address : 8303 PLATT RD, SALINE, MI, 48176

Record Type : Bureau of Construction Codes Plan Review Application

Document Filename : FS2.04.pdf

Reviewer Contact Information:

Reviewer Name	Reviewer Email	Reviewer Phone
Daniel Morris	MorrisD9@michigan.gov	517-927-9734

General Comments

Markups for this Approved Document or Plan

Department of Licensing and Regulatory Affairs

1st Floor Ottawa Building
611 W. Ottawa Street
Lansing, MI 48933



Final Report - Approved

Application Number: PR2023BCC-002591

Report Date: 03/29/2024

Description : New one-story with a penthouse addition to existing structure for commercial kitchen and dining space. Addition totals 11,124 square feet and includes plumbing, HVAC, electrical, food service equipment, communications and IT, and associated site work for new construction.

Address : 8303 PLATT RD, SALINE, MI, 48176

Record Type : Bureau of Construction Codes Plan Review Application

Document Filename : M7.03 MECHANICAL SCHEDULES.pdf

Reviewer Contact Information:

Reviewer Name	Reviewer Email	Reviewer Phone
Daniel Morris	MorrisD9@michigan.gov	517-927-9734

General Comments

Markups for this Approved Document or Plan

AIR HANDLING UNIT SUPPLY AIR FAN SCHEDULE																			
UNIT IDENTIFICATION	SYSTEM SERVED	TYPE	AIRFLOW CFM	E.S.P. IN. W.G.	T.S.P. IN. W.G.	MINIMUM WHEEL DIAMETER INCHES	RPM	FAN CLASS	MOTOR				MODULATION/CONTROL TYPE	ELECTRICAL				MODEL NUMBER	KEYED NOTES
									BHP	HP	RPM	DRIVE TYPE		VOLTS	PHASE	SCCR KA (NOTE 5)	OPTIONS/ACCESSORIES		
RF-1	AHU-21H	CENTRIFUGAL	10,000	1.0	1.19	22.25	2403	2	5.12	7.5	1750	DIRECT	VFD	460	3		CAH021GDGC		

GENERAL NOTES:
 1. REFER TO SCHEDULES GENERAL NOTES.
 2. MODEL NUMBERS ARE DAIKIN UNLESS OTHERWISE NOTED.
 3. DESIGN MINIMUM OUTSIDE AIRFLOW CFM (VENTILATION) LISTED IS BASED ON THE ESTIMATED MAXIMUM OCCUPANT LOAD. REFER TO TEMPERATURE CONTROL DRAWINGS FOR OUTSIDE AIR CONTROL SEQUENCE.
 4. REFER TO AIR HANDLING UNIT FILTER SCHEDULE FOR AIR PRESSURE DROP TO BE USED FOR TOTAL STATIC PRESSURE CALCULATIONS.
 5. CONTROLLER (E.G. VARIABLE FREQUENCY CONTROLLER, MOTOR STARTER) FOR SPECIFIED EQUIPMENT SHALL BE MANUFACTURED AND MARKED PER NEC WITH A MINIMUM SHORT CIRCUIT CURRENT RATING AS INDICATED.

KEYED NOTES:
 1. PROVIDE BUNNY CORD MAINTENANCE LED LIGHT 235" LONG, WITH MAGNETIC BASE AND FLEXIBLE CORD
 2. PROVIDE TWO BLANK OFF SHEETS FOR SUPPLY FAN

MODULAR AIR HANDLING UNIT DIMENSIONS							
UNIT IDENTIFICATION	MAXIMUM UNIT LENGTH	MAXIMUM UNIT WIDTH	MAXIMUM UNIT HEIGHT	MAXIMUM UNIT WEIGHT POUNDS	MANUFACTURER LEAD TIME	MANUFACTURER	KEYED NOTES
AHU-21H	310"	90"	58"	5504	---	DAIKIN	1
AHU-22H	166"	80"	52"	2877	---	DAIKIN	1

GENERAL NOTES:
 1. FOR REFERENCE ONLY

KEYED NOTES:
 1. AHU TO BE SHIPPED IN SECTIONS AND THEN BROKEN DOWN TO FIT THROUGH DOORWAYS. CONTRACTOR TO REASSEMBLE AHU IN ROOM UNDER DIRECTION FROM MANUFACTURER

MODULAR AIR HANDLING UNIT COMPONENT SCHEDULE										
UNIT IDENTIFICATION	POSITION NUMBER 1	POSITION NUMBER 2	POSITION NUMBER 3	POSITION NUMBER 4	POSITION NUMBER 5	POSITION NUMBER 6	POSITION NUMBER 7	POSITION NUMBER 8	POSITION NUMBER 9	KEYED NOTES
AHU-21H	PLENUM	ACCESS	RF-1	ECONOMIZER	AF-1	HC-1	CC-1	ACCESS	SF-1	1
AHU-22H	PLENUM	AF-2	HC-2	ACCESS	SF-2	---	---	---	---	1

GENERAL NOTES:
 1. MODULES SELECTED BASED ON DAIKIN INDOOR MODULAR CLIMATE CHANGER AIR HANDLING UNIT.
 2. POSITION NUMBERS ARE INDICATED IN THE DIRECTION OF AIRFLOW FROM RETURN AIR INLET TO SUPPLY AIR DISCHARGE.

KEYED NOTES:
 1. AHU TO BE SHIPPED IN SECTIONS AND THEN BROKEN DOWN TO FIT THROUGH EXISTING DOORWAYS. CONTRACTOR TO REASSEMBLE AHU IN ROOM UNDER DIRECTION FROM MANUFACTURER
 2. AHU IS PRE-PURCHASED AND ASSIGNED TO THE CONTRACTOR FOR DELIVERY AND INSTALLATION

AIR HANDLING UNIT FILTER SCHEDULE																
UNIT I.D.	SYSTEM SERVED	TYPE	AIRFLOW CFM	AIR PRESS. DROP			EFFICIENCY	FILTER MEDIA				HOUSING		MODEL NO.	KEYED NOTES	
				INITIAL IN. W.G.	DIRTY IN. W.G.	MERV		QUAN.	WIDTH IN.	DEPTH IN.	MIN. MEDIA FACE AREA SQ. FT.	ACCESS TYPE	WIDTH IN.			HEIGHT IN.
AF-1	AHU-21H	PLEATED	10,000	0.22	1.0	8	3/3	24/24	24/20	2	20	SIDE	18	48	CAH021GDGC	
AF-1	AHU-21H	VARICEL SH CARTRIDGE	10,000	0.53	1.5	13	3/3	24/24	24/20	12	20	SIDE	18	48	CAH021GDGC	
AF-2	AHU-22H	PLEATED	8700	0.08	1.0	8	3/6/3	24/20/12	24/24/24	2/2/2	12/20/6	SIDE	26	42	CAH018GDGM	


GENERAL NOTES:
 1. MODEL NUMBERS ARE FAIR UNLESS OTHERWISE NOTED.
 2. PROVIDE 25% TO 30% EFFICIENT 2 INCH THROW AWAY PREFILTERS
 3. MERV DESIGNATES THE "MINIMUM EFFICIENCY REPORTING VALUE" AS EVALUATED UNDER ASHRAE STANDARD 52.2 1999.
 4. AIR HANDLING UNIT TOTAL STATIC PRESSURE FOR VARIABLE AIR VOLUME SYSTEMS IS BASED ON THE FILTER DIRTY AIR PRESSURE DROP AND AVERAGE/MOLIFE FILTER AIR PRESSURE DROP FOR CONSTANT VOLUME SYSTEMS UNLESS NOTED OTHERWISE.

KEYED NOTES:
 1. PROVIDE THREE SETS OF EACH TYPE OF FILTER

AIR HANDLING UNIT SUPPLY AIR FAN SCHEDULE																				
UNIT IDENTIFICATION	SYSTEM SERVED	TYPE	AIRFLOW CFM	OUTSIDE AIR FLOW CFM	E.S.P. IN. W.G.	T.S.P. IN. W.G.	MINIMUM WHEEL DIAMETER INCHES	RPM	FAN CLASS	MOTOR				MODULATION/CONTROL TYPE	ELECTRICAL				MODEL NUMBER	KEYED NOTES
										BHP	HP	RPM	DRIVE TYPE		VOLTS	PHASE	SCCR KA (NOTE 5)	OPTIONS/ACCESSORIES		
SF-1	AHU-21H	CENTRIFUGAL	10,000	3000	2.0	4.89	24.5	1796	2	11.29	15.0	1750	DIRECT	VFD	460	3		CAH021GDGC		
SF-2	AHU-22H	CENTRIFUGAL	8700	8700	1.5	3.51	18.25	3650	2	7.9	10	3500	DIRECT	VFD	460	3				

GENERAL NOTES:
 1. REFER TO SCHEDULES GENERAL NOTES.
 2. MODEL NUMBERS ARE DAIKIN UNLESS OTHERWISE NOTED.
 3. DESIGN MINIMUM OUTSIDE AIRFLOW CFM (VENTILATION) LISTED IS BASED ON THE ESTIMATED MAXIMUM OCCUPANT LOAD. REFER TO TEMPERATURE CONTROL DRAWINGS FOR OUTSIDE AIR CONTROL SEQUENCE.
 4. REFER TO AIR HANDLING UNIT FILTER SCHEDULE FOR AIR PRESSURE DROP TO BE USED FOR TOTAL STATIC PRESSURE CALCULATIONS.
 5. CONTROLLER (E.G. VARIABLE FREQUENCY CONTROLLER, MOTOR STARTER) FOR SPECIFIED EQUIPMENT SHALL BE MANUFACTURED AND MARKED PER NEC WITH A MINIMUM SHORT CIRCUIT CURRENT RATING AS INDICATED.

KEYED NOTES:
 1. PROVIDE BUNNY CORD MAINTENANCE LED LIGHT 235" LONG, WITH MAGNETIC BASE AND FLEXIBLE CORD
 2. PROVIDE TWO BLANK OFF SHEETS FOR SUPPLY FAN

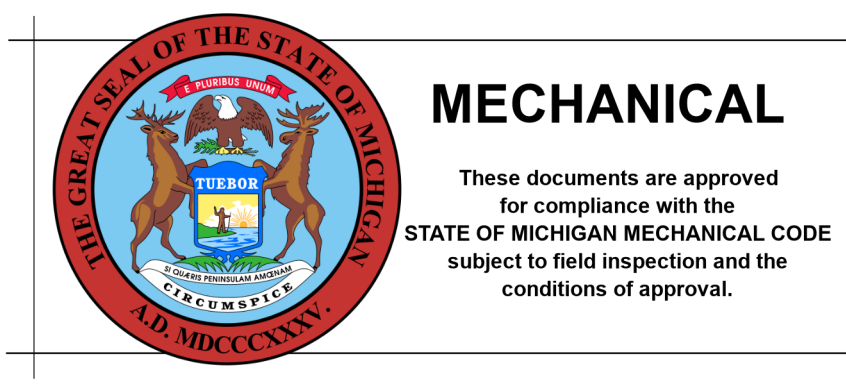

CHILLED WATER COOLING COIL SCHEDULE																			
UNIT IDENTIFICATION	SYSTEM SERVED	MAXIMUM NUMBER ROWS	MAXIMUM FIN DENSITY FINS/INCH	TOTAL CAPACITY MBH	AIR					MINIMUM FACE AREA SQ. FT.	WATER				CONTROL VALVE W.P.D. FT. HEAD	MODEL NUMBER	KEYED NOTES		
					AIRFLOW CFM	E.D.B. °F	E.W.B. °F	L.D.B. °F	L.W.B. °F		MAXIMUM A.P.D. IN. W.G.	FLOW GPM	FLUID TYPE	E.W.T. °F				L.W.T. °F	MAXIMUM W.P.D. FT. HEAD
CC-1	AHU-21H	6	9	388.6	10000	79.7	65.9	53.9	53.0	0.69	20.1	63.7	W	44.0	56.2	16.0	15	SWL0906B	#

GENERAL NOTES:
 1. MODEL NUMBERS ARE DAIKIN UNLESS OTHERWISE NOTED.
 2. COIL SELECTIONS BASED ON .00025 FOULING FACTOR.
 3. FLUID TYPE: W = WATER, PGXX = PROPYLENE GLYCOL SOLUTION XX PERCENTAGE OF GLYCOL, EGXX = ETHYLENE GLYCOL SOLUTION XX PERCENTAGE OF GLYCOL.

HOT WATER HEATING COIL SCHEDULE																	
UNIT IDENTIFICATION	SYSTEM SERVED	MAXIMUM NUMBER ROWS	MAXIMUM FIN DENSITY FINS/INCH	CAPACITY MBH	AIR					MINIMUM FACE AREA SQ. FT.	WATER				CONTROL VALVE W.P.D. FT. HD.	MODEL NUMBER	KEYED NOTES
					AIRFLOW CFM	E.D.B. °F	L.D.B. °F	MAXIMUM A.P.D. IN. W.G.	MINIMUM A.P.D. IN. W.G.		FLOW GPM	FLUID TYPE	E.W.T. °F	L.W.T. °F			
HC-1	AHU-21H	2	10	305.5	10000	43.0	70.9	0.30	15.1	19.7	PG35	130	99	2.00	15	5WH1002B	
HC-2	AHU-22H	2	10	804.5	8700	-10.0	82.0	0.33	16.0	42.2	PG35	130	94	8.6	15	5WH1002C	

GENERAL NOTES:
 1. MODEL NUMBERS ARE DAIKIN UNLESS OTHERWISE NOTED.
 2. COIL SELECTION BASED ON .00025 FOULING FACTOR.
 3. FLUID TYPE: W = WATER, PGXX = PROPYLENE GLYCOL SOLUTION XX PERCENTAGE OF GLYCOL, EGXX = ETHYLENE GLYCOL SOLUTION XX PERCENTAGE OF GLYCOL.

AIR TERMINAL TYPE											
DUCT CONNECTIONS		DISCHARGE SOUND POWER/RADIATED SOUND POWER - dB					DIMENSIONS		MODEL NUMBER	KEYED NOTES	
INLET SIZE INCHES	OUTLET SIZE INCHES	125 Hz	250 Hz	500 Hz	1000 Hz	2000 Hz	4000 Hz	LENGTH INCHES			HEIGHT INCHES
6e	12x8	73/66	69/63	62/52	56/42	53/40	49/36			ESV	1
8e	12x10	72/68	70/59	66/53	63/47	57/46	53/46			ESV	2
10e	14x12-1/2	78/71	70/61	65/56	61/50	58/47	53/45			ESV	3
12e	16x15	76/72	73/63	69/59	65/53	61/48	57/46			ESV	4
16e	24x18	78/70	73/63	70/58	68/53	64/52	59/50			ESV	5
24x16	38x18	83/74	81/69	76/63	74/54	73/48	68/41			ESV	6

GENERAL NOTES:
 1. MODEL NUMBERS ARE TITUS UNLESS OTHERWISE NOTED.
 2. MAXIMUM SOUND POWER LEVEL BASED ON 2" PRESSURE DROP ACROSS UNIT WITH NO ALLOWANCE FOR EXTERNAL ATTENUATION.

KEYED NOTES:
 1. BASED ON 350 CFM
 2. BASED ON 650 CFM
 3. BASED ON 900 CFM
 4. BASED ON 1500 CFM
 5. BASED ON 2500 CFM
 6. BASED ON 5300 CFM

AIR TERMINAL UNIT WITH HOT WATER COIL SCHEDULE																			
UNIT IDENTIFICATION	INLET SIZE	AREA SERVED	UNIT SERVED FROM	AIR FLOW				CAPACITY MBH	NUMBER ROWS	HEATING COIL (NOTE 3)				KEYED NOTES					
				COOLING MAX CFM	COOLING MIN. CFM	HEATING MIN. CFM	HEATING MAX CFM			MINIMUM A.P.D. W/COL IN. W.G.	AIR E.D.B. °F	AIR L.D.B. °F	FLOW GPM		FLUID TYPE	E.W.T. °F	L.W.T. °F	MAXIMUM W.P.D. FT. HEAD	CONTROL VALVE W.P.D. FT. HEAD
VBR-H108	6	H132,H119, H133	AHU-21H	260	80	80	260	0.11	5.0	2	55.0	90.0	0.5	PG35	130	100	0.29	15	3-WAY
VBR-H109	12	DINING H131	AHU-21H	1080	325	325	1080	0.16	20.6	2	55.0	90.0	1.2	PG35	130	100	1.41	15	3-WAY
VBR-H110	12	DINING H131	AHU-21H	1080	325	325	1080	0.16	20.6	2	55.0	90.0	1.2	PG35	130	100	1.41	15	3-WAY
VBR-H111	12	DINING H131/SERVERY H130	AHU-21H	1280	325	325	1280	0.22	24.4	2	55.0	90.0	1.5	PG35	130	100	2.77	15	3-WAY
VBR-H112	12	DINING H131/SERVERY H130	AHU-21H	1280	325	325	1280	0.22	24.4	2	55.0	90.0	1.5	PG35	130	100	2.77	15	3-WAY
VBR-H113	12	KITCHEN H123	AHU-21H	1260	325	325	1260	0.21	24.0	2	55.0	90.0	1.4	PG35	130	100	2.63	15	3-WAY
VBR-H114	12	KITCHEN H123	AHU-21H	1375	325	325	1375	0.22	24.3	2	55.0	90.0	1.5	PG35	130	100	2.74	15	3-WAY
VBR-H115	6	BREAK ROOM H127	AHU-21H	205	80	80	205	0.08	4.0	2	55.0	90.0	0.5	PG35	130	100	0.11	15	3-WAY
VBR-H116	12	KITCHEN H123	AHU-21H	1330	325	325	1330	0.30	25.3	2	55.0	90.0	1.5	PG35	130	100	1.78	15	3-WAY
VBR-H117	6	OFFICE H125	AHU-21H	200	80	80	200	0.07	3.9	2	55.0	90.0	0.5	PG35	130	100	0.10	15	3-WAY
VBR-H118	8	CORRIDOR H122	AHU-21H	600	145	145	600	0.34	11.5	2	55.0	90.0	0.7	PG35	130	100	4.95	15	3-WAY
VBR-H119	6	STORAGE H124	AHU-21H	150	80	80	150	0.03	3.1	1	55.0	90.0	0.5	PG35	130	100	0.05	15	3-WAY

GENERAL NOTES:
 1. MODEL NUMBERS ARE TITUS UNLESS OTHERWISE NOTED.
 2. MAXIMUM PRESSURE DROP SCHEDULED SHALL BE THE MAXIMUM ALLOWABLE STATIC PRESSURE FOR BOX AND COIL AT THE MAXIMUM CFM.
 3. HEATING COIL SELECTION BASED ON HEATING MAXIMUM AIR FLOW.
 4. FLUID TYPE: W = WATER, PGXX = PROPYLENE GLYCOL SOLUTION XX PERCENTAGE OF GLYCOL, EGXX = ETHYLENE GLYCOL SOLUTION XX PERCENTAGE OF GLYCOL.

KITCHEN EXHAUST DUCT REQUIREMENT SCHEDULE							
EXHAUST SYSTEM	MINIMUM DESIGN PRESSURE	MINIMUM DESIGN TEMPERATURE (DEG. F)	WORKING PRESSURE	TEST PRESSURE	TEST LIGHT TEST	TEST TIME	ALLOWABLE LEAKAGE
GREASE DUCT	20 PSIG	>200	-5" PSIG	20 PSIG	TEST ALL JOINTS PER NFPA 96	2 HOURS	NONE

NOTES:
 1. CONTRACTOR TO TEST ALL JOINT PER NFPA 96
 2. CAP END OF GREASE DUCTS AND TEST WITH COMPRESSED AIR, REDD JOIST THAT DO NOT PASS, HOLD TEST FOR MINIMUM 2 HOURS

PUMP SCHEDULE																				
UNIT IDENTIFICATION	SYSTEM SERVED	LOCATION	TYPE	COUPLING TYPE	WATERFLOW GPM	FLUID TYPE	COLDEST SYSTEM OPERATING TEMP. °F FOR PUMP SELECTION	PUMP HEAD FT.	OVERLOAD GPM	MINIMUM EFFICIENCY %	MOTOR			MODULATION/CONTROL TYPE	ELECTRICAL				MODEL NUMBER	KEYED NOTES
											BHP	HP	RPM		VOLTS	PHASE	SCCR KA (NOTE 4)	OPTIONS/ACCESSORIES		
P-54	HWH	PENTHOUSE	IN-LINE	CLOSE	140	PG35	70 °F	69	NON-OVERLOADING	77.4	3.97	5	3600	AUTO	480	3	5	---	E-90-2AAC	
P-55	HWH	PENTHOUSE	IN-LINE	CLOSE	140	PG35	70 °F	69	NON-OVERLOADING	77.4	3.97	5	3600	AUTO	480	3	5	---	E-90-2AAC	

GENERAL NOTES:
 1. REFER TO SCHEDULES GENERAL NOTES.
 2. MODEL NUMBER ARE BELL & GOSSETT UNLESS OTHERWISE NOTED.
 3. FLUID TYPE: W = WATER, PGXX = PROPYLENE GLYCOL SOLUTION XX PERCENTAGE OF GLYCOL, EGXX = ETHYLENE GLYCOL SOLUTION XX PERCENTAGE OF GLYCOL.
 4. CONTROLLER (E.G. VARIABLE FREQUENCY CONTROLLER, MOTOR STARTER) FOR SPECIFIED EQUIPMENT SHALL BE MANUFACTURED AND MARKED PER NEC WITH A MINIMUM SHORT CIRCUIT CURRENT RATING AS INDICATED.

KEYED NOTES:
 1. PUMPS SIZED FOR CURRENT CONNECTED LOAD, PIPING SIZE FOR WEST BUILDING FUTURE CONNECTED LOAD


2	BULLETIN #1	01/19/2024
1	STATE REVIEW SET	12/20/23
NO.	REVISION	DATE



FILE NO.
491/20167.SDW

FUNDING CODE
171CODHHS7255

CONTRACT NO.
Y22003

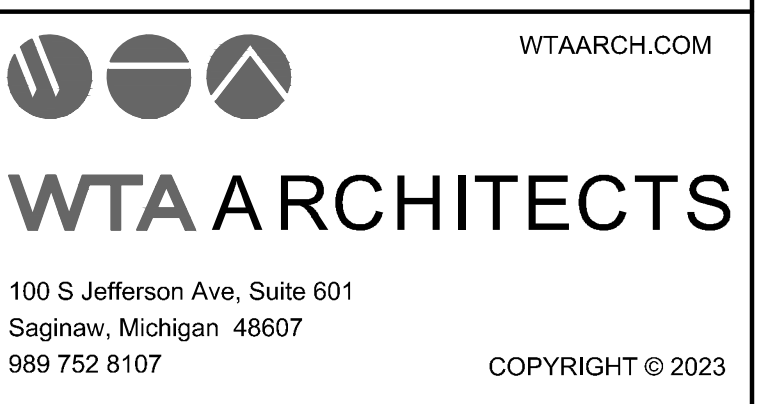

PROJECT TITLE
491/20167.SDW - PHASE 500:
CENTER FOR FORENSIC PSYCHIATRY - CREATE KITCHEN
SALINE, MICHIGAN

SHEET TITLE
MECHANICAL SCHEDULES

PROJECT NUMBER 2021094	SHEET NUMBER
PROJECT DATE AUGUST 23, 2023	M7.03
CHECKED BY WEK	



g:\2021\2021-0402-00\CA01\2021-0402-M7-SH3.dwg, M-703, 3/19/2024, 3:00:23 PM, Thomas B. Cramonte, Peter Basso Associates Inc.

Department of Licensing and Regulatory Affairs

1st Floor Ottawa Building
611 W. Ottawa Street
Lansing, MI 48933



Final Report - Approved

Application Number: PR2023BCC-002591

Report Date: 03/29/2024

Description : New one-story with a penthouse addition to existing structure for commercial kitchen and dining space. Addition totals 11,124 square feet and includes plumbing, HVAC, electrical, food service equipment, communications and IT, and associated site work for new construction.

Address : 8303 PLATT RD, SALINE, MI, 48176

Record Type : Bureau of Construction Codes Plan Review Application

Document Filename : M7.04 MECHANICAL SCHEDULES.pdf

Reviewer Contact Information:

Reviewer Name	Reviewer Email	Reviewer Phone
Daniel Morris	MorrisD9@michigan.gov	517-927-9734

General Comments

Markups for this Approved Document or Plan

POWER VENTILATOR SCHEDULE																																				
UNIT IDENTIFICATION	SYSTEM SERVED	TYPE	AIRFLOW CFM	T.S.P. IN. W.G.	TIP SPEED FPM	FAN RPM	MOTOR				CURB HEIGHT INCHES	MODULATION/CONTROL TYPE	MAXIMUM SOUND POWER LEVELS												MODEL NUMBER	KEYED NOTES										
							BHP	HP	RPM	DRIVE TYPE			UNIT DISCHARGE Lw BY OCTAVE BAND						UNIT INLET Lw BY OCTAVE BAND																	
													VOLTS	PHASE	SCCR KA	OPTIONS/ACCESSORIES	63 HZ (DB)	125 HZ (DB)	250 HZ (DB)	500 HZ (DB)	1000 HZ (DB)	2000 HZ (DB)	4000 HZ (DB)	8000 HZ (DB)			63 HZ (DB)	125 HZ (DB)	250 HZ (DB)	500 HZ (DB)	1000 HZ (DB)	2000 HZ (DB)	4000 HZ (DB)	8000 HZ (DB)		
EF-6H	TOILET H126	CENTRIFUGAL	100	0.25	3161	1486	0.01	1/10	1725	DIRECT	18	AUTO	120	1	5	B	---	---	---	---	---	---	---	---	---	---	57	61	58	48	47	48	39	32	G-060-VG	
EF-7H	CHEMICAL STORAGE H129	CENTRIFUGAL	200	0.5	3669	1725	0.03	1/15	1725	DIRECT	18	AUTO	120	1	5	B	---	---	---	---	---	---	---	---	---	---	68	71	69	54	49	47	43	38	G-070-VG	
EF-8H	DISHWASHER HOOD	CENTRIFUGAL	200	0.5	3669	1725	0.03	1/15	1725	DIRECT	18	AUTO	120	1	5	B	---	---	---	---	---	---	---	---	---	---	68	71	69	54	49	47	43	38	G-070-VG	
EF-9H	KITCHEN HOOD	CENTRIFUGAL	3600	1.0	6693	1538	1.39	2	1725	DIRECT	18	AUTO	208	1	5	B	---	---	---	---	---	---	---	---	---	---	78	85	86	84	78	74	71	68	CUE-160-VG	
EF-10H	KITCHEN HOOD	CENTRIFUGAL	5100	1.5	7299	1304	2.53	3	1360	DIRECT	18	AUTO	208	3	5	B	---	---	---	---	---	---	---	---	---	---	93	81	88	74	70	69	67	62	CUE-200-VG	

GENERAL NOTES:
1. REFER TO SCHEDULES GENERAL NOTES.
2. MODEL NUMBERS ARE GREENHECK UNLESS OTHERWISE NOTED.

STEAM HUMIDIFIER SCHEDULE											
UNIT IDENTIFICATION	SYSTEM SERVED	AHU DISTRIBUTION TUBE BANK							MODULATION/CONTROL TYPE	REMARKS	
		QUANTITY REQUIRED	TYPE	MODEL LES/HR	AHU AIR TEMPERATURE °F	AHU WIDTH INCHES	AHU HEIGHT INCHES	MAXIMUM ABSORPTION DISTANCE INCHES			MODEL
H-1	AHU-21H	1	INSULATED MULTIPLE TUBES	62.8	88.9	78	48	26"	DRISTEEM	AUTO	

NOTE:
1. REFER TO SCHEDULES GENERAL NOTES.
2. MODEL NUMBERS ARE DRISTEEM UNLESS OTHERWISE NOTED.
3. PROVIDE STEAM DISTRIBUTION ASSEMBLY TO AHU MANUFACTURE FOR MOUNTING IN AHU HUMIDIFIER SECTION.

GAS FIRED CONDENSING BOILER SCHEDULE																				
UNIT IDENTIFICATION	TURNDOWN	FUEL TYPE	MAXIMUM ALLOWABLE OUTPUT AT MINIMUM FIRING RATE (MBH)	AGA INPUT MBH	AGA OUTPUT MBH	MINIMUM EFFICIENCY (%)	DIMENSIONS			WATER		UNIT CONTROL TYPE	ELECTRICAL				MODEL NUMBER	KEYED NOTES		
							DEPTH (IN.)	WIDTH (IN.)	HEIGHT (IN.)	E.W.T. °F	L.W.T. °F		FLOW GPM	MAXIMUM W.P.D. FT. HD.	VOLTS	PHASE			FLA	OPTIONS/ACCESSORIES
B-11	20:1	NAT GAS	100	2000	1800	90	43.6	28	78	90	130	140	7	AUTO	120	1	16	B	BMK2000	
B-12	20:1	NAT GAS	100	2000	1800	90	43.6	28	78	90	130	140	7	AUTO	120	1	16	B	BMK2000	

GENERAL NOTES:
1. REFER TO SCHEDULES GENERAL NOTES.
2. MODEL NUMBERS ARE AERCO UNLESS OTHERWISE NOTED.
3. PROVIDE BOILER WITH CONDENSATE NEUTRALIZATION TANK ASSEMBLY.
4. MINIMUM PRESSURE RATING OF 125 PSIG.

GRILLE, REGISTER, AND DIFFUSER SCHEDULE									
UNIT IDENTIFICATION	TYPE	FACE SIZE	NECK SIZE	FRAME TYPE	ACCESSORY	CONSTRUCTION	FINISH	MODEL NUMBER	KEYED NOTES
S-1	DIFFUSER	24x24	SEE PLANS	LAY-IN	NONE	STEEL	WHITE	500	
R-1	GRILLE	24x24	SEE PLANS	LAY-IN	NONE	ALUMINUM	WHITE	80	
R-2	GRILLE	24x12	SEE PLANS	LAY-IN	NONE	ALUMINUM	WHITE	80	
E-1	GRILLE	12x12	SEE PLAN	LAY-IN	NONE	ALUMINUM	WHITE	80	
E-2	GRILLE	24x24	SEE PLAN	LAY-IN	NONE	ALUMINUM	WHITE	80	
L-1	LOUVER	72x78	SEE PLAN	FLANGED	NONE	ALUMINUM	MILL	ESD-635	1
L-2	LOUVER	66x78	SEE PLAN	FLANGED	NONE	ALUMINUM	MILL	ESD-635	1

GENERAL NOTES:
1. MODEL NUMBERS ARE PRICE UNLESS OTHERWISE NOTED.

KEYED NOTES:
1. MODEL NUMBERS ARE GREENHECK.

HOT WATER CABINET UNIT HEATER SCHEDULE																									
UNIT IDENTIFICATION	CAPACITY MBH	AIR			FAN		WATER			CONTROL VALVE W.P.D. FT. HEAD	DIMENSIONS			RECESS DEPTH INCHES	FILTER TYPE	AREA SQ. FT.	MODULATION/CONTROL TYPE	ELECTRICAL				MODEL NUMBER	KEYED NOTES		
		AREFLOW CFM	E.D.B. °F	L.D.B. °F	HP	RPM	FLOW GPM	FLUID TYPE	E.W.T. °F		L.W.T. °F	MAXIMUM W.P.D. FT. HEAD	LENGTH INCHES					HEIGHT INCHES	DEPTH INCHES	VOLTS	PHASE			SCCR KA	OPTIONS/ACCESSORIES
CUH-3H	19.0	860	60	80.4	1/10	1050	2.8	PG35	130	100	1.5	15	61	44	9.5	9	WASHABLE	3.5	AUTO	120	1	5	B	RC-1200-08	
CUH-4H	19.0	860	60	80.4	1/10	1050	2.8	PG35	130	100	1.5	15	61	44	9.5	9	WASHABLE	3.5	AUTO	120	1	5	B	RC-1200-08	
CUH-5H	30.4	1040	60	86.9	1/10	1050	4.4	PG35	130	100	1.5	15	66	49	9.5	9	WASHABLE	3.5	AUTO	120	1	5	B	RC-1200-10	1
CUH-6H	28.2	845	60	90.8	1/10	1050	4.1	PG35	130	100	1.5	15	61	44	9.5	0	WASHABLE	3.5	AUTO	120	1	5	B	W-1110-08	1

GENERAL NOTES:
1. REFER TO SCHEDULES GENERAL NOTES.
2. MODEL NUMBERS ARE STERLING UNLESS OTHERWISE NOTED.
3. FLUID TYPE: W = WATER, PGXX = PROPYLENE GLYCOL SOLUTION XX PERCENTAGE OF GLYCOL, EGXX = ETHYLENE GLYCOL SOLUTION XX PERCENTAGE OF GLYCOL.

KEYED NOTES:
1. HIGH CAPACITY COIL

HOT WATER PROPELLER FAN UNIT HEATER SCHEDULE																		
UNIT IDENTIFICATION	CAPACITY MBH	AIRFLOW CFM	LEAVING AIR TEMPERATURE °F	FAN		WATER			CONTROL VALVE W.P.D. FT. HEAD	MODULATION/CONTROL TYPE	ELECTRICAL				MODEL NUMBER	KEYED NOTES		
				HP	RPM	FLOW GPM	FLUID TYPE	E.W.T. °F			L.W.T. °F	MAXIMUM W.P.D. FT. HEAD	VOLTS	PHASE			SCCR KA	OPTIONS/ACCESSORIES
UH-8H	12.7	750	104	1/20	1000	1.8	PG35	130	100	0.12	15	AUTO	120	1	---	B	HS-48	
UH-9H	53.0	1800	103	1/12	1000	3.9	PG35	130	100	0.36	15	AUTO	120	1	---	B	HS-108	
UH-10H	53.0	1800	103	1/12	1000	3.9	PG35	130	100	0.36	15	AUTO	120	1	---	B	HS-108	
UH-11H	12.7	750	104	1/20	1000	1.8	PG35	130	100	0.12	15	AUTO	120	1	---	B	HS-48	

GENERAL NOTES:
1. REFER TO SCHEDULES GENERAL NOTES.
2. MODEL NUMBERS ARE STERLING UNLESS OTHERWISE NOTED.
3. FLUID TYPE: W = WATER, PGXX = PROPYLENE GLYCOL SOLUTION XX PERCENTAGE OF GLYCOL, EGXX = ETHYLENE GLYCOL SOLUTION XX PERCENTAGE OF GLYCOL.

EXPANSION TANK SCHEDULE													
UNIT IDENTIFICATION	SYSTEM SERVED	ESTIMATED TOTAL SYSTEM VOLUME GALLON	TYPE	OPERATING PRESSURE		OPERATING TEMPERATURE		TANK VOLUME GALLON	ACCEPTANCE VOLUME GALLON	DIMENSIONS		MODEL NUMBER	REMARKS
				MINIMUM PSIG	MAXIMUM PSIG	MINIMUM °F	MAXIMUM °F			DIAMETER INCHES	HEIGHT INCHES		
ET-1	HWHS	200	BLADDER	16	35	40	140	10	7.43	12	24	B35	

NOTE:
1. MODEL NUMBERS ARE BELL & GOSSETT UNLESS OTHERWISE NOTED.
2. COLD FILL PRESSURE = 12PSI

GLYCOL MAKEUP UNIT SCHEDULE							
UNIT IDENTIFICATION	FLUID TYPE	TANK VOLUME GAL.	FILL PRESSURE PSI	ELECTRICAL		MODEL NUMBER	KEYED NOTES
				VOLTS	PHASE		
GMU-1	PG35	18	15	115	1	GMP SERIES GMP-18	

GENERAL NOTES:
1. MODEL NUMBERS ARE WESSELS UNLESS OTHERWISE NOTED.
2. FLUID TYPE: W = WATER, PGXX = PROPYLENE GLYCOL SOLUTION XX PERCENTAGE OF GLYCOL, EGXX = ETHYLENE GLYCOL SOLUTION XX PERCENTAGE OF GLYCOL.

AIR & DIRT SEPARATOR SCHEDULE					
INLET/OUTLET PIPE SIZE (INCHES)	MAX SYSTEM FLOW (GPM)	MAX PRESSURE DROP CLEAN (FT. HD)	OPERATING WEIGHT (LBS)	TYPE	MODEL NUMBER
2	35	0.70	66	STANDARD VELOCITY / AIR & DIRT	VDT 200 FA
2 1/2	57	0.75	75	STANDARD VELOCITY / AIR & DIRT	VDT 250 FA
3	100	5.0	178	HIGH VELOCITY / AIR & DIRT	VHT 300 FA
4	220	6.0	186	HIGH VELOCITY / AIR & DIRT	VHT 400 FA
6	650	8.0	336	HIGH VELOCITY / AIR & DIRT	VHT 600 FA
8	1400	9.0	590	HIGH VELOCITY / AIR & DIRT	VHT 800 FA
10	2400	10.0	986	HIGH VELOCITY / AIR & DIRT	VHT 1000 FA
12	3500	12.0	1518	HIGH VELOCITY / AIR & DIRT	VHT 1200 FA

NOTE:
1. MODEL NUMBERS ARE SPIROTECH UNLESS OTHERWISE NOTED.
2. SEPARATOR FLANGE CONNECTION MUST BE A MINIMUM OF THE PIPE DIAMETER SIZE OF WHICH THE SEPARATOR IS INSTALLED.

HOT WATER FINNED TUBE RADIATION SCHEDULE															
UNIT IDENTIFICATION	CAPACITY BTUH/ LINEAR FT.	ENTERING AIR TEMP °F	FLUID TYPE	WATER TEMP.		ENCLOSURE		ELEMENT				CONTROL VALVE W.P.D. FT. HEAD	MODEL NUMBER	KEYED NOTES	
				E.W.T. °F	AVERAGE °F	TYPE	LENGTH INCHES	HEIGHT INCHES	TUBE DIAMETER INCHES	WIDTH INCHES	HEIGHT INCHES				NUMBER OF TIERS
FTR-1	300	65	W	130	110	SLOPE TOP (JWB-S-LT)	SEE PLAN	14	0.75	4.25	3.63	1	15	C3/4-433-148	


GENERAL NOTES:
1. MODEL NUMBERS ARE STERLING UNLESS OTHERWISE NOTED.
2. FLUID TYPE: W = WATER, PGXX = PROPYLENE GLYCOL SOLUTION XX PERCENTAGE OF GLYCOL, EGXX = ETHYLENE GLYCOL SOLUTION XX PERCENTAGE OF GLYCOL.

HOT WATER RADIANT CEILING PANEL SCHEDULE											
UNIT IDENTIFICATION	CAPACITY BTUH/ LINEAR FT.	FLUID TYPE	WATER TEMP.		DIMENSIONS		FINISH	CONSTRUCTION	CONTROL VALVE W.P.D. FT. HEAD	MODEL NUMBER	KEYED NOTES
			E.W.T. °F	L.W.T. °F	LENGTH INCHES	WIDTH INCHES					
RCP-1	142	PG35	130	100	SEE PLANS	12	WHITE	STEEL	15	RC-4	

GENERAL NOTES:
1. MODEL NUMBERS ARE RUNTAL UNLESS OTHERWISE NOTED.
2. EXTENDED ARCHITECTURAL SPACE MASTERY SERIES HEF-2 FLUTED.
3. FLUID TYPE: W = WATER, PGXX = PROPYLENE GLYCOL SOLUTION XX PERCENTAGE OF GLYCOL, EGXX = ETHYLENE GLYCOL SOLUTION XX PERCENTAGE OF GLYCOL.

VARIABLE FREQUENCY CONTROLLER SCHEDULE					
UNIT IDENTIFICATION	SYSTEM SERVED	LOCATION	RATED HORSEPOWER	OPERATING HORSEPOWER	REMARKS
VFC-AHU-21H-SF	SF-1	SEE DRAWINGS	15	11.3	PRIMARY
VFC-AHU-21H-RF	RF-1	SEE DRAWINGS	7.5	5.1	PRIMARY
VFC-AHU-22H-SF	SF-2	SEE DRAWINGS	10	7.9	PRIMARY
VFC-EF-9H	EF-9H	SEE DRAWINGS	2	1.4	PRIMARY
VFC-EF-10H	EF-10H	SEE DRAWINGS	3	2.5	BACKUP

NOTE:
1. REFER TO SPECIFICATIONS FOR APPROVED MANUFACTURERS.
2. REFER TO ELECTRICAL WIRING DIAGRAM FOR CONNECTION REQUIREMENTS.

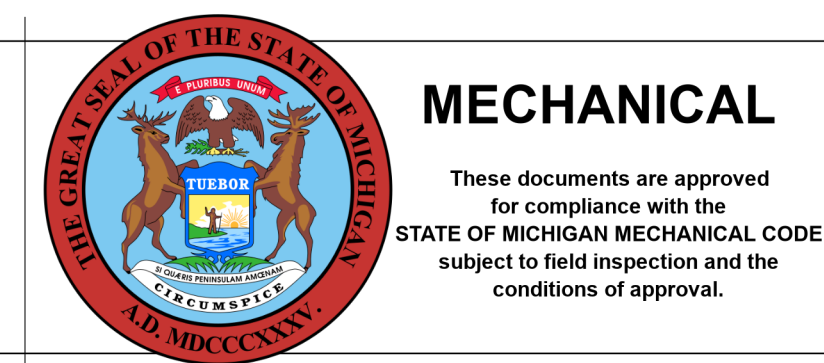

1	STADDER/REVISION#	09/20/23
NO.	REVISION	DATE

STATE OF MICHIGAN
DEPARTMENT OF TECHNOLOGY, MANAGEMENT AND BUDGET
FACILITIES AND BUSINESS SERVICES ADMINISTRATION
DESIGN AND CONSTRUCTION DIVISION
ADAM LACH, RA, DIRECTOR

FILE NO.
491/20167.SDW

FUNDING CODE
171CODHHS7255

CONTRACT NO.
Y22003

WTAARCH.COM
WTA ARCHITECTS
100 S. Jefferson Ave, Suite 601
Saginaw, Michigan 48607
989 752 8107
COPYRIGHT © 2023

PROJECT TITLE
491/20167.SDW - PHASE 500:
**CENTER FOR FORENSIC
PSYCHIATRY - CREATE
KITCHEN**
SALINE, MICHIGAN

SHEET TITLE
MECHANICAL SCHEDULES

PROJECT NUMBER
2021094

SHEET NUMBER
M7.04

PROJECT DATE
AUGUST 23, 2023

CHECKED BY
WEK

Peter Basso Associates Inc.
CONSULTING ENGINEERS
5145 Livernois, Suite 100
Troy, Michigan 48068-3276
Tel: 248-879-5666
Fax: 248-879-0007
www.PeterBassoAssociates.com
PBA Project No. 2021094

Department of Licensing and Regulatory Affairs

1st Floor Ottawa Building
611 W. Ottawa Street
Lansing, MI 48933



Final Report - Approved

Application Number: PR2023BCC-002591

Report Date: 03/29/2024

Description : New one-story with a penthouse addition to existing structure for commercial kitchen and dining space. Addition totals 11,124 square feet and includes plumbing, HVAC, electrical, food service equipment, communications and IT, and associated site work for new construction.

Address : 8303 PLATT RD, SALINE, MI, 48176

Record Type : Bureau of Construction Codes Plan Review Application


Document Filename : M8.03 TEMPERATURE CONTROLS.pdf

Reviewer Contact Information:


Reviewer Name	Reviewer Email	Reviewer Phone
Daniel Morris	MorrisD9@michigan.gov	517-927-9734

General Comments


Markups for this Approved Document or Plan

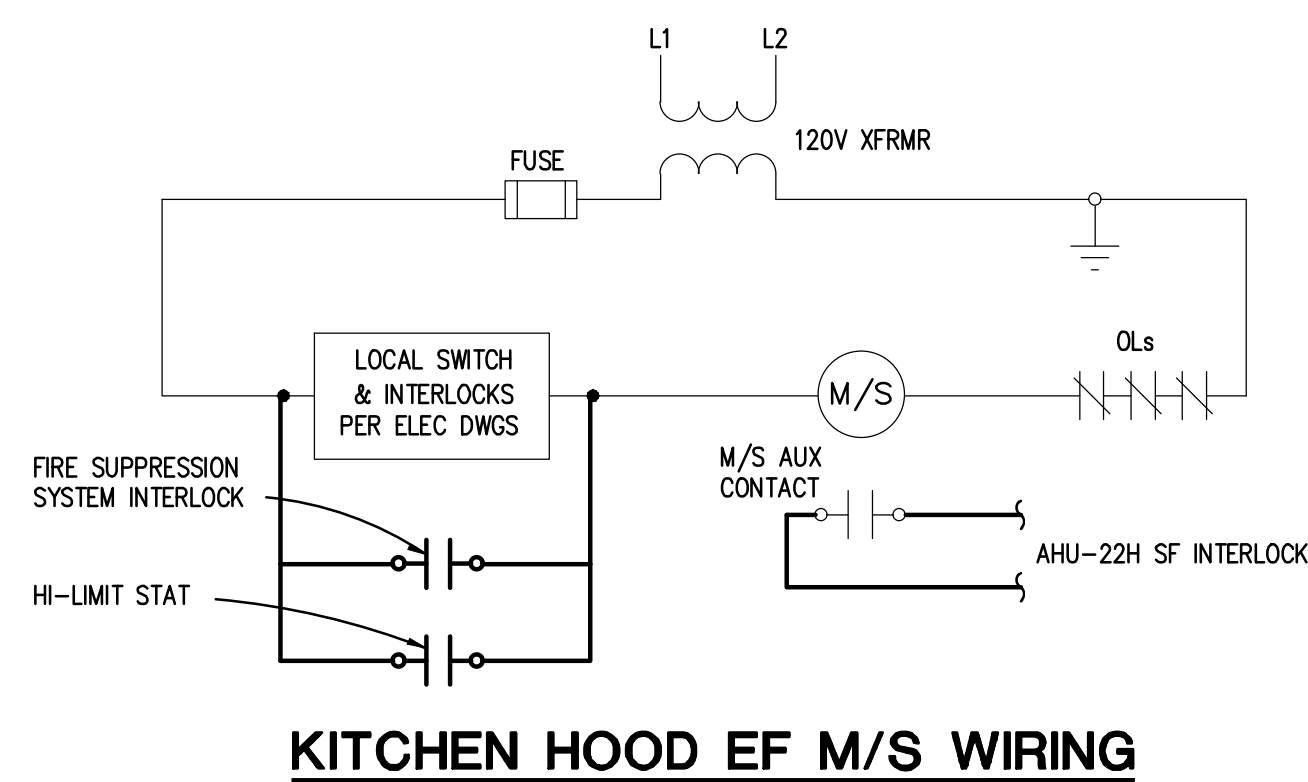

KITCHEN HOOD EF M/S WIRING

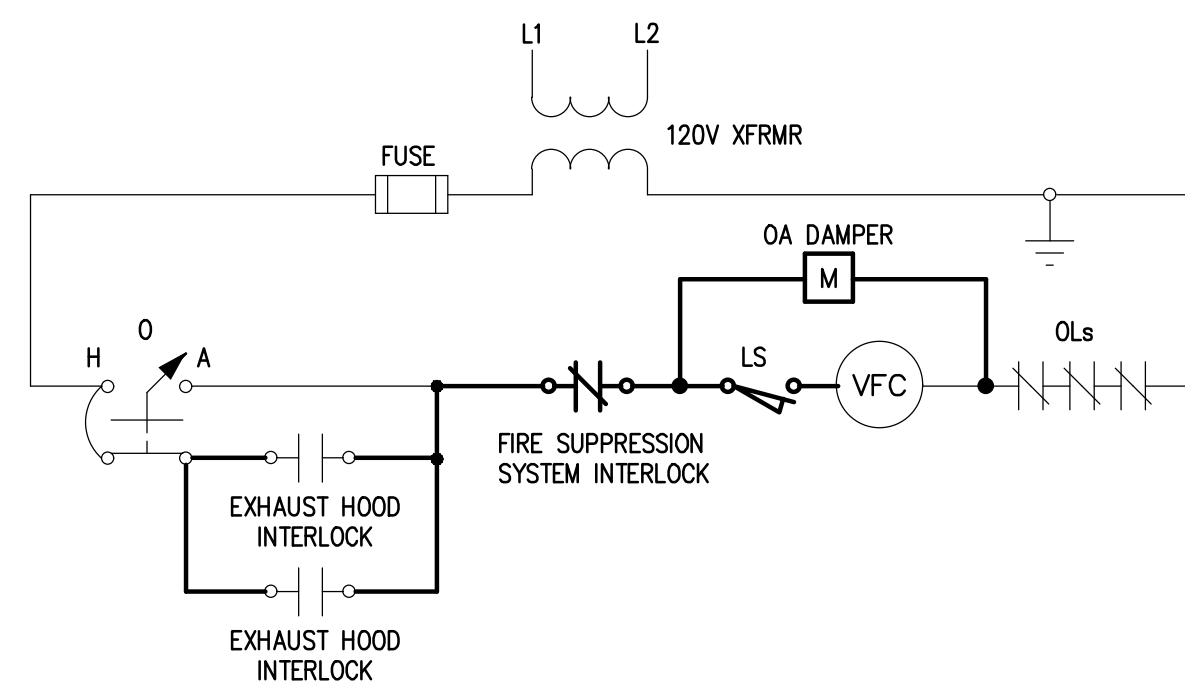


AHU-22H SF M/S WIRING

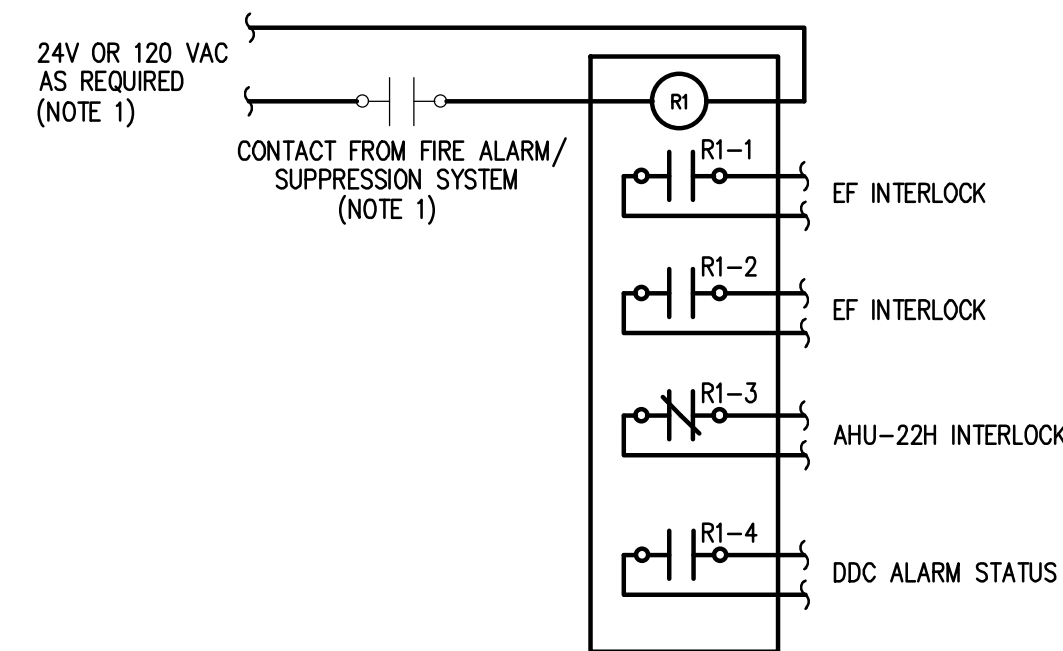

KEF'S AND AHU-22H CONTROL


- NOTE:
- FIRE SUPPRESSION SYSTEM IS NEW. COORDINATE VOLTAGE REQUIREMENTS, WIRING, ETC. WITH FIRE SUPPRESSION SYSTEM MANUFACTURER.

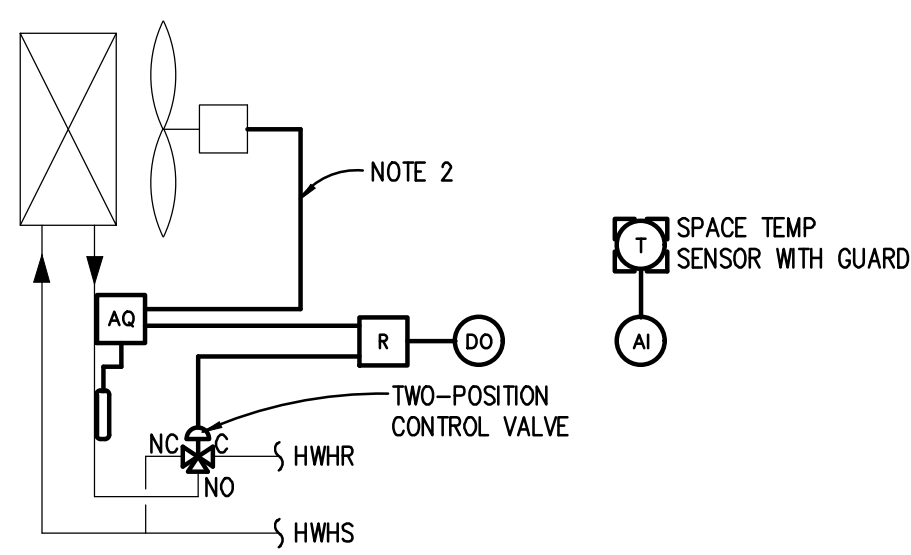

HWH UH & CUH CONTROL - NEW WORK


- NOTES:
- REFER TO FLOOR PLANS FOR QUANTITY AND LOCATION OF UNITS.
 - AQUASTAT SHALL BE WIRED IN SERIES WITH FAN CONTROL WIRING CIRCUIT.

SEQUENCE OF OPERATION:
 DDC SHALL ENABLE/DISABLE FAN CIRCUIT AND OPEN/CLOSE HEATING VALVE AS REQUIRED TO MAINTAIN SPACE TEMP SETPOINT OF 68°F DURING BLDG OCCUPANCY AND 55°F DURING BLDG UNOCCUPANCY. FAN SHALL ACTIVATE UPON PROOF OF HWHR FLOW BY AQ.

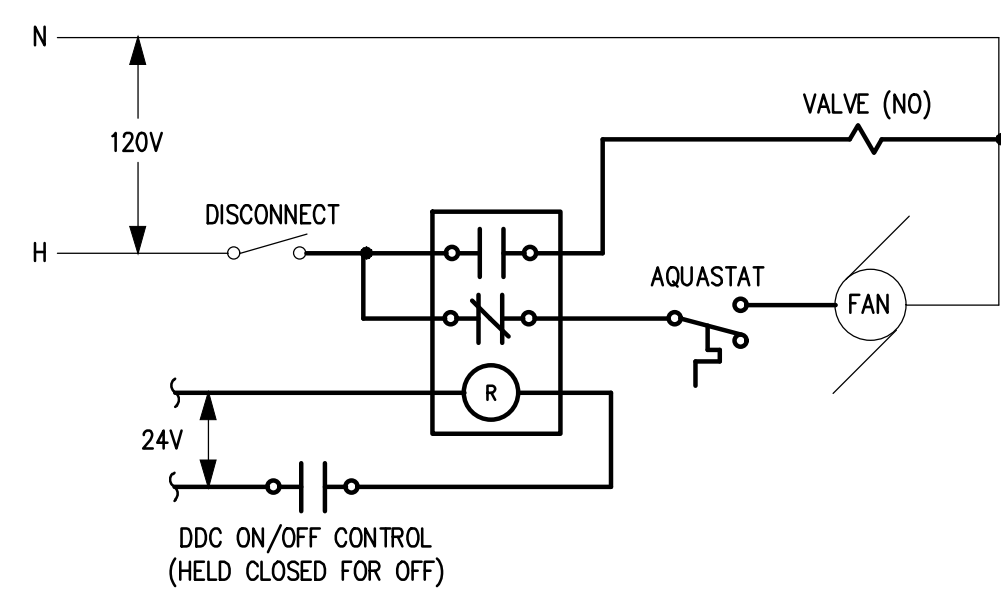

HWH UH & CUH WIRING

TYPICAL

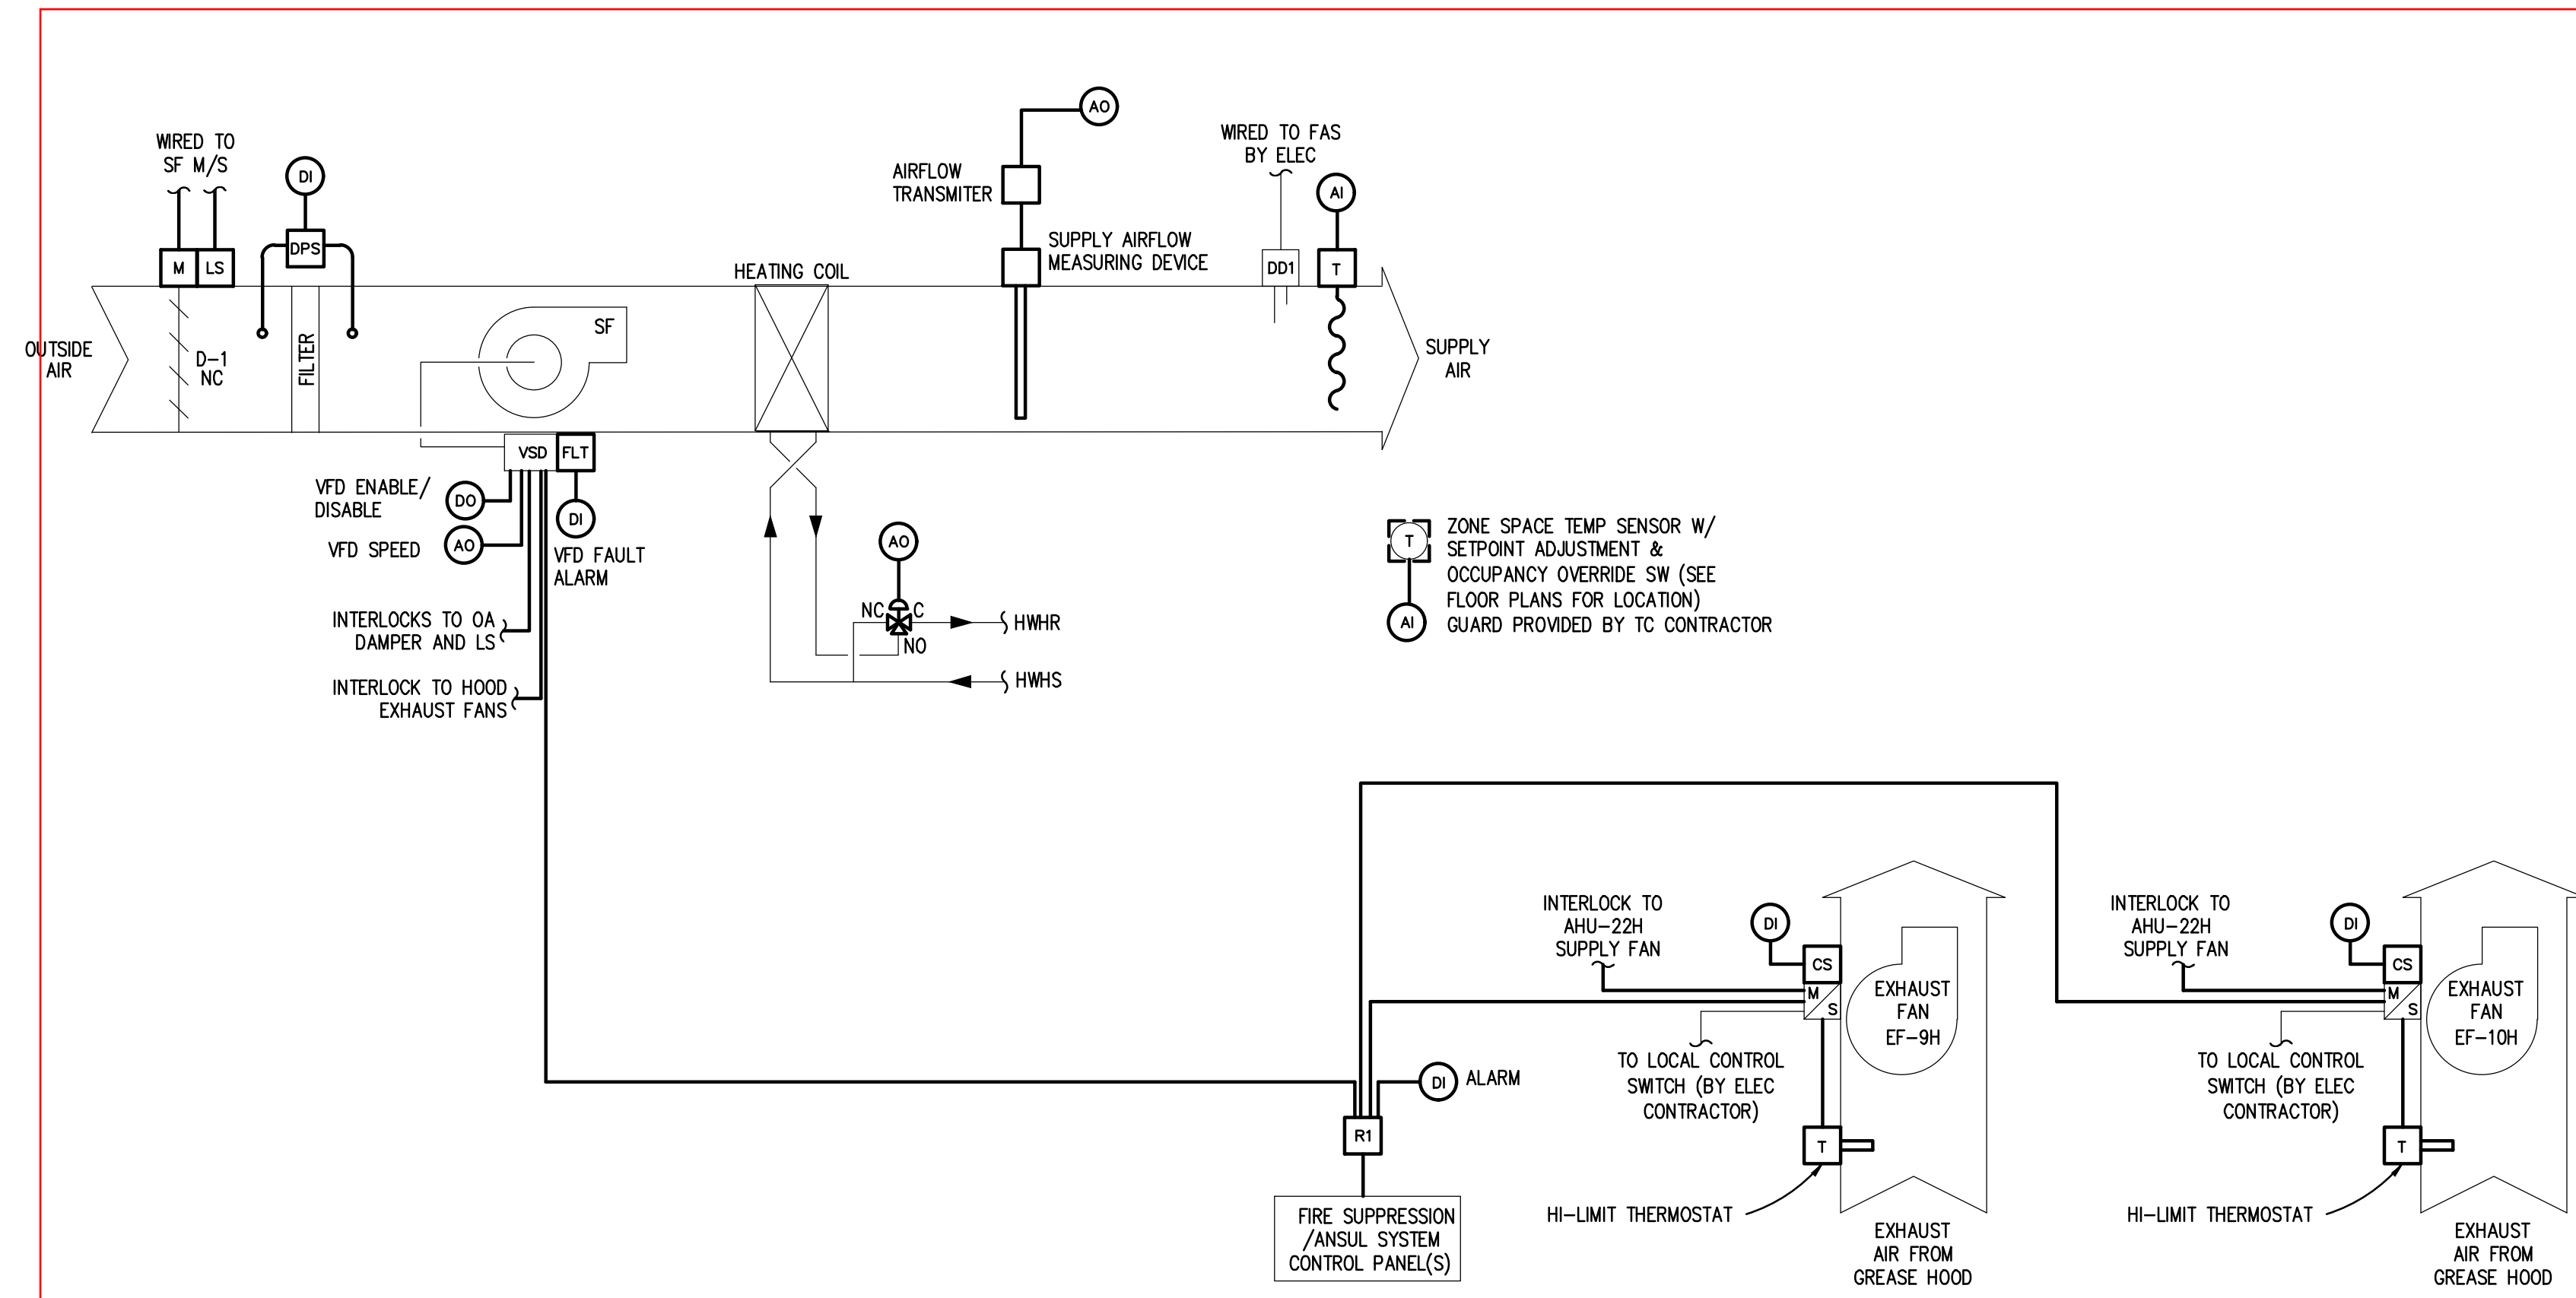

KITCHEN EXHAUST HOODS (EF-9H & EF-10H) AND MAKE-UP AIR UNIT (AHU-22H) CONTROL


- NOTES:
- COORDINATE WIRING WITH EQUIPMENT SUPPLIERS.

SEQUENCE OF OPERATION

- KITCHEN EXHAUST HOOD AND MAKE-UP AIR UNIT CONTROL:
- AHU-22H/EF-9H/EF-10H SHALL BE CAPABLE OF BEING CONTROLLED INDIVIDUALLY.
 - EF-9H AND EF-10H SHALL BE STARTED AND STOPPED MANUALLY BY ITS ON/OFF SWITCH LOCATED NEAR THE KITCHEN EXHAUST HOOD.
 - WITH THE SUPPLY FAN VFC HAND/OFF/AUTO SWITCH AND EXHAUST MOTOR STARTER HAND/OFF/AUTO SWITCH(S) IN THE "AUTO" POSITION, THE SUPPLY FAN SHALL BE INTERLOCKED WITH THE KITCHEN HOOD EXHAUST FANS. WHENEVER THE KITCHEN HOOD EXHAUST FAN IS ENERGIZED, THE MAKE UP AIR UNIT SHALL BE ENERGIZED. WHENEVER THE KITCHEN HOOD EXHAUST FAN IS DE-ENERGIZED, THE MAKE UP AIR UNIT SHALL BE DE-ENERGIZED.
 - WHEN THE CONTROL CIRCUIT OF THE SUPPLY FAN IS ENERGIZED TO START, ITS OUTSIDE AIR DAMPER SHALL FULLY OPEN FIRST. AFTER THE DAMPER IS FULLY OPEN, THE OUTSIDE AIR DAMPER LIMIT SWITCH SHALL COMPLETE. THE CONTROL CIRCUITS TO START THE SUPPLY FAN.
 - PROOF OF FLOW STATUS FOR THE SUPPLY FAN AND EXHAUST SHALL BE PROVEN TO THE DDC SYSTEM BY MEANS OF THE FAN MOTOR CURRENT SWITCH.
 - THE SUPPLY FAN VARIABLE FREQUENCY CONTROLLER SHALL BE MODULATED BASED ASSOCIATED KITCHEN HOOD EXHAUST FAN OPERATION. WHEN AN ASSOCIATED KITCHEN HOOD EXHAUST FAN IS ENERGIZED AS SENSED BY DDC THRU THE FAN MOTOR CURRENT SWITCH THE SUPPLY FAN VFC SHALL BE MODULATED TO THE EF CFM RATE.
 - THE DISCHARGE AIR TEMPERATURE SENSOR THROUGH DDC SHALL MODULATE THE UNITS HOT WATER HEATING (GLYCOL) COIL CONTROL VALVE TO MAINTAIN DISCHARGE AIR TEMPERATURE SET POINT. THE DISCHARGE AIR SET POINT SHALL BE RESET BY THE SPACE TEMPERATURE BETWEEN 55 DEGREES F AND 95 DEGREES F TO MAINTAIN SPACE TEMPERATURE SET POINT OF 68 DEGREES F (ADJUSTABLE).
 - THE FILTER DIFFERENTIAL PRESSURE SWITCH SHALL ISSUE A DIRTY FILTER ALARM IF IT'S SET POINT IS REACHED.
 - IF THE LOW LIMIT SET POINT (40 DEGREES F ADJUSTABLE) OF THE DISCHARGE AIR SENSOR IS REACHED FOR MORE THAN 1 MINUTE (ADJUSTABLE) THROUGH DDC, THE SUPPLY AND EXHAUST FAN SHALL BE DE-ENERGIZED AND AN ALARM SHALL BE SENT THROUGH THE DDC SYSTEM.
 - WHEN THE SUPPLY FAN IS DE-ENERGIZED, THE OUTSIDE AIR DAMPER (D-1) SHALL CLOSE.
 - WHEN FIRE SUPPRESSION SYSTEM IS ACTIVATED, THE MAU SUPPLY FAN WILL BE DE-ACTIVATED AND THE KITCHEN HOOD EXHAUST FAN SHALL BE ACTIVATED REGARDLESS OF LOCAL CONTROL SWITCH POSITION. THIS CONDITION WILL ACTIVATE A DDC SYSTEM ALARM.
 - KITCHEN HOOD EXHAUST FAN MAY ALSO BE ACTIVATED BY HI-LIMIT THERMOSTAT REGARDLESS OF LOCAL CONTROL SWITCH POSITION, IF HEAT IS DETECTED UNDER THE KITCHEN HOOD.


SEQUENCE OF OPERATION

- AIR TERMINAL UNIT WITH PERIMETER HEATING - DISH WASH AREA:
- NOTE: ALL SETPOINTS DESCRIBED IN SEQUENCE SHALL BE ADJUSTABLE BY SYSTEM OPERATORS (CREATE REQUIRED VIRTUAL POINTS). APPROPRIATE DEADBANDS SHALL BE USED TO PREVENT SHORT CYCLING SITUATIONS.
- ALL TU'S ASSOCIATED WITH A SINGLE SPACE TEMP SENSOR SHALL CONTROL IN UNISON.
 - SUPPLY AIR TERMINAL UNIT'S (TU) VAV MINIMUM AND MAXIMUM AIRFLOW SETTINGS SHALL BE AS INDICATED ON THE MECHANICAL SCHEDULES. WHERE MINIMUM AND MAXIMUM AIRFLOW SETTINGS ARE THE SAME, THE TU CONTROLLER SHALL PERFORM CONSTANT AIR VOLUME CONTROL.
 - IN ALL MODES OF HEATING, TU DISCHARGE AIR TEMP SENSOR SHALL PROVIDE HIGH LIMIT SETPOINT CONTROL AT 90° DAT.
 - WHEN ROOM TEMPERATURE RISES ABOVE THE SETPOINT, THE SUPPLY AIR TERMINAL UNIT CONTROLLER SHALL KEEP THE TEMPERING COIL VALVE AND PERIMETER HEATING CONTROL VALVE CLOSED AND SHALL MODULATE THE SUPPLY AIRFLOW BETWEEN ITS MINIMUM AND MAXIMUM SETTING TO MAINTAIN ROOM TEMPERATURE.
 - WHEN OA TEMP IS 60 DEG F OR BELOW AND ROOM TEMPERATURE FALLS BELOW SETPOINT, THE SUPPLY TERMINAL UNIT CONTROLLER SHALL KEEP THE SUPPLY AIRFLOW AT ITS MINIMUM SETTING AND SHALL FIRST MODULATE THE PERIMETER HEATING CONTROL VALVE FOLLOWED BY TEMPERING COIL CONTROL VALVE (WHEN PERIMETER HEATING CONTROL VALVE IS FULL OPEN) TO MAINTAIN THE ROOM TEMPERATURE SETPOINT.
 - WHEN OA TEMP IS ABOVE 60 DEG F AND ROOM TEMPERATURE FALLS BELOW SETPOINT, THE SUPPLY TERMINAL UNIT CONTROLLER SHALL KEEP THE SUPPLY AIRFLOW AT ITS MINIMUM SETTING AND SHALL MODULATE THE TEMPERING COIL CONTROL VALVE TO MAINTAIN THE ROOM TEMPERATURE SETPOINT. PERIMETER HEATING CONTROL VALVE SHALL REMAIN CLOSED.
 - WHENEVER THE DISH WASH EXHAUST FAN IS ENERGIZED THE VAV TERMINAL UNITS AIR FLOW SHALL INCREASE TO MAKE UP EXHAUST AIR 100 CFM LESS THE EXHAUST AIR FLOW (ADJUSTABLE).
 - THE SUPPLY AIR TERMINAL UNIT'S MINIMUM AND MAXIMUM VOLUME AIRFLOW SETTINGS SHALL BE AS INDICATED ON THE SHEET METAL FLOOR PLANS.
 - WHEN SPACE CARBON DIOXIDE LEVEL RISES ABOVE 1100 PPM SETPOINT, THE SUPPLY AIR TU CONTROLLER SHALL OVERRIDE TEMPERATURE CONTROL AND MODULATE DAMPER OPEN TO INCREASE SUPPLY AIRFLOW UNTIL CO2 SETPOINT IS SATISFIED. THE TEMPERING COIL VALVE SHALL BE MODULATED TO MAINTAIN SPACE TEMP SETPOINT. (NOTE: THERE IS NOT A REQUIREMENT TO INCREASE OUTSIDE AIRFLOW AT RELATED RTU IF CO2 LEVEL IS ABOVE SETPOINT WHEN TU DAMPER IS AT MAX POSITION).
 - WHEN SPACE CARBON DIOXIDE LEVEL FALLS BELOW 800 PPM SETPOINT AFTER BEING IN VENTILATION OVERRIDE MODE, THE TU DAMPER SHALL BE MODULATED CLOSED TOWARDS MINIMUM POSITION. THE TEMPERING COIL VALVE SHALL BE MODULATED TO MAINTAIN SPACE TEMP SETPOINT.
 - SPACE TEMPERATURE SETPOINTS SHALL BE AS FOLLOWS:
 HEATING UNOCCUPIED SETPOINT = 62°F
 HEATING TEMPORARY UNOCCUPIED SETPOINT = 68°F
 HEATING OCCUPIED SETPOINT = 70°F
 COOLING OCCUPIED SETPOINT = 75°F
 COOLING TEMPORARY UNOCCUPIED SETPOINT = 77°F
 COOLING UNOCCUPIED SETPOINT = 80°F
 - DURING BUILDING UNOCCUPANCY, RELATED AHU (RTU OR ERU) SHALL CYCLE AS REQUIRED TO MAINTAIN BUILDING SETBACK AND SETUP TEMP SETPOINTS.
 - WHEN RESPECTIVE AHU (RTU OR ERU) IS DEACTIVATED, THE AIR TERMINAL UNIT DAMPER SHALL REMAIN IN MINIMUM POSITION AND THE TEMPERING COIL VALVE SHALL REMAIN CLOSED. THE PERIMETER HEATING VALVE SHALL BE MODULATED TO MAINTAIN HEATING UNOCCUPIED SETPOINT.
 - THE DDC TERMINAL UNIT CONTROLLER SHALL RE-CALIBRATE THE AIRFLOW SENSOR ONCE A WEEK MINIMUM. THE RE-CALIBRATION PROCESS SHALL BE STAGGERED AMONGST THE TERMINAL UNITS SO THE DUCT STATIC PRESSURE DOES NOT EXCEED LIMITS.
 - CONTROL SIGNALS FOR AIR TERMINAL UNIT DAMPER ACTUATOR AND HEATING CONTROL OUTPUT(S) SHALL BE DISPLAYED WITH SYSTEM GRAPHICS.

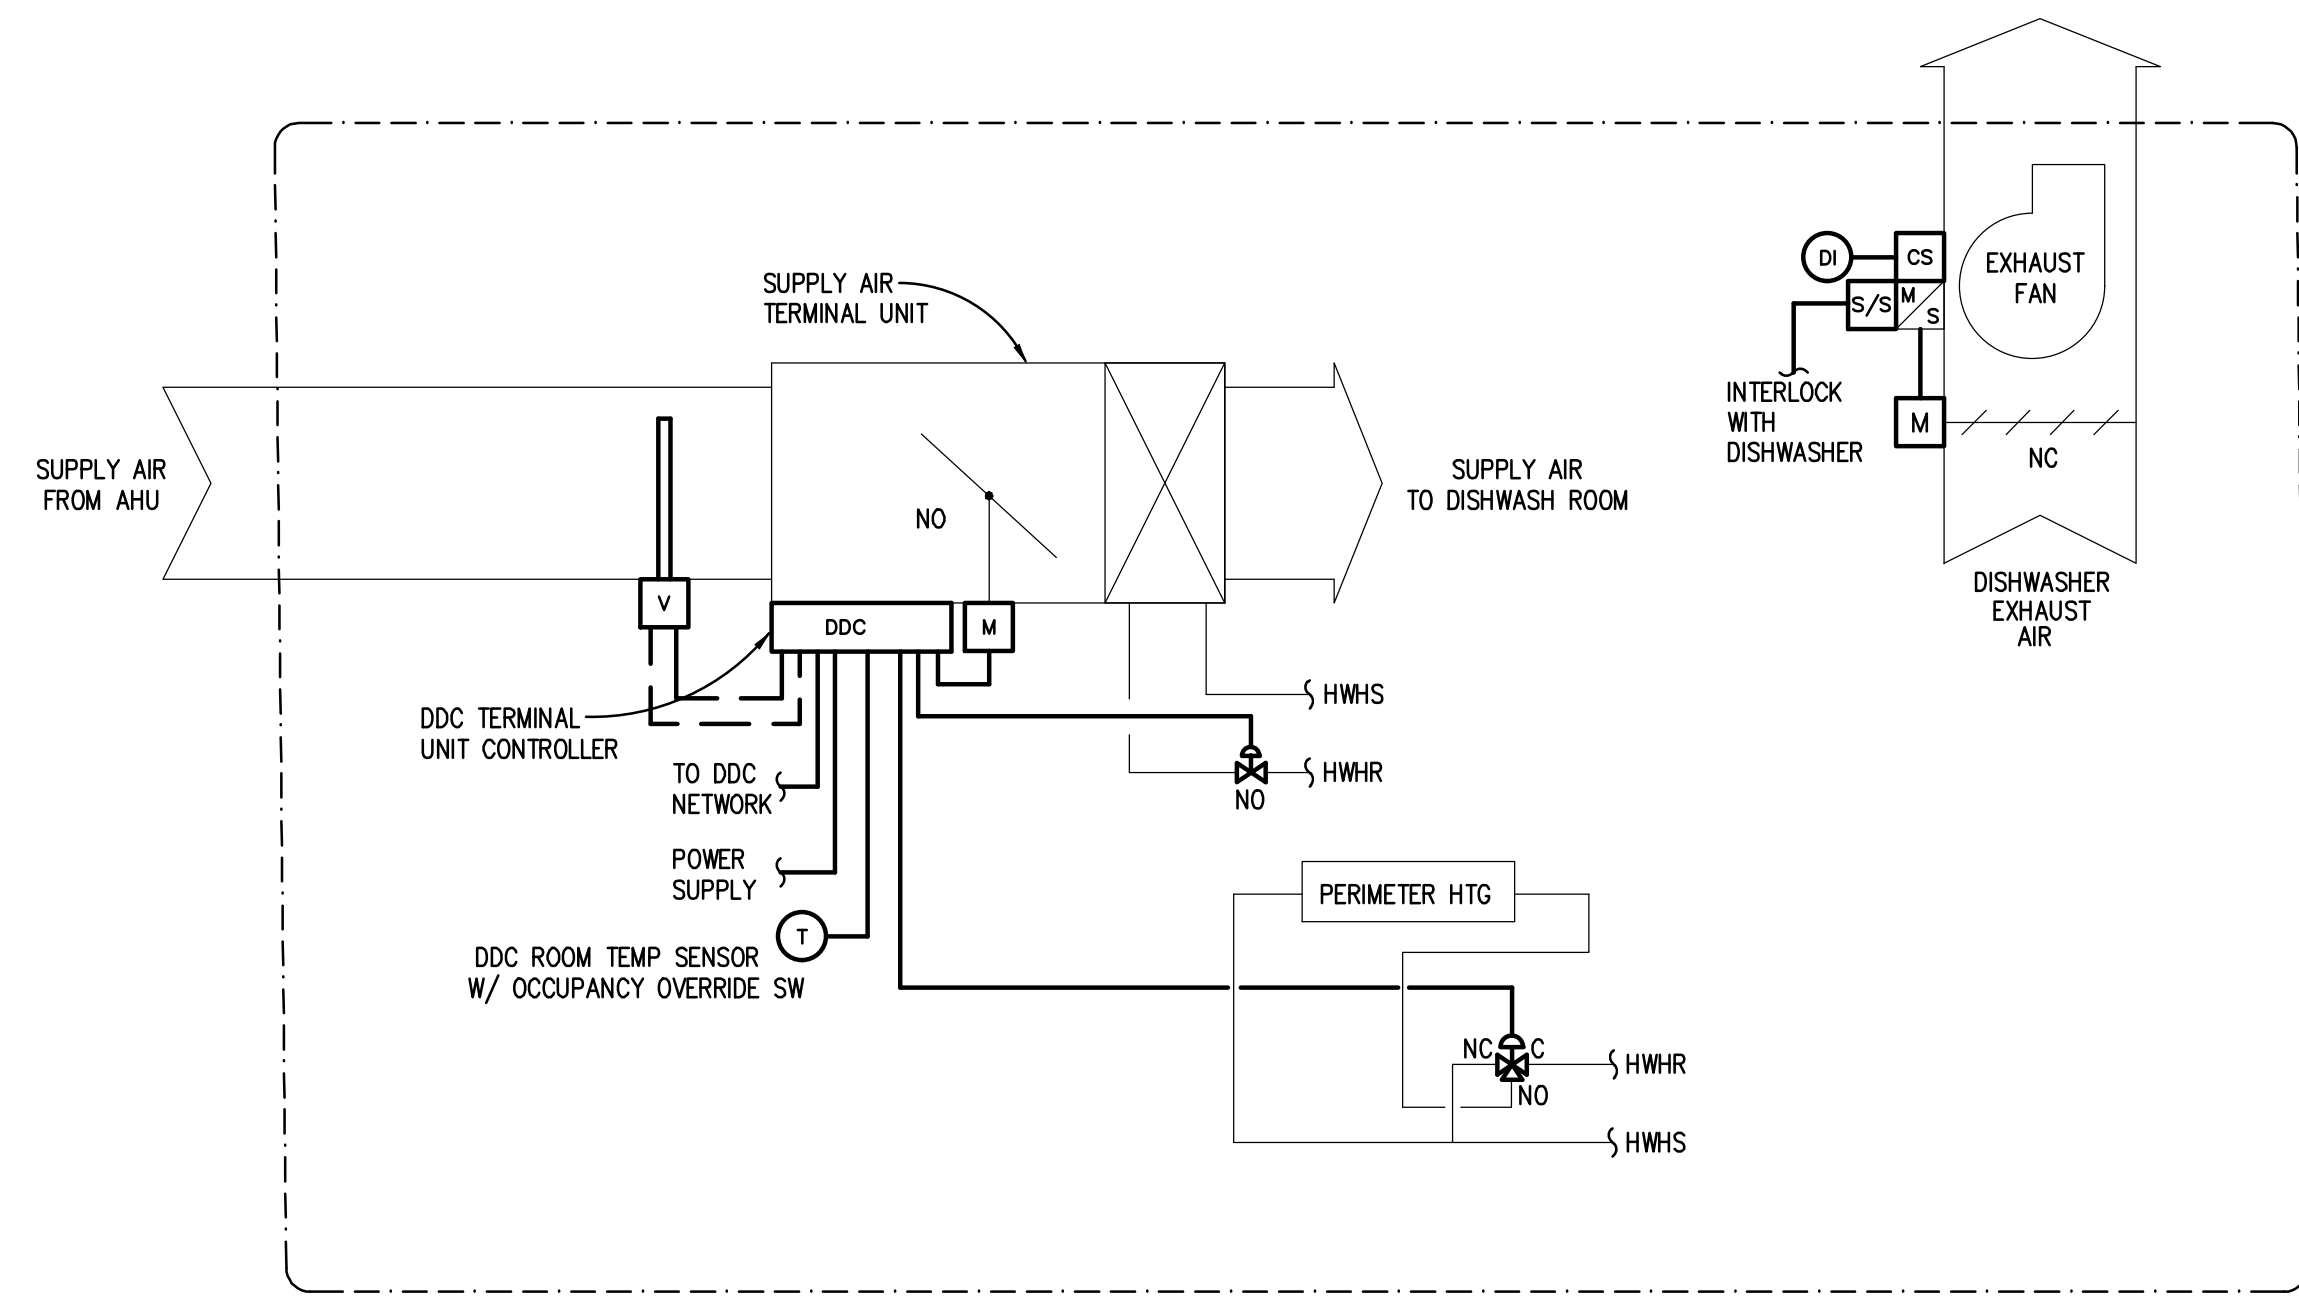

DISHWASH AREA TERMINAL UNIT CONTROL WITH PERIMETER HEAT CONTROL DIAGRAM

- NOTES:
- REFER TO SHEET METAL PLANS FOR LOCATIONS AND QUANTITY OF UNITS. REFER TO HVAC PIPING PLANS FOR LOCATIONS OF ROOM TEMP SENSORS.

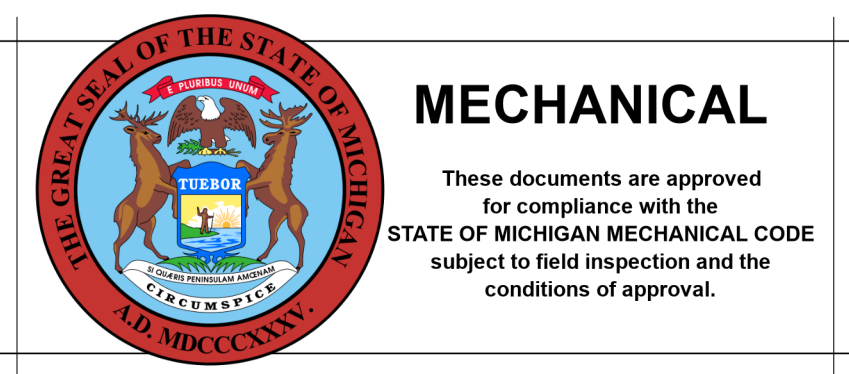

1	STATE REVIEW SET	12/20/23
NO.	REVISION	DATE

STATE OF MICHIGAN
 DEPARTMENT OF TECHNOLOGY, MANAGEMENT AND BUDGET
 FACILITIES AND BUSINESS SERVICES ADMINISTRATION
 DESIGN AND CONSTRUCTION DIVISION
 ADAM LACH, RA, DIRECTOR

FILE NO.
 491/20167.SDW

FUNDING CODE
 171CODH57255

CONTRACT NO.
 Y22003



PROJECT TITLE
 491/20167.SDW - PHASE 500:
 CENTER FOR FORENSIC
 PSYCHIATRY - CREATE
 KITCHEN
 SALINE, MICHIGAN

SHEET TITLE
 TEMPERATURE CONTROLS

PROJECT NUMBER
 2021094

PROJECT DATE
 AUGUST 23, 2023

CHECKED BY
 WEK

SHEET NUMBER
 M8.03

REFER TO SHEET M801 FOR T.C. (TEMPERATURE CONTROL) GENERAL NOTES.

Peter Basso Associates Inc.
 CONSULTING ENGINEERS
 5145 Livernois, Suite 100
 Troy, Michigan 48068-3276
 Tel: 248-879-5666
 Fax: 248-879-0007
 www.PeterBassoAssociates.com
 PBA-Project No. 2021094

en:\2021\2021-0402-00\CAD\2021-0402-M8-CP.dwg, M-803, 3/19/2024 2:42:16 PM, Thomas B. Crenonte, Peter Basso Associates Inc.