



Architect's Supplemental Instructions

PROJECT: (name and address)
Center for Forensic Psychiatry - Construct
Kitchen
8303 Platt Rd, Saline, MI 48176

CONTRACT INFORMATION:
Contract For: Construction
Date: 11-14-2023

ASI INFORMATION:
ASI Number: 1
Date: 02-14-2025

OWNER: (name and address)
The Michigan Department of Technology,
Management & Budget
320 S. Walnut Street, 2nd Floor,
Lansing, MI 48909

ARCHITECT: (name and address)
WTA Architects
100 S. Jefferson Ave., Suite 601
Saginaw, MI 48607

CONTRACTOR: (name and address)
Antler Construction Company, Inc
588 N. Canton Cnter Rd #105
Canton, MI 48187

The Contractor shall carry out the Work in accordance with the following supplemental instructions without change in Contract Sum or Contract Time. Proceeding with the Work in accordance with these instructions indicates your acknowledgment that there will be no change in the Contract Sum or Contract Time.

(Insert a detailed description of the Architect's supplemental instructions and, if applicable, attach or reference specific exhibits.)

Item 1: Reference Sheet A2.01 (Re-Issued)

Added a temporary egress travel distances on the Master First Floor Plan for BFS plan review

Item 2: Reference Sheet A2.21 and A2.22 (Re-Issued)

Revised stair dimensions on first and second floor per RFI 02.

Item 3: Reference Sheet A2.21 and A2.22 (Re-Issued)

Revised dimensions per RFI 50, refer to re-issued sheet.

Item 4: Reference Sheet A2.22 (Re-Issued)

Revised sill height of overhead door with counter per submittal.

Item 5: Reference Sheet A9.01 (Re-Issued)

Revised location of radaition panel and light fixtures for coordination per RFI 10.

ISSUED BY THE ARCHITECT:

WTA Architects

ARCHITECT (Firm name)

A handwritten signature in black ink, appearing to read "Cariann Davitt Schartow".

SIGNATURE


Cariann Davitt Schartow, Project Manager

PRINTED NAME AND TITLE

02-14-2025


DATE

CENTER FOR FORENSIC PSYCHIATRY - BUILDING CODE NOTES				
CODE REFERENCE	2012 NFPA 2015 MICHIGAN BUILDING CODE ANSI A117.1 2015 PLUMBING CODE 2015 ELECTRICAL CODE 2015 MECHANICAL CODE			
DESCRIPTION	REFERENCE	EXISTING	NEW ADDITION	REMARKS
OCCUPANCY CLASSIFICATION	MBC 303.3 / 308.4	I-2 CONDITION 1	A-2	ASSEMBLY - DINING FACILITY & ASSOCIATED KITCHEN / INSTITUTIONAL - PSYCHIATRIC HOSPITAL
CONSTRUCTION TYPE	MBC 601	IB	IIB	TYPE IIB: RATING FOR BLDG ELEMENTS = 0-HOUR TYPE IB: RATING FOR BLDG ELEMENTS = 2-HOUR EXCEPTION: NONBEAR INT WALLS = 0-HOUR ROOF = 1-HOUR
NONBEARING EXTERIOR WALL SEPARATION	MBC 602	IIB > 30 FT = 0-HOUR	IIB-A = 0-HOUR	
FEATURES OF FIRE PROTECTION		FULLY SPRINKLED		
BUILDING HEIGHT	MBC 504.4	ALLOWED - 5 STORIES 180 FT.	ALLOWED - 3 STORIES 75 FT.	A-2: ACTUAL - 1 STORY - 18 FT.
BUILDING AREA	MBC 506.2	UNLIMITED	ALLOWED - 38,000 S.F.	A-2: ACTUAL - 11,124 S.F.
SEPARATED OCCUPANCIES	MBC 508.4	I-2	A-2	2-HOUR FIRE BARRIER SEPARATION TO COMPLY WITH A-2 REQUIREMENTS
INCIDENTAL USE AREAS	MBC 509	FURNACE ROOM WITH >40,000 BTU PER HOUR INPUT = 1 HOUR OR SPR. BOILER ROOMS >15 PSI OR 10 HORSEPOWER = 1 HOUR OR SPR.		BUILDING FULLY SPRINKLERED
FIRE BARRIERS	MBC 707	SEPARATED OCCUPANCIES		CONTINUITY: TOP OF FND OR FLR/CLG ASSEMBLY TO UNDERSIDE OF FLR OR ROOF ABOVE - CONT THRU OUT CONCEALED SPACES
INTERIOR WALL/CEILING FINISHES	MBC TABLE 803.11	INTERIOR EXIT STAIRWAYS - B CORRIDORS - B ROOMS AND ENCLOSED SPACES - B ADMIN - C ≤ 4 OCC - C	ROOMS AND ENCLOSED SPACES - C	
OCCUPANT LOAD	MBC 1004.12	STOR/MECH 1,300 S.F. (GROSS) WAREHOUSE 1/500 S.F. (GROSS) INPUT 1,240 S.F. (GROSS) SLEEPING 1/20 S.F. (GROSS) DINING ROOM/SERVING 15 S.F. (NET)	KITCHEN 1,200 S.F. (GROSS) DINING ROOM/SERVING	A-2 : TOTAL OCCUPANTS = 718
FIRE EXTINGUISHERS	NFPA 10	75' MAXIMUM DISTANCE APART		
COMMON PATH EGRESS TRAVEL	MBC 1006.21	75'		THAT PORTION OF THE EXIT ACCESS TRAVEL DISTANCE MEASURED FROM THE MOST REMOTE POINT OF EGRESS TO THAT POINT WHERE THE OCCUPANTS HAVE SEPARATE AND DISTINCT ACCESS TO TWO EXITS OR EXIT ACCESS DOOR-WAYS.
NUMBER OF EXITS	MBC 1006.3.1		REQUIRED: (1) KITCHEN (2) DINING	PROVIDED: (2) DINING ROOM (2) KITCHEN
EXIT ACCESS TRAVEL DISTANCE	MBC 1017.2	200 FT.	250 FT.	
CORRIDOR FIRE RESISTANCE	MBC 1020.1	w/ SPRINKLER = 0 HOUR	FULLY SPRINKLERED	
MINIMUM CORRIDOR WIDTH	MBC 1020.2	MIN. 44 INCHES MIN. 96 INCHES FOR BED CLEARANCE		
DEAD END CORRIDORS	MBC 1020.4	20 FT.		
ACCESSIBILITY	MBC 1101.2		DESIGNED AND CONSTRUCTED TO BE ACCESSIBLE	
PLUMBING FIXTURES	MPC TABLE 403.1		NO ADDITIONAL STAFF OR PATIENTS ARE BEING ADDED TO THE FACILITY	
ENERGY EFFICIENCY	MEC		SO OF - INSULATION ENTIRELY ABOVE DECK = R-30 C WALLS - MASS = R-11.4 C SLAB ON GRADE = R-15 FOR 24IN.	

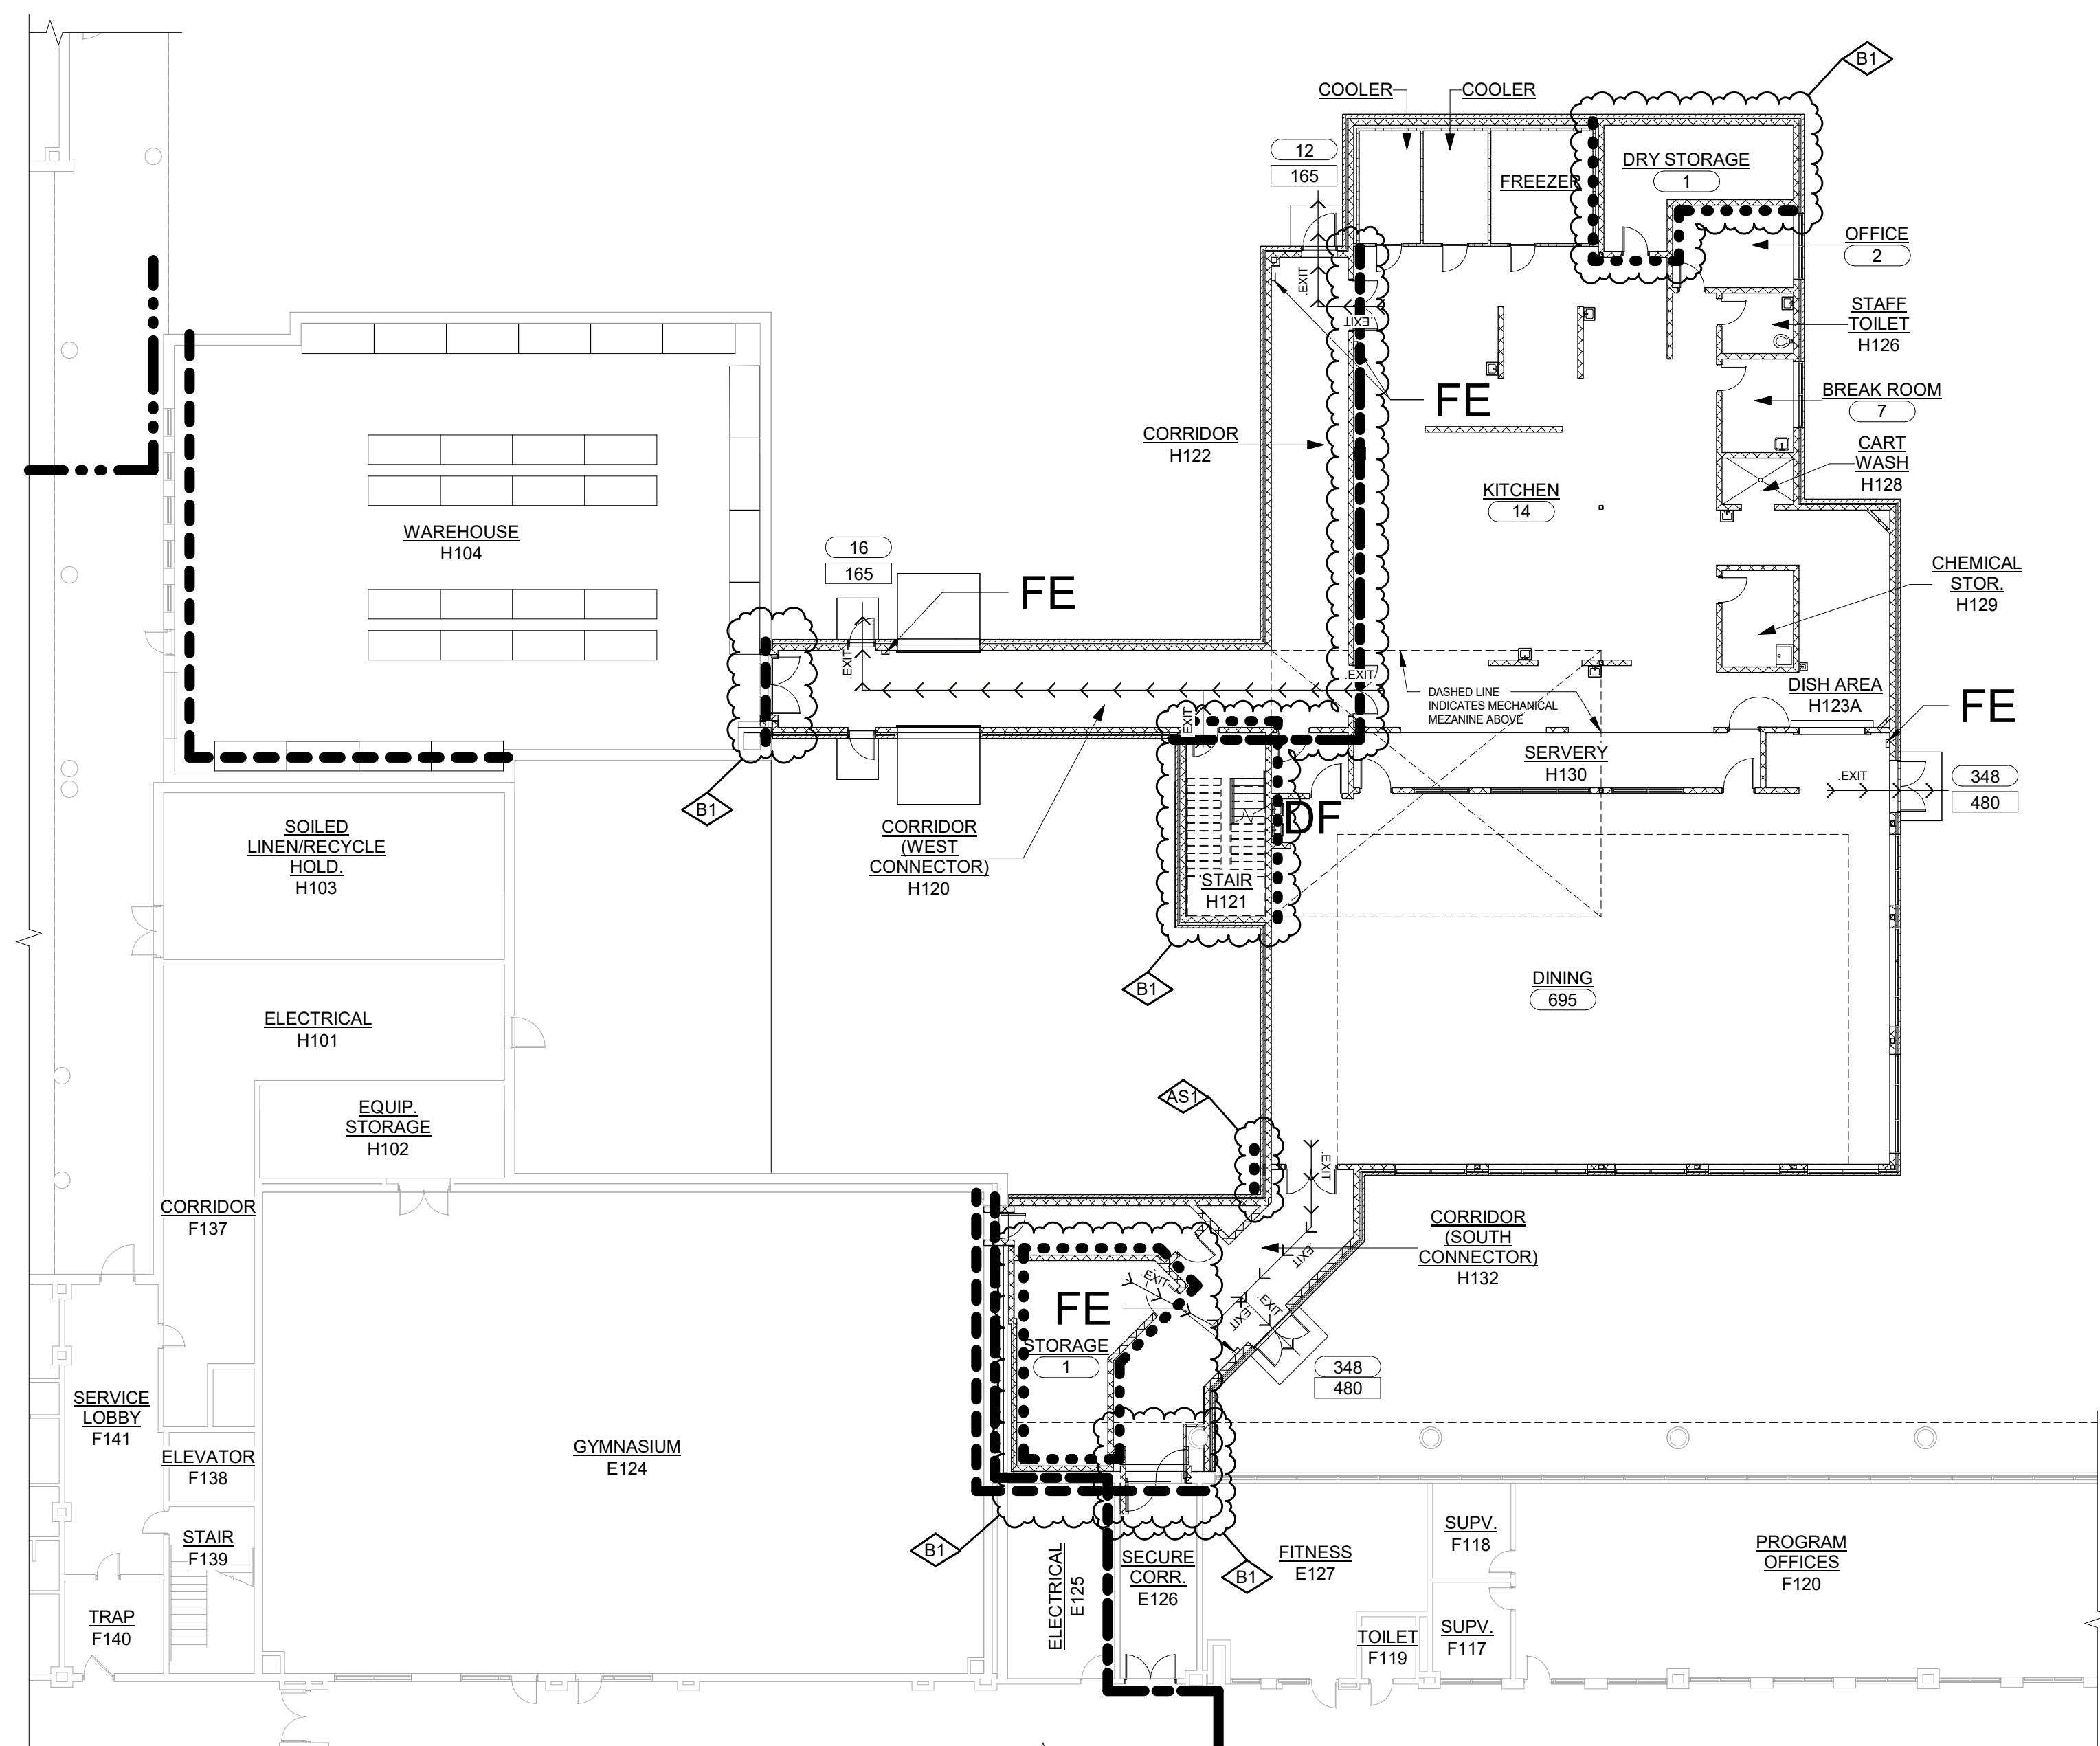

FIRST FLOOR CODE PLAN


SCALE: 1/16" = 1'-0"

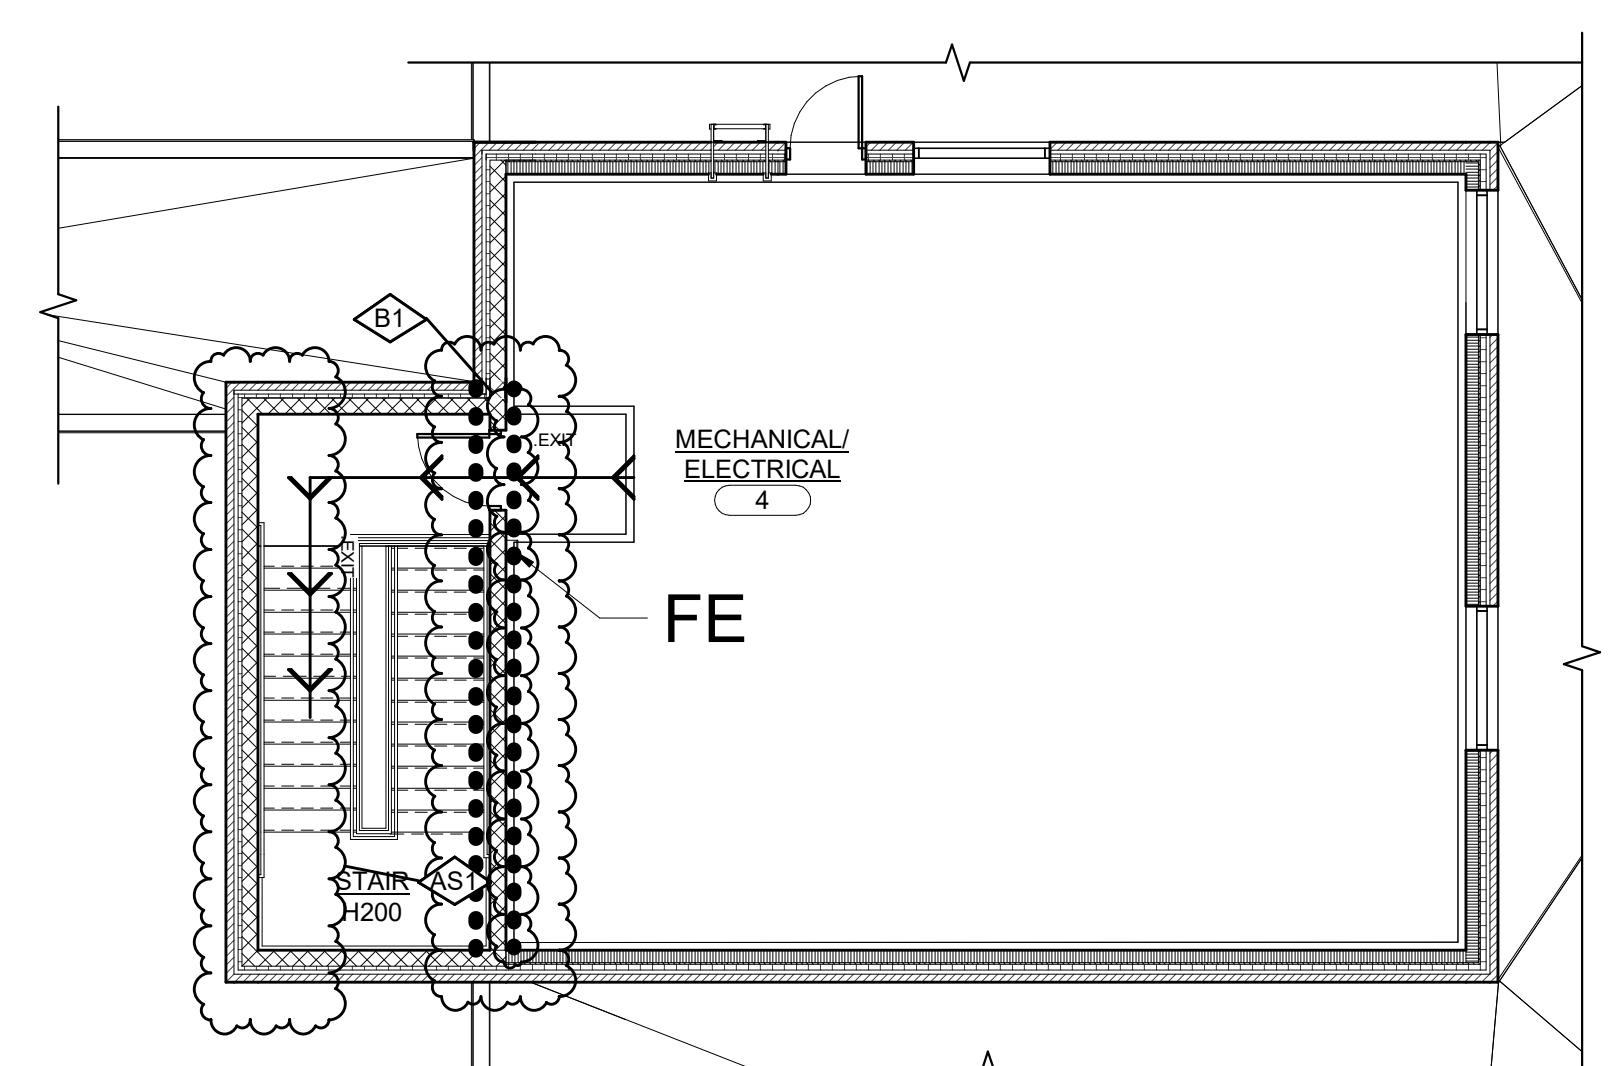

SECOND FLOOR CODE PLAN

SCALE: 1/8" = 1'-0"

CODE LEGEND	
3-HOUR BUILDING SEPARATION	3-HOUR
2-HOUR BARRIER	2-HOUR
1-HOUR ENCLOSURE / FIRE RESISTANCE RATING	1-HOUR
1-HOUR SMOKE BARRIER	1-HOUR
TRAVEL DISTANCE	TRAVEL DISTANCE
100% SPRINKLED	100% SPRINKLED
DRINKING FOUNTAIN	DRINKING FOUNTAIN
FIRE EXTINGUISHER	FIRE EXTINGUISHER
724	724
OCCUPANT LOAD	OCCUPANT LOAD
#	EXIT CAPACITY
AS1	ASI NO. 1
B1	BULLETIN NO 1
NO.	REVISION
	DATE
STATE OF MICHIGAN DEPARTMENT OF TECHNOLOGY, MANAGEMENT AND BUDGET FACILITIES AND BUSINESS SERVICES ADMINISTRATION DESIGN AND CONSTRUCTION DIVISION ADAM LACH, RA, DIRECTOR	
FILE NO. 491/20167.SDW	
FUNDING CODE 17ICODHHS7255	CONTRACT NO. Y22003
KEY PLAN NOT TO SCALE	
WTA ARCHITECTS	
100 S Jefferson Ave, Suite 601 Saginaw, Michigan 48607 989 752 8107	
COPRIGHT © 2024	
PROJECT TITLE 491/20167.SDW - PHASE 500: CENTER FOR FORENSIC PSYCHIATRY - CREATE KITCHEN SALINE, MICHIGAN	
SHEET TITLE FIRST FLOOR PARTIAL CODE PLAN	
PROJECT NUMBER 2021094	SHEET NUMBER
PROJECT DATE SEPTEMBER 6, 2023	A2.02
CHECKED BY C.D.S.	

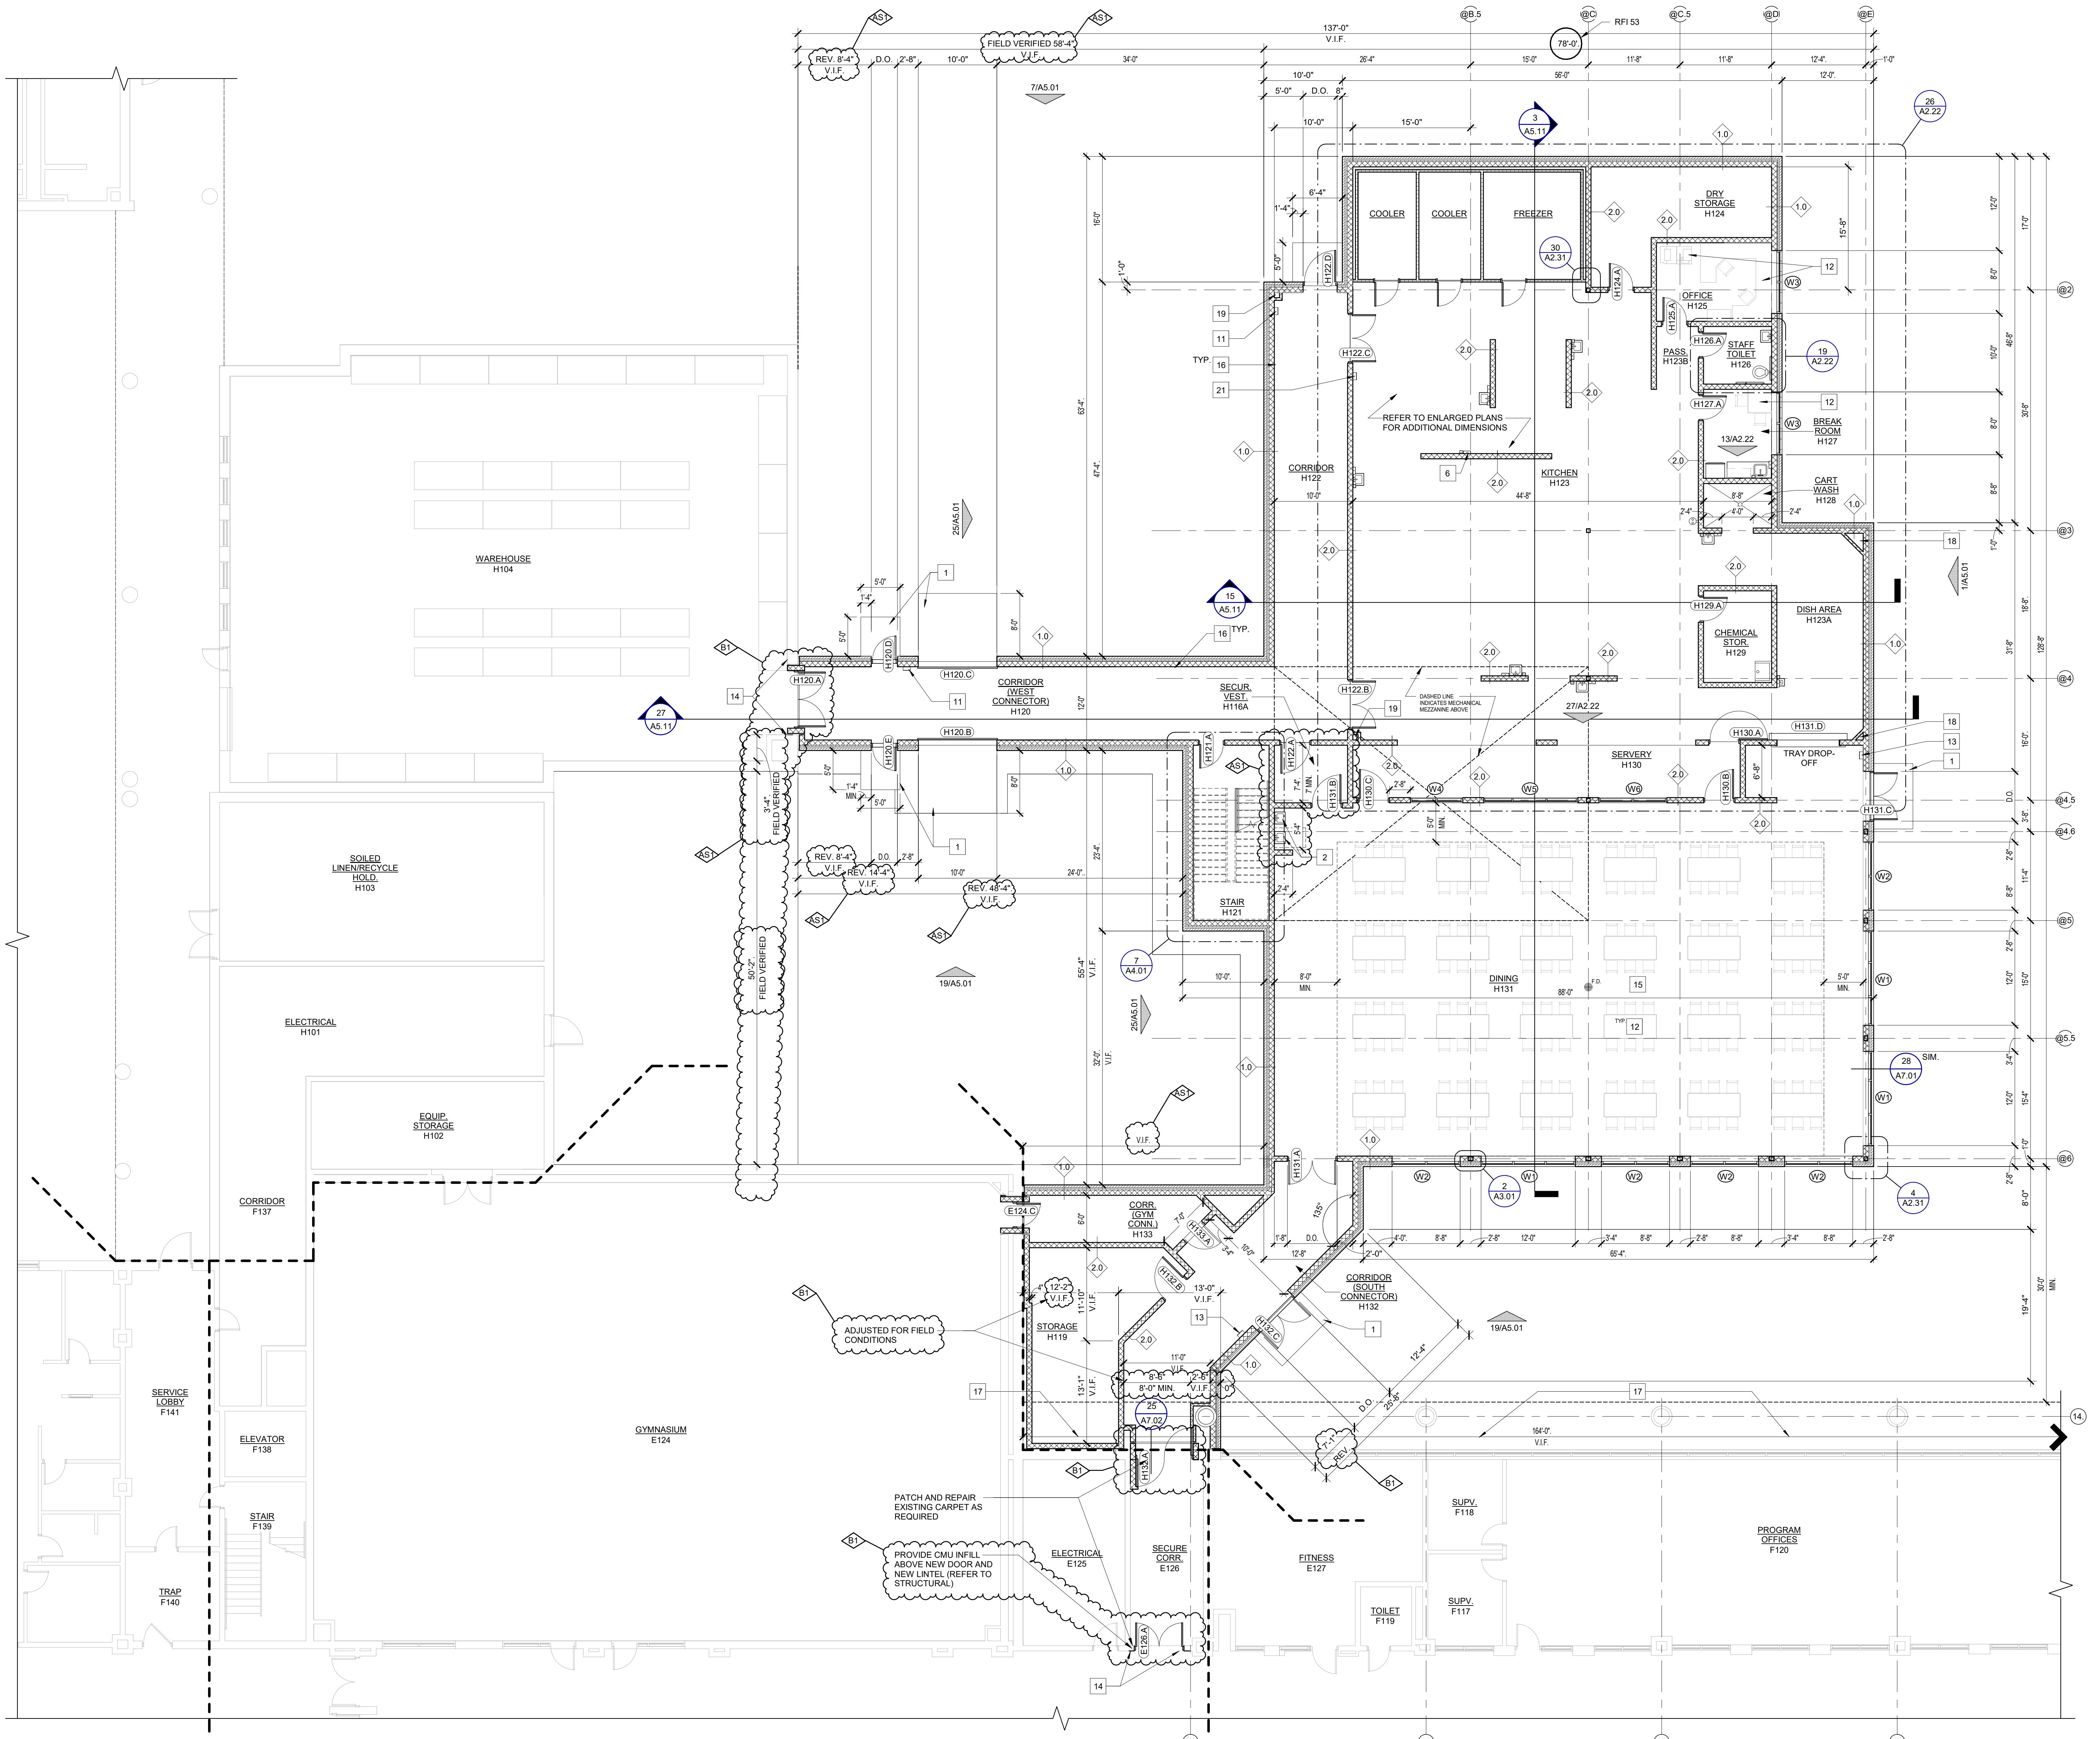

CONSTRUCTION GENERAL NOTES:

WALL TYPES ARE INDICATED AS A DIAMOND WITH A NUMBER. REFER TO SHEET A0.01 FOR DESCRIPTION OF WALL TYPES.

PLAN DIMENSIONS DO NOT INCLUDE WALL THICKNESS (REFER TO WALL TYPES).

DOOR FRAMES ARE TO BE LOCATED 8" FROM THE PERPENDICULAR WALL ON THE HINGE SIDE OF THE DOOR AT MASONRY WALLS, UNLESS NOTED OTHERWISE.

PROVIDE BLOCKING AT ALL WALL MOUNTED ITEMS INCLUDING BUT NOT LIMITED TO: PLUMBING ACCESSORIES, KITCHEN EQUIPMENT, ETC.

ALL AREAS DAMAGED BY DEMOLITION WORK ARE TO BE PATCHED AND REPAIRED OR REPLACED TO MATCH ADJACENT SURFACES.

PATCH AND REPAIR REMAINING WALLS; AT ARCHITECTURAL, MECHANICAL, AND ELECTRICAL DEMOLITION POINTS WITH SIMILAR MATERIALS IN SIZE, COLOR AND TEXTURE.

PATCH AND REPAIR ALL EXISTING FLOORS AS REQUIRED WHERE EXISTING WALLS HAVE BEEN REMOVED.

FURNITURE OR EQUIPMENT TO BE BUILT AND/ORG INSTALLED BY CONTRACTOR IS SPECIFICALLY NOTED, DIMENSIONED OR DETAILED. ALL OTHER FURNITURE OR EQUIPMENT WILL BE PROVIDED AND INSTALLED BY OWNER.

FOR CASEWORK DETAILS - REFER TO "NORTHERN AMERICA ARCHITECTURAL WOODWORK STANDARDS (A.W.S.).

CASEWORK DESIGNATION REFERS TO THE WIDTH (W) AND DEPTH (D) OF THE CABINET. REFER TO DIMENSIONS FOR HEIGHT. REFER TO "A.W.S." FOR CABINET NUMBER LOCATED BELOW DIMENSION LINE.

CONSTRUCTION KEYNOTES

- CONCRETE ENTRY SLAB (REFER TO STRUCTURAL)
- PLUMBING FIXTURE (REFER TO MECHANICAL)
- CASEWORK (REFER TO ELEVATIONS AND DETAILS)
- STAINLESS STEEL GRAB BARS
- PAPER TOWEL DISPENSER
- TOILET PAPER DISPENSER
- SANITARY NAPKIN RECEPTICLE
- MIRROR 18" x 36"
- SOAP DISPENSER
- RECESSED FIRE EXTINGUISHER CABINET
- FURNITURE AND EQUIPMENT (BY OWNER)
- SEMI-RECESSED DETENTION FIRE EXTINGUISHER CABINET
- PATCH AND REPAIR WALL CONSTRUCTION, WALL BASE, AND FLOORING TO MATCH EXISTING.
- COORDINATE LOCATION OF FLOOR TILE MOVEMENT JOINTS WITH ARCHITECT, TYPICAL OF TCNA EJ-171
- FIN TUBE RADIATOR (REFER TO MECHANICAL)
- PROVIDE NEW WATER COLD FLUID-APPLIED WATERPROOFING ALONG THE EXENT OF THE EXISTING FOUNDATION WALL - REFER TO CIVIL FOR COORDINATION OF NEW SIDEWALK, NEW ENTRY SLAB, AND FENCE MODIFICATIONS - USE CAUTION AS UNDERGROUND LINES ARE LOCATED IN THIS AREA.
- MECHANICAL CHASE VERIFY SIZE WITH KITCHEN EQUIPMENT MFR. AND MECHANICAL (REFER TO MECHANICAL)
- MECHANICAL CHASE VERIFY CLEAR WIDTH REQUIRED WITH MECHANICAL (REFER TO MECHANICAL)
- EYE WASH STATION (REFER TO FOOD SERVICE AND MECHANICAL)
- SEMI-RECESSED WET CHEMICAL FIRE EXTINGUISHER CABINET
- REFER TO MECHANICAL AND ELECTRICAL DRAWINGS.

1	ASI NO. 1	02/14/25
1	BULLETIN NO 1	01/08/25
	STATE REVIEW SET	12/20/23
O.	REVISION	DATE

RE NO.

ENDING CODE 1C0DHHS7255	CONTRACT NO. Y22003
----------------------------	------------------------

J

The Key Plan diagram illustrates a layout with the following labeled components:

- A:** A large, irregular shape on the left.
- B:** A diagonal shape below A.
- C:** A vertical shape to the right of A.
- D:** A horizontal shape to the right of C.
- E:** A vertical shape below D.
- F:** A horizontal shape below E.
- G:** A vertical shape below F.
- H:** A large, dark gray rectangular shape at the top center.
- I:** A small, dark gray shape to the right of H.
- J:** A small, dark gray shape below I.
- K:** A horizontal shape at the bottom left.
- L:** A vertical shape below K.
- M:** A horizontal shape to the right of L.
- N:** A vertical shape to the right of M.

KEY PLAN
NOT TO SCALE

JECT TITLE
491/20167.SDW - PHASE 500:
**CENTER FOR FORENSIC
PSYCHIATRY - CREATE
KITCHEN**

STREET TITLE
**FIRST FLOOR
CONSTRUCTION PLAN**

OBJECT NUMBER 2021094	SHEET NUMBER A2.21
OBJECT DATE SEPTEMBER 6, 2023	
CHECKED BY CDS	

CONSTRUCTION GENERAL NOTES:


- WALL TYPES ARE INDICATED AS A DIAMOND WITH A NUMBER. REFER TO SHEET A01 FOR DESCRIPTION OF WALL TYPES.
- DOOR DIMENSIONS ARE TO BE LOCATED 8" FROM THE PERPENDICULAR WALL ON THE HINGE SIDE OF THE DOOR AT MASONRY WALLS, UNLESS NOTED OTHERWISE.
- PROVIDE BLOCKING AT ALL WALL MOUNTED ITEMS INCLUDING BUT NOT LIMITED TO: PLUMBING ACCESSORIES, KITCHEN EQUIPMENT, ETC.
- ALL AREAS DAMAGED BY DEMOLITION WORK ARE TO BE PATCHED AND REPAIRED OR REPLACED TO MATCH ADJACENT SURFACES.
- PATCH AND REPAIR REMAINING WALLS; AT ARCHITECTURAL, MECHANICAL, AND ELECTRICAL DEMOLITION POINTS WITH SIMILAR MATERIALS IN SIZE, COLOR AND TEXTURE.
- PATCH AND REPAIR ALL EXISTING FLOORS AS REQUIRED WHERE EXISTING FLOORS HAVE BEEN REMOVED.
- FURNITURE OR EQUIPMENT TO BE BUILT AND/OR INSTALLED BY CONTRACTOR IS SPECIFICALLY NOTED, DIMENSIONED OR DETAILED. ALL OTHER FURNITURE OR EQUIPMENT WILL BE PROVIDED AND INSTALLED BY OWNER.
- FOR CASEWORK DETAILS, REFER TO "NORTHERN AMERICA ARCHITECTURAL WOODWORK STANDARDS (A.W.S.)".
- CASEWORK DESIGNATION REFERS TO THE WIDTH (W) AND DEPTH (D) OF THE CABINET. REFER TO DIMENSIONS FOR HEIGHT. REFER TO "A.W.S." FOR CABINET NUMBER LOCATED BELOW DIMENSION LINE.

CONSTRUCTION KEYNOTES

- CONCRETE ENTRY SLAB (REFER TO STRUCTURAL)
- PLUMBING FIXTURE (REFER TO MECHANICAL)
- CASEWORK (REFER TO ELEVATIONS AND DETAILS)
- STAINLESS STEEL GRAB BARS
- PAPER TOWEL DISPENSER
- TOILET PAPER DISPENSER
- SANITARY NAPKIN RECEPTACLE
- MIRROR 18" x 36"
- SOAP DISPENSER
- REFLAMED FIRE EXTINGUISHER CABINET
- FURNITURE AND EQUIPMENT (BY OWNER)
- SEMI-REFLAMED DETENTION FIRE EXTINGUISHER CABINET
- PATCH AND REPAIR WALL CONSTRUCTION, WALL BASE, AND FLOORING TO MATCH EXISTING.
- COORDINATE LOCATION OF FLOOR TILE JOINTS WITH ARCHITECT, TYPICAL OF TCA/EA-171
- FIN TUBE RADIATOR (REFER TO MECHANICAL)
- PROVIDE NEW WATER COLD FLUID-APPLIED WATERPROOFING ALONG THE EXENT OF THE EXISTING CONCRETE FLOOR SLAB. FOR COORDINATION OF NEW SIDEWALK, NEW ENTRY SLAB, AND FENCE MODIFICATIONS - USE CAUTION UNDERLINE LINES ARE LOCATED IN THIS AREA.
- MECHANICAL CHASE VERIFY SIZE WITH KITCHEN EQUIPMENT MFR. AND MECHANICAL (REFER TO MECHANICAL)
- MECHANICAL CHASE VERIFY CLEAR WIDTH REQUIRED WITH MECHANICAL REFER TO MECHANICAL
- EYE WASH STATION (REFER TO FOOD SERVICE AND MECHANICAL)
- SEMI-REFLAMED WET CHEMICAL FIRE EXTINGUISHER CABINET
- REFER TO MECHANICAL AND ELECTRICAL DRAWINGS.

AS1 ASI NO. 1 02/14/25
NO. REVISION DATE
 STATE OF MICHIGAN
DEPARTMENT OF TECHNOLOGY, MANAGEMENT AND BUDGET
FACILITIES AND BUSINESS SERVICES ADMINISTRATION
DESIGN AND CONSTRUCTION DIVISION
ADAM LACH, RA, DIRECTOR

FILE NO. 491/20167.SDW
FUNDING CODE 17ICODHHS7255 CONTRACT NO. Y22003



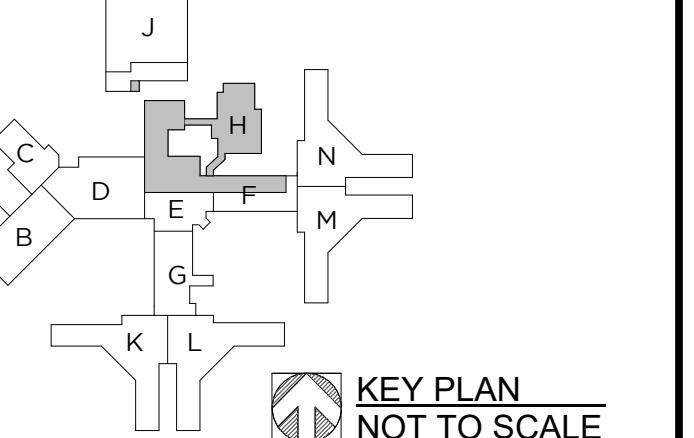


WTA ARCHITECTS
100 S Jefferson Ave, Suite 601
Saginaw, Michigan 48607
989 752 8107
COPYRIGHT © 2024


PROJECT TITLE 491/20167.SDW - PHASE 500:
CENTER FOR FORENSIC
PSYCHIATRY - CREATE
KITCHEN
SALINE, MICHIGAN

PROJECT NUMBER 2021094
SHEET NUMBER
PROJECT DATE SEPTEMBER 6, 2023
CHECKED BY C.D.S.


A2.22

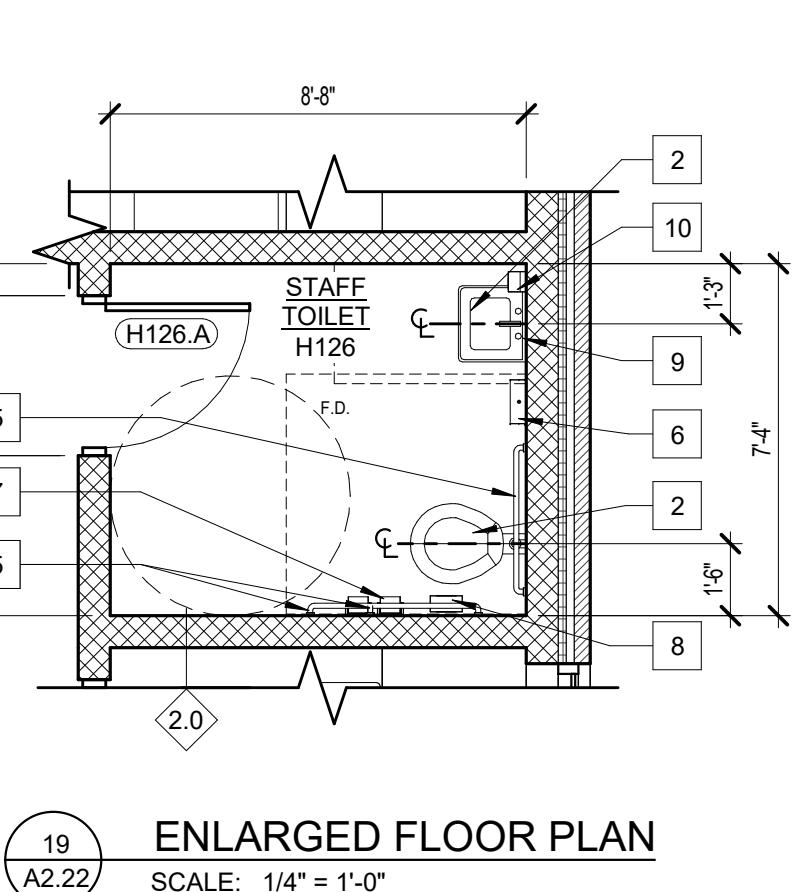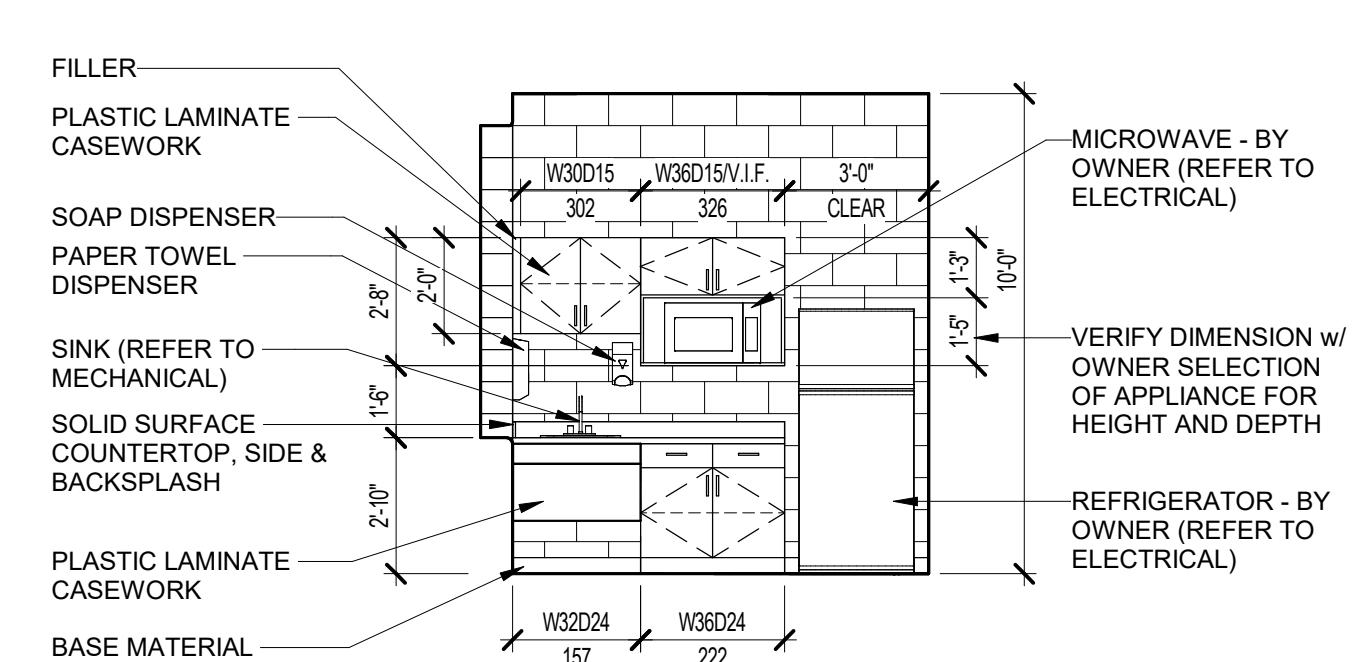
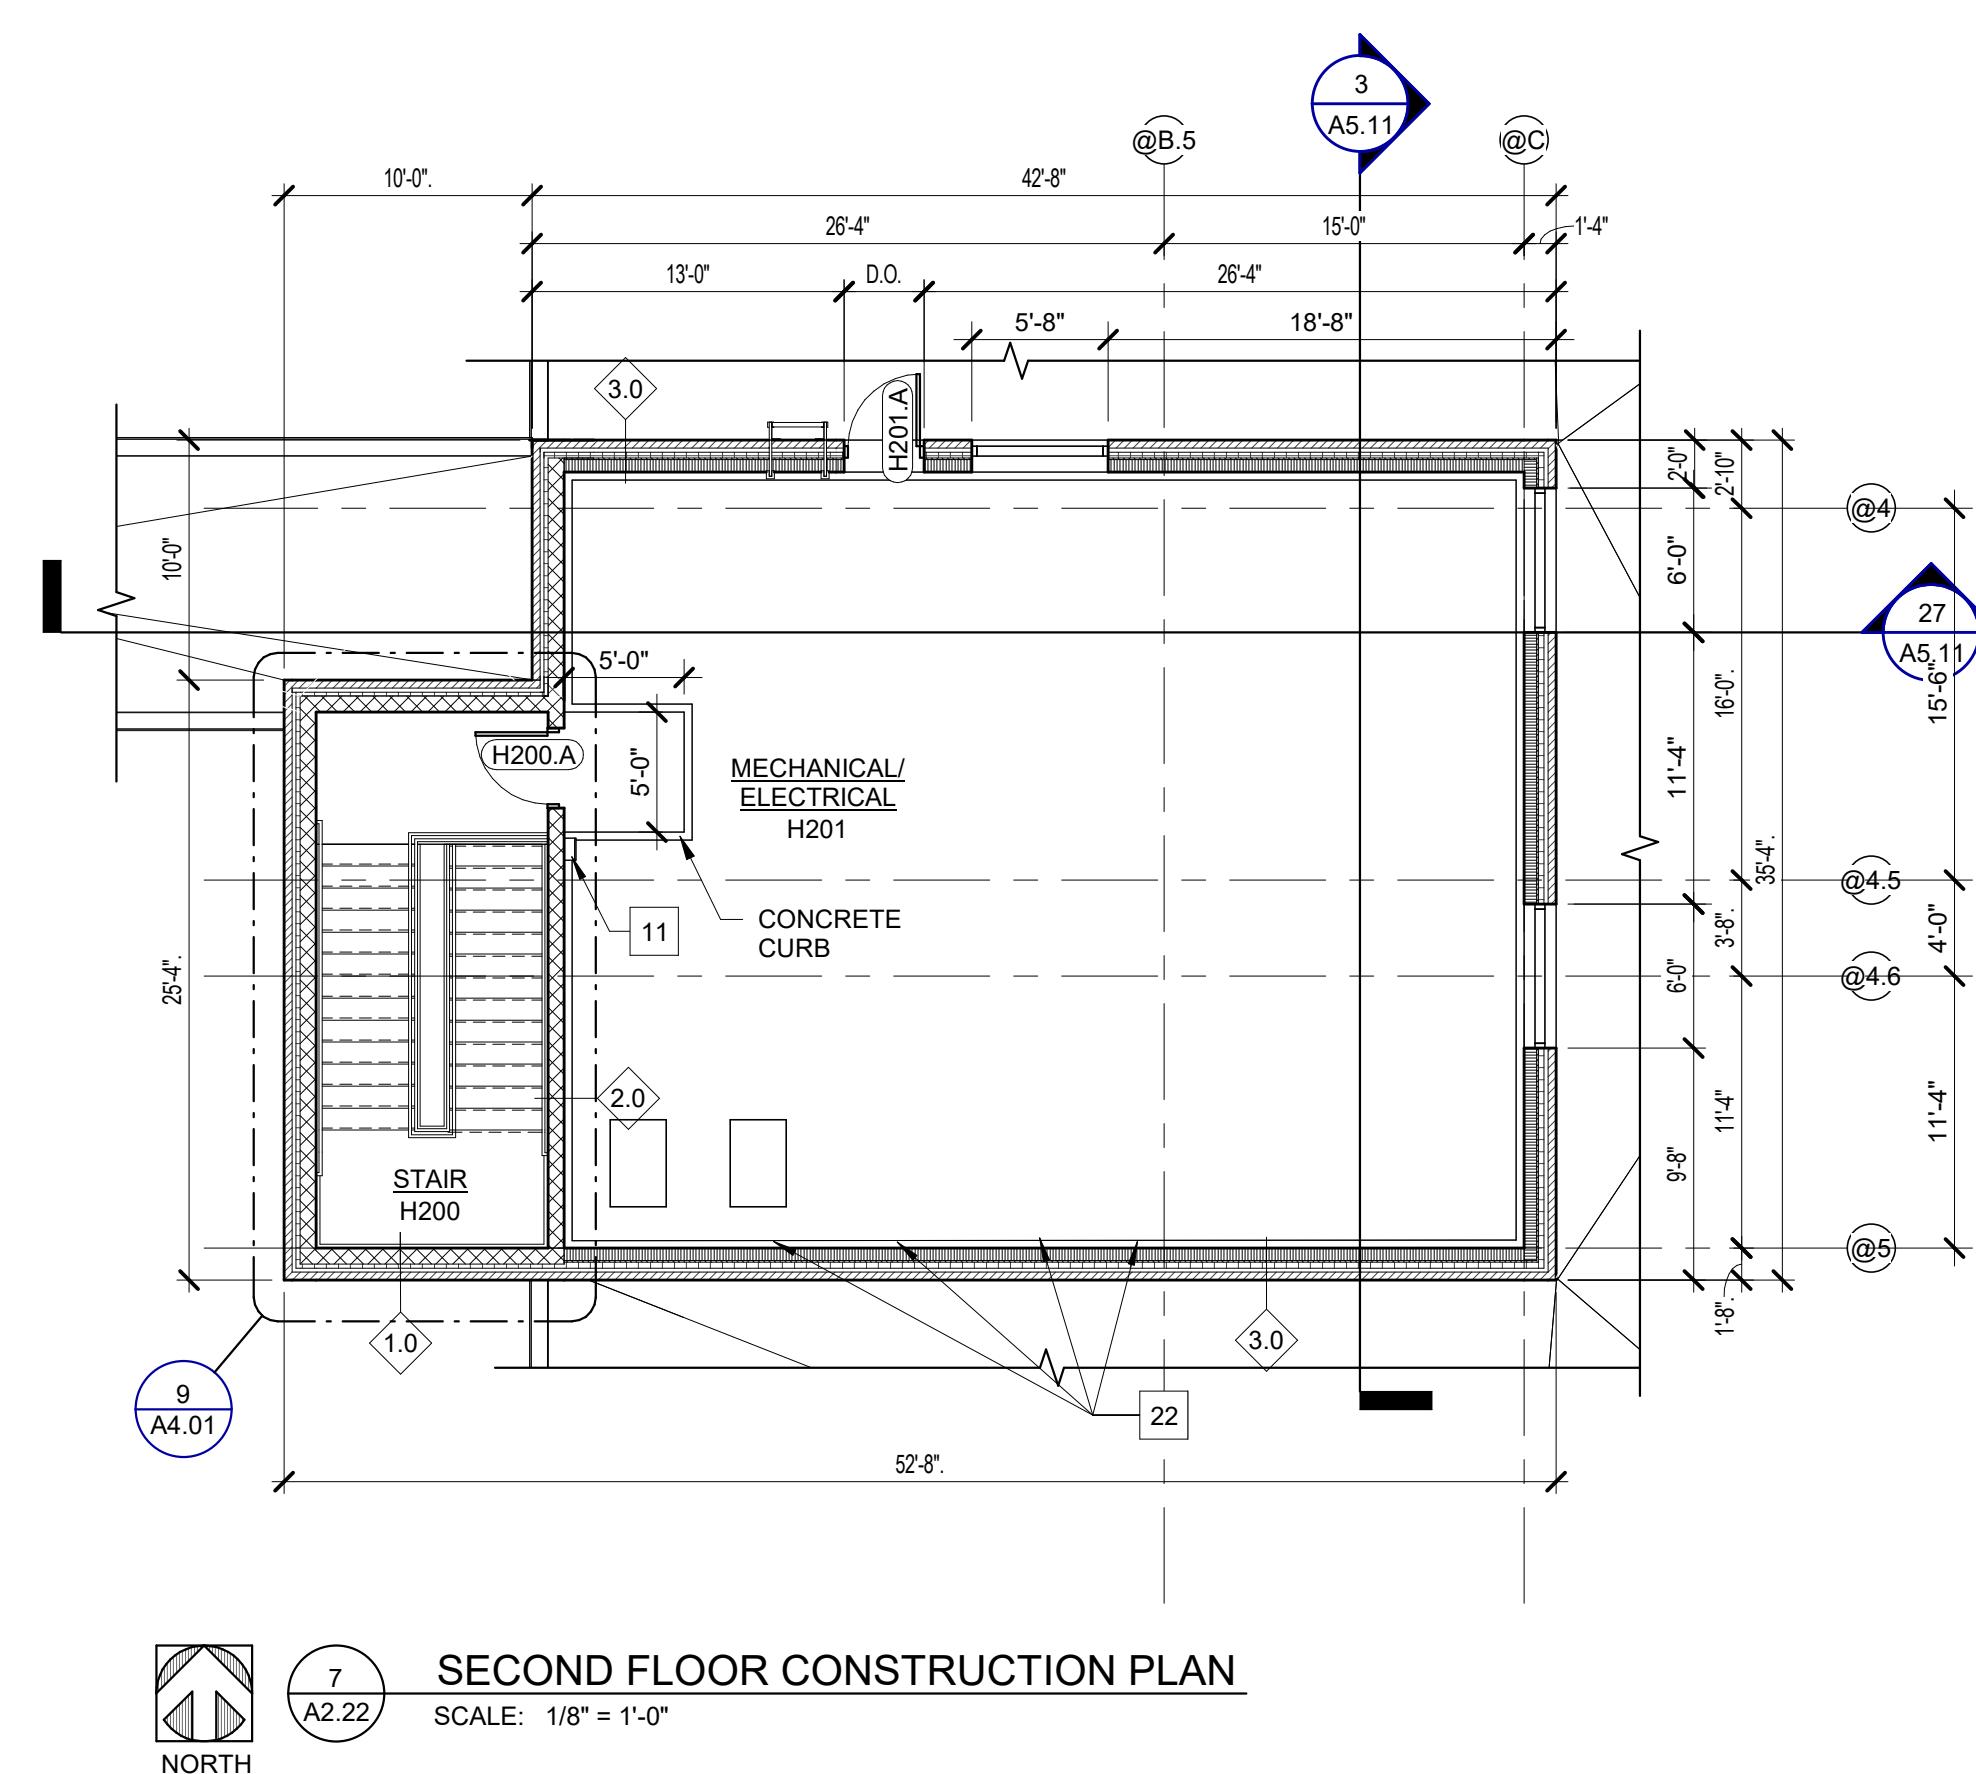


ENLARGED KITCHEN FLOOR PLAN
A2.22 SCALE: 1/4" = 1'-0"

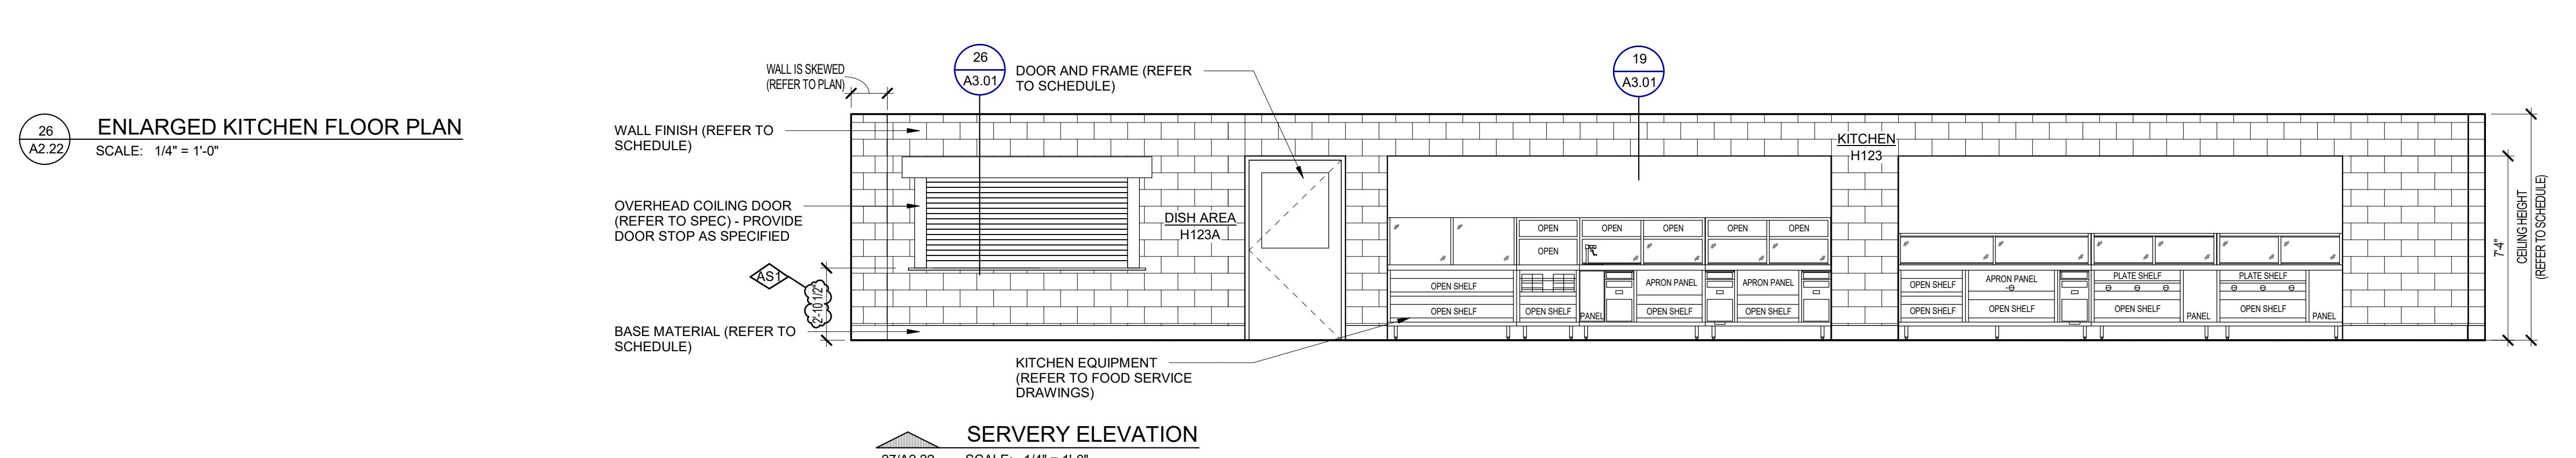

SERVING ELEVATION
27/A2.22 SCALE: 1/4" = 1'-0"

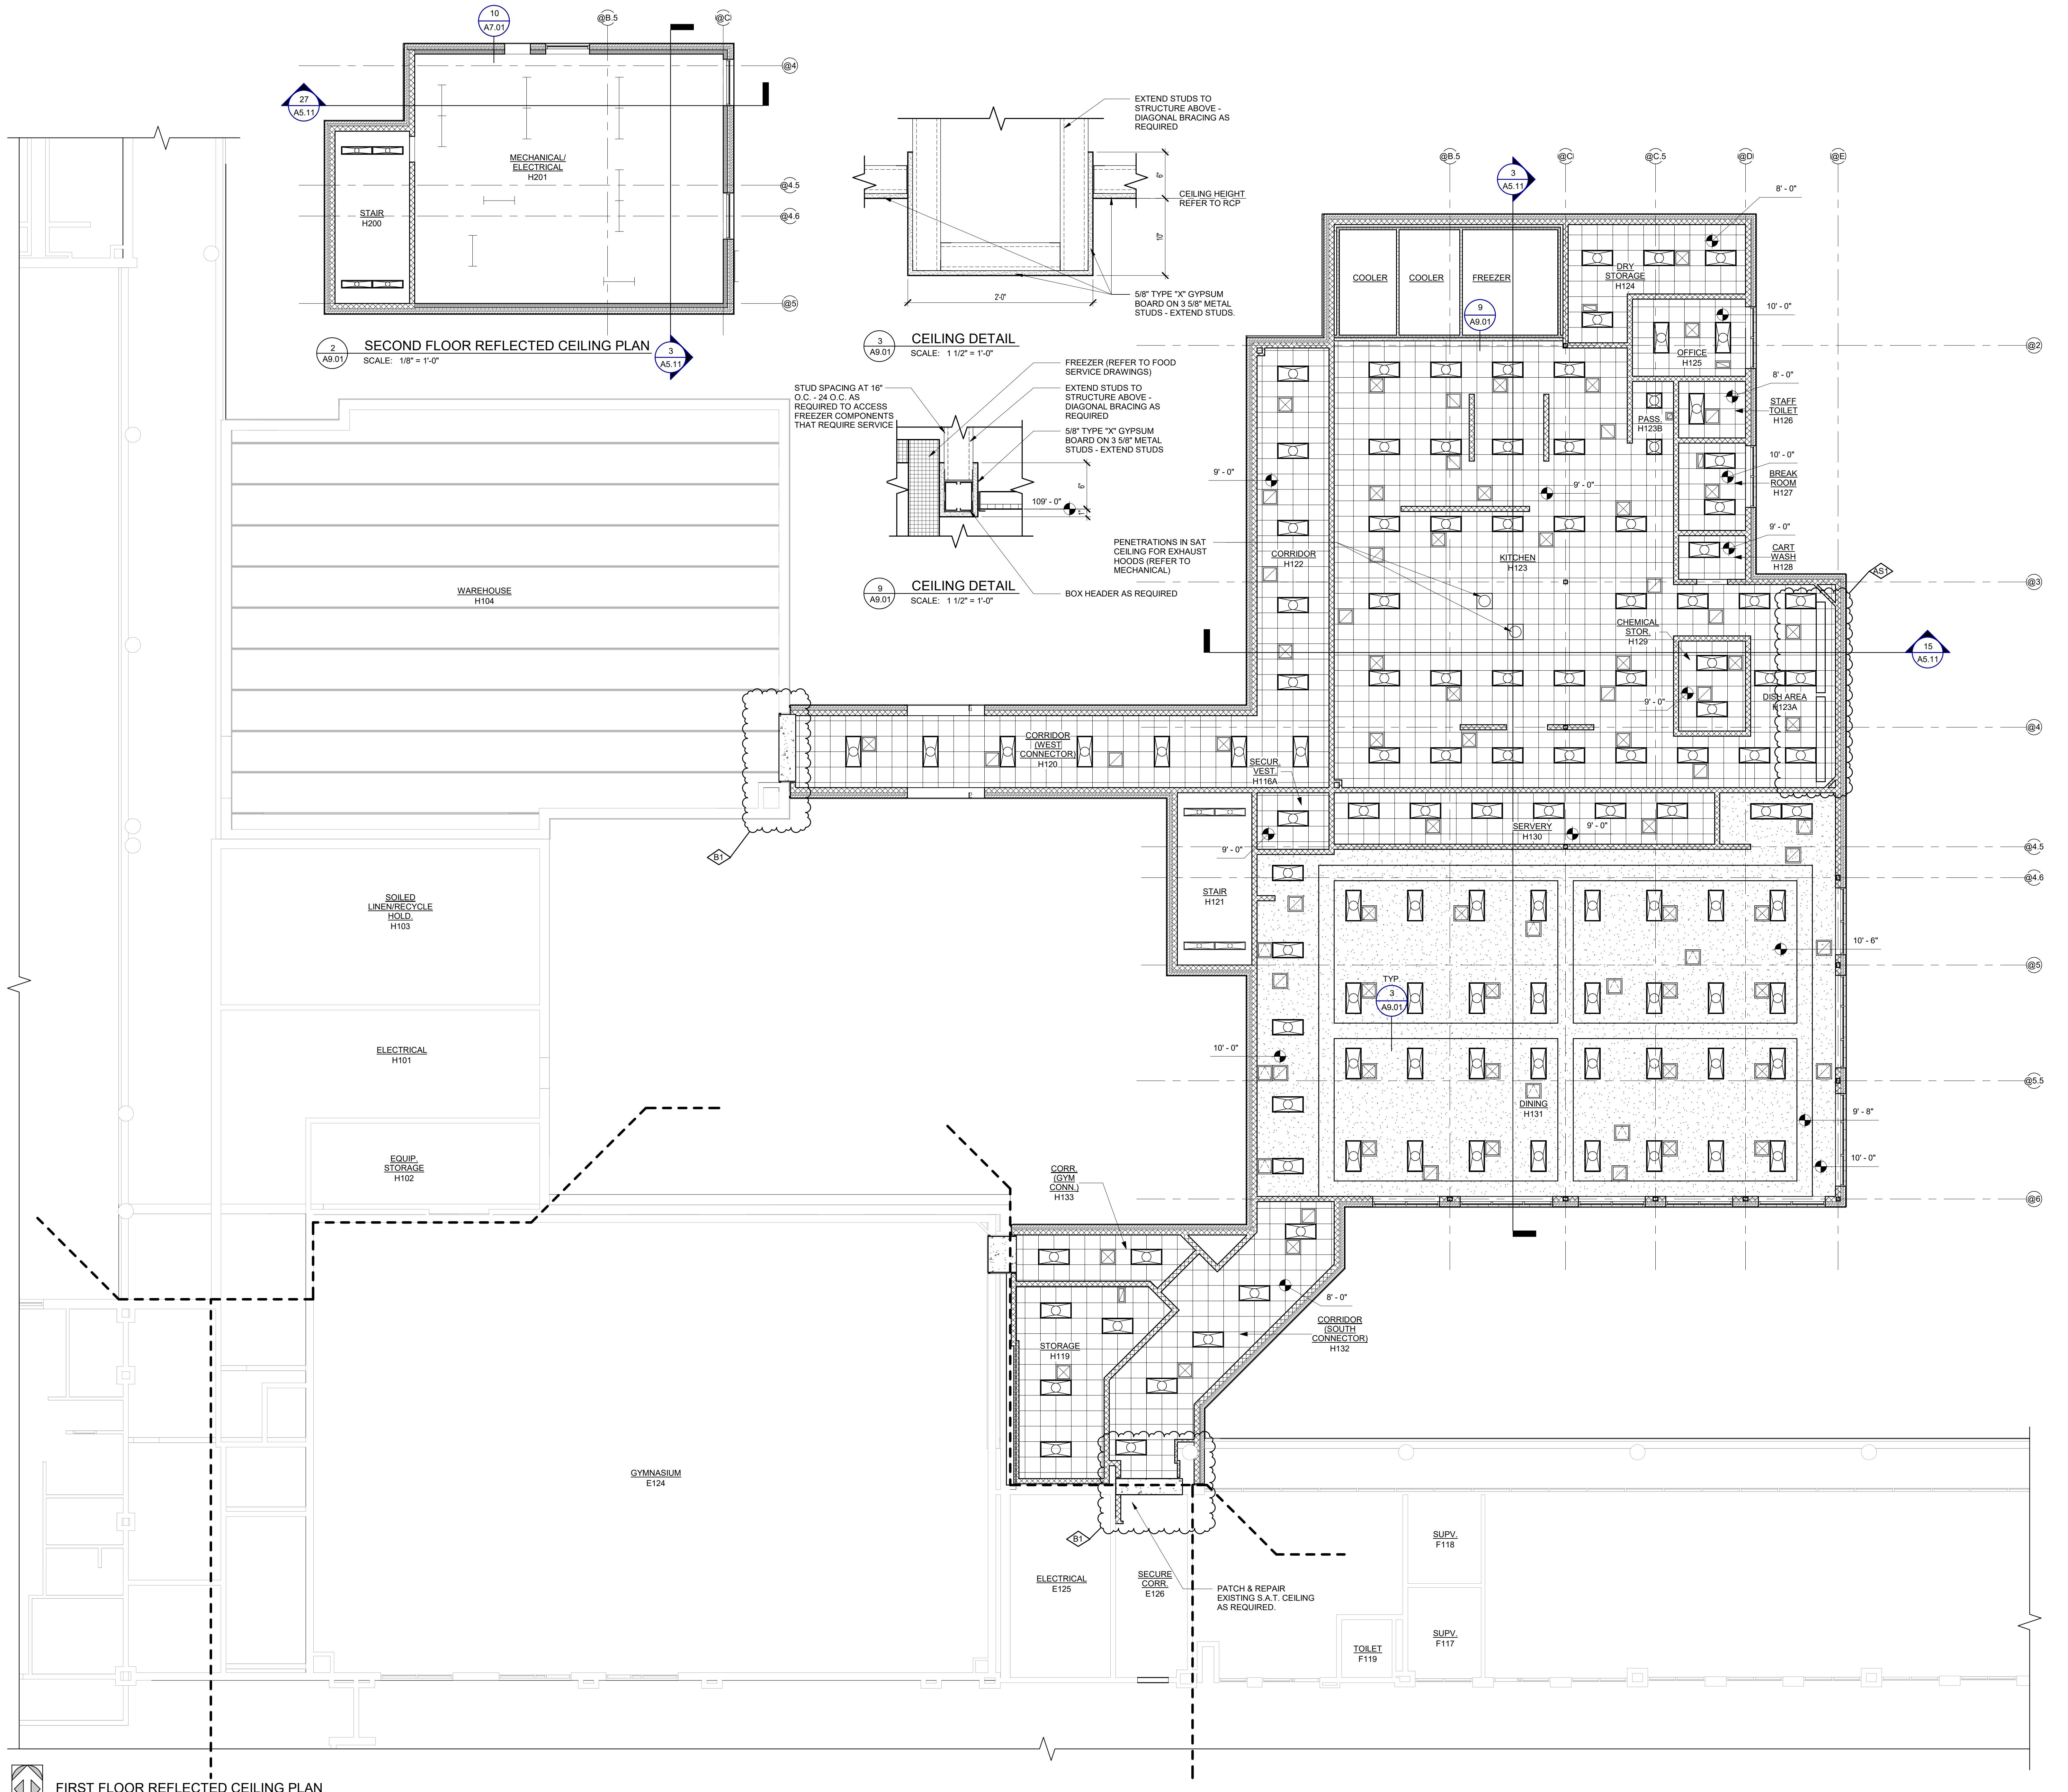

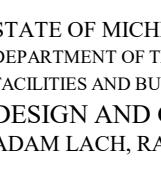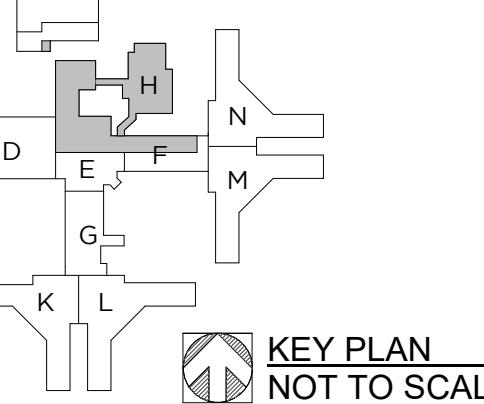REFLECTED CEILING LEGEND: <ul style="list-style-type: none"> Light fixtures (Refer to Electrical) Supply air grille (Refer to Mechanical) Return air grille / exhaust fan (Refer to Mechanical) Ceiling access panel - coordinate locations where ceiling access is required Radiant ceiling panel (Refer to Mechanical) 	
GENERAL CEILING NOTES: <ol style="list-style-type: none"> COORDINATE INSTALLATION OF SUSPENDED CEILING SYSTEM WITH MECHANICAL AND ELECTRICAL SYSTEMS. POSITION LIGHT FIXTURES IN CENTER OF CEILING TILES UNLESS NOTED OR DIMENSIONED OTHERWISE. REFERENCE SPECIFICATIONS FOR SUSPENDED CEILING SYSTEM DESCRIPTION AND LOCATION REQUIREMENTS. ELECTRICAL FIXTURES ARE SHOWN FOR LOCATION REFERENCE ONLY. REFER TO ELECTRICAL DRAWINGS AND SPECIFICATIONS FOR DETAILS. FIRE DEVICES AND EXIT LIGHTING NOT INDICATED ON ARCHITECTURAL DRAWINGS. REFER TO ELECTRICAL DRAWINGS FOR LOCATION, DETAILS, AND SPECIFICATIONS. PROVIDE S.A.T. HOLD DOWN CLIPS AT EXTERIOR DOORS. 	
AS1 ASI NO. 1 02/14/25 B1 BULLETIN NO 1 01/08/25 NO. REVISION DATE	
 STATE OF MICHIGAN DEPARTMENT OF TECHNOLOGY, MANAGEMENT AND BUDGET FACILITIES AND BUSINESS SERVICES ADMINISTRATION DESIGN AND CONSTRUCTION DIVISION ADAM LACH, RA, DIRECTOR	
FILE NO. 491/20167.SDW FUNDING CODE 17ICODHHS7255 CONTRACT NO. Y22003	
 KEY PLAN NOT TO SCALE WTAARCH.COM	
WTA ARCHITECTS 100 S Jefferson Ave, Suite 601 Saginaw, Michigan 48607 989 752 8107 COPRIGHT © 2024	
PROJECT TITLE: 491/20167.SDW - PHASE 500: CENTER FOR FORENSIC PSYCHIATRY - CREATE KITCHEN SALINE, MICHIGAN	
HEET TITLE: FIRST & SECOND FLOOR REFLECTED CEILING PLAN	
PROJECT NUMBER: 2021094 HEET NUMBER: A9.01	
PROJECT DATE: SEPTEMBER 6, 2023 CHECKED BY: C.D.S.	