



Architect's Supplemental Instructions

PROJECT: (name and address)
Center for Forensic Psychiatry - Construct Kitchen
8303 Platt Rd, Saline, MI 48176

CONTRACT INFORMATION:
Contract For: Construction
Date: 11-14-2023

ASI INFORMATION:
ASI Number: 3
Date: 02-27-2025

OWNER: (name and address)
The Michigan Department of Technology, Management & Budget
320 S. Walnut Street, 2nd Floor, Lansing, MI 48909

ARCHITECT: (name and address)
WTA Architects
100 S. Jefferson Avenue, Suite 601
Saginaw, MI. 48607

CONTRACTOR: (name and address)
Antler Construction Company, Inc
588 N Canton Center Rd #105
Canton, MI 48187

The Contractor shall carry out the Work in accordance with the following supplemental instructions without change in Contract Sum or Contract Time. Proceeding with the Work in accordance with these instructions indicates your acknowledgment that there will be no change in the Contract Sum or Contract Time.

(Insert a detailed description of the Architect's supplemental instructions and, if applicable, attach or reference specific exhibits.)

CIVIL

Item C1: Reference Sheet C2.01 (Re-Issued)

Revised the storm piping to work with the deeper storm sewer. Flowable fill was approved for the existing storm pipe, that was to be abandoned per RFI 27.

Item C2: Reference Sheet C2.01 (Re-issued)

Revised to reconnect existing 4" footing drain to the existing 8" PVC and reinstall cleanout. Adjust STM Structure 6 and storm lines as shown on the plans per RFI 42.

Item C3: Reference Sheet C2.03 (Re-issued)

Revised to connect existing storm lines into Storm Structure 1 as indicated on the re-issued sheet per RFI 45. Core a new hole in structure 1 for the 6" SW inflow and make the invert the same as the 12" NE outflow invert.

Item C4: Reference Sheet C2.02 & C2.03 (Re-Issued)

Connect Structure 1 to Structure 6 and eliminate STM 1-2 per RFI 48.

ISSUED BY THE ARCHITECT:

WTA Architects

ARCHITECT (Firm name)

SIGNATURE

Cariann Davitt Schartow, Project Manager

PRINTED NAME AND TITLE

02-27-2025

DATE

GENERAL CONSTRUCTION NOTES:

- 1) CONTRACTOR WILL COORDINATE WITH FACILITY STAFF TO DETERMINE THE IRRIGATION SYSTEM LOCATION FOR REMOVALS AND REPLACEMENT AROUND PROPOSED IMPROVEMENTS.
- 2) CONTRACTOR TO COMPLETE GROUND PENETRATING RADAR WITHIN CONSTRUCTION LIMITS TO DETERMINE THE EXACT LOCATION OF UNDERGROUND UTILITIES PRIOR TO BEGINNING EXCAVATION.
- 3) PRIOR TO CONSTRUCTION CONTRACTOR IS TO WORK WITH THE FACILITY TO DETERMINE AN ADEQUATE LAYDOWN AREA AND JOB TRAILER LOCATION.
- 4) ALL BENCHES ARE TO BE SALVAGED COORDINATE STORAGE LOCATION WITH OWNER.
- 5) EXISTING ABANDONED CONDUIT ALONG EXPOSED WALL SHALL BE REMOVED TO THE BUILDING FOUNDATION AND SHALL BE SEALED TO BE MADE WATER TIGHT.

SOIL EROSION & SEDIMENTATION CONTROL

1. DEVELOPER SHALL SIGN A DETAILED EROSION CONTROL PLAN AND OBTAIN A SOIL EROSION & SEDIMENTATION CONTROL PERMIT PRIOR TO ANY EARTH CHANGES.
2. CONSTRUCTION OPERATION SHALL BE SCHEDULED AND PERFORMED SO THAT PREVENTATIVE EROSION CONTROL MEASURES ARE IN PLACE PRIOR TO EXCAVATION AND TEMPORARY STABILIZATION MEASURES ARE IN PLACE IMMEDIATELY FOLLOWING BACKFILLING AND/OR GRADING OPERATIONS.
3. BORROW AND FILL DISPOSAL AREAS WILL BE SELECTED AND APPROVED AT TIME OF PLAN REVIEW.
4. CONSTRUCTION EQUIPMENT WILL BE TAKEN IN THE USE OF CONSTRUCTION EQUIPMENT TO PREVENT THOSE THAT PROMOTE EROSION.
5. CLEANUP WILL BE DONE IN A MANNER TO ENSURE THAT EROSION CONTROL MEASURES ARE NOT DISRUPTED.
6. THE PROJECT WILL CONTINUALLY BE INSPECTED FOR SOIL EROSION AND SEDIMENTATION CONTROL COMPLIANCE. DEFICIENCIES WILL BE CORRECTED BY THE DEVELOPER WITHIN 24 HOURS.
7. THE PROJECT WILL BE INSPECTED AND EROSION CONTROL MEASURES WILL BE COMPLETELY REMOVED BY THE DEVELOPER UPON ESTABLISHMENT OF PERMANENT CONTROL MEASURES.
8. ALL TEMPORARY SOIL EROSION CONTROL MEASURES MUST BE REMOVED FROM ROAD RIGHT-OF-WAY AREAS PRIOR TO CONSTRUCTION OF PERMANENT EROSION CONTROL MEASURES.
9. VEGETATION MUST BE ACCEPTABLY ESTABLISHED PRIOR TO FINAL RELEASE OF THE CONSTRUCTION GUARANTEE BY THE DESIGNED SOIL EROSION SEDIMENTATION CONTROL AGENT.
10. EXPOSED SOILS SHALL BE PROTECTED FROM WIND AND WATER EROSION.

SESC NOTES

1. DISTANCE TO NEAREST LAKE, STREAM OR WETLAND: 2380'
2. SOIL TYPE: MAPPANE SILTY CLAY LOAM 0 TO 2 PERCENT SLOPES
3. PERIODIC MAINTENANCE: 12 MONTHS
4. ANY REFUSAL TO COMPLY WITH SESC REQUIREMENTS AND CORRECTIVE MEASURES WILL RESULT IN DTMB IMPOSING FINES OF AT LEAST \$500 PER DAY AND ACTUAL DAMAGE COSTS WILL BE ASSESSED.
5. ALL SESC MEASURES ARE TO ADHERE TO THE LATEST MDT STANDARD PLAN R-96 SERIES.

SOIL EROSION/SEDIMENTATION CONTROL

SOIL EROSION/SEDIMENTATION CONTROL OPERATION TIME SCHEDULE


CONTRACTOR TO FILL OUT AND SUBMIT AS PART OF OBTAINING AN SESC PERMIT												
CONSTRUCTION SEQUENCE	JAN	FEB	MAR	APR	MAY	JUN	JUL	AUG	SEP	OCT	NOV	DEC
STRIP & STOCKPILE TOPSOIL												
ROUGH GRADE & STABILIZATION												
TOP SOIL & MEASURES												
STORM FACILITIES												
TEMP. CONSTRUCTION ROADS												
SITE CONSTRUCTION												
PERM. CONTROL MEASURES												
FINISH GRADING												

CONSTRUCTION SEQUENCE


1. EXCAVATION AND STOCKPILING OF SOIL.
2. PLACEMENT OF EROSION CONTROL MEASURES, SELECTIVE GRADING, DIVERSIONS AS REQUIRED IN FIELD, PROTECTION OF STORM SEWER FACILITIES.
3. PERIODIC MAINTENANCE OF AFFECTED EROSION CONTROL MEASURES.
4. PERMANENT MEASURES, FINAL GRADING, SEEDING AND MULCHING.

PERMANENT SEEDING GUIDE

IRRIGATED AND/OR MULCH	APR MAY JUN JUL AUG SEPT OCT											
	ZONE 1	ZONE 2	ZONE 3	ZONE 1	ZONE 2	ZONE 3	ZONE 1	ZONE 2	ZONE 3	ZONE 1	ZONE 2	ZONE 3
WITHOUT IRRIGATION OR MULCH												
IRRIGATED AND/OR MULCH												
WITHOUT IRRIGATION OR MULCH												
IRRIGATED AND/OR MULCH												

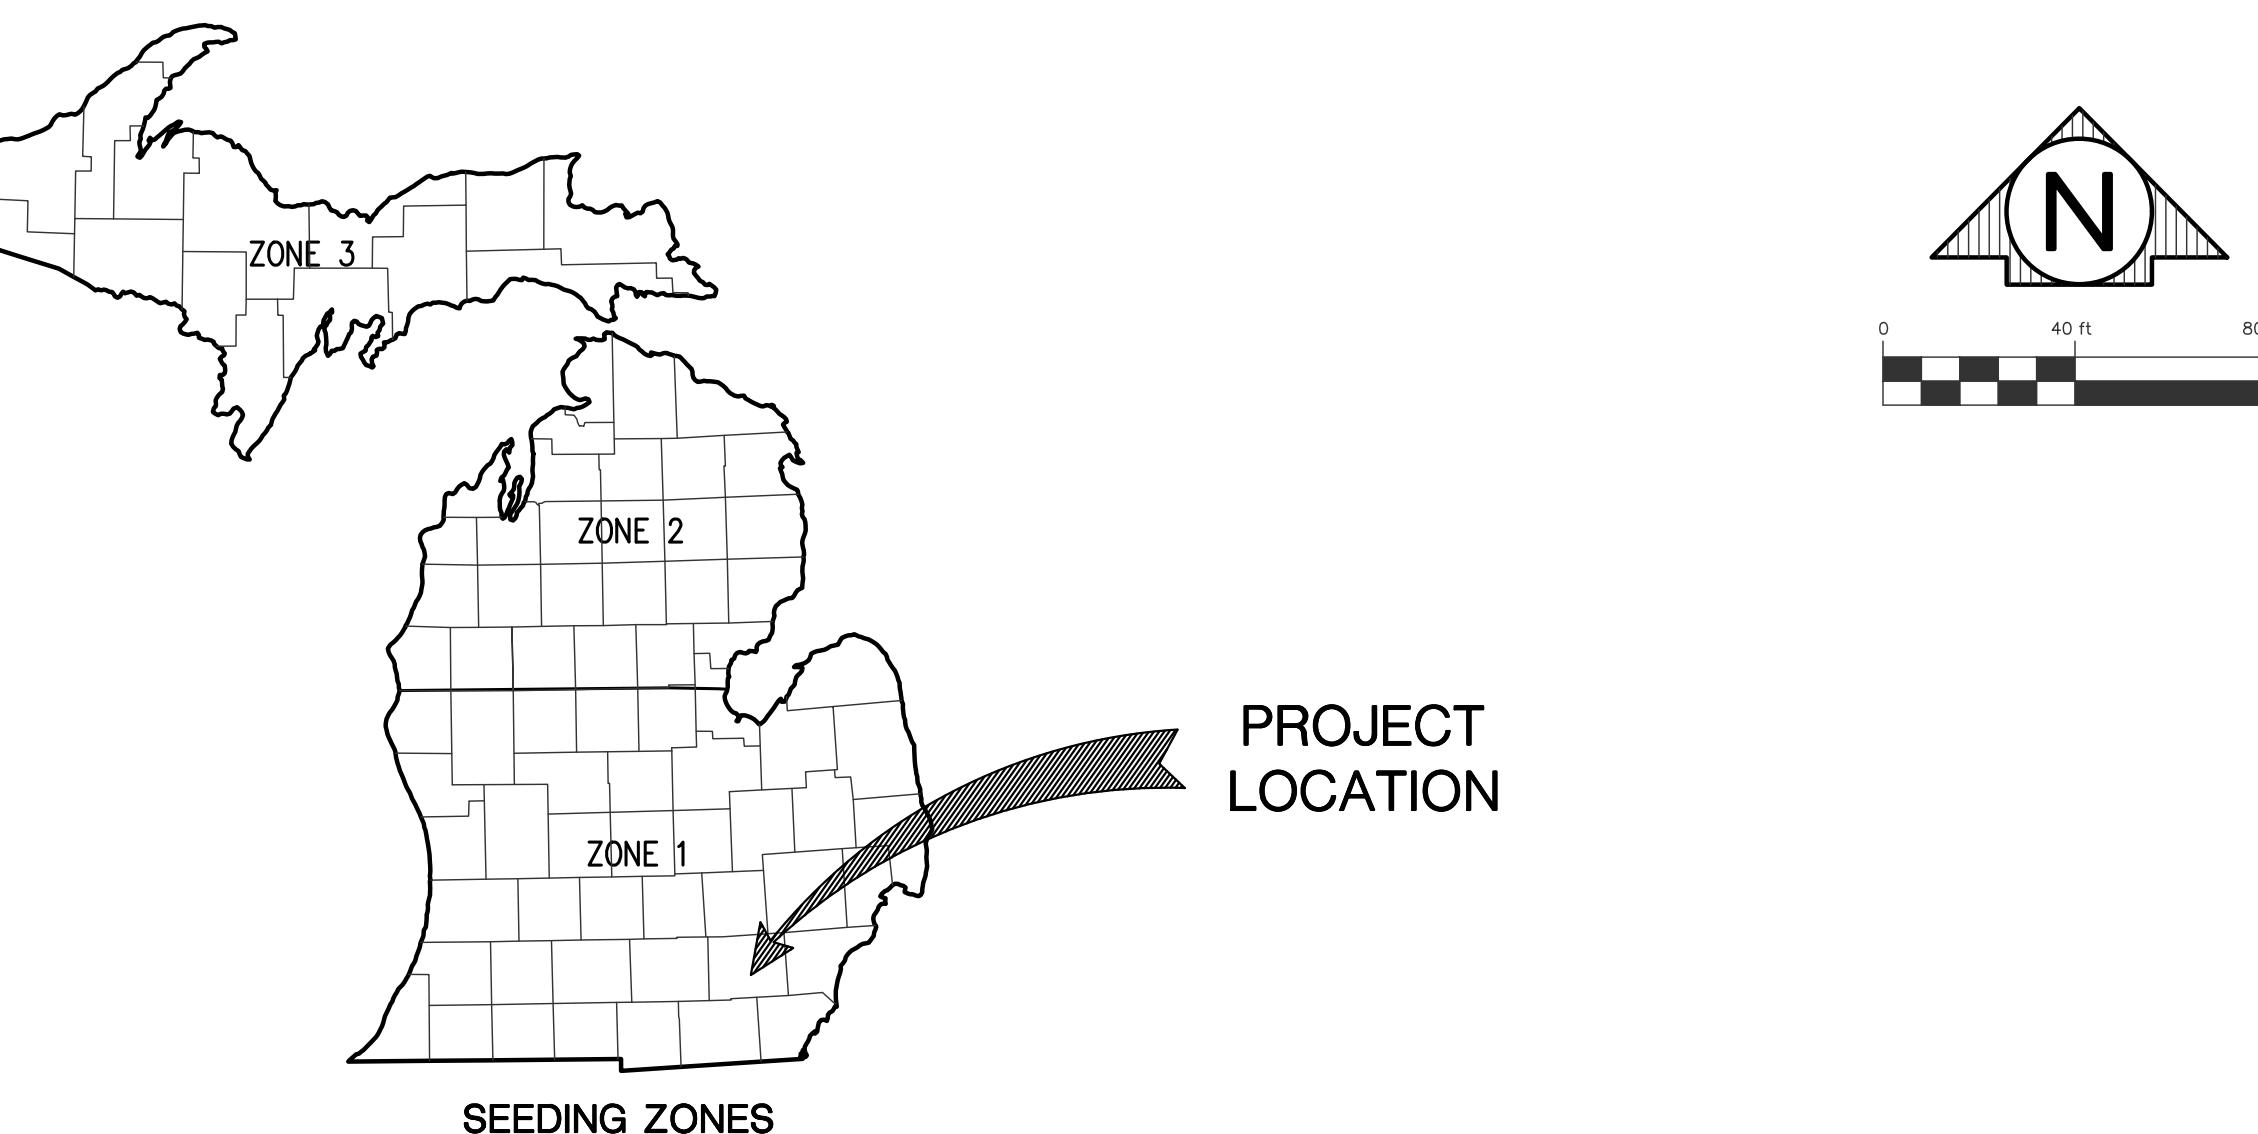

PROJECT LOCATION

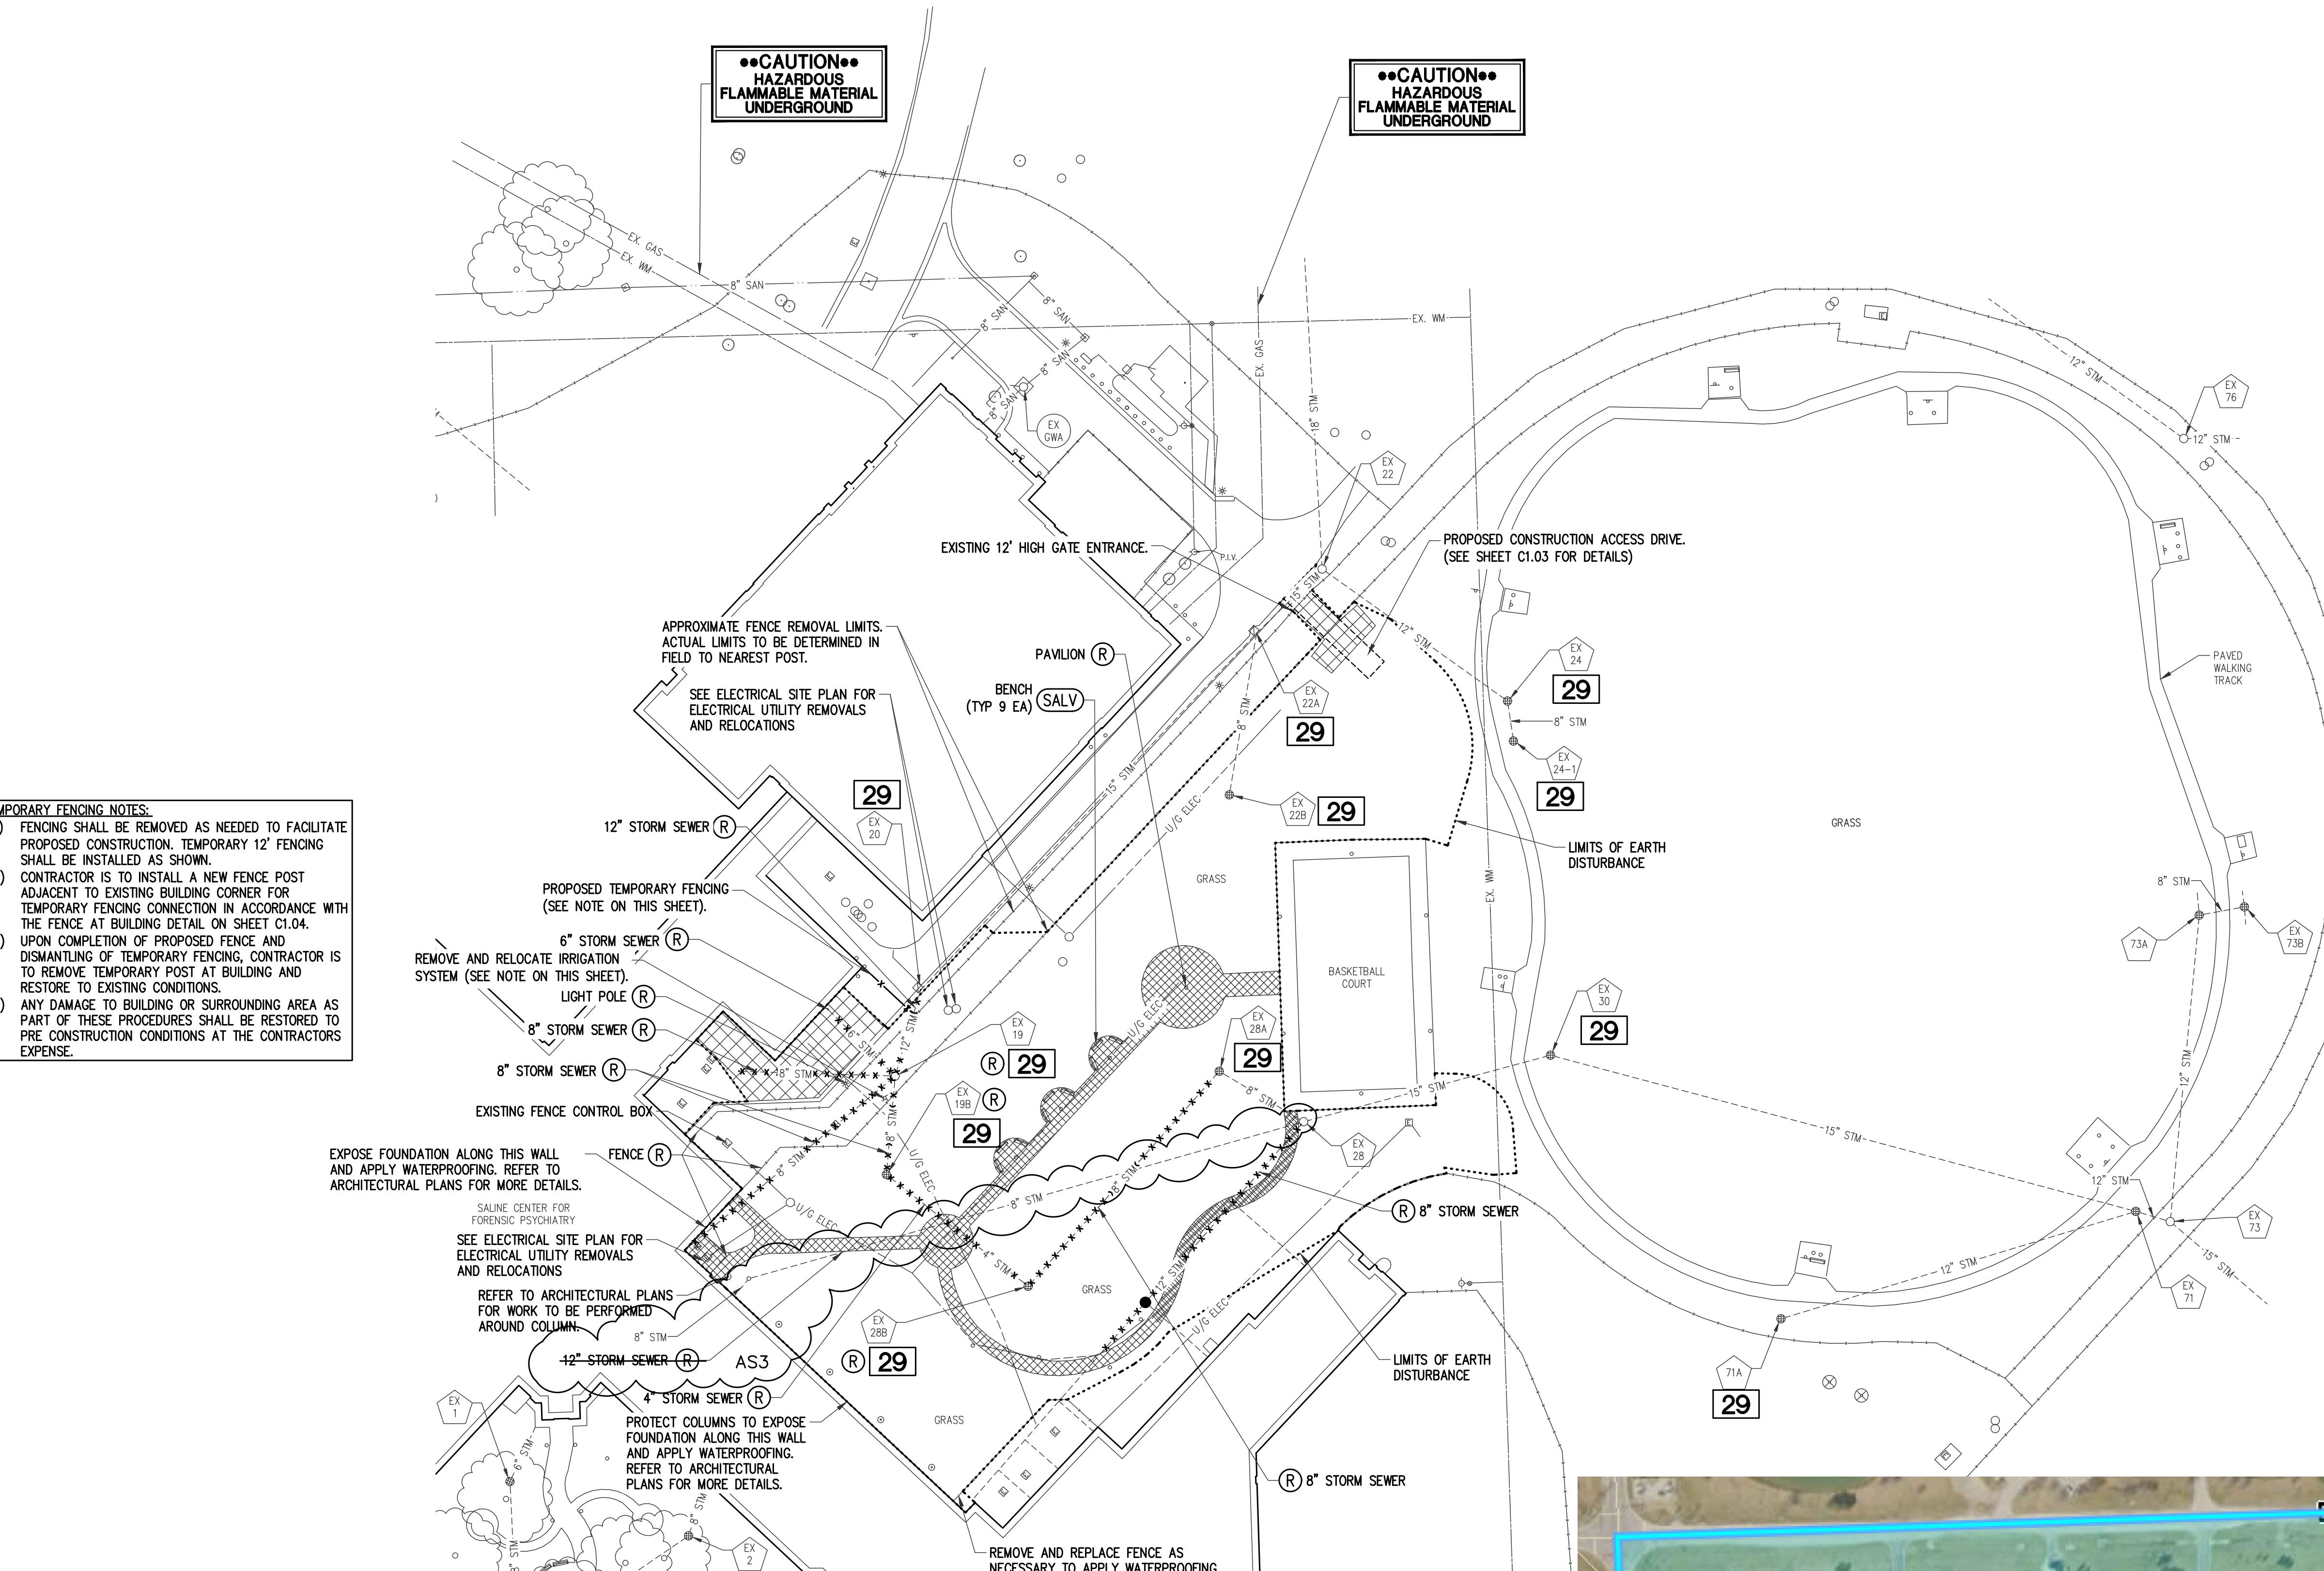

TEMPORARY FENCING NOTES:

- 1) FENCING SHALL BE REMOVED AS NEEDED TO FACILITATE PROPOSED CONSTRUCTION. TEMPORARY 12' FENCING SHALL BE REMOVED AS NEEDED.
- 2) CONTRACTOR IS TO INSTALL A NEW FENCE POST ADJACENT TO EXISTING BUILDING CORNER FOR TEMPORARY FENCING CONNECTION IN ACCORDANCE WITH THE FENCE AT BUILDING DETAIL ON SHEET C1.04.
- 3) UPON COMPLETION OF PROPOSED FENCE AND Dismantling of temporary fencing, contractor is to take care to protect building and restore to existing conditions.
- 4) ANY DAMAGE TO BUILDING OR SURROUNDING AREA AS PART OF THESE PROCEDURES SHALL BE RESTORED TO PRE CONSTRUCTION CONDITIONS AT THE CONTRACTORS EXPENSE.

EXPOSE FOUNDATION ALONG THIS WALL AND APPLY WATERPROOFING. REFER TO ARCHITECTURAL PLANS FOR MORE DETAILS.


SALINE CENTER FOR FORENSIC PSYCHIATRY

SEE ELECTRICAL SITE PLAN FOR ELECTRICAL UTILITY REMOVALS AND RELOCATIONS

REFER TO ARCHITECTURAL PLANS FOR WORK TO BE PERFORMED AROUND COLUMN.


PROTECT COLUMN TO EXPOSE FOUNDATION ALONG THIS WALL AND APPLY WATERPROOFING. REFER TO ARCHITECTURAL PLANS FOR MORE DETAILS.


REMOVE AND REPLACE FENCE AS NECESSARY TO APPLY WATERPROOFING.

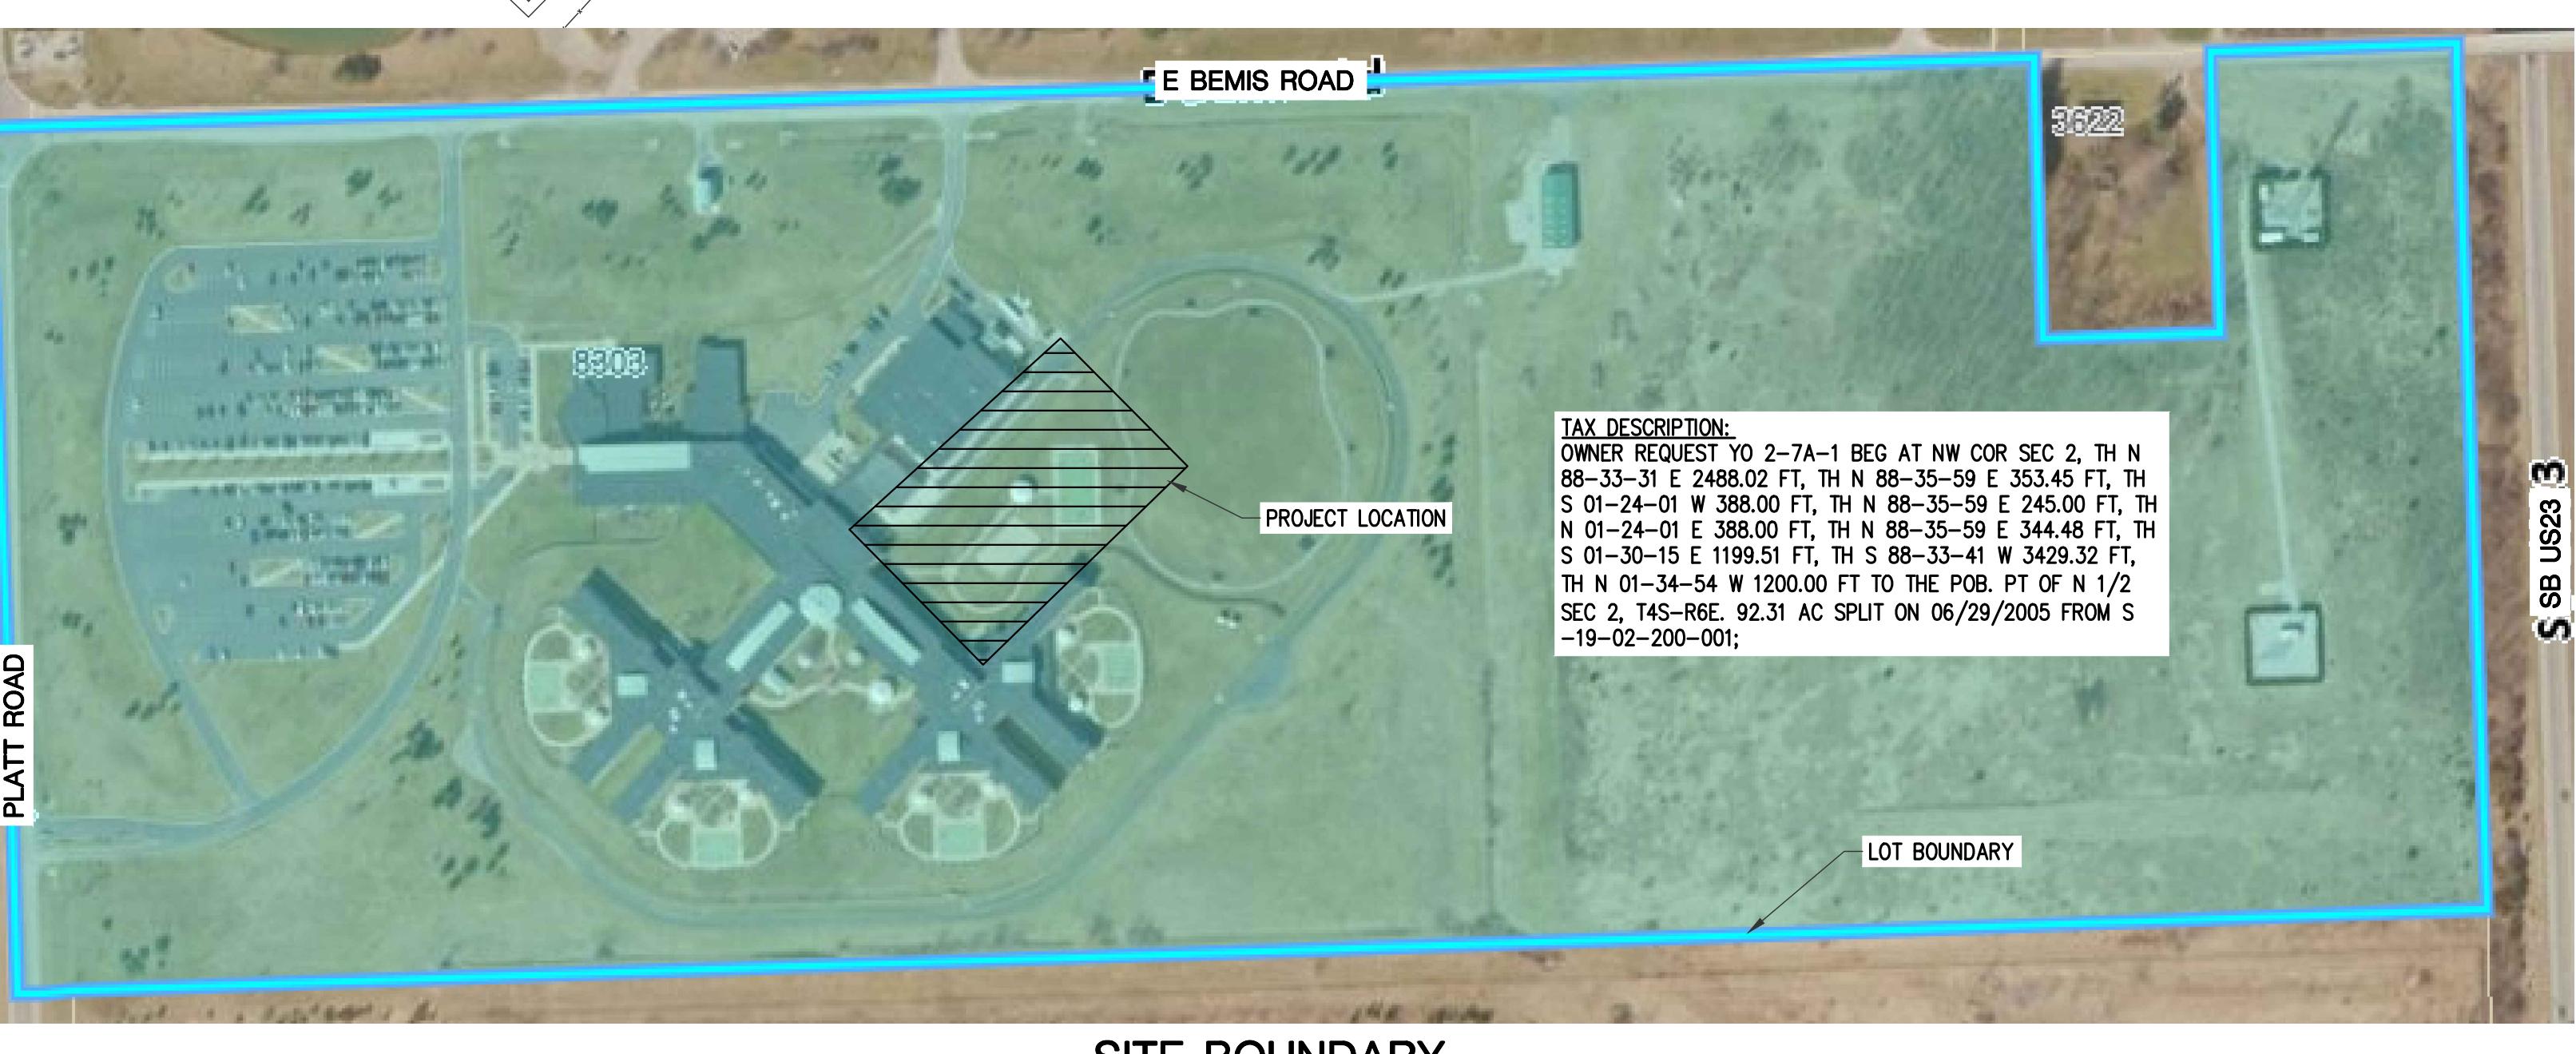

SITE BOUNDARY

NOT TO SCALE

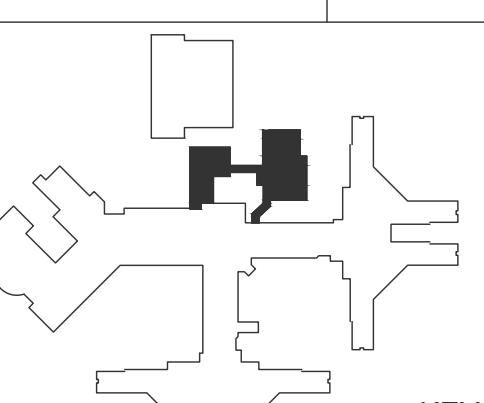
PROJECT NUMBER	2021094	SHEET NUMBER	C2.01
PROJECT DATE	SEPTEMBER 6, 2023	CHECKED BY	A.J.T.
FILE NO. 491/20167.SDW			
FUNDING CODE 171C0D0H57255		CONTRACT NO.	Y22003
			
WTA ARCHITECTS			
100 S Jefferson Ave, Suite 601 Saginaw, Michigan 48607 989.752.8107			
COPYRIGHT © 2023			
ROWE PROFESSIONAL SERVICES COMPANY			
PROJECT TITLE			
491/20167.SDW CFP – PHASE 500			
CENTER FOR FORENSIC PSYCHIATRY – CREATE KITCHEN SALINE, MICHIGAN			
SHEET TITLE			
SITE DEMOLITION PLAN			
TAX DESCRIPTION: OWNER REQUEST TO 2-7A-1 BEG AT NW COR SEC 2, TH N 88-33-31 E 2488.02 FT, TH N 88-35-59 E 353.45 FT, TH S 01-24-01 W 398.00 FT, TH N 88-35-59 E 245.00 FT, TH N 01-24-01 E 388.00 FT, TH N 88-33-59 E 344.48 FT, TH S 01-30-15 E 1199.51 FT, TH S 88-33-41 W 3429.32 FT, TH N 01-34-54 W 1200.00 FT TO THE POB. PT OF N 1/2 SEC 2, T45-R6E. 92.31 AC SPLIT ON 06/29/2005 FROM S -19-02-200-001;			

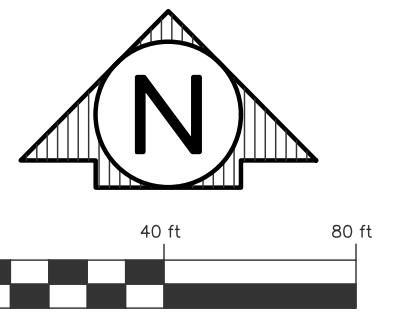

SITE INFORMATION

NOTES:

- 1) PROPOSED PERIMETER ELECTRIC AND CHAIN LINK FENCE IS TO MATCH THE EXISTING FENCE SIZE AND STYLE. ALL FENCING IS TO BE INSTALLED PER MANUFACTURE'S REQUIREMENT. SEE SHEET C1.04 FOR MORE DETAILS.
- 2) PERIMETER ELECTRIC FENCE IS TO BE INSTALLED AGAINST PROPOSED BUILDING CORNER AS SHOWN TO ALLOW FOR NO GAP OR MEANS OF PASSAGE. SEE SHEET C1.04 FOR MORE DETAILS.

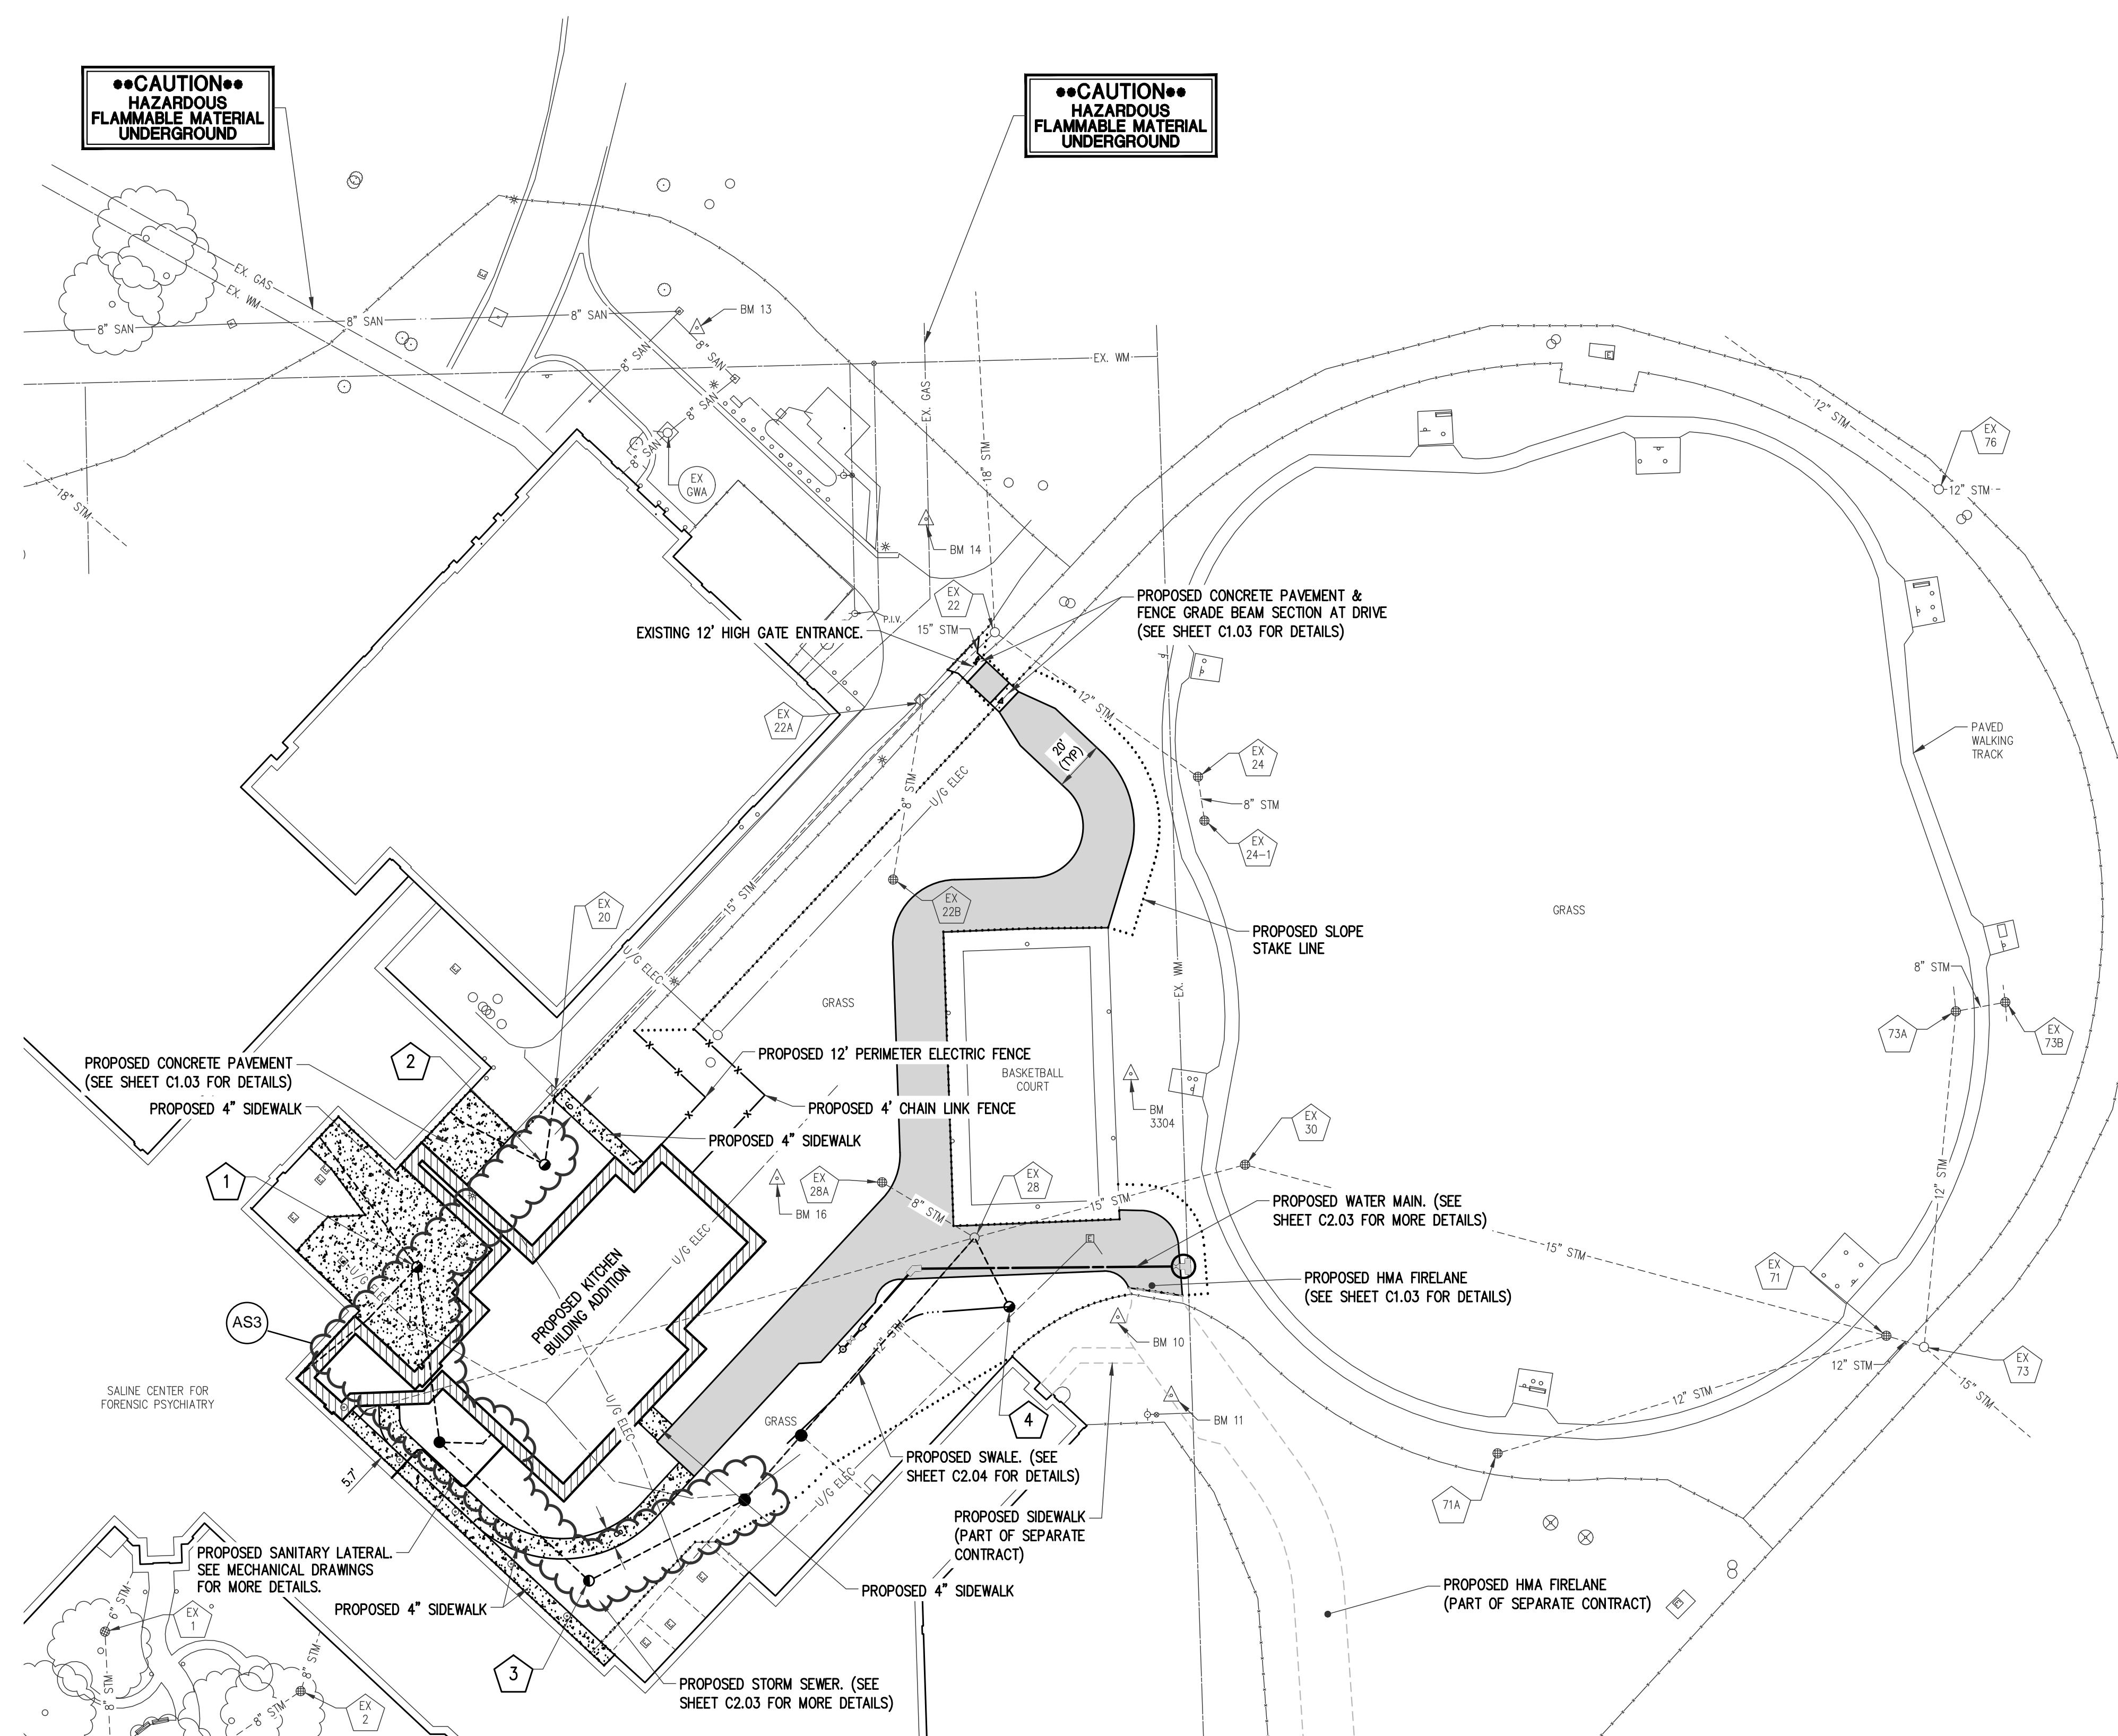

PROPERTY ADDRESS: 8303 PLATT ROAD
SALINE, MI 48176

PROPERTY OWNER: CENTER FOR FORENSIC PSYCHIATRY

PROPERTY TAX ID: S-19-02-200-003

ZONING AND SETBACK
REQUIREMENTS: A-2; INTERIM AGRICULTURE
FRONT YARD SETBACK - 50 FT

LEGAL DESCRIPTION: OWNER REQUEST YO 2-7A-1 BEG AT NW COR SEC 2, TH N 88-33-31 E 2488.02 FT, TH N 88-35-59 E 353.45 FT, TH S 01-24-01 W 388.00 FT, TH N 88-35-59 E 245.00 FT, TH N 01-24-01 E 388.00 FT, TH N 88-35-59 E 344.48 FT, TH S 01-30-15 E 1199.51 FT, TH S 88-33-41 W 3429.32 FT, TH N 01-34-54 W 1200.00 FT TO THE POB. PT OF N 1/2 SEC 2, T4S-R6E. 92.31 AC SPLIT ON 06/29/2005 FROM S -19-02-200-001;


TOTAL SITE AREA: 92.31 ACRES
ADJACENT PROPERTIES: S-19-02-200-002
S-19-02-200-004

63	ASI NO. 3	2-24-25
3	ADDENDUM NO. 3	9/28/23
0.	REVISION	DATE



E NO.
91/20167.SDW

ENDING CODE 1CODHHS7255	CONTRACT NO. Y22003
----------------------------	------------------------

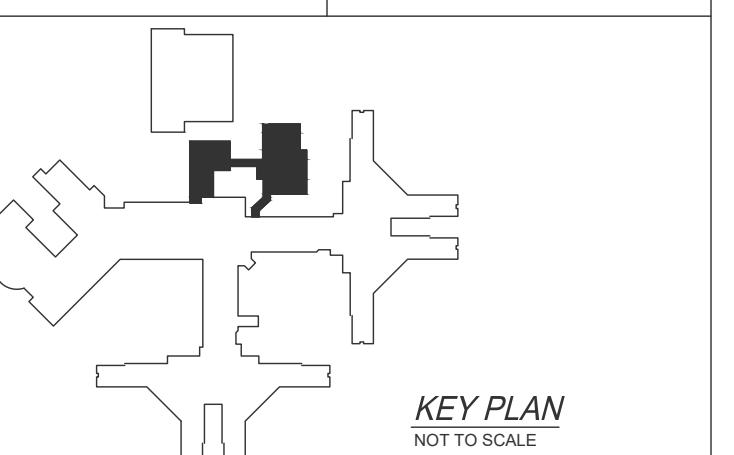



The logo for WTA Architects consists of three circular icons arranged horizontally above the company name. The first icon contains a diagonal line from the top-left to the bottom-right. The second icon contains a horizontal line. The third icon contains a triangle pointing upwards. Below the icons, the word "WTA" is in a large, bold, sans-serif font, and "ARCHITECTS" is in a smaller, regular sans-serif font.



PROJECT TITLE
491/20167.SDW CFP – PHASE 500
CENTER FOR FORENSIC
PSYCHIATRY – CREATE
KITCHEN
ALINE MICHIGAN

STREET TITLE TITLE PLAN

PROJECT NUMBER 2021094	SHEET NUMBER
PROJECT DATE SEPTEMBER 6, 2023	C2.02
CHECKED BY A. L. T.	

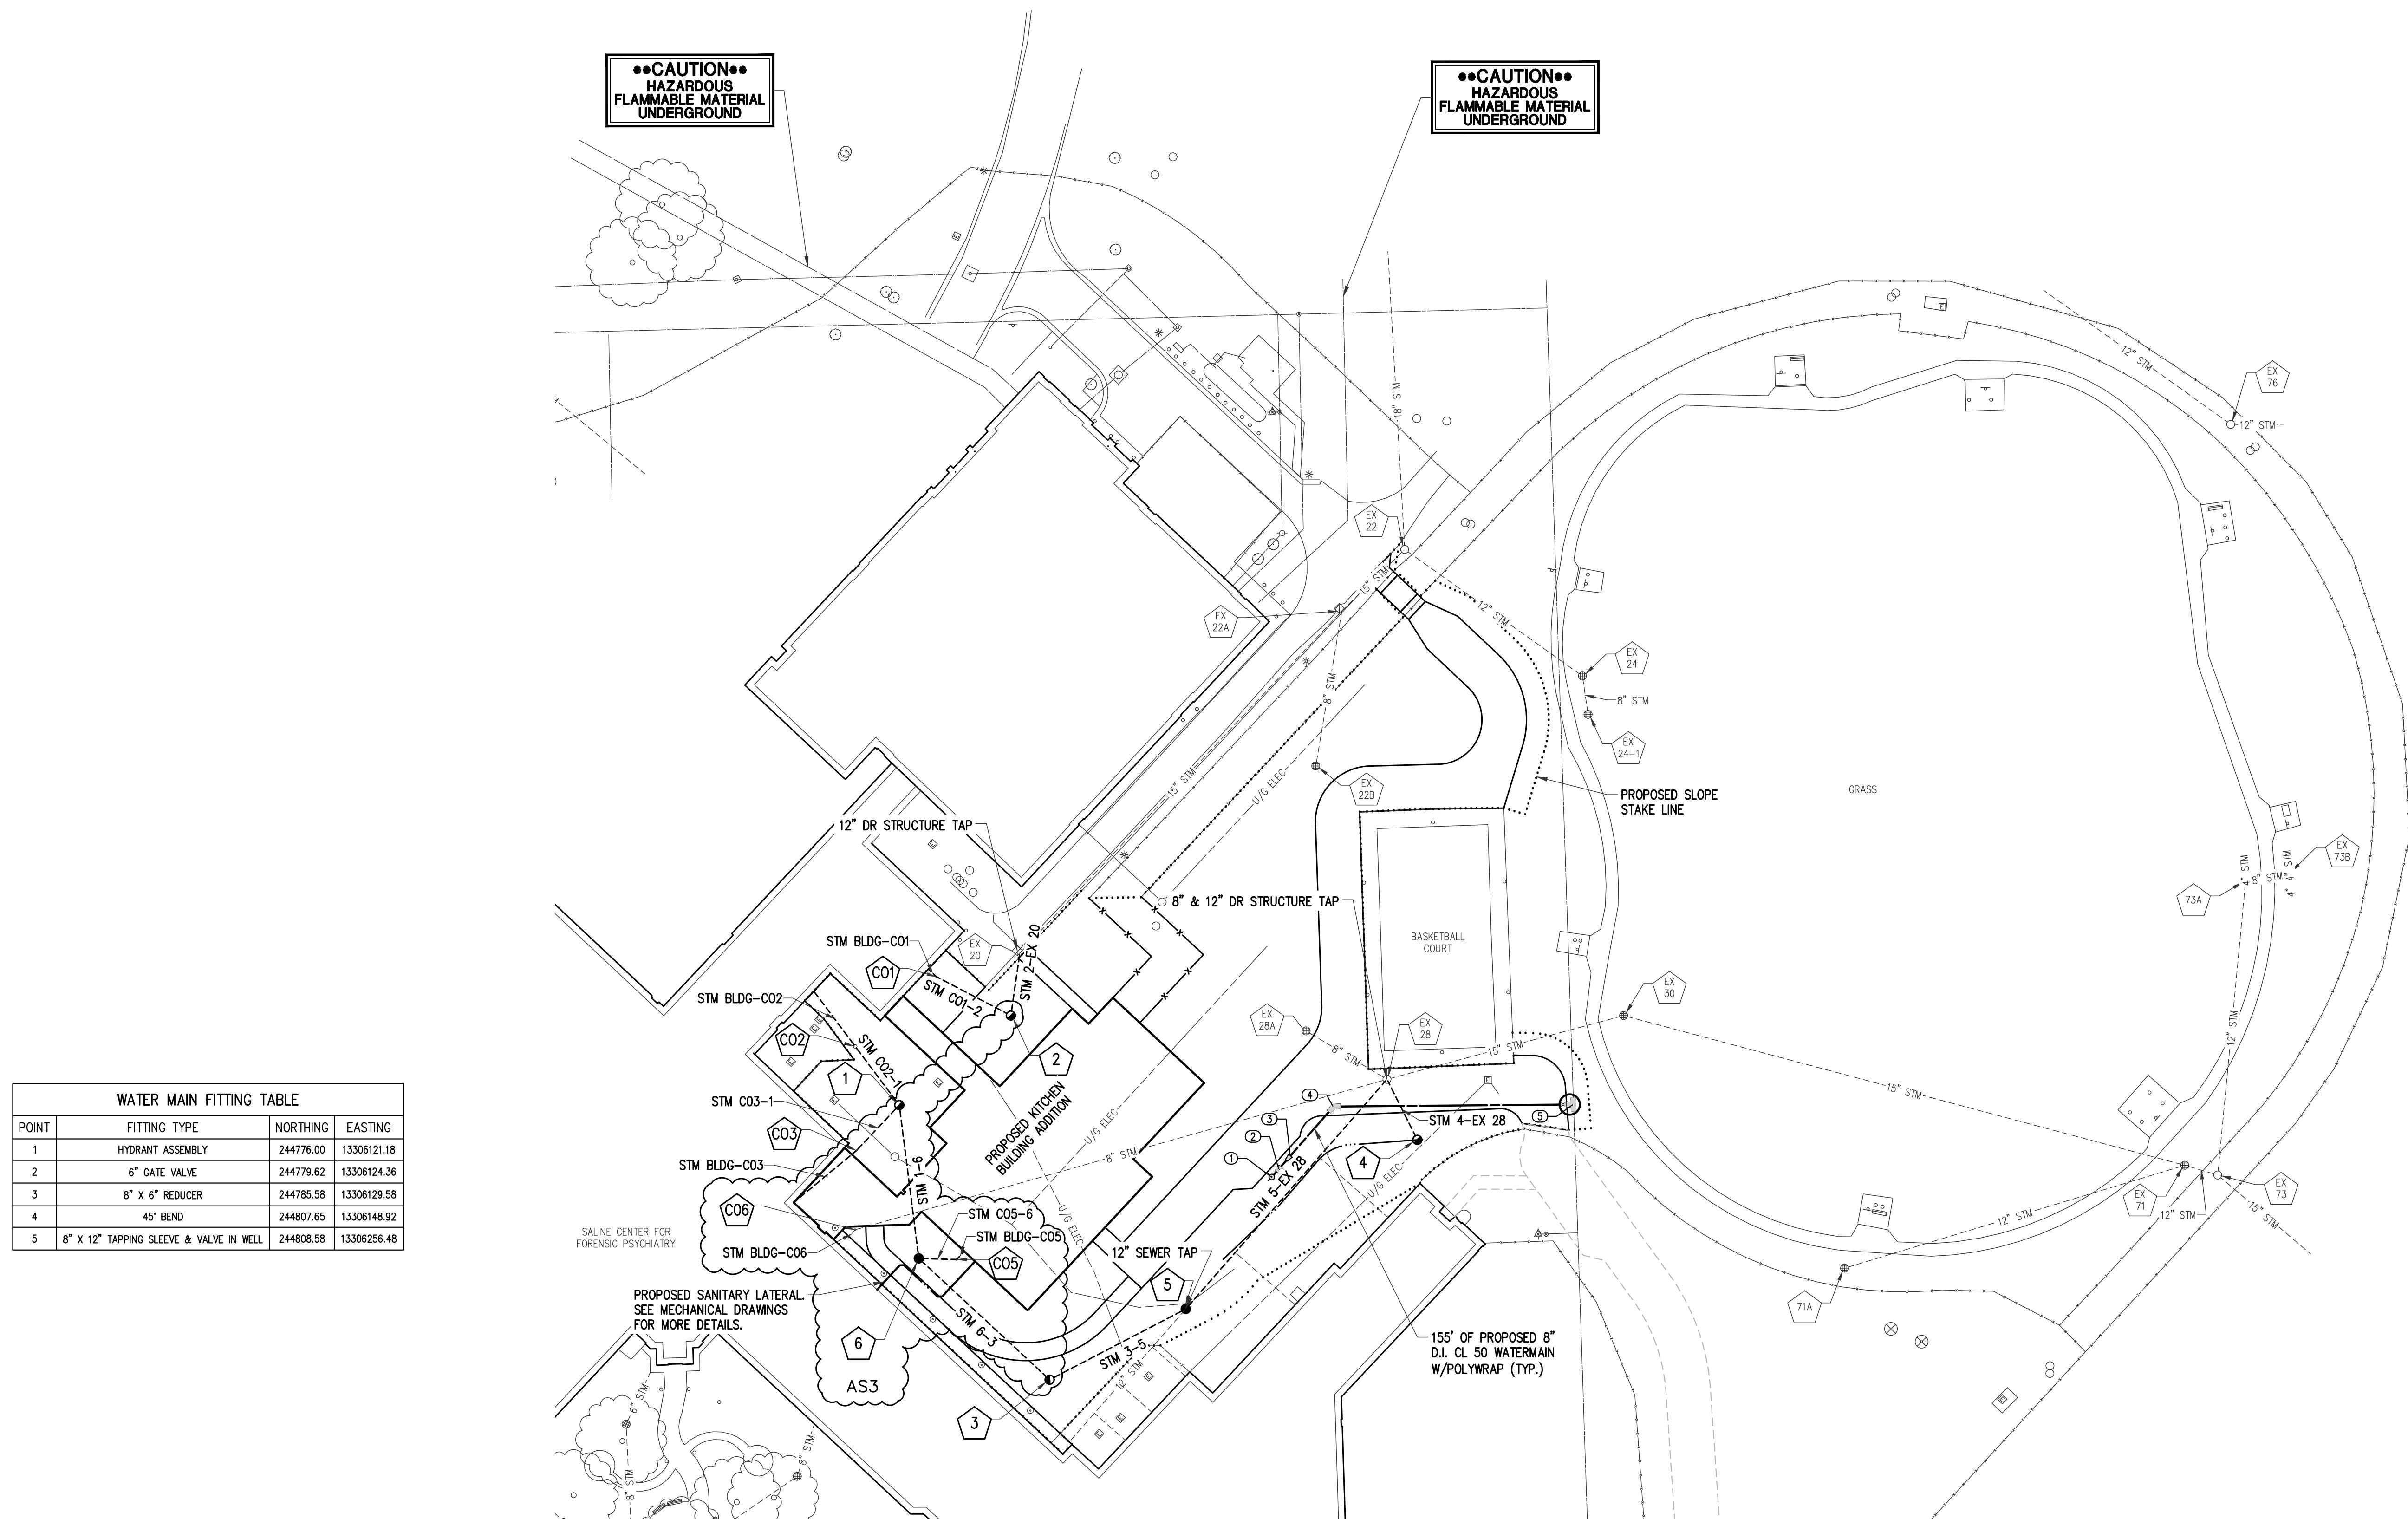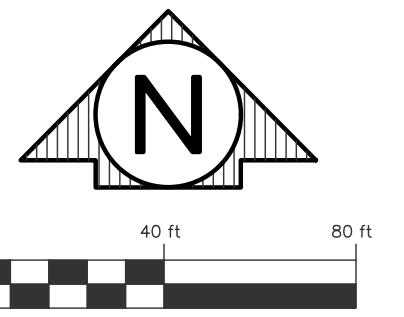

PROPOSED STORM SEWER STRUCTURE TABLE						
STRUCT NO.	DIA.	COVER TYPE	RIM ELEVATION	INVERT	NORTHING	EASTING
1	48"	G	RIM=836.02	12" 817.53 S (PVC Pipe) 6" 831.46 NW (PR) 6" 831.46 SW (PVC Pipe)	244808.30	13305954.08
2	48"	G	RIM=835.52	12" 829.52 N (PR) 6" 830.82 NW (PR)	244848.48	13306004.16
3	48"	G	RIM=835.24	12" 821.73 NE (PR) 12" 821.73 NW (PR)	244685.13	13306021.54
4	24"	G	RIM=833.04	12" 829.57 NW (PR)	244792.70	13306186.54
5	48"	B	RIM=835.71	12" 821.40 NE (PR) 12" 821.40 SW (PR) 12" 829.15 SW (EX)	244716.85	13306082.65
6	48"	B	RIM=836.40	12" 824.00 N (PVC Pipe) 12" 822.36 SE (PR) 8" 830.96 (PR)	244739.50	13305962.85
EX 20	N/A	N/A	T/C=835.49	12" 820.74 SW (PR) 8" 820.74 N (PVC Pipe)	244876.50	13306008.16
EX 28	N/A	N/A	RIM=835.19	12" 820.74 SW (PR) 8" 820.74 N (PVC Pipe) 10" 826.78 NW (EX) 10" 820.74 E (EX)	244819.86	13306172.92
EX 28A	N/A	N/A	RIM=833.60	10" 828.08 SE (EX)	244841.58	13306136.61


PROPOSED STORM SEWER PIPE TABLE					
PIPE NUMBER	DIA	TOTAL LENGTH	SLOPE	TRENCH DETAIL A (T.D. A)	TRENCH DETAIL B (T.D. B)
STM 1-6	12"	69'	9.33%	5'	24'
STM 2-EX 20	12"	28'	1.00%	20'	8'
STM 3-5	12"	69'	0.46%	0'	69'
STM 4-EX 28	12"	30'	1.00%	5'	25'
STM 5-EX 28	12"	137'	0.48%	137'	0'
STM 6-3	12"	80'	0.76%	0'	80'
STM BLDG-C03	8"	37'	1.00%	37'	37'
STM BLDG-C06	8"	5'	1.00%	0'	5'
STM BLDG-C01	6"	5'	1.00%	0'	5'
STM BLDG-C02	12"	31'	1.00%	0'	31'
STM BLDG-C05	8"	5'	1.00%	0'	5'
STM C03-1	6"	26'	1.00%	26'	23'
STM C01-2	6"	38'	1.00%	10'	28'
STM C02-1	6"	33'	1.00%	8'	25'
STM C05-6	8"	17'	3.18%	0'	17'

PROPOSED CLEANOUT TABLE		
CLEANOUT	NORTHING	EASTING
C01	244865.88	13305970.76
C02	244834.65	13305934.31
C03	244787.91	13305934.89
C05	244739.05	13305979.85

STATE OF MICHIGAN
DEPARTMENT OF TECHNOLOGY, MANAGEMENT AND BUDGET
FACILITIES AND BUSINESS SERVICE ADMINISTRATION
DESIGN AND CONSTRUCTION DIVISION
ADAM LACH, DIRECTOR

FILE NO.
491/20167.SDW

FUNDING CODE
171CODHHS7255

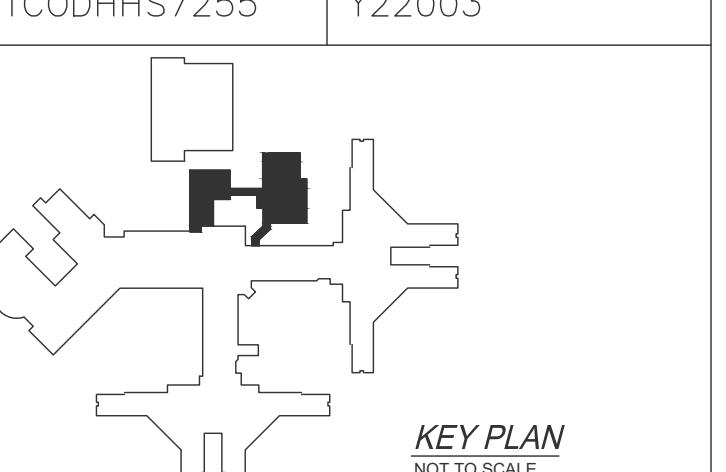

WTAARCH.COM



WTA ARCHITECTS

100 S Jefferson Ave, Suite 601
Saginaw, Michigan 48607
989.752.8107

COPYRIGHT © 2023

ROWE PROFESSIONAL SERVICES COMPANY

PROJECT TITLE
491/20167.SDW CFP – PHASE 500
CENTER FOR FORENSIC PSYCHIATRY – CREATE KITCHEN SALINE, MICHIGAN

SHEET TITLE
UTILITY PLAN

PROJECT NUMBER
2021094

PROJECT DATE
SEPTEMBER 6, 2023

CHECKED BY
A.J.T.

SHEET NUMBER
C2.03

